




GRAPHIC SCALE



(IN FEET)

1 inch = 50 ft.

## SEE SHEET 3

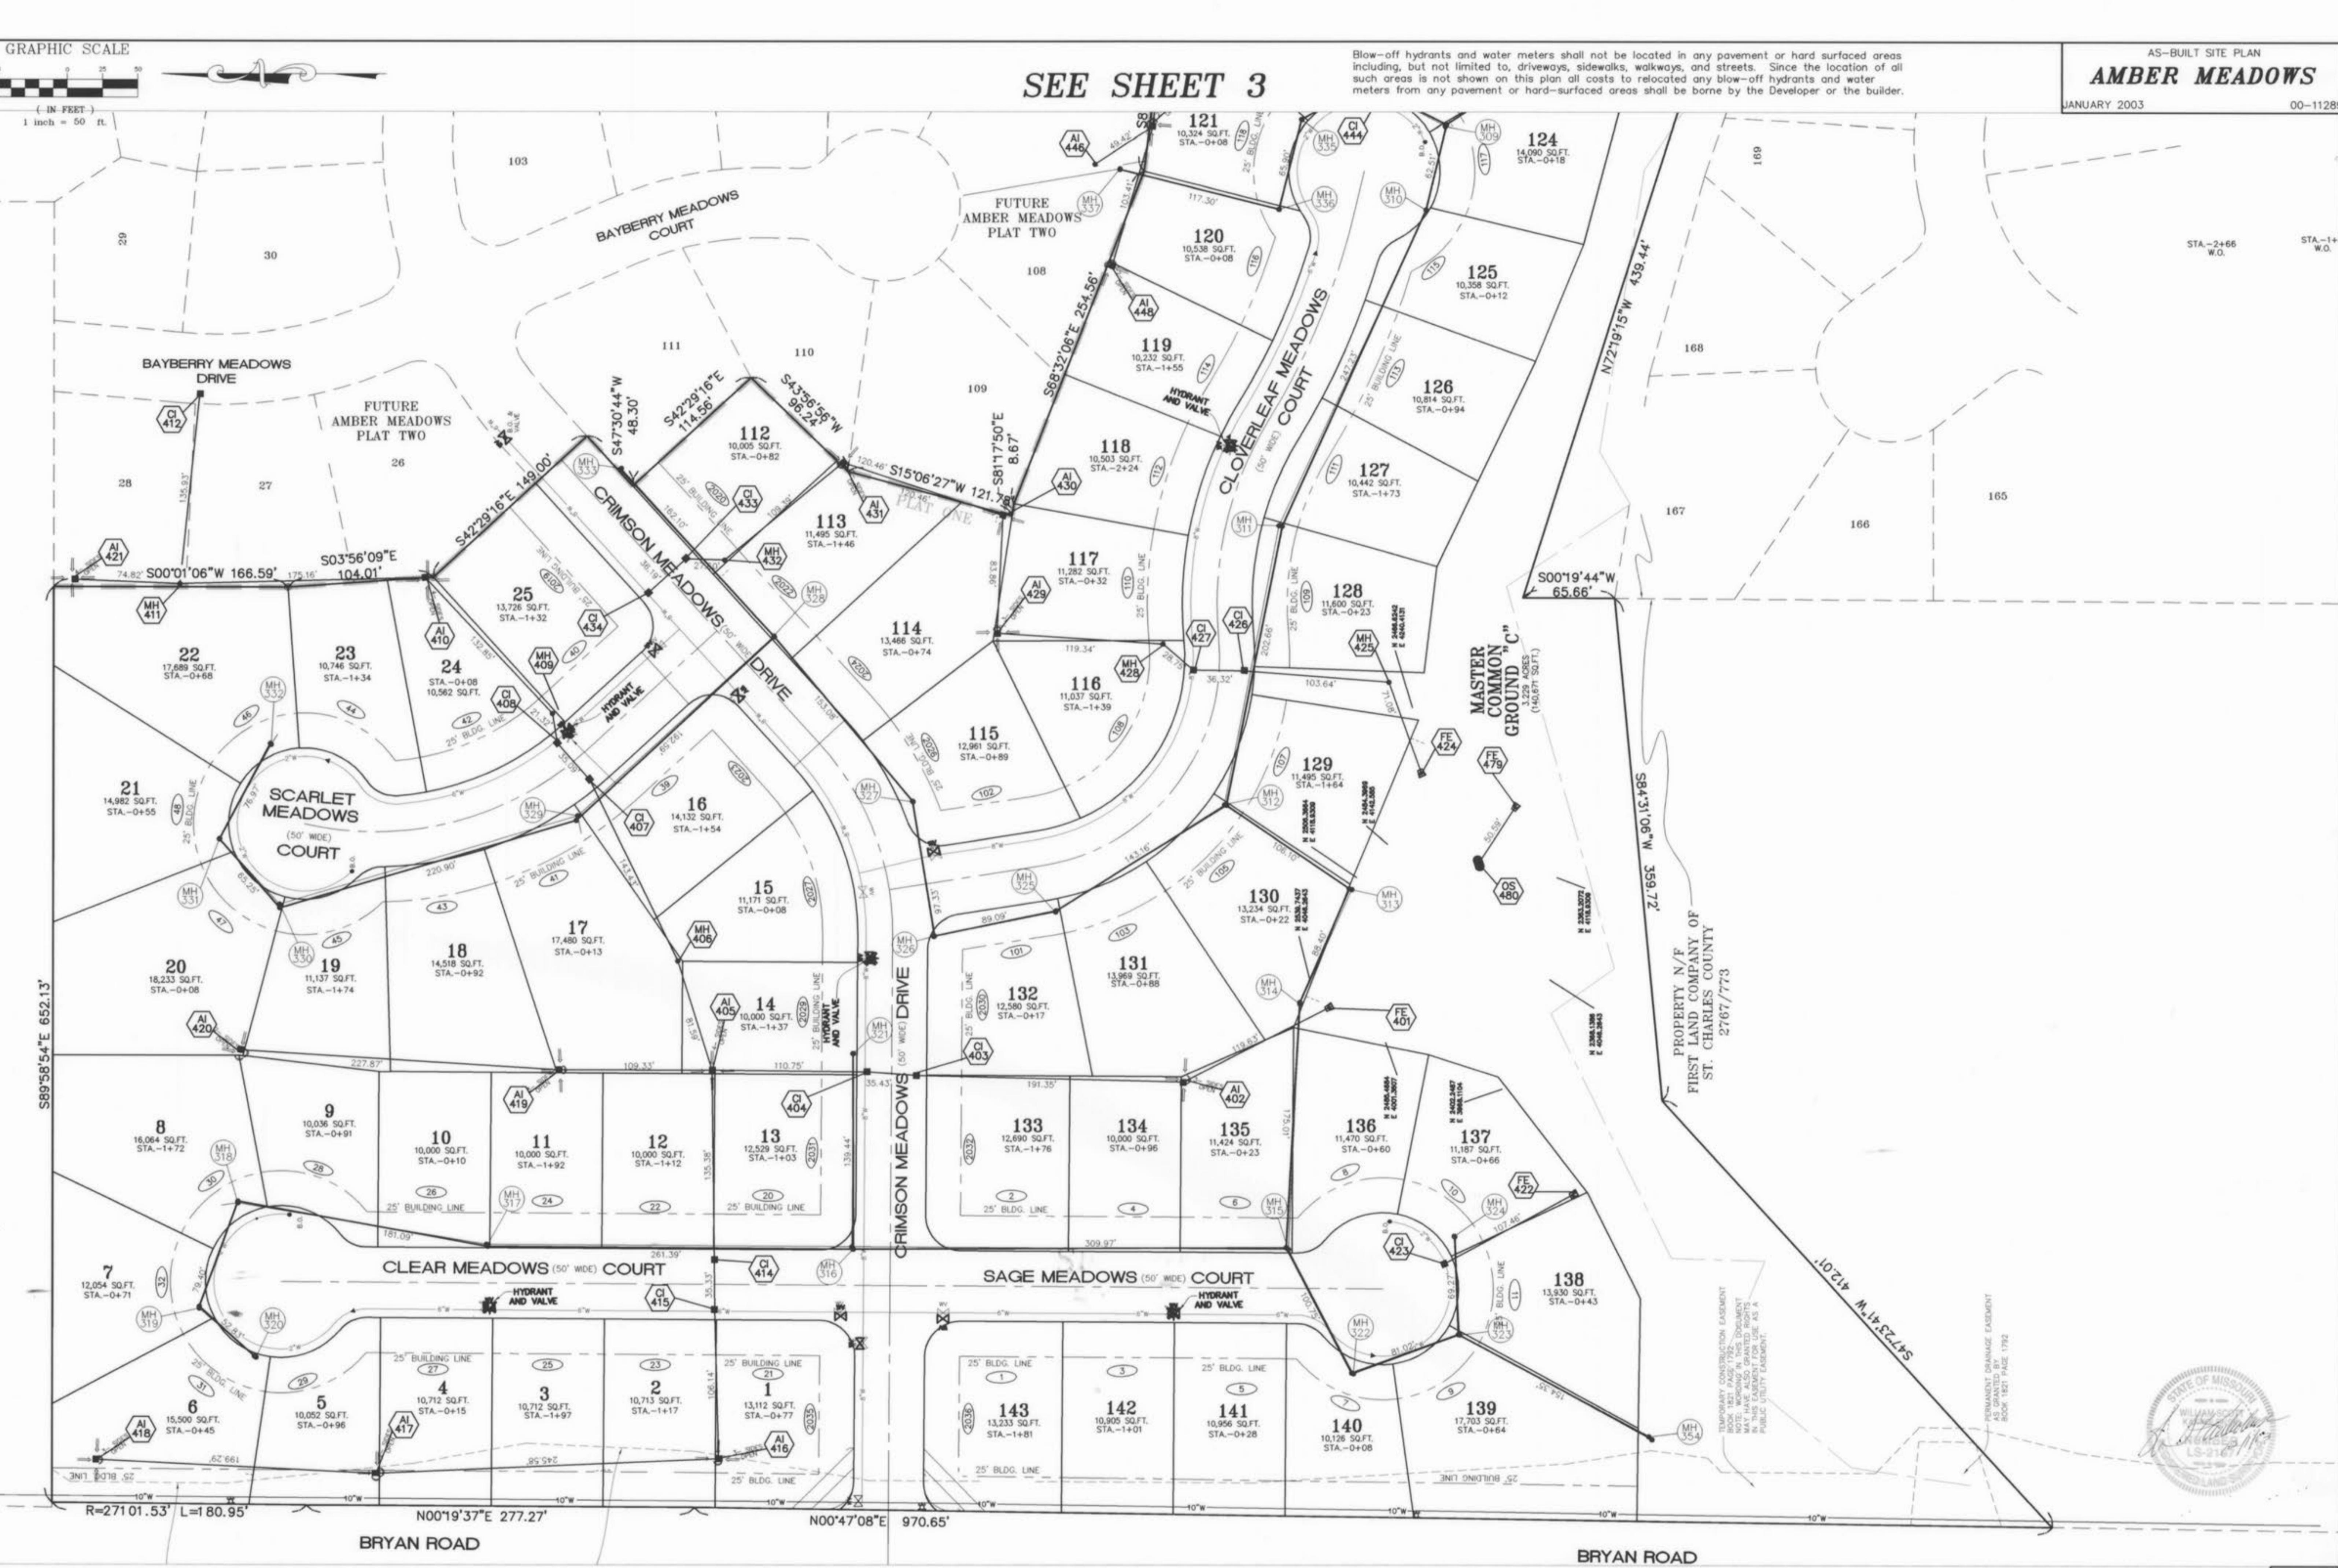

GRAPHIC SCALE



( IN FEET )

1 inch = 50 ft.

Blow-off hydrants and water meters shall not be located in any pavement or hard surfaced areas including, but not limited to, driveways, sidewalks, walkways, and streets. Since the location of all such areas is not shown on this plan all costs to relocate any blow-off hydrants and water meters from any pavement or hard-surfaced areas shall be borne by the Developer or the builder.

AS-BUILT SITE PLAN

**AMBER MEADOWS**

JANUARY 2003

00-11289



Underground utilities have been plotted from available information and, therefore, their locations shall be considered approximate only. The verification of the location of all underground utilities, either shown or not shown, on these plans shall be the responsibility of the Contractor, and shall be located prior to any grading or construction of the improvements.

Note: Street trees shown are to be installed upon completion of home site by homeowner in conjunction with sidewalk installation.


**SEE SHEET 2**  
**AS-BUILT ADDED JANUARY 2003**

These engineering plans have been prepared at the request of the developer for construction with some rock data, but not sufficient enough to determine the exact location of all existing rock conditions.

If existing rock conditions are encountered during construction it shall be the responsibility of the developer and/or his contractor to contact Box Engineering Co., Inc. and the soils engineer for the project at the time of encounter to determine the best design to continue construction.



NOTE: ALL SANITARY SEWER ON THIS SHEET WITHIN  
DUCKETT CREEK SANITARY SEWER DISTRICT.

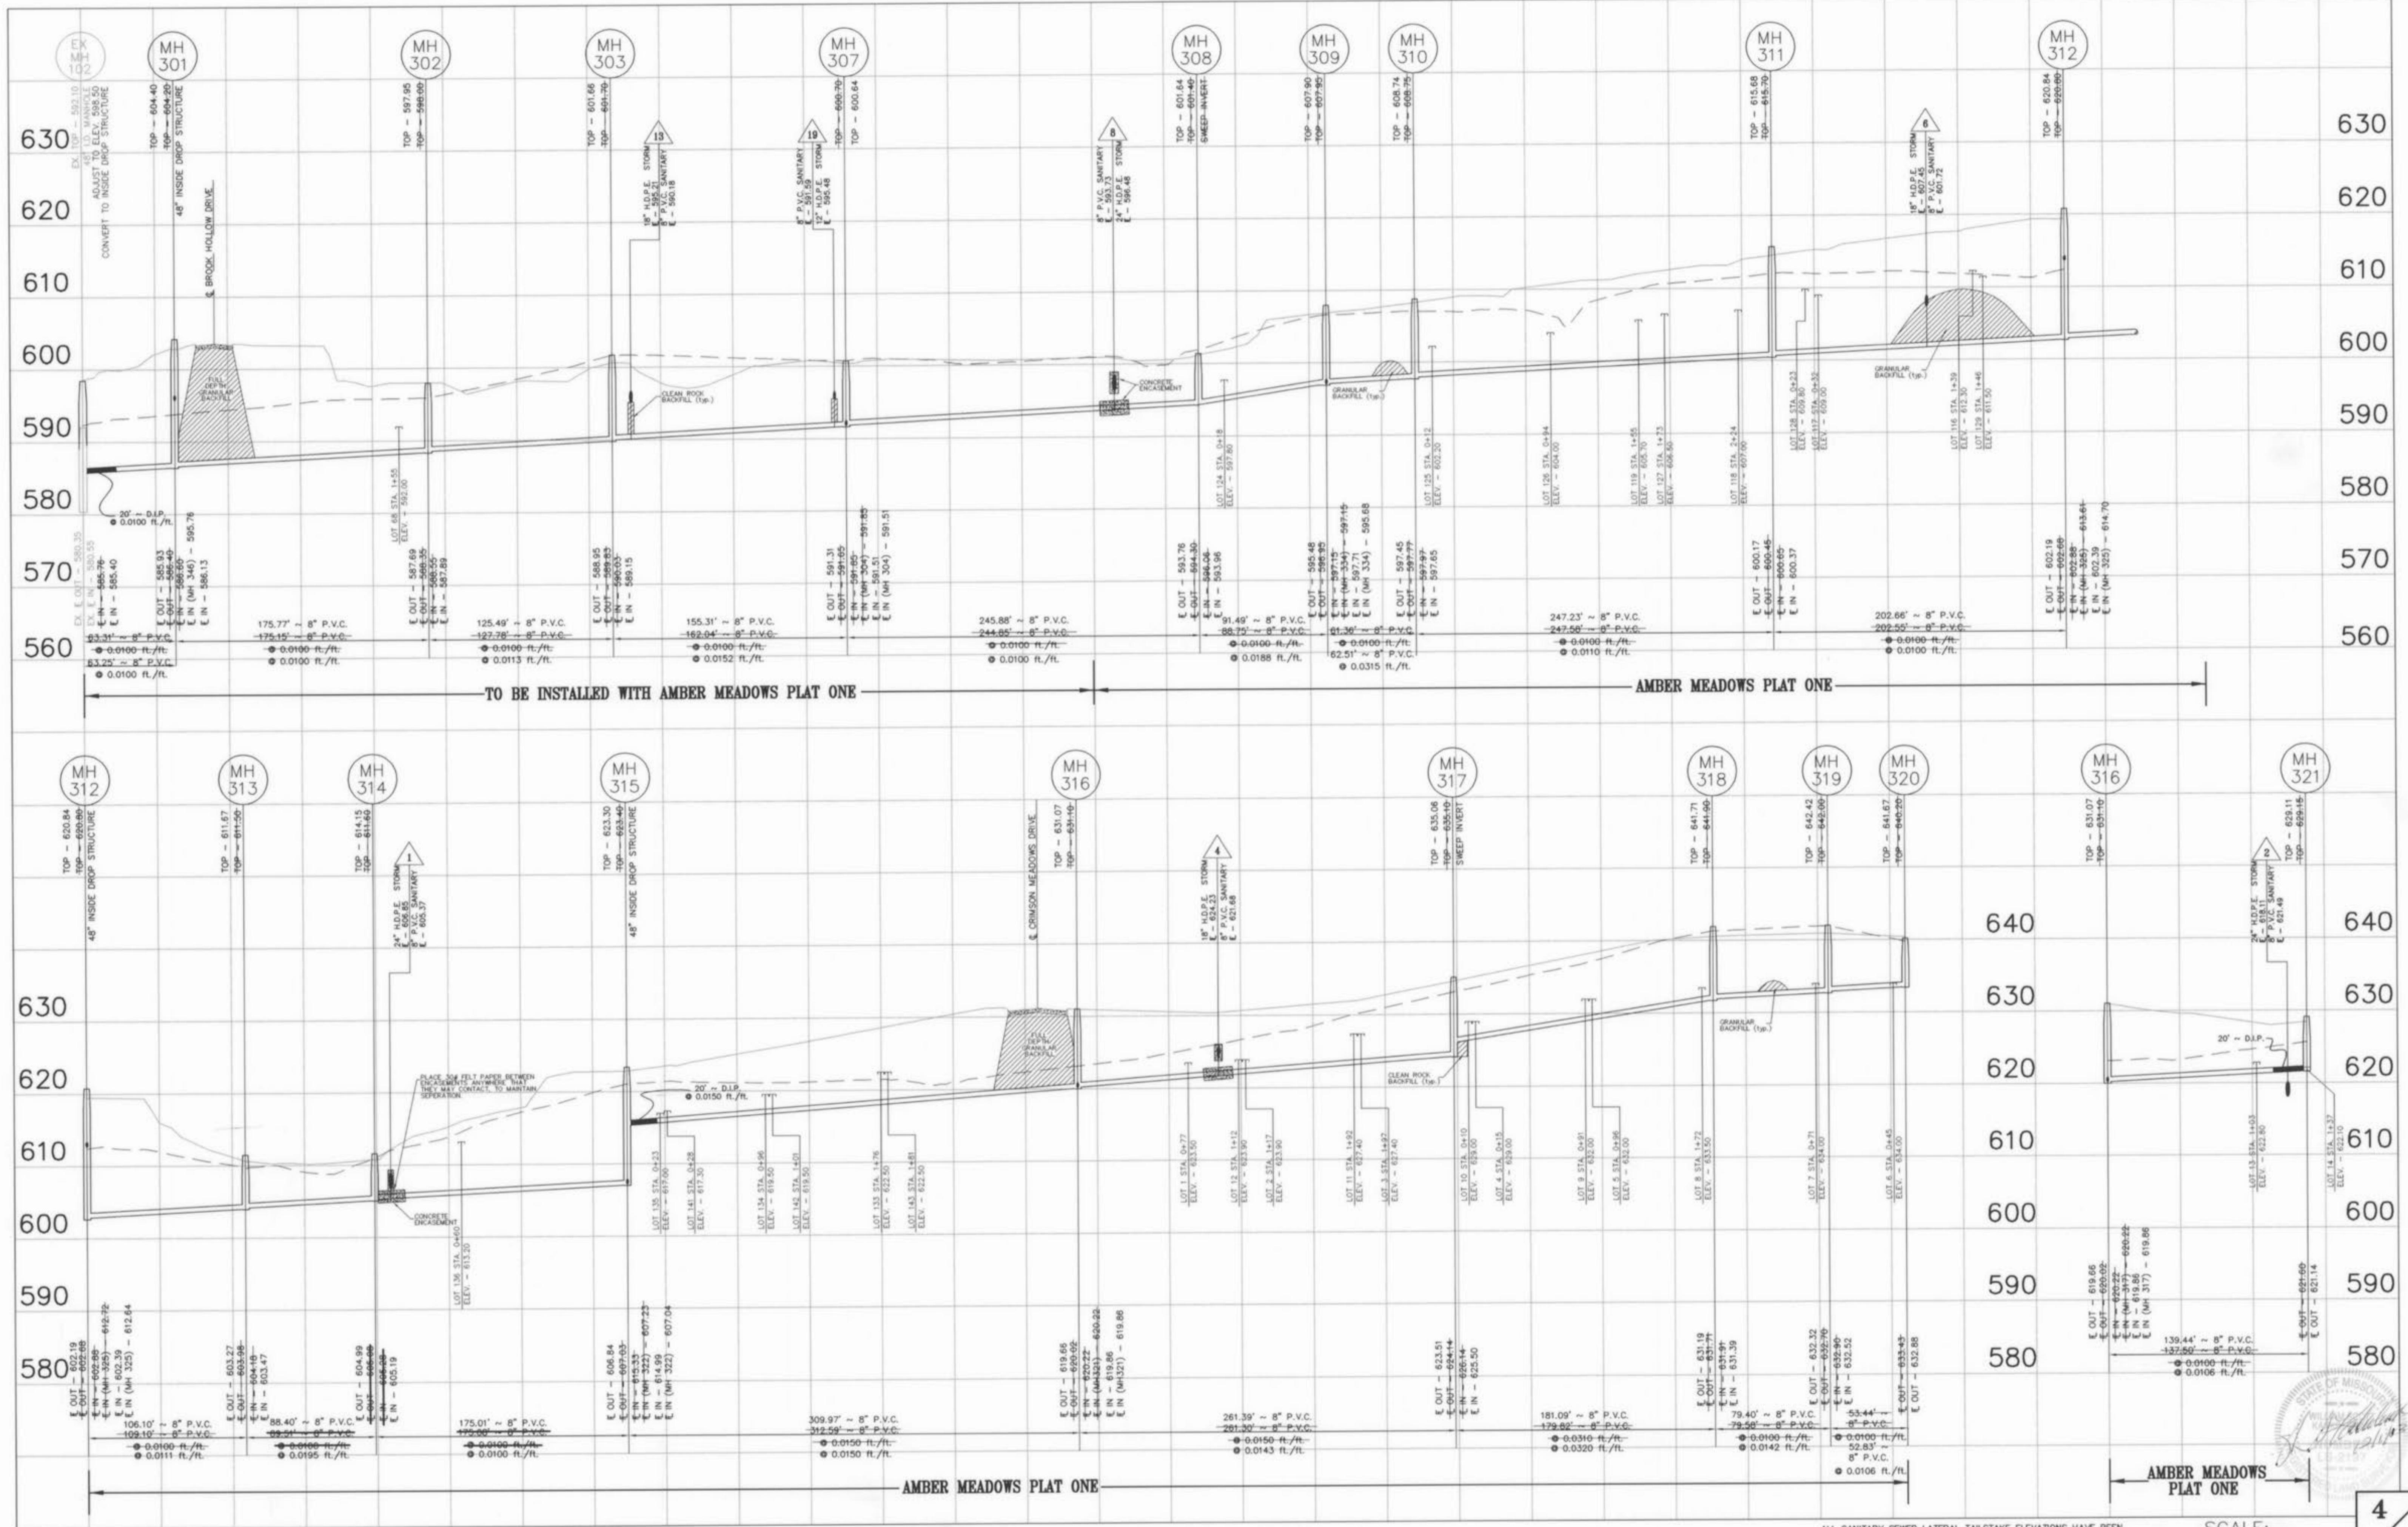

UNDERGROUND UTILITIES HAVE BEEN PLOTTED FROM AVAILABLE INFORMATION AND THEREFORE THEIR LOCATIONS SHALL BE CONSIDERED APPROXIMATE ONLY. THE VERIFICATION OF THE LOCATION OF ALL UNDERGROUND UTILITIES, EITHER SHOWN OR NOT SHOWN ON THESE PLANS SHALL BE THE RESPONSIBILITY OF THE CONTRACTOR, AND SHALL BE LOCATED PRIOR TO ANY GRADING OR CONSTRUCTION OF THE IMPROVEMENTS.


AS-BUILT ADDED JANUARY 2003



ALL SANITARY SEWER LATERAL TAILSTAKE ELEVATIONS HAVE BEEN  
DESIGNED FOR AN 8.0' BASEMENT POUR.

SCALE:  
VERTICAL = 1" = 10'  
HORIZONTAL = 1" = 50'

Amber Meadows Plat 1  
As Built

NOTE: ALL SANITARY SEWER ON THIS SHEET WITHIN  
DUCKETT CREEK SANITARY SEWER DISTRICT.

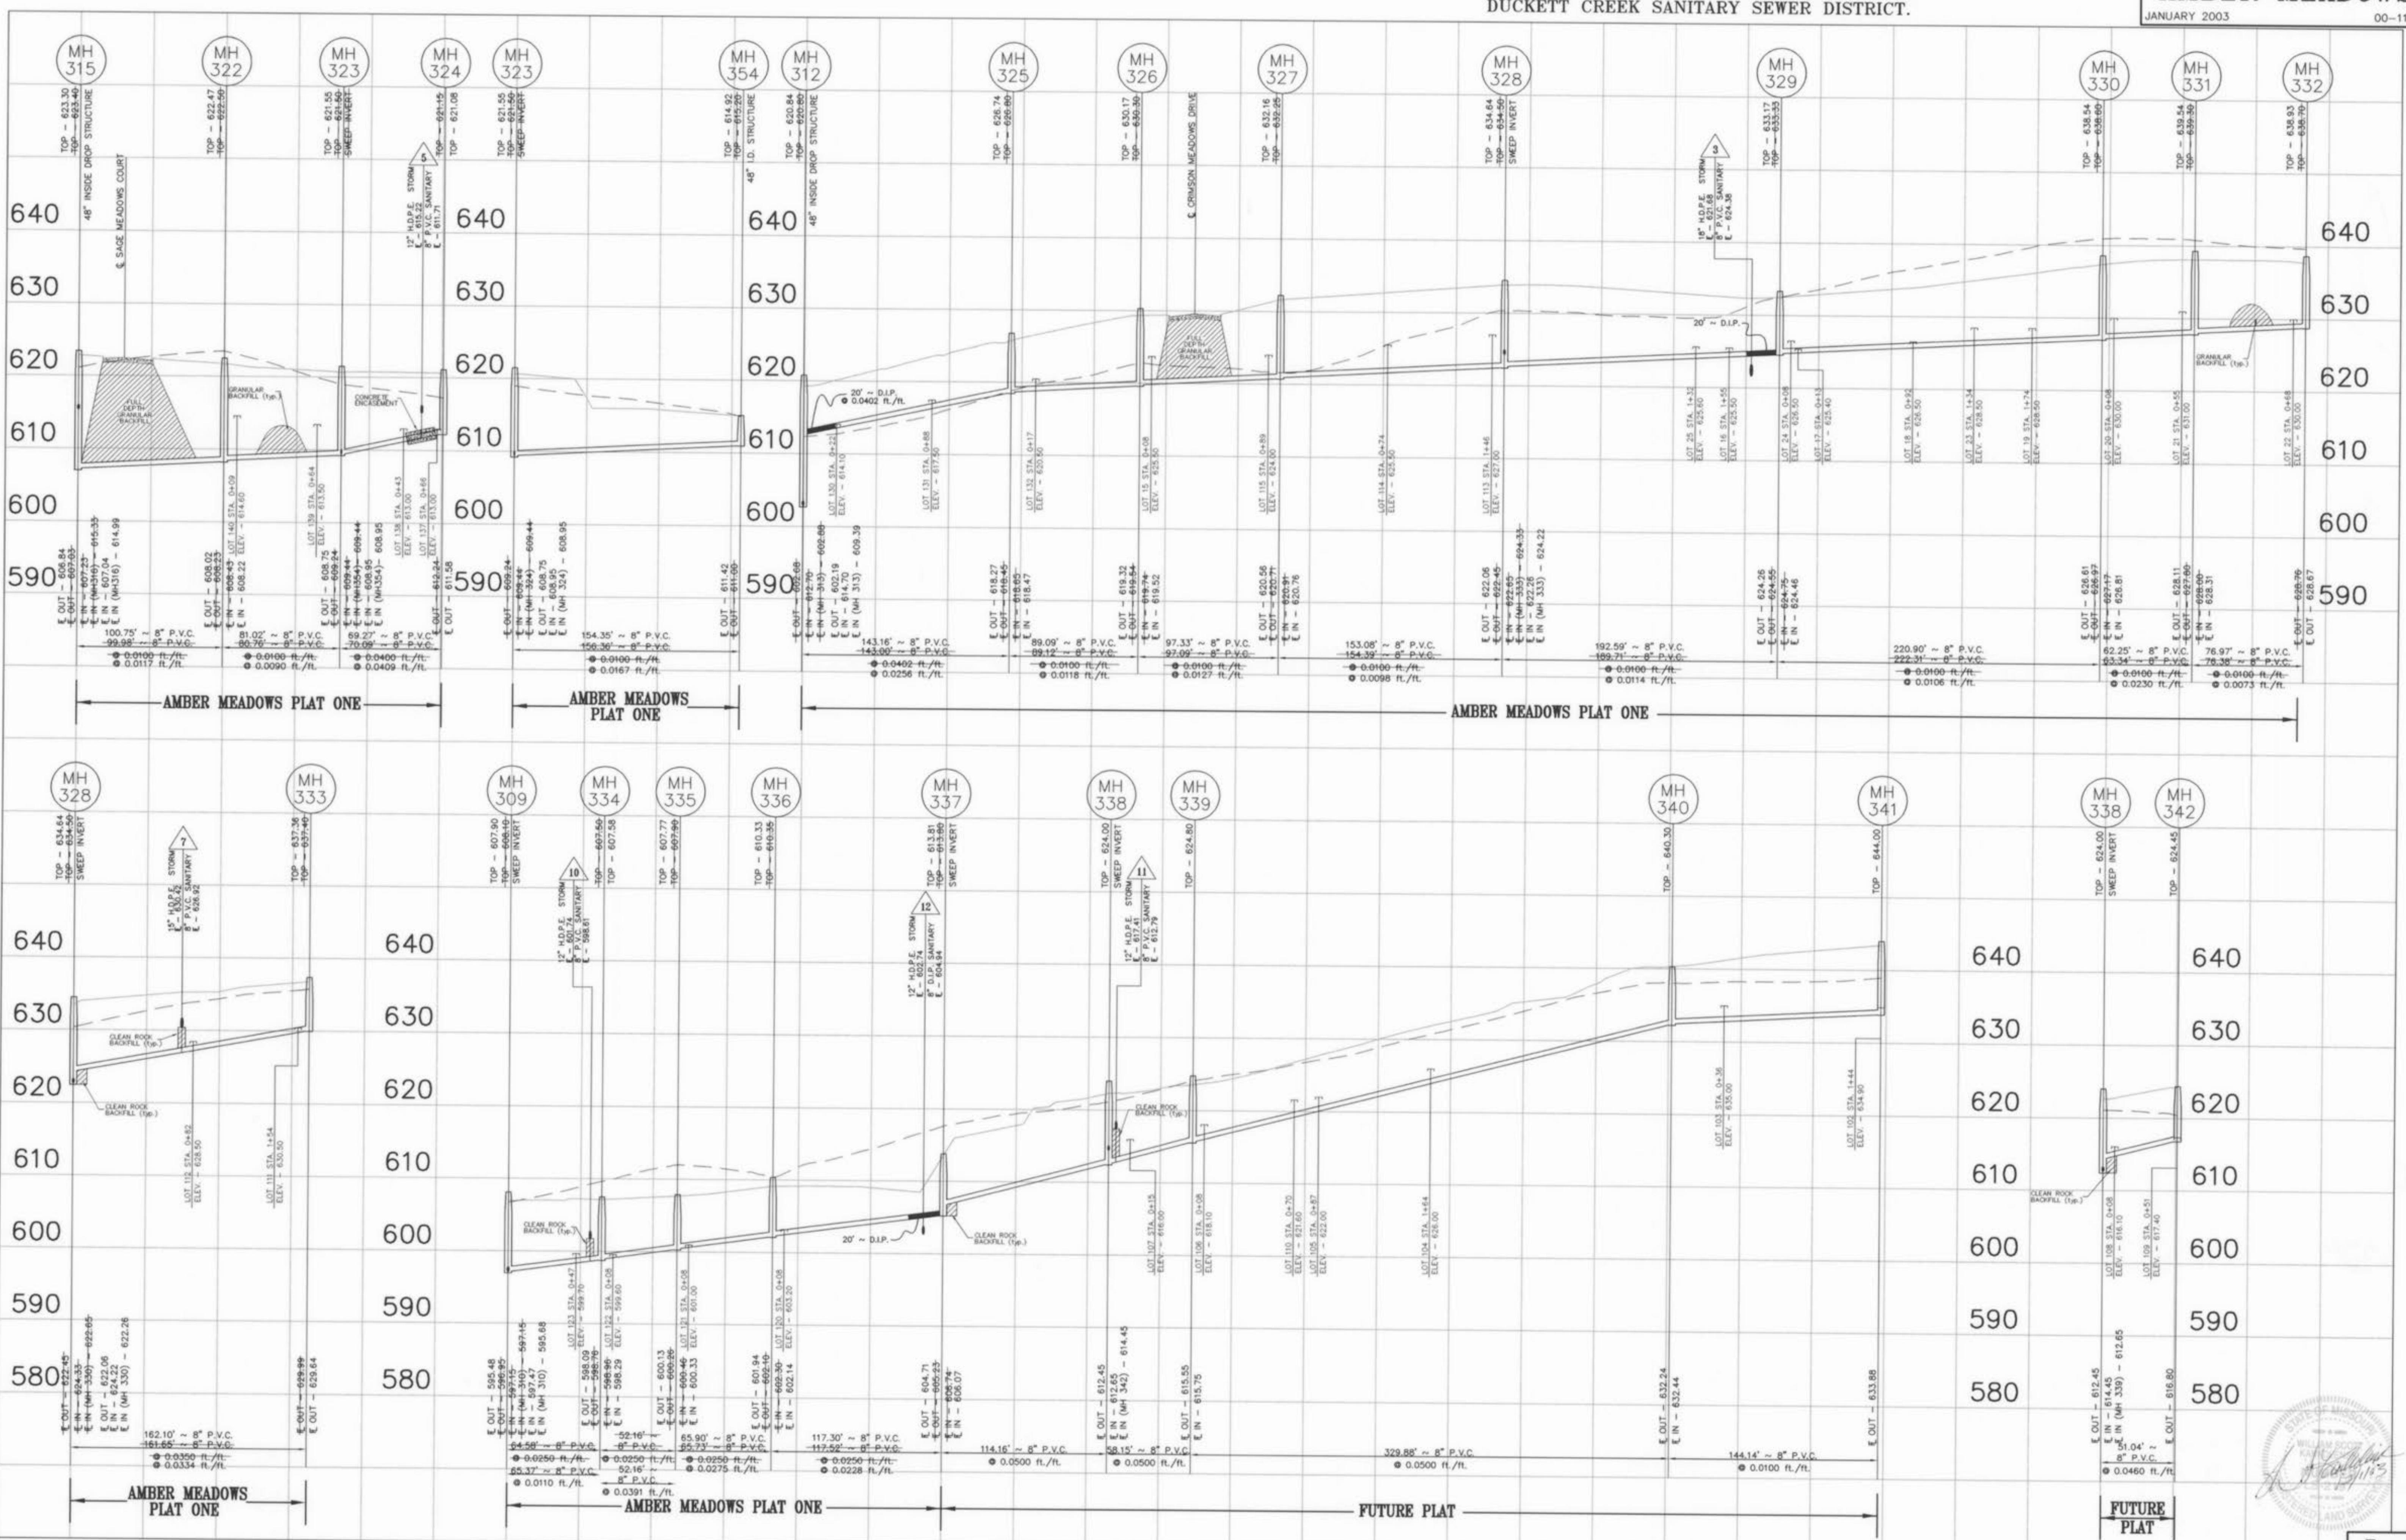

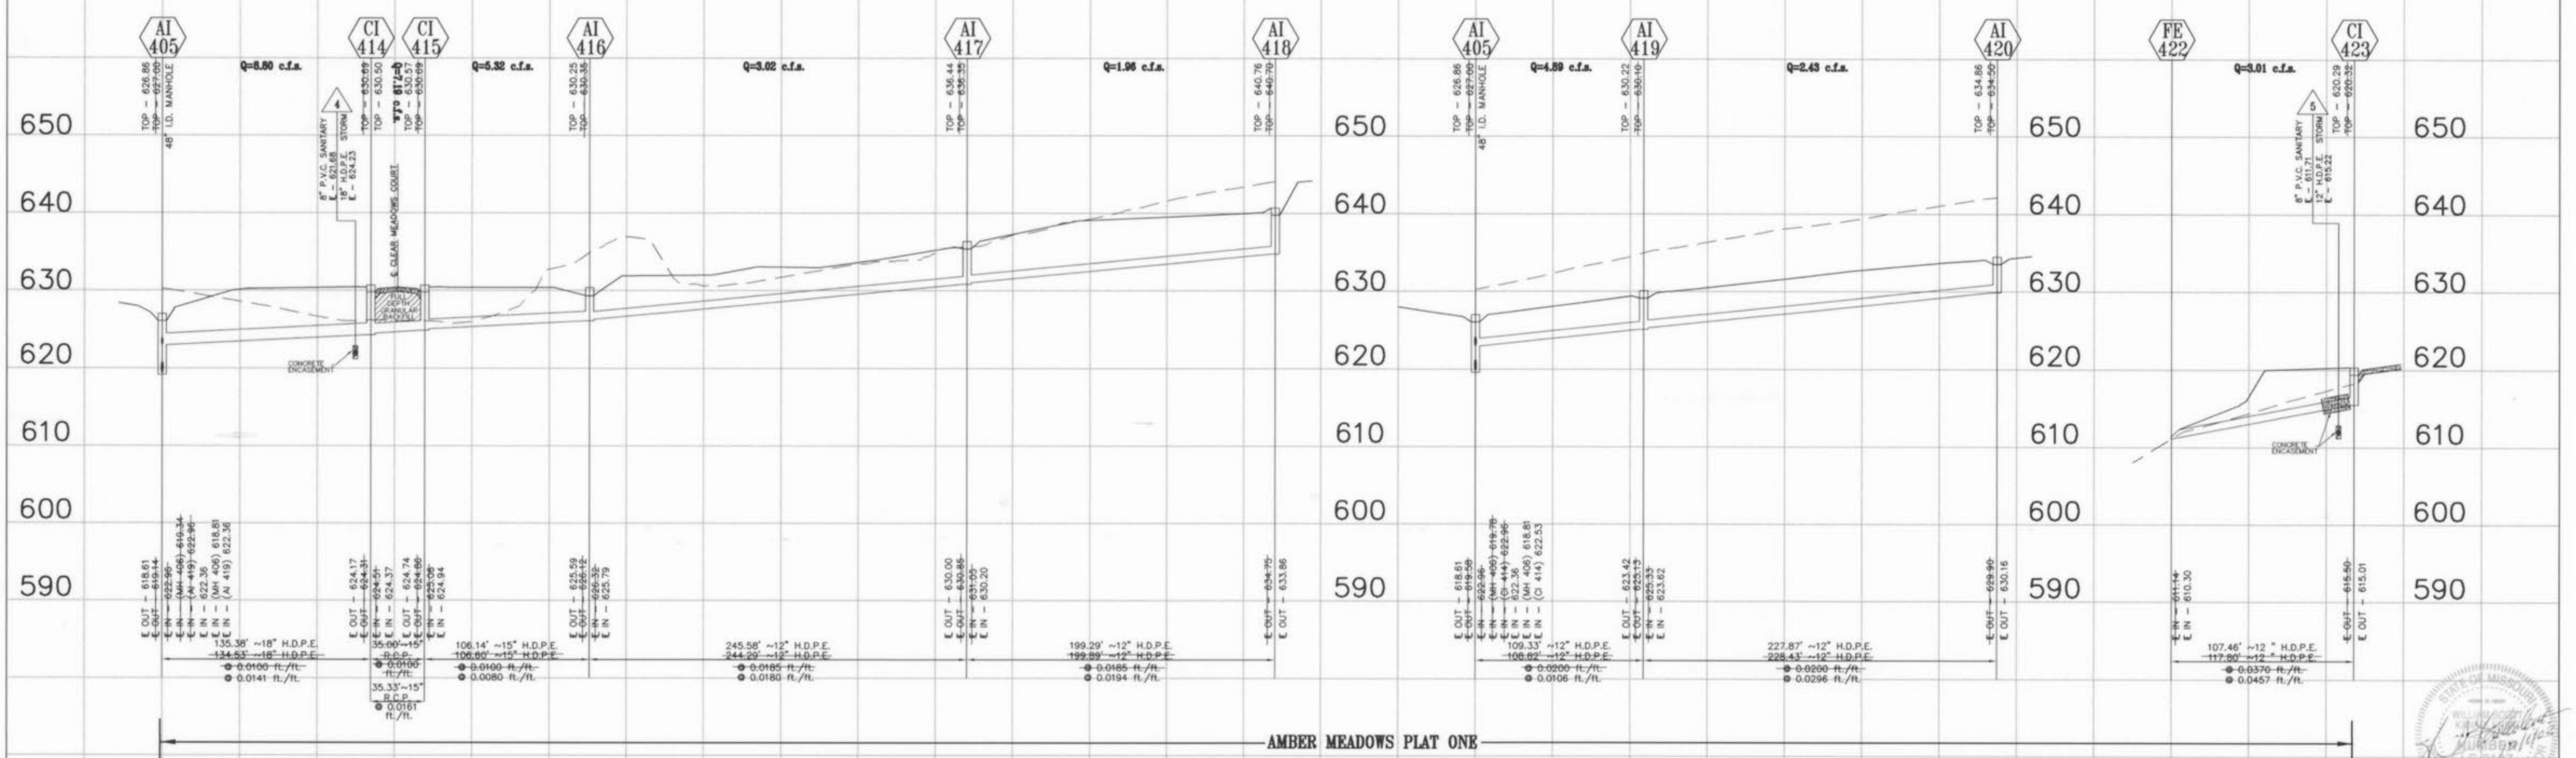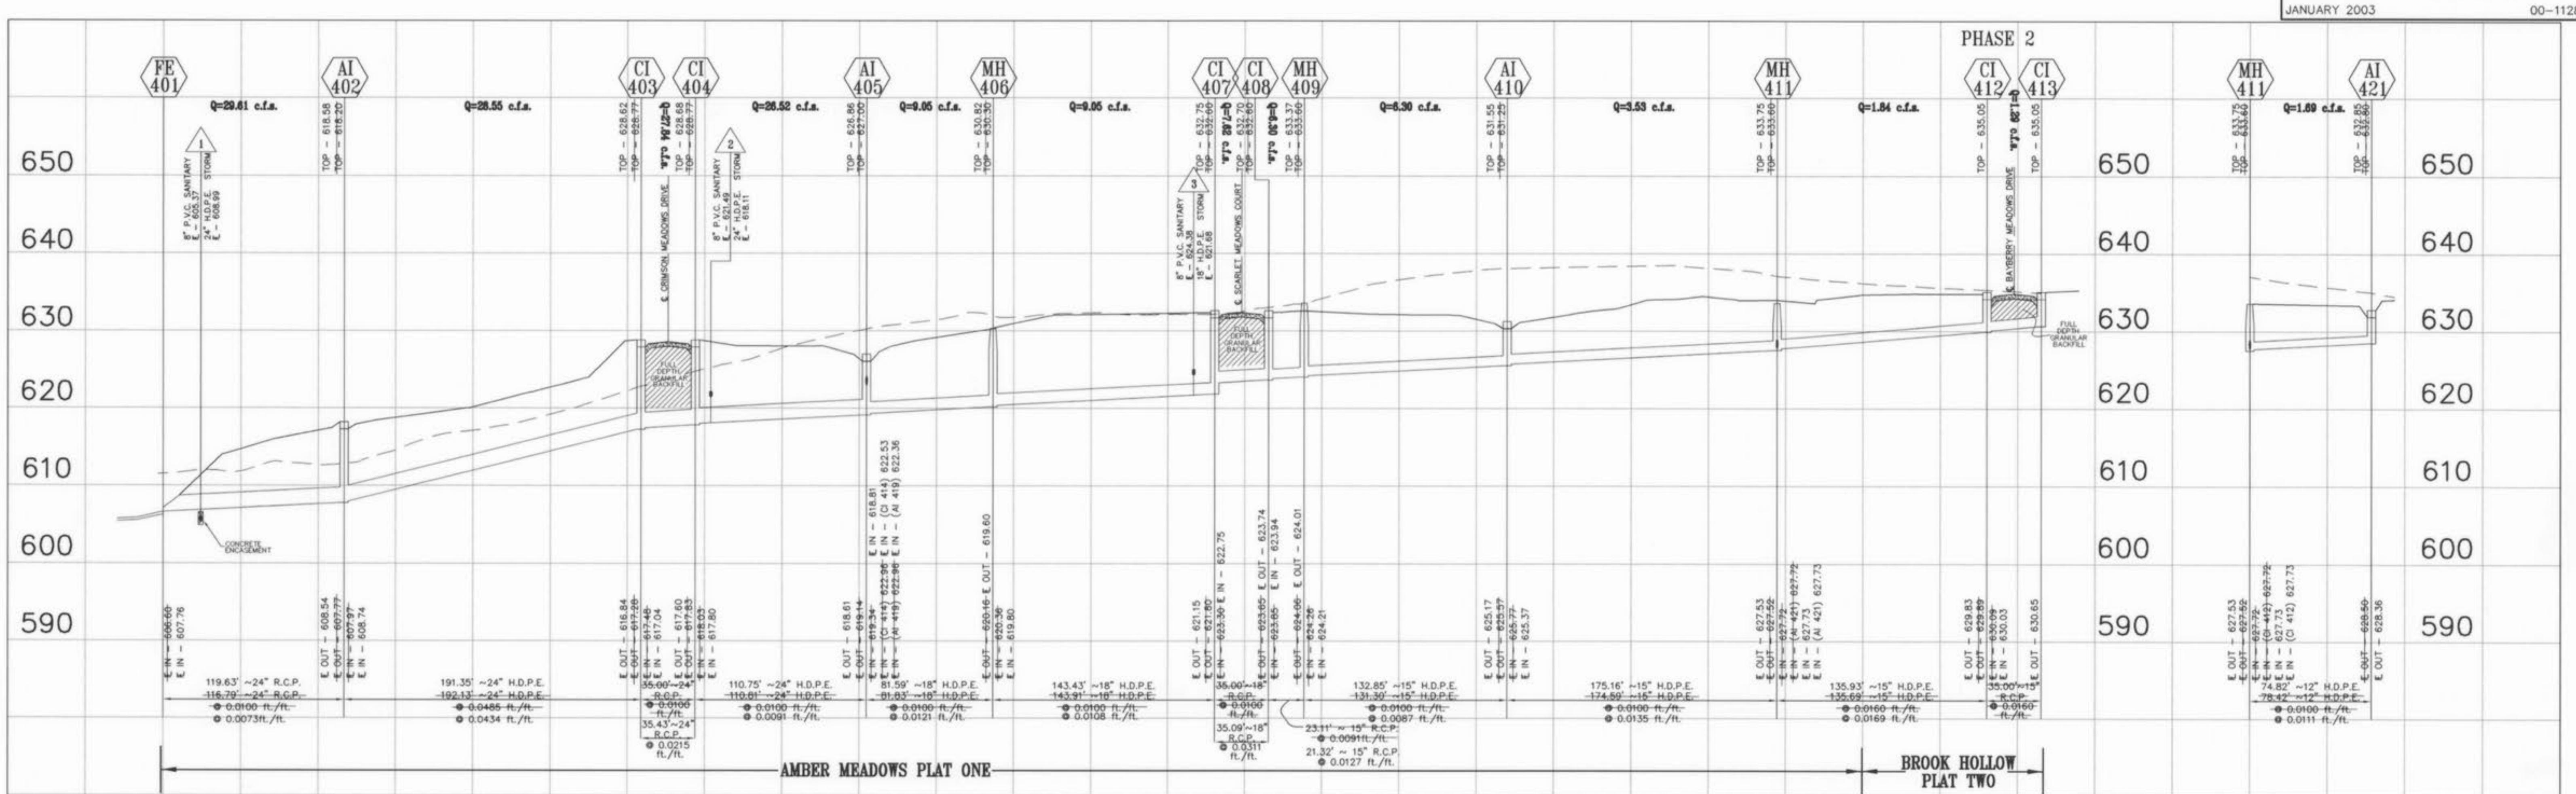

UNDERGROUND UTILITIES HAVE BEEN PLOTTED FROM AVAILABLE INFORMATION AND THEREFORE THEIR LOCATIONS SHALL BE CONSIDERED APPROXIMATE ONLY. THE VERIFICATION OF THE LOCATION OF ALL UNDERGROUND UTILITIES, EITHER SHOWN OR NOT SHOWN ON THESE PLANS SHALL BE THE RESPONSIBILITY OF THE CONTRACTOR, AND SHALL BE LOCATED PRIOR TO ANY GRADING OR CONSTRUCTION OF THE IMPROVEMENTS.


AS-BUILT ADDED JANUARY 2003

SCALE:  
VERTICAL = 1" = 10'  
HORIZONTAL = 1" = 50'

6  
9


Amber Meadows Plat 1  
As Built



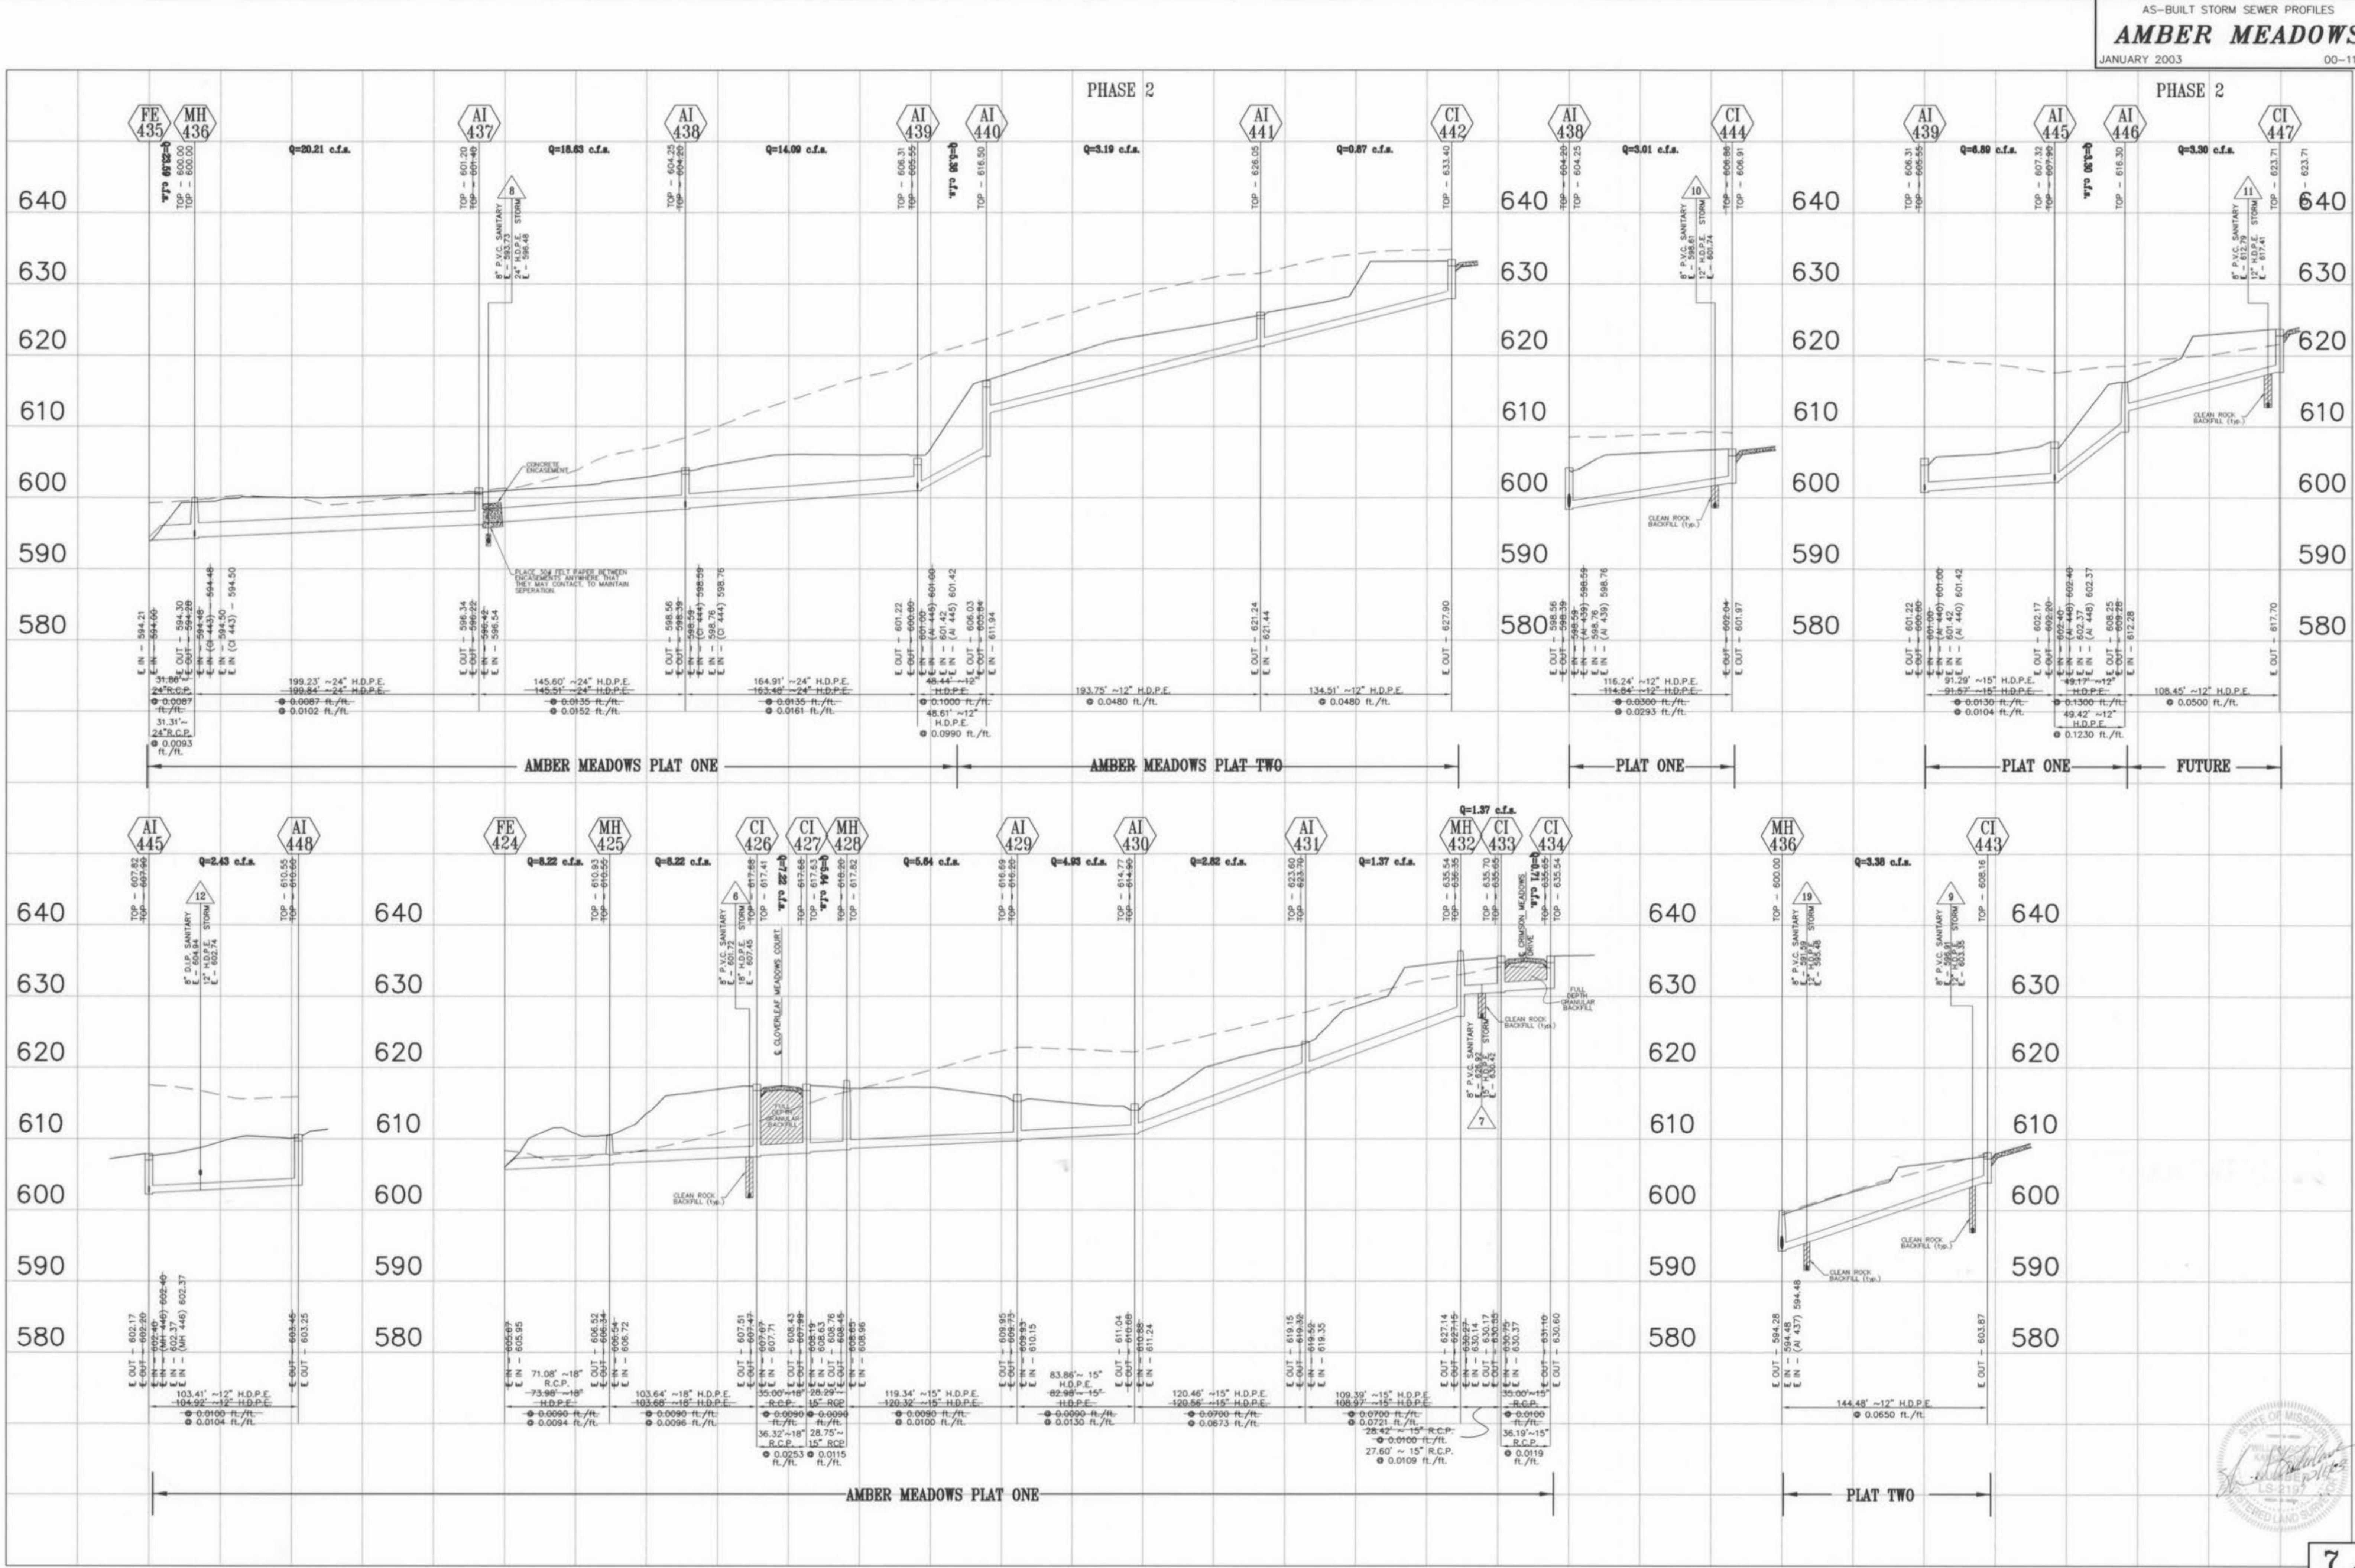


STATE OF MISSOURI  
KATHY KELLY  
REGISTERED LAND SURVEYOR  
LS-2187

7  
9  
AS-BUILT ADDED JANUARY 2003  
Amber Meadows Plat As Built

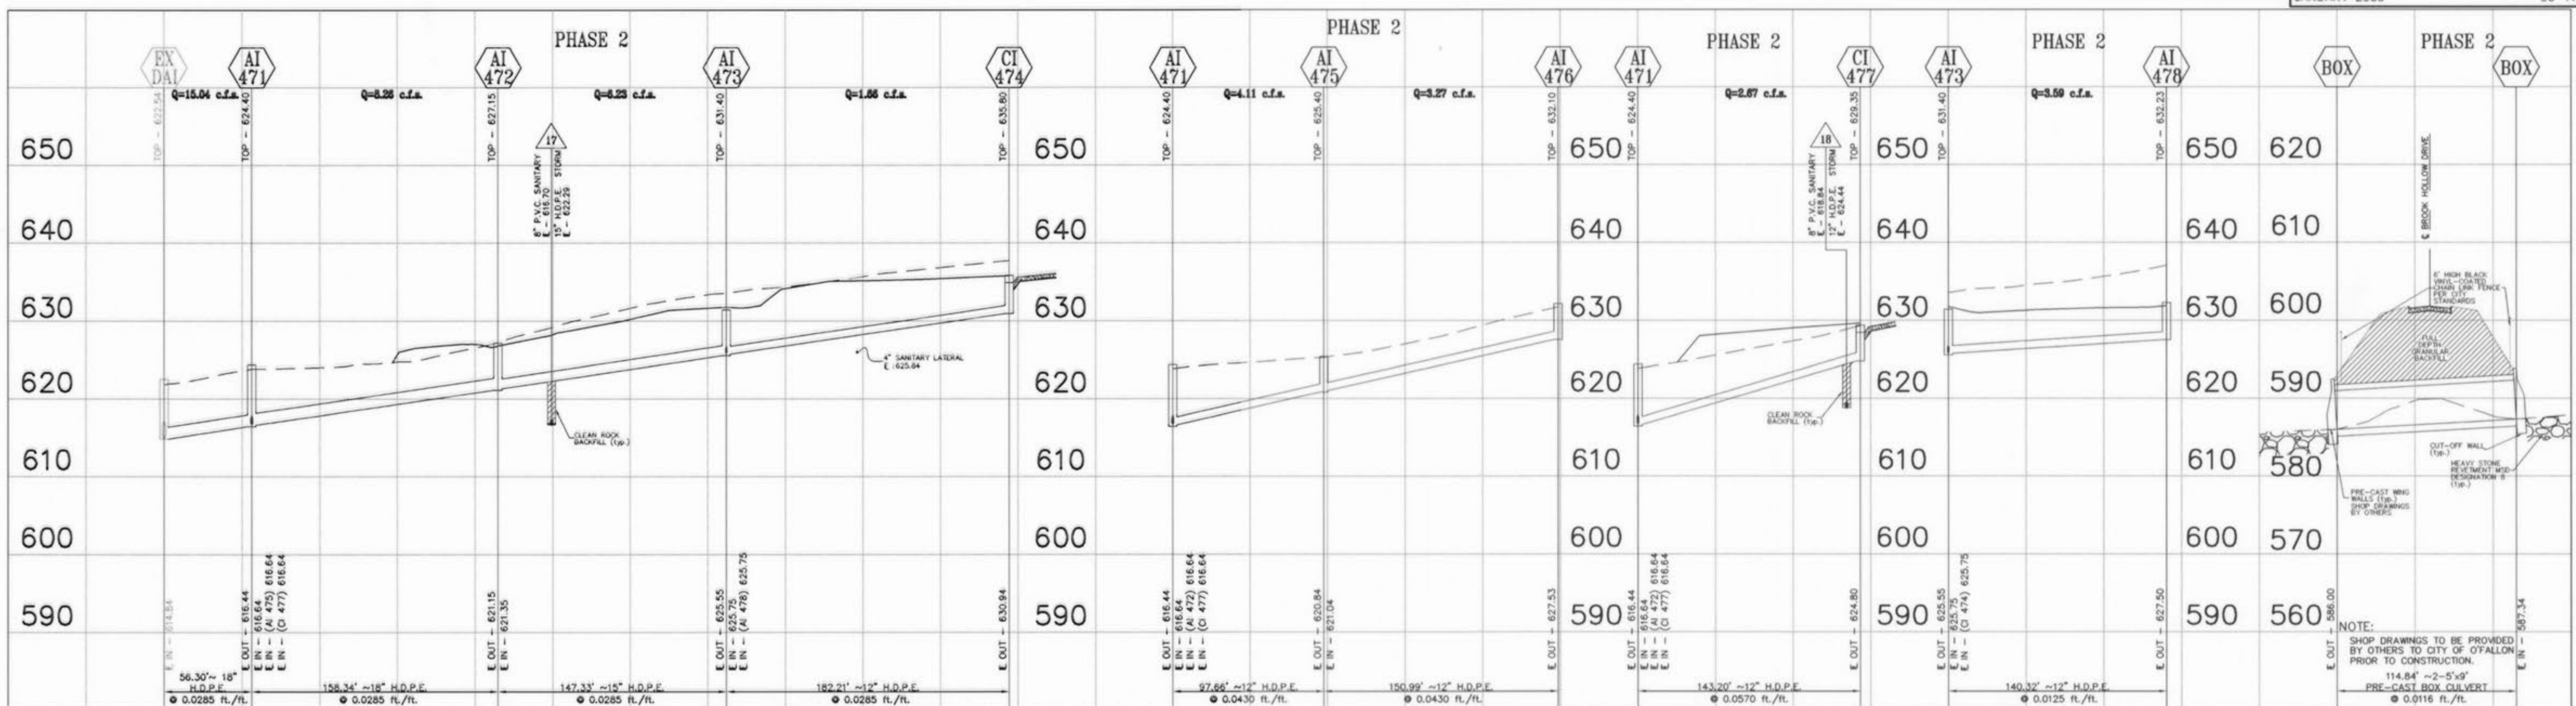

PHASE 2

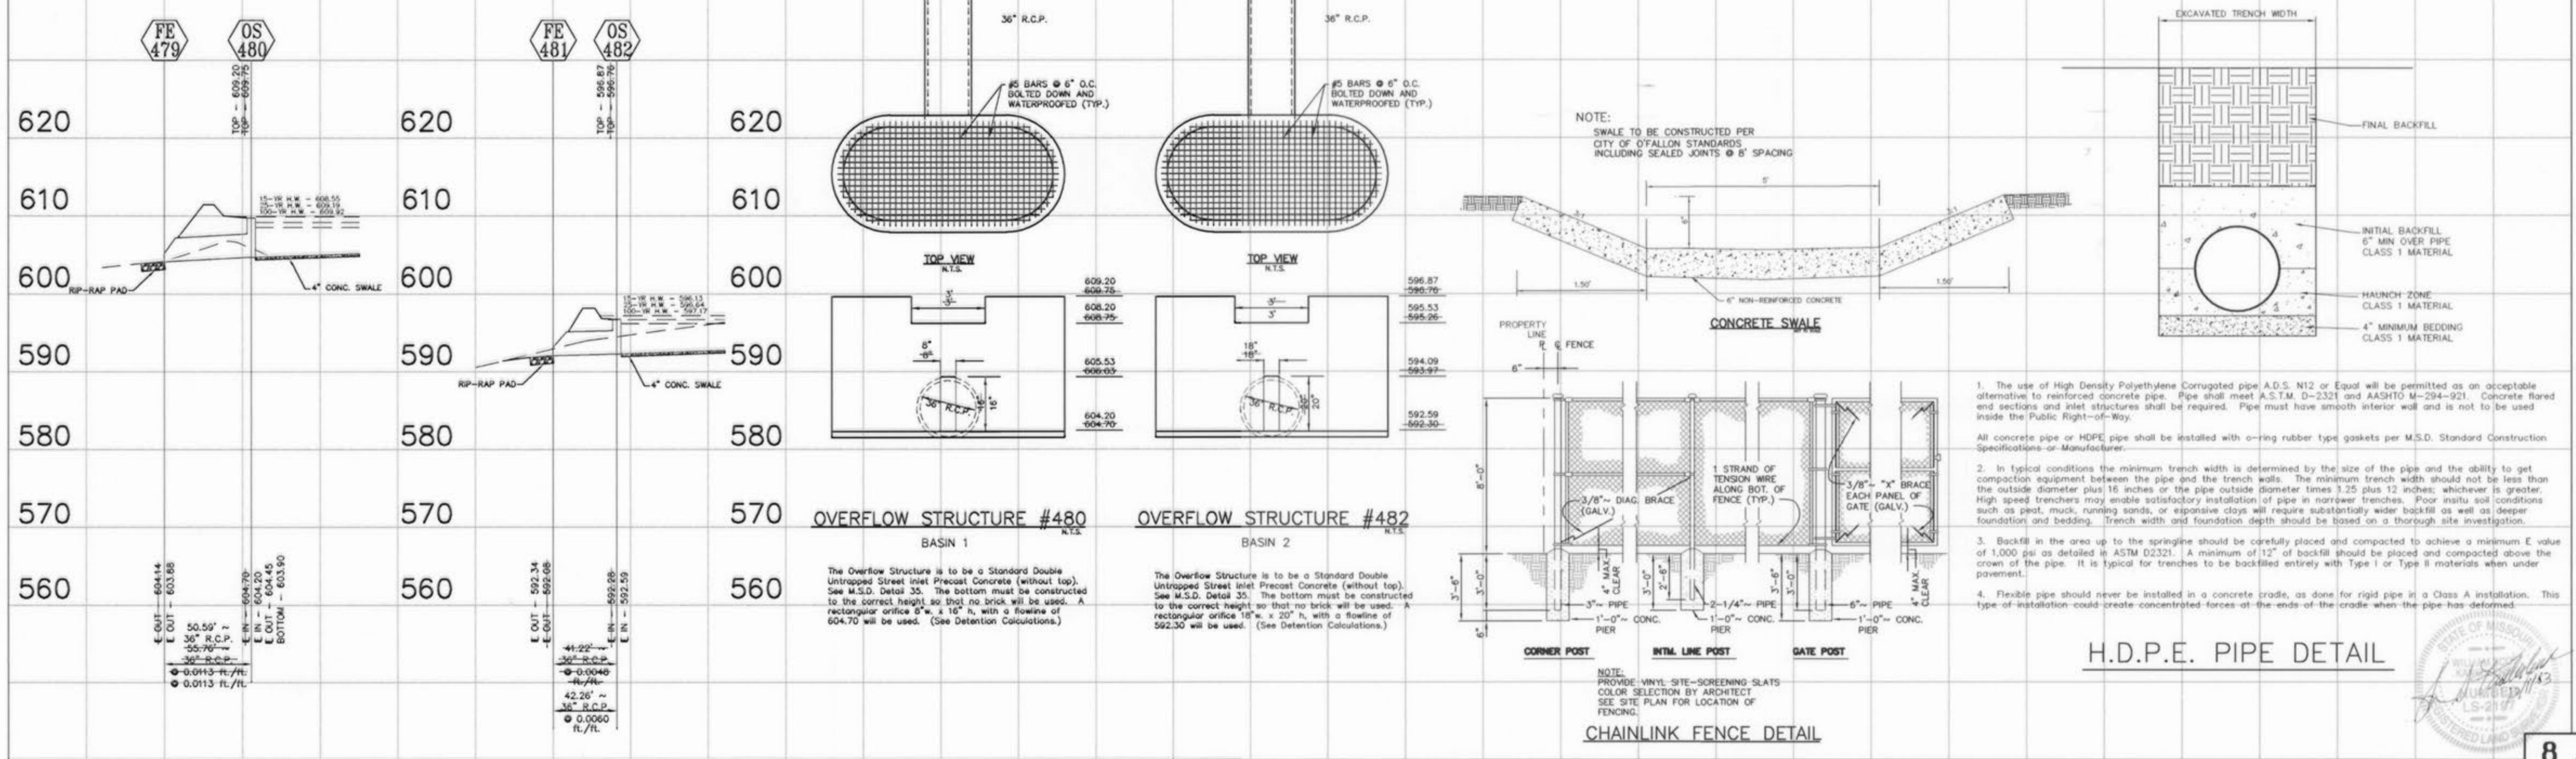




UNDERGROUND UTILITIES HAVE BEEN PLOTTED FROM AVAILABLE INFORMATION AND THEREFORE THEIR LOCATIONS SHALL BE CONSIDERED APPROXIMATE ONLY. THE VERIFICATION OF THE LOCATION OF ALL UNDERGROUND UTILITIES, EITHER SHOWN OR NOT SHOWN ON THESE PLANS SHALL BE THE RESPONSIBILITY OF THE CONTRACTOR AND SHALL BE LOCATED PRIOR TO ANY GRADING OR CONSTRUCTION OF THE IMPROVEMENTS.

10. The following table shows the number of hours worked by each employee in a company.


SCALE:  
VERTICAL = 1" = 10'  
HORIZONTAL = 1" = 50'

## D.P.E. PIPE DETAIL

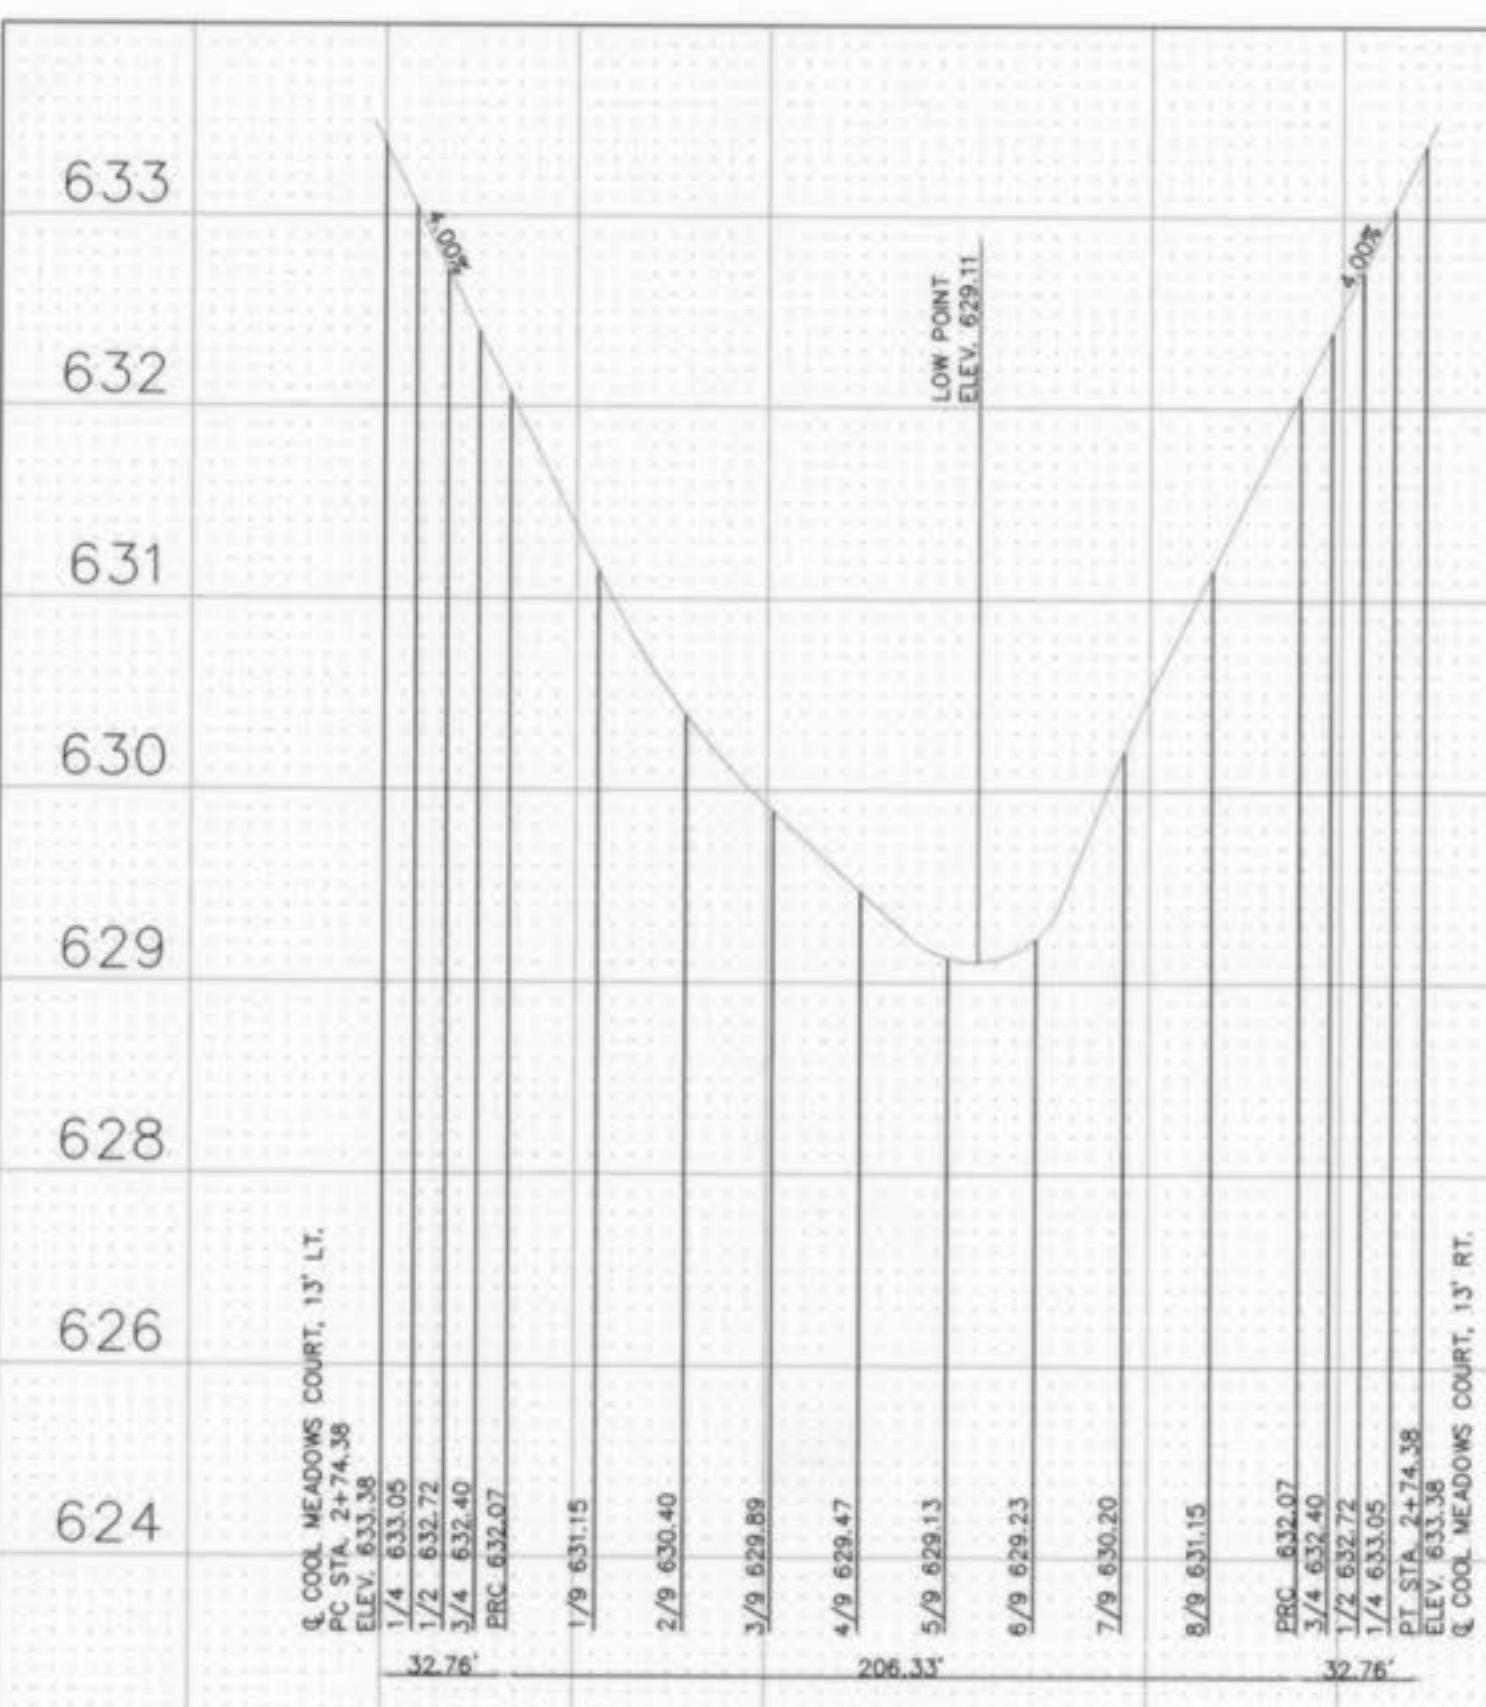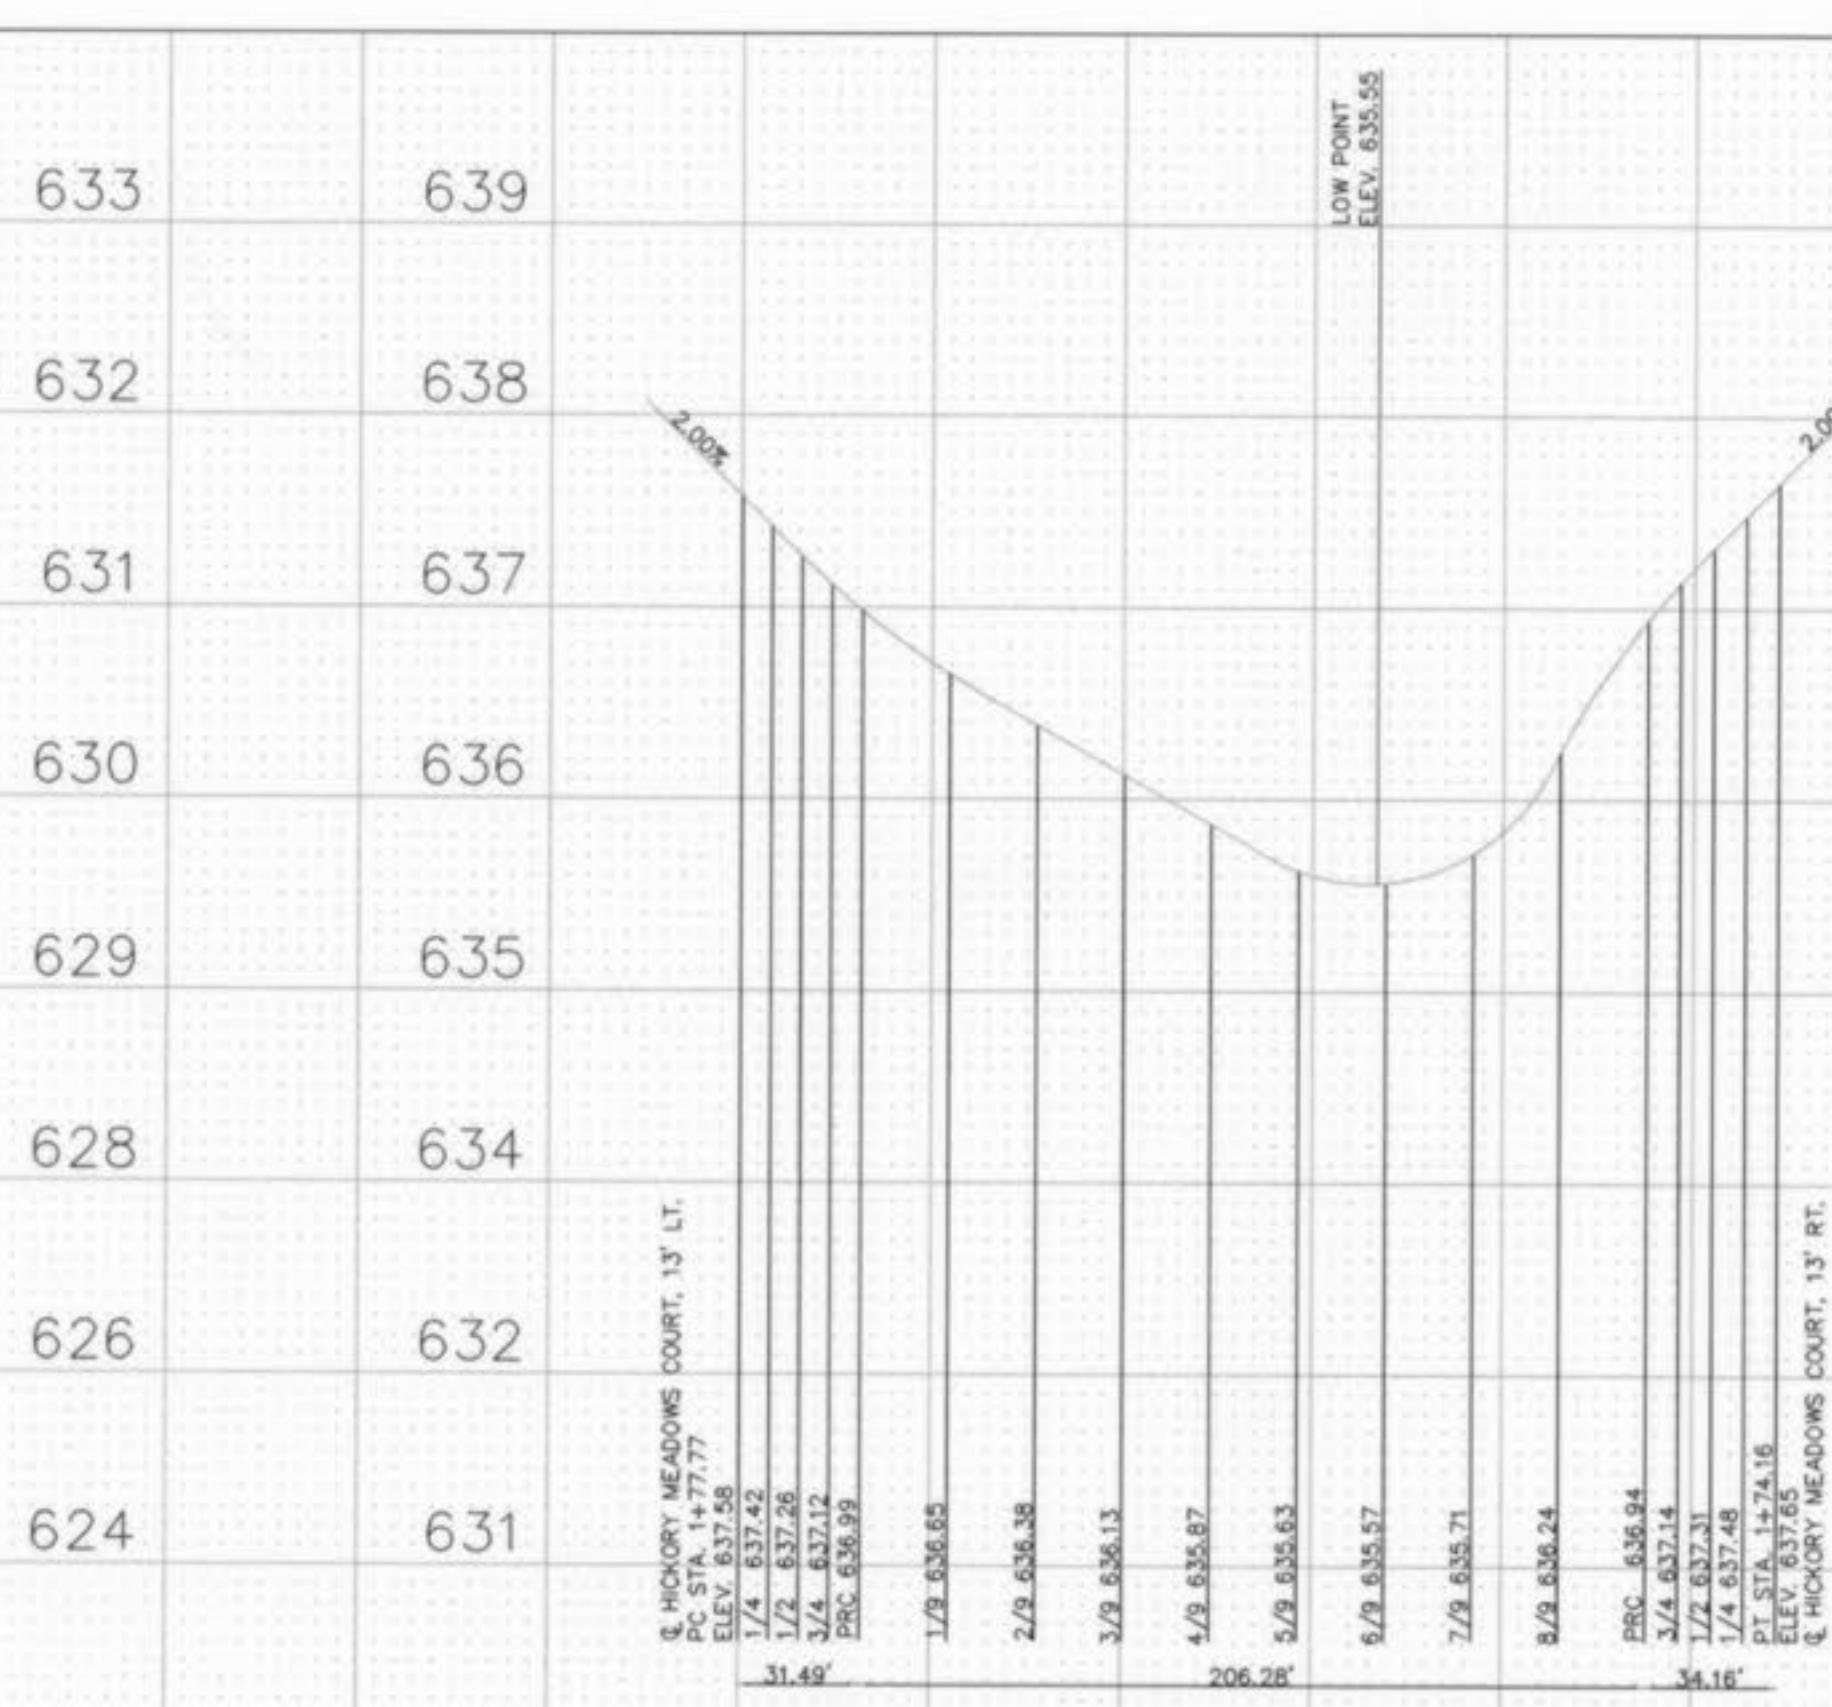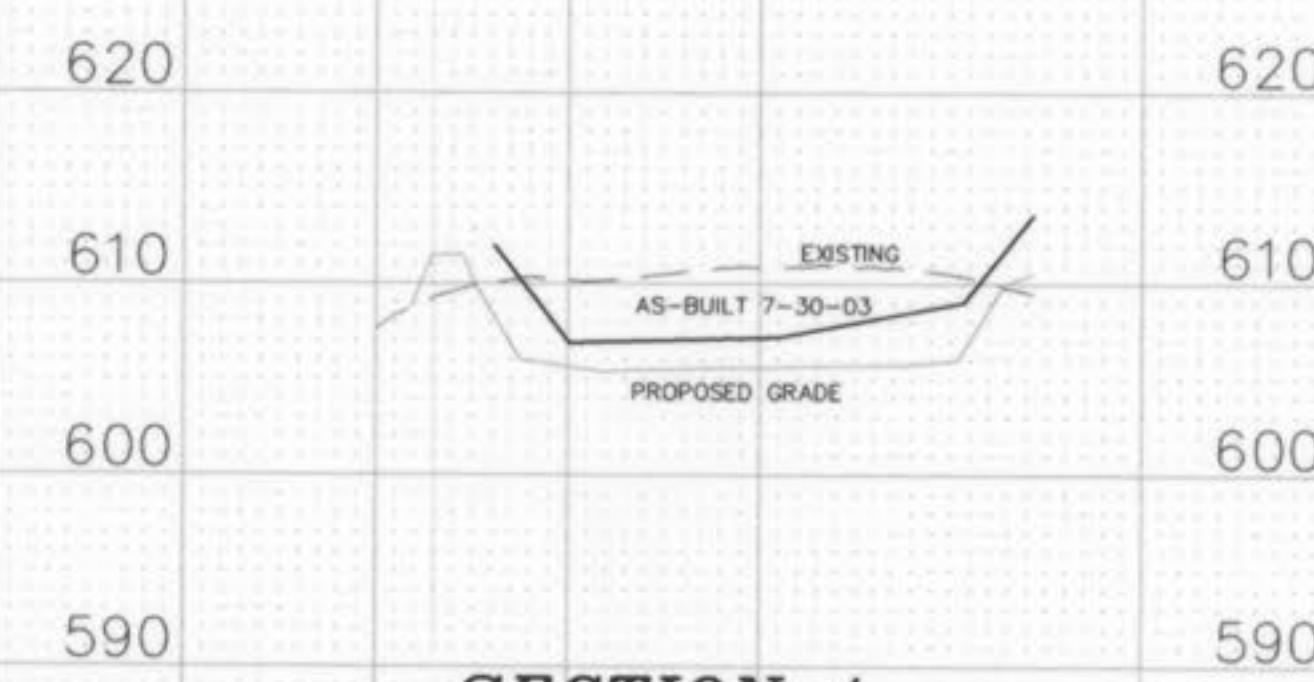


COOL MEADOWS COURT  
CUL-DE-SAC WARPING  
TOP OF CURB ELEVATIONHICKORY MEADOWS COURT  
CUL-DE-SAC WARPING  
TOP OF CURB ELEVATIONDETENTION BASIN  
CROSS SECTIONS

SECTION A

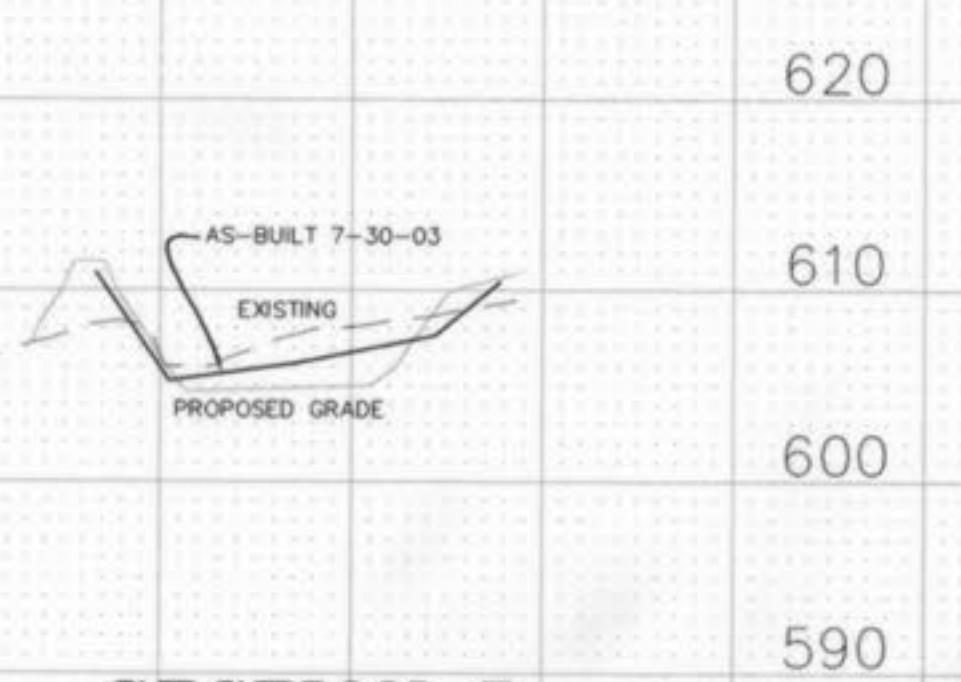


SECTION B

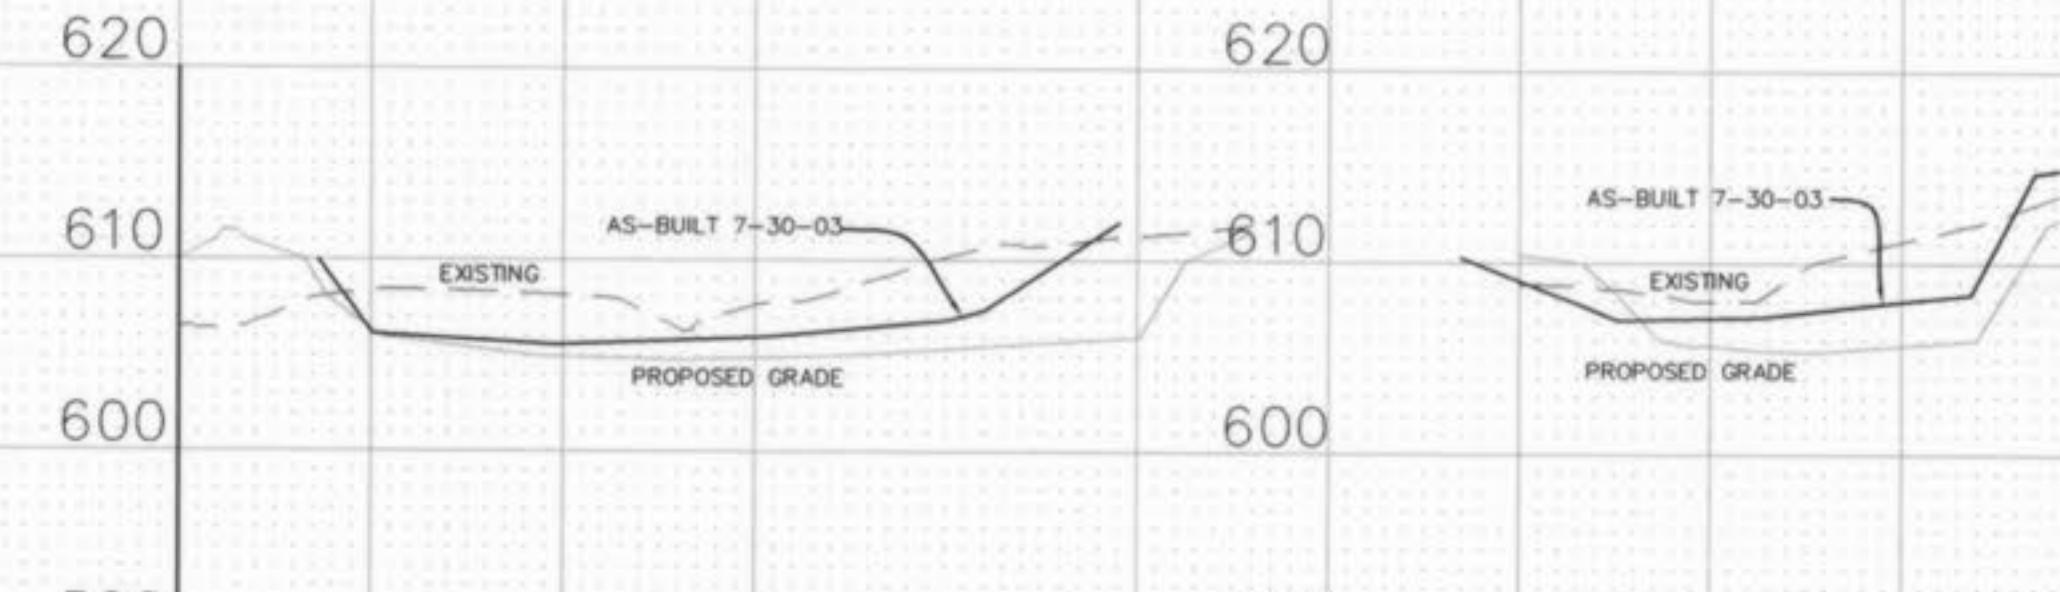

SCALE:  
VERTICAL = 1" = 10'  
HORIZONTAL = 1" = 50'

SECTION C

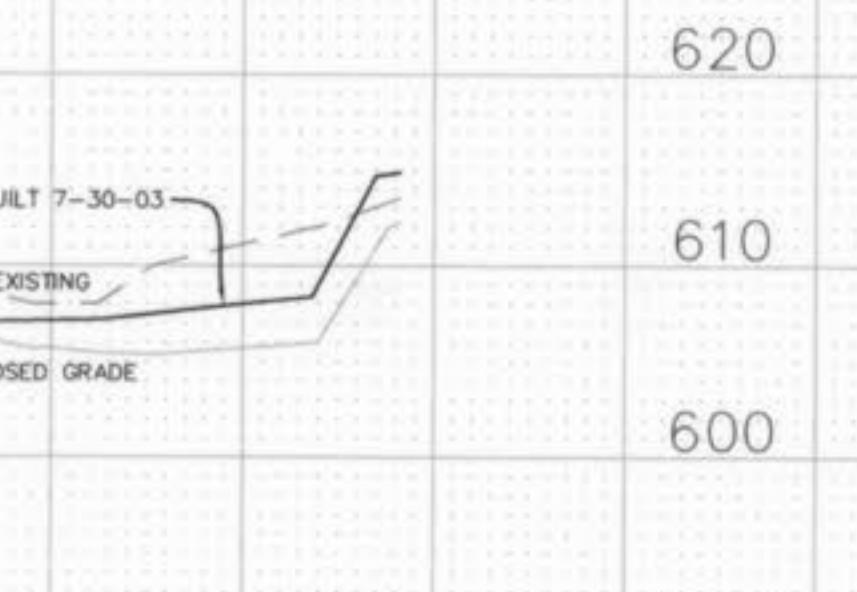

SECTION D

## BASIN 1

UNDERGROUND UTILITIES HAVE BEEN PLOTTED FROM AVAILABLE INFORMATION AND THEREFORE THEIR LOCATIONS SHALL BE CONSIDERED APPROXIMATE ONLY. THE VERIFICATION OF THE LOCATION OF ALL UNDERGROUND UTILITIES, EITHER SHOWN OR NOT SHOWN ON THESE PLANS SHALL BE THE RESPONSIBILITY OF THE CONTRACTOR, AND SHALL BE LOCATED PRIOR TO ANY GRADING OR CONSTRUCTION OF THE IMPROVEMENTS.

ALL SANITARY SEWER LATERAL TAILSTAKE ELEVATIONS HAVE BEEN DESIGNED FOR AN 8.0' BASEMENT POUR IN HOMES WITH THE TOP OF FOUNDATION ELEVATION BEING SET 2.5' ABOVE THE TOP OF CURB ELEVATION AT THE DRIVEWAY.

SCALE:  
VERTICAL = 1" = 10'  
HORIZONTAL = 1" = 50'

Amber Meadows Plat 1  
As Built



9  
9