

GRADING NOTES

- A Geotechnical Engineer shall be employed by the owner and be on site during grading operations. All soils tests shall be performed by the Geotechnical Engineer concurrent with the grading and backfilling operations.
- The grading contractor shall perform a complete grading and compaction operation as shown on the plans, stated in these notes, or reasonably implied there from, all in accordance with the plans and notes as interpreted by the Geotechnical Engineer.
- The Contractor shall notify the Soils Engineer at least two days in advance of the start of the grading operation.
- All areas shall be allowed to drain. All low points shall be provided with temporary ditches.
- A sediment control plan that includes monitored and maintained sediment control basins and/or straw bales should be implemented as soon as possible. No graded area is to be allowed to remain bare without being seeded and mulched. Care should be exercised to prevent soil from damaging adjacent property and siting up existing downstream storm drainage system.
- Debris and foundation material from any existing on-site building or structure which is scheduled to be razed for this development must be disposed of off-site.
- All trash and debris on site, either existing or from construction, must be removed and properly disposed of off-site.
- Soft soil in the bottom and banks of any existing or former pond sites or tributaries or on any sediment basins or traps should be removed, spread out and permitted to dry sufficiently to be used as fill. None of this material should be placed in proposed public right-of-way locations or on any storm sewer locations.
- Site preparation includes the clearance of all stumps, trees, bushes, shrubs, and weeds; the grubbing and removal of roots and other surface obstructions from the site; and the demolition and removal of any man-made structures. The material shall be properly disposed of off-site. Topsoil and grass in the fill areas shall be thoroughly disced prior to the placement of any fill. The Soils Engineer shall approve the discing operation.
- Compaction equipment shall consist of tamping rollers, pneumatic-tired rollers, vibratory roller, or high speed impact type drum rollers acceptable to the Soils Engineer. The roller shall be designed so as to avoid the creation of a layered fill without proper blending of successive fill layers.

1. The Soils Engineer shall observe and test the placement of the fill to verify that specifications are met. A series of fill density tests will be determined on each lift of fill. Interim reports showing fill quality will be made to the Owner at regular intervals.

2. The Soils Engineer shall notify the Contractor of rejection of a lift of fill or portion thereof. The Contractor shall rework the rejected portion of fill and obtain notification from the Soils Engineer of its acceptance prior to the placement of additional fill.

3. All areas to receive fill shall be scarified to a depth of not less than 6 inches and then compacted in accordance with the specifications given below. Natural slopes steeper than 1 vertical to 5 horizontal to receive fill shall have horizontal benches, cut into the slopes before the placement of any fill. The width and height to be determined by the Soils Engineer. The fill shall be loosely placed in horizontal layers not exceeding 8 inches in thickness and compacted in accordance with the specifications given below. The Soils Engineer shall be responsible for determining the acceptability of soils placed. Any unacceptable soils placed shall be removed at the Contractor's expense.

4. The sequence of operation in the fill areas will be fill, compact, verify acceptable soil density, and repetition of the sequence. The acceptable moisture contents during the filling operation are those at which satisfactory dry densities can be obtained. The acceptable moisture contents during the filling operation in the remaining areas are from 2 to 8 percent above the optimum moisture control.

5. The surface of the fill shall be finished so that it will not impound water. If at the end of a day's work it would appear that there may be rain prior to the next working day, the surface shall be finished smooth. If the surface has been finished smooth for any reason, it shall be scarified before proceeding with the placement of succeeding lifts. Fill shall not be placed on frozen ground, nor shall filling operations continue when the temperature is such as to permit the layer under placement to freeze.

6. Fill and backfill should be compacted to the criteria specified in the following table:

CATEGORY	MATERIAL	MINIMUM PERCENT COMPACTON
Fill in building areas below footings		90%
Fill under slabs, walks, and pavement		90%
Fill other than building areas		88%
Natural subgrade		88%
Pavement subgrade		90%
Pavement base course		90%

Measured as a percent of the maximum dry density as determined by modified Proctor Test (ASTM-D-1557).

Moisture content must be within 2 percent below or 4 percent above optimum moisture content if fill is deeper than 10 feet.

A SET OF AS-BUILT PLANS FOR **AMBER MEADOWS** PLAT THREE

A TRACT OF LAND BEING PART OF FRACTIONAL SECTION 6, TOWNSHIP 46 NORTH, RANGE 3 EAST OF THE FIFTH PRINCIPAL MERIDIAN, CITY OF O'FALLON, ST. CHARLES COUNTY, MISSOURI

GENERAL NOTES

- Underground utilities have been plotted from available information and therefore their locations shall be considered approximate only. The verification of the location of all underground utilities, either shown or not shown on these plans shall be the responsibility of the contractor, and shall be located prior to any grading or construction of the improvements.
- All manhole tops & flowlines built without elevations furnished by the Engineer will be the responsibility of the sewer contractor.
- 8" P.V.C. sanitary sewer pipe shall meet the following standards. A.S.T.M.-D-3034 SDR-35, with wall thickness compression joint A.S.T.M.-D-3212. An appropriate rubber seal watertight as approved by the sewer district shall be installed between P.V.C. pipe and masonry structures.
- All filled places, including trench backfills, under buildings, proposed storm and sanitary sewer lines and/or paved areas, shall be compacted to 90% maximum density as determined by the "Modified AASHTO T-180 Compaction Test," (A.S.T.M.-D-1557). All filled places within public roadways shall be compacted to 95% of maximum density as determined by the "Standard Proctor Test AASHTO T-99, Method C" (A.S.T.M.-D-698).
- All trench backfills under paved areas shall be granular backfill, and shall be compacted to 90% of the maximum density as determined by the "Modified AASHTO T-180 Compaction Test," (A.S.T.M.-D-1557). All other trench backfills may be earth material (free of large clogs or stones). All trench backfills shall be water jetted.
- All sanitary house connections have been designed so that the minimum vertical distance from the low point of the basement to the flow line of a sanitary sewer at the corresponding house connection is not less than the diameter of the pipe plus the vertical distance of 2 1/2 feet.
- No area shall be cleared without the permission of the Project Engineer.

- All construction and materials shall conform to the current construction standards of the City of O'Fallon and Duckett Creek Sanitary District.
- All sidewalks shall meet the guidelines set forth in the Americans with Disabilities Act.
- All existing areas disturbed during construction of the off-site sanitary sewer line shall be seeded and mulched to prevent erosion.

- All sanitary sewer laterals shall be a minimum of 4" in diameter per City of O'Fallon and Duckett Creek standards.
- No flushing hydrants or water meters shall be located in driveways and or walkways.
- Concrete pipe for storm sewers shall be Class III, A.S.T.M. C-76 with a minimum diameter of 12" except in the R.O.W. it shall be 15".
- The ADS N-12 pipe shall have a smooth interior wall.

- Easements shall be provided for sanitary sewers, and all utilities on the Record Plat. See Record Plat for location and size of easements.
- Maintenance and upkeep of the common ground area shall be the responsibility of the developer and/or successors.
- A 25' building line shall be established along all Public Rights-Of-Way.

- All water lines shall be laid at least 10 feet horizontally, from any sanitary sewer, storm sewer, or manhole. 18" vertical clearance from outside of pipe to outside of pipe shall be maintained wherever water lines must cross sanitary sewers, laterals, or storm drains the water line shall be laid at such an elevation that the bottom of the water line is above the top of the drain or sewer. A full length of water pipe shall be centered over the sewer line to be crossed so that the joints will be equally distant from the sewer and as remote therefrom as possible. This vertical separation shall be maintained for that portion of the water line located within 10 feet horizontally, of any sewer or drain it crosses.
- All PVC water pipe shall conform to A.S.T.M.-D-2241, SDR 21 Standard Specification for P.V.C. Pressure Pipe, 200 P.S.I. working pressure for water, with approved joint.

- Water lines, valves, sleeves, meters, and fittings shall meet all specifications and installation requirements of Public Water Supply District No. 2 of St. Charles County.
- All water hydrants and valves shall be ductile iron and installed in accordance with plans and details. All ductile iron pipe for water mains shall conform to A.W.W.A. Specifications C-106 and/or C-108. The ductile iron fittings shall conform to A.W.W.A. Specification CC-110. All rubber gasket joints for water ductile iron pressure pipe and fittings shall conform to A.W.W.A. Specification C-111.

- All sanitary manholes shall be waterproofed on the exterior in accordance with Missouri Department of Natural Resources specifications 10 CSR-B-120 (7E).
- Brick will not be used in the construction of sanitary sewer manholes.
- All pipes shall have positive drainage through manholes. No flat base structures are allowed.
- The City of O'Fallon and Duckett Creek Sanitary District shall be notified 48 hours prior to construction for coordination and inspection.

- Gas, water and other underground utilities shall not conflict with the depth or horizontal location of existing or proposed sanitary or storm sewers, including house laterals.
- All existing site improvements disturbed, damaged or destroyed shall be repaired or replaced to closely match pre-construction conditions.

- The contractor shall prevent all storm, surface water, mud and construction debris from entering the existing sanitary sewer system.

- All construction and materials shall conform to the current construction standards of the City of O'Fallon and Duckett Creek Sanitary District.

- All sanitary and storm sewer trench backfills shall be water jetted. Granular backfill will be used under pavement areas.



SHEET INDEX

- 1 COVER SHEET
2-3 SITE PLANS
4-5 SANITARY SEWER PROFILES
6-7 STORM SEWER PROFILES

CALL BEFORE YOU DIG!

1-800-DIG-RITE



LOCATION MAP
NOT TO SCALE

DEVELOPMENT NOTES

- Area of plat three Duckett area only: 12,211 Square Feet
- Existing Zoning: R-1 (City of O'Fallon)
Single Family Residential
- Proposed Use:
- Number of Lots Proposed: 33 Lots
- Area in Common Ground: 1.53 Acres
- Area in Right-of-Way: 2.40 Acres
- Area in Lots: 8.28 Acres
- Average Lot Area (not including common ground) 14,097 Square Feet
- Average Lot Area (including common ground) 16,117 Square Feet
- The proposed height and lot setbacks are as follows:
Minimum Front Yard: 25 feet
Minimum Side Yard: 6 feet
Minimum Rear Yard: 25 feet
Minimum Lot Area: 10,000 square feet
Maximum Height of Building: 2 1/2 stories or 35 feet
- Current Owner of Property:
First Land Company of St. Charles County, Inc.
P.O. Box 176
St. Peters, MO 63376

- Site is served by:
Duckett Creek & City of O'Fallon sewers AmerenUE
St. Charles Gas Company
St. Charles County P.W.S.D.No. 2
Verizon Telephone Company
Fort Zumwalt School District
O'Fallon Fire Protection District
- No Floodplain exists on this tract per F.I.R.M #29183C0240 E. dated Aug. 2, 1996.
- Topographic information is by Walker & Associates. Boundary information is per survey completed by Box Engineering in September of 2001.
- One tree shall be planted for every lot. Every corner lot shall have two street trees planted in the right-of-way.
- All local streets will be constructed to City of O'Fallon standards. Streets will consist of 26 foot wide concrete pavement with integral rolled curb centered in a 50 foot right-of-way. Minimum radius shall be 150 feet.
- All cul-de-sacs and bubbles will have pavement radii of 42 feet with right-of-way radii of 54 feet. Street intersections shall have a minimum rounding radius of 25 feet with pavement radii of 37 feet.
- Minimum street grades shall be 1%.
- A 4 foot wide concrete sidewalk shall be constructed on one side of streets where indicated.
- All homes shall have a minimum of 2 off-street parking places with 2-car garages.
- All proposed utilities must be located underground.
- The developer realizes that they will comply with current Tree Preservation Ordinance Number 1689 and provide landscaping as set forth in Article 23 of the City of O'Fallon Zoning Ordinances.
- Additional lighting may be required by the City of O'Fallon.
- The following lots are susceptible to street movement:
79 & 80, 71 & 72
- Tree Preservation Calculations:
Existing trees 11.49 acres
x 20% 2.30 acres
Saved trees 4.20 acres
Trees removed 7.29 acres

- Landscape Requirements
1 Tree per lot & 2 trees per corner lot = 165 Trees provided = 178
- Detention for this development to be provided in detention basins. All existing creeks to remain shall be enclosed within a stormwater discharge easement. The width of which to be specified by the size of the water shed drained by the creek and to be determined during the improvement plan approval process.
- Per section 405.120 of the O'Fallon City Code, written verification compliance with the construction plans shall be required by the developer.
- Proposed rip-rap pads to be evaluated following installation to determine if pad is of sufficient size to prevent erosion.

- Street trees to have a minimum of 2" caliper per O'Fallon standards. Species to be selected by homebuilder from O'Fallon Tree Planting Guide. Street trees to be maintained by the Home Owner's Association per subdivision C.C. & R.'s.
- Where disturbance occurs within the 60' wide drainage easement during construction, the area will be heavily revegetated following completion of project.

- REVISIONS
Copyright 2004
Box Engineering Company, Inc.
All Rights Reserved

AMBER MEADOWS PLAT THREE DUCKETT CREEK SUBMITTAL
PREPARED FOR:
FIRST LAND COMPANY OF ST. CHARLES COUNTY, INC.
P.O. BOX 176
ST. PETERS, MISSOURI
(636) 928-4988



1052 South Cloverleaf Drive
St. Peters, MO 63376-6445
314-928-5552
FAX 928-1718


7-21-03
DATE
00-11289
PROJECT NUMBER
1 7
SHEET OF
11289AASB3.DWG
FILE NAME
ECF
DRAWN CHECKED
AS-BUILTS NOTE:
ALL DISTANCE AND SLOPE CALCULATIONS ARE FROM CENTER OF STRUCTURE TO CENTER OF STRUCTURE.

AS-BUILTS ADDED JULY, 2004



LS-2197
DATE

Ambermeadows plat 3 App Aug 27/04 JK

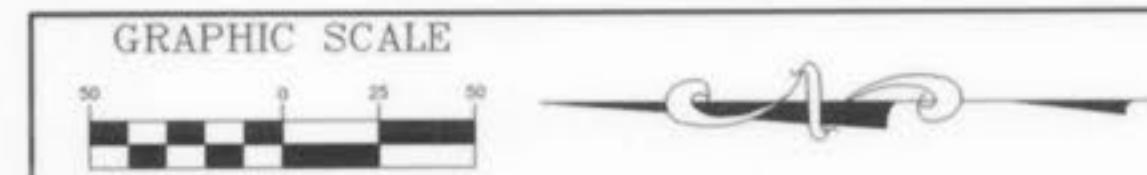

Blow-off hydrants and water meters shall not be located in any pavement or hard surfaced areas including, but not limited to, driveways, sidewalks, walkways, and streets. Since the location of all such areas is not shown on this plan all costs to relocate any blow-off hydrants and water meters from any pavement or hard-surfaced areas shall be borne by the Developer or the builder.

SITE PLAN
AMBER MEADOWS
JULY 21, 2004
00-11289

\DWG\A11289\PLTS\11289-FEISE ROAD TRACT\Sur\rey\Abull\plat\AmberMeadows.dwg, Layout1, 8/27/2004 3:46:30 PM, Sta. 54 UGC
Underground utilities have been plotted from available information and, therefore, their locations shall be considered approximate only. The verification of the location of all underground utilities, either shown or not shown, on these plans shall be the responsibility of the Contractor, and shall be located prior to any grading or construction of the improvements.

Note: Street trees shown are to be installed upon completion of home site by homeowner in conjunction with sidewalk installation.

AS-BUILTS ADDED JULY, 2004

These engineering plans have been prepared at the request of the developer for construction with some rock data, but not sufficient enough to determine the exact location of all existing rock conditions.

If existing rock conditions are encountered during construction it shall be the responsibility of the developer and/or his contractor to contact Box Engineering Co., Inc. and the soils engineer for the project at the time of encounter to determine the best design to continue construction.

GRAPHIC SCALE


 (- IN FEET -)
 1 inch = 50 ft.

Blow-off hydrants and water meters shall not be located in any pavement or hard surfaced areas including, but not limited to, driveways, sidewalks, walkways, and streets. Since the location of all such areas is not shown on this plan all costs to relocate any blow-off hydrants and water meters from any pavement or hard-surfaced areas shall be borne by the developer or the builder.


SITE PLAN
AMBER MEADOWS
 JULY 21, 2004
 00-11289



NOTE: ALL SANITARY SEWER ON THIS SHEET WITHIN
DUCKETT CREEK SANITARY SEWER DISTRICT.

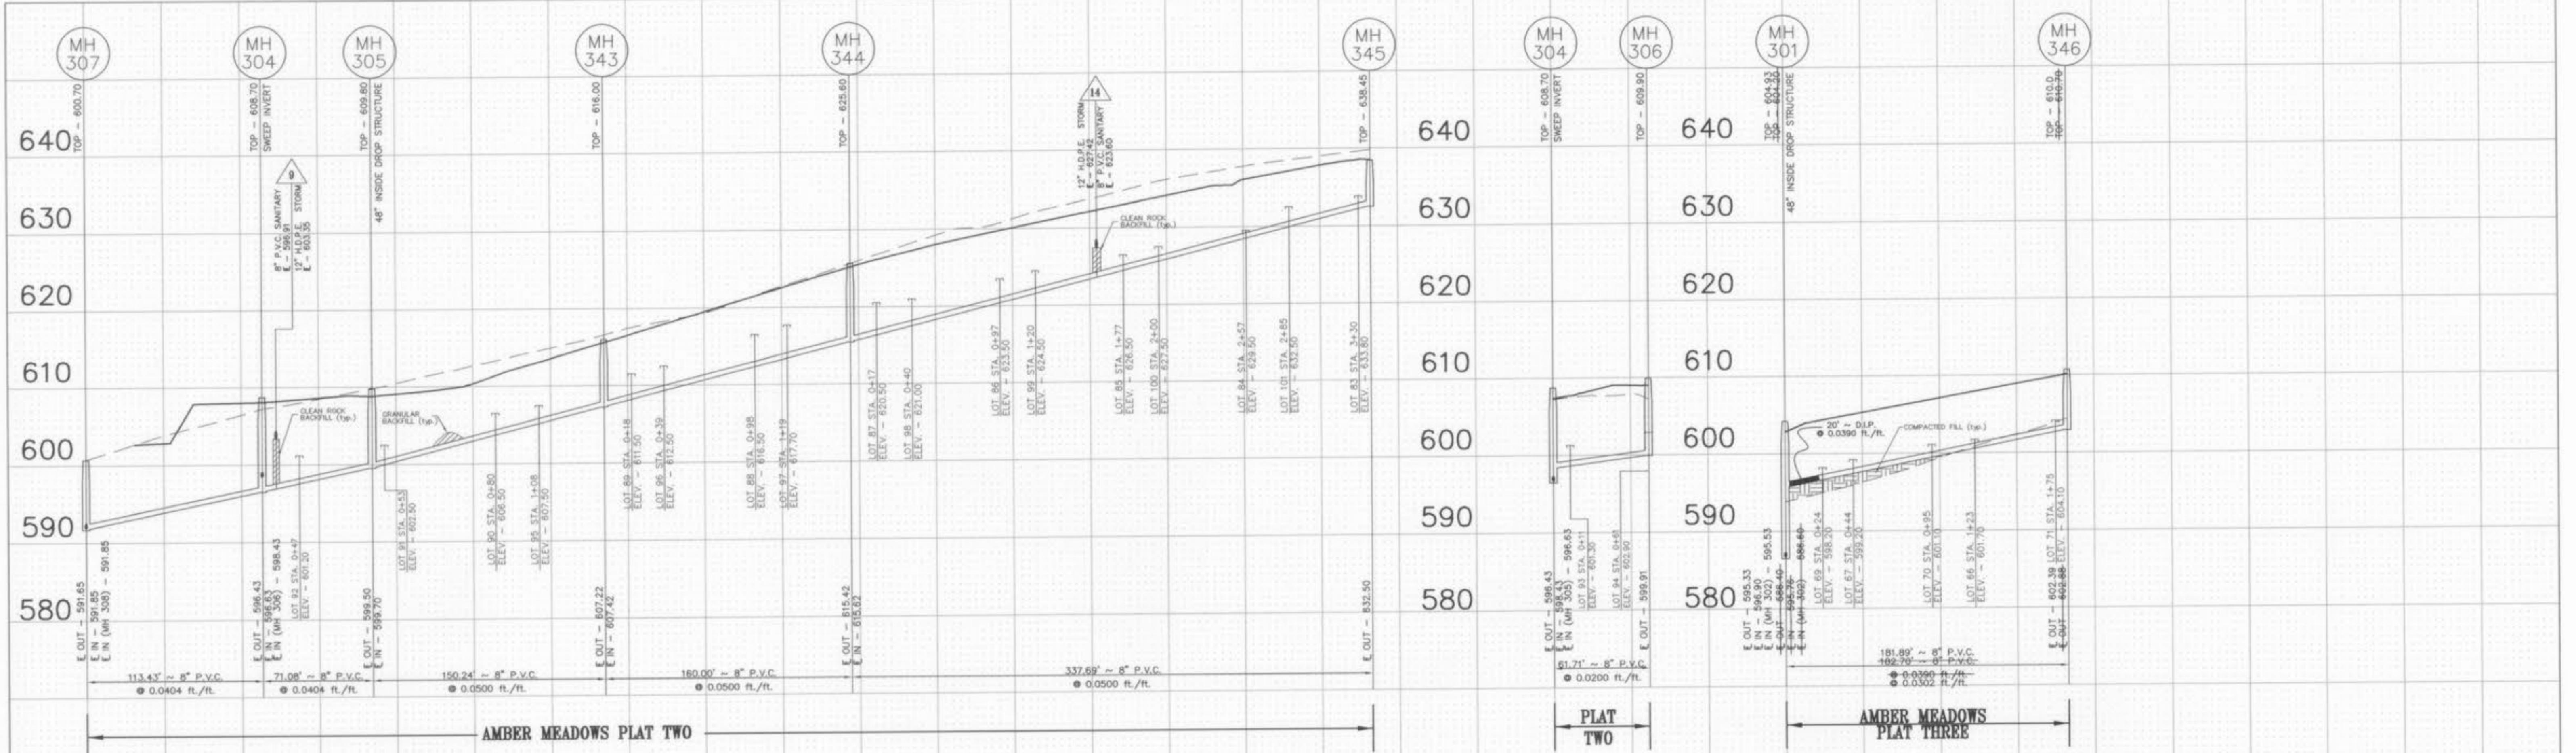

AMBER MEADOWS PLAT TWO

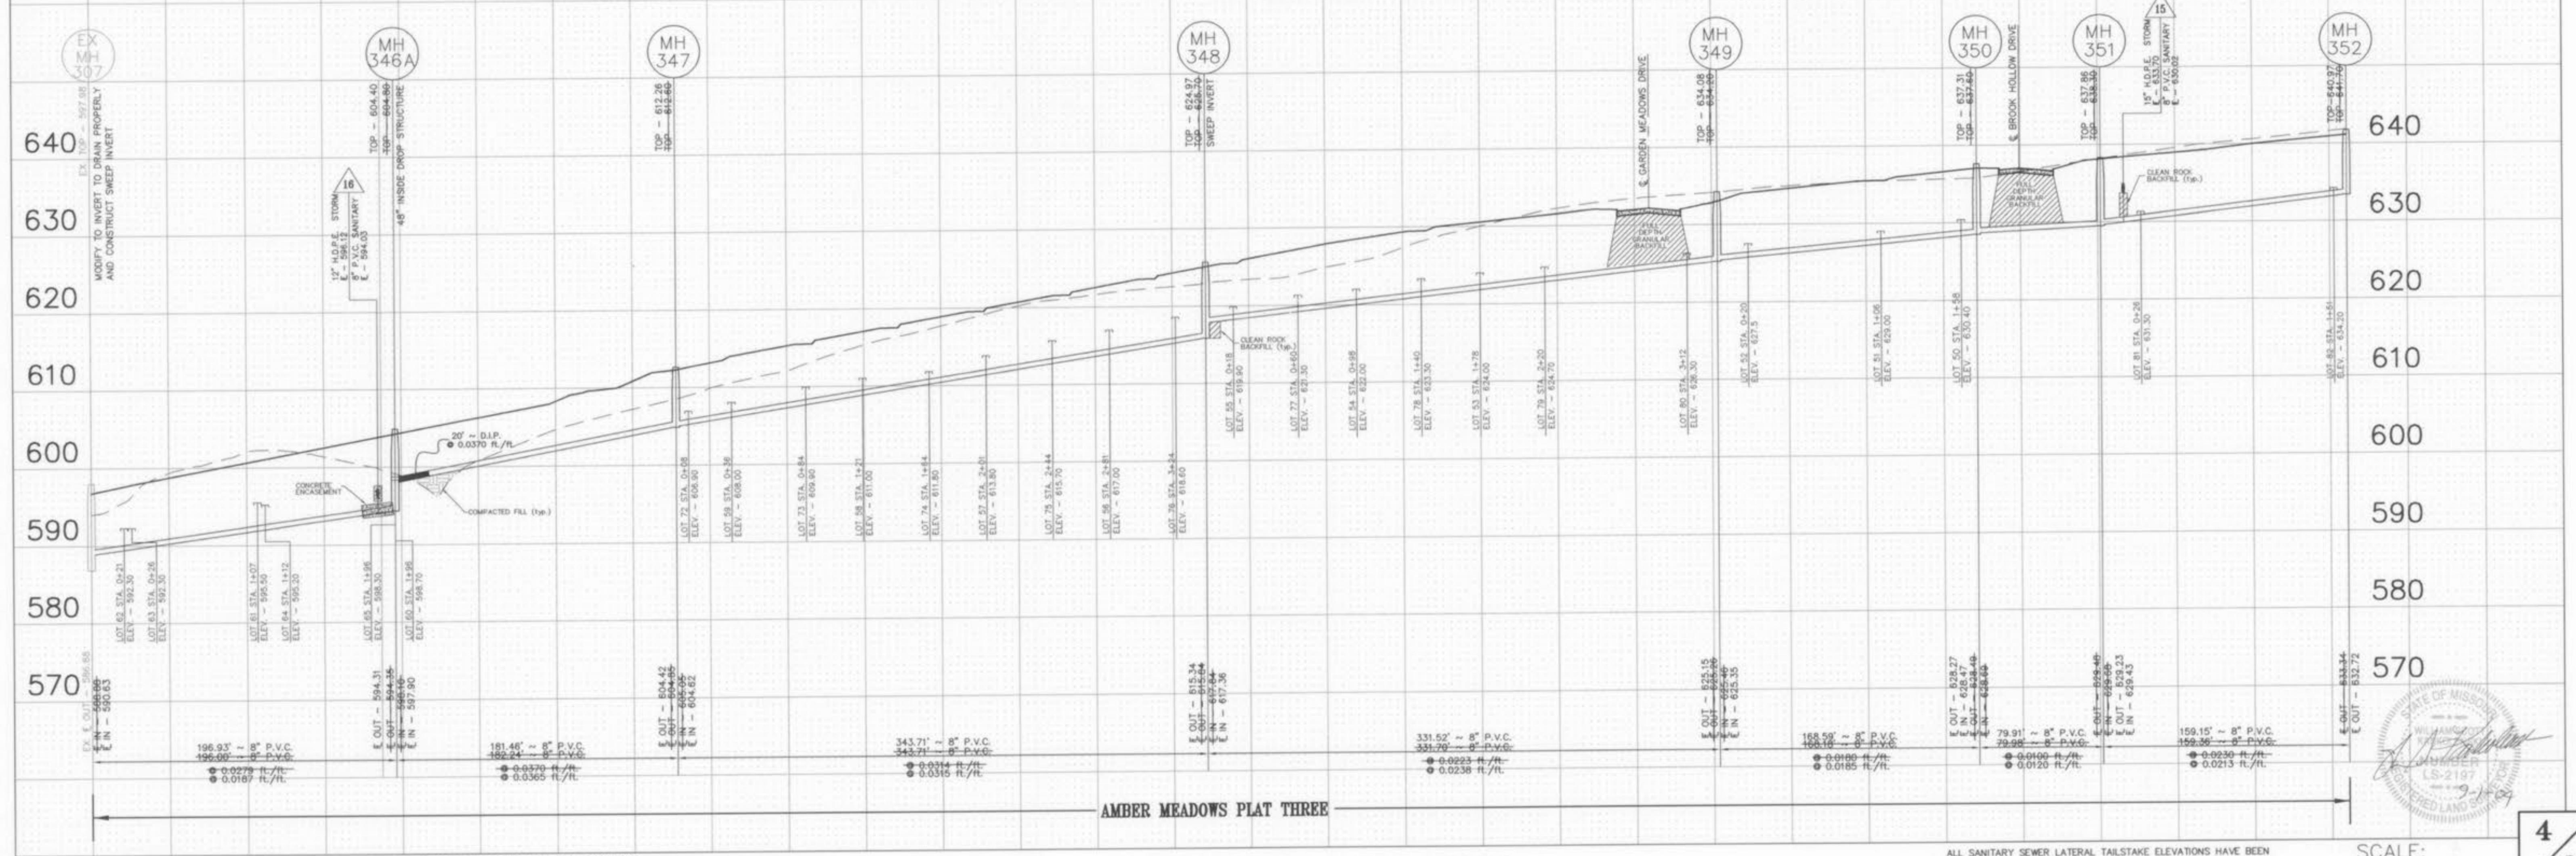


AMBER MEADOWS PLAT THREE

UNDERGROUND UTILITIES HAVE BEEN PLOTTED FROM AVAILABLE INFORMATION AND THEREFORE THEIR LOCATIONS SHALL BE CONSIDERED APPROXIMATE ONLY. THE LOCATION OF ALL UNDERGROUND UTILITIES, EITHER SHOWN OR NOT SHOWN ON THESE PLANS SHALL BE THE RESPONSIBILITY OF THE CONTRACTOR, AND SHALL BE LOCATED PRIOR TO ANY GRADING OR CONSTRUCTION OF THE IMPROVEMENTS.

ALL SANITARY SEWER LATERAL TAILSTAKE ELEVATIONS HAVE BEEN
DESIGNED FOR AN 8.0' BASEMENT POUR.


SCALE:
VERTICAL = 1" = 10'
HORIZONTAL = 1" = 50'
4 7

AS-BUILTS ADDED JULY, 2004

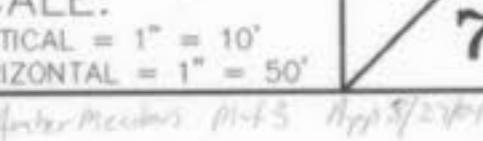


Amber Meadows Plats 1-3 1ppg 8/2004 Adk

NOTE: ALL SANITARY SEWER ON THIS SHEET WITHIN
CITY OF O'FALLON SANITARY SEWER DISTRICT.

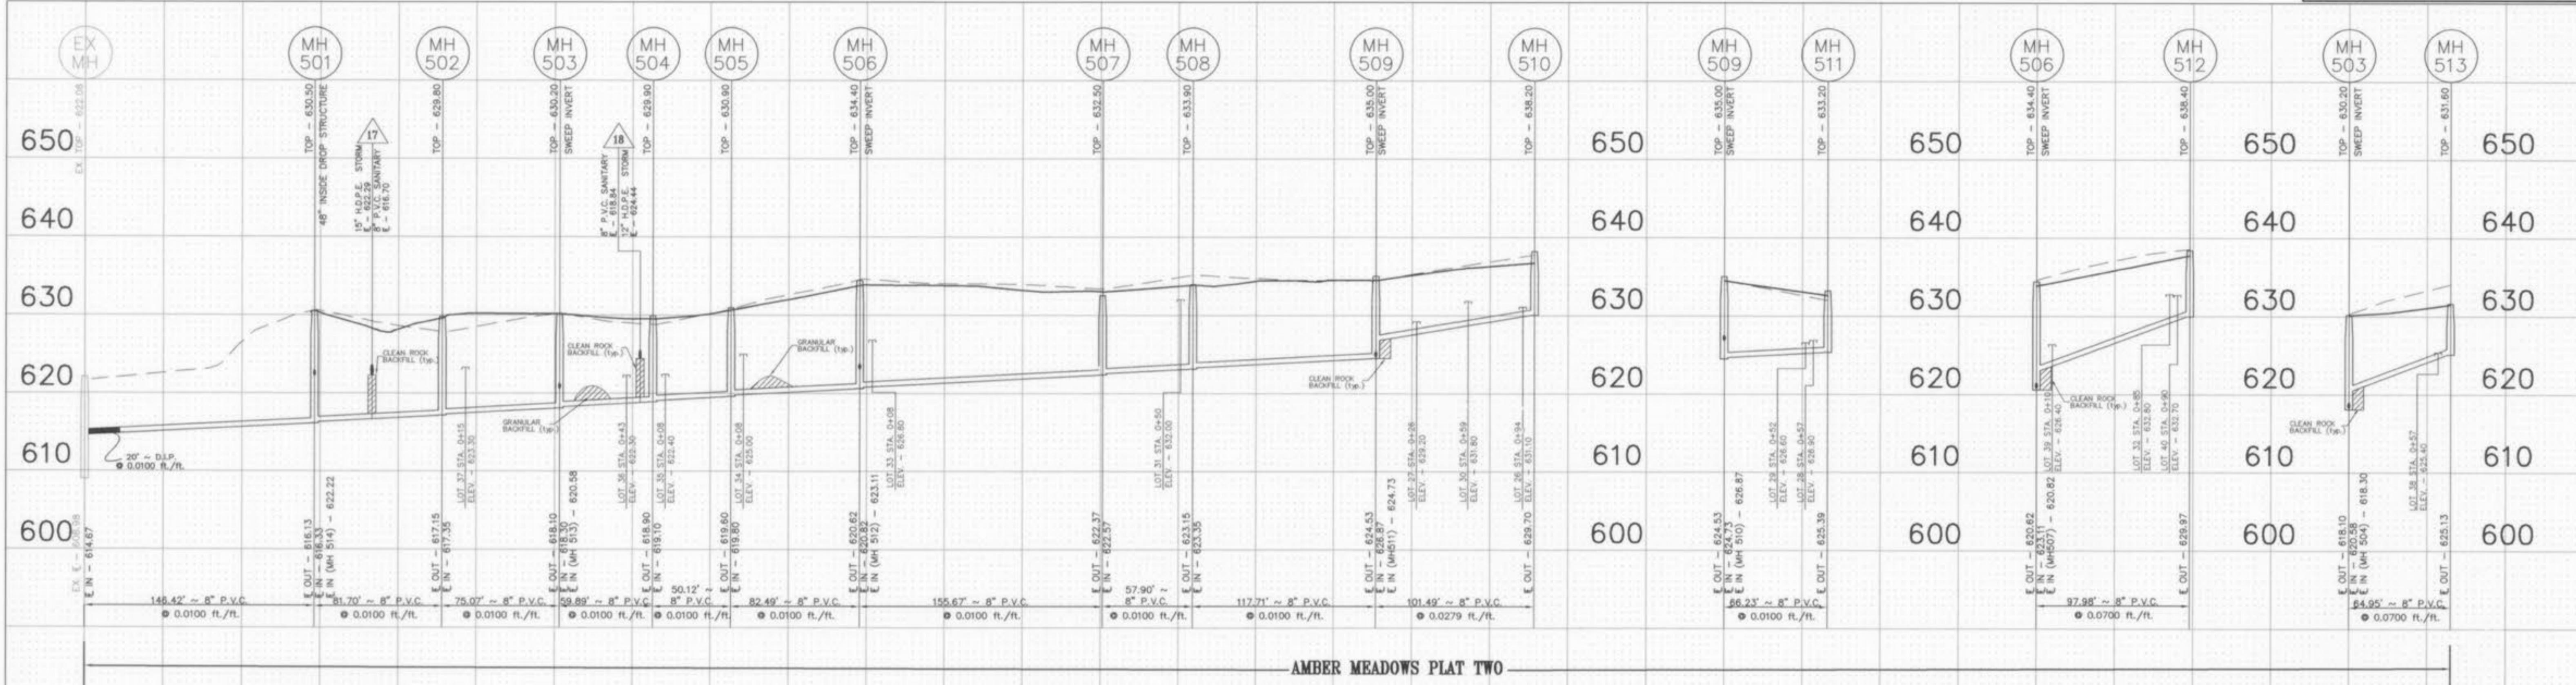

AMBER MEADOWS PLAT TWO

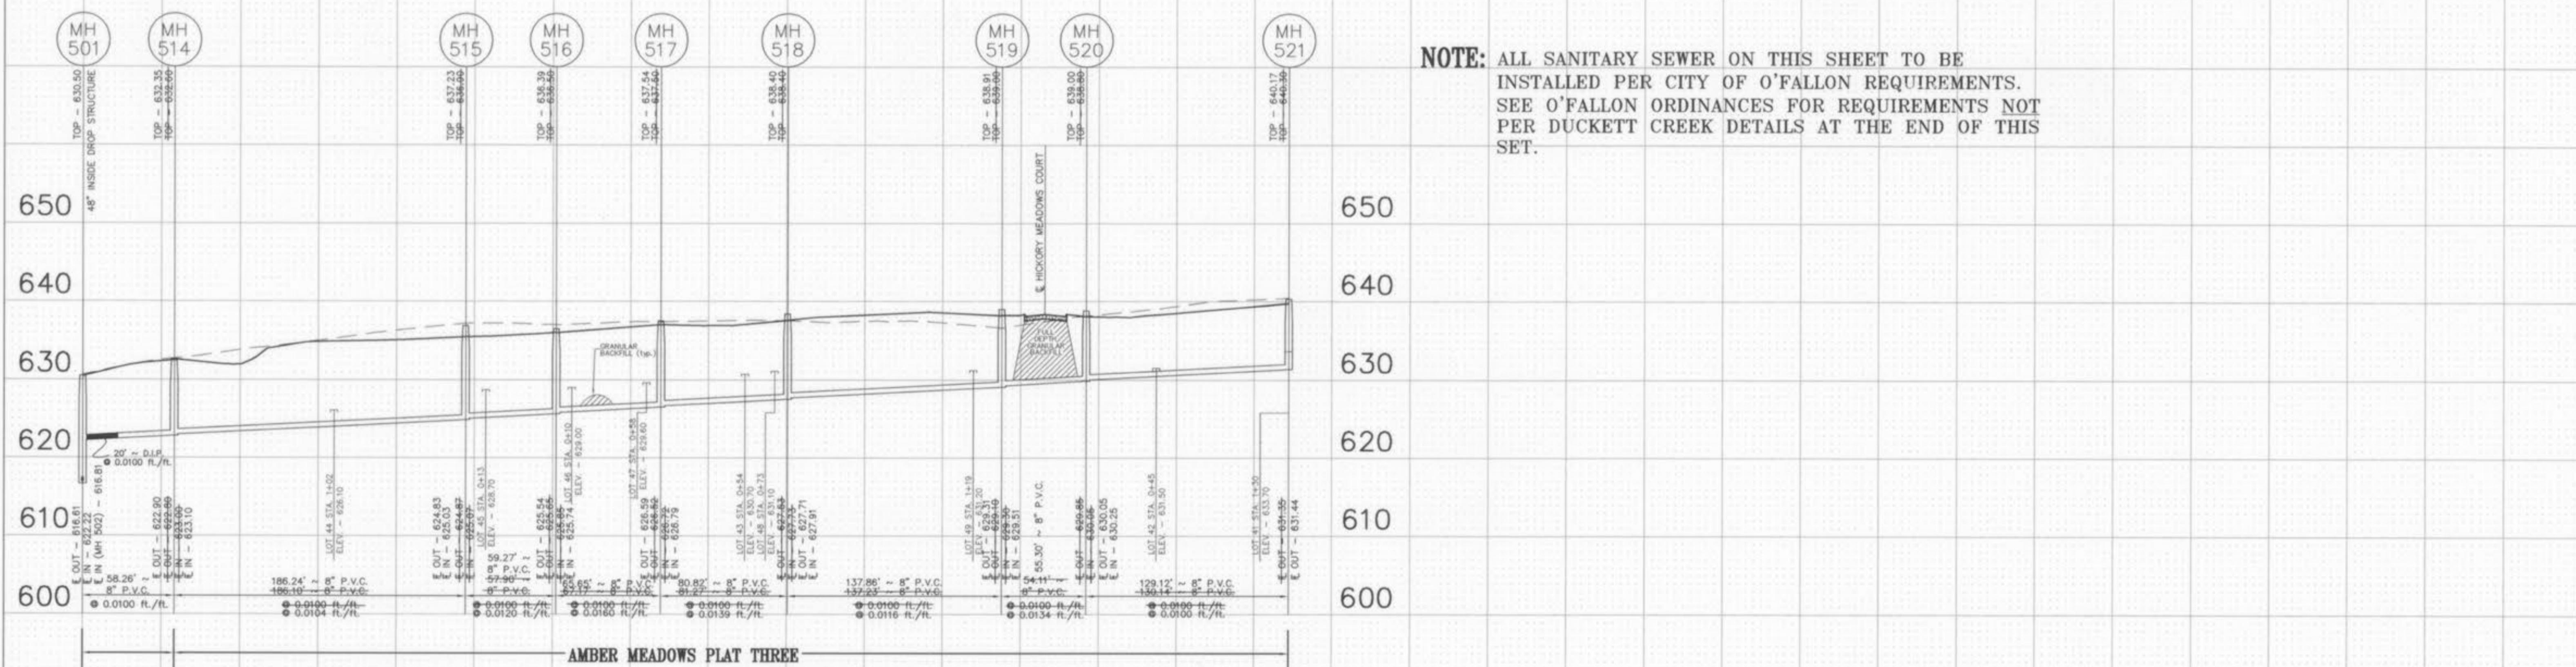

AMBER MEADOWS PLAT THREE



NOTE: ALL SANITARY SEWER ON THIS SHEET TO BE
INSTALLED PER CITY OF O'FALLON REQUIREMENTS.
SEE O'FALLON ORDINANCES FOR REQUIREMENTS NOT
PER DUCKETT CREEK DETAILS AT THE END OF THIS
SET.



UNDERGROUND UTILITIES HAVE BEEN PLOTTED FROM AVAILABLE INFORMATION AND THEREFORE THEIR LOCATIONS SHALL BE CONSIDERED APPROXIMATE ONLY. THE VERIFICATION OF THE LOCATION OF ALL UNDERGROUND UTILITIES, EITHER SHOWN OR NOT SHOWN ON THESE PLANS SHALL BE THE RESPONSIBILITY OF THE CONTRACTOR, AND SHALL BE LOCATED PRIOR TO ANY GRADING OR CONSTRUCTION OF THE IMPROVEMENTS.


ALL SANITARY SEWER LATERAL TAILSTAKE ELEVATIONS HAVE BEEN
DESIGNED FOR AN 8.0' BASEMENT POUR.

AS-BUILTS ADDED JULY, 2004


SCALE:
VERTICAL = 1" = 10'
HORIZONTAL = 1" = 50'

5
7


PLAT 3 APP 9/27/04 MEC

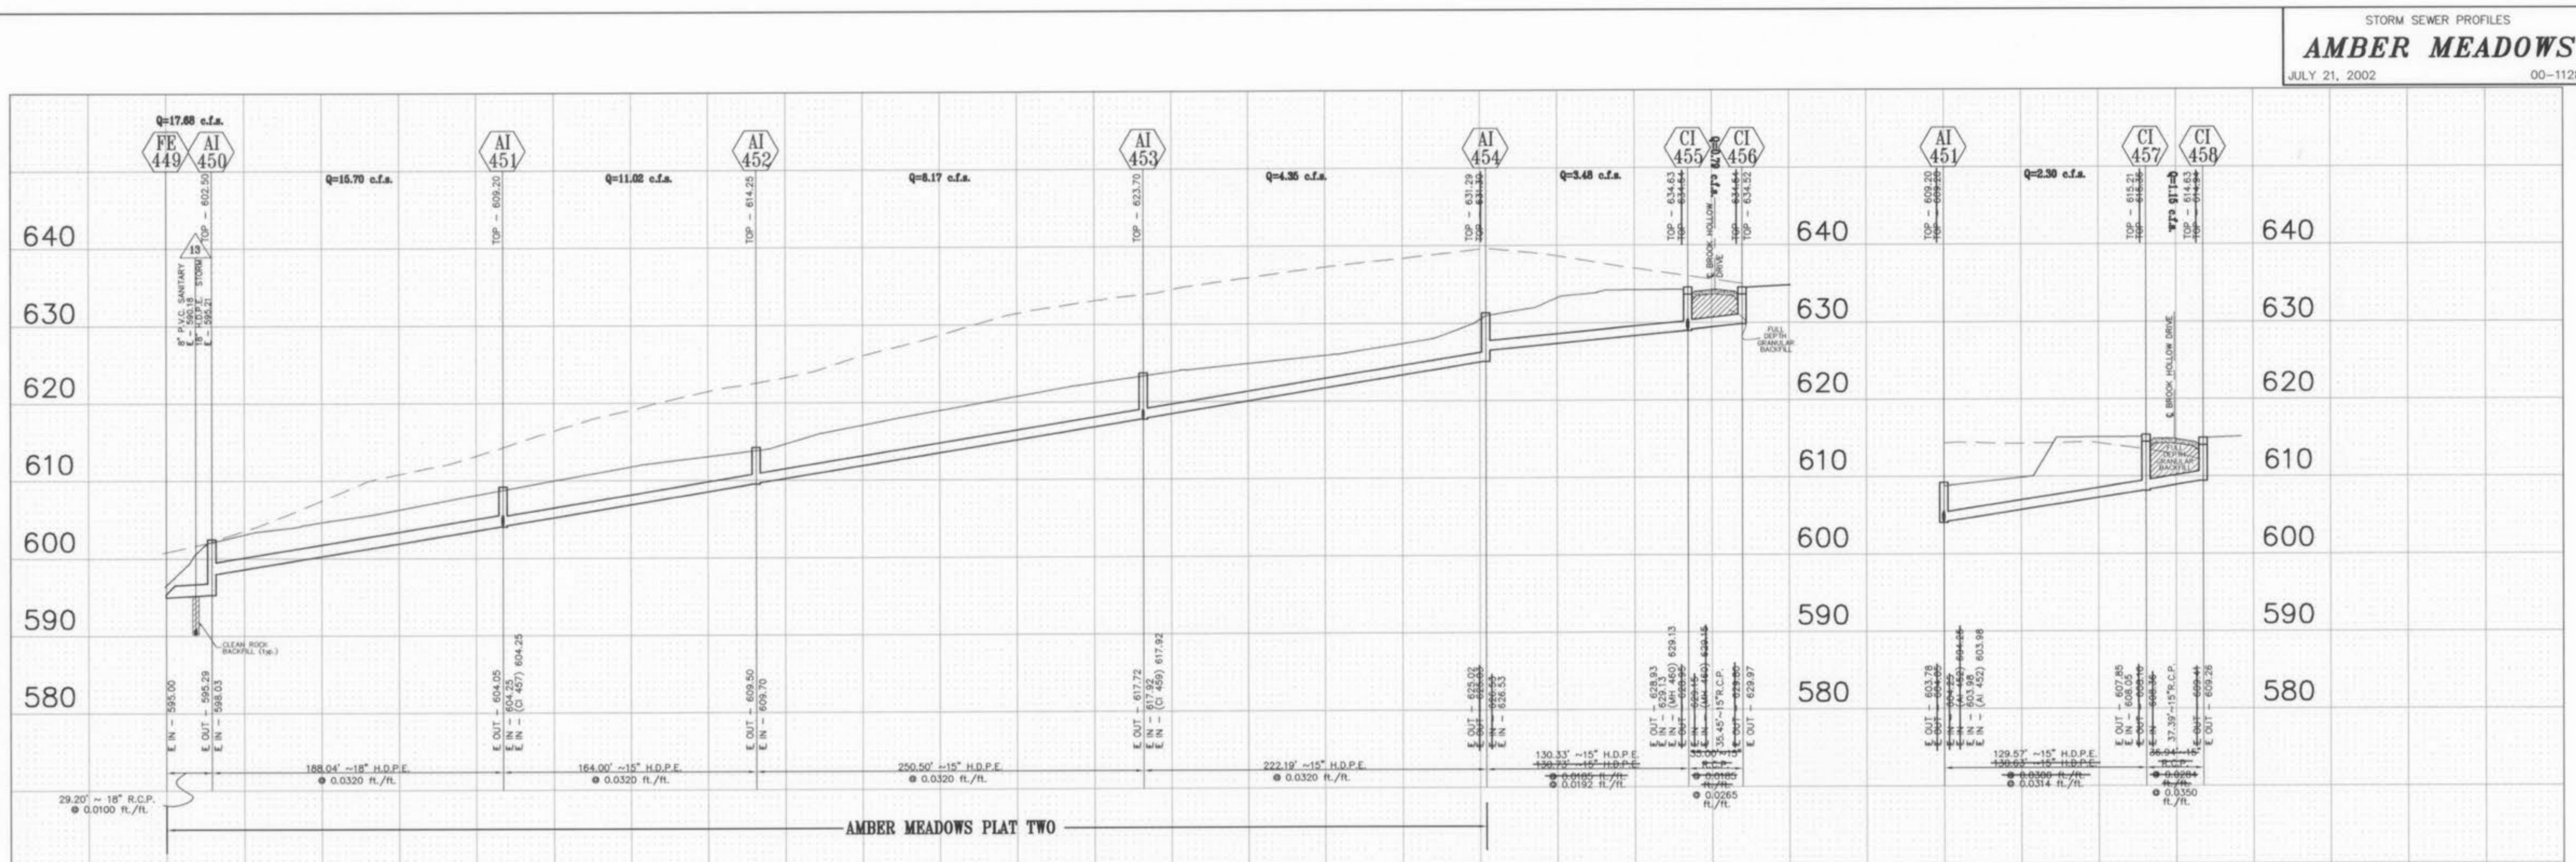

AMBER MEADOWS PLAT TWO

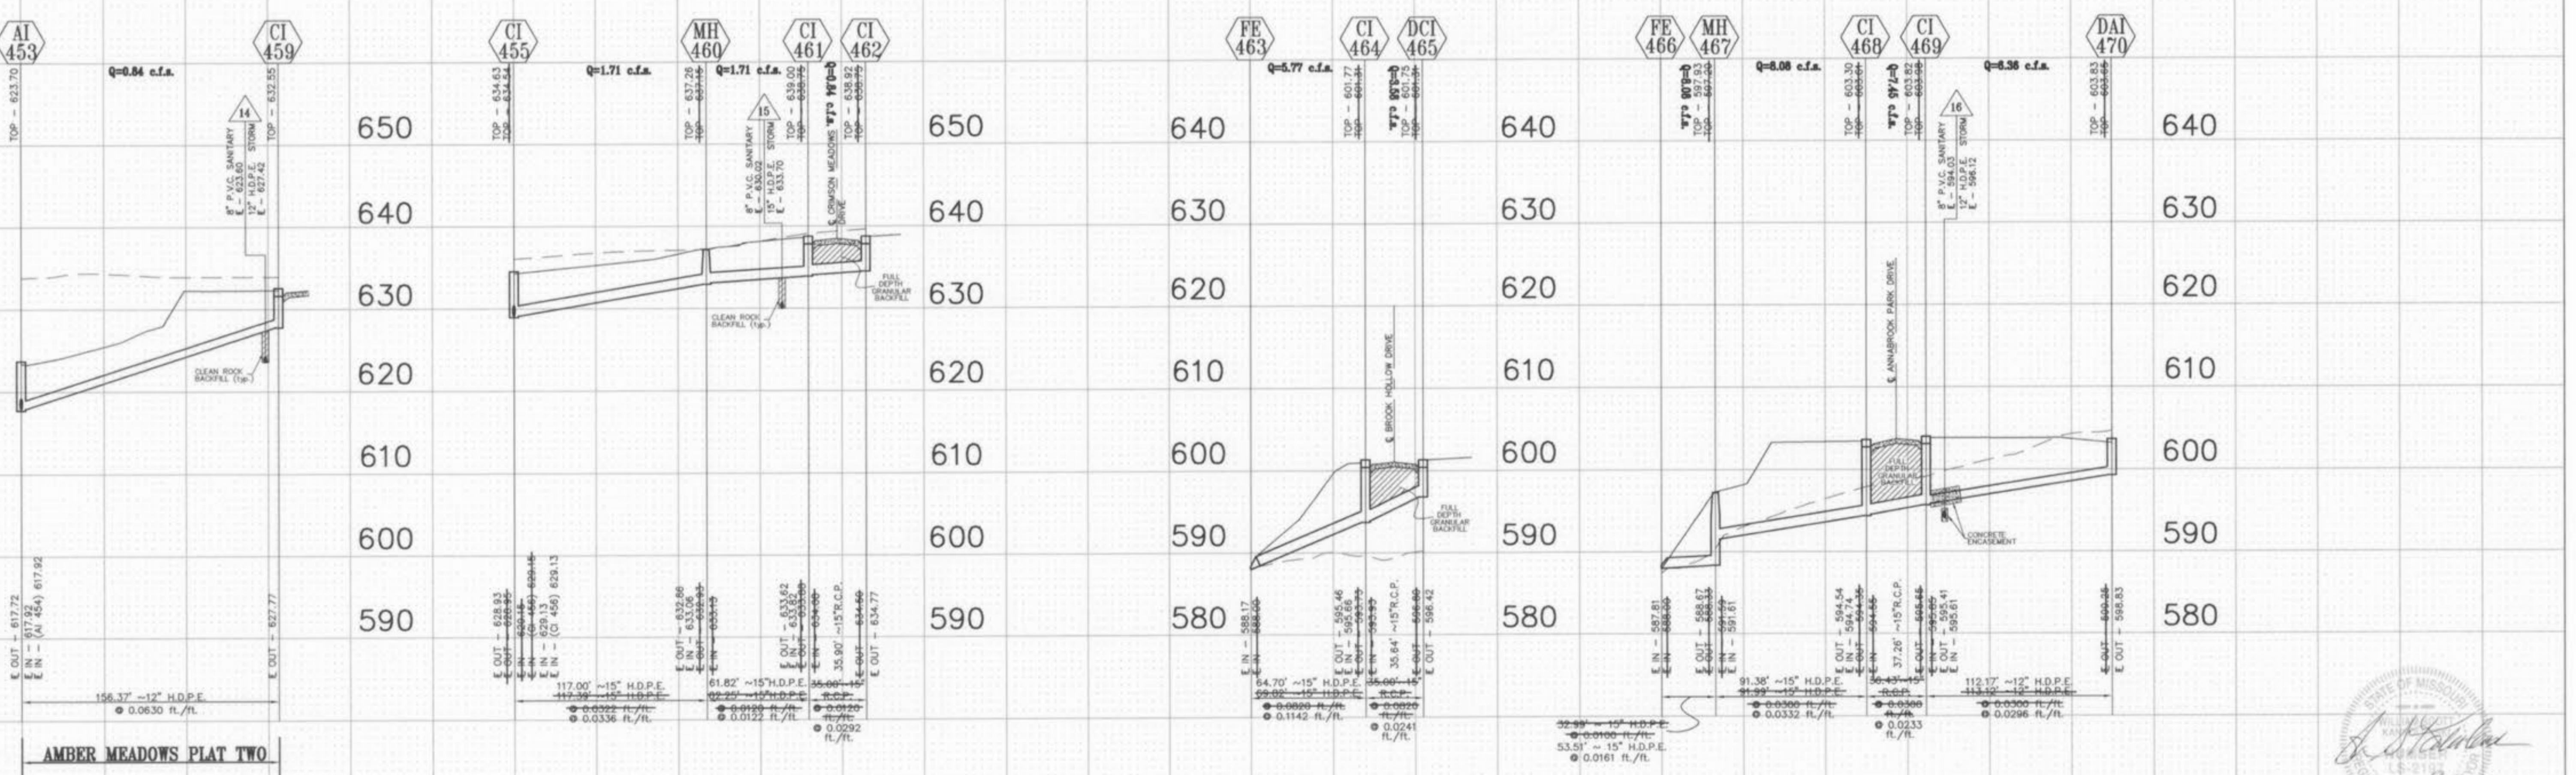


9-12-04

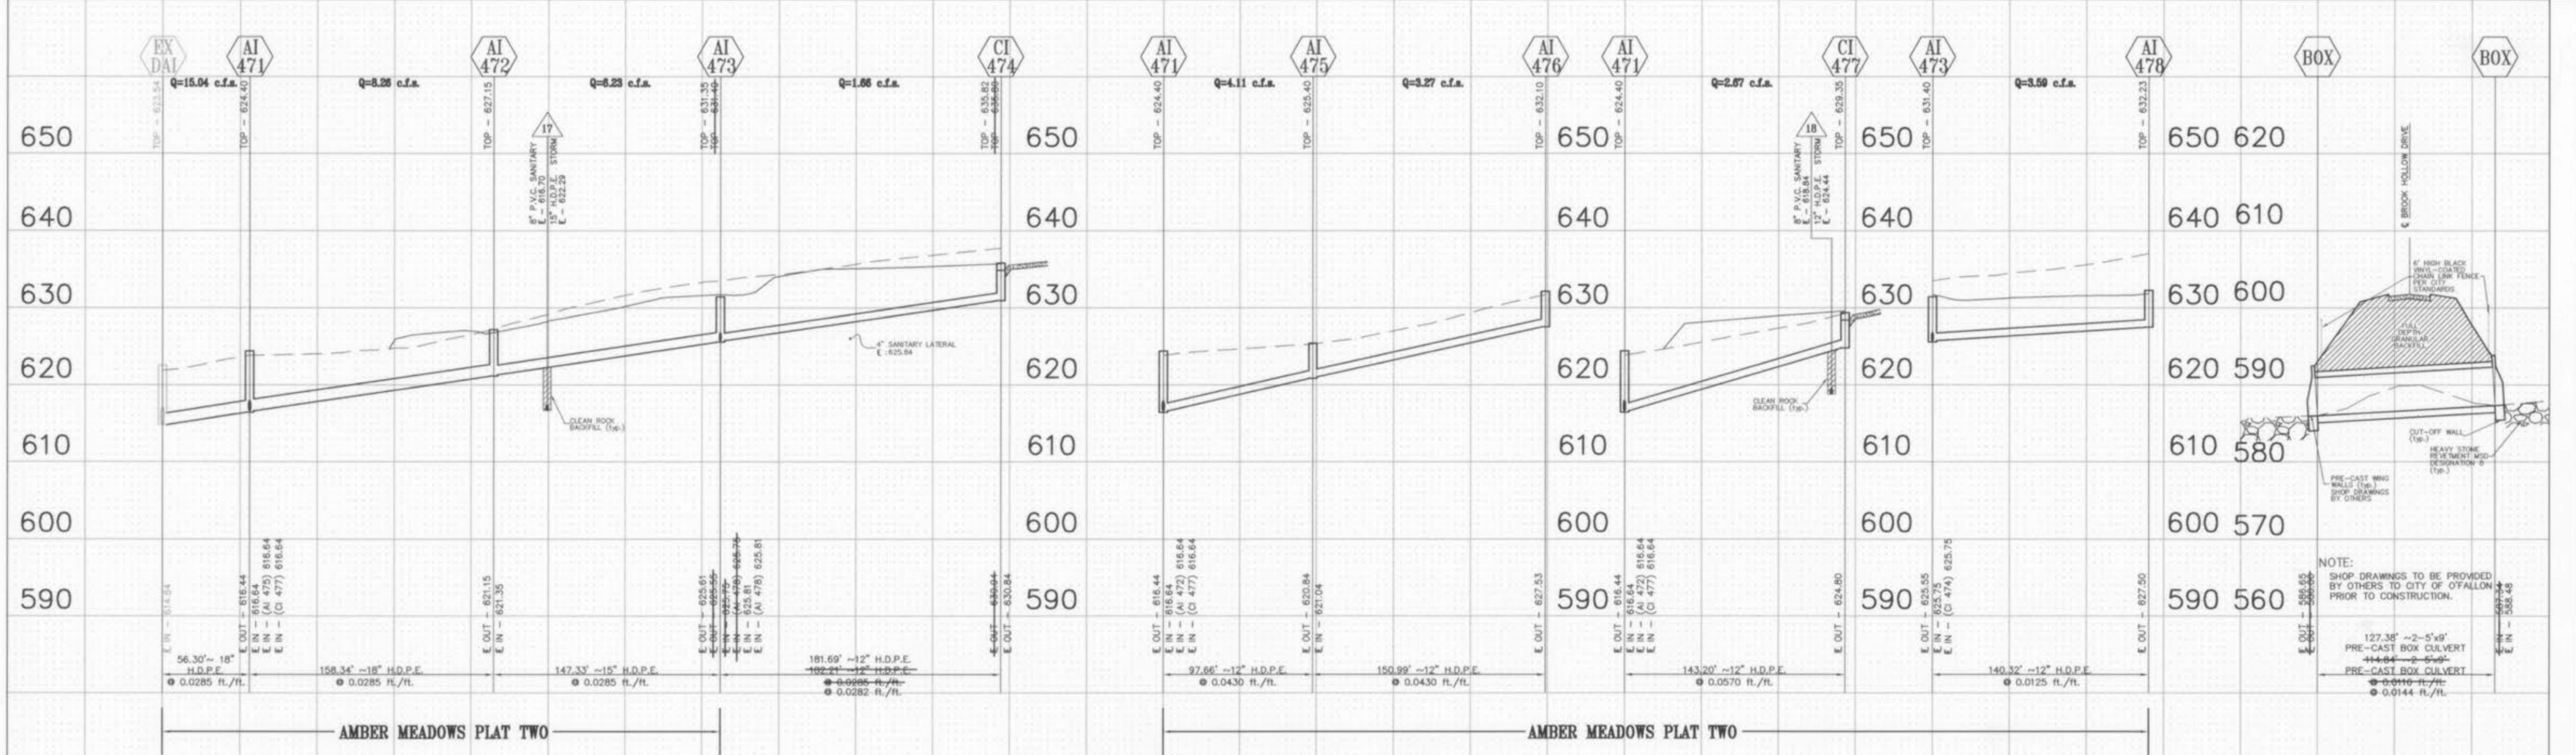

AMBER MEADOWS PLAT TWO

AMBER MEADOWS PLAT TWO

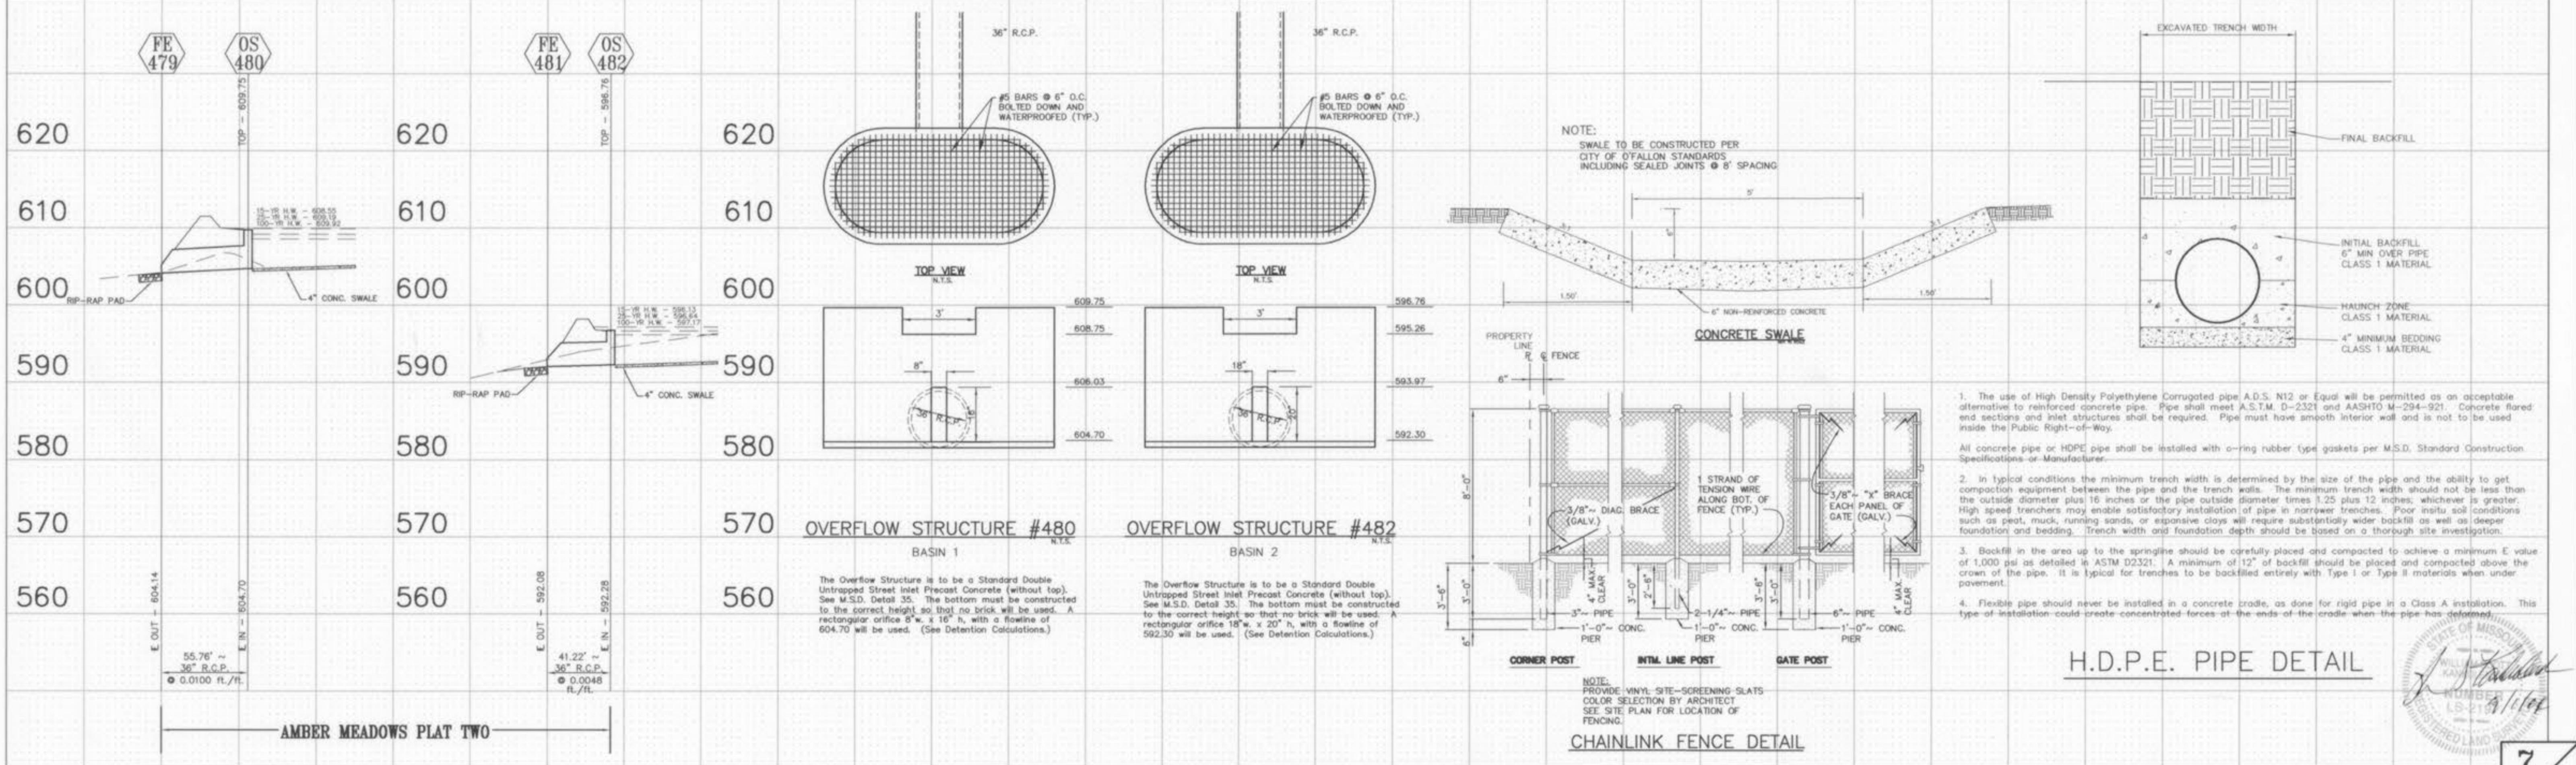

AS-BUILTS ADDED JULY, 2004

UNDERGROUND UTILITIES HAVE BEEN PLOTTED FROM AVAILABLE INFORMATION AND THEREFORE THEIR LOCATIONS SHALL BE CONSIDERED APPROXIMATE ONLY. THE VERIFICATION OF THE LOCATION OF ALL UNDERGROUND UTILITIES, EITHER SHOWN OR NOT SHOWN ON THESE PLANS SHALL BE THE RESPONSIBILITY OF THE CONTRACTOR, AND SHALL BE LOCATED PRIOR TO ANY GRADING OR CONSTRUCTION OF THE IMPROVEMENTS.

SCALE:
VERTICAL = 1" = 10'
HORIZONTAL = 1" = 50'

7
7

Amber Meadows Plat 3 App 8/27/04 ABC