


ASHFORD PLACE

A TRACT OF LAND BEING PART OF THE SW 1/4 OF FRAC. SEC. 16 & THE NW 1/4 OF FRAC. SEC. 21, TOWNSHIP 47 N., RANGE 3 E. CITY OF O'FALLON ST. CHARLES CO., MO.

GENERAL NOTES

1. Underground utilities have been plotted from available information and therefore their locations shall be considered approximate only. The verification of the location of all underground utilities, either shown or not shown on these plans, shall be the responsibility of the contractor, and shall be located prior to any grading and/or construction of improvements.
2. All standard curb inlets are to have front-of-inlet 2' (two feet) behind curb, within public right-of-way, unless otherwise noted.
3. Storm sewers 18" diameter and smaller shall be A.S.T.M. C-14 unless otherwise shown on the plans.
4. Storm sewers 21" diameter and larger shall be A.S.T.M. C-76, Class II minimum, unless otherwise shown on the plans.
5. All storm sewer pipe in the right-of-way shall be reinforced concrete pipe (A.S.T.M. C-76, Class II minimum).
6. Corrugated metal pipe shall conform to the standard specifications for corrugated culvert pipe AASHTO, M36, aluminized or asphalt polymer coated.
7. 8" P.V.C. sanitary sewer pipe shall meet the following standards: A.S.T.M. D-3034 SDR35, with wall thickness compression joint A.S.T.M. D-3212. An appropriate rubber seal watertight as approved by the sewer district shall be installed between P.V.C. pipe and masonry structures.
8. All filled places, including under paved areas, under buildings, under proposed storm and sanitary sewer lines, and/or paved areas, shall be compacted to 90% of maximum density as determined by the "Modified AASHTO T-180 Compaction Test", (A.S.T.M. D1557). Test shall be verified by a soils engineer.
9. All trench backfills under paved areas shall be granular backfill, and water jetted. All other trench backfills may be earth material (free of large clods or stones) and shall be water jetted.
10. No slope shall be steeper than 3.1. All slopes shall be seeded and mulched.
11. Barricades will be constructed per the standard specifications as shown in the "Manual of Uniform Traffic Control Devices". End of roadway markers shall be mounted 4 feet above the pavement on two pound "U" channel sign posts. Each marker shall consist of an 18" diamond panel with red reflectors.
12. All construction and materials used shall conform to current City of O'Fallon Standards and Specifications.
13. Easements shall be provided for storm sewers, sanitary sewers, and all utilities on the record plat. See record plat for location size, and width of easements.
14. All water line construction shall conform to current City of O'Fallon Water District Standards and Specifications.
15. All sanitary sewer construction shall conform to current City of O'Fallon Sewer District Standards and Specifications.
16. The length of the concrete encasement around the P.V.C. sanitary sewers and the concrete storm sewers shall extend at least 5' into undisturbed soil to bridge the pipe across the trench backfill. Reinforcing steel shall be placed in the concrete encasement for tensile strength.
17. Erosion control shall not be limited to what is shown on the plan. The contractor shall take whatever means necessary to prevent siltation and erosion from entering adjacent roadways, properties, and ditches. Such control might include channeling runoff into sediment basins, channeling runoff into areas where an extra row of straw bales are used. A silt fence might be considered, if necessary.
18. All construction and materials shall conform to O'Fallon Fire Protection District Standards.
19. The minimum vertical distance from the low point of the basement to the flowline of the sanitary sewer at the corresponding house connection shall not be less than two and one half feet (2 1/2") plus the diameter of the sanitary sewer.
20. The most stringent of the above requirements shall apply.
21. All streets and right-of-ways shown on these improvement plans will be dedicated to the City O'Fallon for public use forever.
22. When grading operations are completed or suspended for more than 30 days, permanent grass must be established at sufficient density to provide erosion control on the site. Between permanent grass seeding periods, temporary cover shall be provided according to the City of O'Fallon Specifications.
23. The contractor shall place all fire hydrants within (2') two feet of the street curb.
24. The contractor shall place the "steamer" outlet of the fire hydrant toward the street.
25. All sanitary sewer manholes shall be waterproofed on the exterior in accordance with Missouri D.N.R. Specification 10CSR-8.120 (7)(E).
26. Any wells and/or springs which may exist on this property should be located and sealed in a manner acceptable to the City of O'Fallon.
27. All existing trash and debris on-site must be removed and disposed of off-site.
28. Debris and foundation material from any existing on-site building or structure which is scheduled to be razed for this development must be disposed of off-site.
29. Soft soils in the bottom and banks of any existing or former pond sites or tributaries should be removed, spread out, and permitted to dry sufficiently to be used as fill. None of this material should be placed in proposed public right-of-way locations or on any storm sewer location.

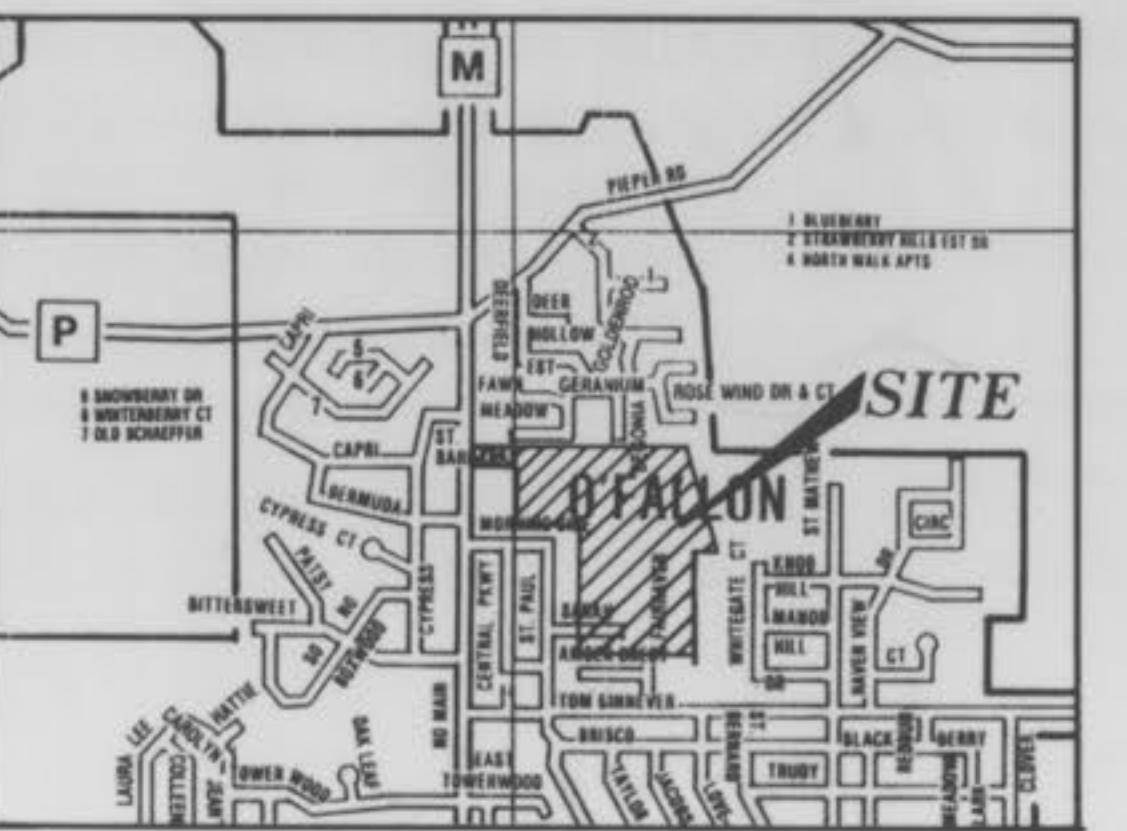

LOCATION MAP

N.T.S.

LEGEND	
BUILDING LINE	
EXISTING SANITARY SEWER	
PROPOSED SANITARY SEWER	
EXISTING STORM SEWER	
PROPOSED STORM SEWER	
EXISTING CONTOUR	
PROPOSED CONTOUR	
EXISTING WOOD AREA	
SILTATION CONTROL	
CREEK OR DITCH	
FLOWLINE	
GAS MAIN	
TELEPHONE CABLE	
WATER MAIN	
UNDERGROUND ELECTRIC	
OVERHEAD ELECTRIC	
STREET SIGN	
GENERAL SURFACE DRAINAGE	
LIGHT STANDARD	
CLEARING AND GRADING LIMITS	
LATERAL TAIL STAKE	
Basement Floor	
F.H.	FIRE HYDRANT
8" W.M.	WATER MAIN
B.O.	BLOW-OFF VALVE
1234	DENOTES STREET ADDRESS
□	EXISTING TELEPHONE PEDESTAL (EX. TELE, PED.)

INDEX

DESCRIPTION	SHEET NUMBER
Cover Sheet	1
Flat Plans	2-3
Grading Plans	4-5
Storm Grading Plans	6-8
Street Profiles	9-15
Sanitary Sewer Profiles	13-15
Storm Sewer Profiles	16-19
Drainage Area Plans	20-24
Construction Details	22-28

Plat Two - Sept. 27, 1996

**SANITARY & STORM AS-BUILTS
(AS SHOWN ON PROFILES)**

ASHFORD PLACE

ENGINEERS AUTHENTICATION
The responsibility for professional engineering liability on this project is hereby limited to the set of plans authenticated by the seal, signature and date hereunder attached. Responsibility is disclaimed for all other engineering plans involved in the project and specifically excludes revisions after this date unless re-authenticated.

St. Charles Engineering and Surveying

Revised 11/16/96 Sheet 1 of 26

Order No. 93-1207

Date 4-27-94

801 South Fifth Street, Suite 202

St. Charles, Missouri 63301

Off. 947-0607, Fax 947-2448

PREPARED FOR:
JAMES TARKINGTON
#4 ROSE ANNA ACRES
WENTZVILLE MO. 63385
(314) 828-4221

Michael J. Kellerman

ST. CHARLES ENGINEERING & SURVEYING

801 South Fifth Street, Suite 202

St. Charles, Missouri 63301

Off. 947-0607, Fax 947-2448


Ashford Place - Plat 2 As-Builts

ASHFORD PLACE FLAT PLAN

NOTE:
The 15" x 72" Tee(103) and The 25' x 50'
21" x 72" Tee(166) Will Need Grooved Rip-Rap
To Be Fabricated by the Factory.

**ASHFORD PLACE
SANITARY PROFILES**

Scale:
1" = 50' Horiz.
1" = 10' Vert.

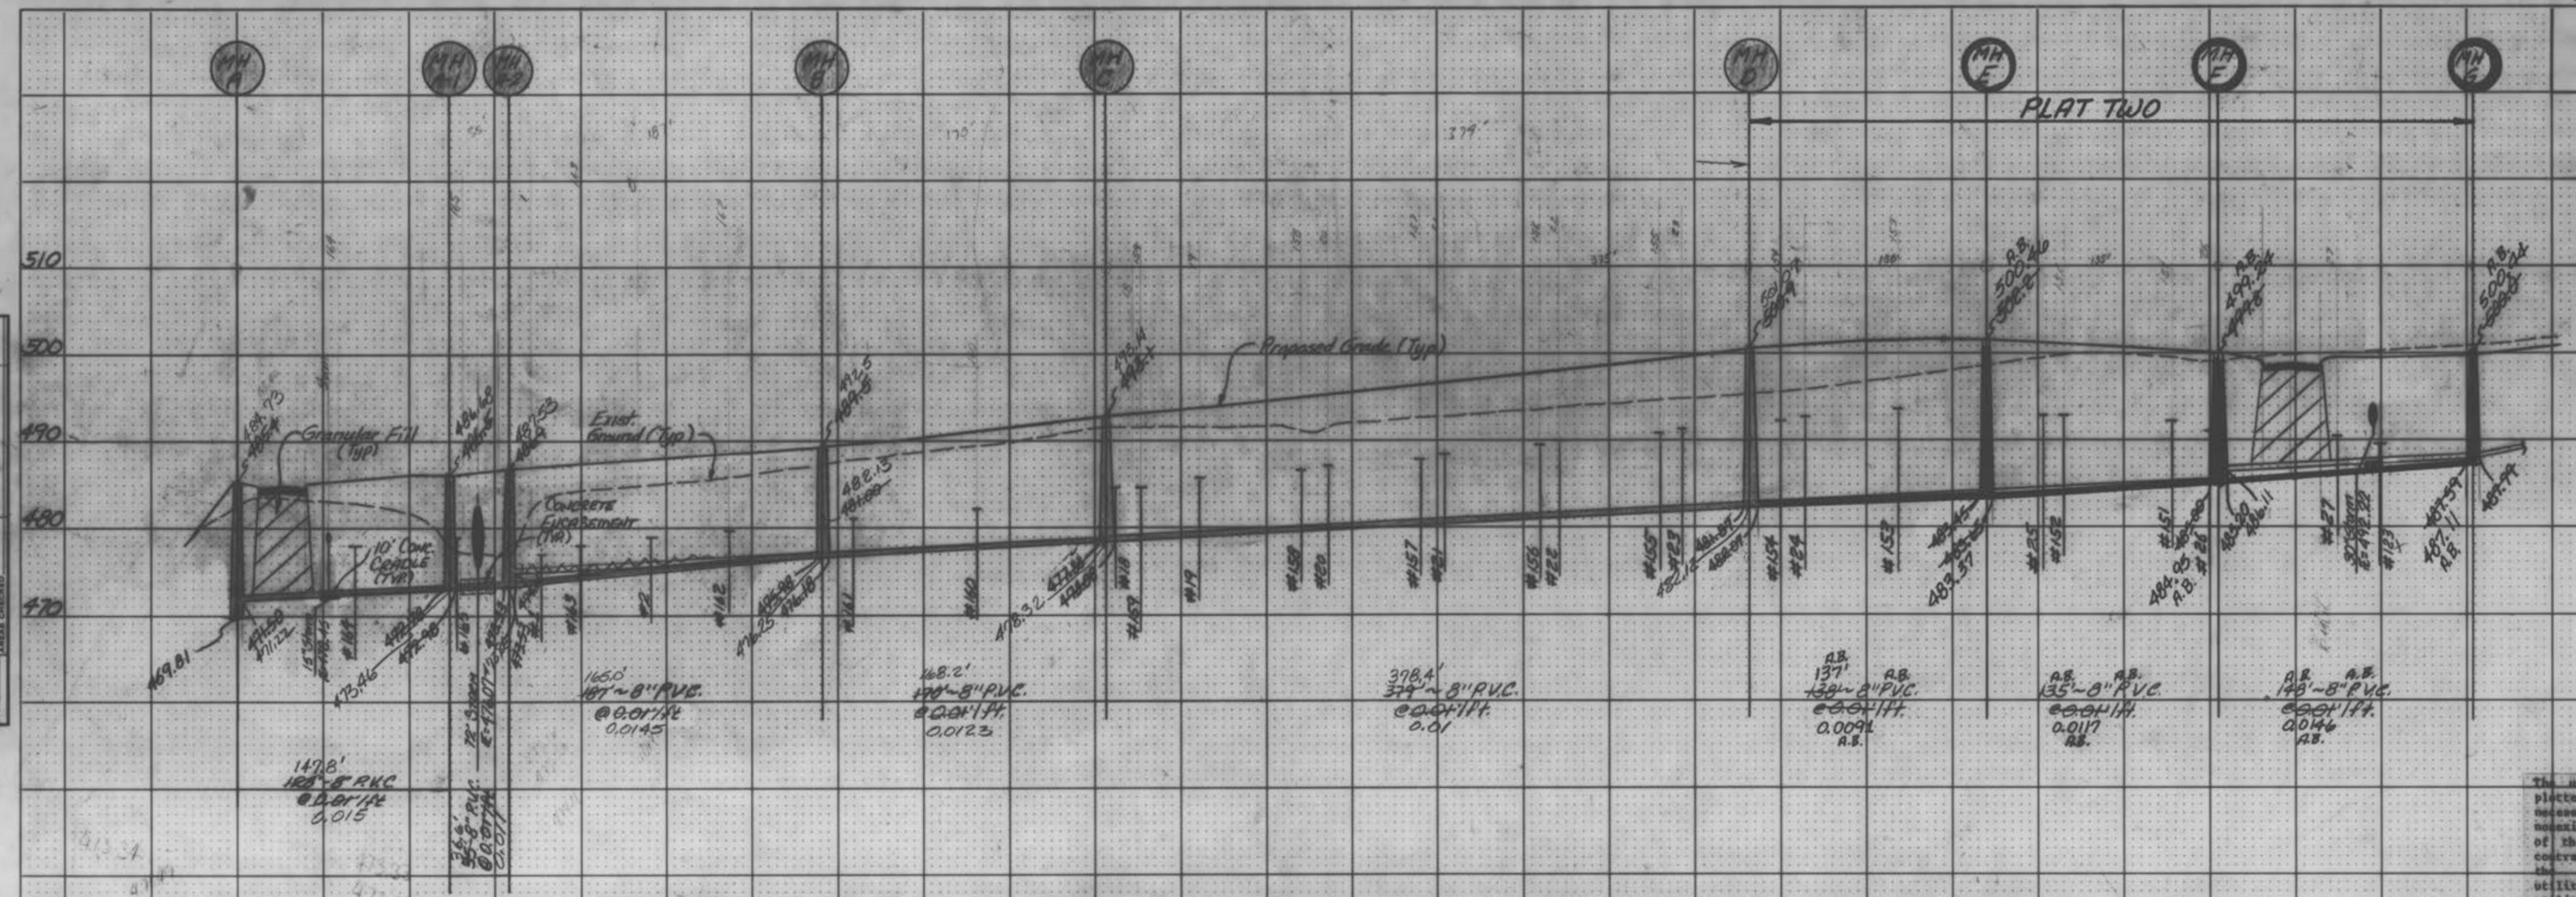

The underground utilities shown herein were plotted from available information and do not necessarily reflect the actual existence, nonexistence, size, type, number, or location of these or other utilities. The general contractor shall be responsible for verifying the actual location of all underground utilities, shown or not shown, and said utilities shall be located in the field prior to any grading, excavation, or construction of improvements. These provisions shall be no way adverse to any party from complying with the Underground Facility Safety and Damage Prevention Act, Chapter 39, RSA.

ORIGINAL SURVEY	SUBDIVIDED SURVEY
PLADED	PLADED
NOTE BOOK NO.	NOTE BOOK NO.
ANSWER CHECKED	ANSWER CHECKED

ORIGINAL SURVEY	SUBDIVIDED SURVEY
PLADED	PLADED
NOTE BOOK NO.	NOTE BOOK NO.
ANSWER CHECKED	ANSWER CHECKED

**SANITARY & STORM AS-BUILTS
(AS SHOWN ON PROFILES)**

PLAT 2 - As Built 9/26/96
Plat 1 - As Built 11/14/94


13

26

ALL SANITARY MANHOLES SHALL BE 48" I.D.

**ASHFORD PLACE
SANITARY PROFILES**

Scale:
1"=50' Horiz.
1"=10' Vert.

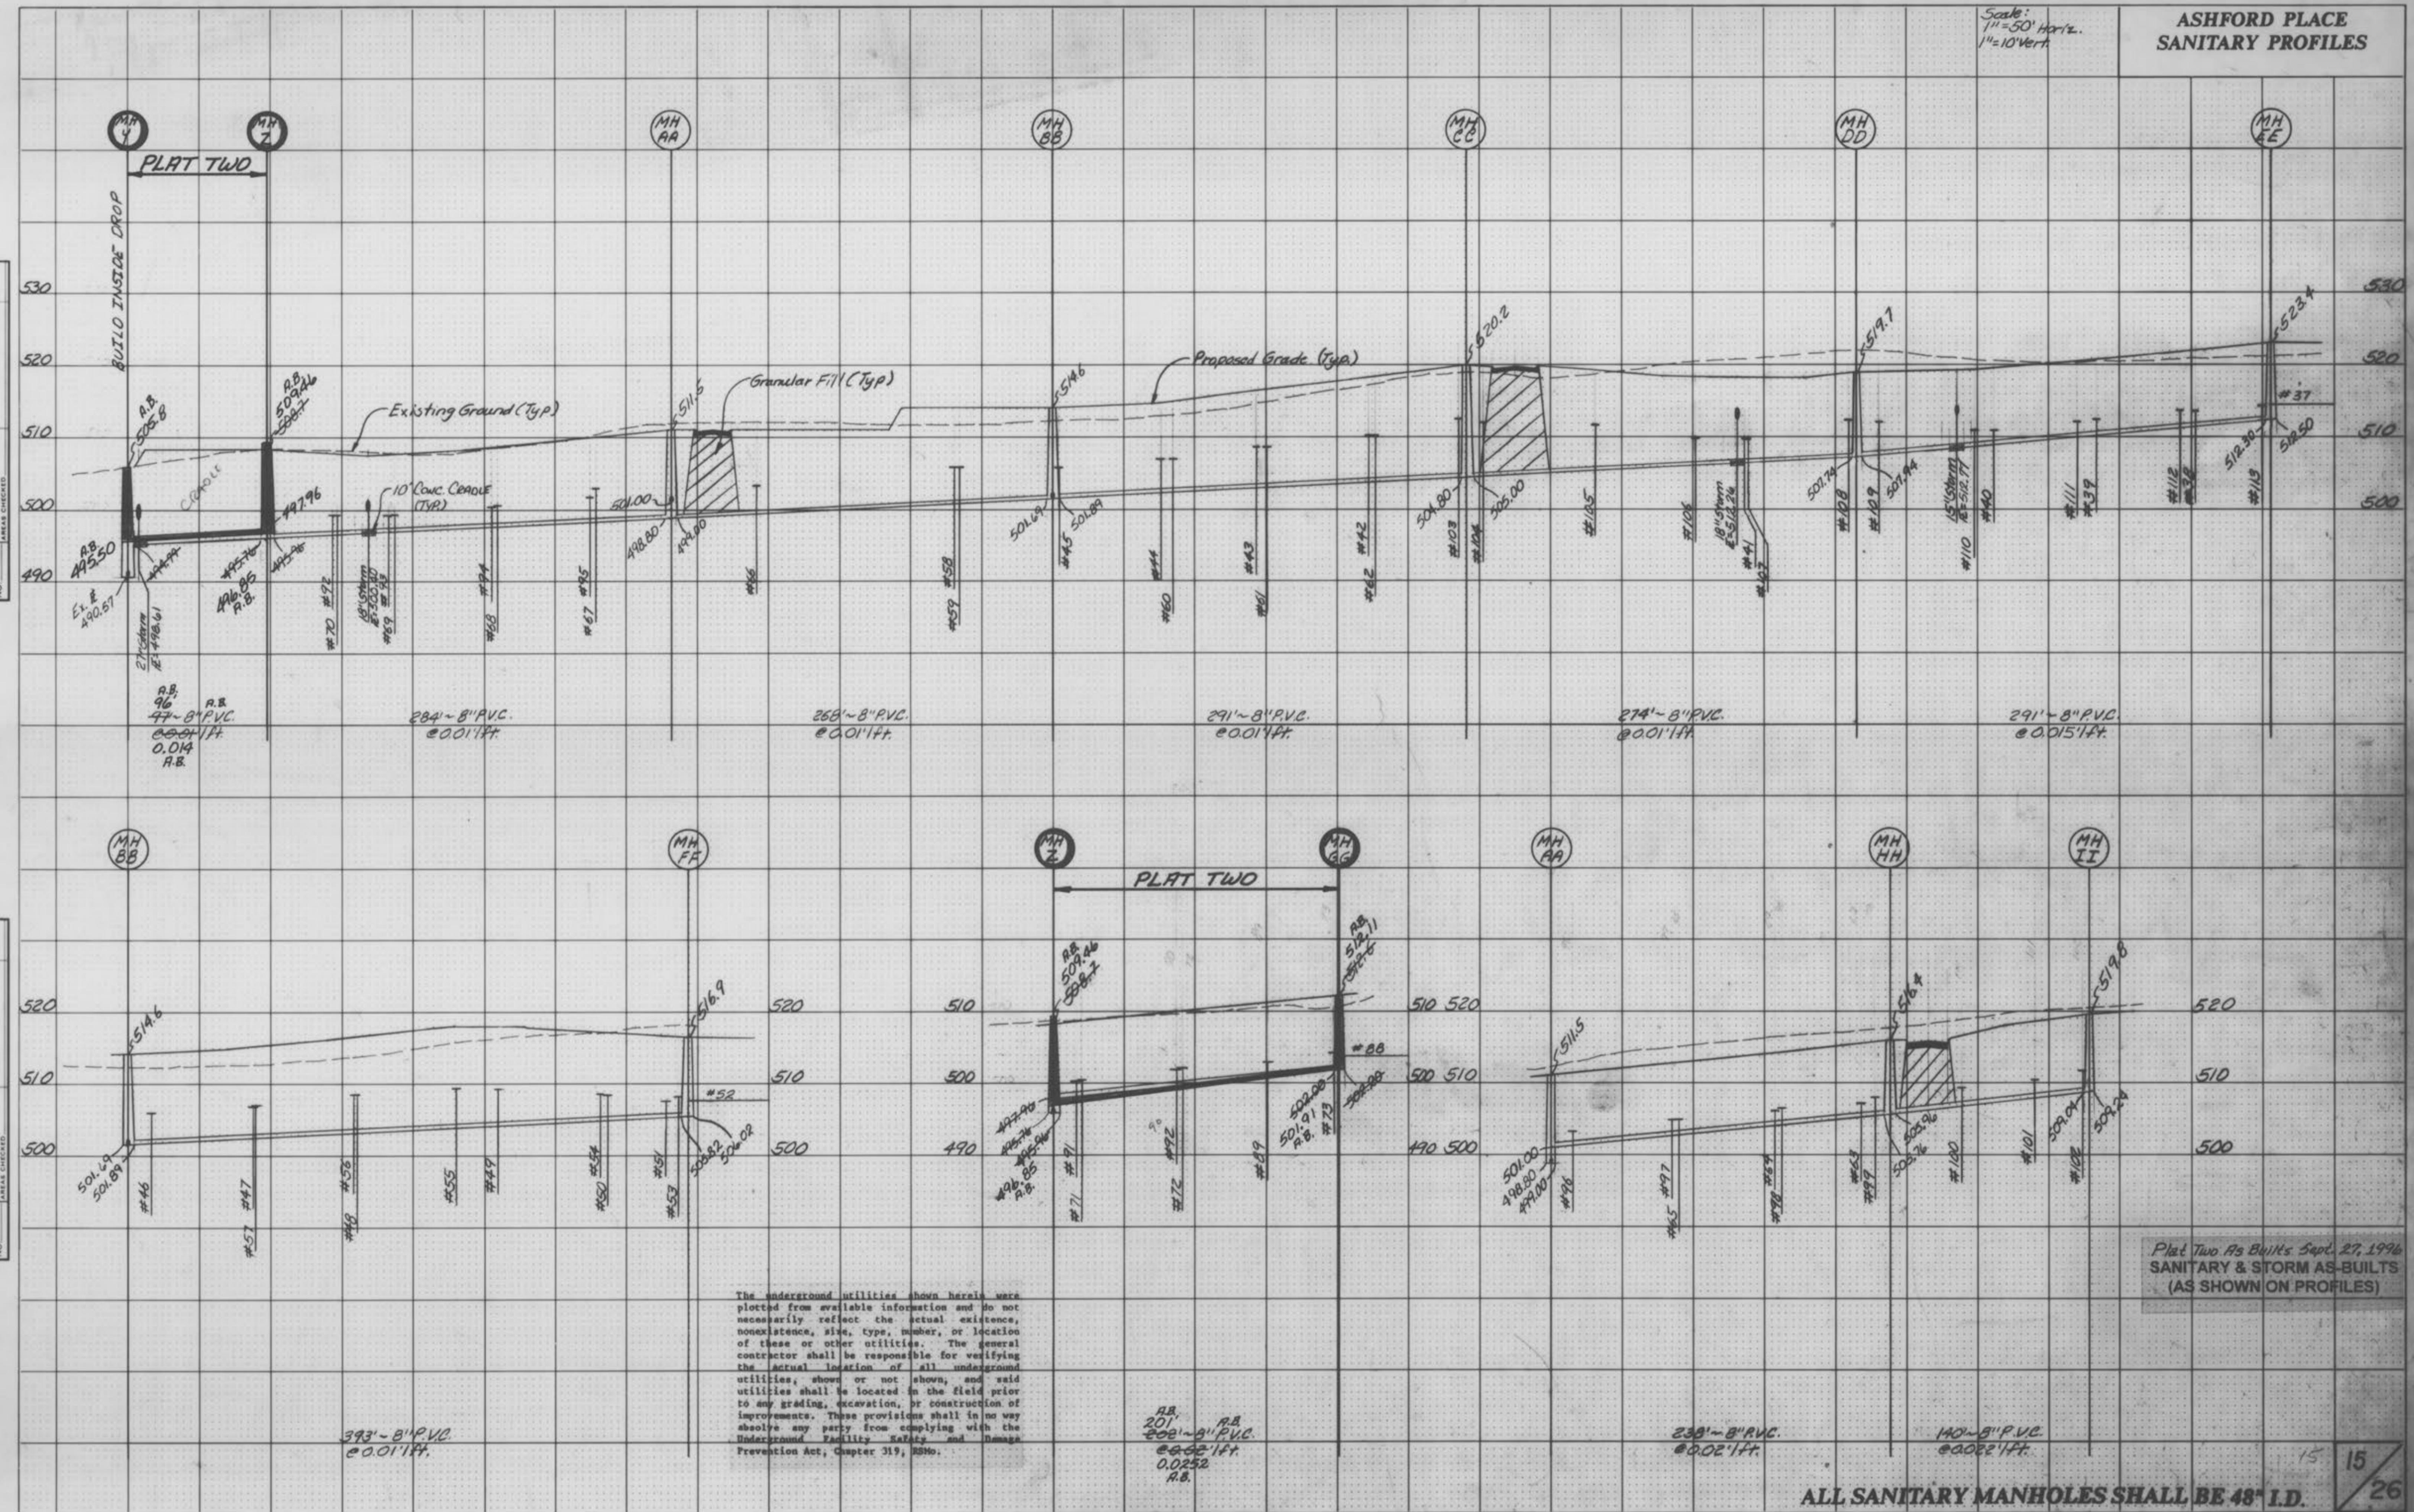



FINAL SURVEY	SURVEYED
BY:	
NOTE BOOK NO.	TEMPERATE AREA CHECKED

ORIGINAL SURVEY	SURVEYED
BY:	
NOTE BOOK NO.	TEMPERATE AREA CHECKED

**ASHFORD PLACE
STORM PROFILES**

SCALE: HORIZ. 1" = 50'
VERT. 1" = 10'

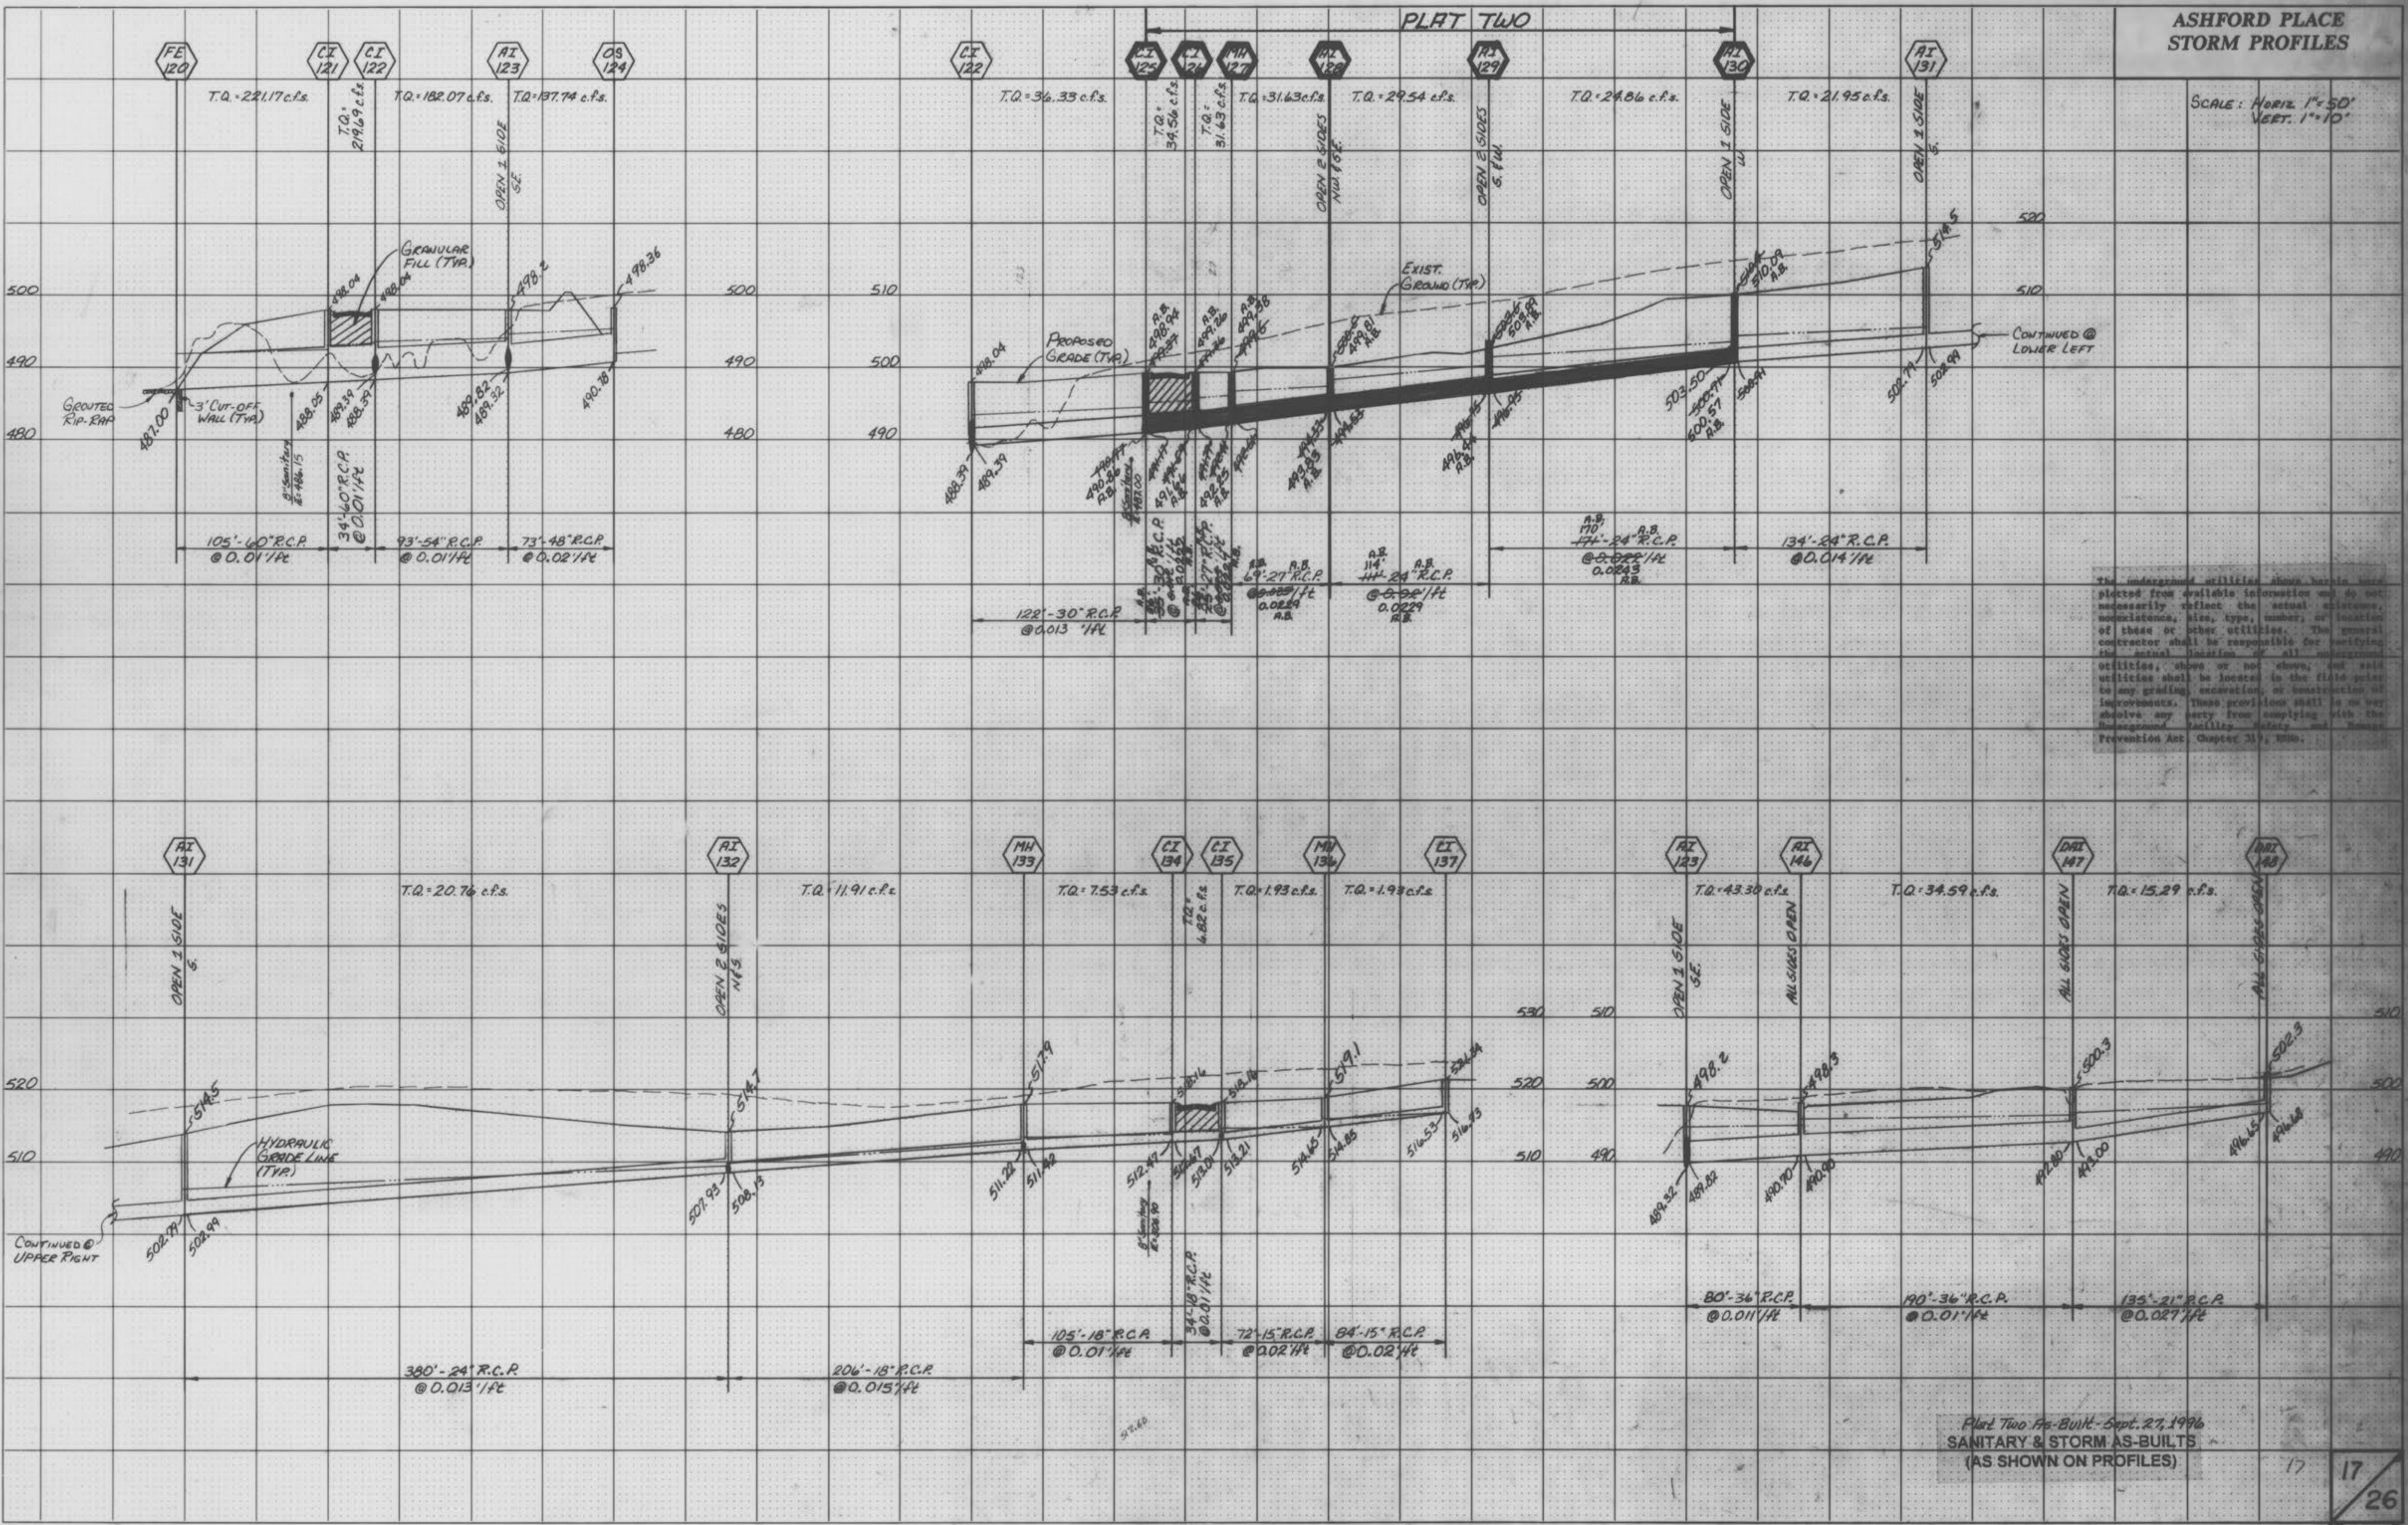

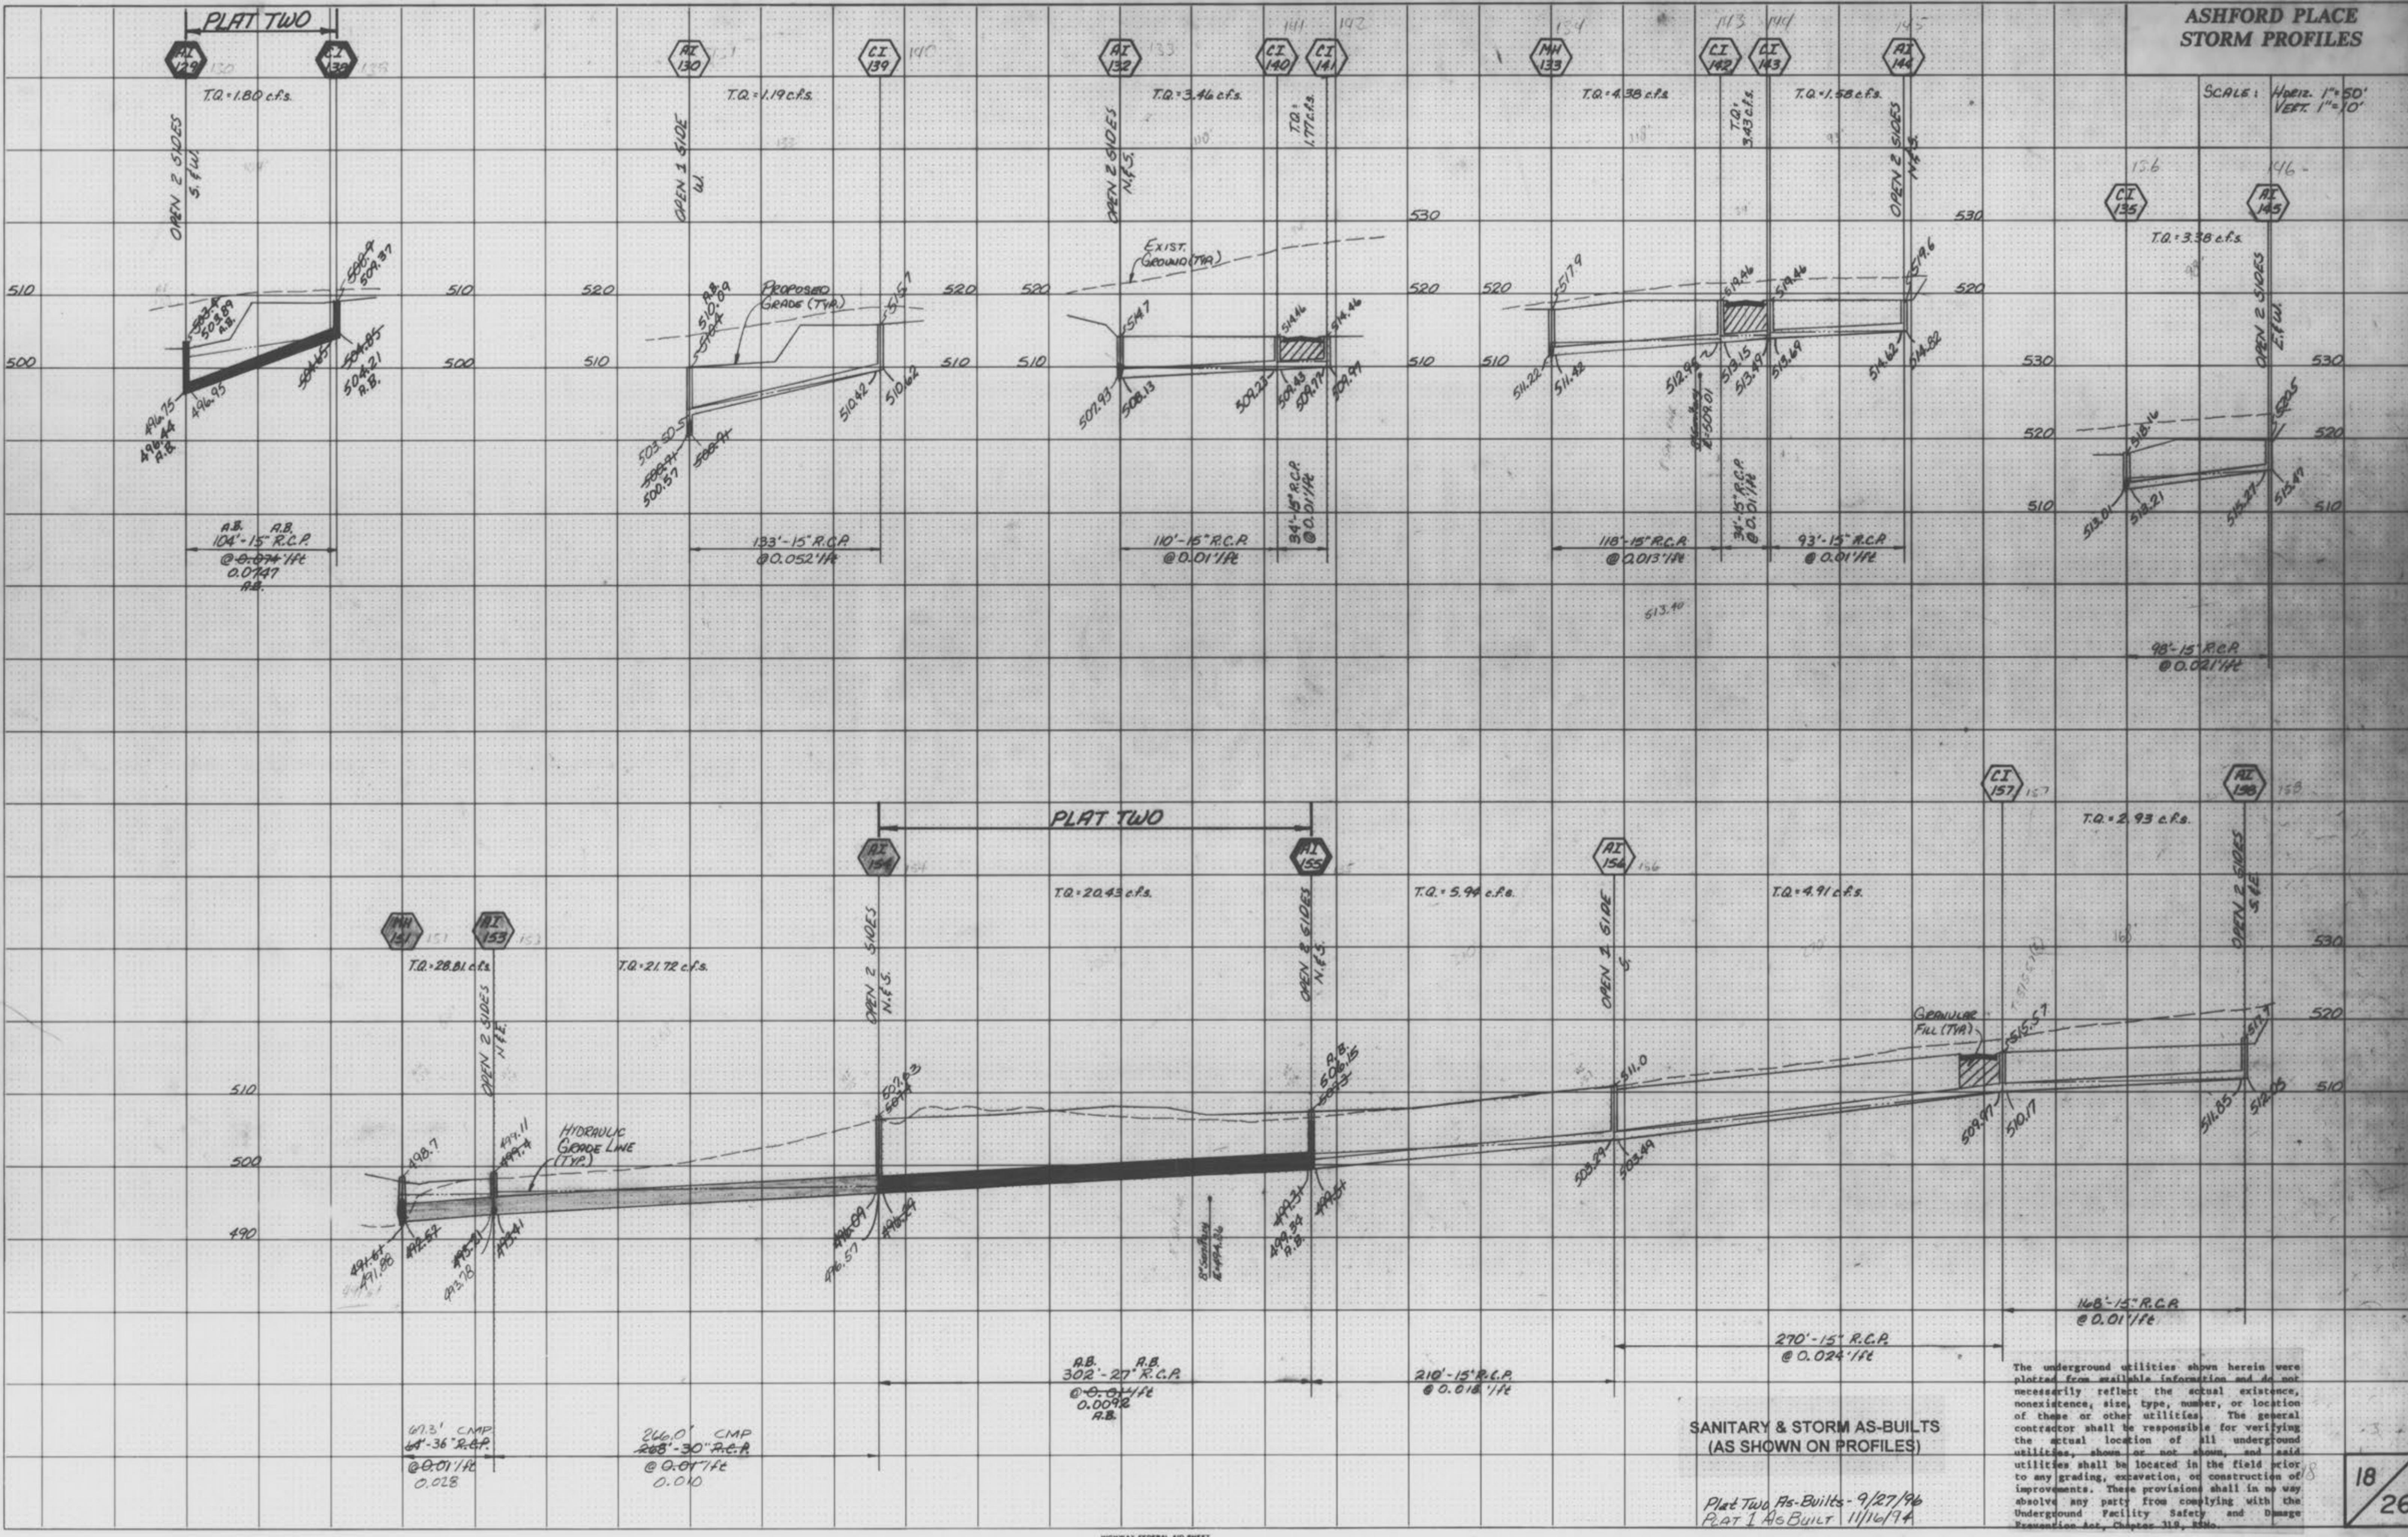

underground utilities shown herein were taken from available information and do not necessarily reflect the actual existence, existence, size, type, number, or location of these or other utilities. The general contractor shall be responsible for verifying the actual location of all underground utilities, shown or not shown, and said utilities shall be located in the field prior to any grading, excavation, or construction of improvements. These provisions shall in no way relieve any party from complying with the Underground Facility Safety and Damage Prevention Act, Chapter 319, RSMo.

**SANITARY & STORM AS-BUILTS
(AS SHOWN ON PROFILES)**

Plat Two As-Builts - 9/27/96
PLAT 1 AS BUILT 11/16/94

**ASHFORD PLACE
STORM PROFILES**

SCALE: HORIZ. 1"=50'
VERT. 1"=10'

