

GENERAL NOTES

- 1) Underground utilities have been plotted from available information and therefore their locations shall be considered approximate only. The verification of the location of all underground utilities, either shown or not shown on these plans shall be the responsibility of the contractor, and shall be located prior to any grading or construction of the improvements.
2) All manhole and inlet tops built without elevations furnished by the Engineer will be the responsibility of the Sewer Contractor.
3) All standard curb inlets to have front of inlet 2' (foot) behind curb.
4) Storm sewers 18" diameter and smaller shall be A.S.T.M. C-14 unless otherwise shown on the plans.
5) Storm sewers 21" diameter and larger shall be A.S.T.M. C-76, Class II minimum, unless otherwise shown on the plans.
6) All storm pipe in the right-of-way shall be reinforced concrete pipe (A.S.T.M. C-76 Class III minimum).
7) 8" P.V.C. sanitary sewer pipe shall meet the following standards. A.S.T.M.-D-3034 SDR-35, with wall thickness compression joint A.S.T.M.-D-3212. An appropriate rubber seal waterstop as approved by the sewer district shall be installed between P.V.C. pipe and masonry structures.
8) All filled places, including trench backfills, under buildings, proposed storm and sanitary sewer lines and/or paved areas, shall be compacted to 90% maximum density as determined by the "Modified AASHTO T-99 Compaction Test," (A.S.T.M.-D-1557). All filled places within public roadways shall be compacted to 95% of maximum density as determined by the "Standard Proctor Test AASHTO T-99, Method C" (A.S.T.M. D-698).
9) All trench backfills within the public right-of-way shall be granular backfill. Granular backfill shall be water jetted to attain proper compaction. Trench backfills under paved areas, outside of public right-of-way may be granular backfill in lieu of the earth backfill compacted to 90% of the Modified AASHTO Compaction Test.
10) No area shall be cleared without the permission of the Project Engineer.
11) All grades shall be within 0.2 feet of those shown on the grading plan.
12) No slope shall be steeper than 3:1. All slopes shall be sodded or seeded and mulched.
13) All construction and materials used shall conform to current City of O'Fallon and Missouri Cities Water Company standards.
14) All P.V.C. sanitary pipe to have crushed stone bedding uniformly graded between 1" and 1/4" size. This bedding shall extend from 6" below the pipe to 12" of crushed stone bedding above top of pipe.
15) All soils tests shall be verified by a Soils Engineer concurrent with the grading and backfilling operations.
16) A 25' building line shall be established along all public rights-of-way.
17) Easements shall be provided for storm sewers, sanitary sewers, and all utilities on the record plat. See record plat for location and size of easements.
18) All water lines shall be laid at least 10 feet horizontally, from any sanitary sewer, storm sewer, or manhole. Whenever water lines must cross sanitary sewers, laterals or storm drains the water line shall be laid at such an elevation that the bottom of the water line is 18 inches above the top of the drain or sewer. A full length of water pipe shall be centered over the sewer line to be crossed so that the joints will be equally distant from the sewer and as remote therefrom as possible. This vertical separation shall be maintained for that portion of the water line located within 10 feet, horizontally, of any sewer or drain it crosses.
19) All P.V.C. water pipe shall have a minimum pressure rating of PS-200 or SDR-21.
20) Water lines, valves, sleeves, meters and etc. shall meet all specifications and installation requirements of the local governing authority.
21) All ductile iron pipe for water mains shall conform to A.W.W.A. Specifications C-106 and/or C-108. The ductile iron fitting shall conform to A.W.W.A. Specification C-110. All rubber gasket joints for water ductile iron pressure pipe and fittings shall conform to A.W.W.A. Specification C-111.
22) All water hydrants and valves shall be ductile iron and installed in accordance with plans and details.
23) Hazard markers will consist of four (4) standard specifications, "Manual on Uniform Traffic Control Devices", and of roadway markers mounted on two (2) pound "U" channel sign post. Each marker shall consist of an eighteen (18) inch diamond reflectorized red panel. The bottom of each panel shall be mounted a minimum of four (4) feet above the elevation of the pavement surface.
24) The minimum vertical distance from the low point of the basement to the flowline of a sanitary sewer at the corresponding house connections shall not be less than the diameter of the sanitary sewer plus a vertical distance of not less than 2 1/2 feet.
25) The City of O'Fallon shall be notified 48 hours prior to start of construction of sanitary sewers for coordination and inspection.
26) Siltation control devices shall be as shown on plans, and approved by the local governing authority. Additional siltation control, if required, will be placed at the direction of the soils engineer on-site and the local governing authority prior to placement.
27) All grading on City right-of-way shall be seeded and mulched and all disturbed right-of-way markers shall be reset at the completion of grading.
28) Brick will not be used in the construction of sanitary sewer manholes and all sanitary sewer manholes shall have 3" thick coat of cast concrete bedding ring.


BENCH MARKS :

1. U.S. BENCH MARK (Elevation: 142.14) - 2" diameter "B" on the concrete curb of the south side of Highway 94, 1/4 mile east of the intersection of Highway 94 and the City of O'Fallon.

PLANS FOR CONSTRUCTION OF SANITARY SEWERS, STORM SEWERS, GRADING, PAVING AND WATER MAINS FOR


ASPEN POINTE

A TRACT OF LAND BEING PART OF THE NORTHWEST FRACTIONAL QUARTER OF SECTION 34 AND PART OF THE NORTHEAST FRACTIONAL QUARTER OF SECTION 33 TOWNSHIP 47 NORTH, RANGE 3 EAST, ST. CHARLES COUNTY, MISSOURI
STORM AND SANITARY SEWER AS-BUILTS

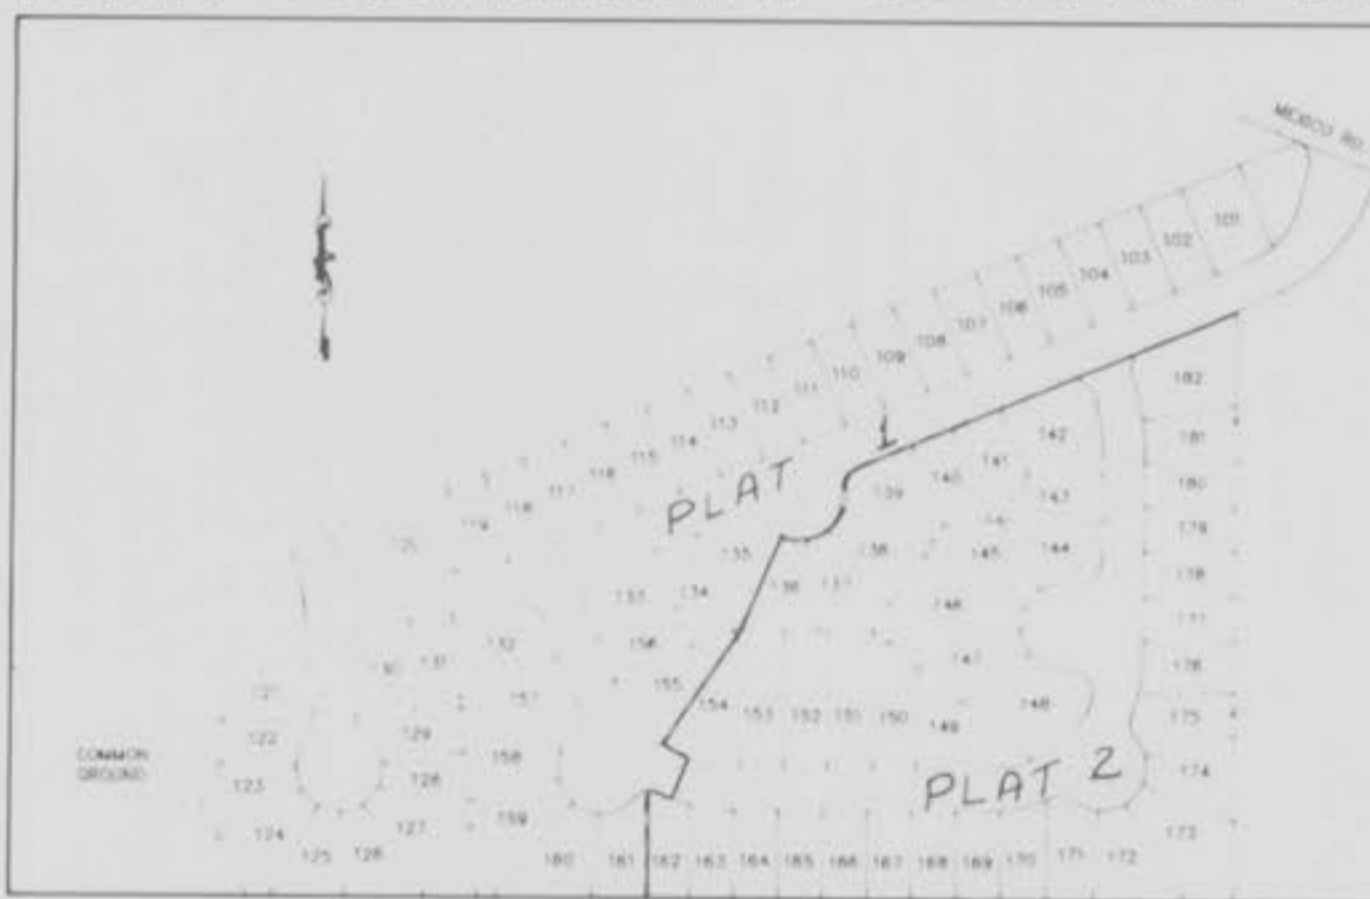

KEY MAP

NOT TO SCALE

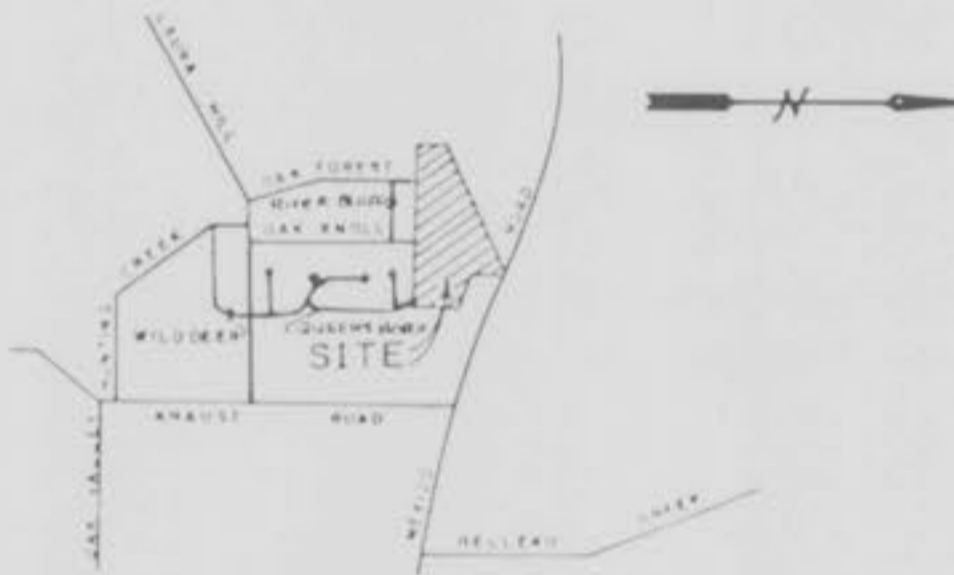

LOCATION MAP

NOT TO SCALE

DEVELOPMENT NOTES

- 1. Gross Acreage of Property: 24.65 acres.
2. Present Zoning Classification: "P.U.D." Planned Unit Development
3. Proposed Use of Property: Single Family Residential Subdivision of 82 Lots and Common Ground.
4. This property will be served by the following utilities:
WATER: Missouri Cities Water Company
SANITARY SEWER: City of O'Fallon
ELECTRIC: Union Electric Company
GAS: St. Charles Gas Company
TELEPHONE: Central Telephone Company
5. This property is located in the following service areas:
Fort Zumwalt School District
O'Fallon Fire Protection District
6. The proposed Height and Lot Area Requirements are as follows:
Minimum Front Yard: 25 feet
Minimum Rear Yard: 25 feet, which may be reduced to 15 feet on corner lots
Minimum Side Yard: 6 feet
Maximum Height of Building: 2 1/2 stories or 35 feet
Minimum Lot Area: 5300 sq. ft.
7. This plat contains the approximate division of gross acreage as follows:
Gross Acreage: 24.65 acres
Acreage in 34-foot Right-of-Way: 3.88 acres
Net Acreage: 20.77 acres
Acreage of Common Grounds: 2.30 acres
Acreage in SFR Lots: 13.47 acres
Acreage in Boys Club: 5.00 acres
Average Area Per SFR Lot: 1,250 sq. ft.

LEGEND

Table with two columns: EXISTING and PROPOSED. It lists various symbols and line styles used in the plans, such as centerlines, spot elevations, property lines, curbs, structures, trees, fences, storm sewers, sanitary sewers, curb and area curbs, manholes, final end systems, cleanouts, utility or power poles, fire hydrants, soil boring, railroad, gas main, water main, telephone, electric, open pipe, to be removed, and to be removed & replaced.

INDEX OF SHEETS

Table with two columns: SHEET NO. and DESCRIPTION. It lists sheets 1 through 12-16 and their corresponding descriptions: COVER SHEET, FLAT PLAN, GRADING PLAN, WATER PLAN, STREET PROFILE, SEWER PROFILE, DRAINAGE AREA MAP, DETENTION BASIN WALL DETAILS, and CONSTRUCTION DETAILS.

BAX ENGINEERING CO., INC.
221 WEST WEST BLVD. ST. CHARLES, MISSOURI 63301
946-6588 724-3330

DEVELOPER:
TRAVIS SHANE CORP.
3910 OLD HIGHWAY 94 SOUTH
STATE 114

AS-BUILTS ADDED JANUARY, 1991


REC. 9-17-92

REV. B-A-10  
 REV. B-16-10

**BOUNDARY DATA**

- ① Δ = 02°32'32" R = 2904.79' L = 128.88'
- ② Δ = 88°37'25" R = 25.00' L = 38.67'
- ③ Δ = 46°08'13" R = 226.61' L = 182.48'
- ④ S 67°49'30" W 35.78'

**GRAPHIC SCALE**

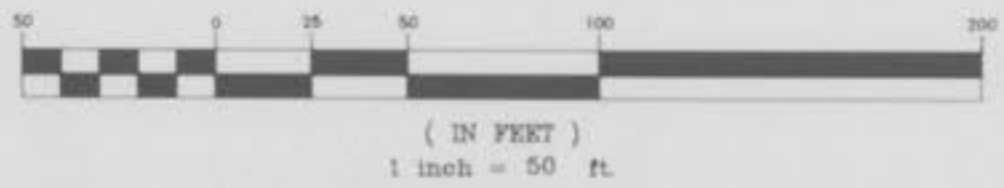

SEWER PROFILE  
**ASPEN POINTE**

JULY 19, 1990 90 3 196  
 REV 8-8-90

FINAL SURVEY  
 DATE: \_\_\_\_\_  
 BY: \_\_\_\_\_  
 CHECKED: \_\_\_\_\_  
 NO. \_\_\_\_\_

ORIGINAL SURVEY  
 DATE: \_\_\_\_\_  
 BY: \_\_\_\_\_  
 CHECKED: \_\_\_\_\_  
 NO. \_\_\_\_\_

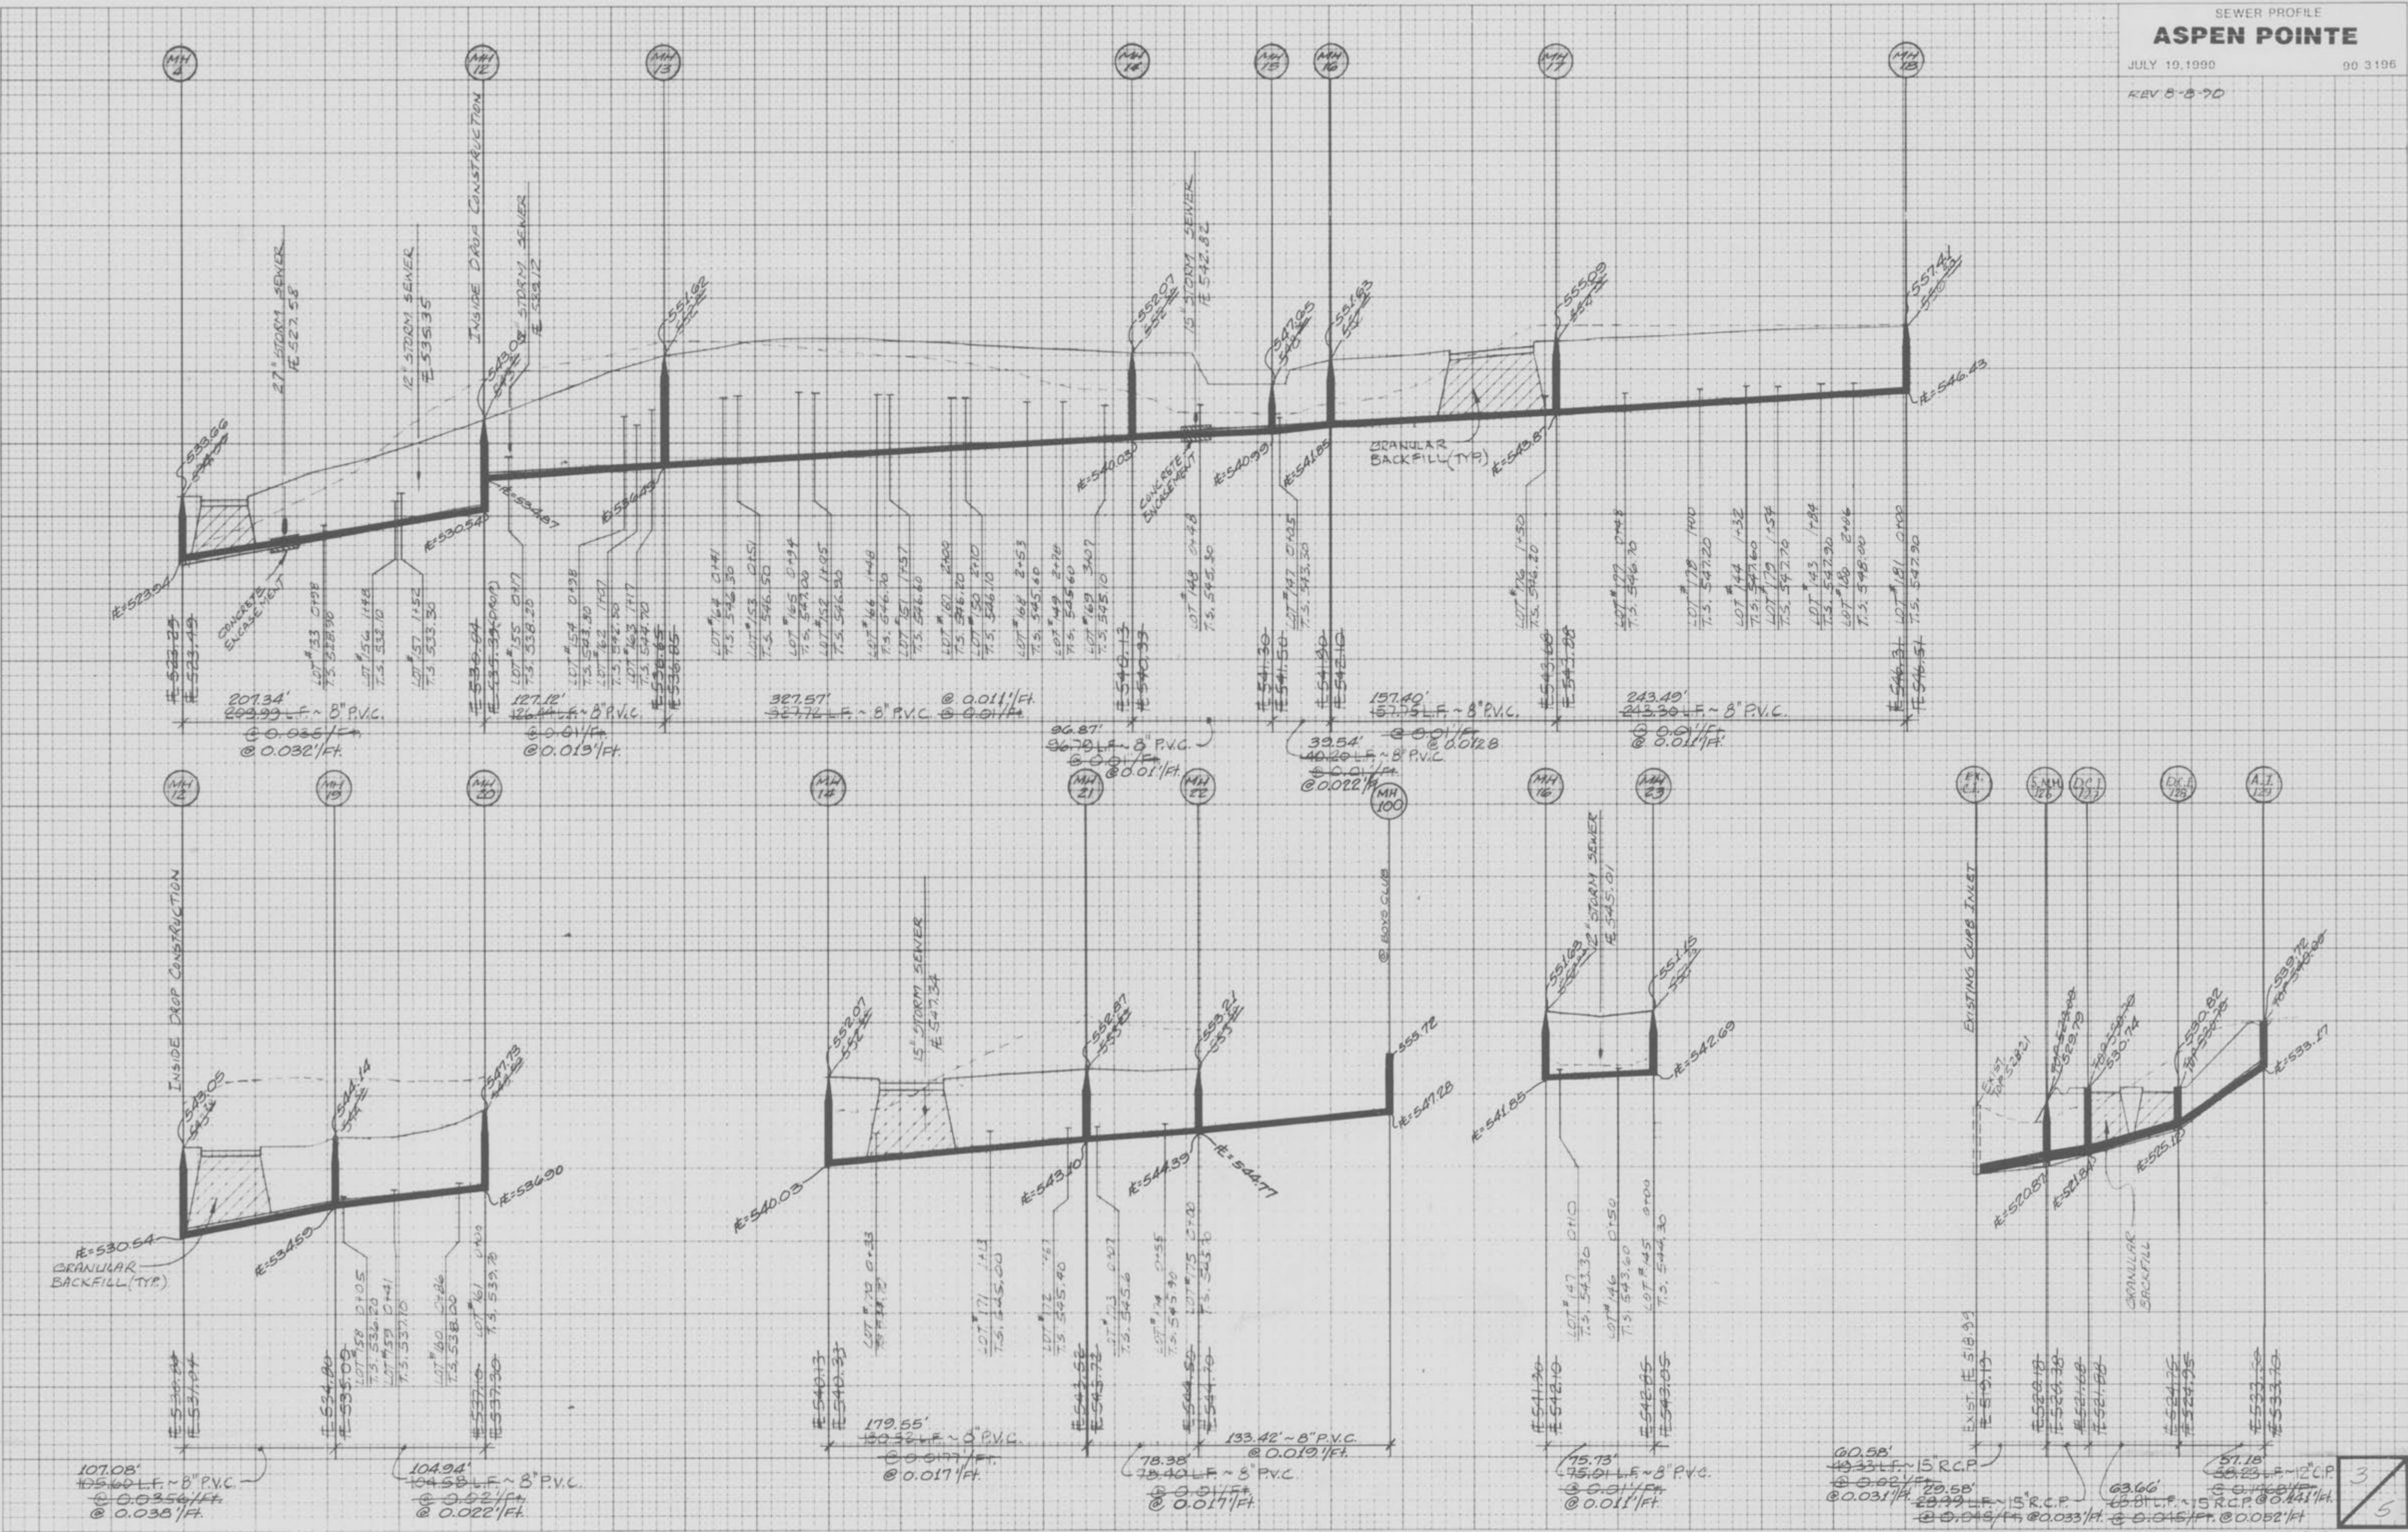


PLATE 3 - FULL CROSS SECTION FOUR LINE  
 FIELD NO. 10

AS-BUILTS ADDED JANUARY, 1991


3  
5

SEWER PROFILE  
**ASPEN POINTE**

JULY 19, 1990  
 REV. 8-8-90  
 REV. 8-16-90

FINAL SURVEY PLOTTED  
 DATE: \_\_\_\_\_ BY: \_\_\_\_\_  
 PROJECT: \_\_\_\_\_  
 SHEET NO. \_\_\_\_\_ OF \_\_\_\_\_  
 AREA: \_\_\_\_\_

ORIGINAL SURVEY PLOTTED  
 DATE: \_\_\_\_\_ BY: \_\_\_\_\_  
 PROJECT: \_\_\_\_\_  
 SHEET NO. \_\_\_\_\_ OF \_\_\_\_\_  
 AREA: \_\_\_\_\_

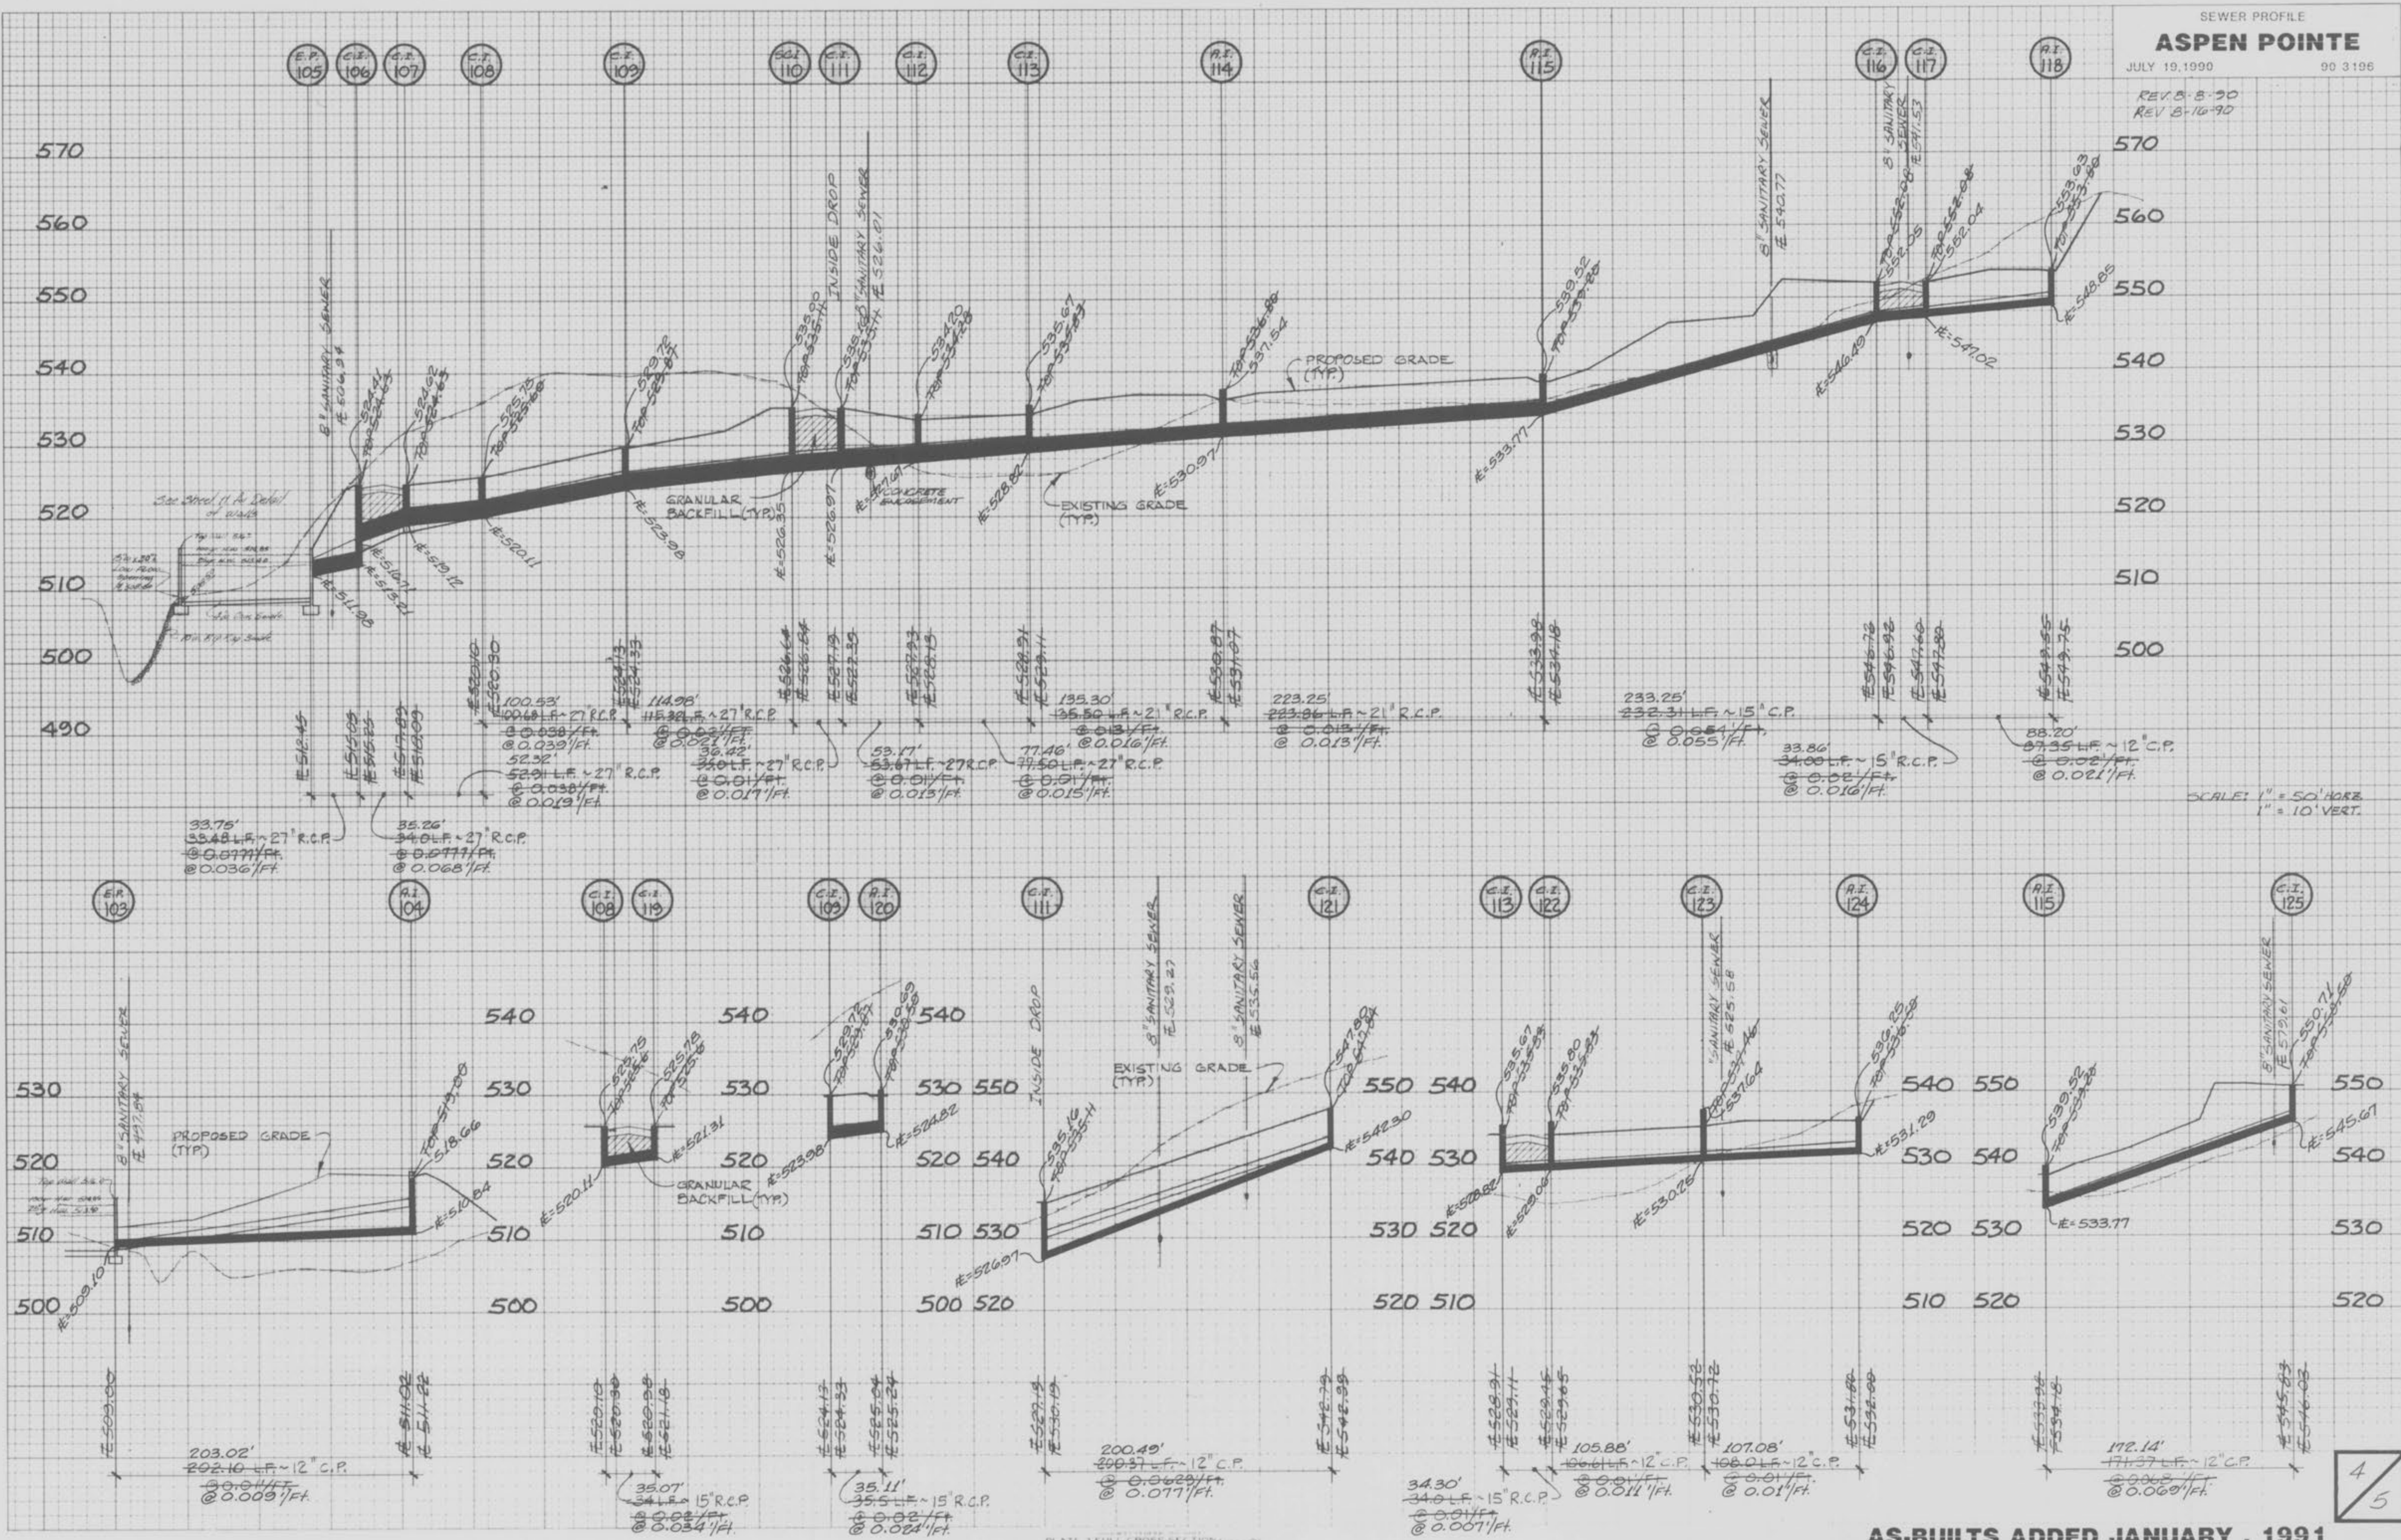

SCALE: 1" = 50' HORZ.  
 1" = 10' VERT.


PLATE 3 FULL CROSS SECTION

AS-BUILTS ADDED JANUARY, 1991

4  
5

FINAL SURVEY  
 SURVEY  
 DATE  
 BY  
 NO.

ORIGINAL SURVEY  
 SURVEY  
 DATE  
 BY  
 NO.

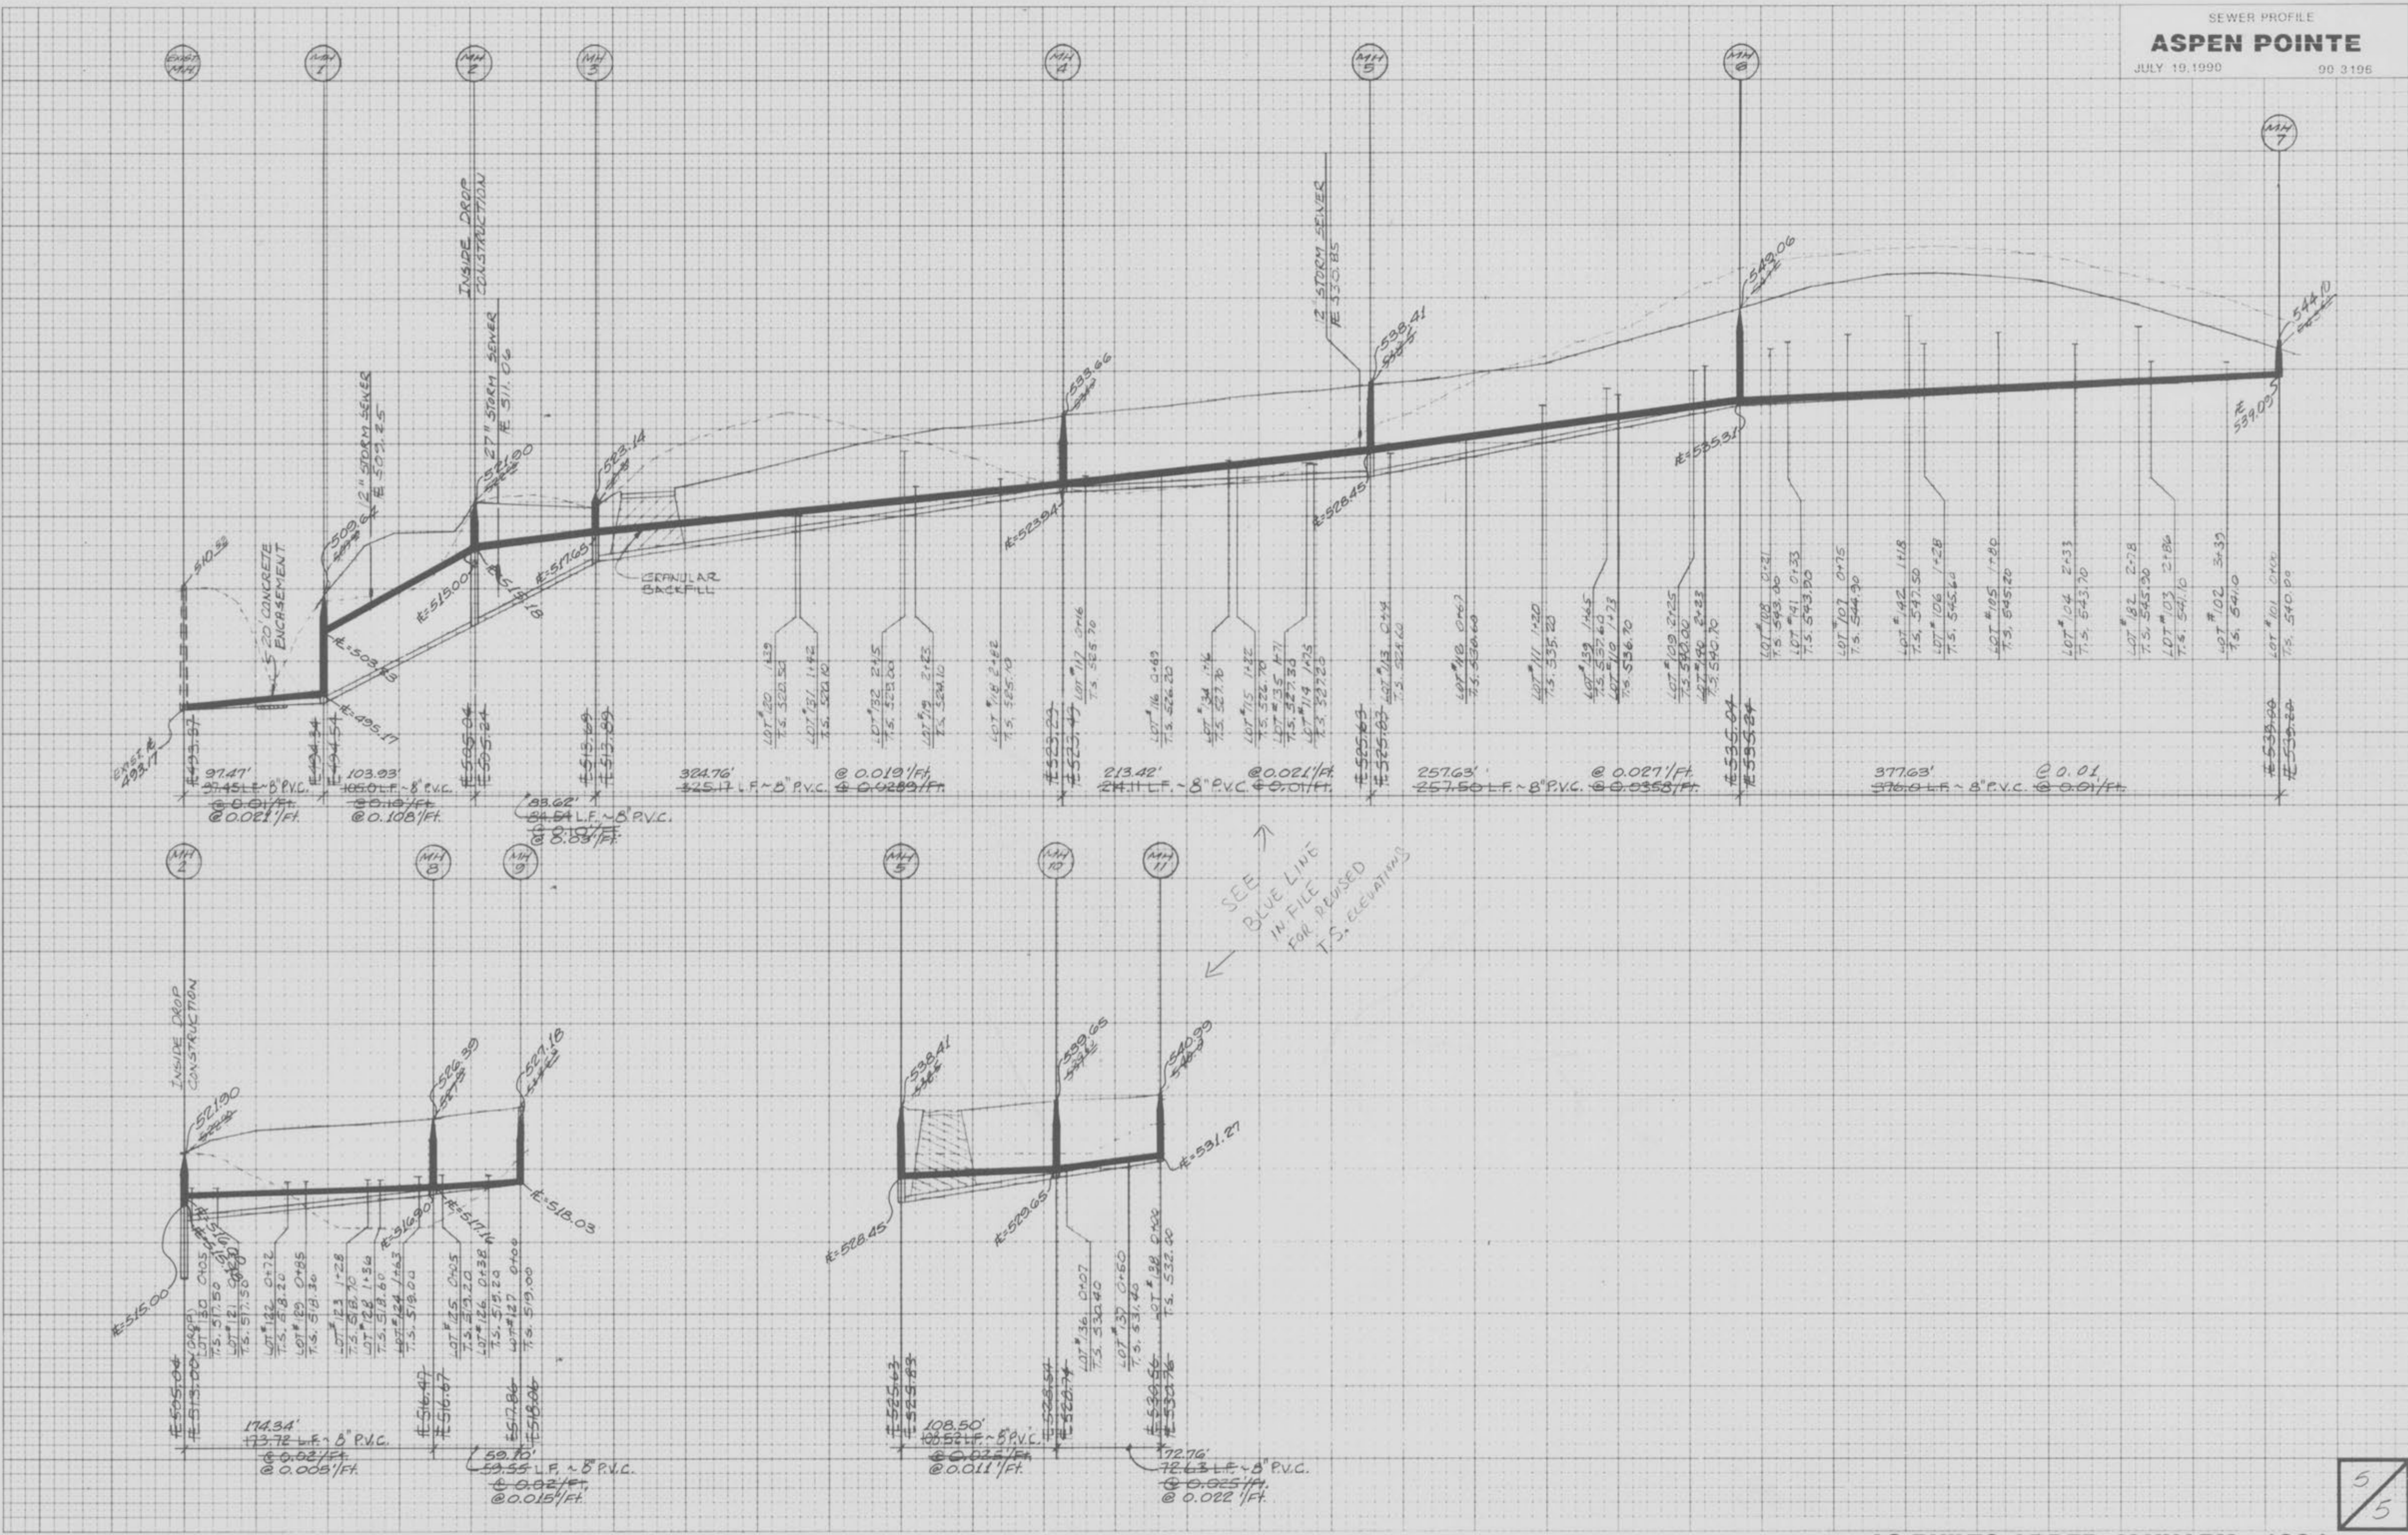

SEE BLUE LINE  
 IN FILE  
 FOR REVISED  
 T.S. ELEVATIONS

5  
 5

AS-BUILTS ADDED JANUARY, 1991

PLATE 3 FULL CROSS SECTION