

GENERAL NOTES

- Underground utilities have been plotted from available information and therefore their locations shall be considered approximate only. The verification of the location of all underground utilities, either shown or not shown on these plans shall be the responsibility of the contractor, and shall be located prior to any grading or construction of the improvements.
- All manhole and inlet tops built without elevations furnished by the Engineer will be the responsibility of the Sewer Contractor.
- All standard curb inlets to have front of inlet 2' (foot) behind curb.
- Storm sewers 18" diameter and smaller shall be A.S.T.M. C-14 unless otherwise shown on the plans.
- Storm sewers 21" diameter and larger shall be A.S.T.M. C-76, Class II minimum, unless otherwise shown on the plans.
- All storm pipe in the right-of-way shall be reinforced concrete pipe (A.S.T.M. C-76 Class III minimum).
- 8" P.V.C. sanitary sewer pipe shall meet the following standards. A.S.T.M.-D-3034 SDR-35, with wall thickness compression joint A.S.T.M.-D-3212. An appropriate rubber seal waterstop as approved by the sewer district shall be installed between P.V.C. pipe and masonry structures.
- All filled places, including trench backfills, under buildings, proposed storm and sanitary sewer lines and/or paved areas, shall be compacted to 90% maximum density as determined by the "Modified AASHTO T-180 Compaction Test," (A.S.T.M.-D-1557). All filled places within public roadways shall be compacted to 95% of maximum density as determined by the "Standard Proctor Test AASHTO T-99, Method C" (A.S.T.M. D-698).
- All trench backfills within the public right-of-way shall be granular backfill. Granular backfill shall be water jetted to attain proper compaction. Trench backfills under paved areas, outside of public right-of-way may be granular backfill in lieu of the earth backfill compacted to 90% of the Modified AASHTO Compaction Test.
- No area shall be cleared without the permission of the Project Engineer.
- All grades shall be within 0.2 feet of those shown on the grading plan.
- No slope shall be steeper than 3:1. All slopes shall be sodded or seeded and mulched.
- All construction and materials used shall conform to current City of O'Fallon, East-Central Missouri Water and Sewer Authority and Missouri Cities Water Company Standards.
- All P.V.C. sanitary pipe to have crushed stone bedding uniformly graded between 1" and 1/4" size. This bedding shall extend from 3" below the pipe to 12" ABOVE THE TOP OF PIPE.
- All soils tests shall be verified by a Soils Engineer concurrent with the grading and backfilling operations.
- A 25' building line shall be established along all public rights-of-way.
- Easements shall be provided for storm sewers, sanitary sewers, and all utilities on the record plat. See record plat for location and size of easements.
- All water lines shall be laid at least 10 feet horizontally, from any sanitary sewer, storm sewer, or manhole. Whenever water lines must cross sanitary sewers, laterals or storm drains the water line shall be laid at such an elevation that the bottom of the water line is 18 inches above the top of the drain or sewer. A full length of water pipe shall be centered over the sewer line to be crossed so that the joints will be equally distant from the sewer and as remote therefrom as possible. This vertical separation shall be maintained for that portion of the water line located within 10 feet, horizontally, of any sewer or drain it crosses.
- All P.V.C. water pipe shall have a minimum pressure rating of PR-200 or SDR-21.
- Water lines, valves, sleeves, meters and etc. shall meet all specifications and installation requirements of the local governing authority.
- All ductile iron pipe for water mains shall conform to A.W.W.A. Specifications C-106 and/or C-108. The ductile iron fitting shall conform to A.W.W.A. Specification C-110. All rubber gasket joints for water ductile iron pressure pipe and fittings shall conform to A.W.W.A. Specification C-111.
- All water hydrants and valves shall be ductile iron and installed in accordance with plans and details.
- The minimum vertical distance from the low point of the basement to the flowline of a sanitary sewer at the corresponding house connections shall not be less than the diameter of the sanitary sewer plus a vertical distance of not less than 2 1/2 feet.
- The City of O'Fallon and East-Central Missouri Water and Sewer Authority shall be notified 48 hours prior to start of construction of sanitary sewers for coordination and inspection.
- Siltation control devices shall be as shown on plans, and approved by the local governing authority. Additional siltation control, if required, will be placed at the direction of the soils engineer on-site and the local governing authority prior to placement.

**PLANS FOR CONSTRUCTION OF
SANITARY SEWERS, STORM SEWERS,
GRADING, PAVING AND WATER MAINS
FOR**

AUTUMN CHASE

A TRACT OF LAND BEING PART OF LOT 1
OF BELLEAU RIDGE PLAZA SUBDIVISION IN THE
NORTHWEST FRACTIONAL QUARTER OF SECTION 33
TOWNSHIP 47 NORTH, RANGE 3 EAST, ST. CHARLES COUNTY, MISSOURI

WATER SANITARY AND STORM SEWER AS-BUILTS



KEY MAP



**LOCATION MAP
DEVELOPMENT NOTES**

- Gross Acreage of Property: 16.84 acres
- Present Zoning Classification:
R-4 P.U.D., Apartment House District Planned Unit Development
C-2 P.U.D., General Business District Planned Unit Development
- Proposed Use: Single Family Residential Subdivision
- This property will be served by the following utilities:
WATER: St. Charles County Water District No. 2
SANITARY SEWER: City of O'Fallon
ELECTRIC: Union Electric Company
GAS: St. Charles Gas Company
TELEPHONE: Centel Telephone Company
- This property is located in the following service areas:
Fort Zumwalt School District
O'Fallon Fire Protection District
- The proposed Height and Lot Area Requirements are as follows:
RESIDENTIAL TRACT:
Minimum Front Yard: 25 feet
Minimum Rear Yard: 25 feet
Minimum Side Yard: 6 feet
Maximum Height of Building: 2 1/2 stories or 35 feet
Minimum Lot Area: 5500 square feet
- This plat contains the approximate division of gross acreage as follows:
Gross Acreage: 16.84 acres
Acreage in Street Right-of-Way: 3.28 acres
Net Acreage: 13.56 acres
Acreage of Common Ground: 0.71 acres
Acreage in SFR Lots: 12.85 acres
Average Area Per SFR Lots:
Net Acreage = 13.56 Acres
Number of Lots = 78 Lots = 7,572 square feet per lot
- This property is proposed to be developed in one stage only.

LEGEND :

EXISTING		PROPOSED
400	Contours	(400)
451	Spot Elevation	(456)
---	Building Line	---
---	Property Line	---
---	Center Line	---
---	Structure	---
---	Tree or Bush	---
---	Fence	Chain, Link
---	Storm Sewer	---
---	Sanitary Sewer	---
---	Curb or Area Catch Basin	---
---	Grated Inlet	---
---	Manhole	---
---	Flared End Section	---
---	Cleanout	---
---	Utility or Power Pole	---
---	Fire Hydrant	---
---	Soil Boring	---
---	Railroad	---
---	Gas Main	---
---	Water Main	---
---	Telephone	---
---	Electric	---
---	Use in Place	(U.P.)
---	To Be Removed	(T.B.R.)
---	To Be Removed & Replaced	(T.B.R.R.)
---	Scale	---
---	Light Standard	---
---	Handicapped	---

INDEX

- | | |
|---------------------|--------------------------------|
| SHEET 1 | COVER SHEET |
| SHEET 2 | FLAT PLAN |
| SHEET 3 | GRADING PLAN |
| SHEETS 3-4 | SANITARY SEWER PROFILES |
| SHEETS 5-6 | STORM SEWER PROFILES |
| SHEET 7 | WATER PLAN |
| SHEETS 9-10 | STREET PROFILES |
| SHEET 11 | DRAINAGE AREA MAP |
| SHEETS 12-16 | CONSTRUCTION DETAILS |

AS-BUILTS ADDED JULY, 1992



DEVELOPER:
TRAVIS SHANE CORP.
3910 OLD HIGHWAY 94 SOUTH
SUITE 114
ST. CHARLES, MISSOURI 63303
TELEPHONE (314) 928-8108

Aug 1991
0118
71-3355
PROJECT NUMBER
1
SHEET 16

221 Point West Boulevard
St. Charles, MO 63031
314-928-6888 FAX 913-9182
314-724-0300

This is to certify that the following as-built locations were located in the field and are correctly shown herein.

Neal J. Niewald, MO. Reg. L.S. # 2117

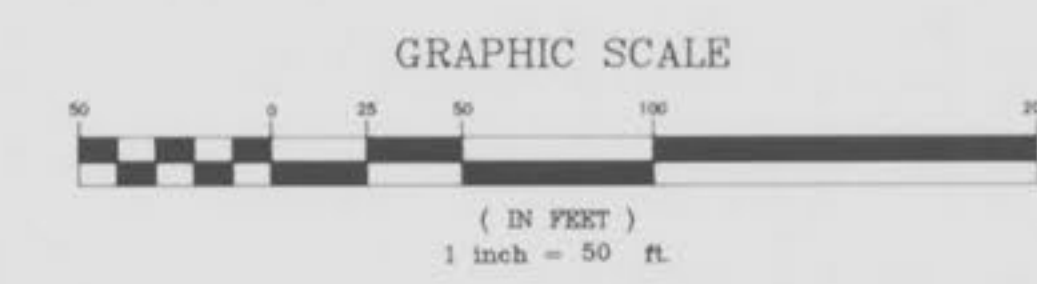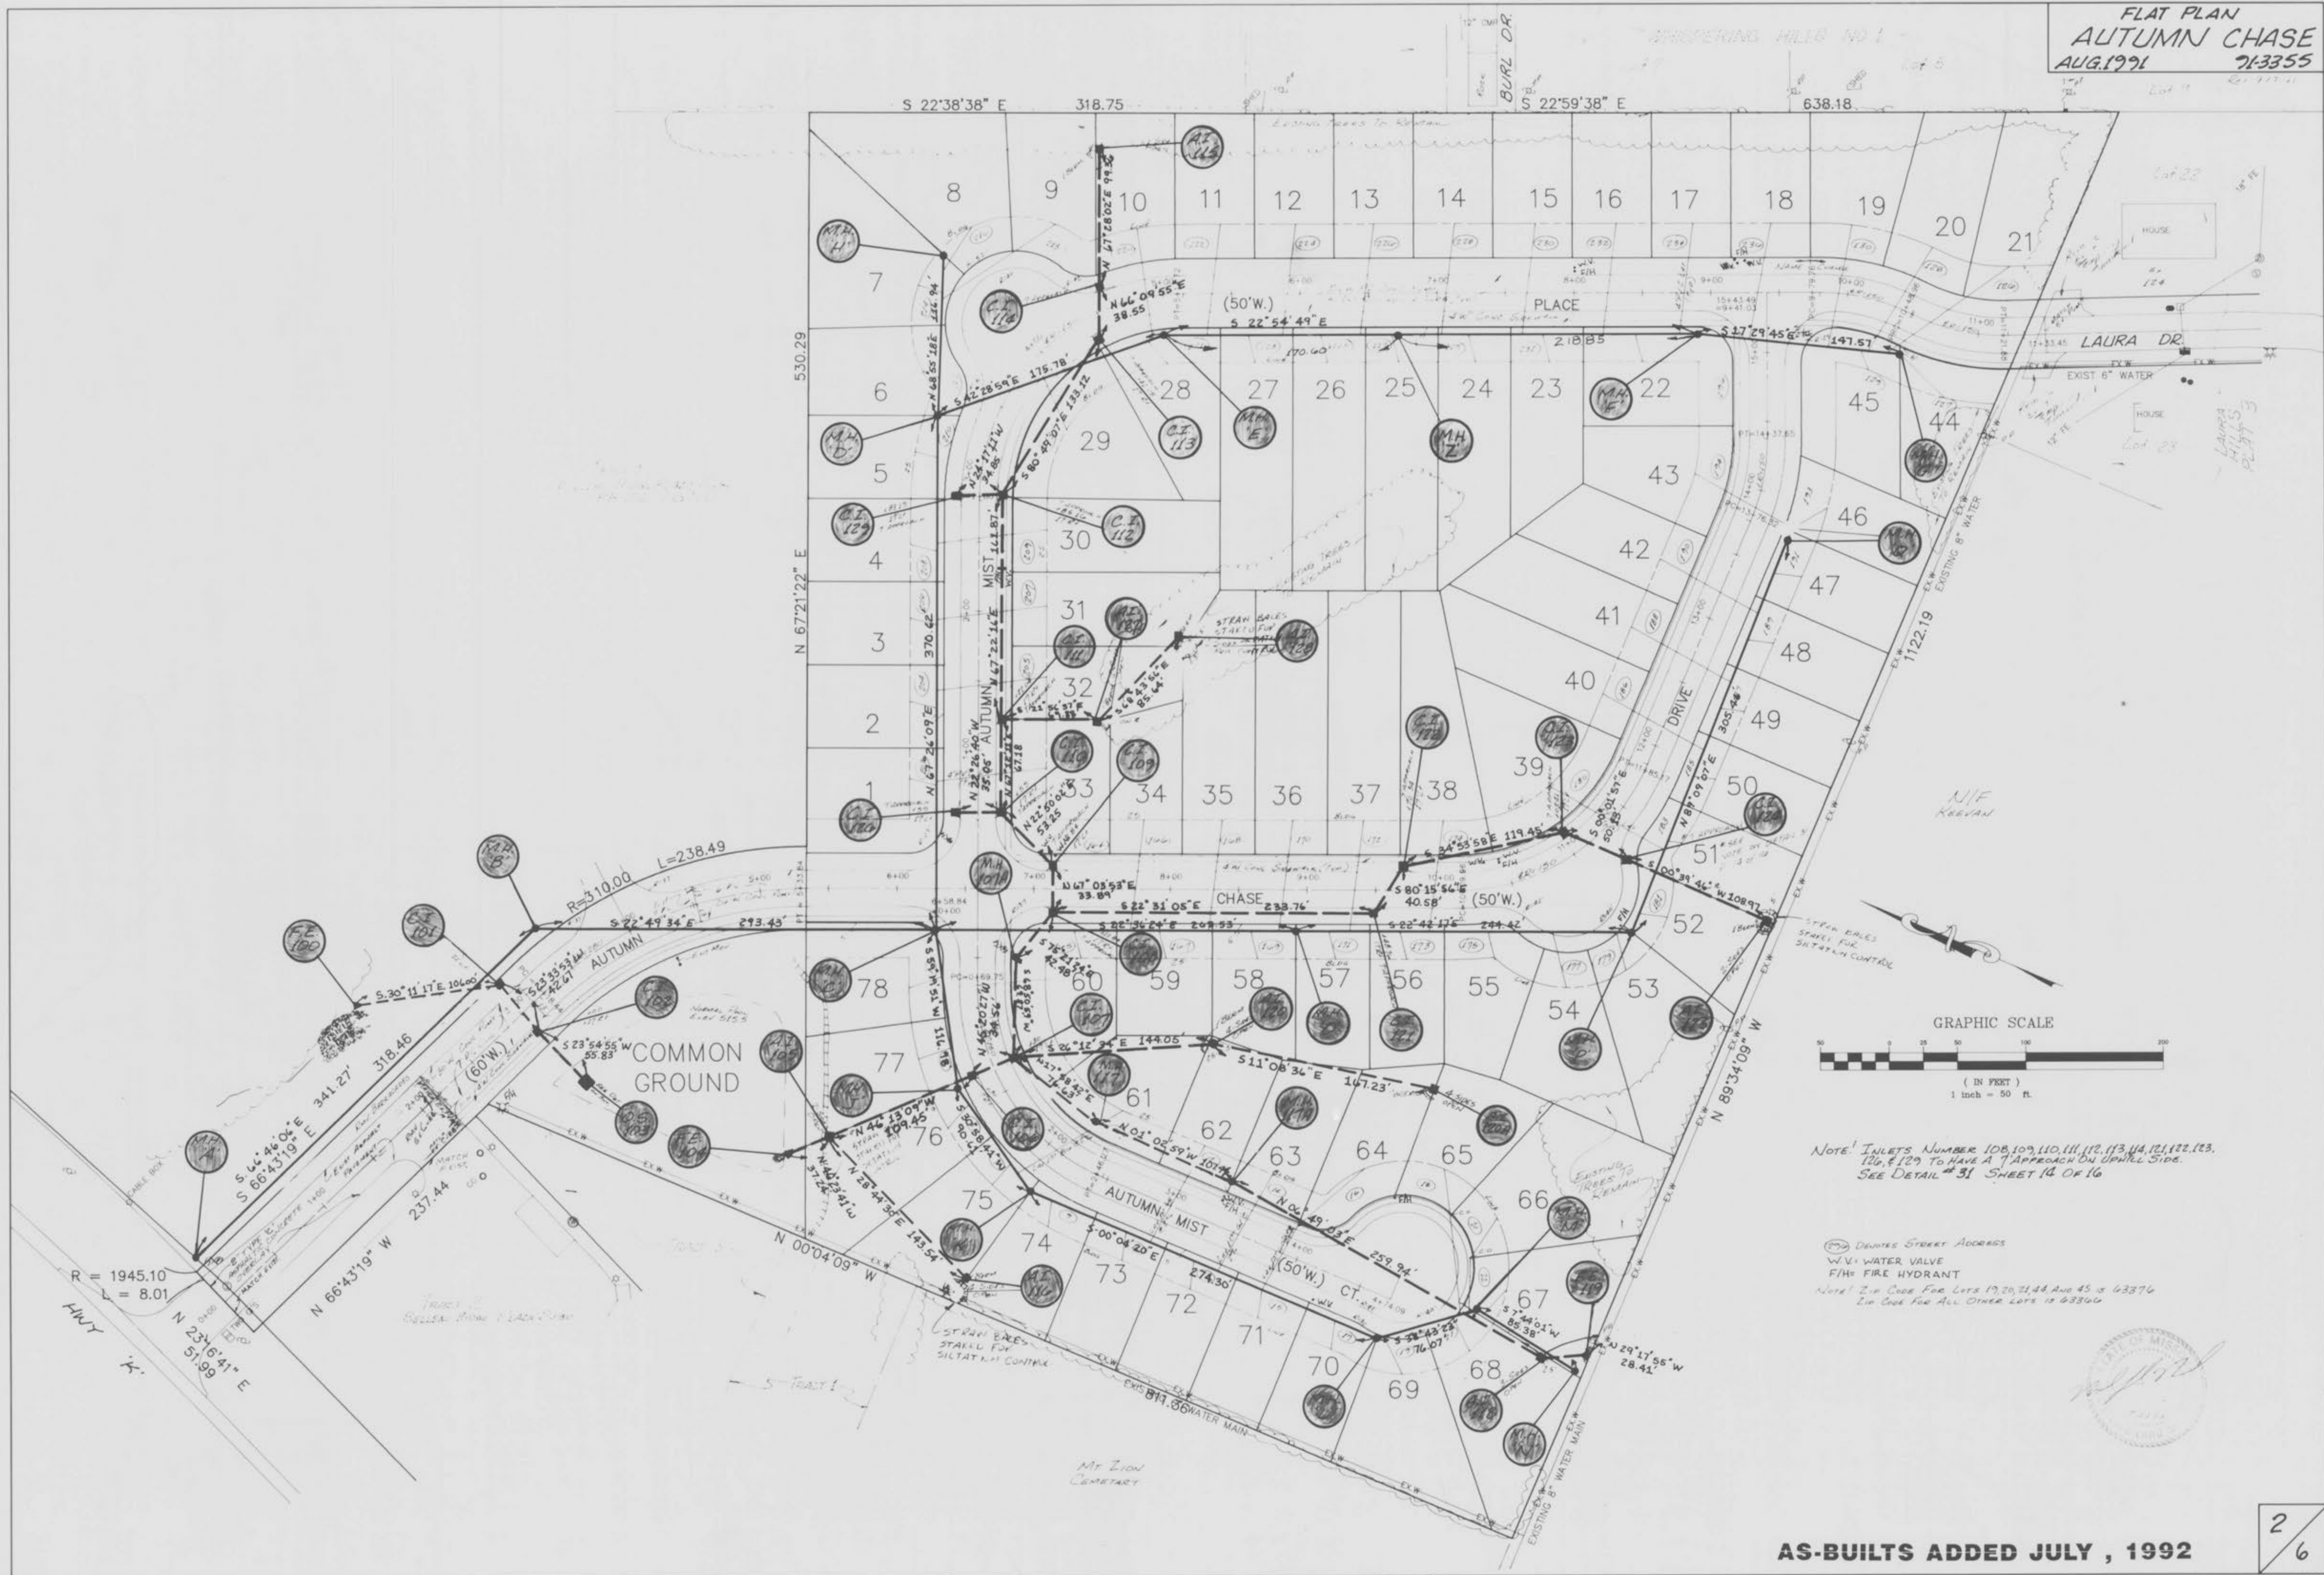


NOTE: INLETS NUMBER 108, 109, 110, 111, 112, 113, 114, 121, 122, 123, 126, & 129 TO HAVE A 7' APPROACH ON UPWELL SIDE. SEE DETAIL # 31 SHEET 14 OF 16

⊙ DENOTES STREET ADDRESSES
 W/V = WATER VALVE
 F/H = FIRE HYDRANT
 NOTE: ZIP CODE FOR LOTS 19, 20, 21, 44 AND 45 IS 63374
 ZIP CODE FOR ALL OTHER LOTS IS 63360


AS-BUILTS ADDED JULY, 1992

FINAL SURVEY

SCALE: 1" = 50' HOR
 1" = 10' VERT

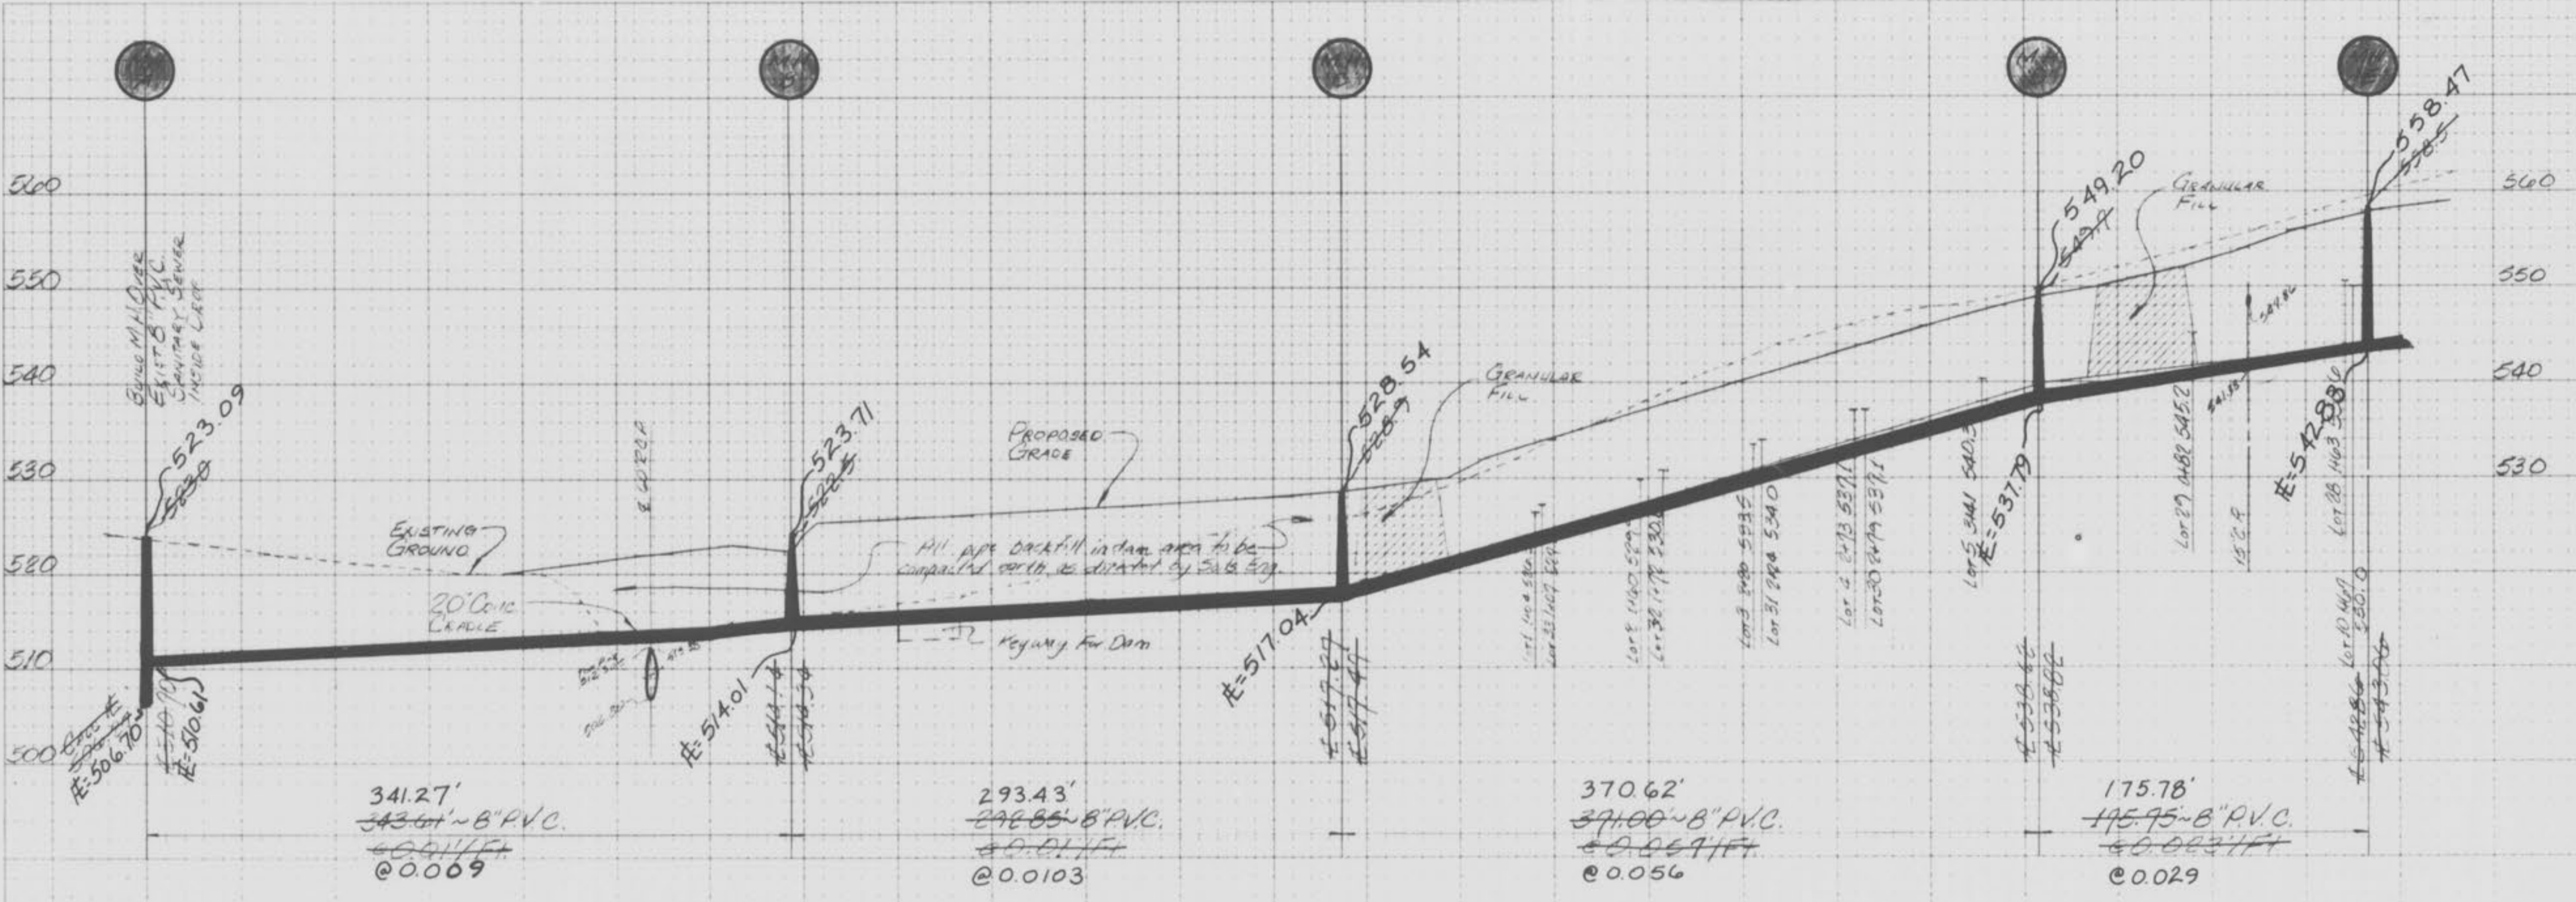

FINAL SURVEY

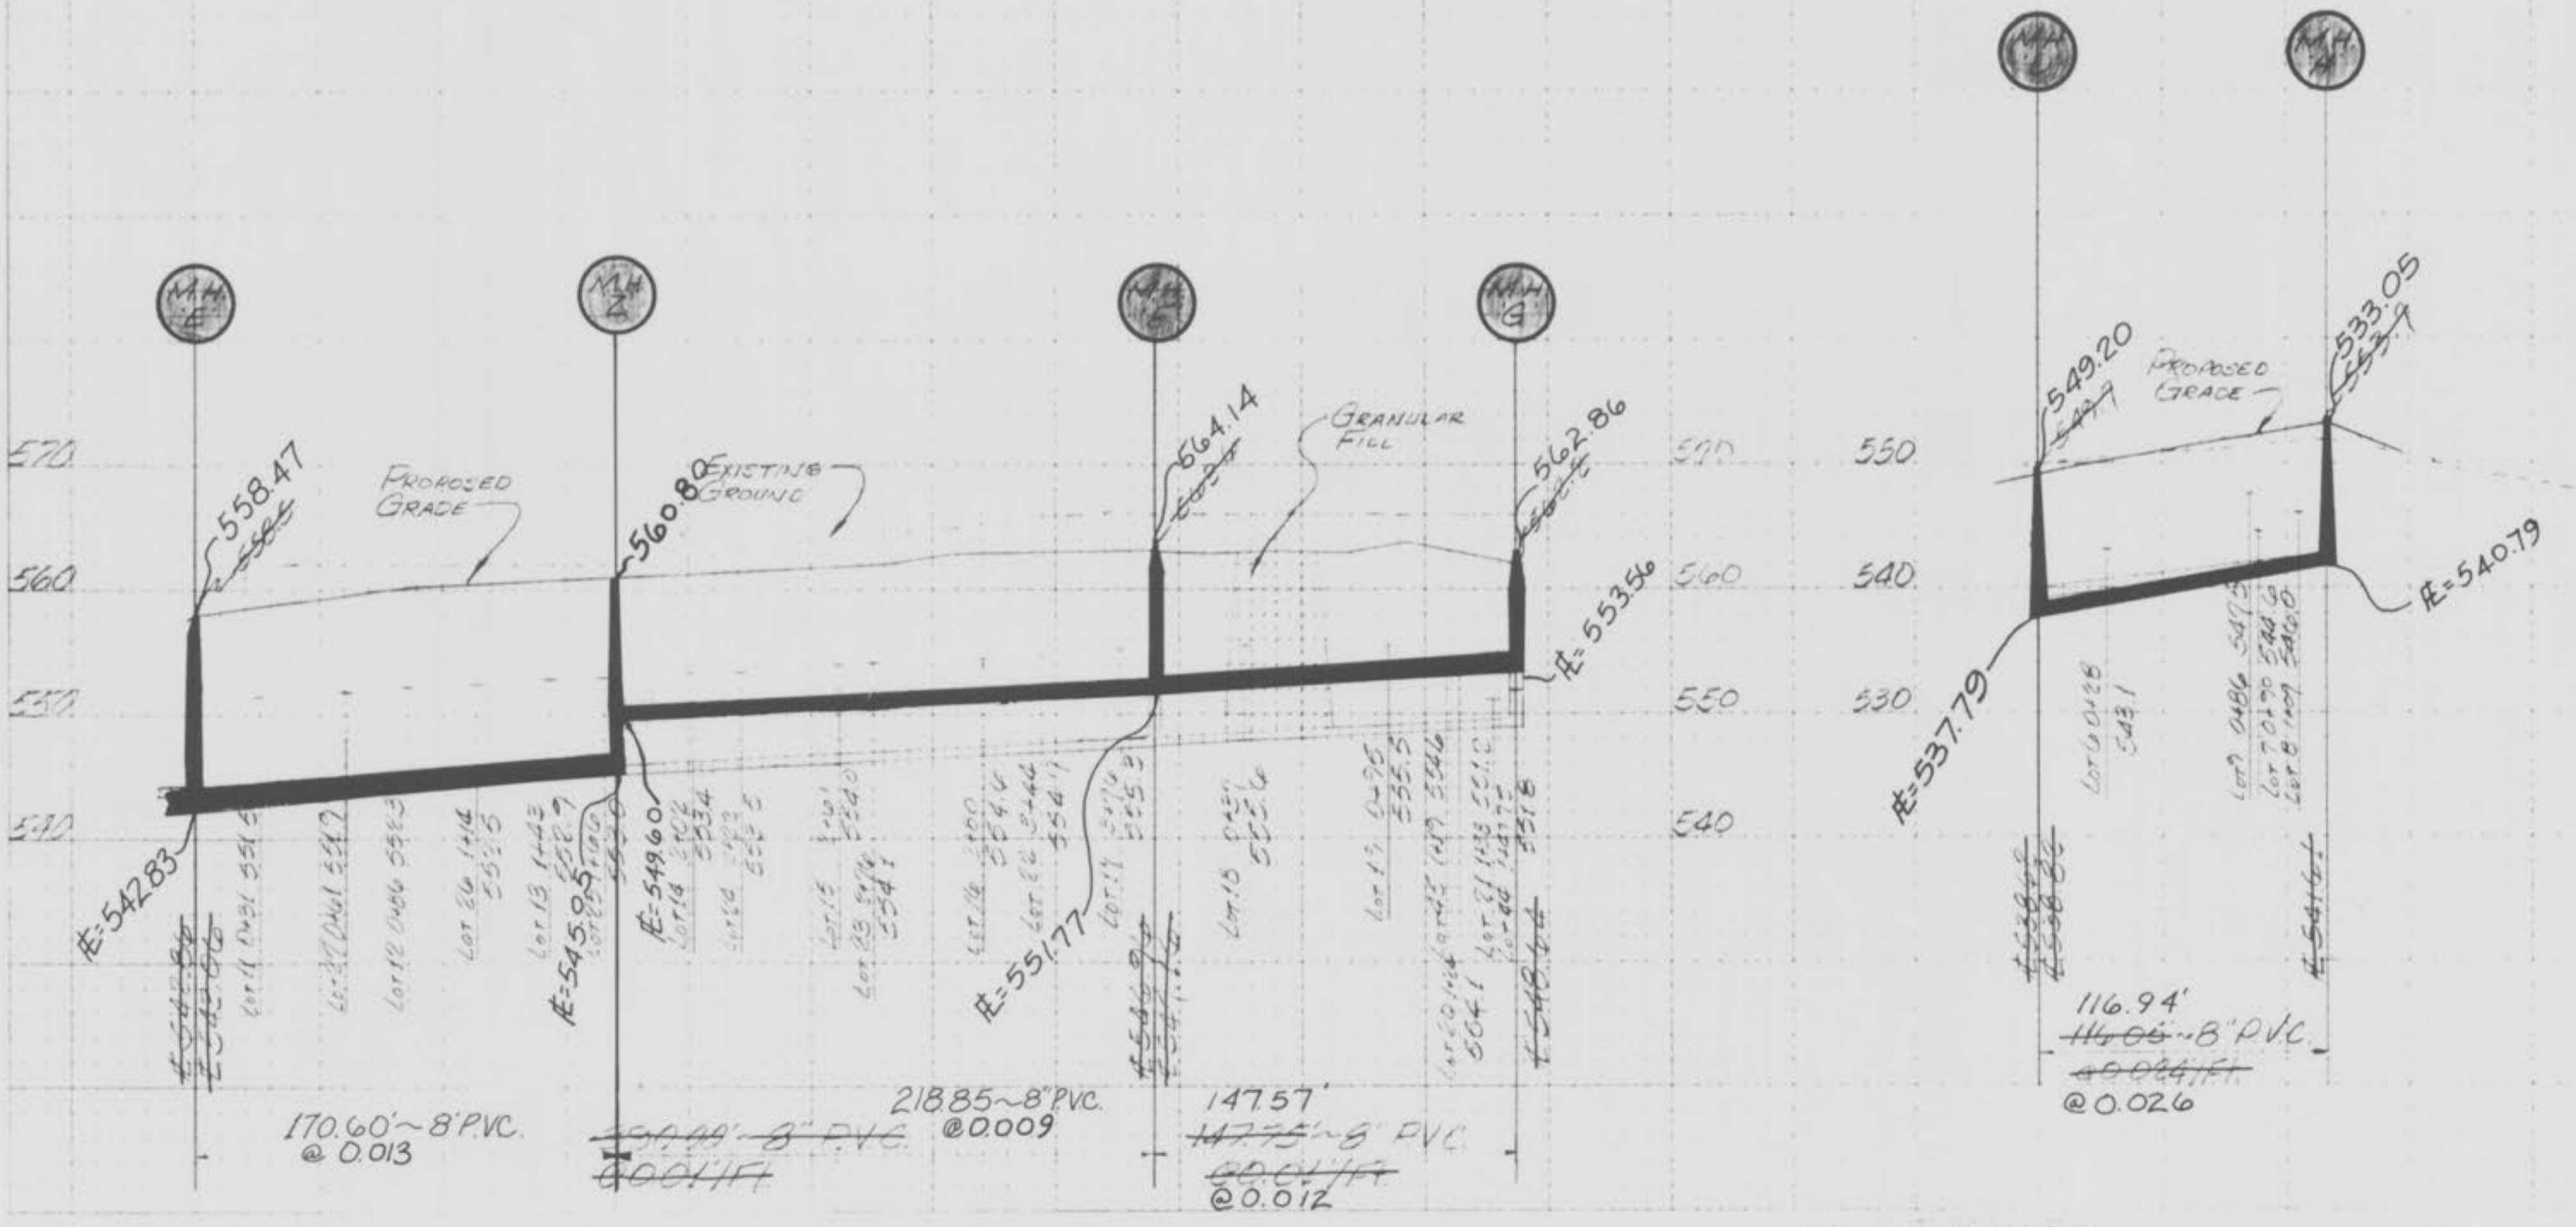


AS-BUILTS ADDED JULY, 1992

SCALE: 1"=50' HOR
 1"=10' VERT

FINAL SURVEY

ORIGINAL SURVEY

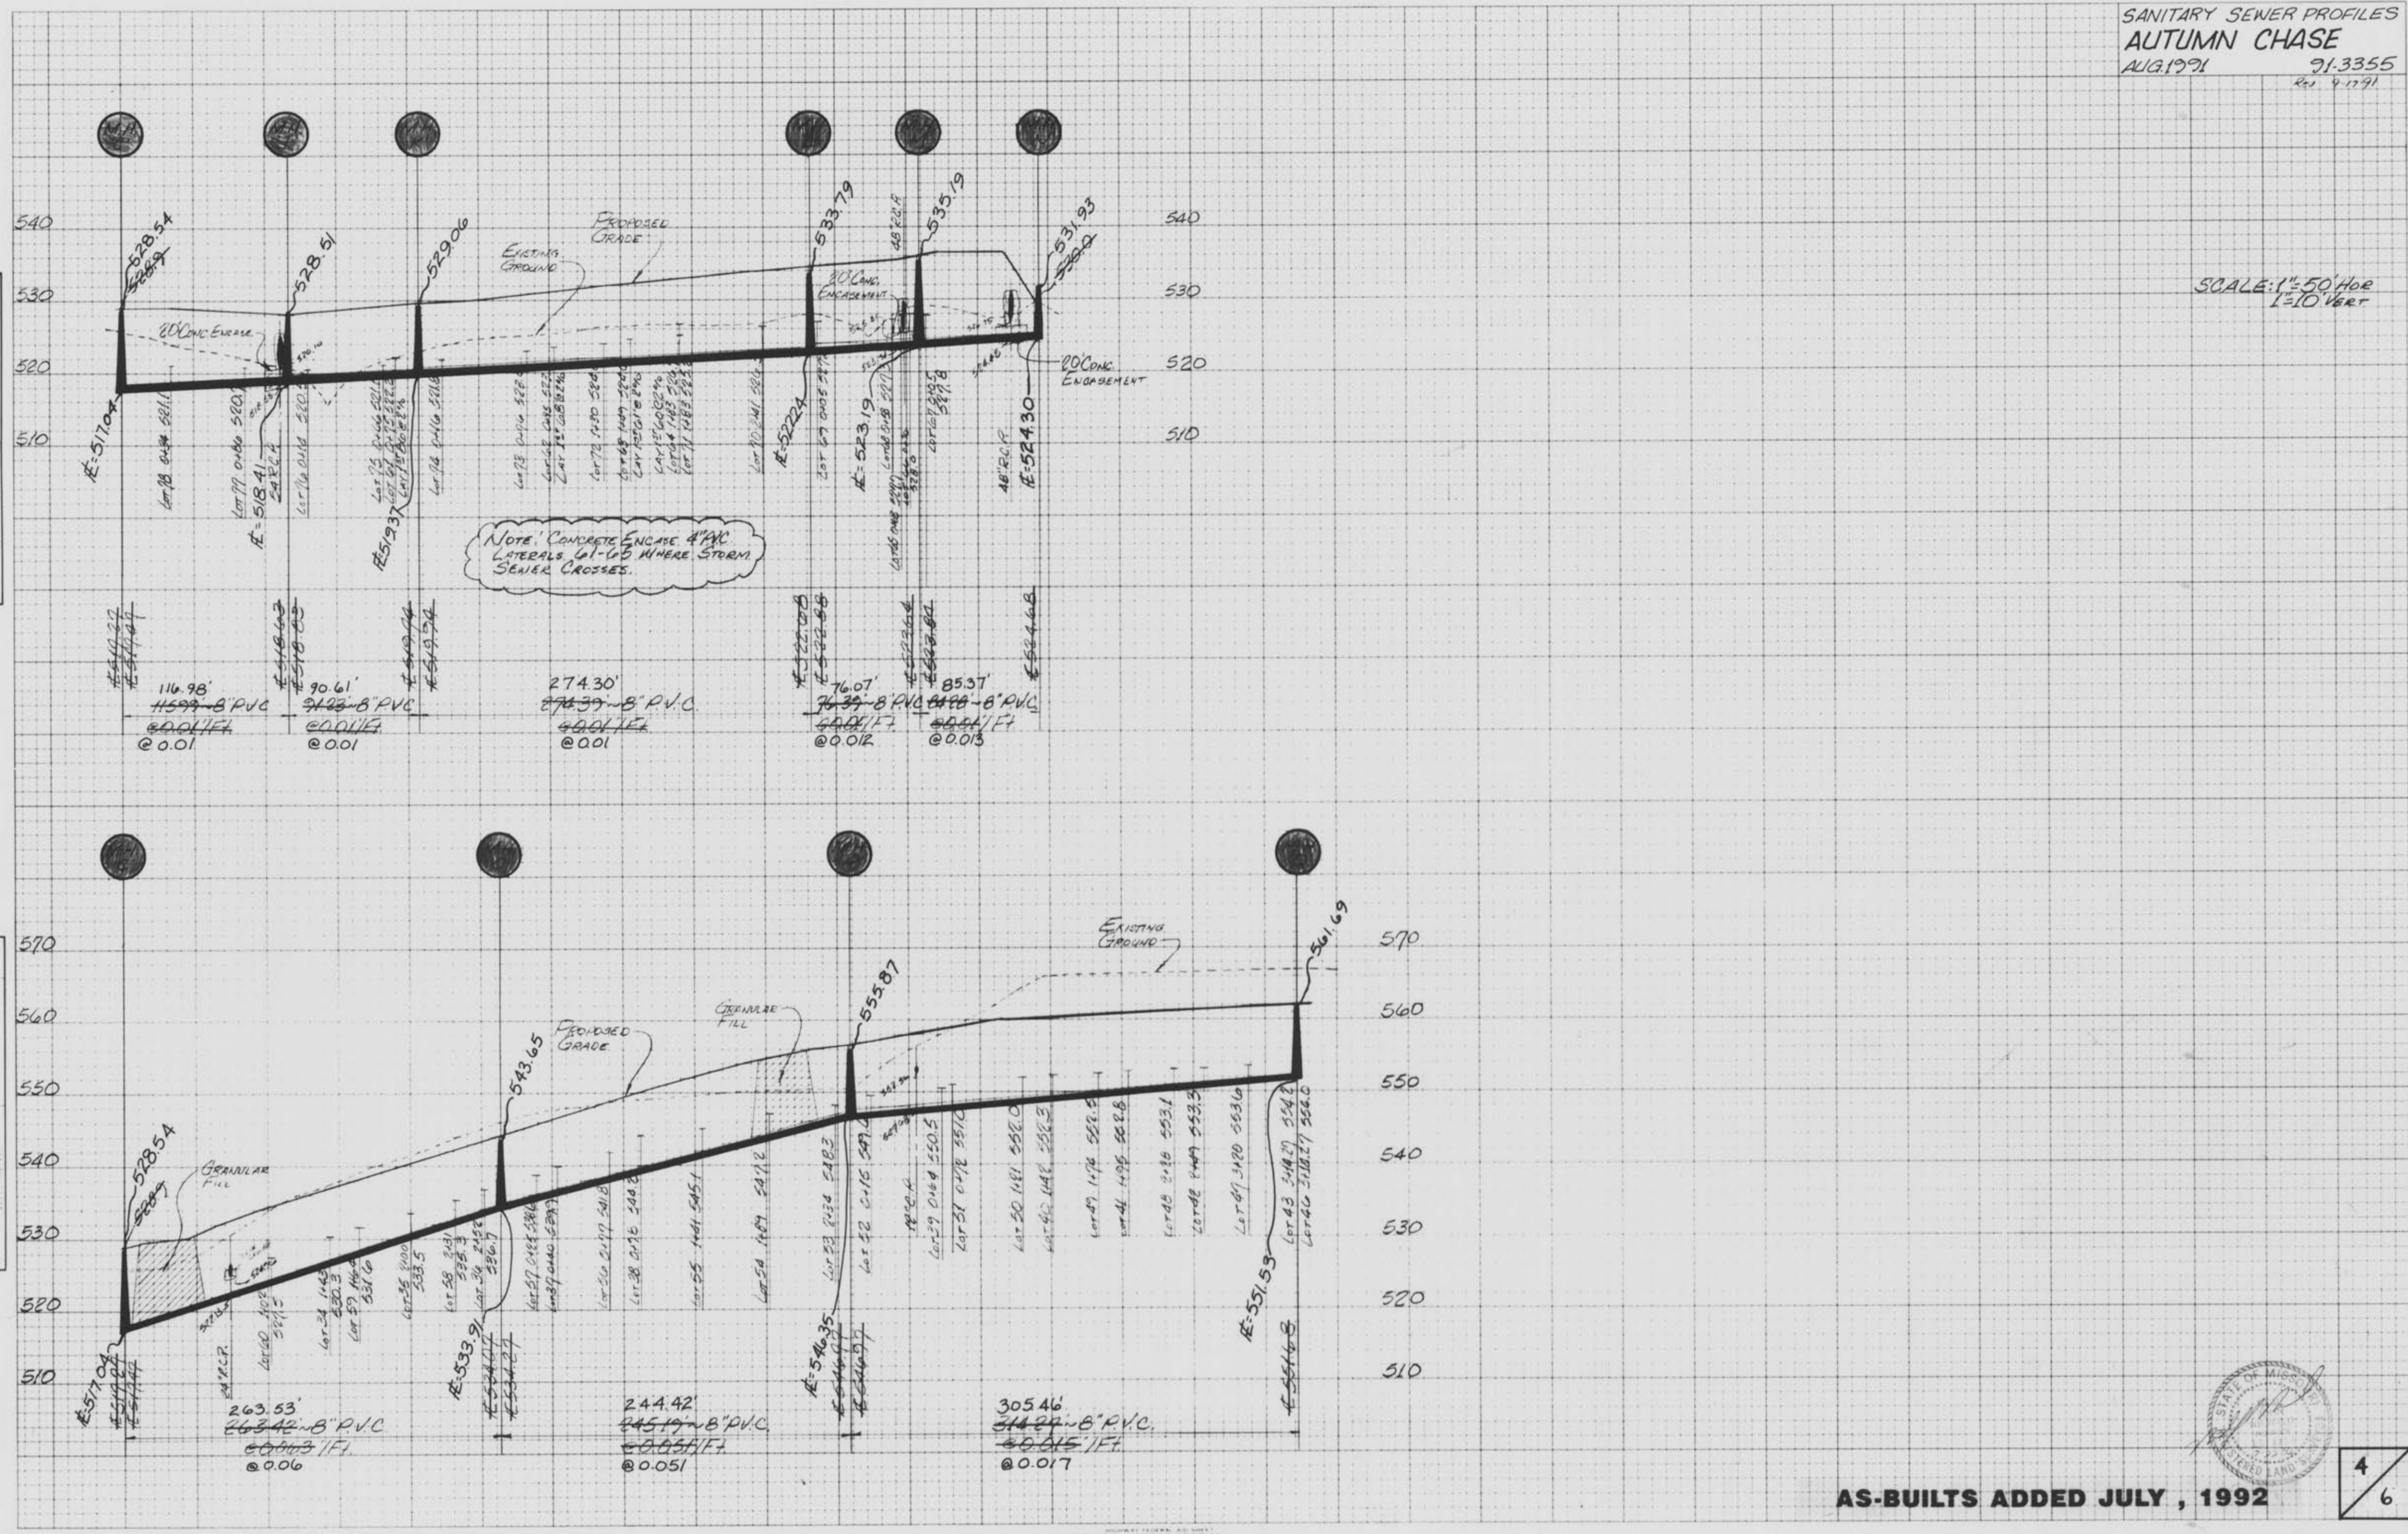


NOTE: CONCRETE ENCASE 4" PVC
 LATERALS 61-65 WHERE STORM
 SEWER CROSSES.



AS-BUILTS ADDED JULY, 1992

4
6

STORM SEWER PROFILES
AUTUMN CHASE
AUG 1991 91-3355
Rev 9/19/91

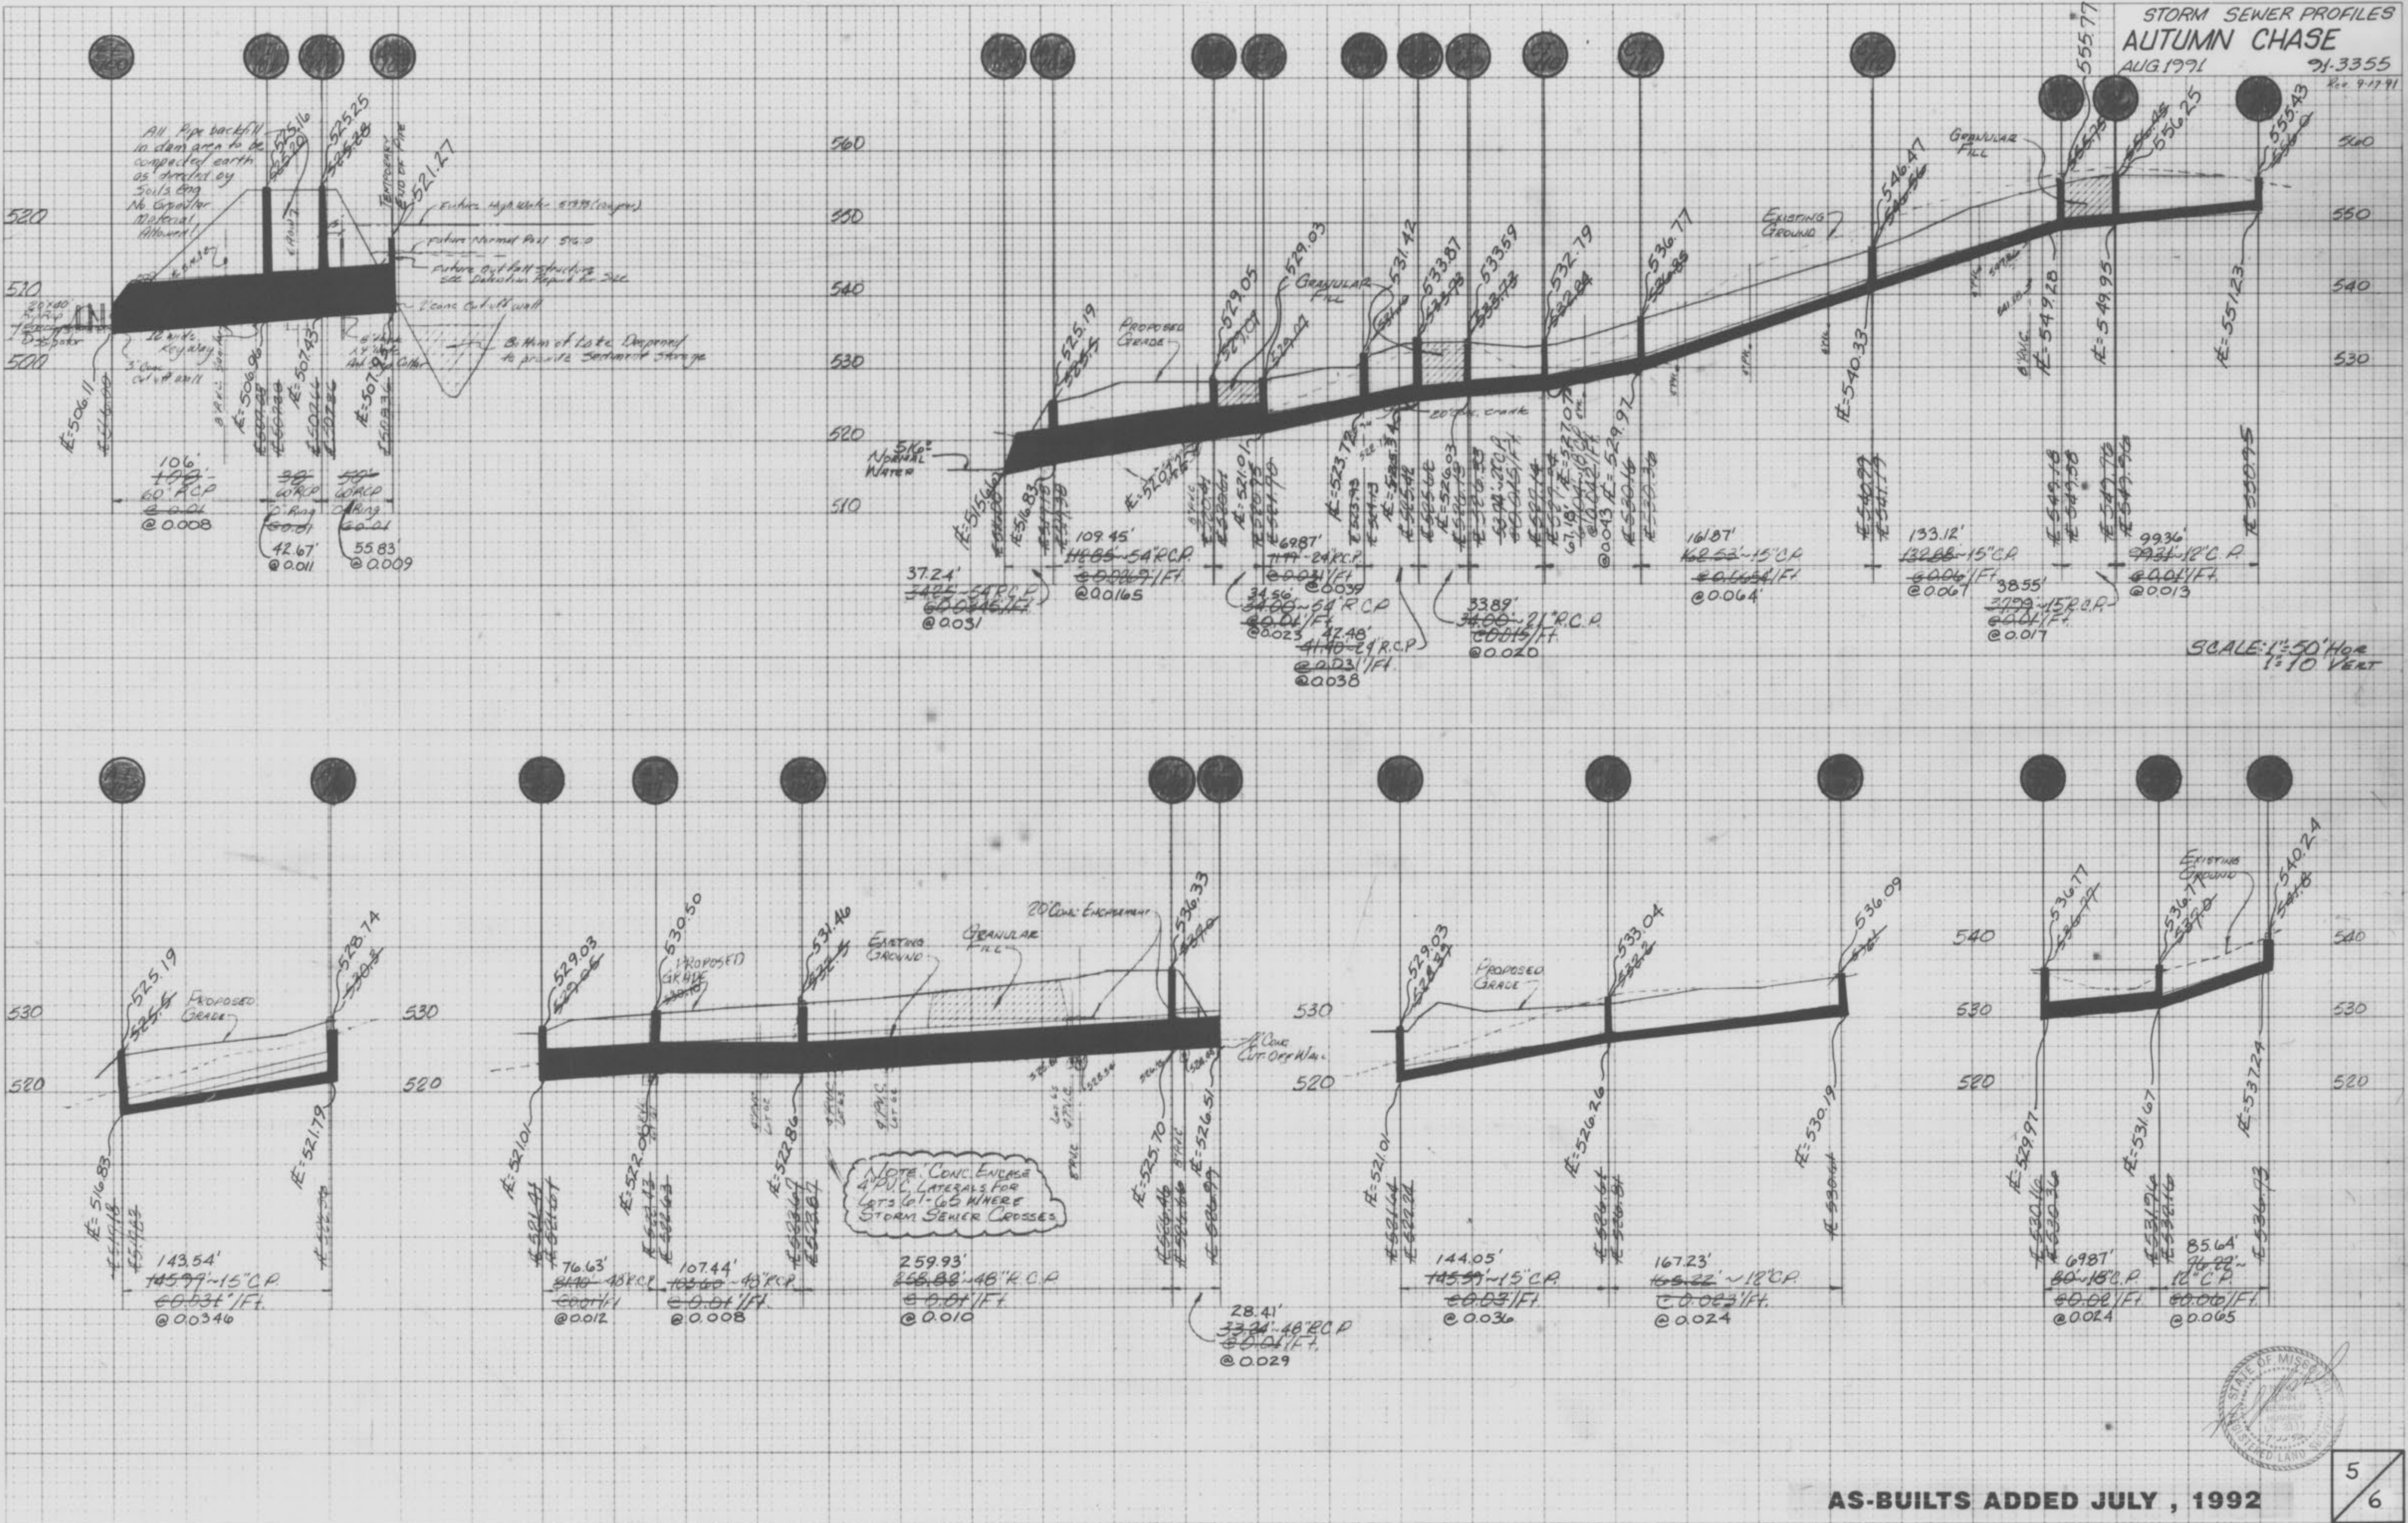

FINAL SURVEY

ORIGINAL SURVEY

SCALE: 1"=50' HOR
1"=10' VERT

AS-BUILTS ADDED JULY, 1992

5
6

PLATE 3-FULL CROSS SECTION FULL LINE


AUTUMN CHASE AC-27
5/6

FINAL SURVEY DATE
 BY
 CHECKED
 DATE
 PROJECT NO.
 SHEET NO.

ORIGINAL SURVEY DATE
 BY
 CHECKED
 DATE
 PROJECT NO.
 SHEET NO.



SCALE: 1" = 50' HOR
 1" = 10' VERT

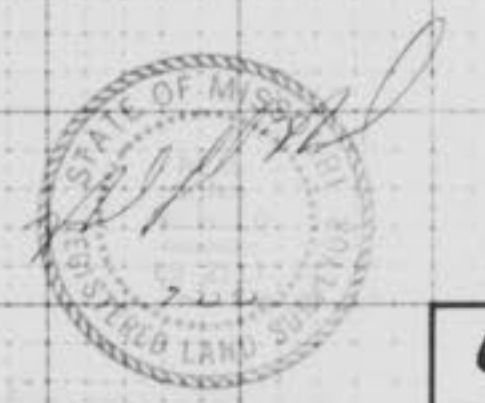

AS-BUILTS ADDED JULY, 1992

6/6



**ALL MAINS, VALVES, AND
 FIRE HYDRANTS AS-BUILT JULY 22, 1992**