



## LOCATION MAP

NTS

## GRADING NOTES

- A Geotechnical Engineer shall be employed by the owner and be on site during grading operations. All soils tests shall be verified by the Geotechnical Engineer concurrent with the grading and backfilling operations.
- The grading contractor shall perform a complete grading and compaction operation as shown on the plans, stated in these notes, or reasonably implied there from, all in accordance with the plans and notes as interpreted by the Geotechnical Engineer.
- The Contractor shall notify the Soils Engineer at least two days in advance of the start of the grading operation.
- All areas shall be allowed to drain. All low points shall be provided with temporary ditches.
- A sediment control plan that includes monitored and maintained sediment control basins and/or straw bales should be implemented as soon as possible. No graded area is to be allowed to remain bare over the winter without being seeded and mulched. Care should be exercised to prevent soil from damaging adjacent property and silting up existing downstream storm drainage system.
- Soft soil in the bottom and banks of any existing or former pond sites or tributaries should be removed, spread out and permitted to dry sufficiently to be used as fill. None of this material should be placed in proposed right-of-way locations or on storm sewer locations.
- Site preparation includes the clearance of all stumps, trees, bushes, shrubs, and weeds; the grubbing and removal of roots and other surface obstructions from the site; and the demolition and removal of any man-made structures. The unsuitable material shall be properly disposed of off-site. Topsoil and grass in the fill areas shall be thoroughly disced prior to the placement of any fill. The Soils Engineer shall approve the discing operation.
- Compaction equipment shall consist of tamping rollers, pneumatic-tired rollers, vibratory roller, or high speed impact type drum rollers acceptable to the Soils Engineer. The roller shall be designed so as to avoid the creation of a layered fill without proper blending of successive fill layers.
- The Soils Engineer shall observe and test the placement of the fill to verify that specifications are met. A series of fill density tests will be determined on each lift of fill. Interim reports showing fill quality will be made to the Owner at regular intervals.
- The Soils Engineer shall notify the Contractor of rejection of a lift of fill or portion thereof. The Contractor shall rework the rejected portion of fill and obtain notification from the Soils Engineer of its acceptance prior to the placement of additional fill.
- All areas to receive fill shall be scarified to a depth of not less than 6 inches and then compacted in accordance with the specifications given below. Natural slopes steeper than 1 vertical to 5 horizontal to receive fill shall have horizontal benches, cut into the slopes before the placement of any fill. The width and height to be determined by the Soils Engineer. The fill shall be loosely placed in horizontal layers not exceeding 8 inches in thickness and compacted in accordance with the specifications given below. The Soils Engineer shall be responsible for determining the acceptability of soils placed. Any unacceptable soils placed shall be removed at the Contractor's expense.
- The sequence of operation in the fill areas will be fill, compact, verify acceptable soil density, and repetition of the sequence. The acceptable moisture contents during the filling operation are those at which satisfactory dry densities can be obtained. The acceptable moisture contents during the filling operation in the remaining areas are from 2 to 8 percent above the optimum moisture control.
- The surface of the fill shall be finished so that it will not impound water. If at the end of a day's work it would appear that there may be rain prior to the next working day, the surface shall be finished smooth. If the surface has been finished smooth for any reason, it shall be scarified before proceeding with the placement of succeeding lifts. Fill shall not be placed on frozen ground, nor shall filling operations continue when the temperature is such as to permit the layer under placement to freeze.

# AS-BUILT FOR STORM AND SANITARY SEWERS PLANS FOR THE CONSTRUCTION OF SANITARY SEWERS, STORM SEWERS, GRADING, PAVING, AND WATER MAINS FOR CIVIC PARK MANOR AUTUMN OAKS

A TRACT OF LAND IN THE SOUTHWEST QUARTER OF SECTION 20,  
T.47 N., R.3 E., ST. CHARLES COUNTY, MISSOURI


This is to certify that we have during October, 1996, we have taken field measurements for the locations and elevations on the storm and sanitary sewers as shown.



Noel J. Niewald, R.L.S.  
Mo. Reg. R.L.S. #2117

## LEGEND

C.I.	CURB INLET
D.C.I.	DOUBLE CURB INLET
A.I.	AREA INLET
M.H.	MANHOLE
F.E.	FLARED END SECTION
E.P.	END PIPE
C.P.	CONCRETE PIPE
R.C.P.	REINFORCED CONCRETE PIPE
C.M.P.	CORRUGATED METAL PIPE
C.I.P.	CAST IRON PIPE
P.V.C.	POLY VINYL CHLORIDE (PLASTIC)
C.O.	CLEAN OUT
*	STORM HYDRANT
- - -	STORM SEWER
○	SANITARY SEWER
○○	STREET LIGHT
— 582 —	EXISTING CONTOUR
— 582 —	PROPOSED CONTOUR
SxS	STREET SIGN
W.V.	WATER VALVE
B.O.	BLOW OFF ASSEMBLY
	FLOWLINE ELEVATION OF HOUSE CONNECTION
	FLOWLINE ELEVATION OF SEWER MAIN
XXX	STREET ADDRESS

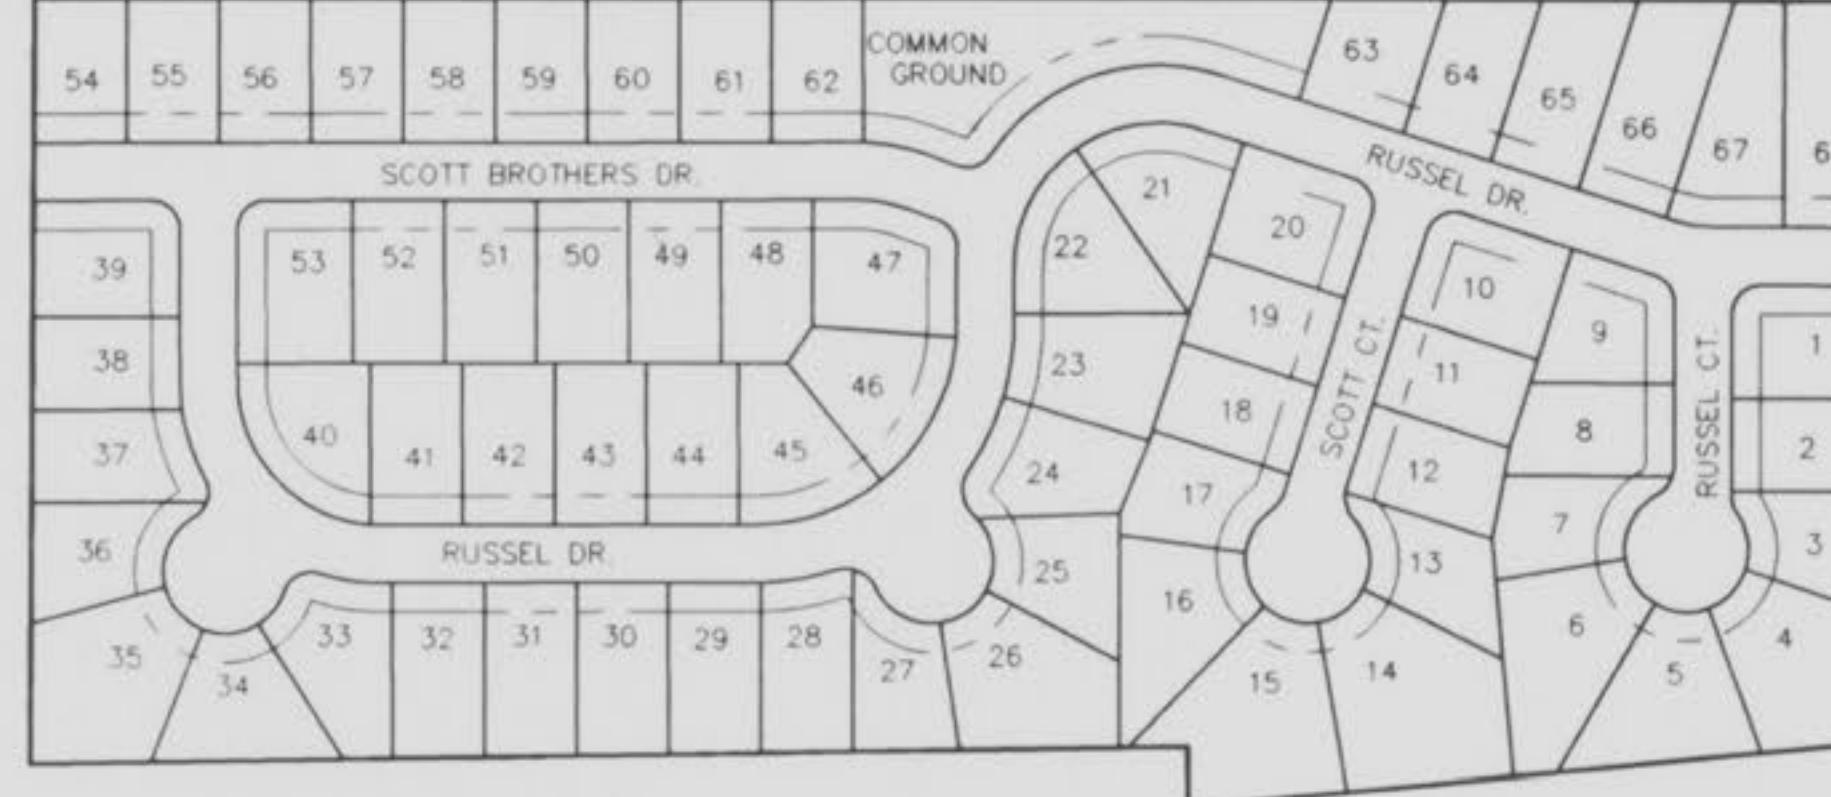

## KEY MAP

## DEVELOPMENT NOTES

- Fill and backfill should be compacted to the criteria specified in the following table:

CATEGORY	MINIMUM PERCENT COMPACTION
Fill in building areas below footings	90%
Fill under slabs, walks, and pavement	90%
Fill other than building areas	88%
Natural subgrade	88%
Pavement subgrade	90%
Pavement base course	90%

- Measured as a percent of the maximum dry density as determined by modified Proctor Test (ASTM-D-1557).
- Moisture content must be within 2 percent below or 4 percent above optimum moisture content if fill is deeper than 10 feet.
- NOTE: Trash and debris shall be disposed of in the detention basin area and other designated areas. All debris shall be buried a minimum of 3 feet below finished grade.
- GENERAL NOTES**
- Underground utilities have been plotted from available information and therefore their locations shall be considered approximate only. The verification of the location of all underground utilities, either shown or not shown on these plans shall be the responsibility of the contractor, and shall be located prior to any grading or construction of the improvements.
- All manhole tops built without elevations furnished by the Engineer will be the responsibility of the sewer contractor.
- 8" P.V.C. sanitary sewer pipe shall meet the following standards. A.S.T.M.-D-3034 SDR-35, with wall thickness compression joint A.S.T.M.-D-3212. An appropriate rubber seal waterstop as approved by the sewer district shall be installed between P.V.C. pipe and masonry structures.
- All filled places, including trench backfills, under buildings, proposed storm and sanitary sewer lines and/or paved areas, shall be compacted to 90% maximum density as determined by the "Modified AASHTO T-180 Compaction Test," (A.S.T.M.-D-1557). All filled places within public roadways shall be compacted to 95% of maximum density as determined by the "Standard Proctor Test AASHTO T-99, Method C" (A.S.T.M.D.-698).
- All trench backfills under paved areas shall be granular backfill, and shall be compacted to 90% of maximum density as determined by the "Modified AASHTO T-180 Compaction Test," (A.S.T.M.-D-1557). All other trench backfills may be earth material (free of large clods or stones). All trench backfills shall be water jetted.
- All sanitary house connections have been designed so that the minimum vertical distance from the low point of the basement to the flow line of a sanitary sewer at the corresponding house connection is not less than the diameter of the pipe plus the vertical distance of 2 1/2 feet.
- No area shall be cleared without the permission of the Project Engineer.
- All grades shall be within 0.2 feet of those shown on the grading plan.
- No slope shall be steeper than 3:1 or as called for in the soils report for the project. All slopes shall be sodded or seeded and mulched.
- All construction and materials used shall conform to current City of O'Fallon Standards.
- All P.V.C. sanitary sewer is to be SDR-35 or equal with clean 1/2" to 1" granular stone bedding uniformly graded. This bedding shall extend from 4" below the pipe to the springline of the pipe. Immediate backfill over pipe shall consist of same size "clean" or minus stone from springline of pipe to 6" above the top of pipe.
- All soils test shall be verified by a Soils Engineer concurrent with the grading and backfilling operations.
- Easements shall be provided for sanitary sewers, and all utilities on the Record Plat. See Record Plat for location and size of easements.
- Maintenance and upkeep of the common ground area shall be the responsibility of the developer and/or successors.
- A 25' building line shall be established along all Public Right-Of-Way.

- Area of Tract: 24.20 Acres
- Existing Zoning: R-1
- Proposed Use: Single Family Homes
- Number of Lots Proposed: 68 Lots
- Area in Common Ground: 0.93 Acres
- Area in Right-of-Way: 4.61 Acres
- Area in Lots: 18.66 Acres
- Minimum Lots Area: 10,000 Square Feet
- Average Lot Area (not including common ground): 11,953 Square Feet
- Average Lot Area including Common Ground: 12,549 Square Feet
- The proposed height and lot setbacks are as follows:  
Minimum Front Yard: 25 feet  
Minimum Side Yard: 6 feet  
Minimum Rear Yard: 25 feet  
Minimum Lot Area: 10,000 square feet  
Maximum Height of Building: 2 1/2 stories or 35 feet
- Current Owner of Property: Robert and Marilyn Scott ETAL  
909 Highway Y  
O'Fallon, MO 63366
- Owner Under Contract and Developer: Commonwealth Dev. Corp.  
P.O. Box 176  
St. Peters, MO 63376  
314-928-4988
- Site is served by:  
City of O'Fallon Sewers  
Union Electric Company  
St. Charles Gas Company  
City Water  
GTE Telephone Company  
Fort Zumwalt School District  
O'Fallon Fire Protection District


## SHEET INDEX

- OF 17 - COVER SHEET
- OF 17 - FLAT PLAN
- OF 17 - GRADING PLAN
- OF 17 - WATER PLAN
- OF 17 - STREET PROFILES
- OF 17 - STREET PROFILES
- OF 17 - SANITARY SEWER PROFILES
- OF 17 - SANITARY SEWER PROFILES
- OF 17 - STORM SEWER PROFILES
- OF 17 - STORM SEWER PROFILES
- OF 17 - DRAINAGE AREA MAP
- OF 17 - CONSTRUCTION DETAILS



OCT. 17, 1995  
DATE  
95-6277  
PROJECT NUMBER  
1 176  
SHEET OF  
6277COND.WDG  
FILE NAME  
b.b  
DRAWN CHECKED

PREPARED FOR:  
COMMONWEALTH DEV. CORP.  
P.O. BOX 176  
ST. PETERS, MO 63376  
314-928-4988

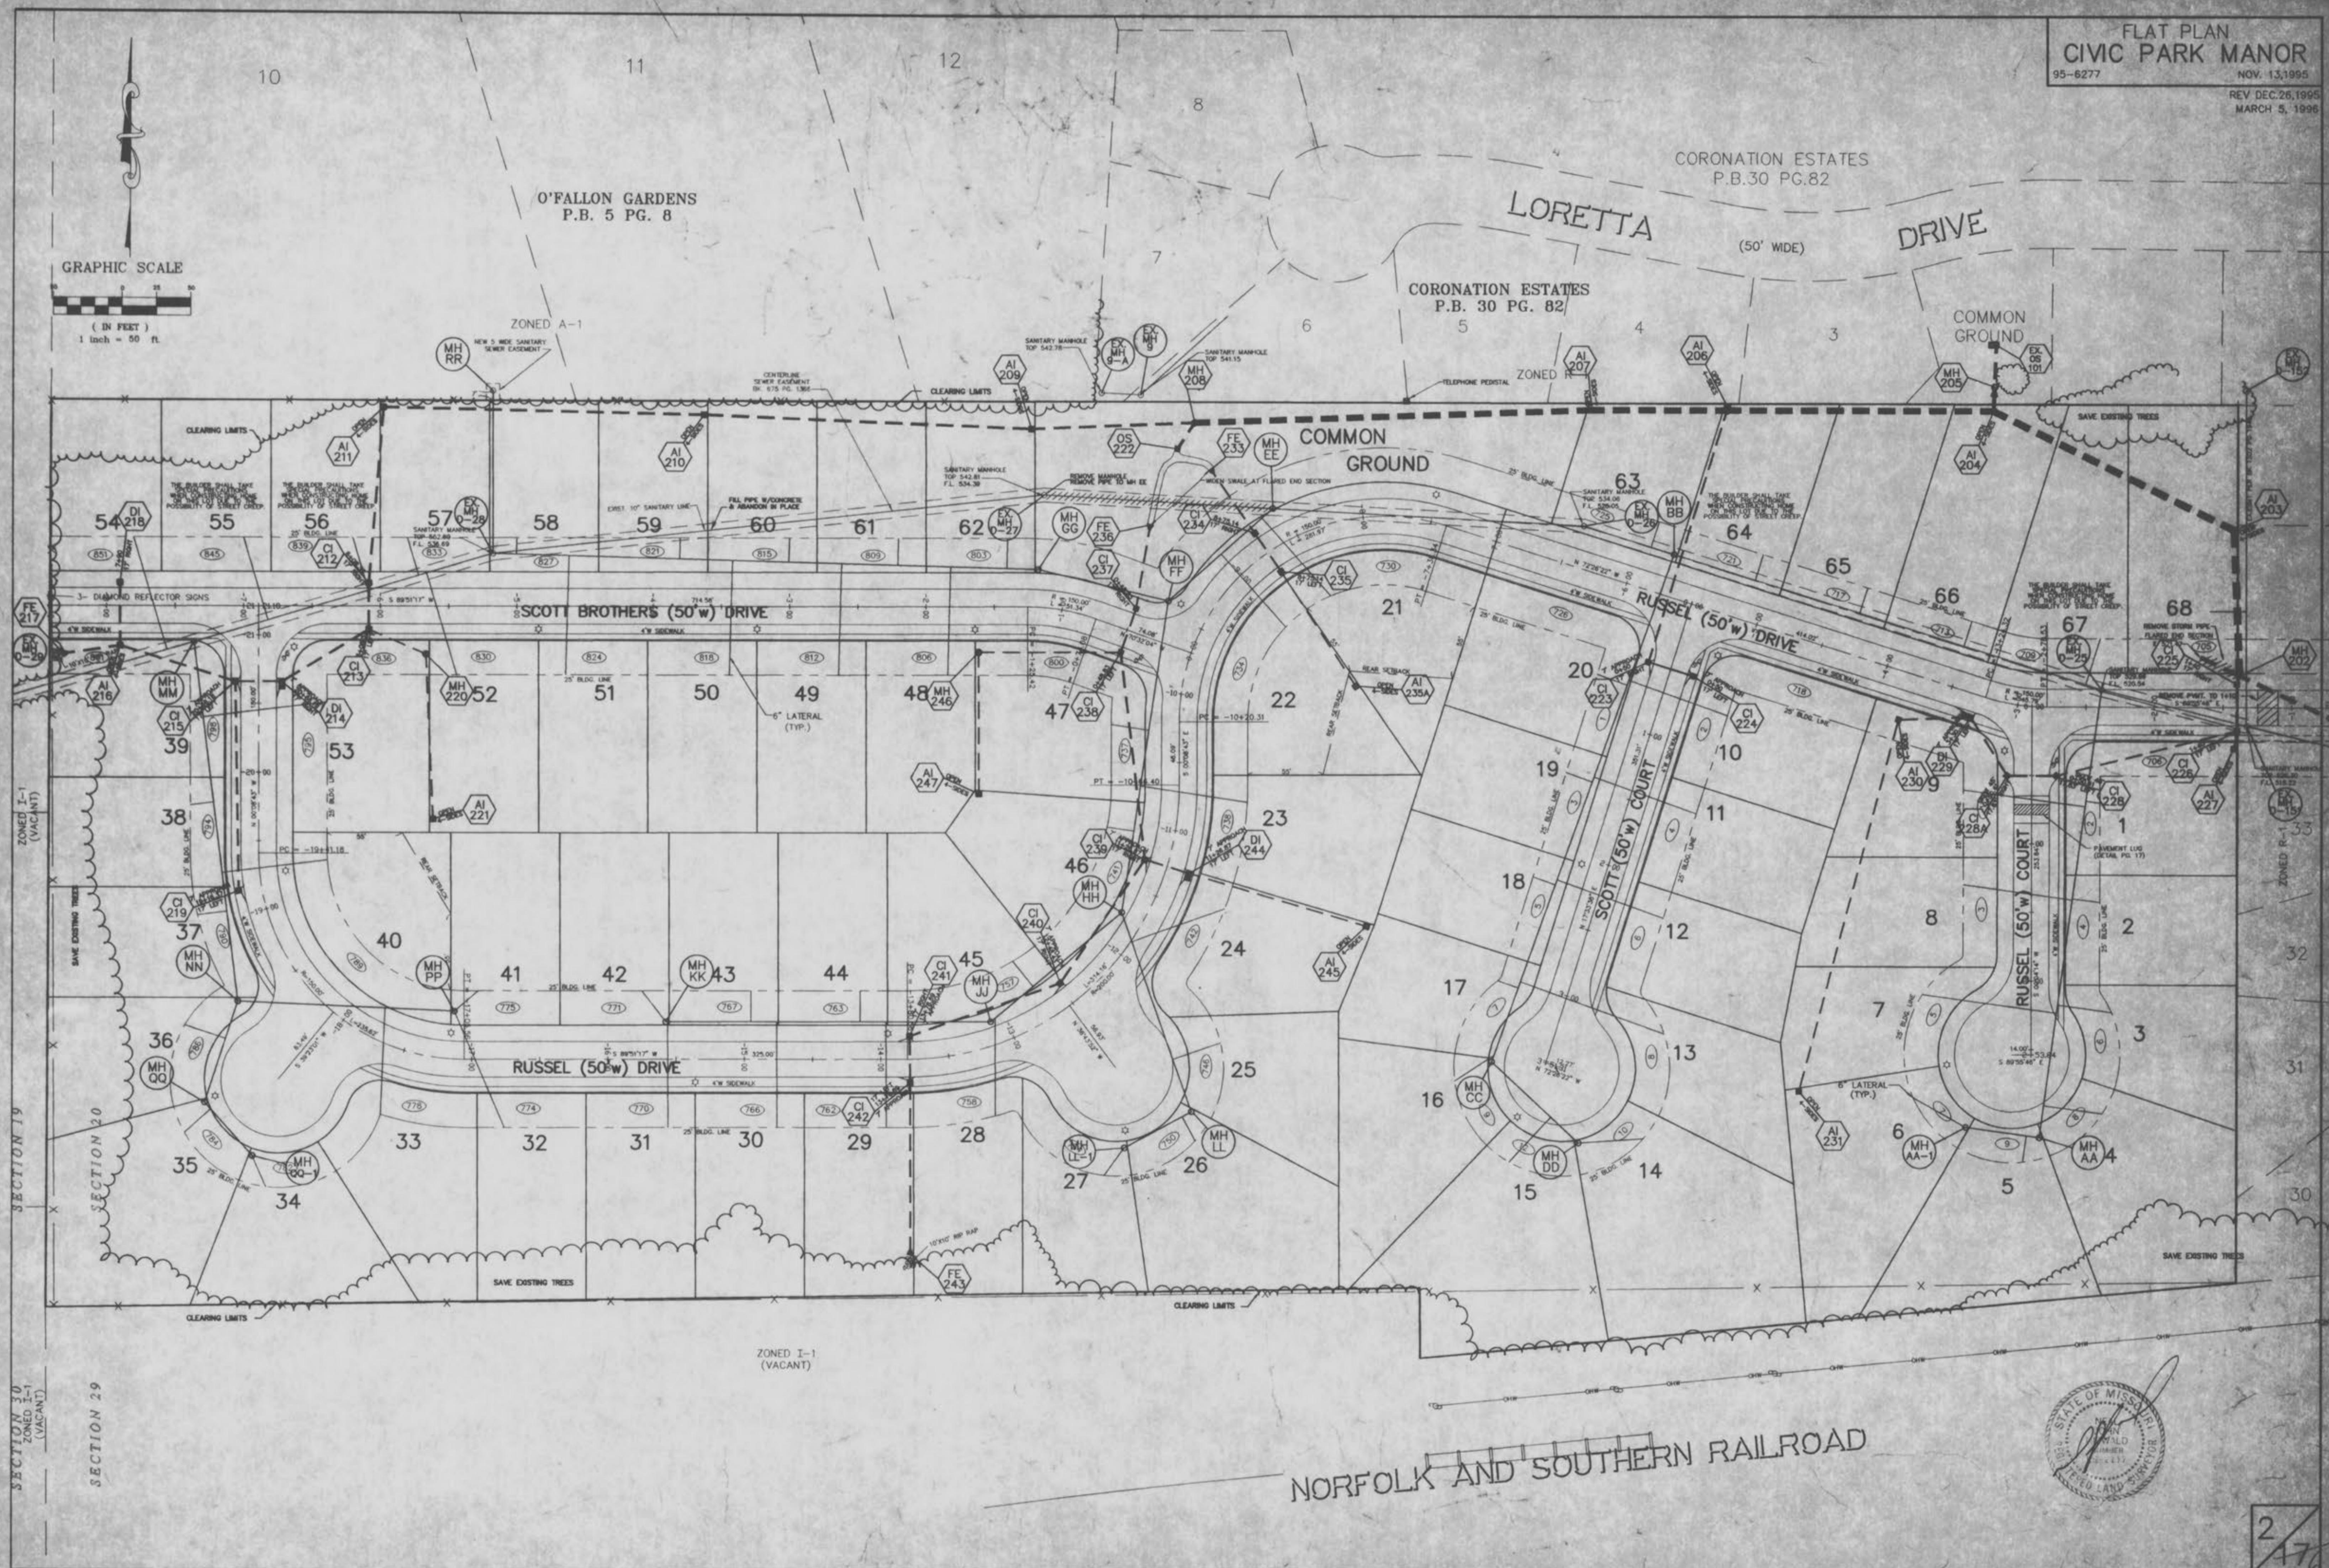

SANITARY SEWERS  
CIVIC PARK MANOR  
95-6277 Oct. 19, 1995  
Rev. 12-26-95

THE JOURNAL OF CLIMATE

**FINAL SURVEY**

ORIGINAL SURVEY  
RECORDED  
PROBLEMS  
TAKEN  
BY THE  
PUBLISHER

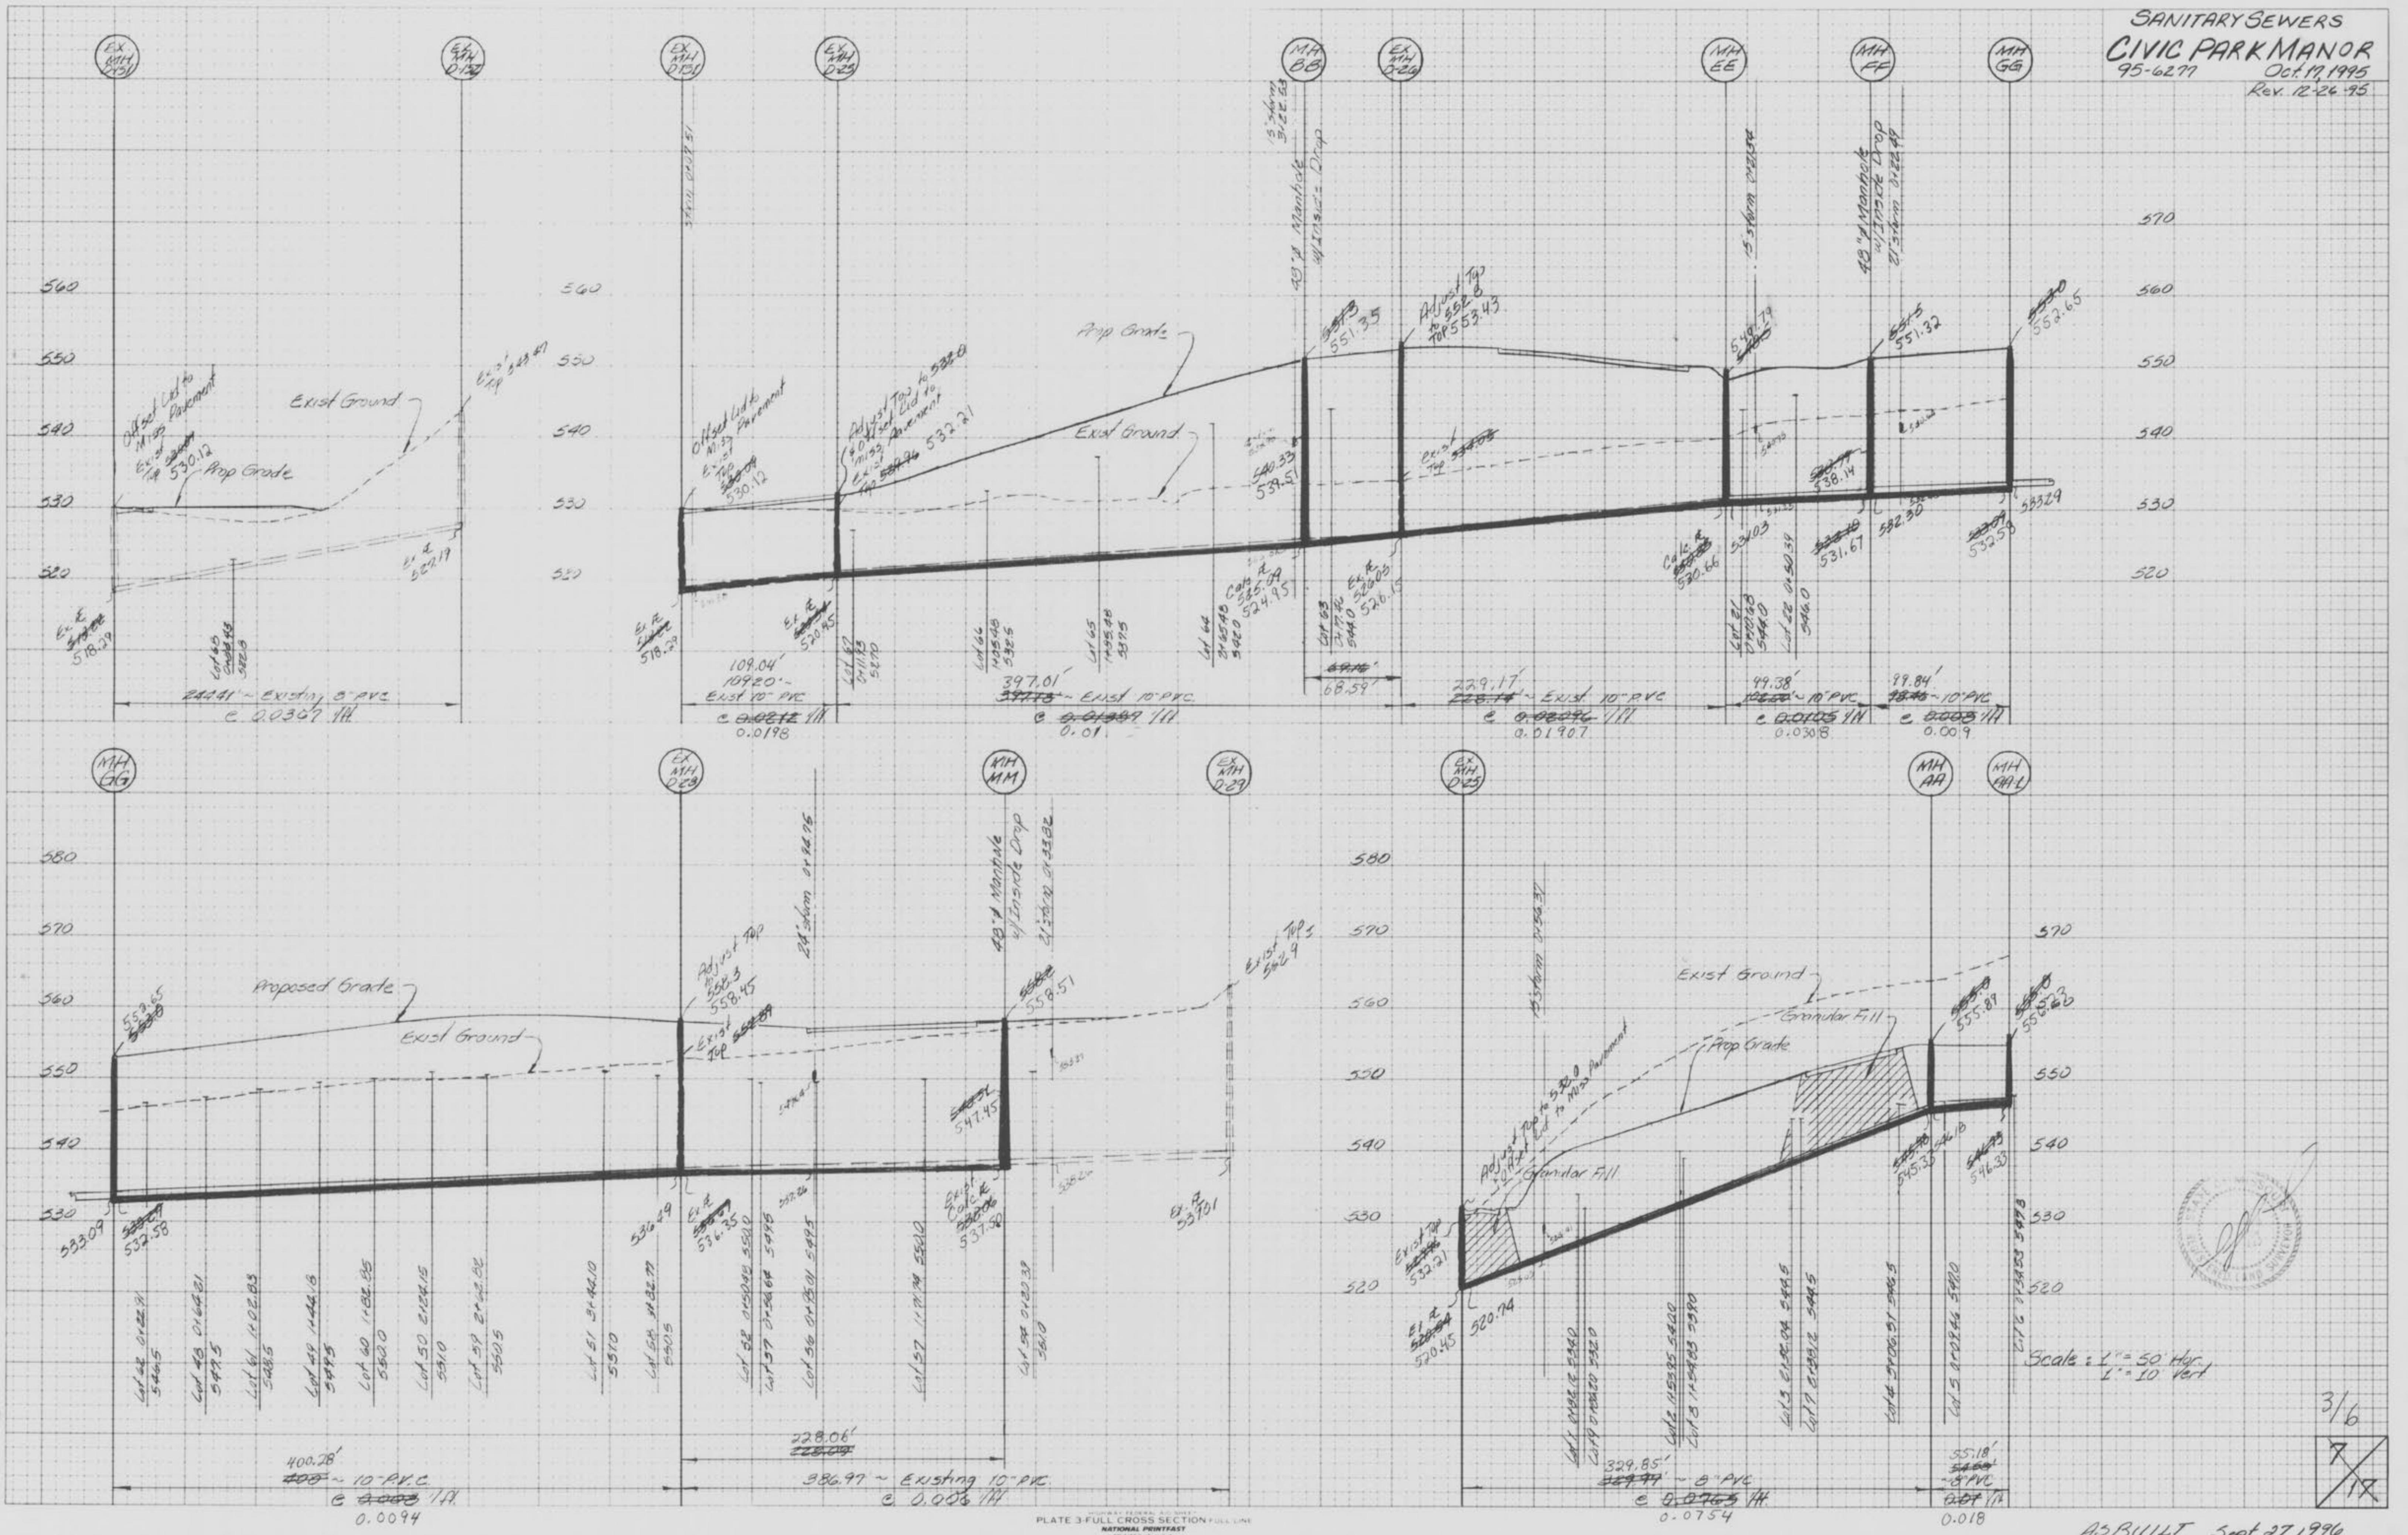



PLATE 3-FULL CROSS SECTION FULL  
**NATIONAL PRINTFAST**  
PRINTED IN U.S.A.

AS BUILT Sept 27, 1996

## Autumn Dales

AS-BUILT

SANITARY SEWERS  
CIVIC PARK MANOR  
95-6277  
Oct 17 1995  
Rev 12 26 95

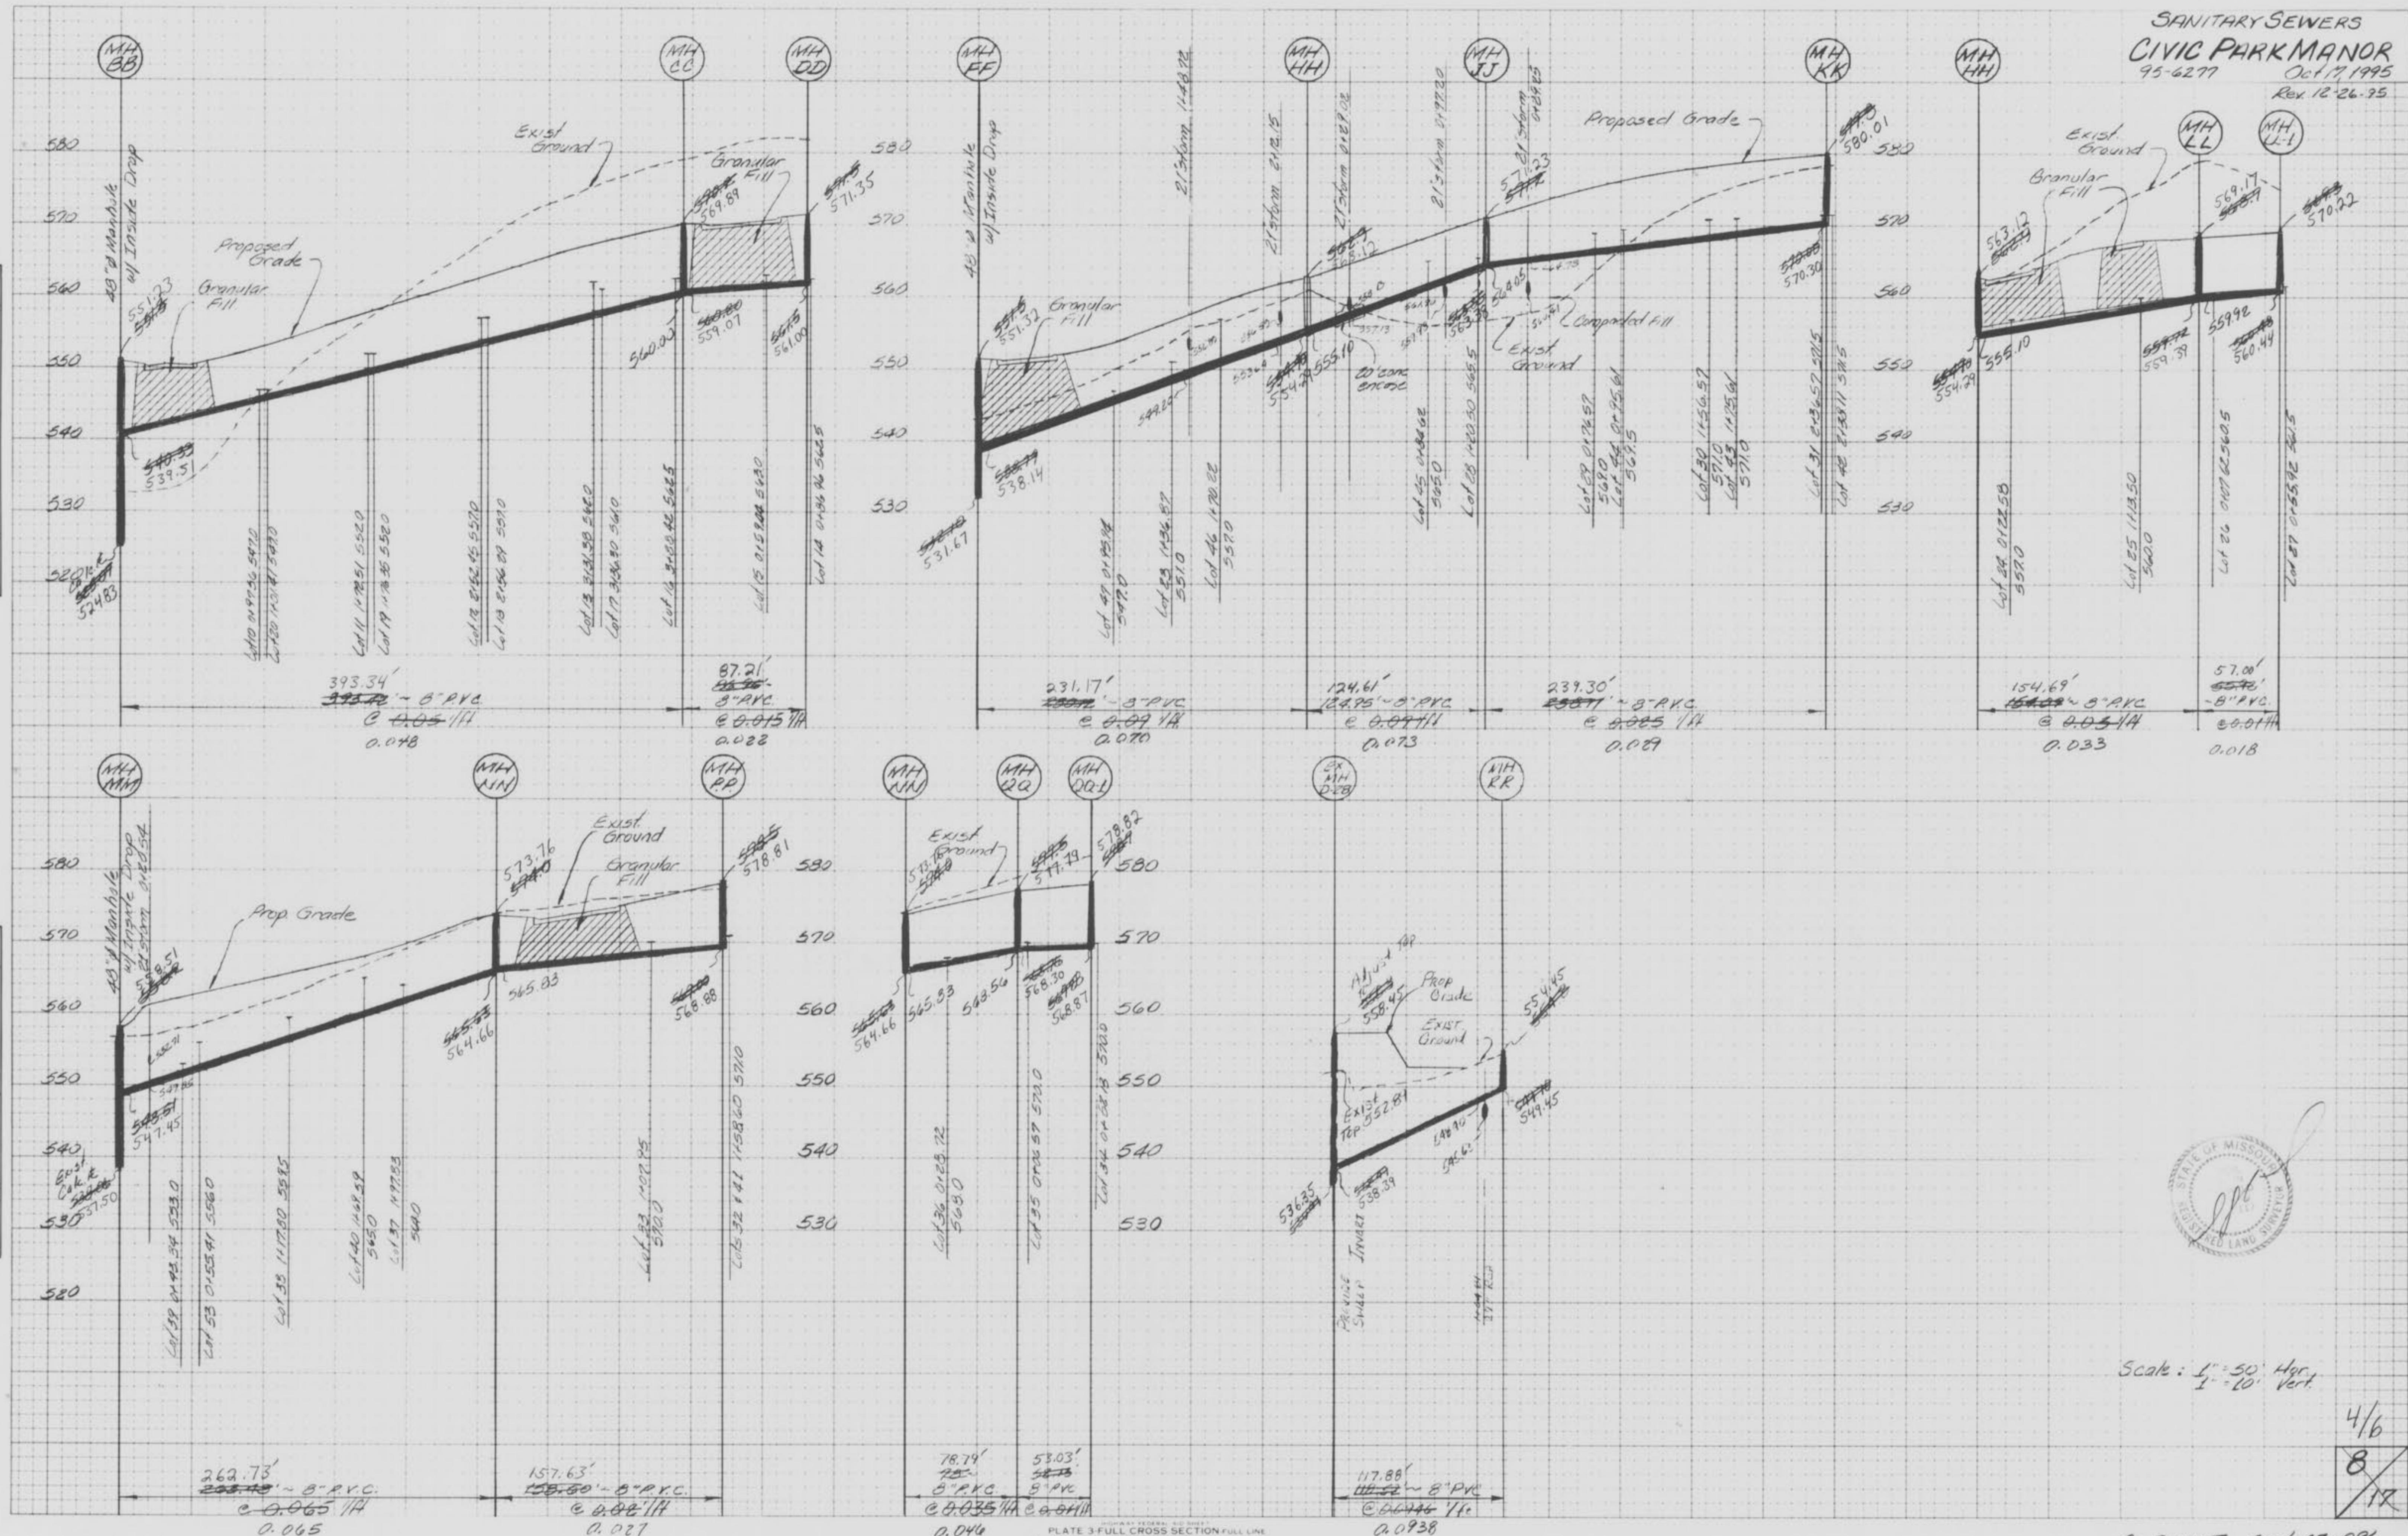

Scale: 1" = 50' Horiz.  
1" = 20' Vert.


4/6

8

/17

AS BUILT Sept 27 1996

Autumn Oaks AS-BUILTS

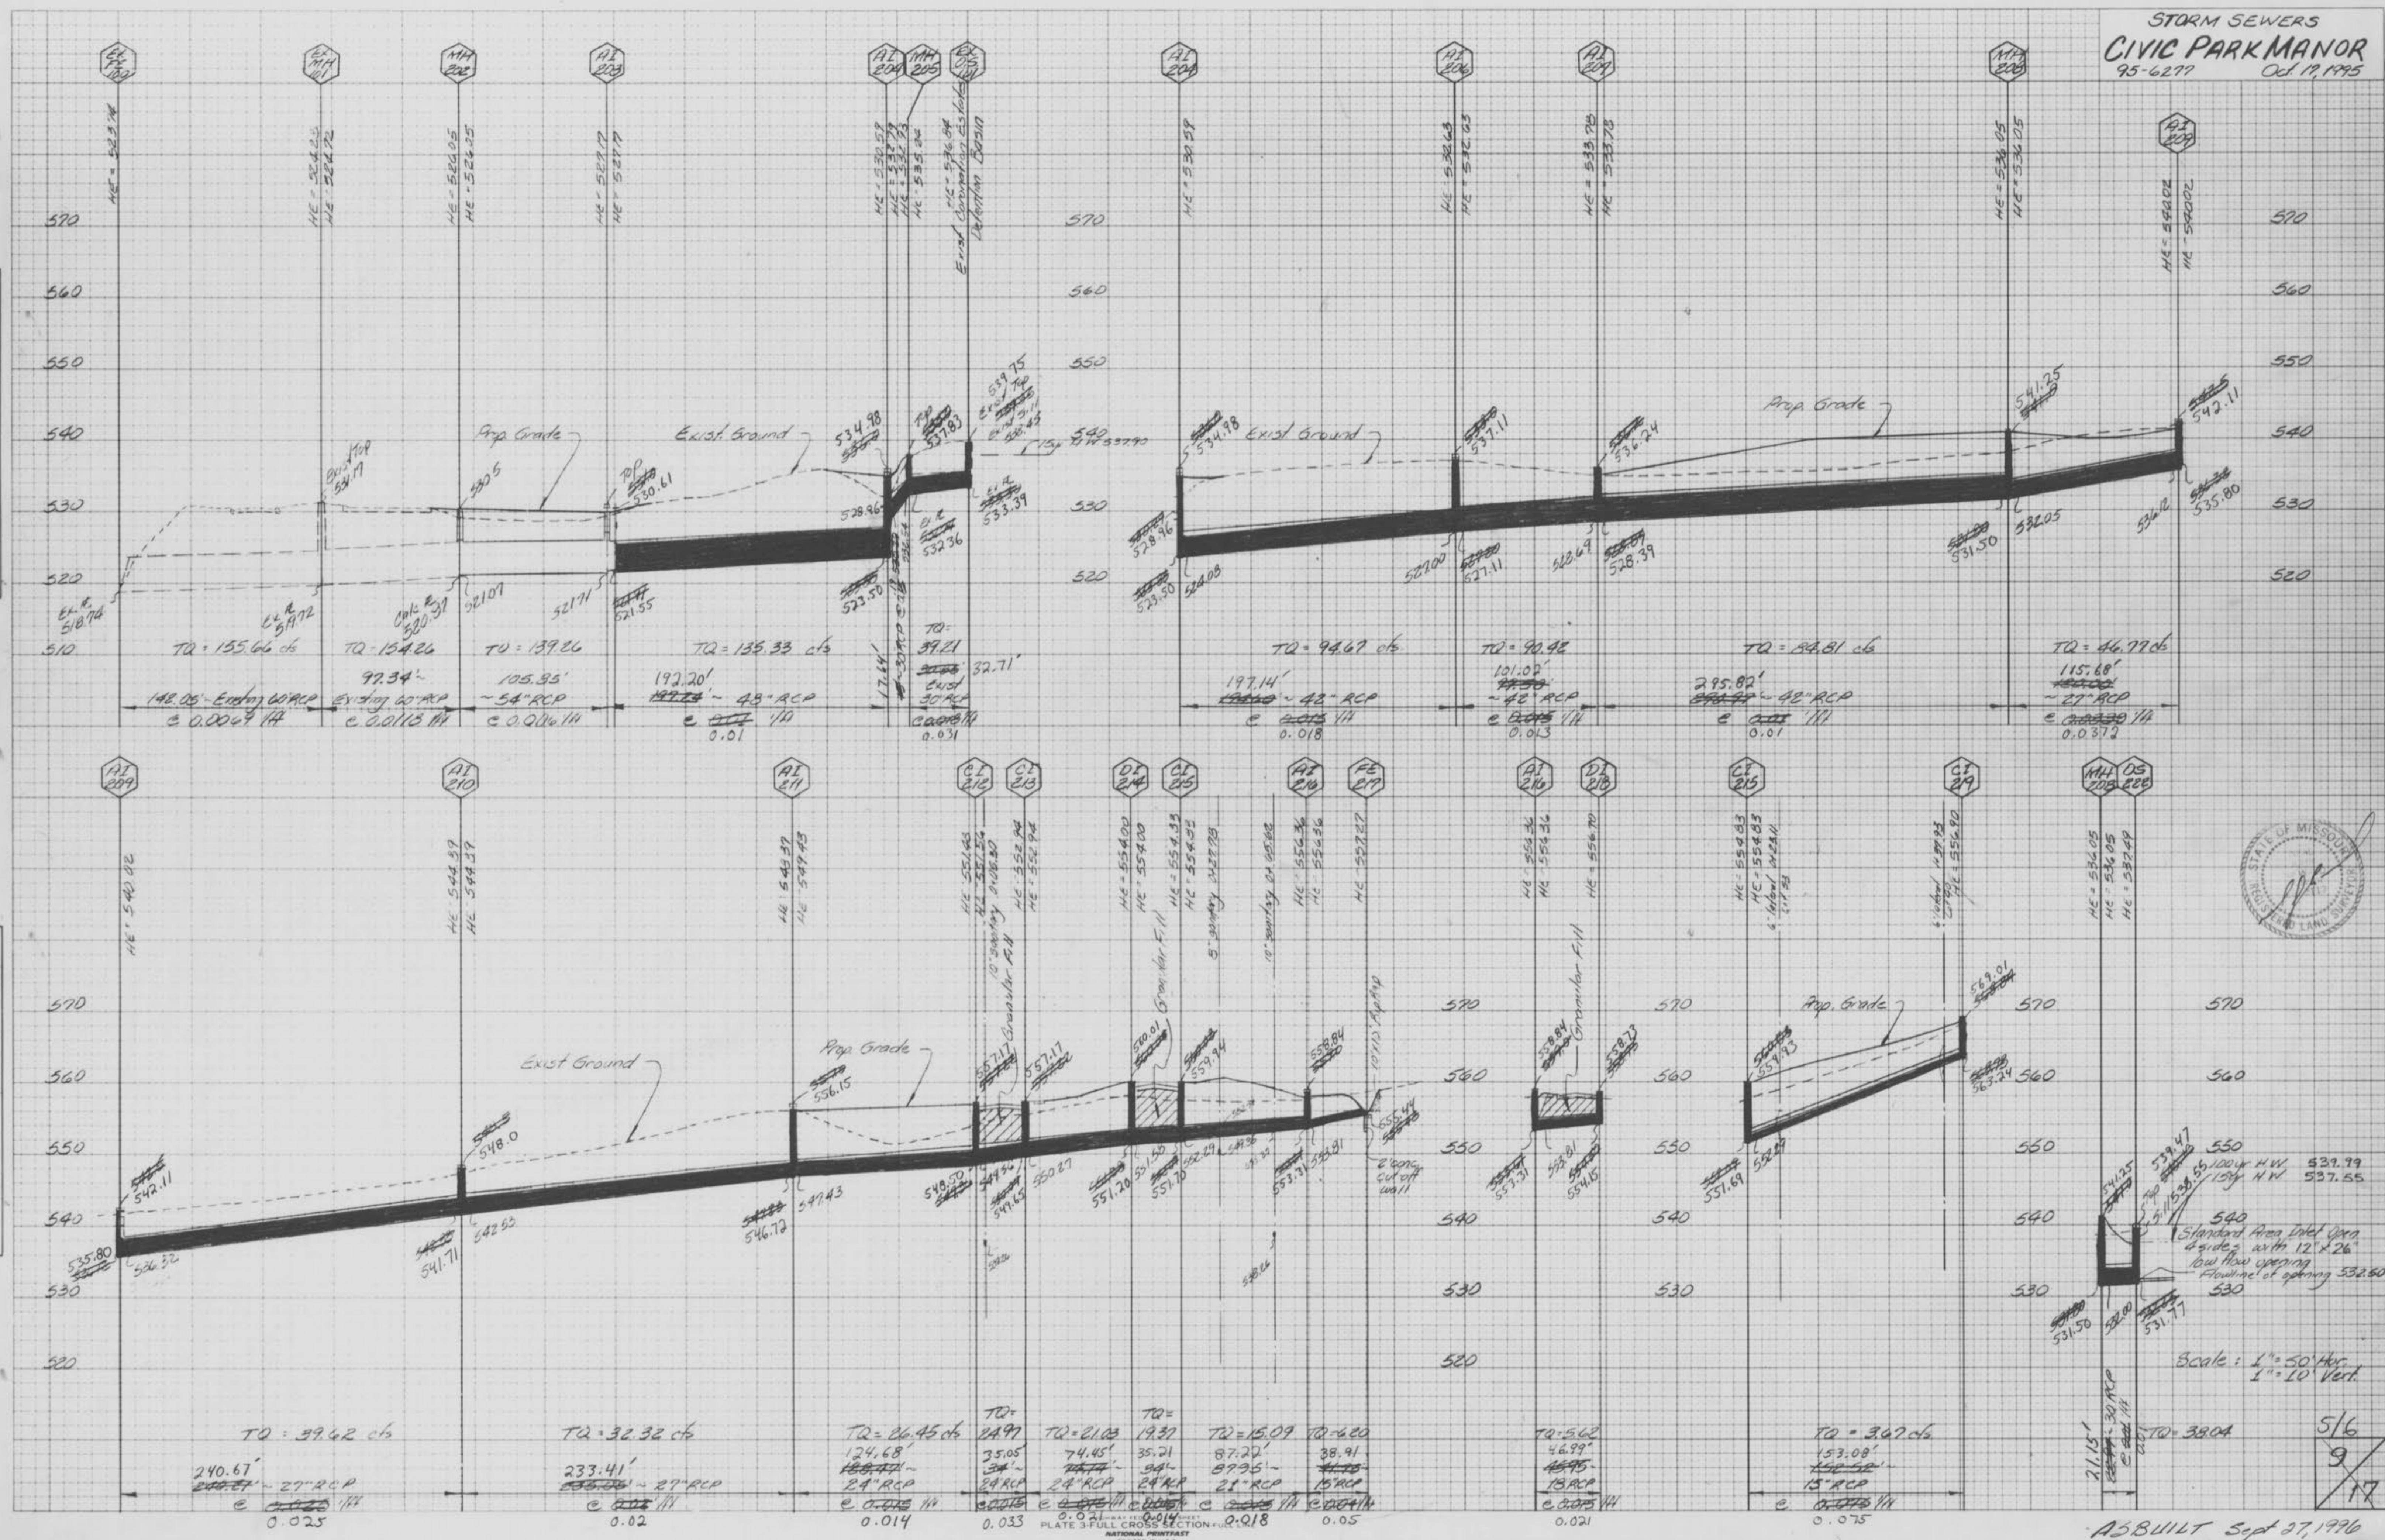


AS BUILT Sept 27, 1996

STORM SEWERS  
CIVIC PARK MANOR  
95-6277 Oct 17, 1995  
Rev 10-26-95

FINAL SURVEY  
LIAISON  
SURVEYORS  
SOUTHERN INTEGRATED  
TECHNOLOGIES INC.

ORIGINAL SURVEY  
LIAISON  
SURVEYORS  
SOUTHERN INTEGRATED  
TECHNOLOGIES INC.

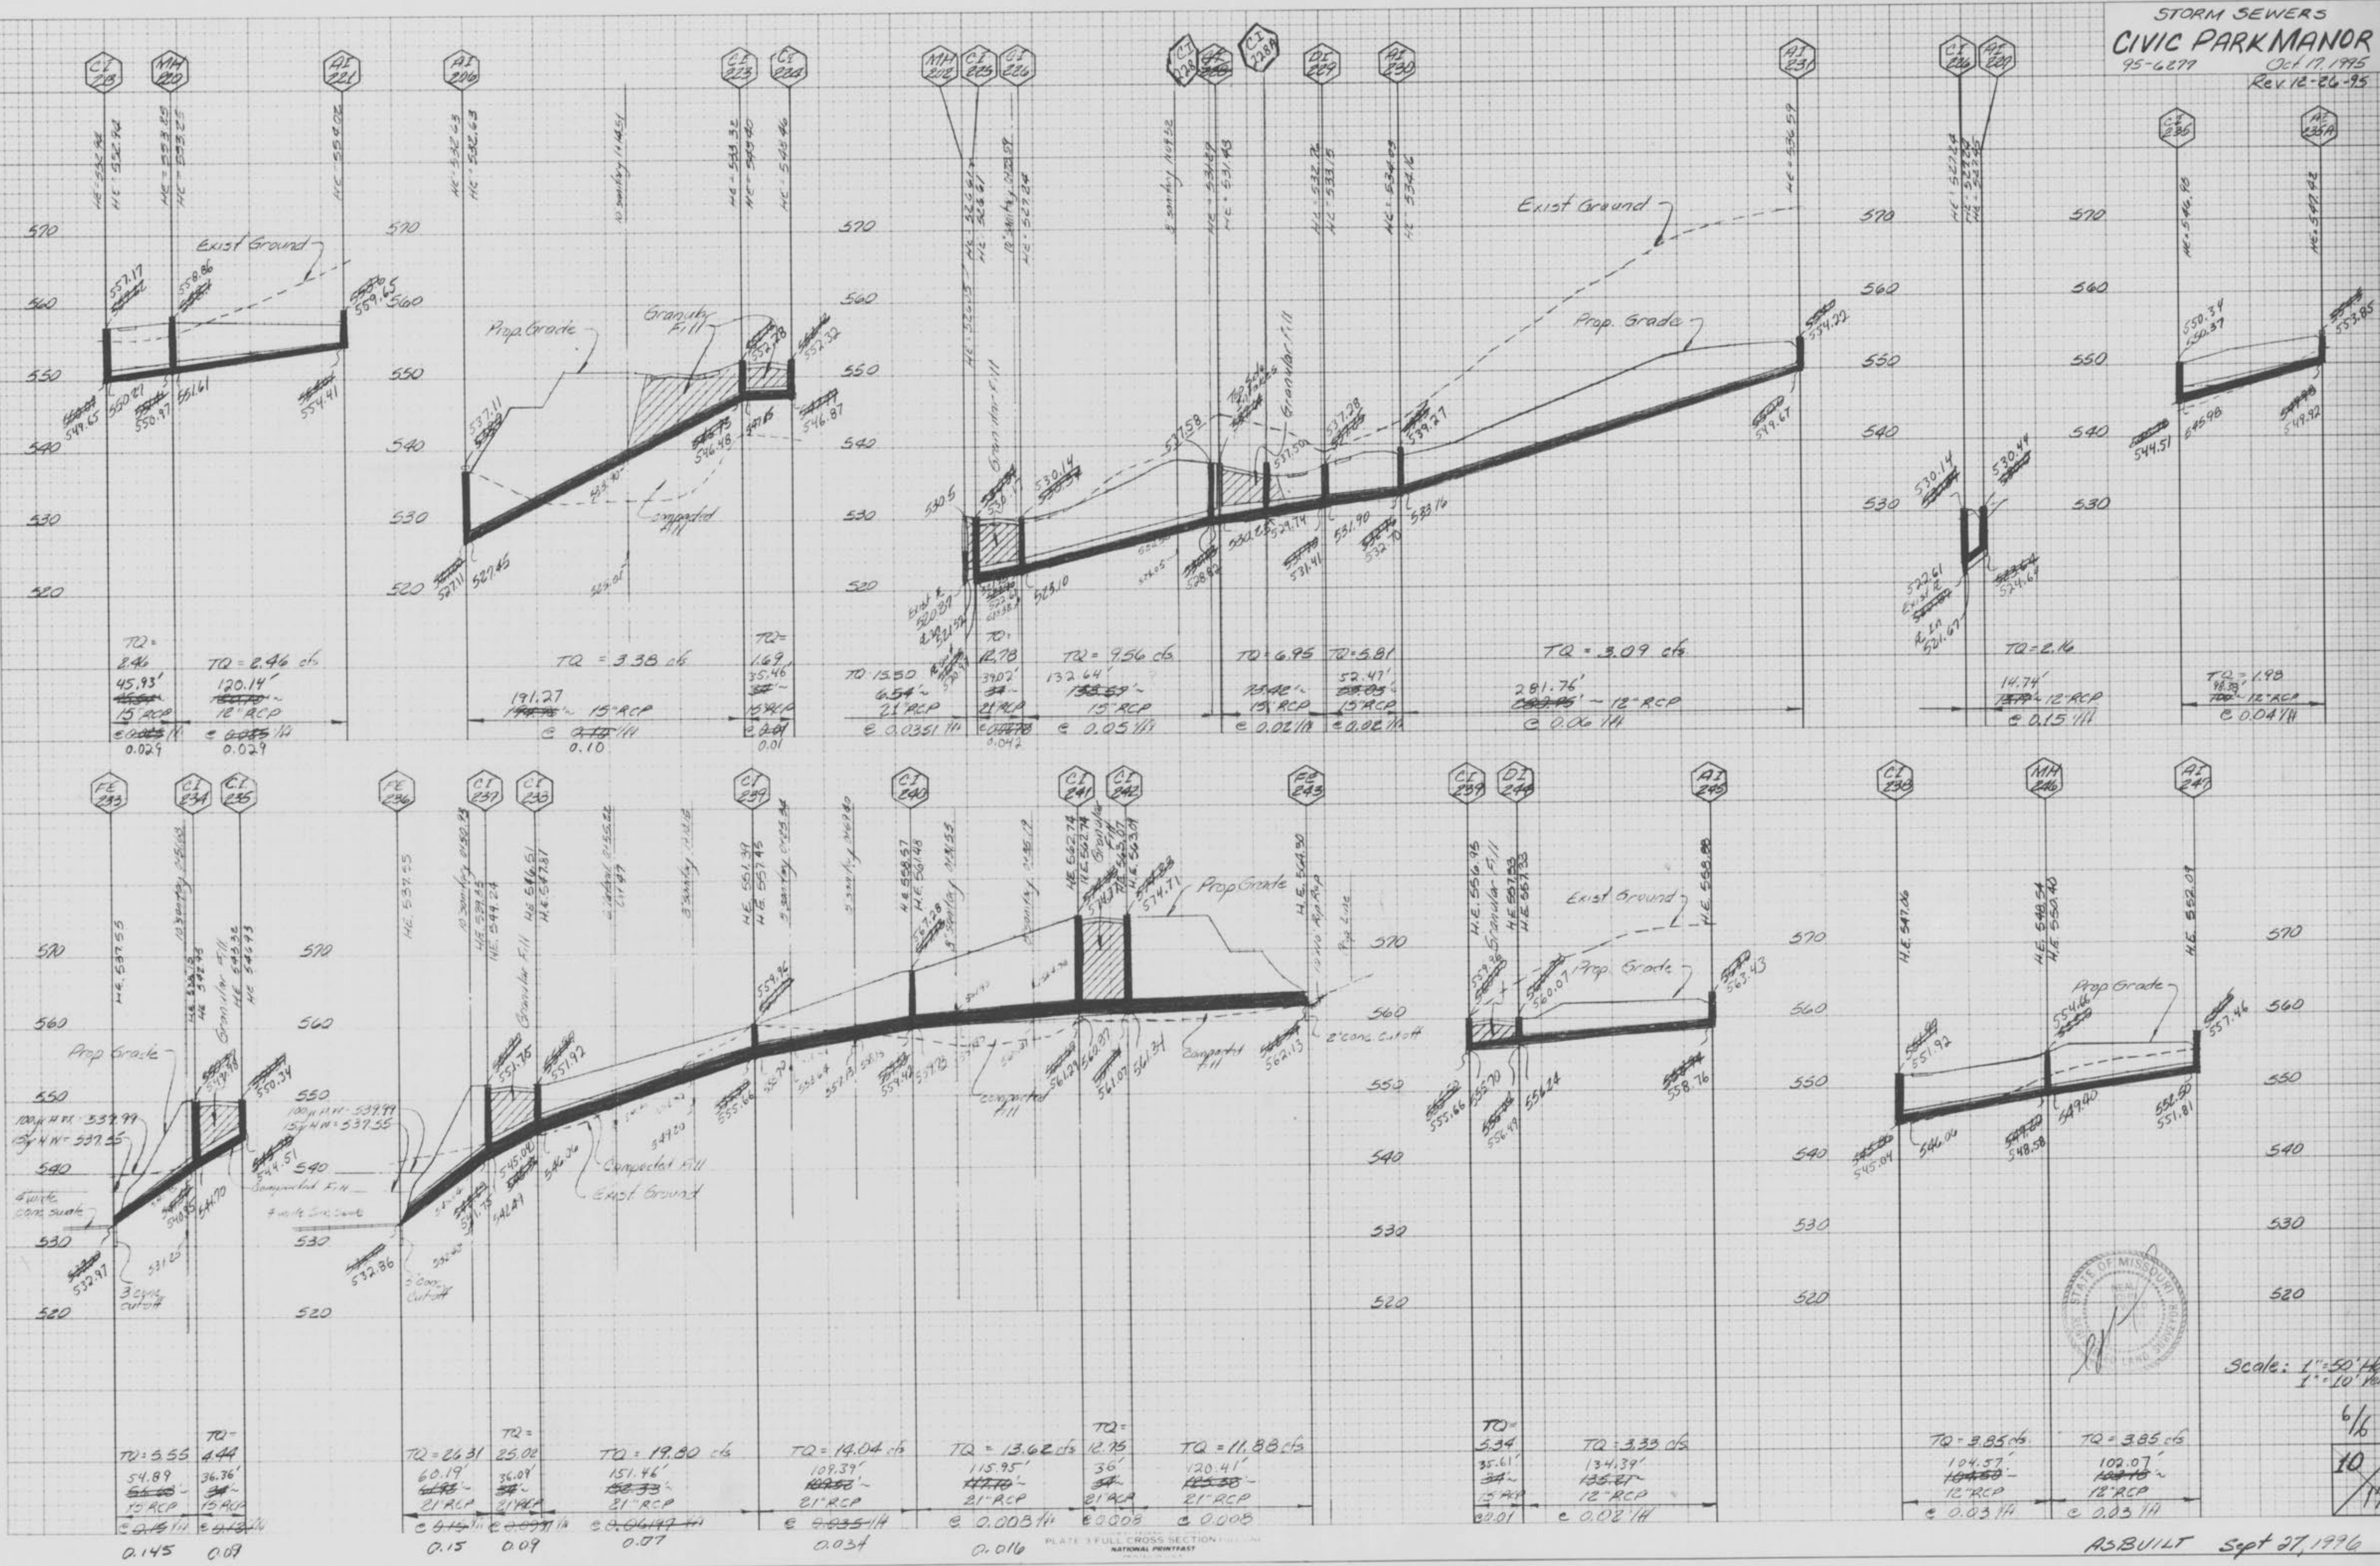

Scale: 1" = 50' Hori.  
1" = 10' Vert.

6/6

10

17

AS BUILT Sept 27, 1996