

SEE SHEET 2

N/F
KAPLAN LUMBER COMPANY, INC.
BK. 1413, PG. 268

1331.15



UNDERGROUND FACILITY STRUCTURES AND UTILITIES HAVE BEEN
PLOTTED FROM AVAILABLE SURVEYS AND RECORDED INFORMATION, AND
ARE LOCATED AS OF THE DATE OF THIS DRAWING. CONSIDERATION OF STRUCTURES ONLY.
FACILITIES EITHER SHOWN OR NOT SHOWN ON THESE PLANS, SHALL BE
THE RESPONSIBILITY OF THE CONTRACTOR.

UTILITY NOTE:

3

25

St. Louis, Mo.
Rev. 2/1/83
Rev. 9/27/87
Rev. 9/27/87
REV. 9/27/87 PER CITY COMMISSIONS
REV. 9/27/87 PER CITY COMMISSIONS

BERKSHIRE DOWNS
FLAT PLAN
APRIL 1987

SURVEYED BY:
ENGINEERING & SURVEYING
11/14/83 J.M.
PRIVATE RECORDS
G-4

N84°32'45"E

N/
TIMOTHY D. & WENDY

BK. 1518,

TEMPORARY CONST.
10' WIDE PERMANENTS09°13'55"W
25.40'FOR OFF-SITE SEWER
SEE SHEET 20

TEMPORARY CONST.

10' WIDE PERMANENT

"AS-BUILT"




3
25

BERKSHIRE DOWNS
SANITARY SEWER PROFILES

APRIL 1987

12/10
25

"AS-BUILTS"

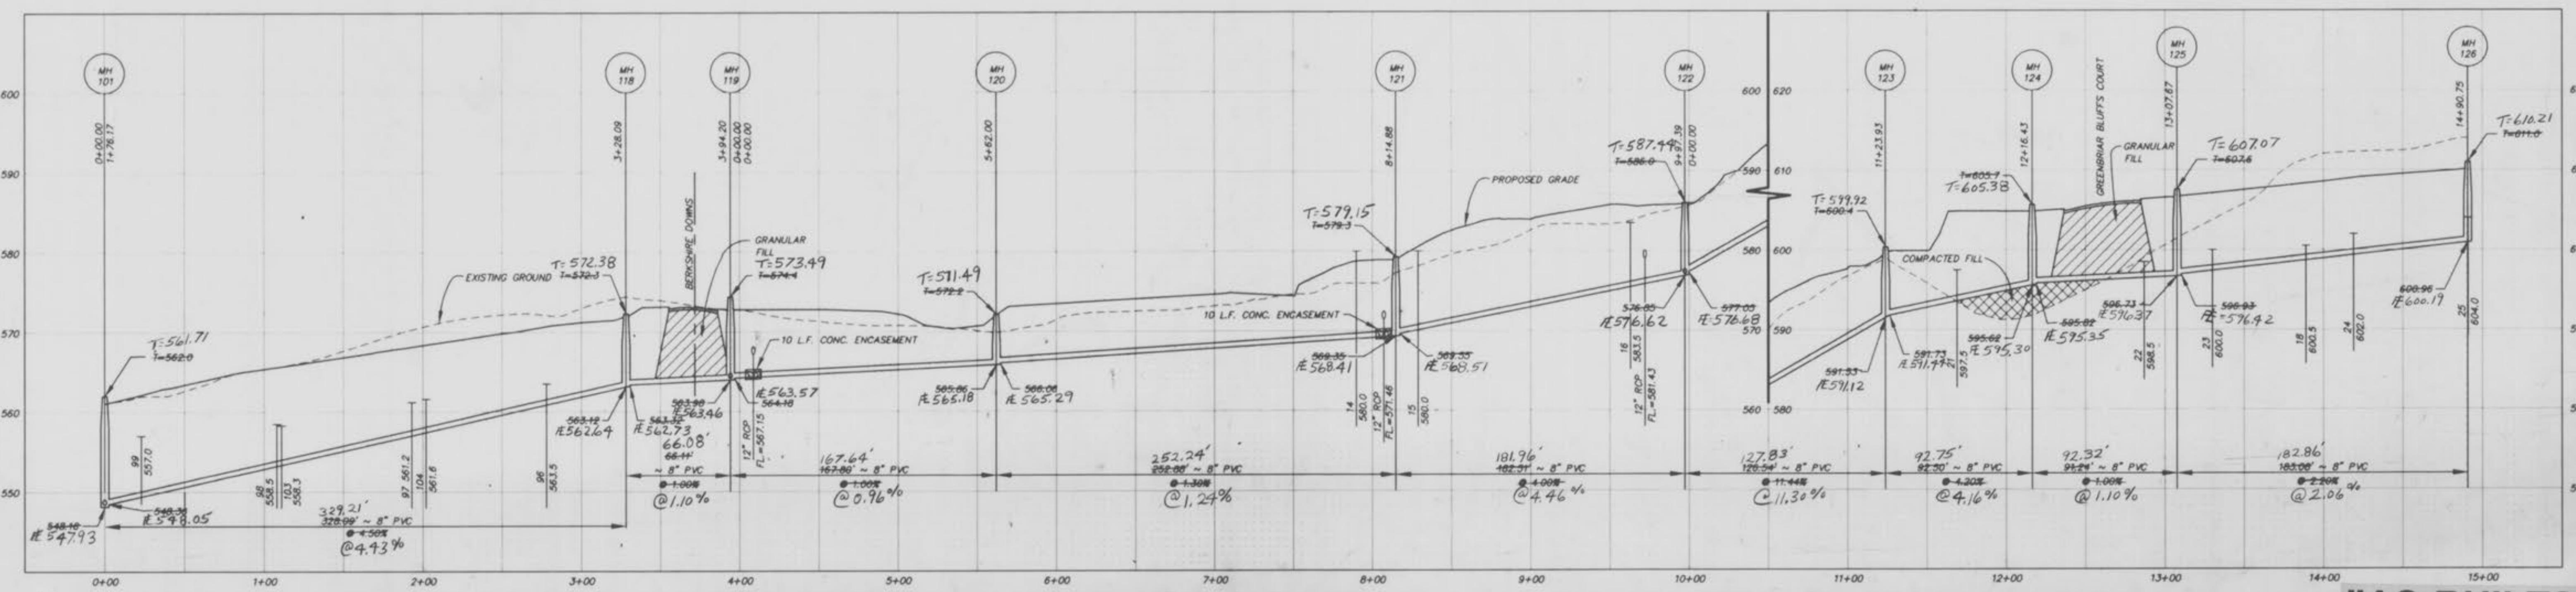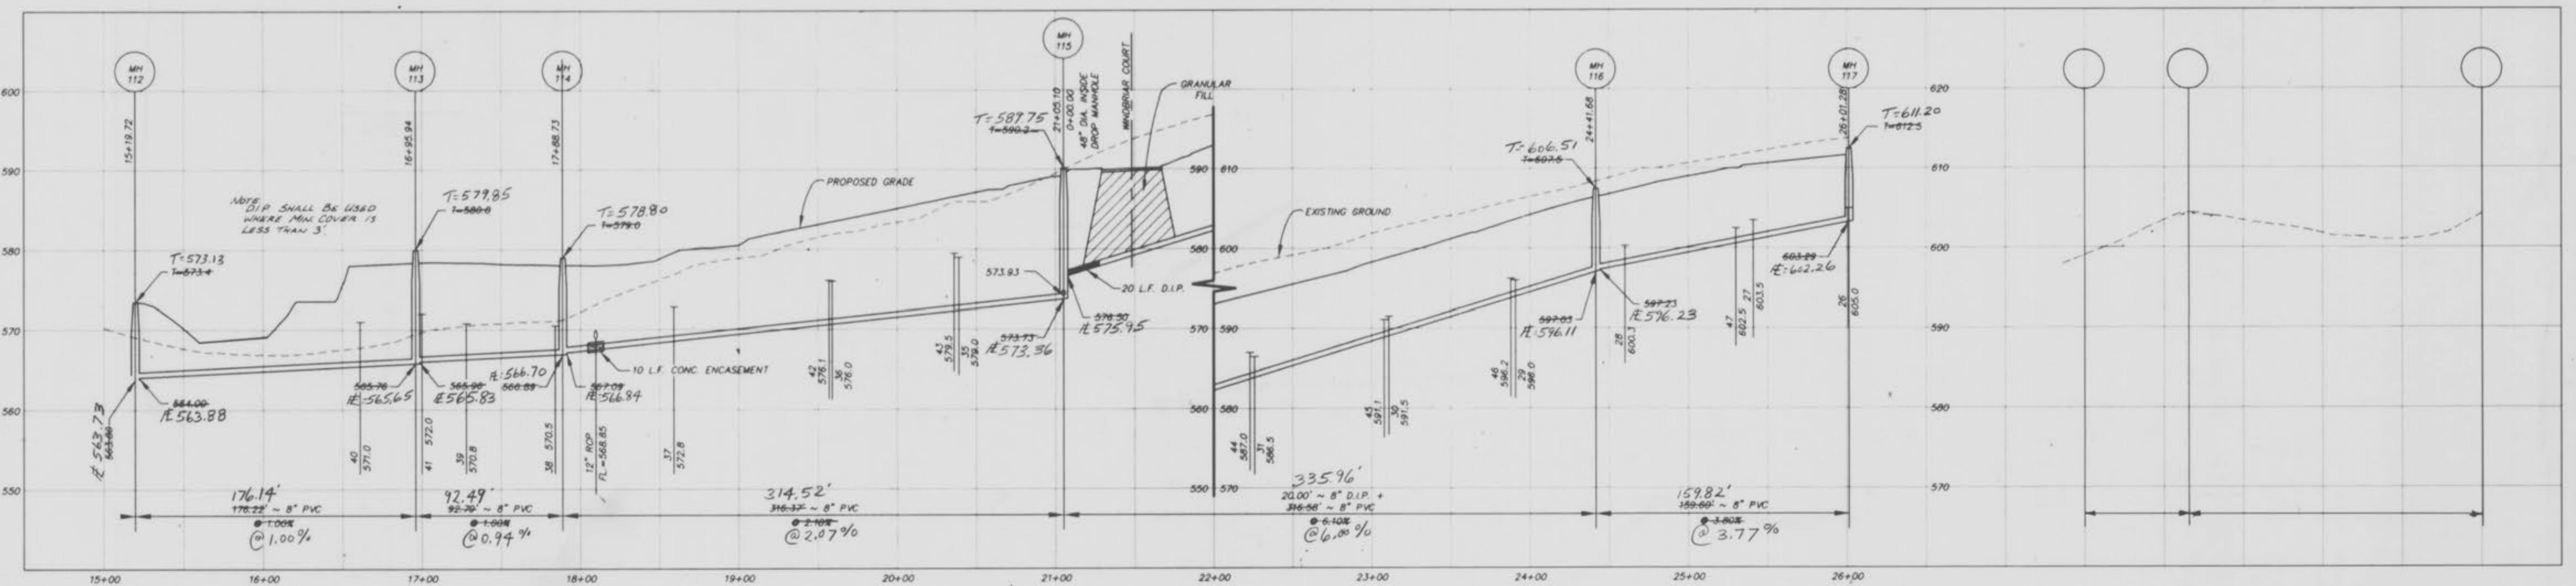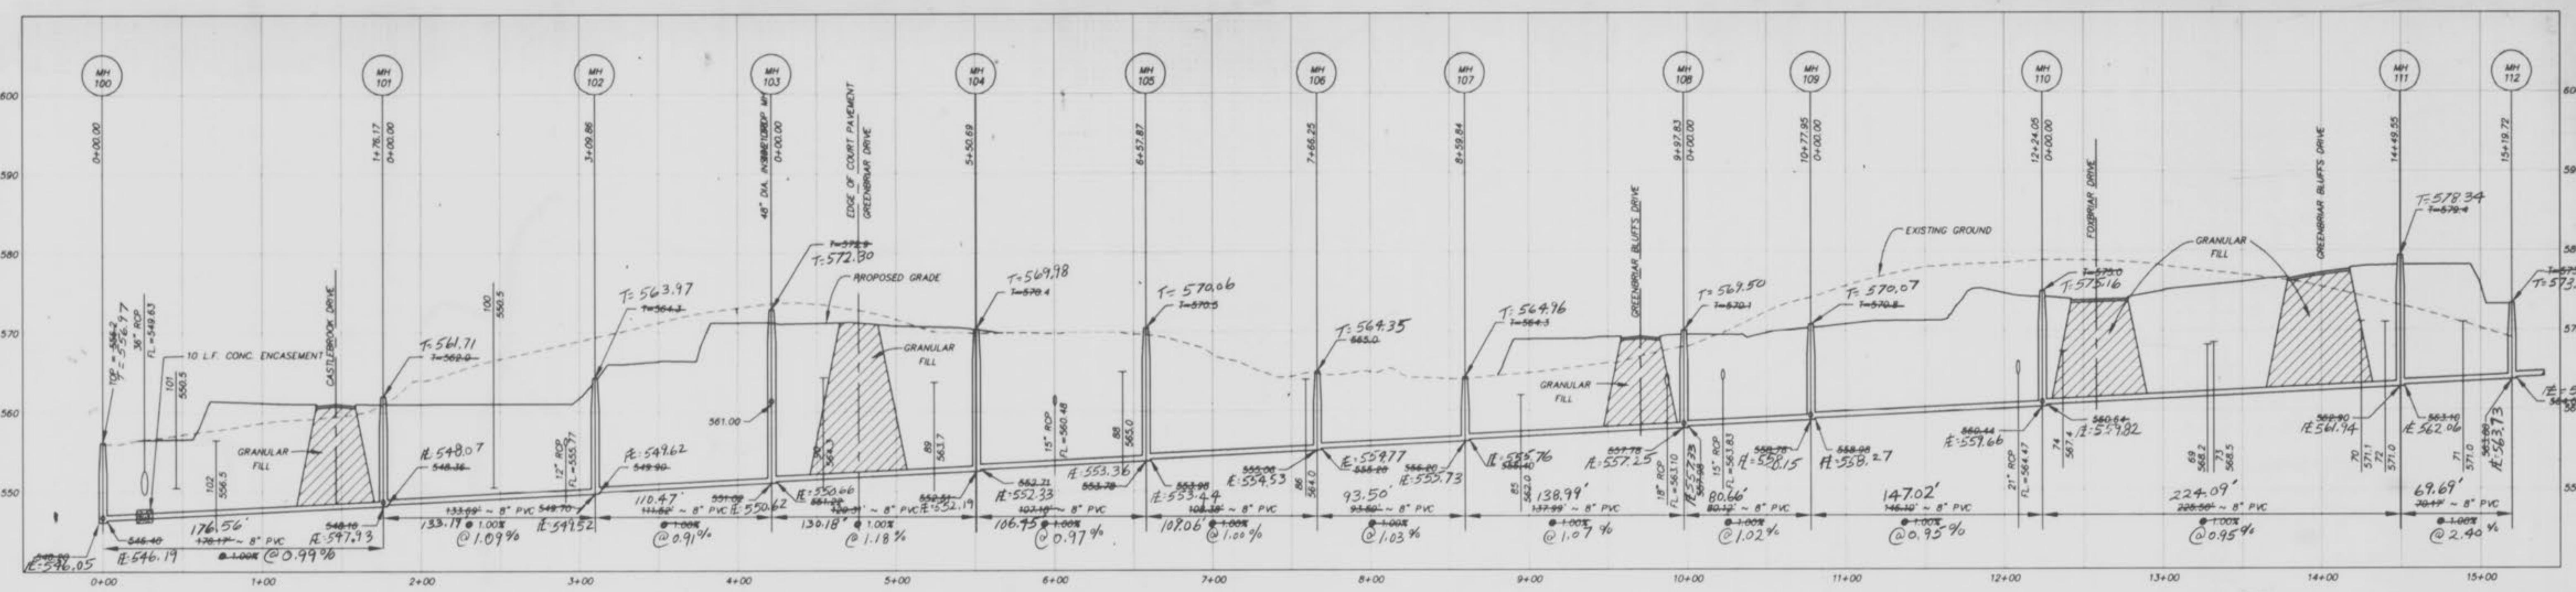

BERKSHIRE DOWNS
SANITARY SEWER PROFILES

APRIL 1997




AS-BUILT'S
STORM SAN
REF ID: 1997 PER DUCETT CREEK SAN DWT
REV 05/26/97 PER CITY OF OTTAWA ROW

ROW # 06-221

SCALE: 1" = 10' HORIZONTAL
1" = 10' VERTICAL

13
25




"AS-BUILTS"

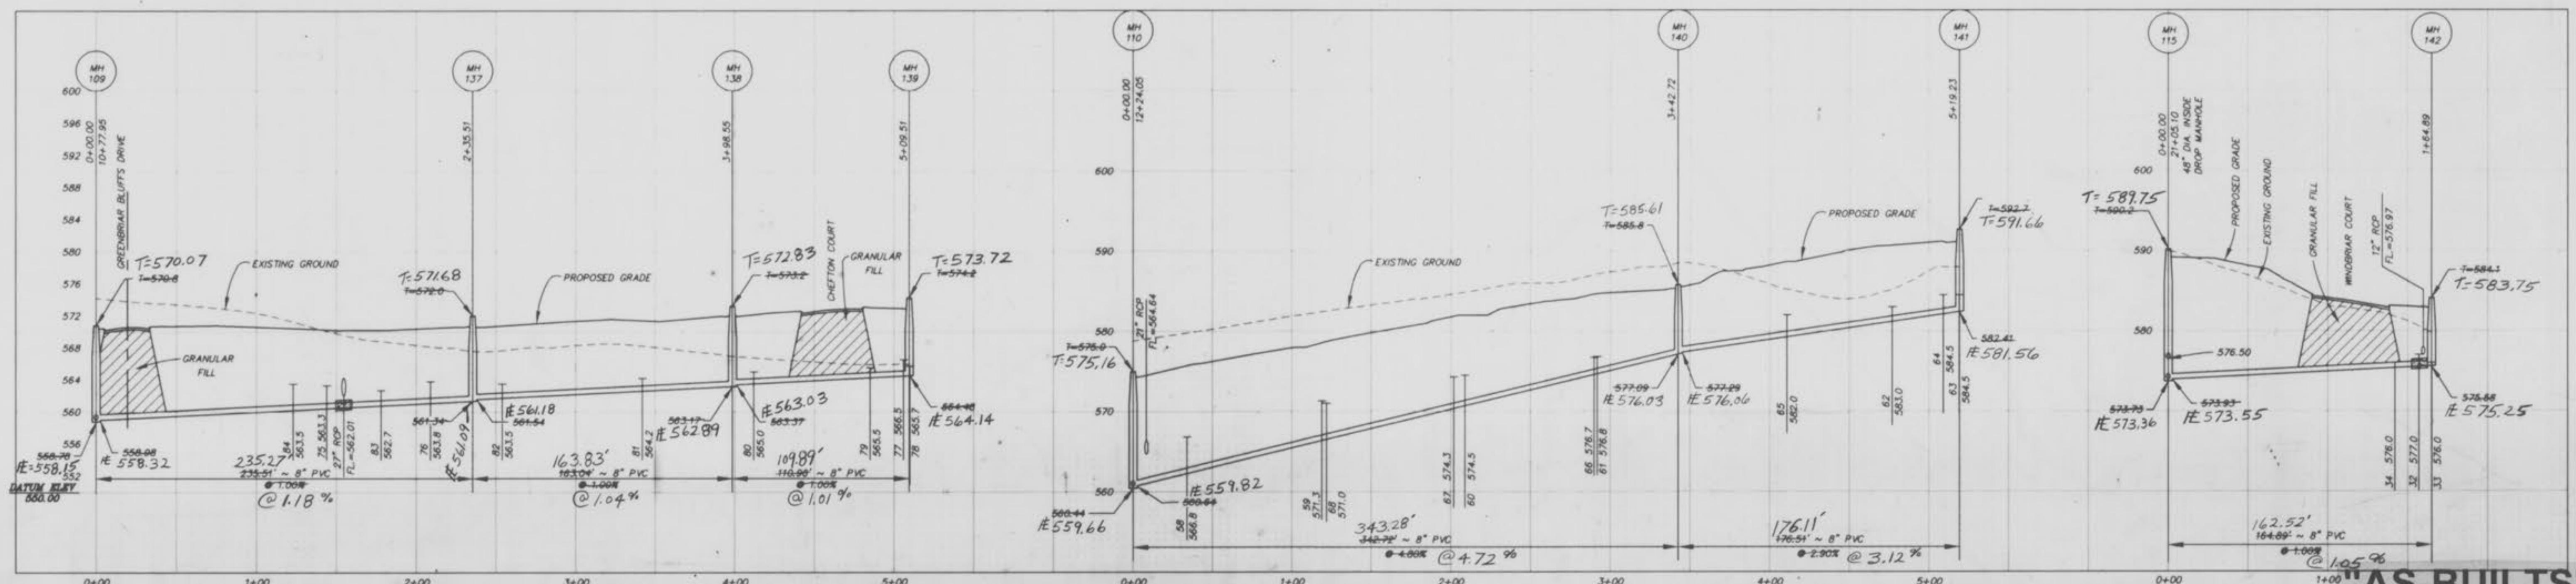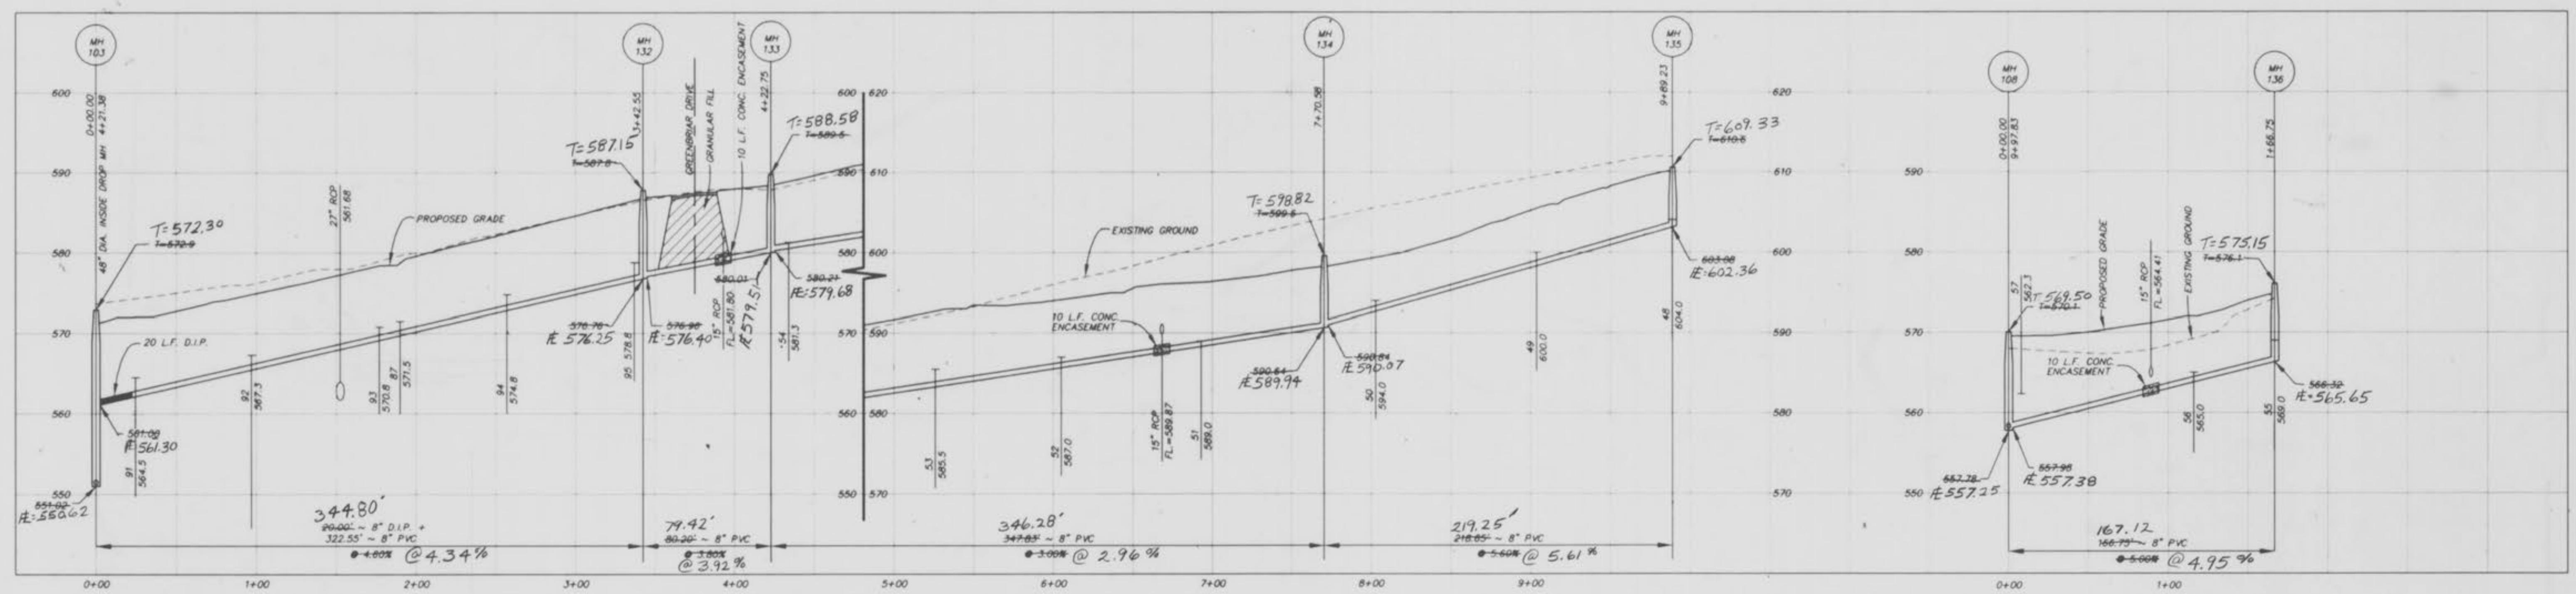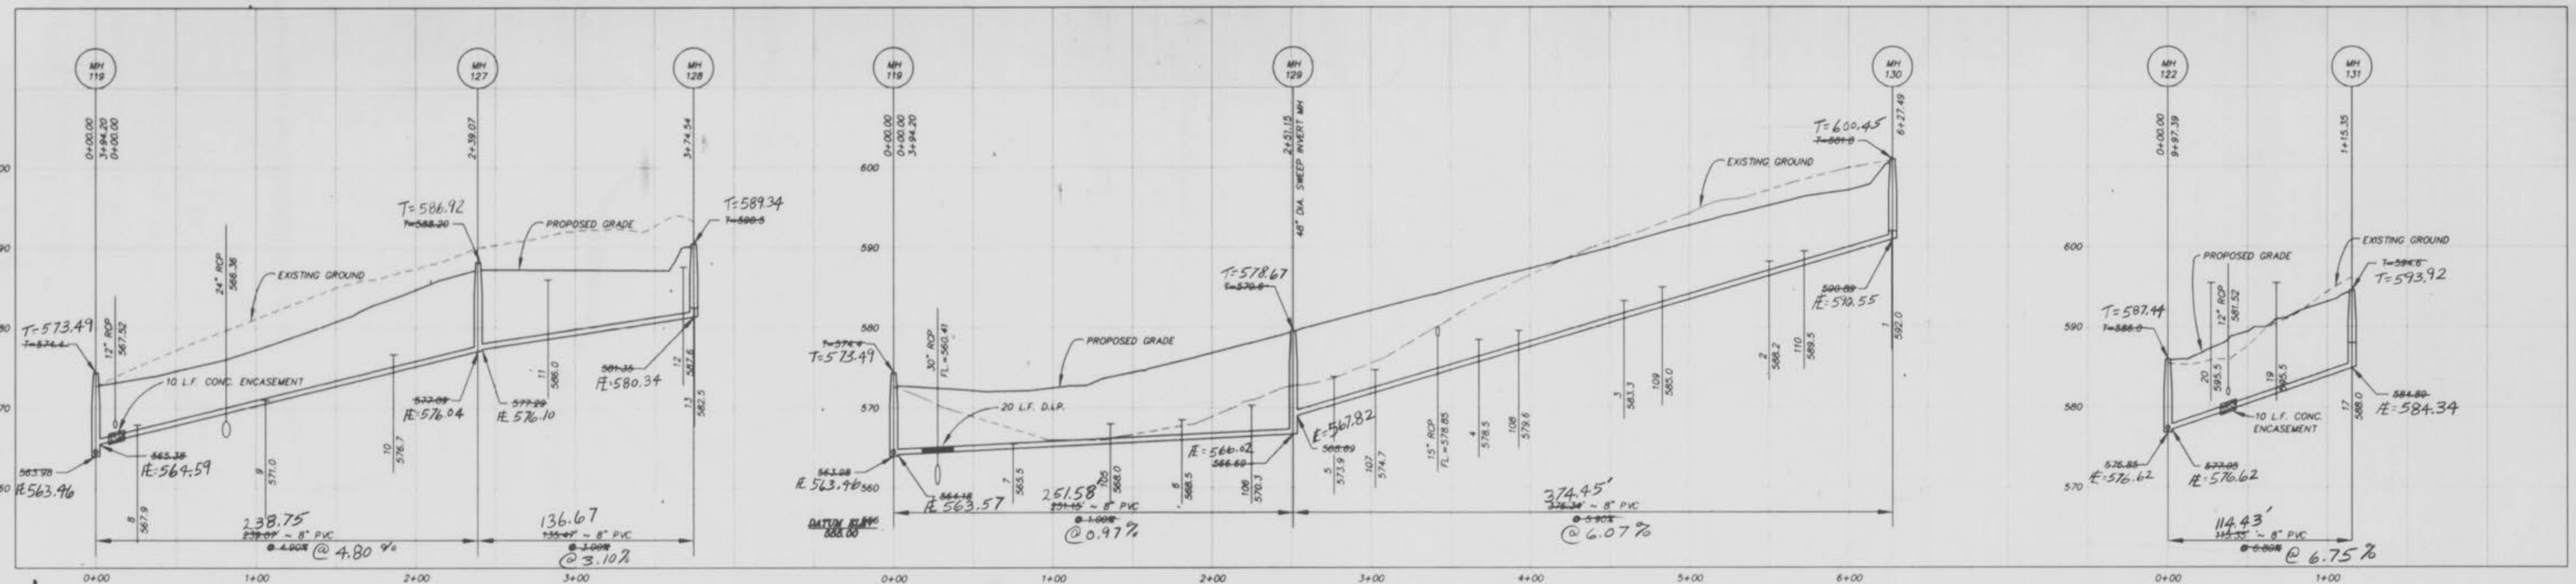

BERKSHIRE DOWNS
STORM SEWER PROFILES

APRIL 1997

AS-BUILT'S
STICK & STICKER CHART
REV. 04/26/97
224
100 # 06-221

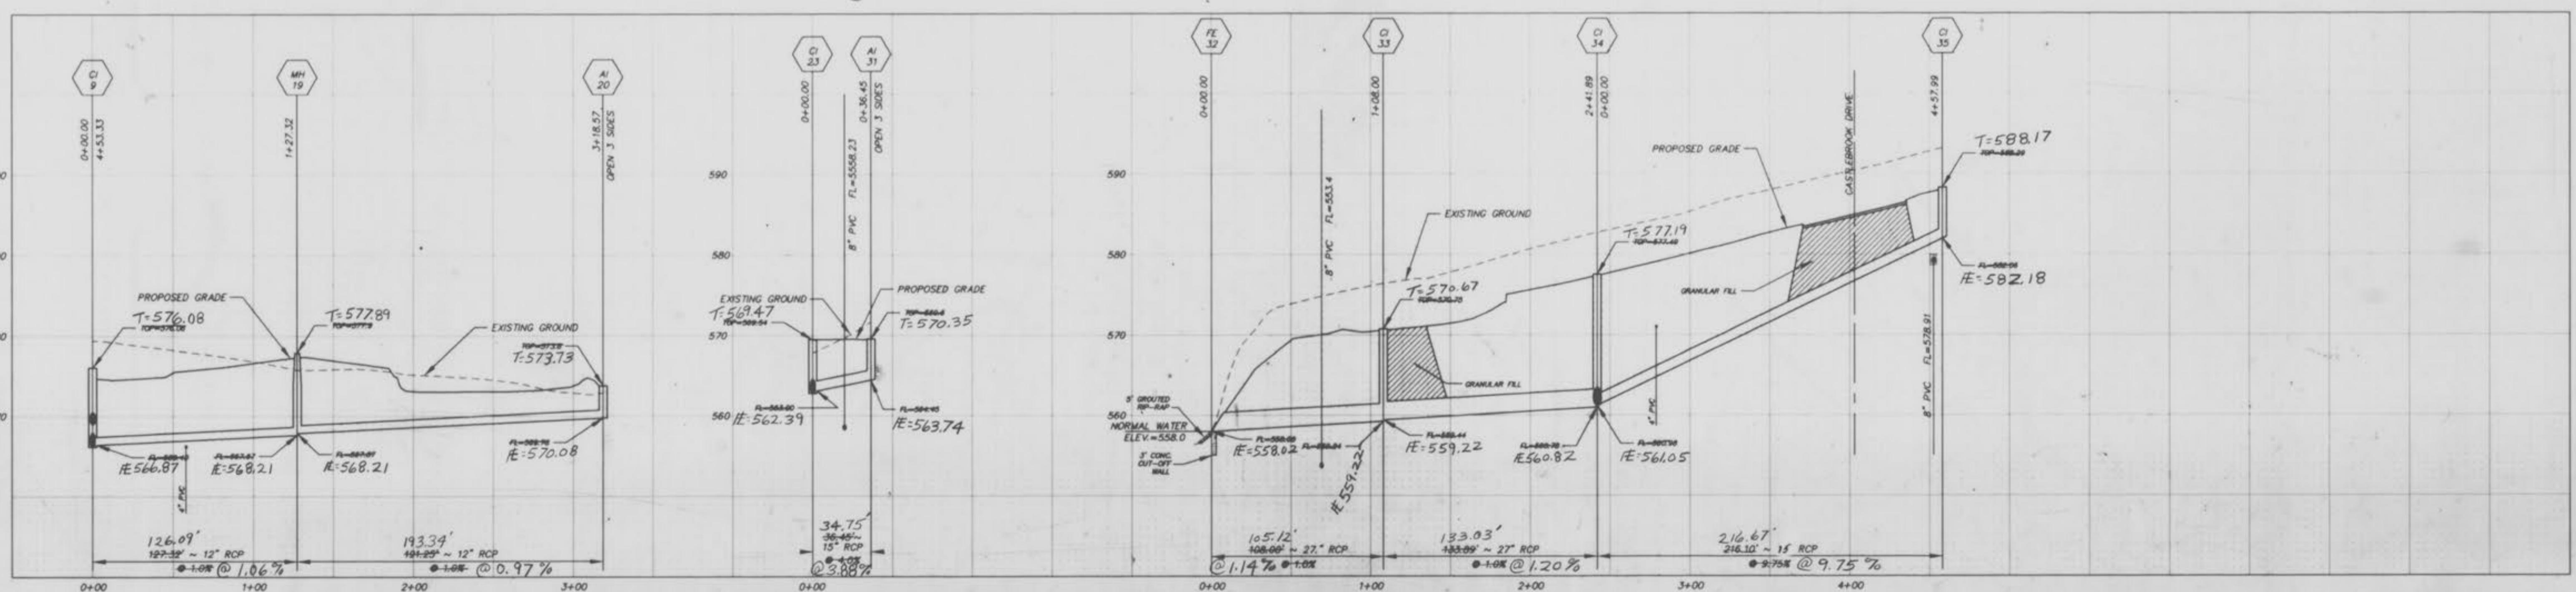
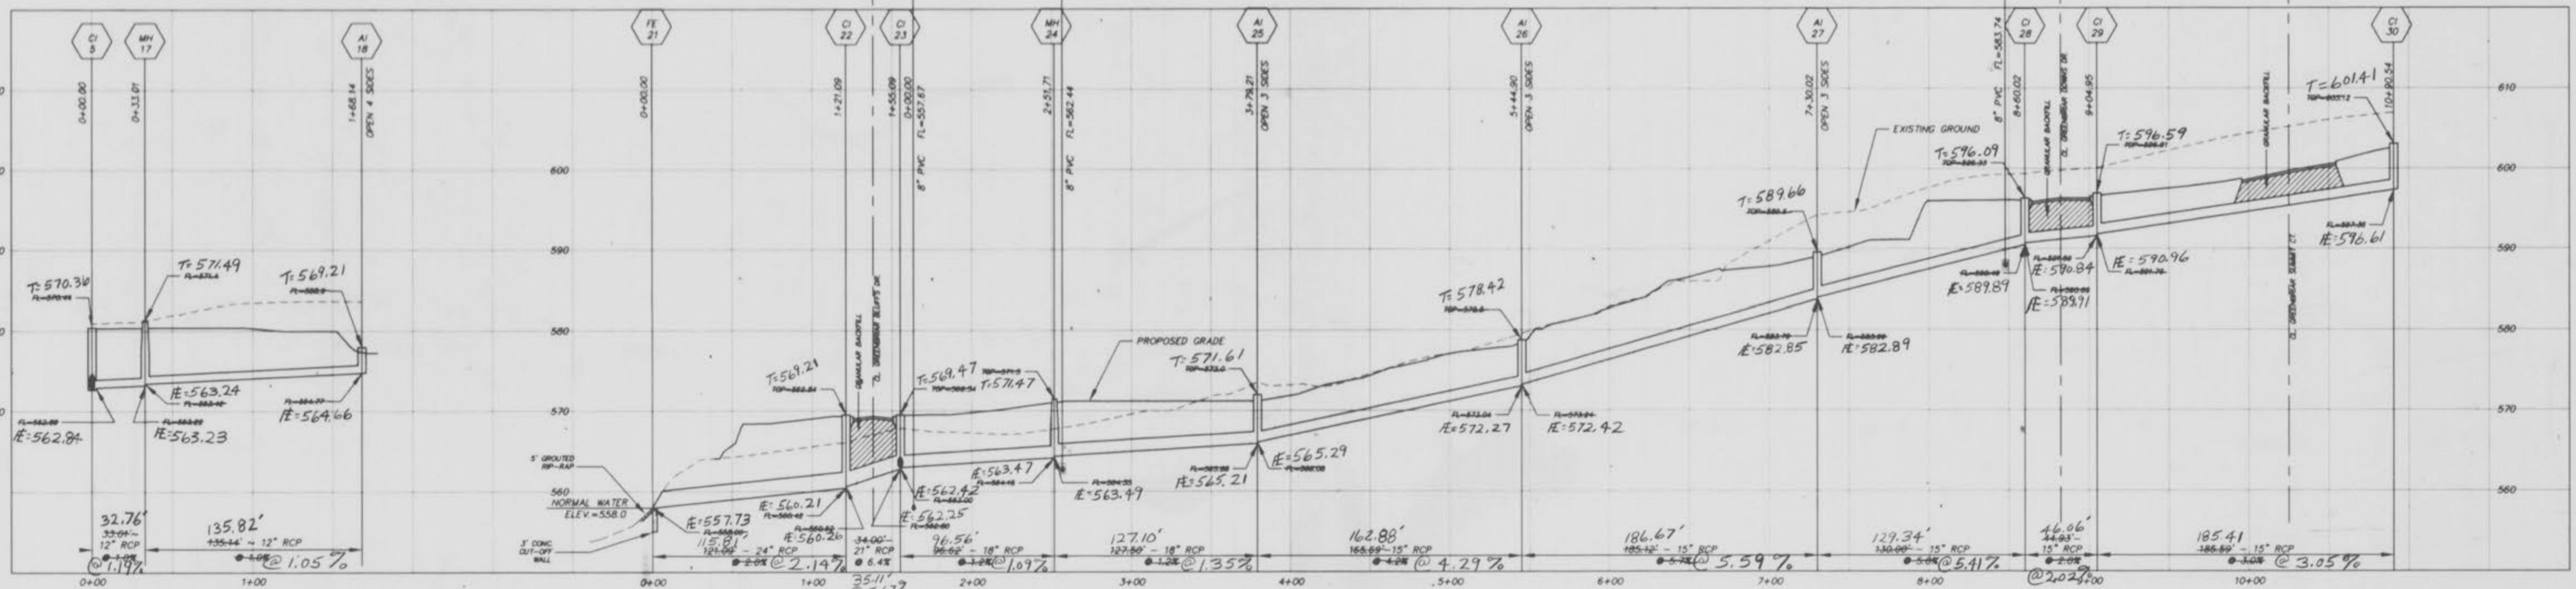
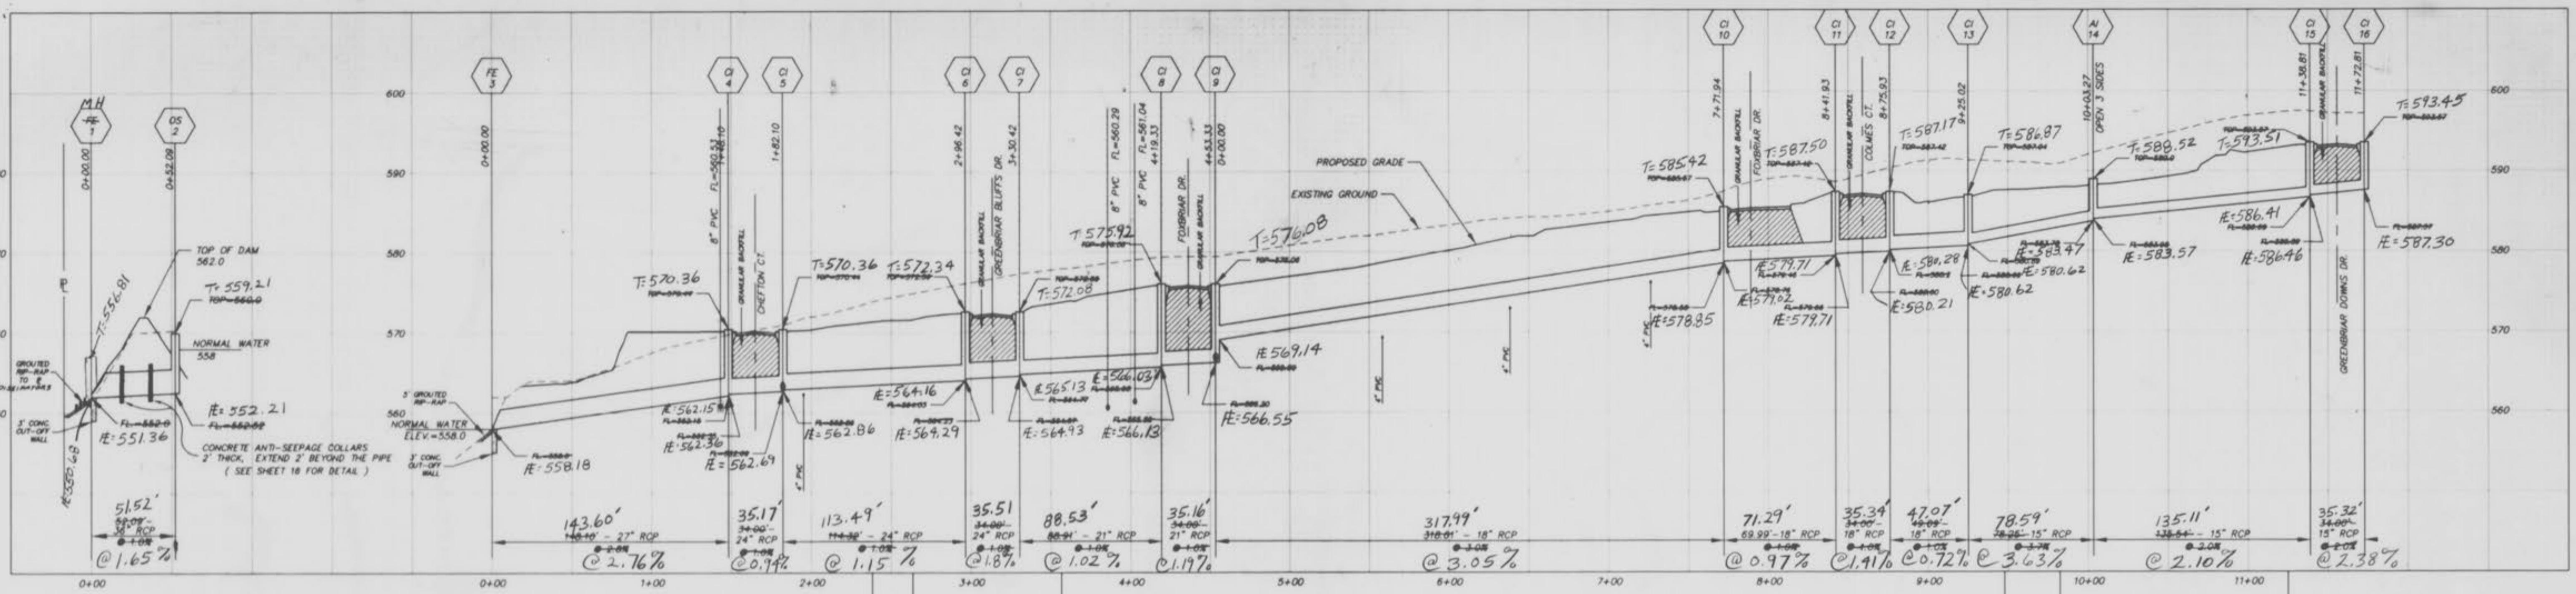


BERKSHIRE DOWNS
STORM SEWER PROFILES

APRIL 1987

A-5-Build 15
Station 50-13-98
On the Ground Line C of Channel
Line # 96-27

REvised
9-5-01
Off-Ground

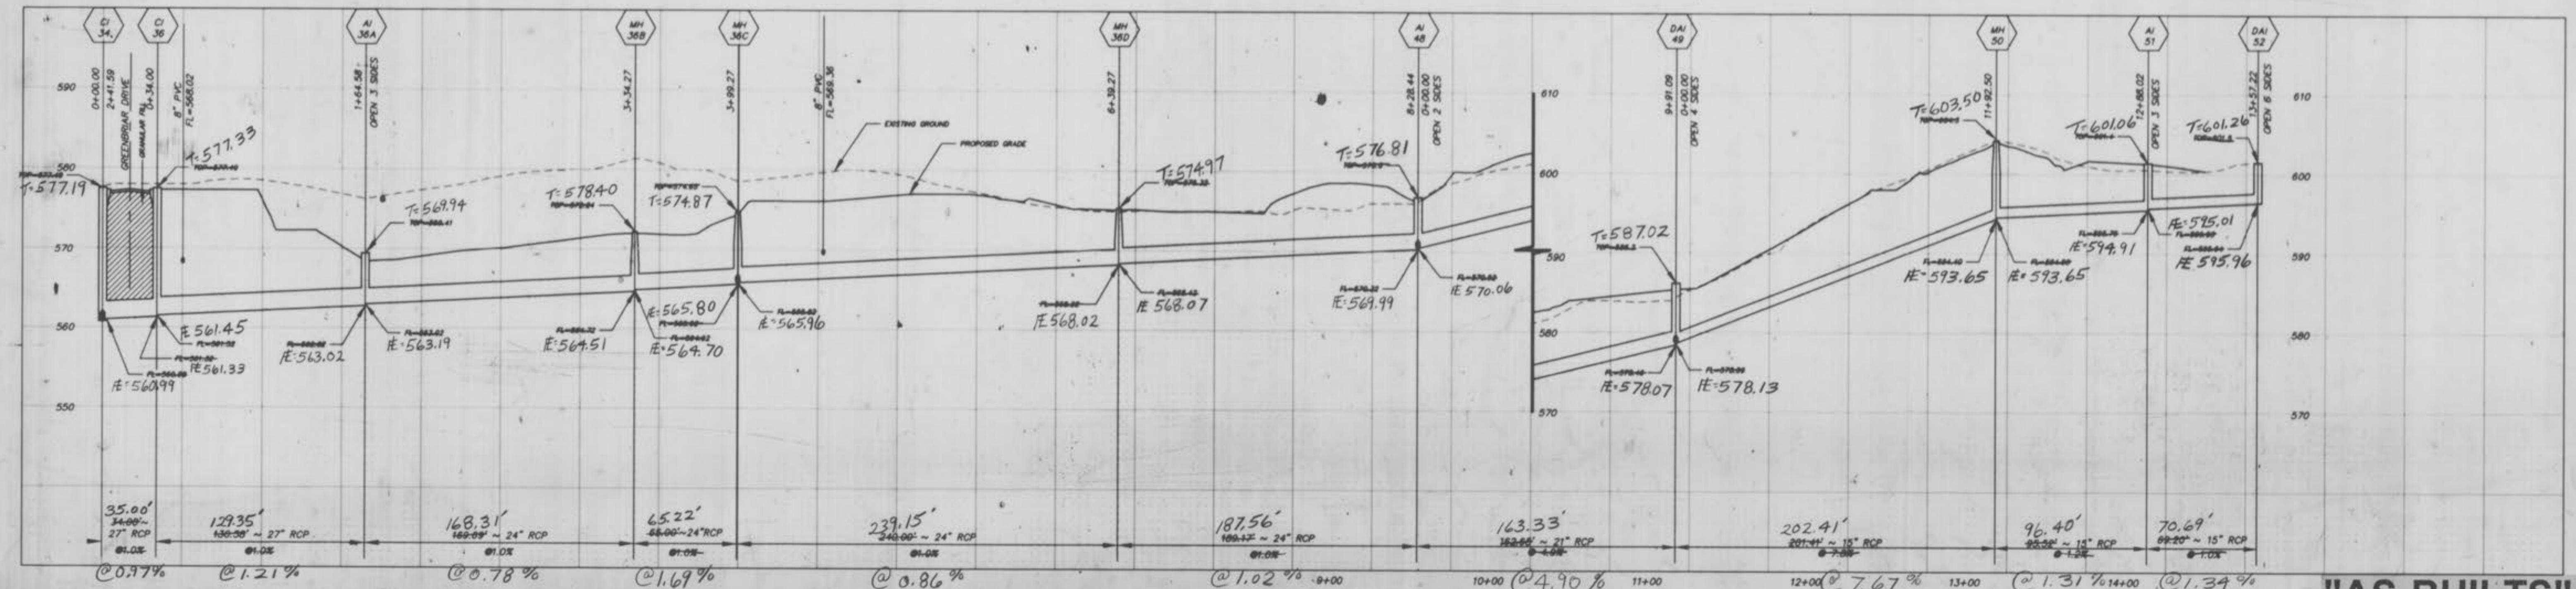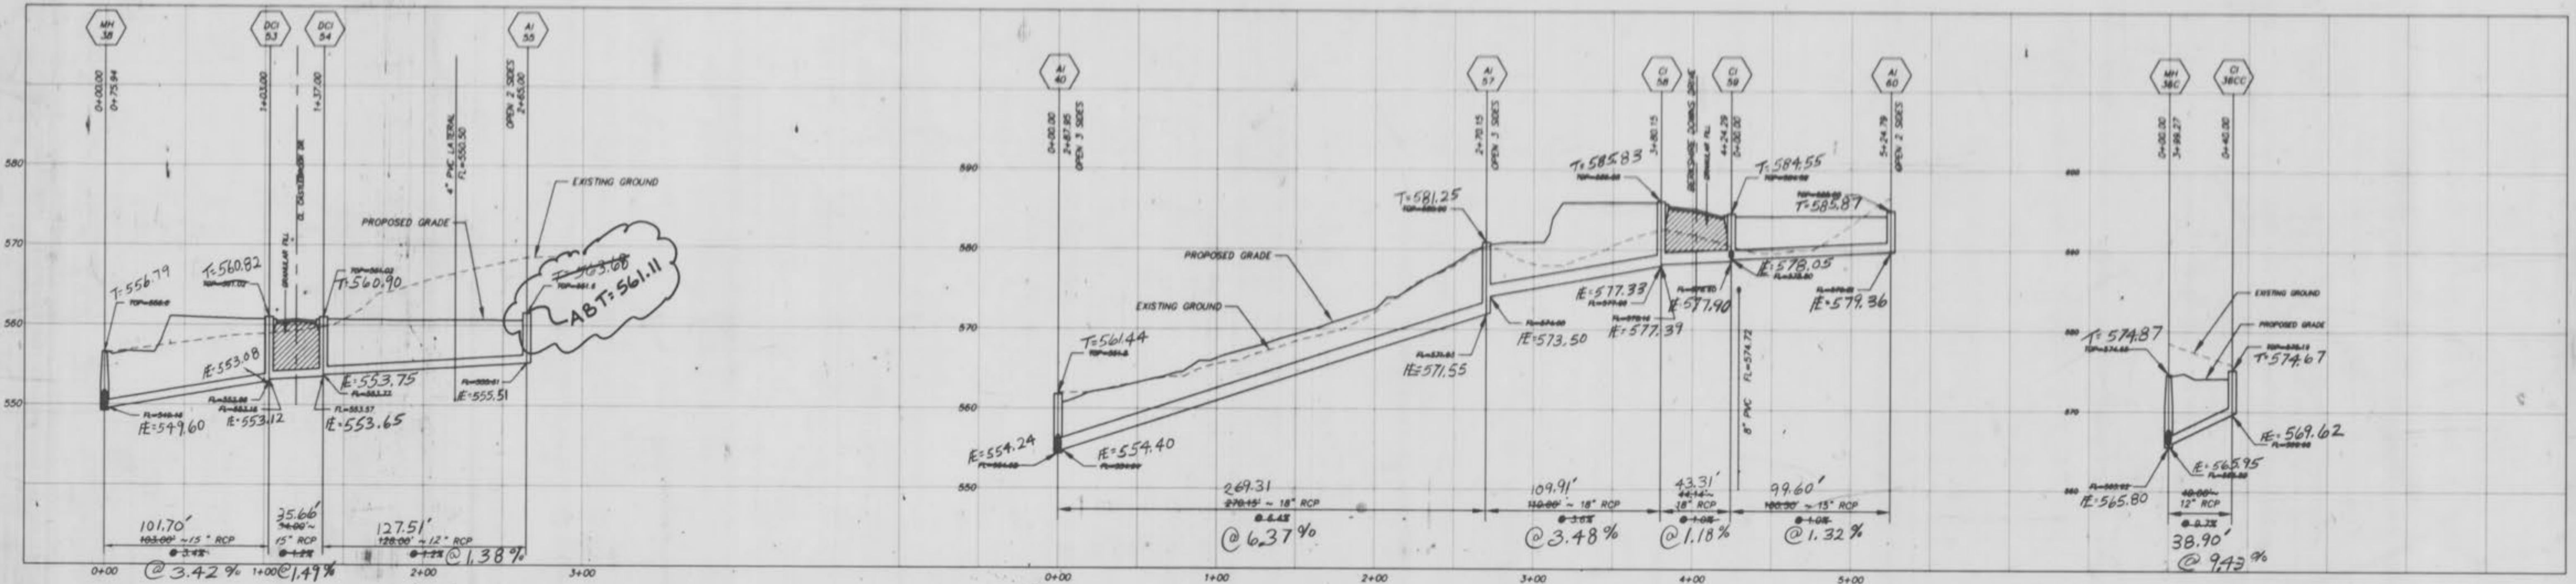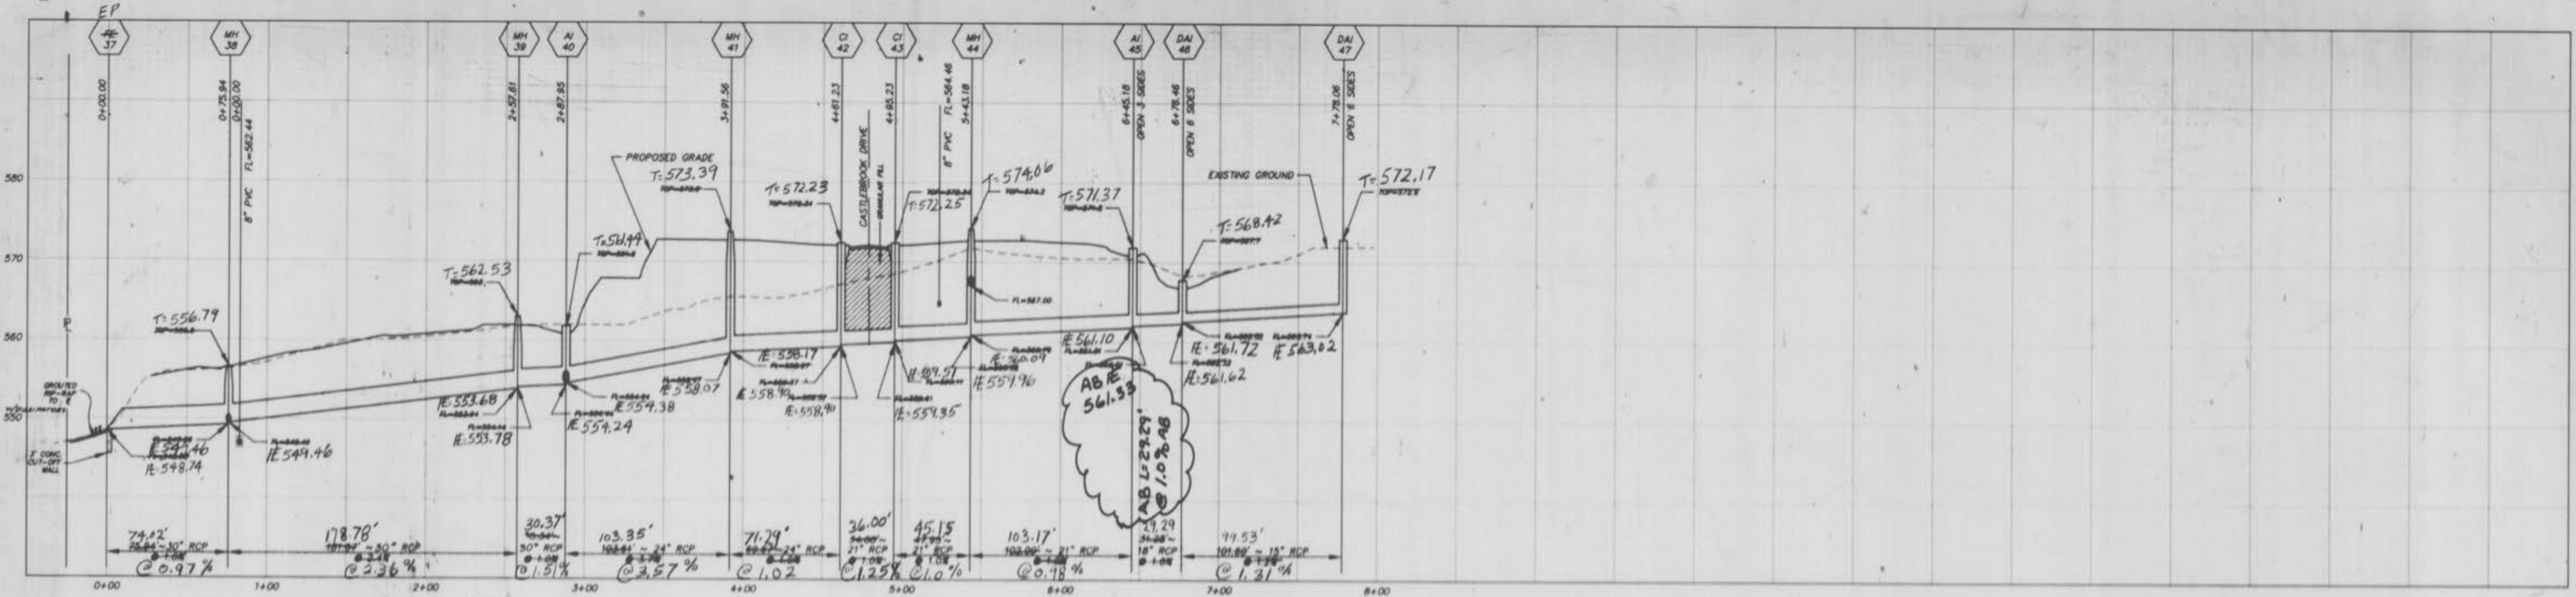

"AS-BUILTS"

15/10
25



BERKSHIRE DOWNS
STORM SEWER PROFILES

APRIL 1997

408 04-221

A.S-BU.LT+S

Storano SA~ 3-3-98

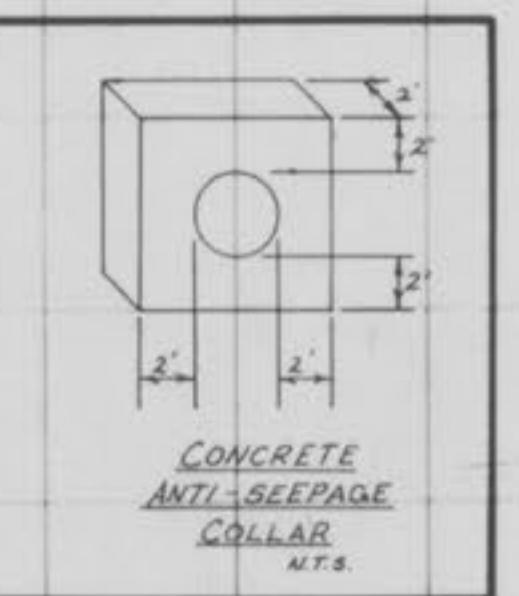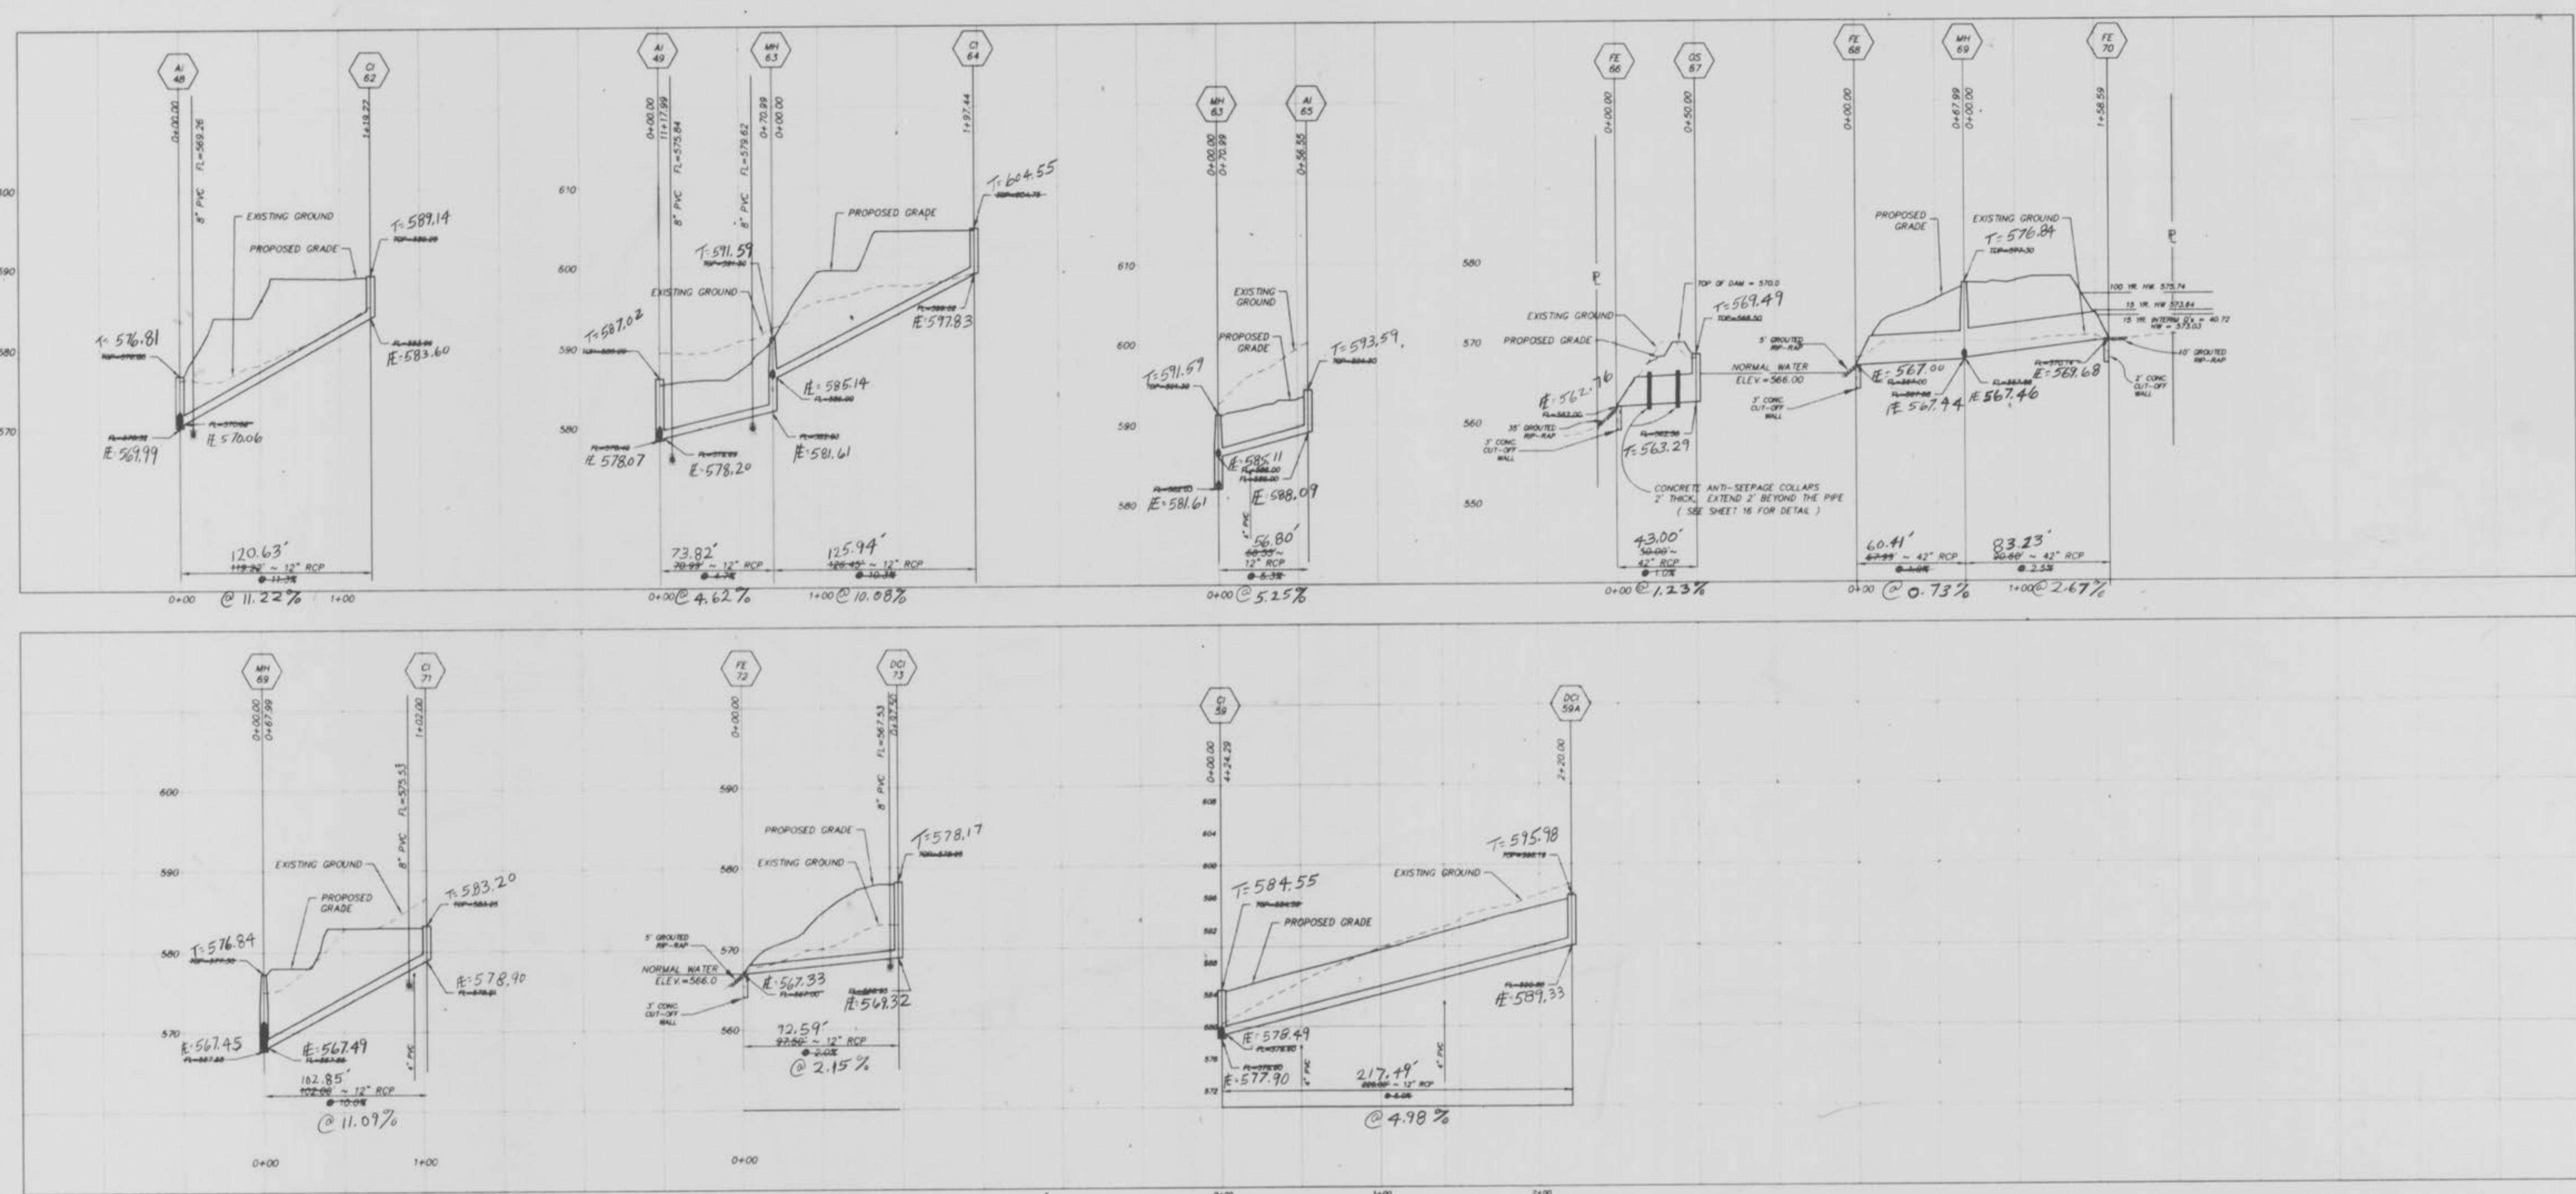

"AS-BUILTS"

16
10
25