

# BROOKSIDE


A TRACT OF LAND BEING PART OF  
SECTIONS 22, 23, 26, & 27, AND PART OF  
U.S. SURVEY 54, TOWNSHIP 47 NORTH, RANGE 2 EAST,  
ST. CHARLES COUNTY, MISSOURI

## STORM SEWER BYPASS AS-BUILTS

### GENERAL NOTES



- Gas, water and other underground utilities shall not conflict with the depth or horizontal locations of existing and proposed sanitary and storm sewers, including house laterals.
- Underground utilities have been plotted from available information and, therefore, their locations must be considered approximate only. The verification of the location of all underground utilities, either shown or not shown on these plans, shall be the responsibility of the contractor and shall be located prior to grading or construction of improvements.
- All filled places under buildings shall be compacted to at least 90% of maximum dry density as determined by the "Modified A.A.S.H.T.O. T-180 Compaction Test" (ASTM D-1557) unless otherwise specified by the local governing authority specifications. All tests will be verified by a Soils Engineer.
- All grading on City of O'Fallon right-of-way shall be seeded and mulched and all disturbed right-of-way markers shall be reset at the completion of grading.
- No area shall be cleared without permission of the developer.
- All grades shall be within 0.2 feet more or less of those shown on the grading plan.
- No slope shall be greater than 3:1 and shall be either sodded or seeded and mulched.
- The developer shall contract with a soil consultant firm registered in the State of Missouri during the grading operation to monitor cut and fill and to verify proper compaction has been achieved. A report shall be prepared by the soils consultant and provided to the City for verification of the grading operation.
- Owner/Developer assumes full responsibility as to the performance of the grading operation and assurance that all properties and roads will be adequately protected.
- The total yardage for this project is based on a 15.0%+ shrinkage factor.
- The shrinkage factor is subject to change, due to soil conditions, (types and moisture content), weather conditions, and the percent compaction actually achieved at the time year grading is performed. As a result, adjustments in final grade may be required. If adjustments need to be made, the contractor shall contact the project engineer, prior to completion of the grading.
- If straw bales or siltation fence are destroyed by heavy rains, vandalism, etc., they are to be replaced promptly by Contractor.
- All fills under and within 15 feet of the building areas that are deeper than 8 feet shall be compacted to at least 92 percent of the maximum dry density as determined by a modified proctor test. Fills less than 8 feet in building areas should be compacted to at least 90 percent of the maximum dry density as determined by a modified proctor test.
- Where natural vegetation is removed during grading, vegetation shall be re-established in such a density as to prevent erosion. Permanent type grasses shall be established as soon as possible or during the next seeding period after grading has been completed.
- When grading operations are completed or suspended for more than 14 days, vegetation must be established at sufficient density to provide erosion control from the site. Between permanent grass seeding periods, temporary cover shall be provided according to the designated officials recommendation.
- All finished grades (areas not to be disturbed by future improvement) in excess of 20% slopes (5:1) shall be mulched and tacked at the rate of 100 pounds per 1,000 square feet when seeded.
- Trees, organic debris, rubble, foundations and other deleterious material shall be removed from the site and disposed in compliance with all applicable laws and regulations. Landfill tickets for such disposal shall be maintained on file by the developer. Burning on site shall be allowed only by permit from the local fire district.
- The developer and his contractor shall be responsible for installing the siltation control as approved by the City of O'Fallon prior to the commencement of grading operations.
- Development is located within the 100 Year Flood Plain Limits as shown on F.E.M.A. Maps No. 29183C0210E, 29183C0220E, 29183C0405E and 29183C0410E dated MARCH 17, 2003.
- Erosion control shall NOT be limited to what is shown on the plan. Whatever means necessary shall be taken to prevent siltation and erosion from entering natural streams and adjacent roadways, properties, and ditches.
- This tract is served by:  
CITY OF O'FALLON SEWER  
CITY OF O'FALLON WATER  
AMEREN UE  
CENTURY TEL  
ST. CHARLES GAS CO.  
WENTZVILLE FIRE PROTECTION DISTRICT  
FORT ZUMWALT SCHOOL DISTRICT  
O'FALLON POST OFFICE
- Each contractor, subcontractor, and/or utility company shall be responsible for the maintenance and preservation of any siltation control placed on the development by the developer and shall not disturb the siltation control except as absolutely necessary. In the event of any such disturbance of siltation control, then the contractor, subcontractor, or utility company, as applicable, disturbing such siltation control shall immediately replace the same at such contractor's, subcontractor's, and utility company's, as applicable, expense. In the event of any fines or penalties being levied as a result of the disturbance of any such siltation control, the party disturbing such siltation control shall be liable for payment of same and shall indemnify and hold Summit Points L.C., harmless from any and all liabilities, damages, demands, penalties, fines, fees, claims, causes of action, judgments, costs and expenses, including, without limitation, attorneys' fees, arising from or in connection with any such disturbance.
- It is the responsibility of the developer and the developer's grading contractor to read and be familiar with the Geotechnical Report prepared by the Soils Engineer.
- Developer must supply City inspectors with soils reports prior to or during site soil testing.
- The contractor shall assume complete responsibility for controlling all siltation and erosion of the project area. The contractor shall use whatever means necessary to control erosion and siltation including, but not limited to, staked straw bales and/or siltation fabric fences (possible methods of control are detailed in the plan). Control shall commence with grading and be maintained throughout the project until acceptance of the work by the owner and/or the City of O'Fallon and/or MoDOT. The Contractor's responsibilities depositing of silt. The Owner and/or the City of O'Fallon and/or MoDOT may at their option direct the contractor in his methods as deemed fit to protect property and improvements. Any depositing of silts or mud on new or existing pavement or in new or existing storm sewers or swales shall be removed after each rain and affected areas cleaned to the satisfaction of the Owner and/or the City of O'Fallon and/or MoDOT.
- All erosion control systems shall be inspected and necessary corrections made within 72 hours of any rainstorm resulting in one-half inch of rain or more.
- No graded area is to remain bare for over 6 months without being seeded and mulched.
- All low places whether on site or off site should be graded to allow positive drainage.
- The developer is required to keep all public roadways used to access this site, clear of dirt, rock, sediment, and/or all other debris during all grading.
- Graded areas to remain bare for over 2 weeks are to be seeded and mulched.
- \*All fill placed under proposed storm and sanitary sewer, proposed roads, and/or paved areas shall be compacted to 90% of maximum density as determined by the Modified AASHTO T-180 Compaction Test or 95% of maximum density as determined by the Standard Proctor Test AASHTO T-99. All fill placed in proposed roads shall be compacted from the bottom of the fill up. All test shall be verified by a soils engineer concurrent with grading and backfilling operations.\*  
Ensure the moisture content of the soil in fill areas is to correspond to the compactive effort as defined by the Standard or Modified Proctor Test. Optimum moisture content shall be determined using the same test that was used for compaction. Soil compaction curves shall be submitted to the City of O'Fallon prior to the placement of fill. Proof rolling may be required to verify soil stability at the discretion to the City of O'Fallon.
- A separate permit must be obtained for demolition of existing buildings and structures.

These "AS-BUILT" STORM SEWER BYPASS plans are based on actual field observations conducted during MARCH 2015, and the results are shown hereon.

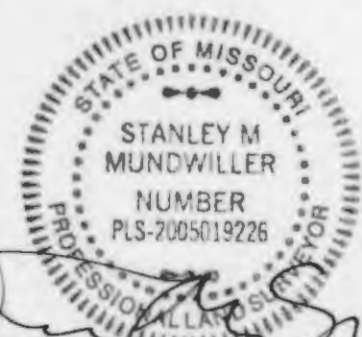

By: *[Signature]* 5/19/15  
STANLEY M. MUNDWILER, P.L.S., #2005019226  
STATE OF MISSOURI

PICKETT, RAY & SILVER'S CORPORATE  
REGISTRATION NO. LS-54-D

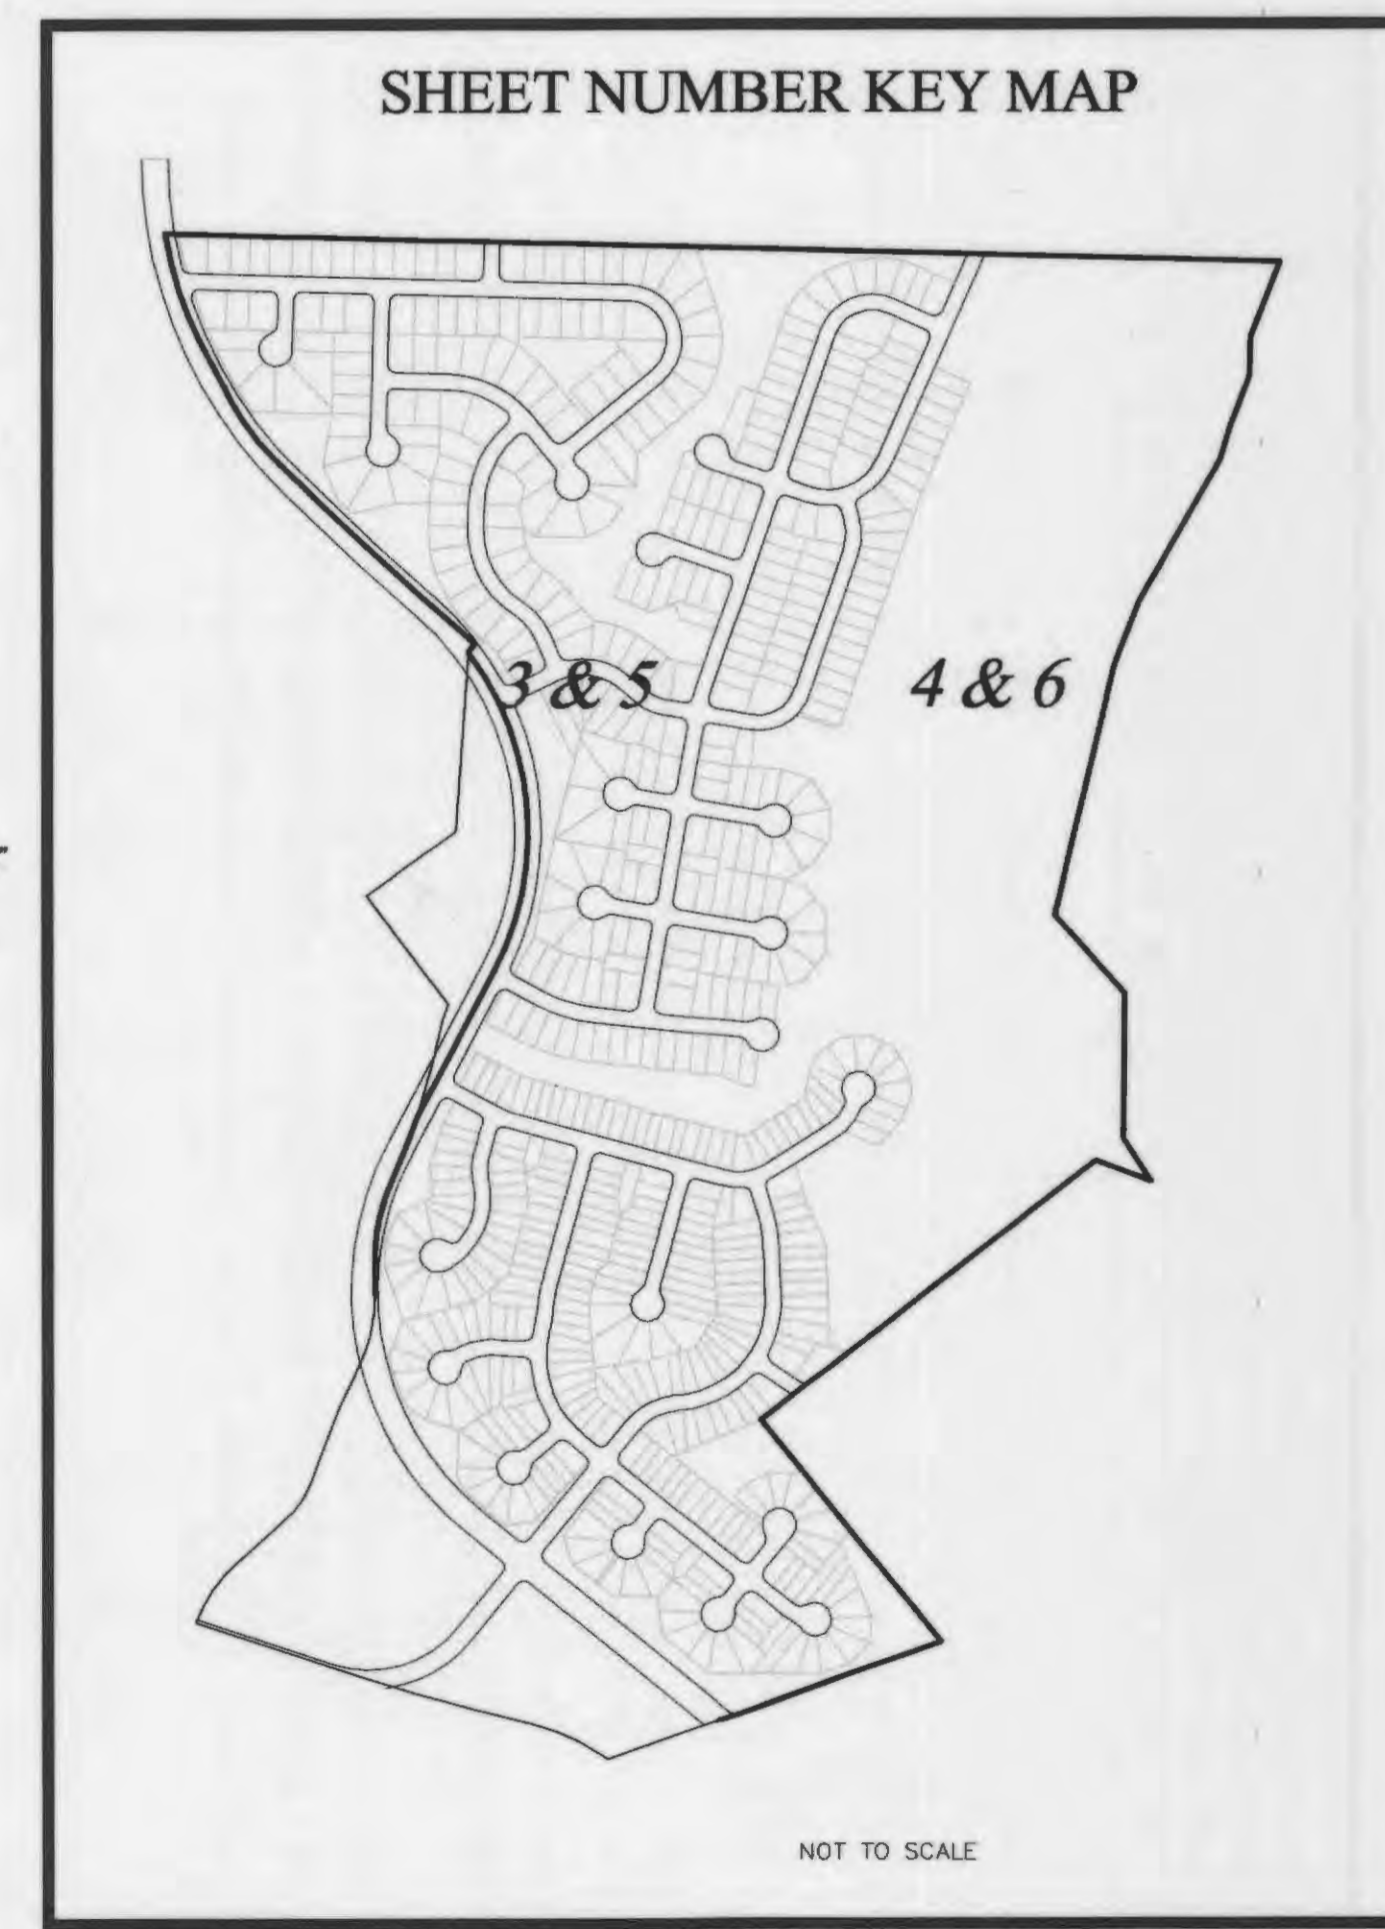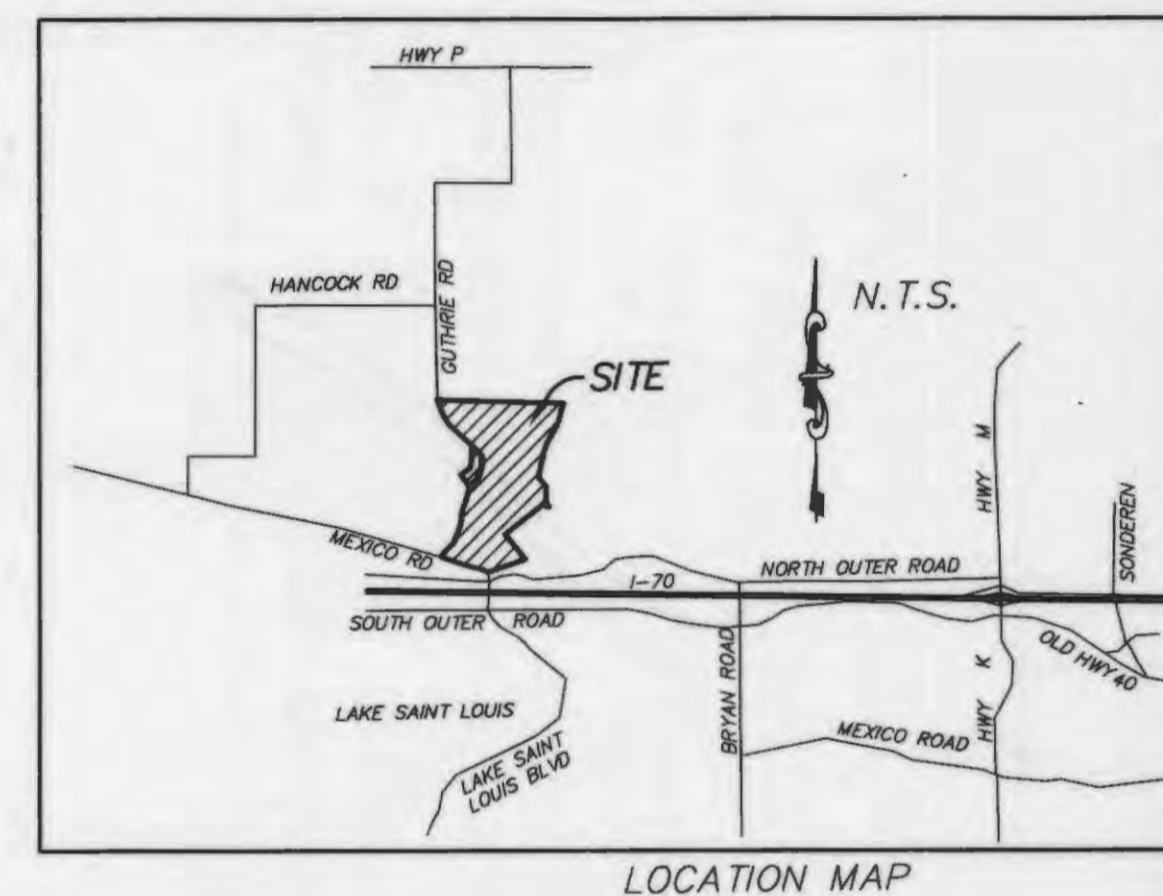

### DRAWING INDEX

Sheet	Description
1	COVER SHEET
2	SITE NOTES
3-4	SITE PLANS
5-6	GRADING PLANS
7	STORM SEWER PROFILES & DETAILS
8	DRAINAGE AREA MAP
9	DETAILS

### LEGEND

● Sanitary Sewer (Proposed)	MA 20 Sanitary Structure	R.C.P. Reinforced Concrete Pipe
○ Sanitary Sewer (Existing)	CA 30 Storm Structure	C.M.P. Corrugated Metal Pipe
--- Storm Sewer (Proposed)	⊕ Test Hole	C.I.P. Cast Iron Pipe
⊕ Storm Sewer (Existing)	⊕ Power Pole	P.V.C. Polyvinyl Chloride
8" Water Line & Size	⊕ Light Standard	V.C.P. Vitriified Clay Pipe
Ex W- Existing water line	⊕ Double Water Meter Setting	
⊕ Tee & Valve	⊕ Single Water Meter Setting	C.O. Clean Out
⊕ Hydrant	C.I. Curb Inlet	V.T. Vent Trap
⊕ Cap	S.C.I. Skewed Curb Inlet	T.B.R. To Be Removed
18 Lot or Building Number	D.C.I. Double Curb Inlet	T.B.R.&R To Be Removed & Relocated
x Existing Fence Line	G.I. Gate Inlet	T.B.P. To Be Protected
⊕ Existing Tree Line	A.I. Area Inlet	T.B.A. To Be Abandoned
⊕ Street Sign	D.A.I. Double Area Inlet	B.C. Base Of Curb
⊕ Existing Contour	C.C. Concrete Collar	T.C. Top Of Curb
⊕ Proposed Contour	F.E. Flared End Section	T.W. Top Of Wall
⊕ Rip-Rap	E.P. End Pipe	B.W. Base Of Wall
⊕ End of Lateral	E.D. Energy Dissipater	(TYP) Typical
⊕ Asphalt Pavement	M.H. Manhole	U.N.O. Unless Noted Otherwise
⊕ Concrete Pavement	C.P. Concrete Pipe	U.I.P. Use In Place
⊕ Strawbales		

#### PROJECT BENCH MARK

NGVD (same as USGS)  
RM 45: Chiseled square on the southeast wingwall of the Lake Saint Louis Boulevard bridge over the spillway of Lake Saint Louis.  
Elev. 526.16

#### SITE BENCH MARK

RM 45: Chiseled square on the southeast wingwall of the Lake Saint Louis Boulevard bridge over the spillway of Lake Saint Louis.  
Elev. 526.16

PICKETT RAY & SILVER

22 Richmond Center Ct.  
St. Peters, MO 65376  
Phone (636) 397-1211  
Fax (636) 397-1704

CIVIL ENGINEERS  
PLANNERS  
LAND SURVEYORS

BROOKSIDE  
STORM SEWER BYPASS  
COVER SHEET

11901 OLIVE BLVD.  
ST. LOUIS, MO. 63141  
(314) 692-6398

Prepared For:  
FIRST BANK, INC.


REVISONS	NO.	DATE	DESCRIPTION
	1	8/08/05	PER CITY OF O'FALLON COMMENTS
	2	8/15/05	PER CITY OF O'FALLON COMMENTS

**ENGINEERS AUTHENTICATION**  
The responsibility for professional engineering liability on this project is hereby limited to the set of plans authenticated by the seal, signature, and date hereunder attached. Responsibility is disclaimed for all other engineering plans involved in this project and specifically excludes revisions after this date unless reauthenticated.  
PICKETT, RAY & SILVER, INC

DRAWN	DATE
MAK/SMM	03/13/15
CHECKED	DATE
	03/15/05
PROJECT #	FIELD BOOK
TASK # 1	847M


STORM SEWER BYPASS &  
SPRING INTERCEPT PLANS  
COVER SHEET  
SHEET 1 OF 9  
© Copyright 2015 by Pickett, Ray & Silver Inc.

# AS BUILTS

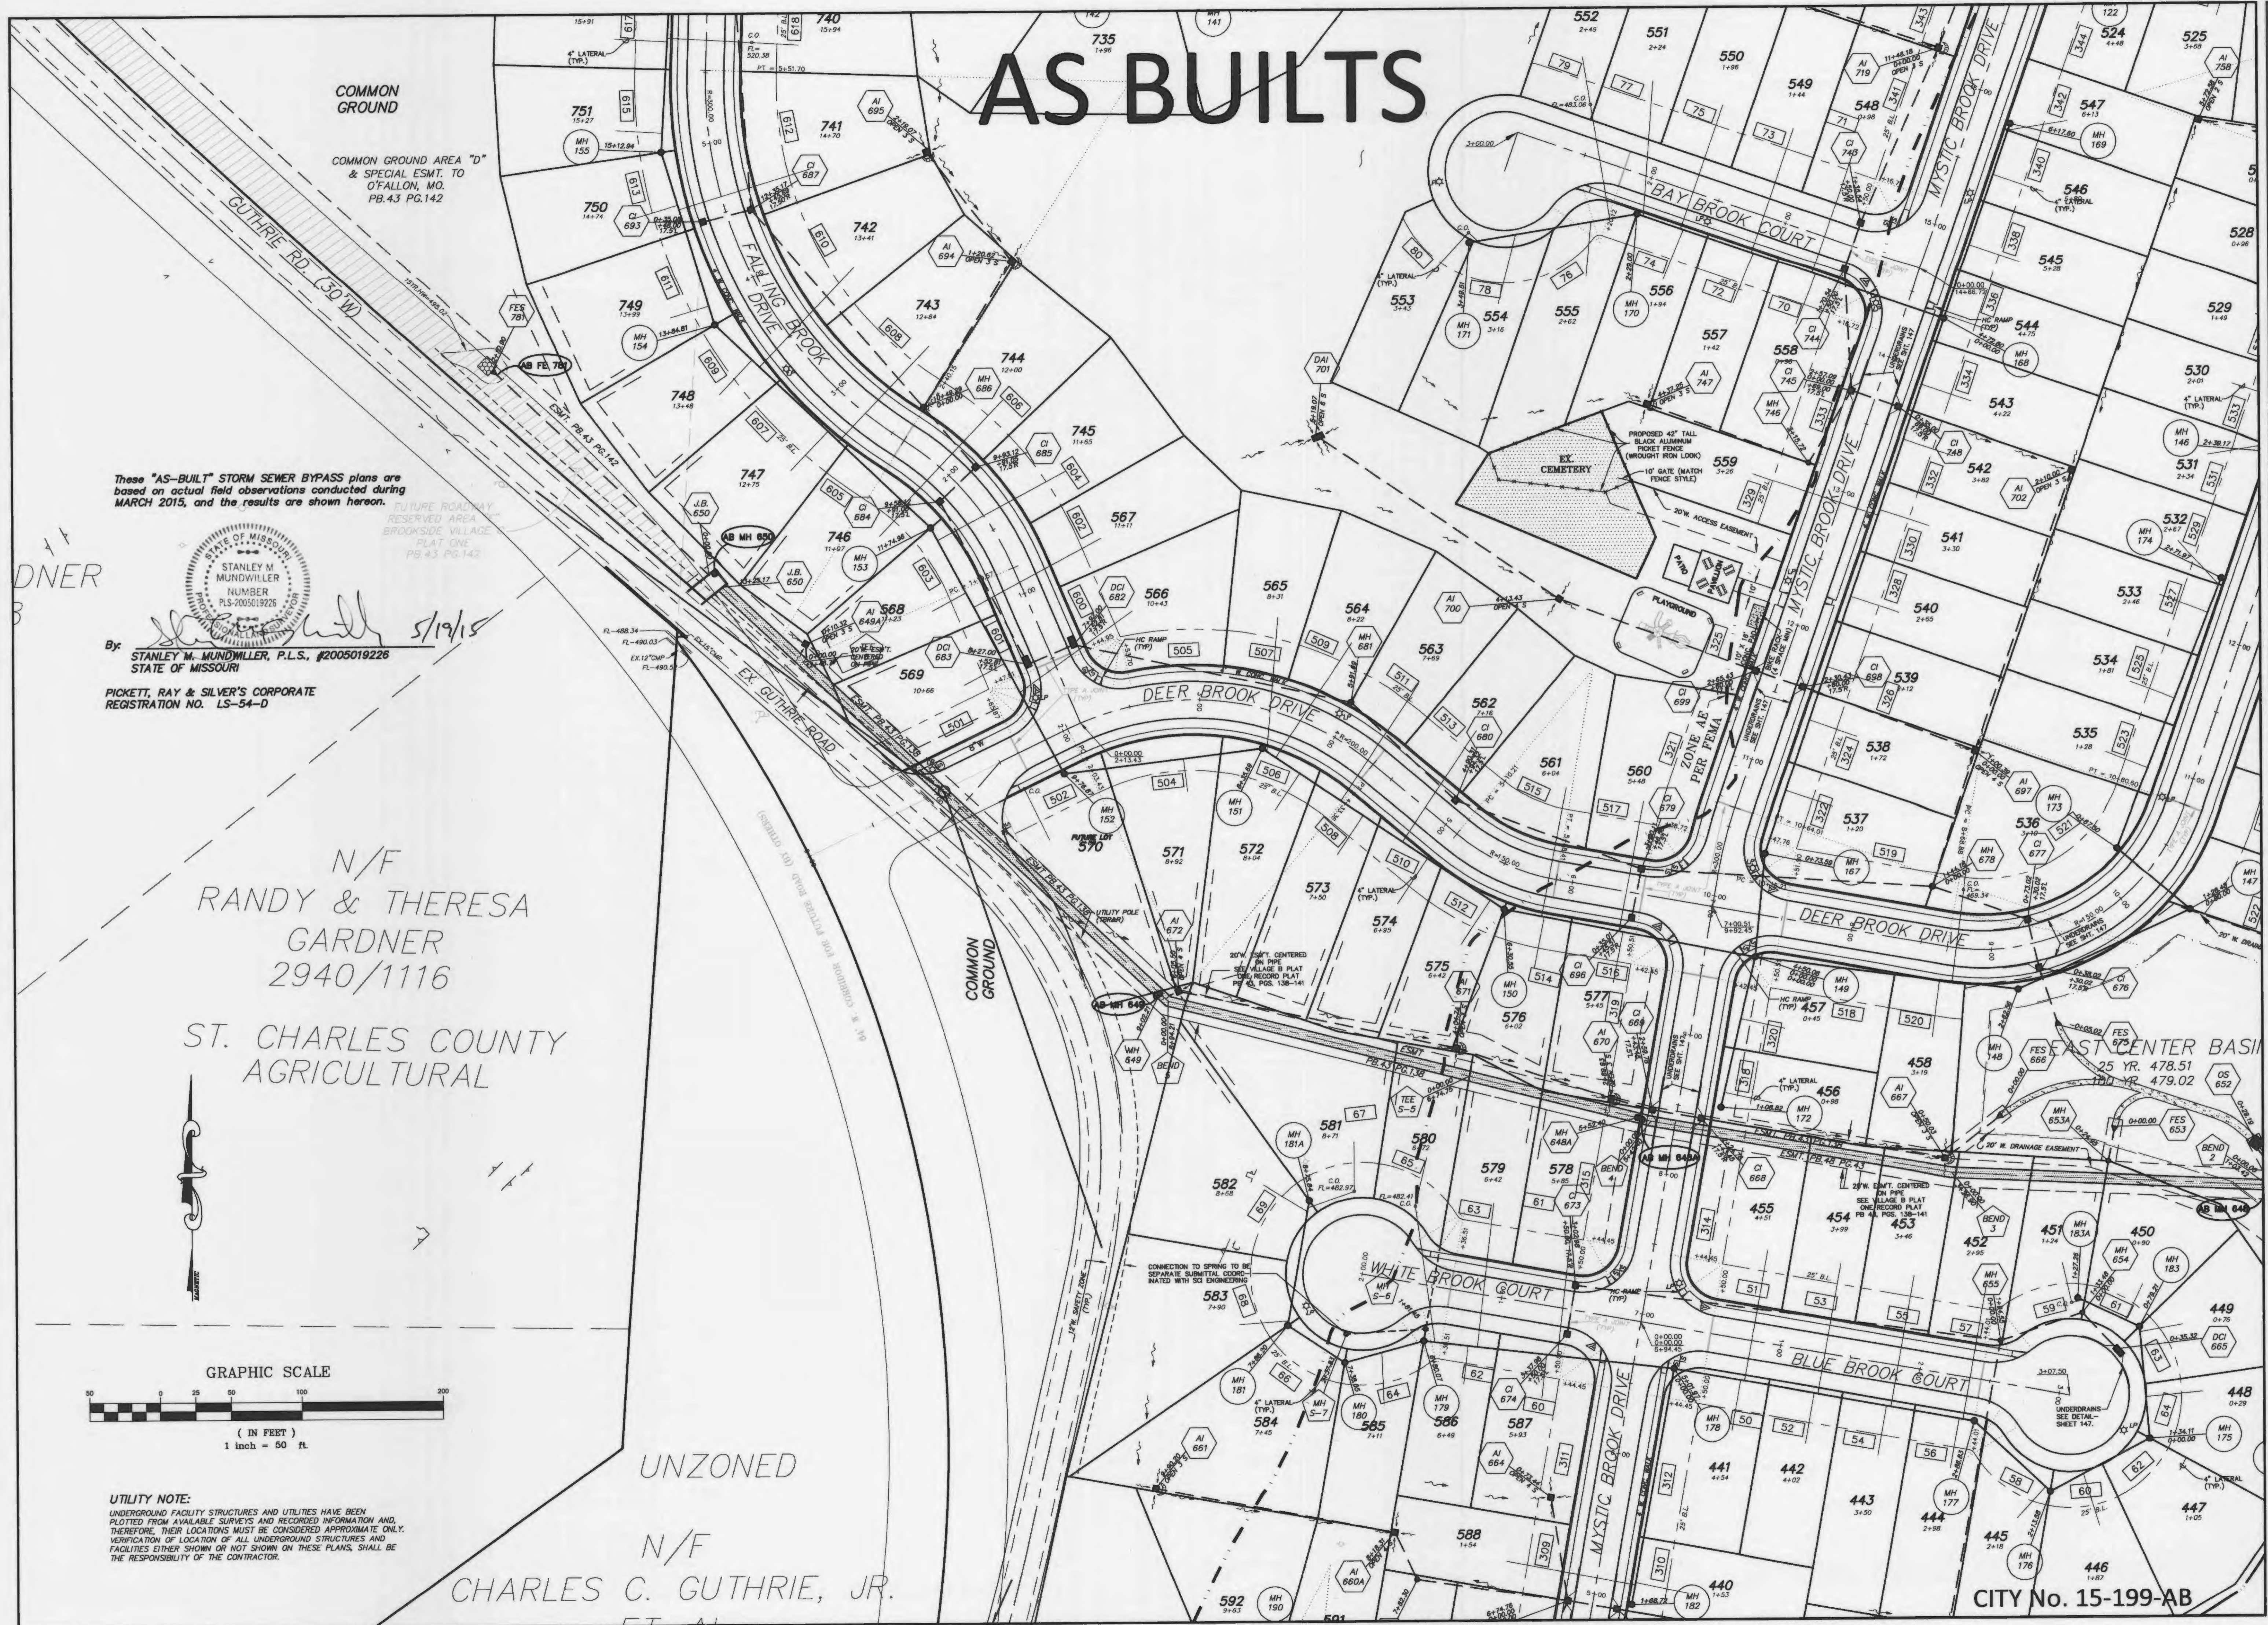

COMMON GROUND  
COMMON GROUND AREA "D"  
& SPECIAL ESMT. TO  
O'FALLON, MO.  
PB.43 PG.142

These "AS-BUILT" STORM SEWER BYPASS plans are based on actual field observations conducted during MARCH 2015, and the results are shown hereon.

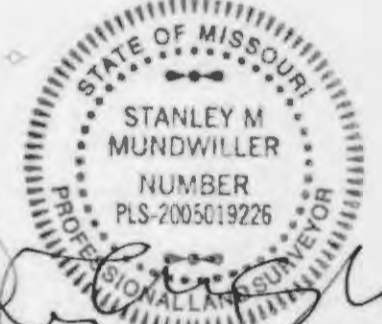


By: *Stanley M. Mundwiler* 5/19/15  
STANLEY M. MUNDWILER, P.L.S., #2005019226  
STATE OF MISSOURI

PICKETT, RAY & SILVER'S CORPORATE  
REGISTRATION NO. LS-54-D

N/F  
RANDY & THERESA  
GARDNER  
2940/1116

ST. CHARLES COUNTY  
AGRICULTURAL

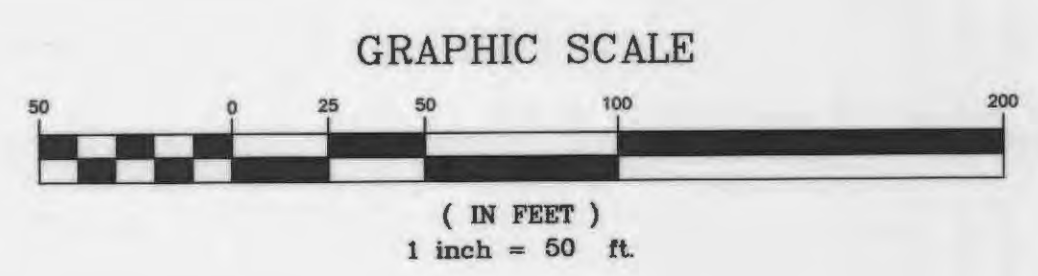

UTILITY NOTE:  
UNDERGROUND FACILITY STRUCTURES AND UTILITIES HAVE BEEN PLOTTED FROM AVAILABLE SURVEYS AND RECORDED INFORMATION AND, THEREFORE, THEIR LOCATIONS MUST BE CONSIDERED APPROXIMATE ONLY. VERIFICATION OF LOCATION OF ALL UNDERGROUND STRUCTURES AND FACILITIES EITHER SHOWN OR NOT SHOWN ON THESE PLANS, SHALL BE THE RESPONSIBILITY OF THE CONTRACTOR.

UNZONED  
N/F  
CHARLES C. GUTHRIE, JR.


**PICKETT RAY & SILVER**  
CIVIL ENGINEERS  
PLANNERS  
LAND SURVEYORS  
22 Richmond Center Ct.  
St. Peters, MO 65376  
Phone (636) 397-1211  
Fax (636) 397-1104

**BROOKSIDE**  
STORM SEWER BYPASS PLAN  
SITE PLAN  
Prepared For:  
**FIRST BANK, INC.**

REVISIONS	NO.	DATE	PER CITY OF O'FALLON COMMENTS
	1	8/09/05	PER CITY OF O'FALLON COMMENTS
	2	8/15/05	PER CITY OF O'FALLON COMMENTS

ENGINEERS AUTHENTICATION  
The responsibility for professional engineering liability on this project is hereby limited to the set of plans authenticated by the seal, signature, and date hereunder attached. Responsibility is disclaimed for all other engineering plans involved in this project and specifically excludes revisions after this date unless reauthenticated.  
PICKETT, RAY & SILVER, INC

DRAWN	MAK/SMM	DATE	03/13/15
CHECKED		DATE	03/17/15
PROJECT #	03029.FBCC.03S	TASK #	1
FIELD BOOK	847M	BOOK	847M
STORM SEWER BYPASS PLAN	SITE PLAN		
SHEET	3	OF	9
CITY No. 15-199-AB			
© Copyright 2015 by Pickett, Ray & Silver Inc.			

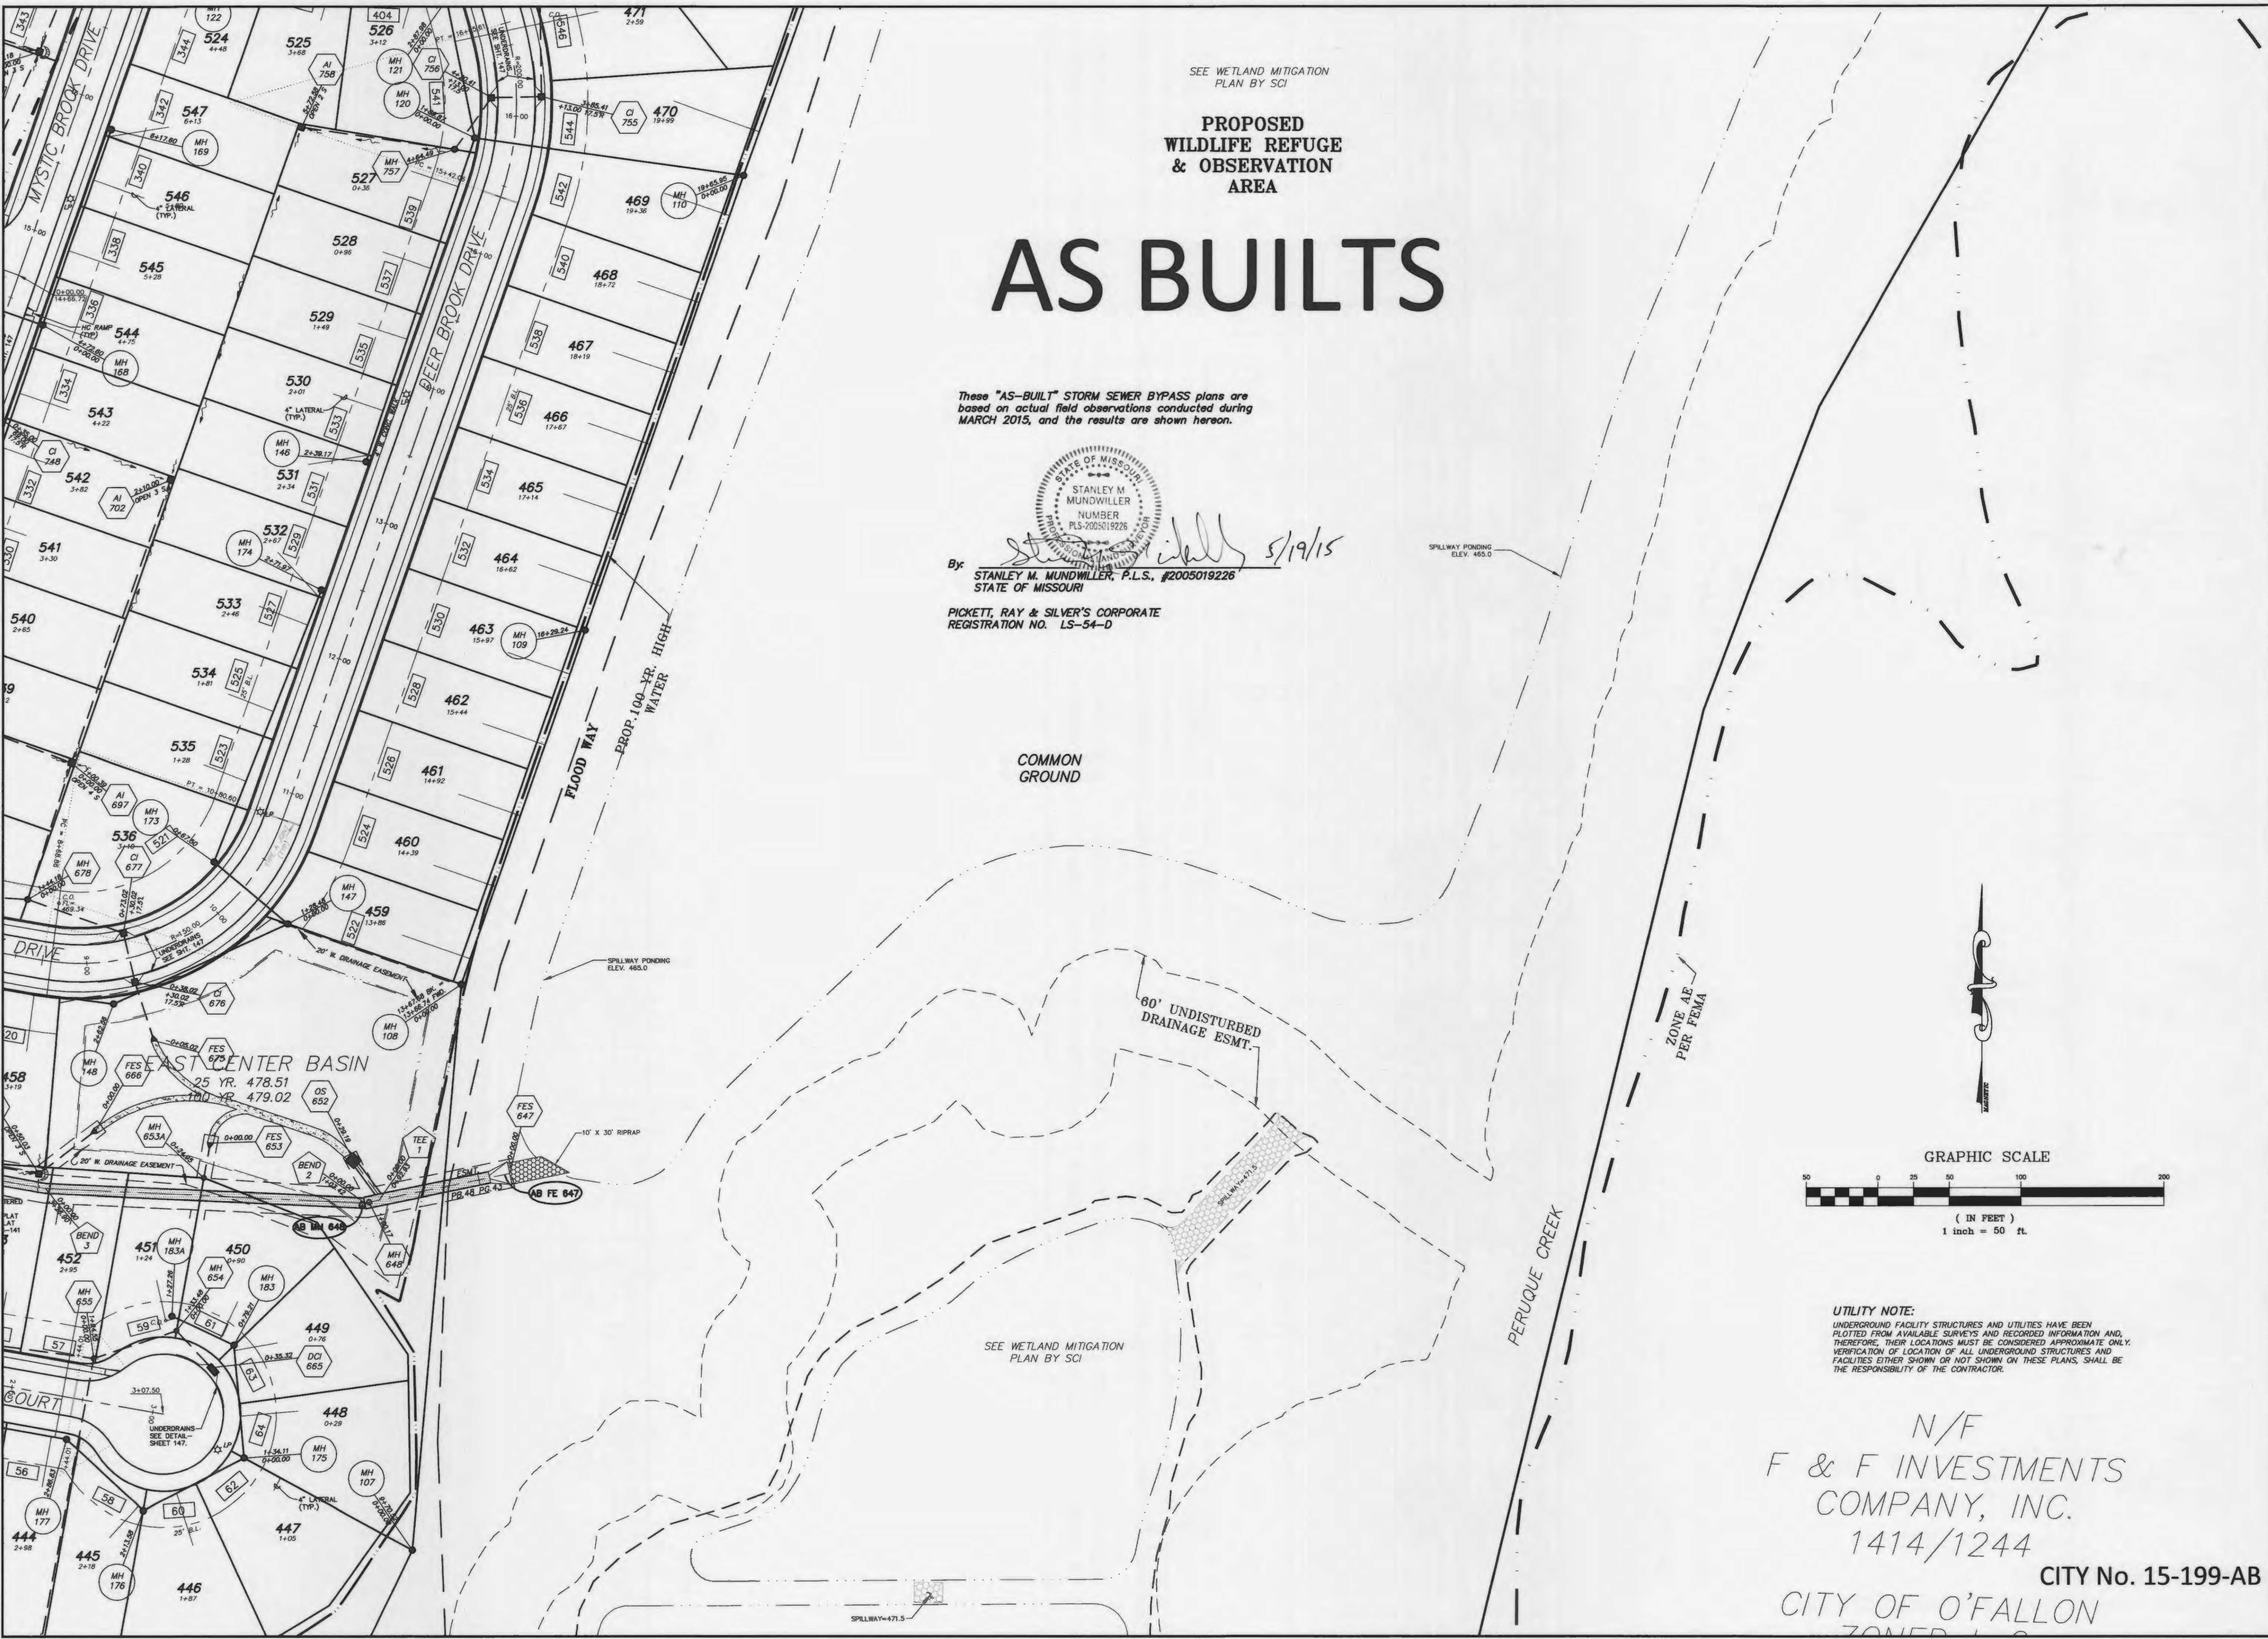


SEE WETLAND MITIGATION PLAN BY SCI

**PROPOSED WILDLIFE REFUGE & OBSERVATION AREA**

# AS BUILTS


These "AS-BUILT" STORM SEWER BYPASS plans are based on actual field observations conducted during MARCH 2015, and the results are shown hereon.

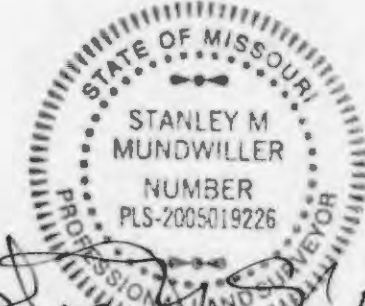

By: *Stanley M. Mundwiler* 5/19/15  
 STANLEY M. MUNDWILER, P.L.S., #2005019226  
 STATE OF MISSOURI

PICKETT, RAY & SILVER'S CORPORATE REGISTRATION NO. LS-54-D

COMMON GROUND

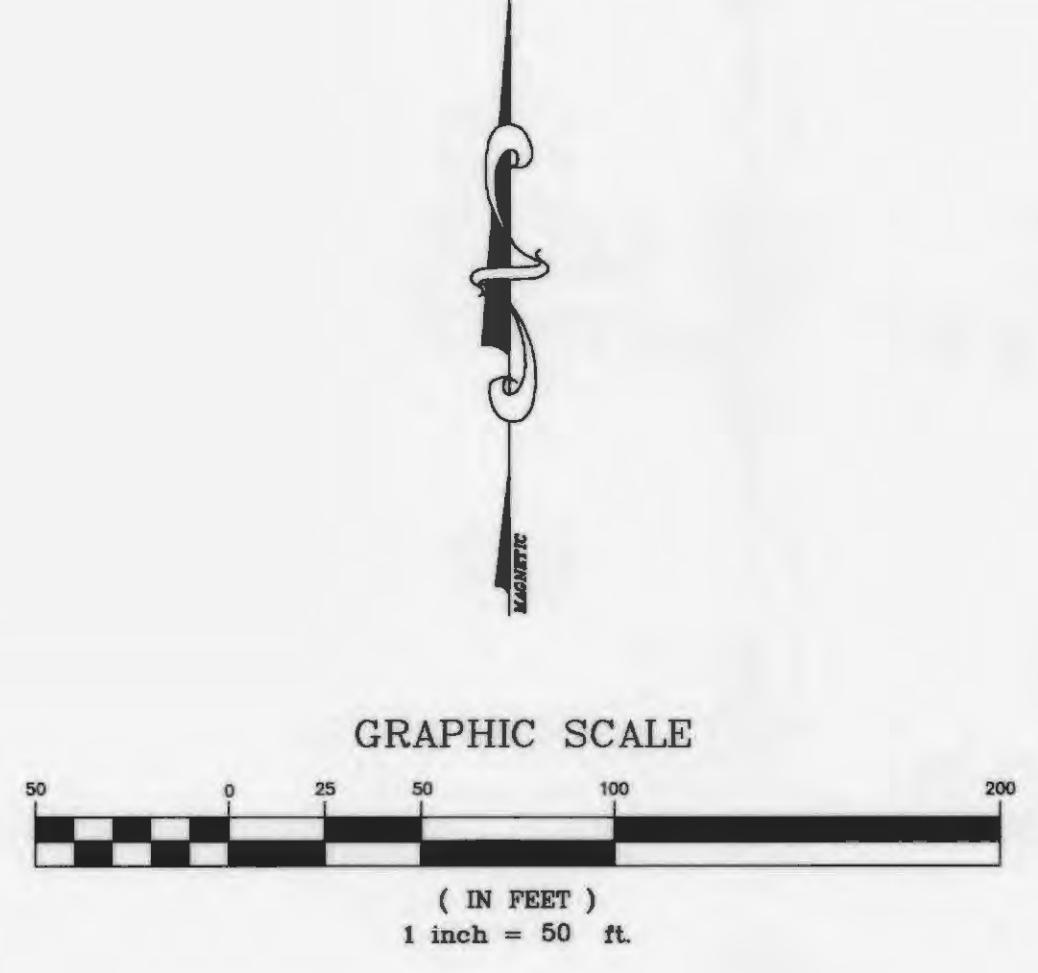

**UTILITY NOTE:**  
 UNDERGROUND FACILITY STRUCTURES AND UTILITIES HAVE BEEN PLOTTED FROM AVAILABLE SURVEYS AND RECORDED INFORMATION AND, THEREFORE, THEIR LOCATIONS MUST BE CONSIDERED APPROXIMATE ONLY. VERIFICATION OF LOCATION OF ALL UNDERGROUND STRUCTURES AND FACILITIES EITHER SHOWN OR NOT SHOWN ON THESE PLANS, SHALL BE THE RESPONSIBILITY OF THE CONTRACTOR.

N/F  
 F & F INVESTMENTS COMPANY, INC.  
 1414/1244  
 CITY No. 15-199-AB  
 CITY OF O'FALLON

**PICKETT RAY & SILVER**  
 CIVIL ENGINEERS  
 PLANNERS  
 LAND SURVEYORS

22 Richmond Center Ct.  
 St. Peters, MO 63376  
 Phone (636) 397-1211  
 Fax (636) 397-1104

**BROOKSIDE**  
 STORM SEWER BYPASS PLAN  
 SITE PLAN

Prepared For:  
**FIRST BANK, INC.**




11901 OLIVE BLVD.  
 ST. LOUIS, MO 63141  
 (314) 992-6328

REVISIONS	DATE	PER CITY OF O'FALLON COMMENTS
NO.	DATE	PER CITY OF O'FALLON COMMENTS
1	8/08/05	PER CITY OF O'FALLON COMMENTS
2	8/15/05	PER CITY OF O'FALLON COMMENTS

**ENGINEERS AUTHENTICATION**  
 The responsibility for professional engineering liability on this project is hereby limited to the set of plans authenticated by the seal, signature, and date hereunder attached. Responsibility is disclaimed for all other engineering plans involved in this project and specifically excludes revisions after this date unless reauthenticated.  
**PICKETT, RAY & SILVER, INC.**

DRAWN	MAK/SMM	DATE	03/13/15
CHECKED		DATE	03/1/15
PROJECT #	03029.FBCC.03S	FIELD BOOK	847M
TASK #	1	FIELD BOOK	847M
STORM SEWER BYPASS PLAN	SITE PLAN		
SHEET	4	OF	9
© Copyright 2015 by Pickett, Ray & Silver Inc.			

HORIZONTAL SCALE: 1"=50' VERTICAL SCALE: 1"=10'


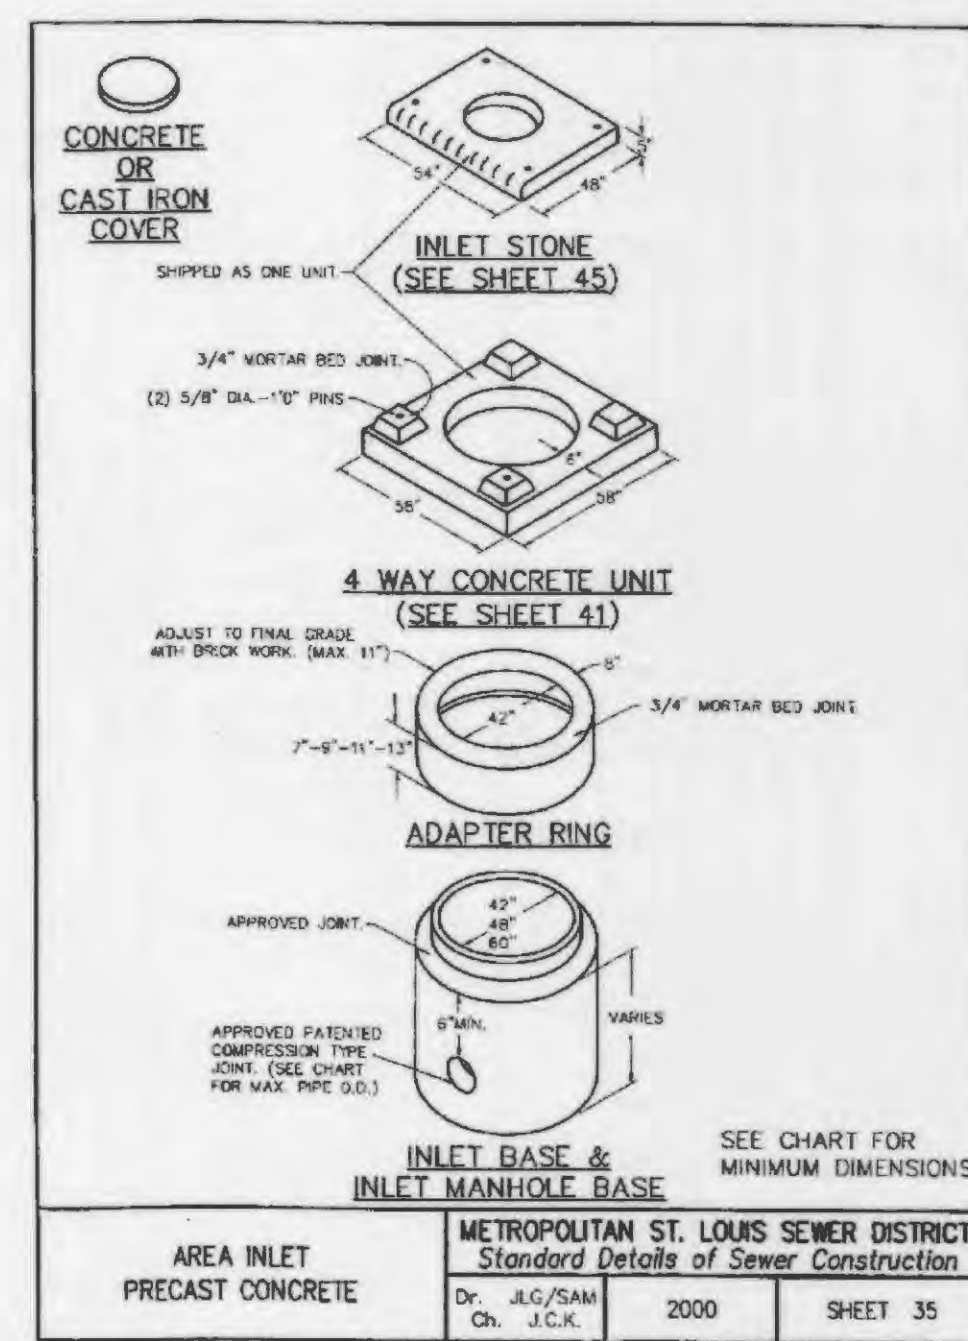
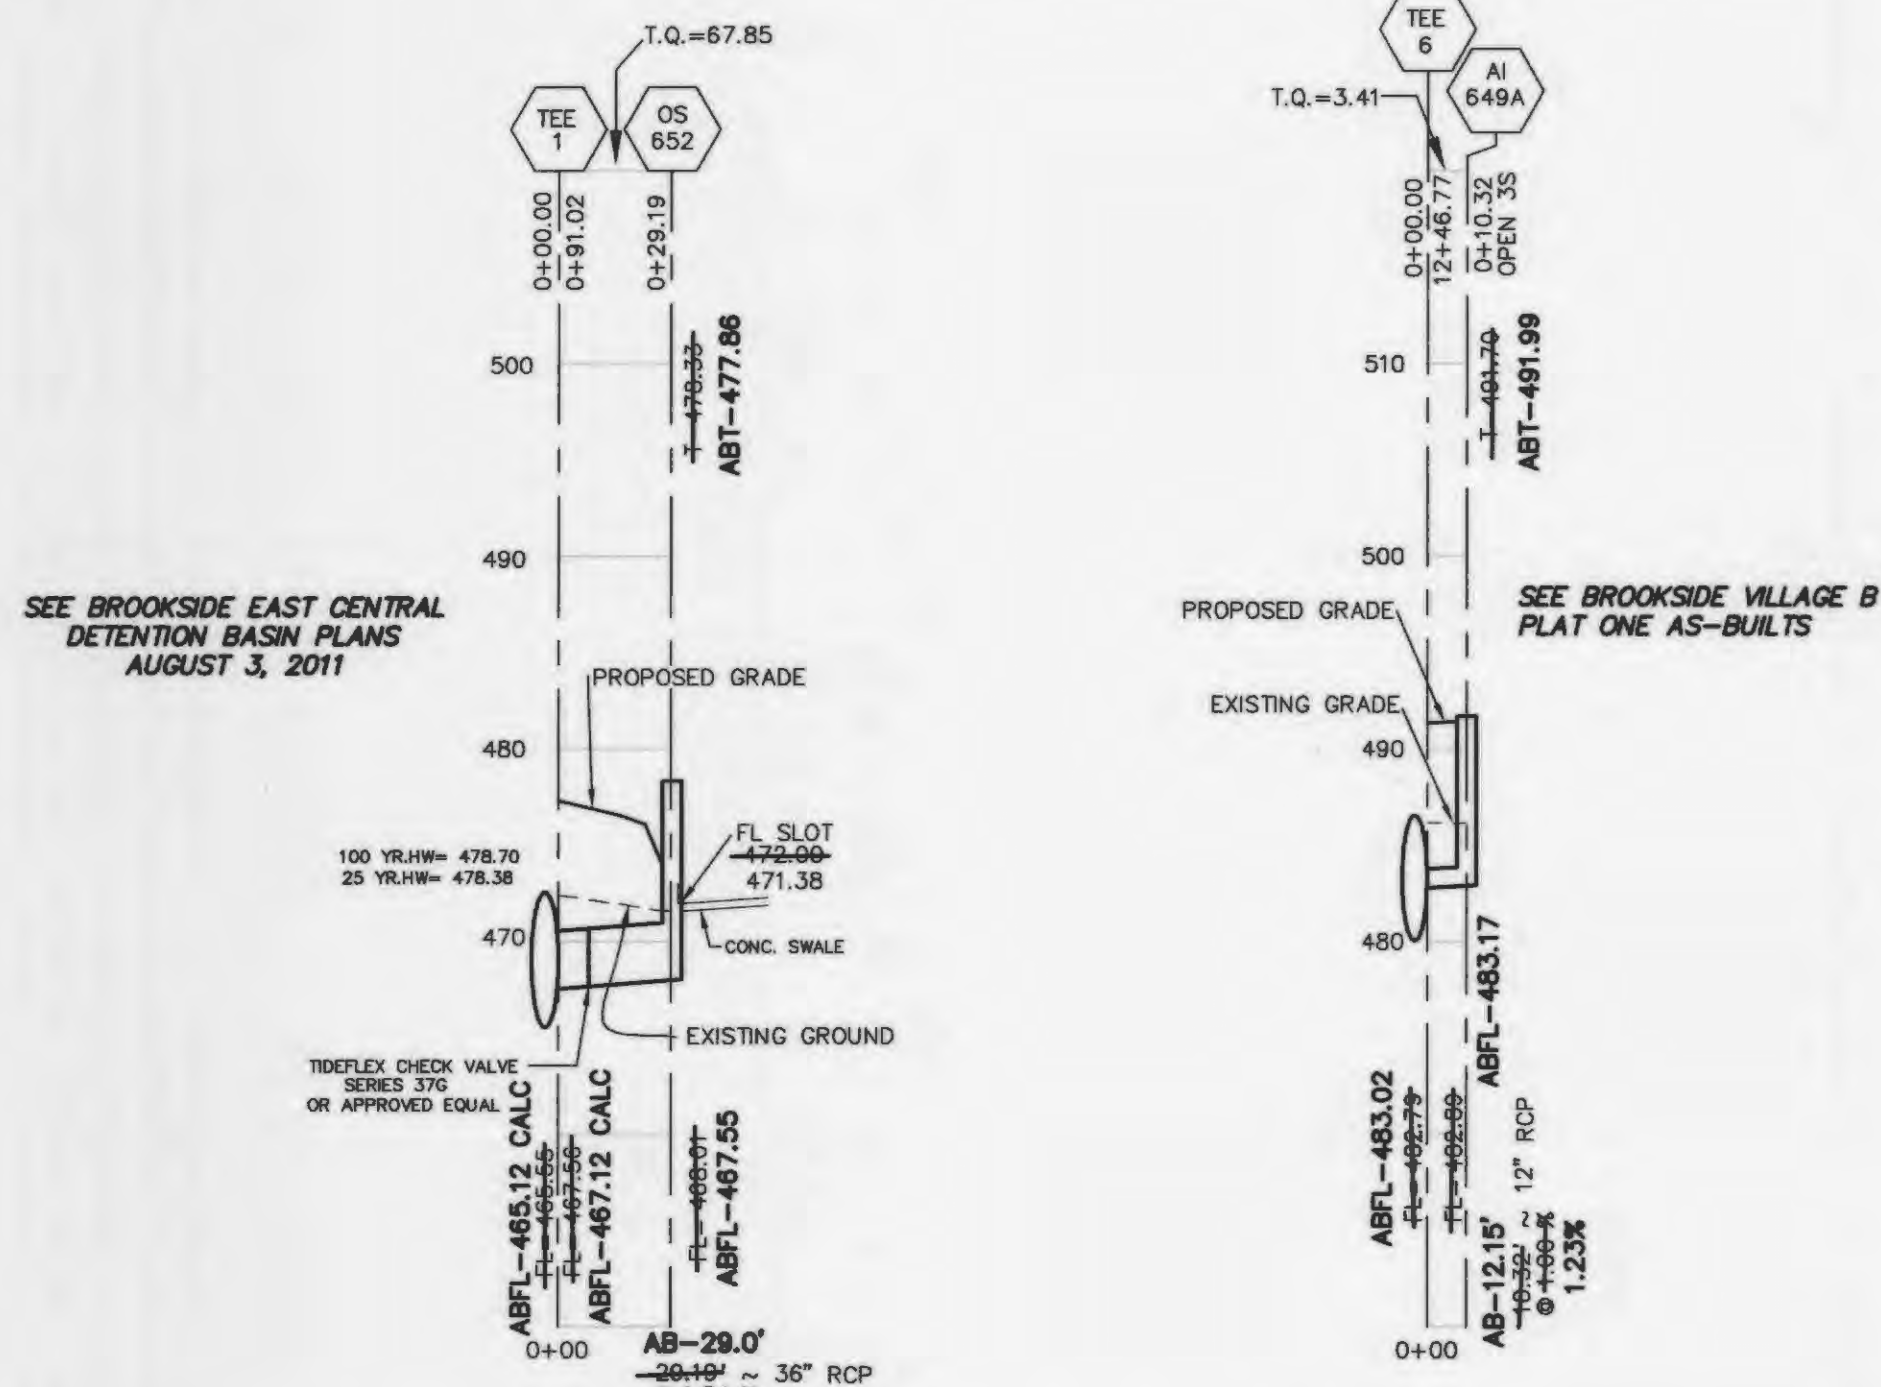
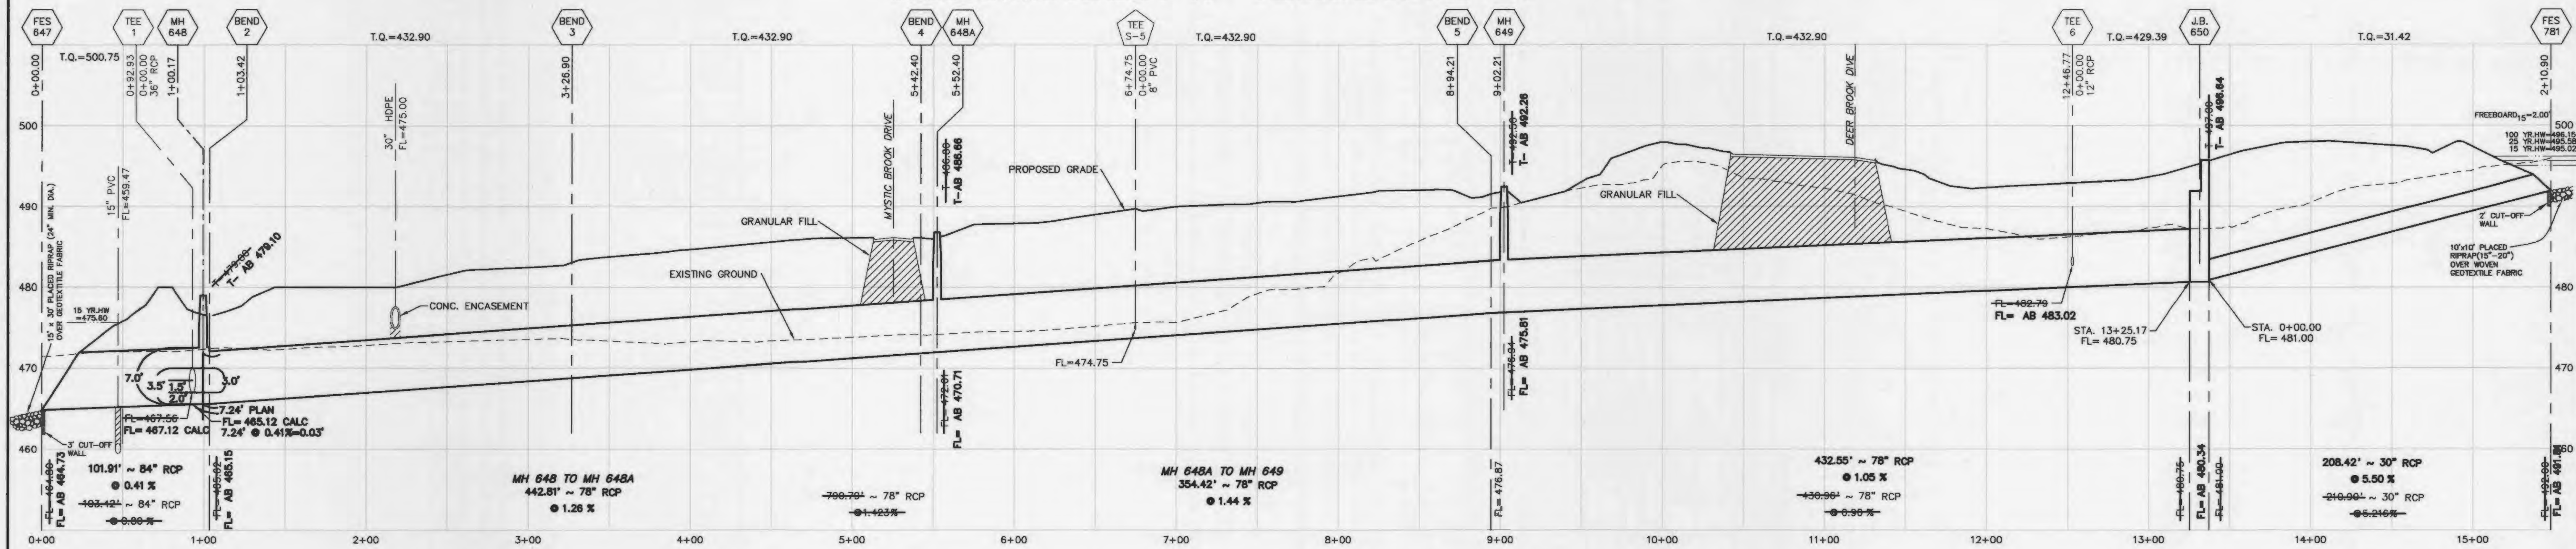


# AS-BUILTS

These "AS-BUILT" STORM SEWER BYPASS plans are based on actual field observations conducted during MARCH 2015, and the results are shown hereon.

By: *Stanley M. Mundwiler* 5/19/15  
**STANLEY M. MUNDWILLER, P.L.S., #2005019226**  
 STATE OF MISSOURI  
 REGISTRATION NO. LS-54-D

ALL SANITARY LATERAL STREET CROSSINGS, IF TRENCHED, SHALL BE BACKFILLED WITH GRANULAR MATERIAL (AGGREGATE).  
 IF THE STORM AND SANITARY SEWERS ARE PARALLEL AND IN THE SAME TRENCH OR OVERING, THE UPPER SHALL BE PLACED ON A SHELF AND THE LOWER SHALL BE BEDDED IN COMPACTED GRANULAR FILL TO THE FLOW LINE OF THE UPPER.  
 STORM SEWERS WHICH CROSS OVER EXISTING OR PROPOSED SANITARY SEWER TRENCHES SHALL BE GRADLED IN CONCRETE (OR ENCASED H.D.P.E.) THROUGH THE FULL WIDTH OF THE SANITARY SEWER TRENCH. THE TRENCH SHALL BE BACKFILLED AND COMPACTED GRANULAR FILL TO THE BOTTOM OF THE CONCRETE GRADE.

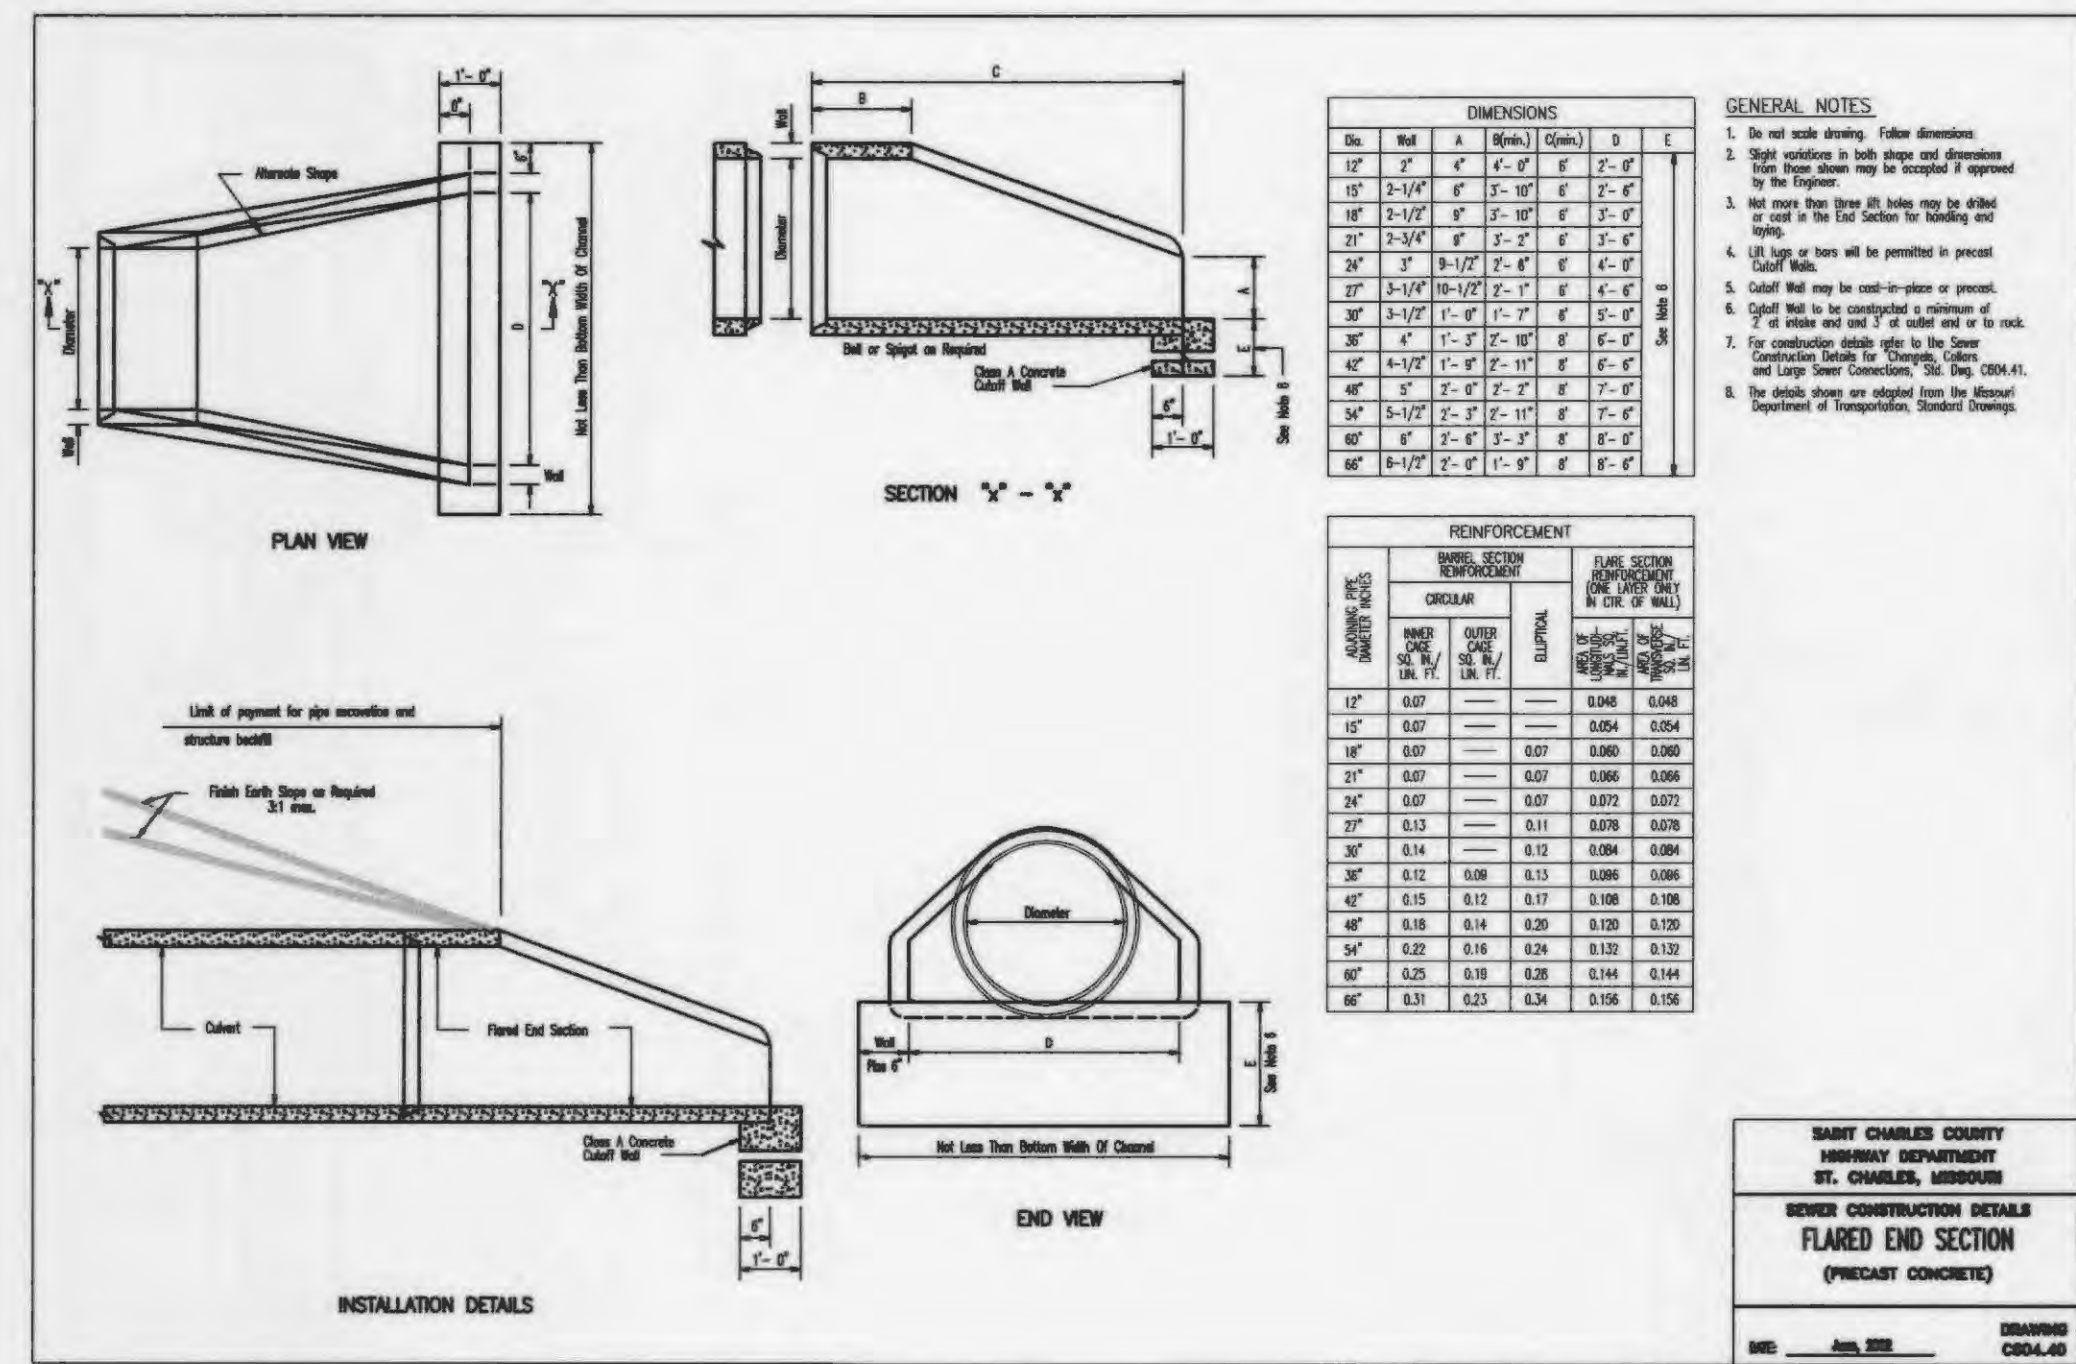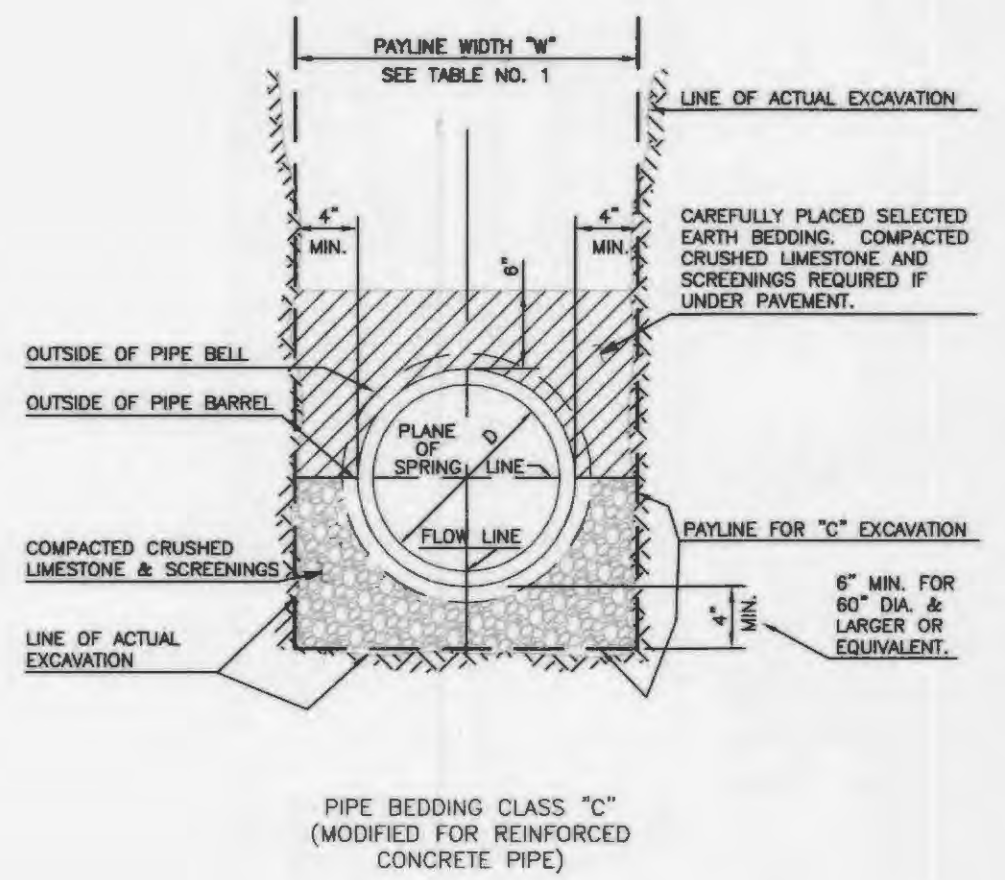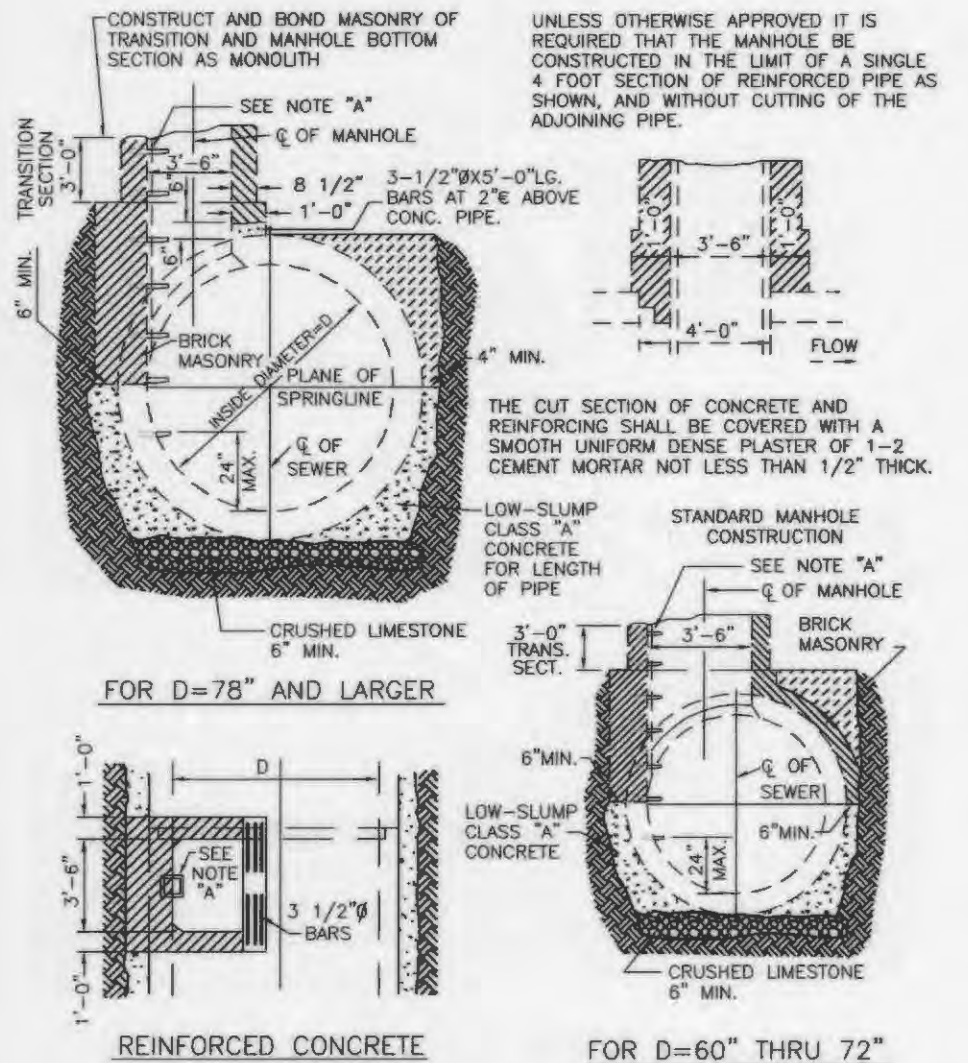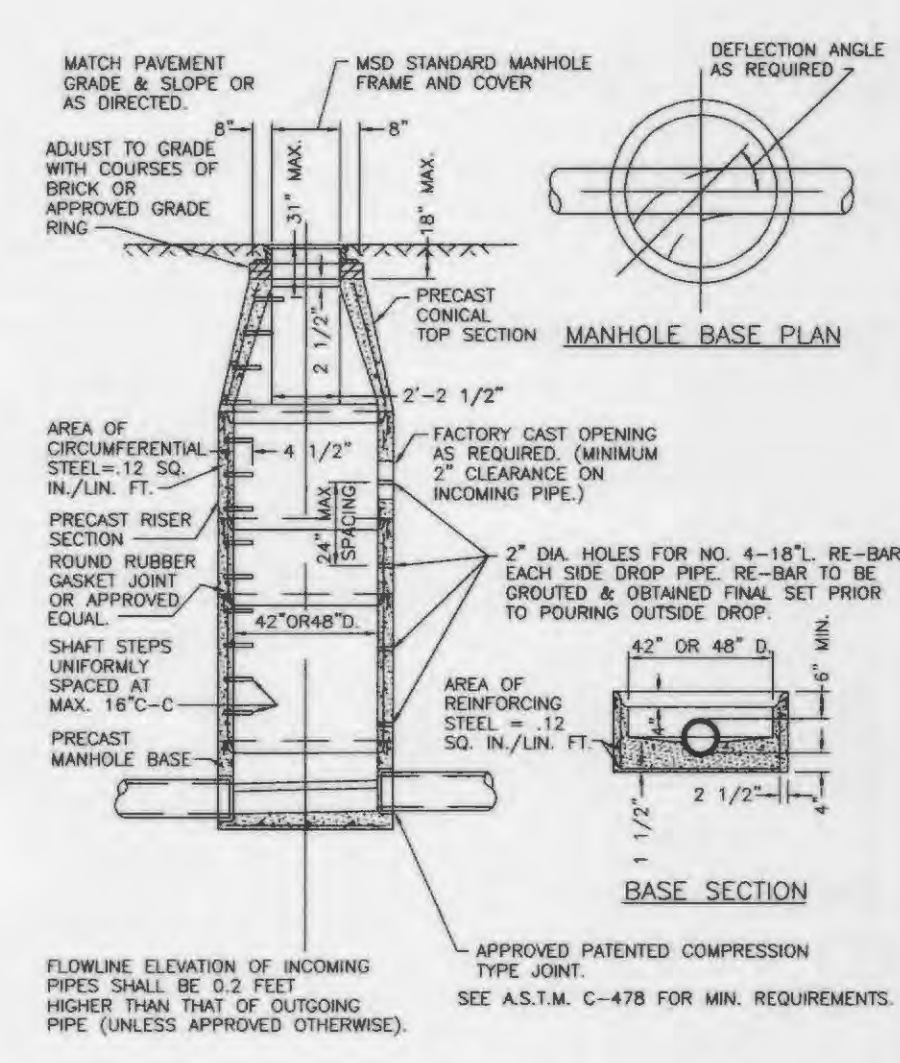

**PICKETT RAY & SILVER**  
 CIVIL ENGINEERS  
 PLANNERS  
 LAND SURVEYORS  
 22 Richmond Center Ct.  
 St. Peters, MO 63376  
 Phone (636) 387-1211  
 Fax (636) 387-1104

**BROOKSIDE**  
 STORM SEWER BYPASS  
 PROFILES & DETAILS  
 Prepared For:  
**FIRST BANK, INC.**  
 1190 OLIVE BLVD.  
 ST. LOUIS, MO 63101  
 (314) 692-6398

REVISIONS	DATE	PER CITY OF ST. LOUIS COMMENTS
1	8/08/05	
2	8/15/05	

**ENGINEERS AUTHENTICATION**  
 The responsibility for professional engineering liability on this project is hereby limited to the set of plans authenticated by the seal, signature, and date hereunder attached. Responsibility is disclaimed for all other engineering plans involved in this project and specifically excludes revisions after this date unless reauthenticated.  
**PICKETT, RAY & SILVER, INC.**

DRAWN: MAK/SMM DATE: 03/13/15  
 CHECKED: DATE: 03/15/15  
 PROJECT # 03029.FBCC.03S  
 TASK # 1 FIELD BOOK 847M

STORM SEWER BYPASS  
 PROFILES & DETAILS  
 SHEET 7 OF 9  
 © Copyright 2015 by Pickett, Ray & Silver Inc.

CITY No. 15-199-AB