

BRYAN VALLEY

PLAT THREE
A TRACT OF LAND BEING PART OF
U.S. SURVEY 1780, T.47 N., R.2 & 3 E.,
ST. CHARLES COUNTY, MISSOURI

CITY OF O'FALLON GENERAL NOTES

1. Gas, water and other underground utilities shall not conflict with the depth or horizontal locations of existing and proposed sanitary and storm sewers, including house laterals.
2. Underground utilities have been plotted from available information and, therefore, their locations must be considered approximate only. The verification of the location of all underground utilities, either shown or not shown on these plans, shall be the responsibility of the contractor and shall be located prior to grading or construction of improvements.
3. Polyvinyl Chloride (PVC) shall conform to the requirements of ASTM D-3034 Standard Specifications for the PSM Polyvinyl Chloride (PVC) Sewer Pipe and Fittings, SDR-35.
4. Storm sewers 18" in diameter or smaller shall be ASTM C-14.
5. Storm sewers 21" in diameter or larger shall be ASTM C-76, Class II.
6. All storm sewer pipe under pavement, regardless of size, shall be reinforced concrete pipe (ASTM C-76, Class II) unless noted otherwise in the plans.
7. Corrugated metal pipe shall conform to the standard specifications for corrugated culvert pipe M-36, A.A.S.H.O.
8. All filled places under buildings, proposed sanitary and storm sewer lines, and/or paved areas including trench backfills shall be compacted to 90% of maximum density as determined by the "Modified A.A.S.H.O. T-180 Compaction Test" (ASTM D-1557) unless otherwise specified by the local governing authority specifications. All tests will be verified by a soils engineer.
9. All earthen filled places within State, County, or City roads (highways) shall be compacted to 95% of maximum density as determined by the "Standard Proctor Test A.A.S.H.O. T-99" (ASTM D-698) unless otherwise specified by local governing authority specifications. All tests will be verified by a soils engineer.
10. All storm and sanitary trench backfills shall be water jetted. Granular fill will be used under paved areas.
11. Easements shall be provided for storm sewers, sanitary sewers, and all utilities on the record plot. See record plot for location and size of easements. This does not apply to house laterals.
12. No area shall be cleared without the permission of the developer.
13. All grades shall be within 0.2 feet (more or less) of those shown on the grading plan.
14. No slope shall be greater than 3:1 and shall be either sodded or seeded and mulched.
15. Hazard markers will consist of three (3) standard specification "Manual on Uniform Traffic Control Devices," etc. of roadway markers mounted on two (2) pound "D" chain link posts. Each marker shall consist of an eighteen (18) inch diamond reflectorized red panel. The bottom of each panel shall be mounted a minimum of four (4) feet above the elevation of the pavement surface.
16. All manhole and curb inlet tops built without elevations furnished by the Engineer will be the responsibility of the sewer contractor. At the time of construction stake-out of the sewer lines, all curb and grate inlets will be face staked. If normal face stakes fall in line with sewer construction, the Engineer will set these stakes on a double offset. It shall be the responsibility of the sewer contractor to preserve all face stakes from destruction.
17. All standard street curb inlets to have front of inlet 2 feet behind curb.
18. The minimum vertical distance from the low point of the basement to the flowline of a sanitary sewer at the corresponding house connection shall not be less than the diameter of the sanitary sewer plus a vertical distance not less than two and one-half feet (2-1/2).
19. Water lines, valves, sleeves, meters and etc., shall meet all specifications and installation requirements of the local governing authority.

This is to certify to The City of O'Fallon
that these "As-Built" San & Storm plans are
based on actual field surveys conducted
during July 1996 and the results are
shown here on.


by Pickett Ray & Silver

Delmar F. Vincent
MO R.L.S. No. 1889

7/31/96
Date

IMPROVEMENT PLANS 168 LOTS

LOCATION MAP

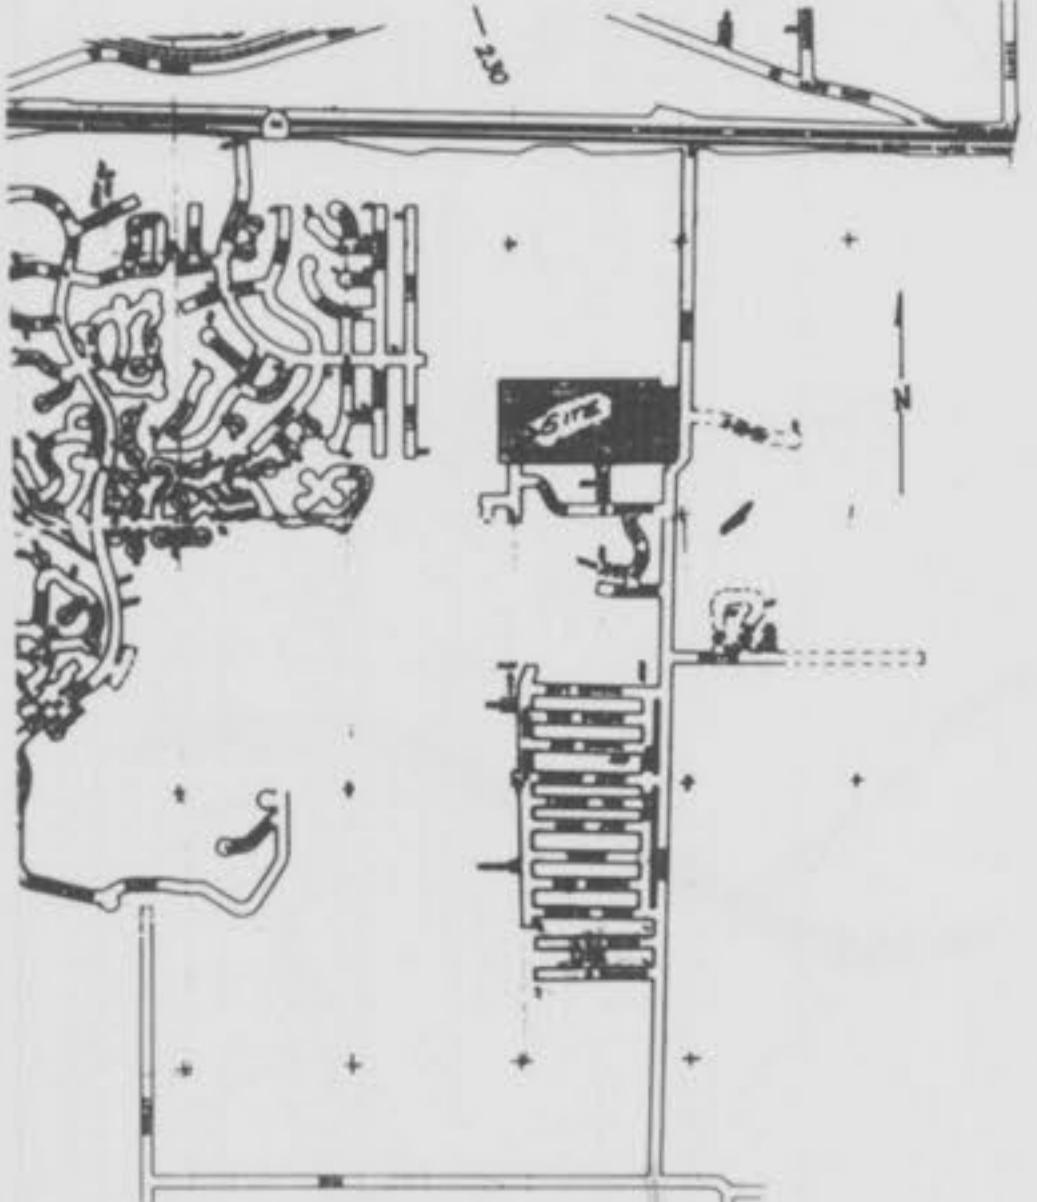

DRAWING INDEX

Sheet	Description
1	COVER SHEET
2	FLAT PLANS
4-5	GRADING PLANS
6-8	STREET PROFILES
9-11	3-4 SANITARY SEWER PROFILES
12-15	5-6 STORM SEWER PROFILES
16	WATER PLAN
17-18	DRAINAGE AREA MAPS
19-23	CONSTRUCTION DETAILS

LEGEND

●	Sanitary Sewer (Proposed)	R.C.P.	Reinforced Concrete Pipe
○	Sanitary Sewer (Existing)	C.M.P.	Corrugated Metal Pipe
- - -	Storm Sewer (Proposed)	C.I.P.	Cast Iron Pipe
- - -	Storm Sewer (Existing)	P.V.C.	Polyvinyl Chloride
- - -	Water Line & Size	V.C.P.	Vitrified Clay Pipe
- - -	Existing Water Line		
—	Double Water Meter Setting		
○	Single Water Meter Setting	C.O.	Clean Out
○	Storm Structure	C.I.	Curb Inlet
○	Test Hole	V.T.	Vent Trap
○	Power Pole	S.C.I.	Skewed Curb Inlet
○	Light Standard	T.B.R.	To Be Removed
○	Double Curb Inlet	T.B.R.&R.	To Be Removed & Relocated
—	Existing Fence Line	G.I.	Grate Inlet
—	Existing Tree Line	A.I.	Area Inlet
—	Street Sign	D.A.I.	Double Area Inlet
—	Existing Contour	B.C.	Base Of Curb
—	Proposed Contour	C.C.	Concrete Collar
—	Flared End Section	T.C.	Top Of Curb
—	Grouted Rip-Rap	F.E.	Flared End Section
—	End Pipe	T.W.	Top Of Wall
—	End of Lateral	E.D.	Energy Dissipator
—	Asphalt Pavement	M.H.	Manhole
—	Concrete Pavement	C.P.	Concrete Pipe
—	Use In Place	U.I.P.	Use In Place

SITE BENCHMARK

07-30-96 F.B. 561 B

"AS-BUILTS"

PLAT THREE

REVISIONS

3-08-95 Cover of O'Fallon 182/185 Commercial G.S.
2-28-95 City of O'Fallon Tax L53
2-8-95 City of O'Fallon L53
8-12-94 Site 182/185 T1
8-16-94 Site 308/309 T1

DEVELOPER

PREPARED FOR:
BRYAN VALLEY PARTNERSHIP

7283 HIGHWAY N
O'FALLON, MISSOURI 63366
(314) 281-3763

© Copyright 1994 by Pickett, Ray & Silver Inc.

CONFIDENTIAL PROPRIETARY MATERIAL
The use, reproduction and sales rights of this
drawing are reserved by Pickett, Ray & Silver Inc.

DRAWN TD/RY DATE 7-15-94
CHECKED DATE
FIELD BOOK PROJECT # 77-088
JOB ORDER # 223

ENGINEERS AUTHENTICATION	
The responsibility for professional engineering liability on this project is hereby limited to the set of plans specifically identified below. The engineer is not responsible for any other engineering work inserted in the project and specifically includes revisions after this date unless recommended.	
PICKETT, RAY & SILVER, INC.	
MISSOURI STATE BOARD OF ENGINEERS REGISTRATION NUMBER E-17751	
Signature	Date



PICKETT RAY & SILVER

Civil Engineers
Planners
Land Surveyors

333 Mid Rivers Mall Dr.
St. Peters, MO 63376
397-1211 FAX 397-1104

Celebrating 25 Years of Service


Bryan Valley Plat 3 As-Builts

BRYAN VALLEY
FLAT PLAN


JULY 1994

77-088-A

REV. 8-16-94 T.J.D. BORE
REV. 9-13-94 T.J.D. ADDRESSES
REV. 2-08-95 L.S.S. D.C.I.s & EX. SAN CALLOUT
REV. 3-08-95 G.S. (PLAT 1) (PLAT 2)
REV. 11-08-95 D.G. 36' PAVT. CITY COMMENTS
36' PAVT. CITY COMMENTS

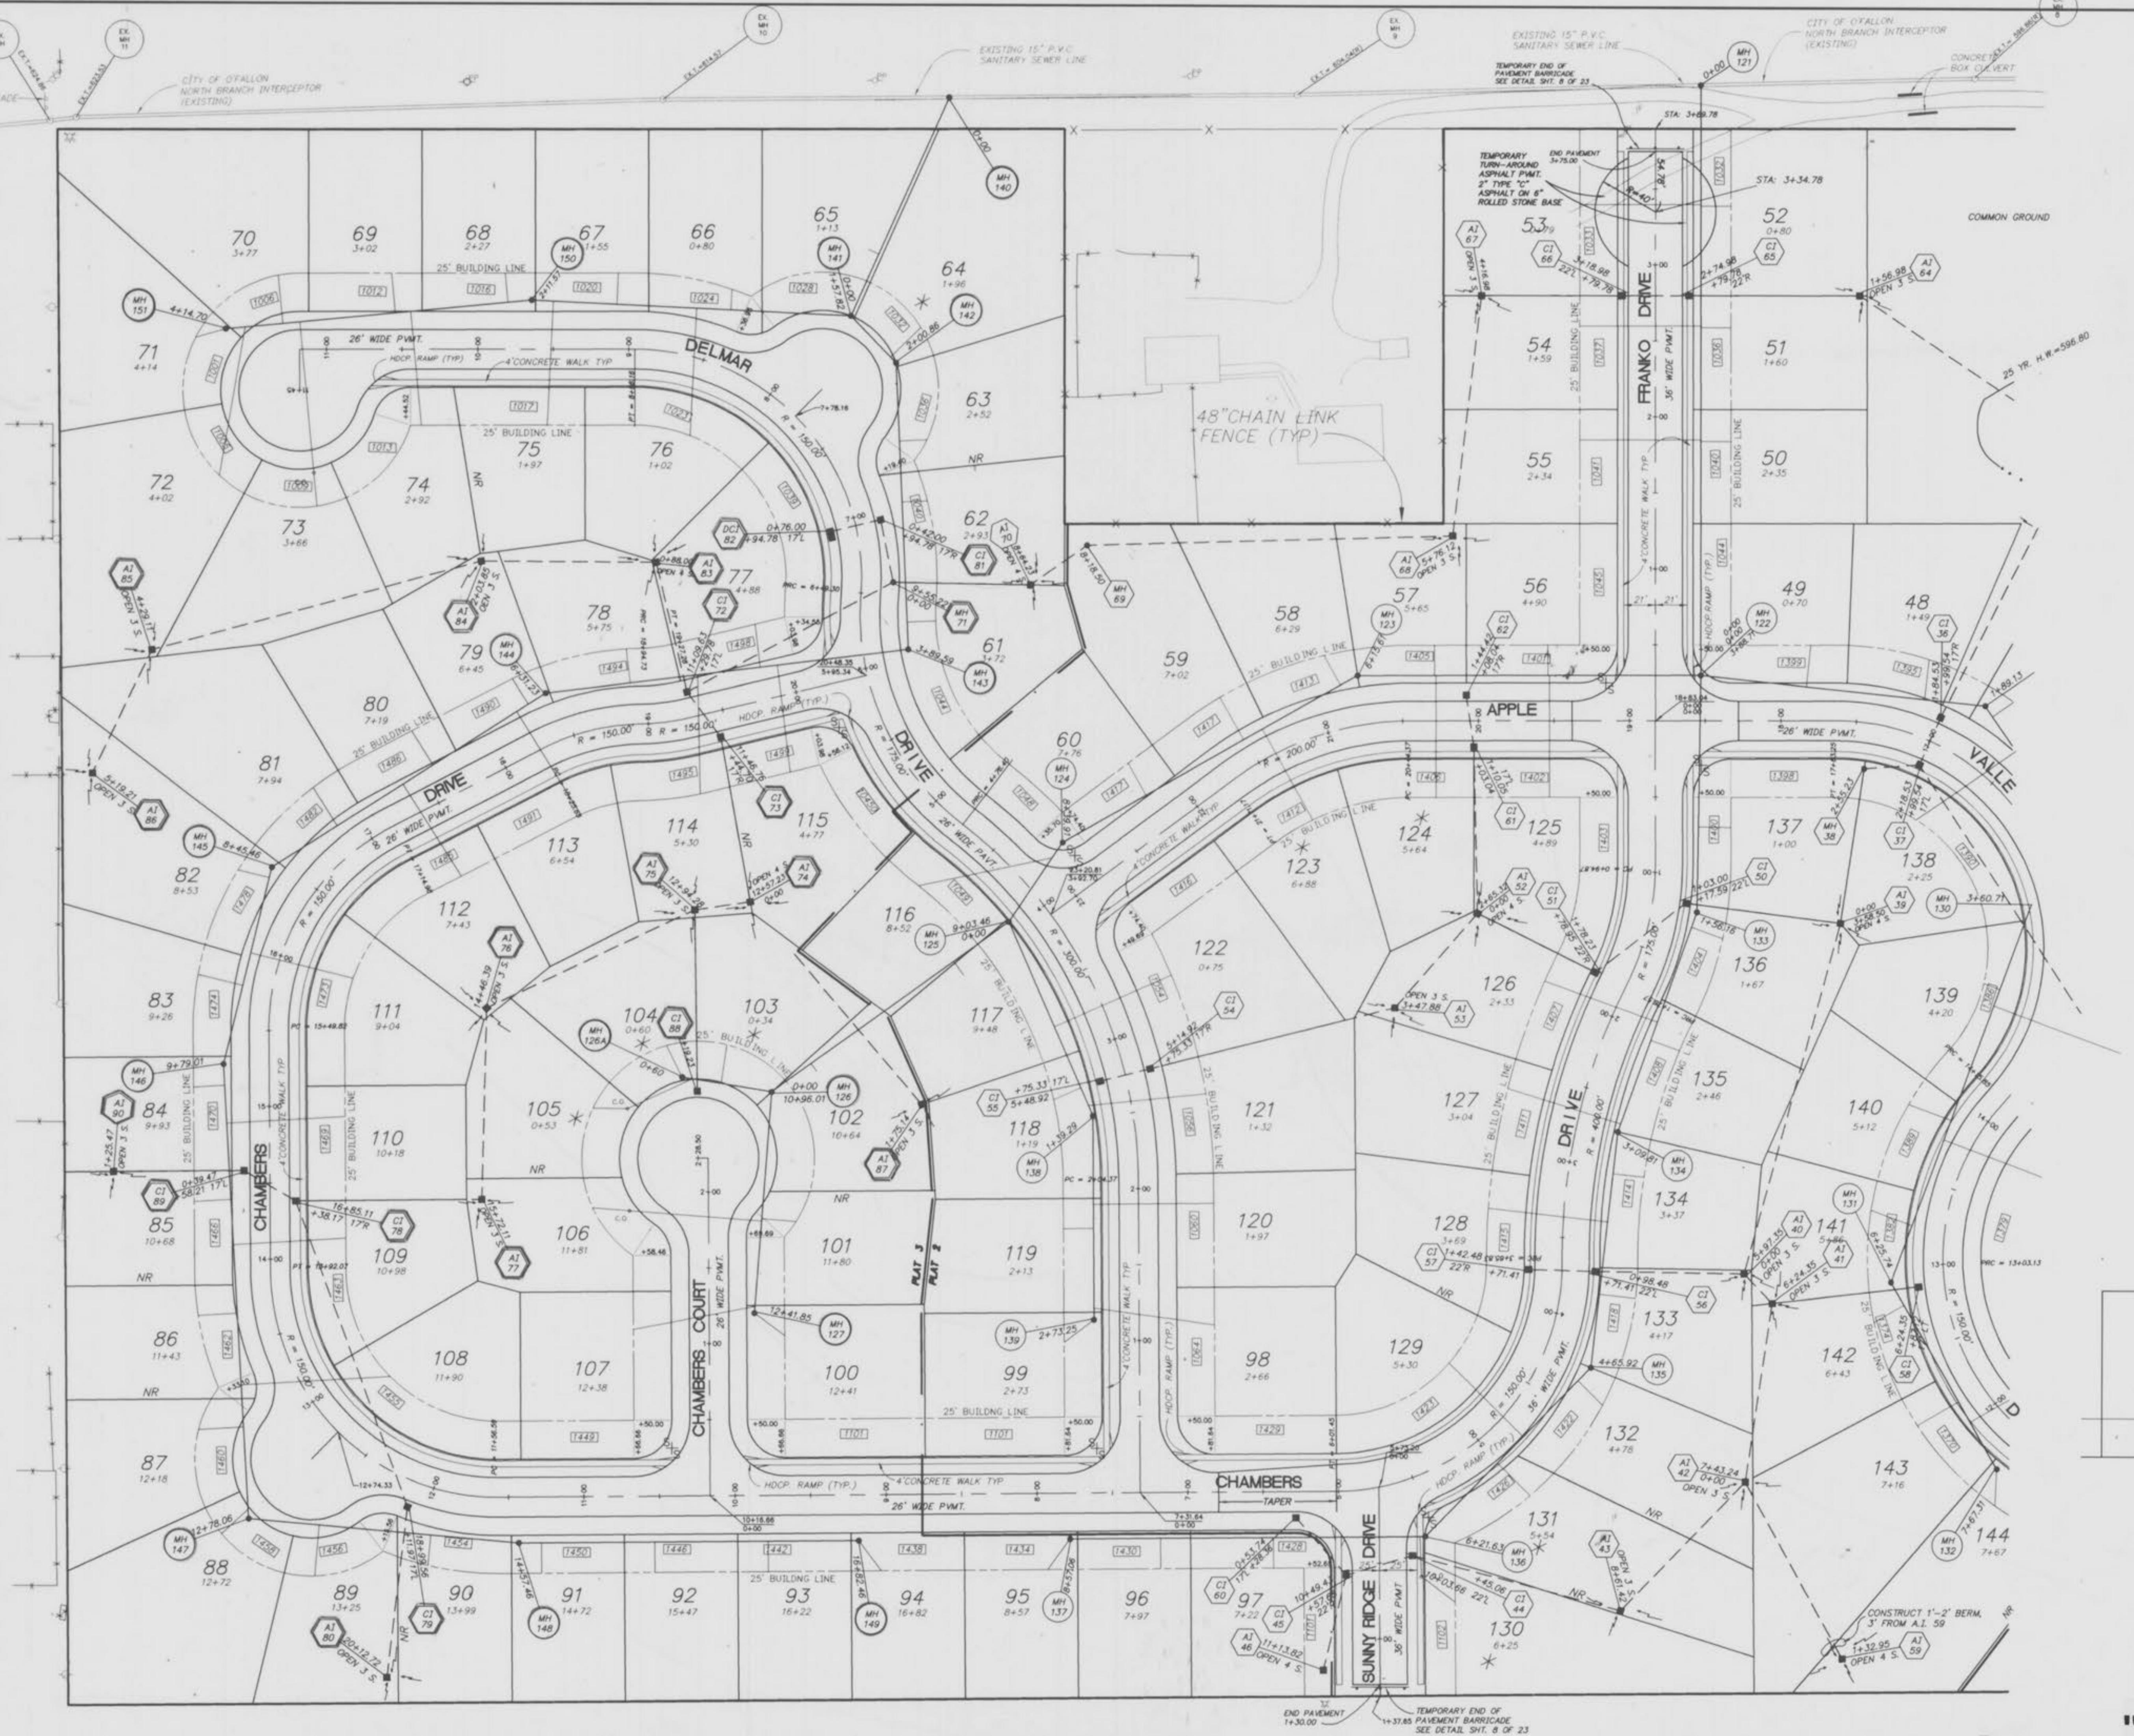

1. ALL STREETS HAVE 50' WIDE R.O.W.
2. ALL PAVEMENT IS 26' W. CONCRETE WITH ROLLED CURB.
3. TYPICAL INTERSECTION: 25' R.O.W. RADIUS 37' PAVEMENT RADIUS
4. TYPICAL CUL DE SACS: 52' R.O.W. RADIUS 40' PAVEMENT RADIUS
5. 36' WIDE PAVEMENT REQUIRES 7" OF CONCRETE PAVEMENT

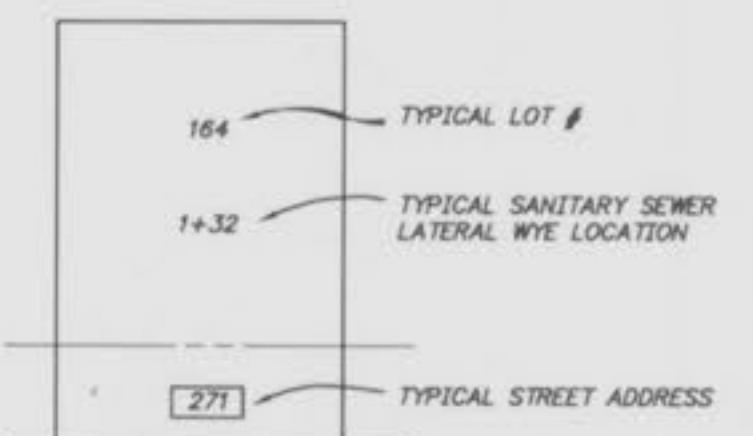

07-30-96
F.B. 5618


"AS-BUILT"

PLAT THREE Bryan Valley As-Built

27 6
27

FINAL	SURVEY	BY	DATE
SURVEYED	PLOTTED		
NOTE BOOK NO.	TEMPATE AREA CHECKED		

ORIGINAL	SURVEY	BY	DATE
SURVEYED	PLOTTED		
NOTE BOOK NO.	TEMPATE AREA CHECKED		

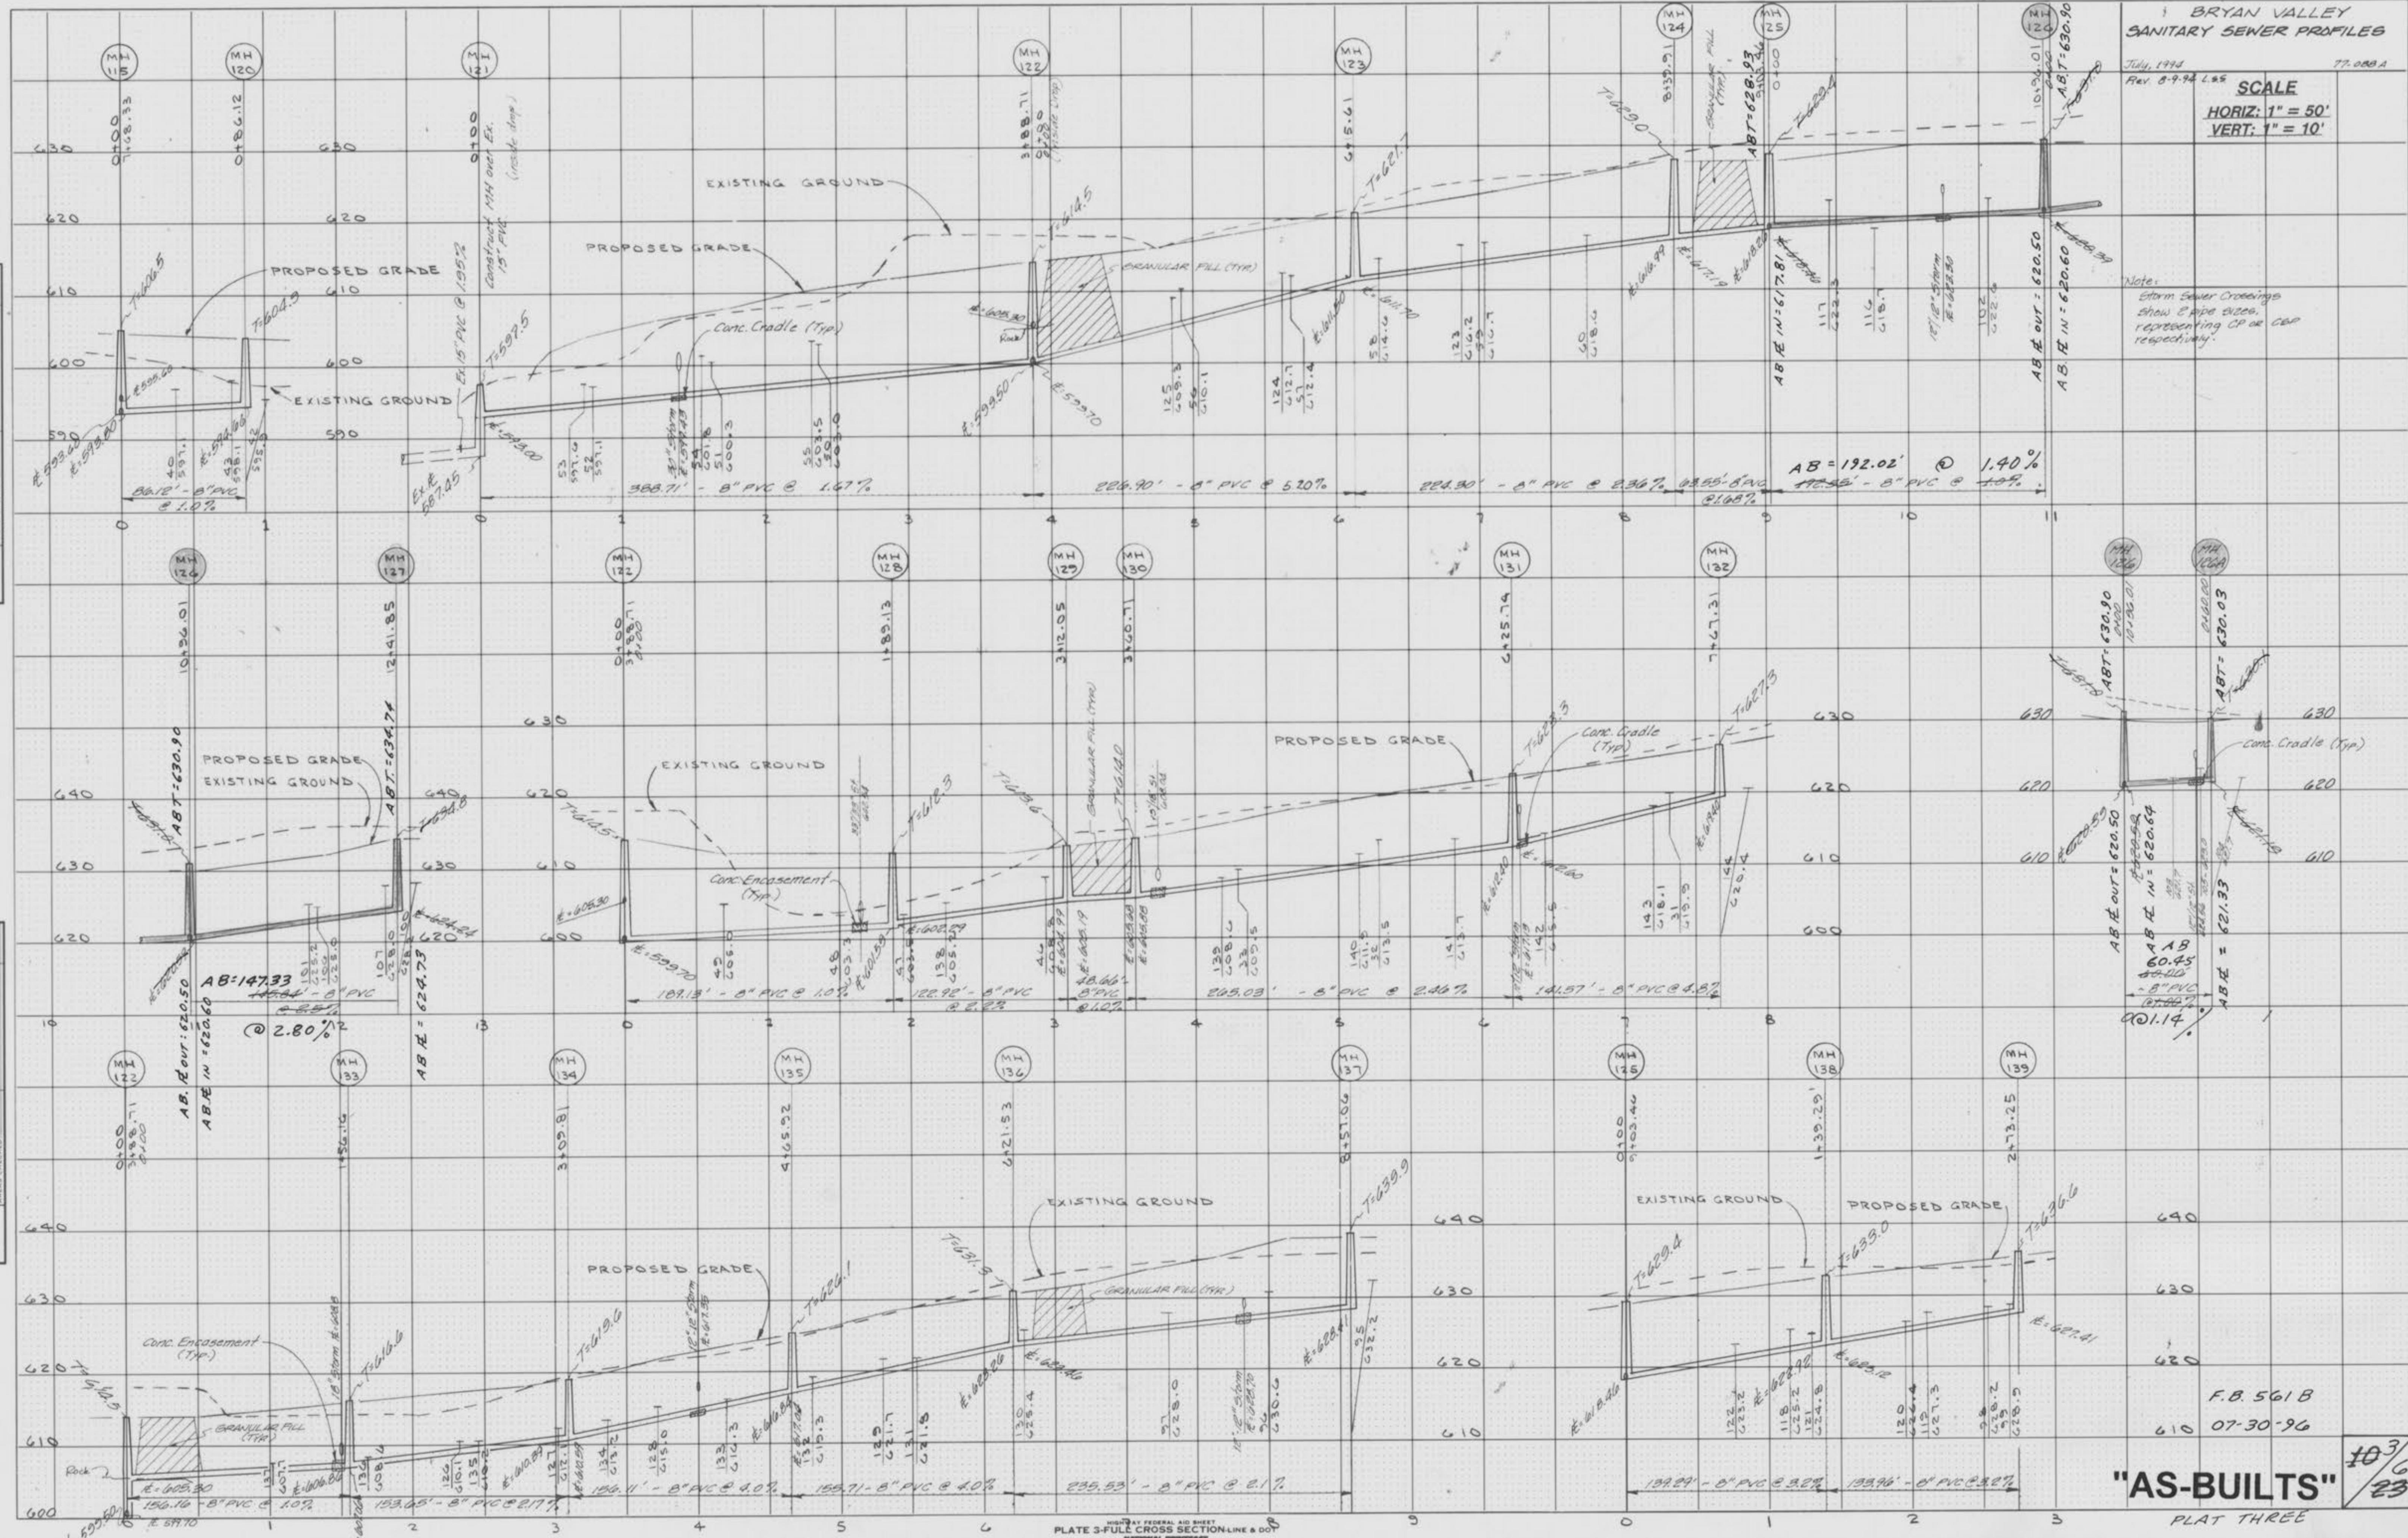

BRYAN VALLEY
SANITARY SEWER PROFILES


JULY, 1994

77-0001

Rev. 8-10-94 1st
Rev. 3-08-95 2nd

Build

Note:
Storm Sewer Crossings
show 2 pipe sizes,
representing CP or CSP
respectively.

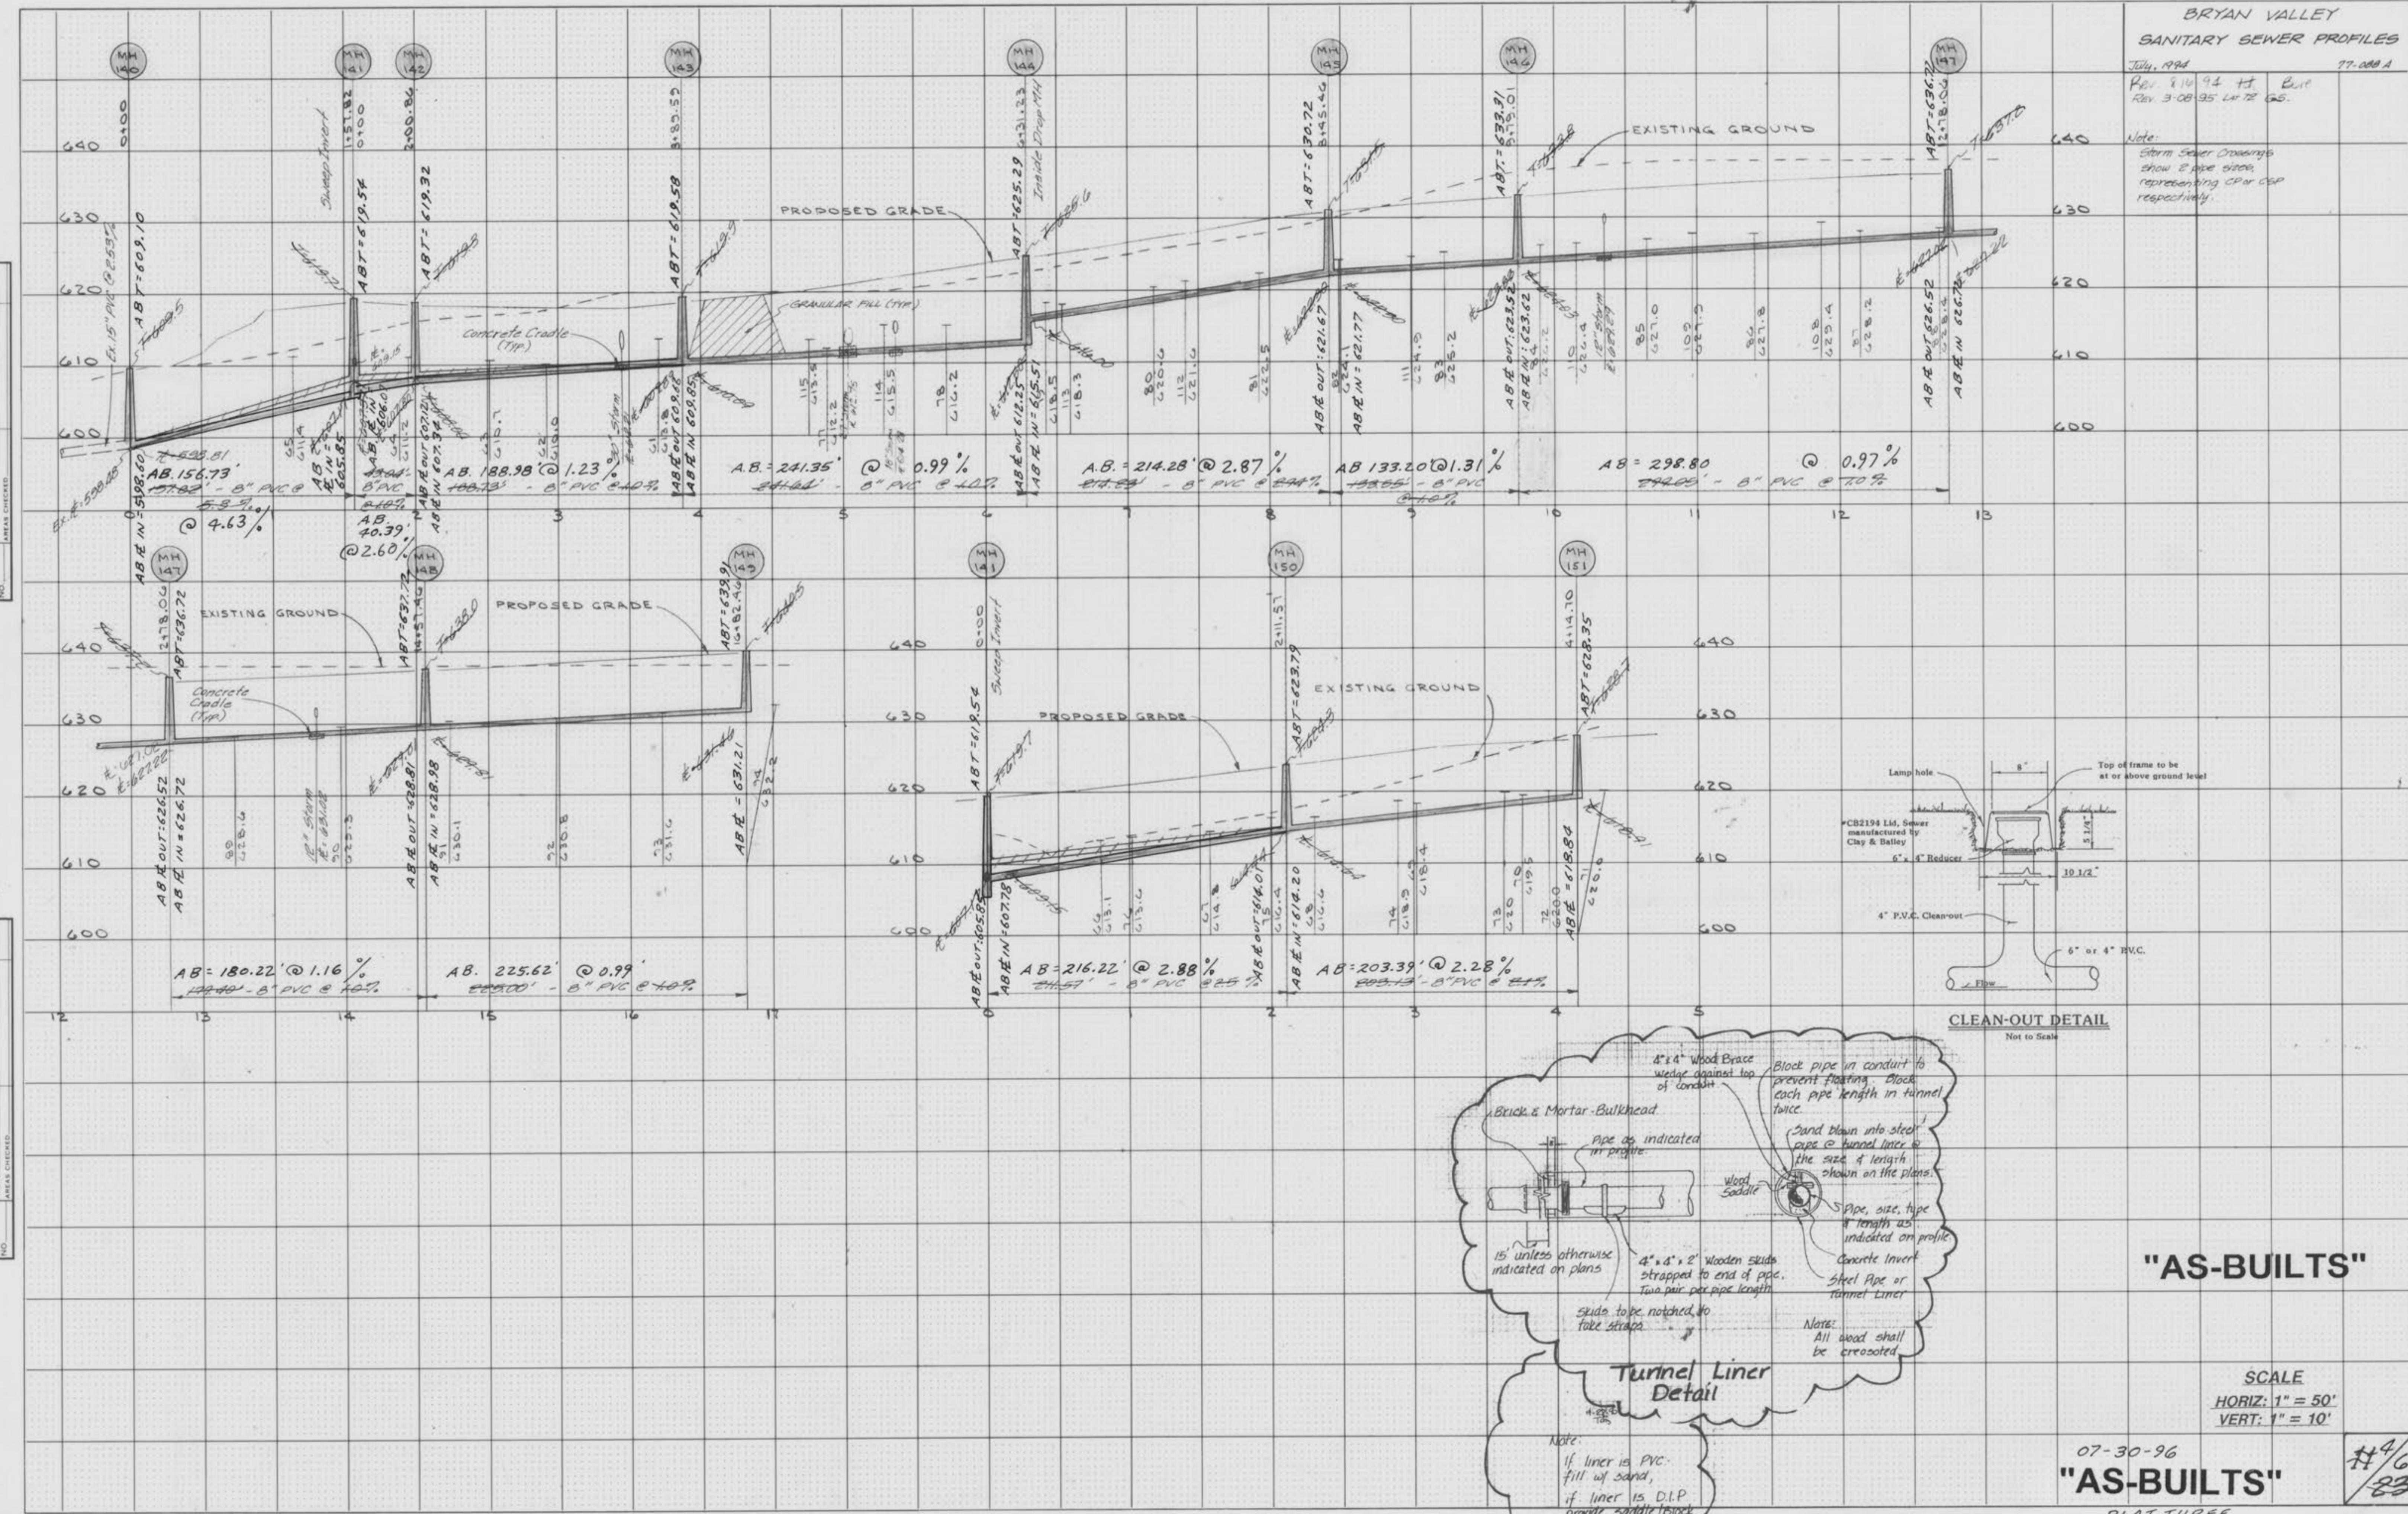

BRYAN VALLEY
STORM SEWER PROFILES

July, 1993


Fav. 10/1/94 Rev. 11/1/94 LGS

SCALE

HORIZ: 1" = 50'

VERT: 1" = 10'

77-0000-1

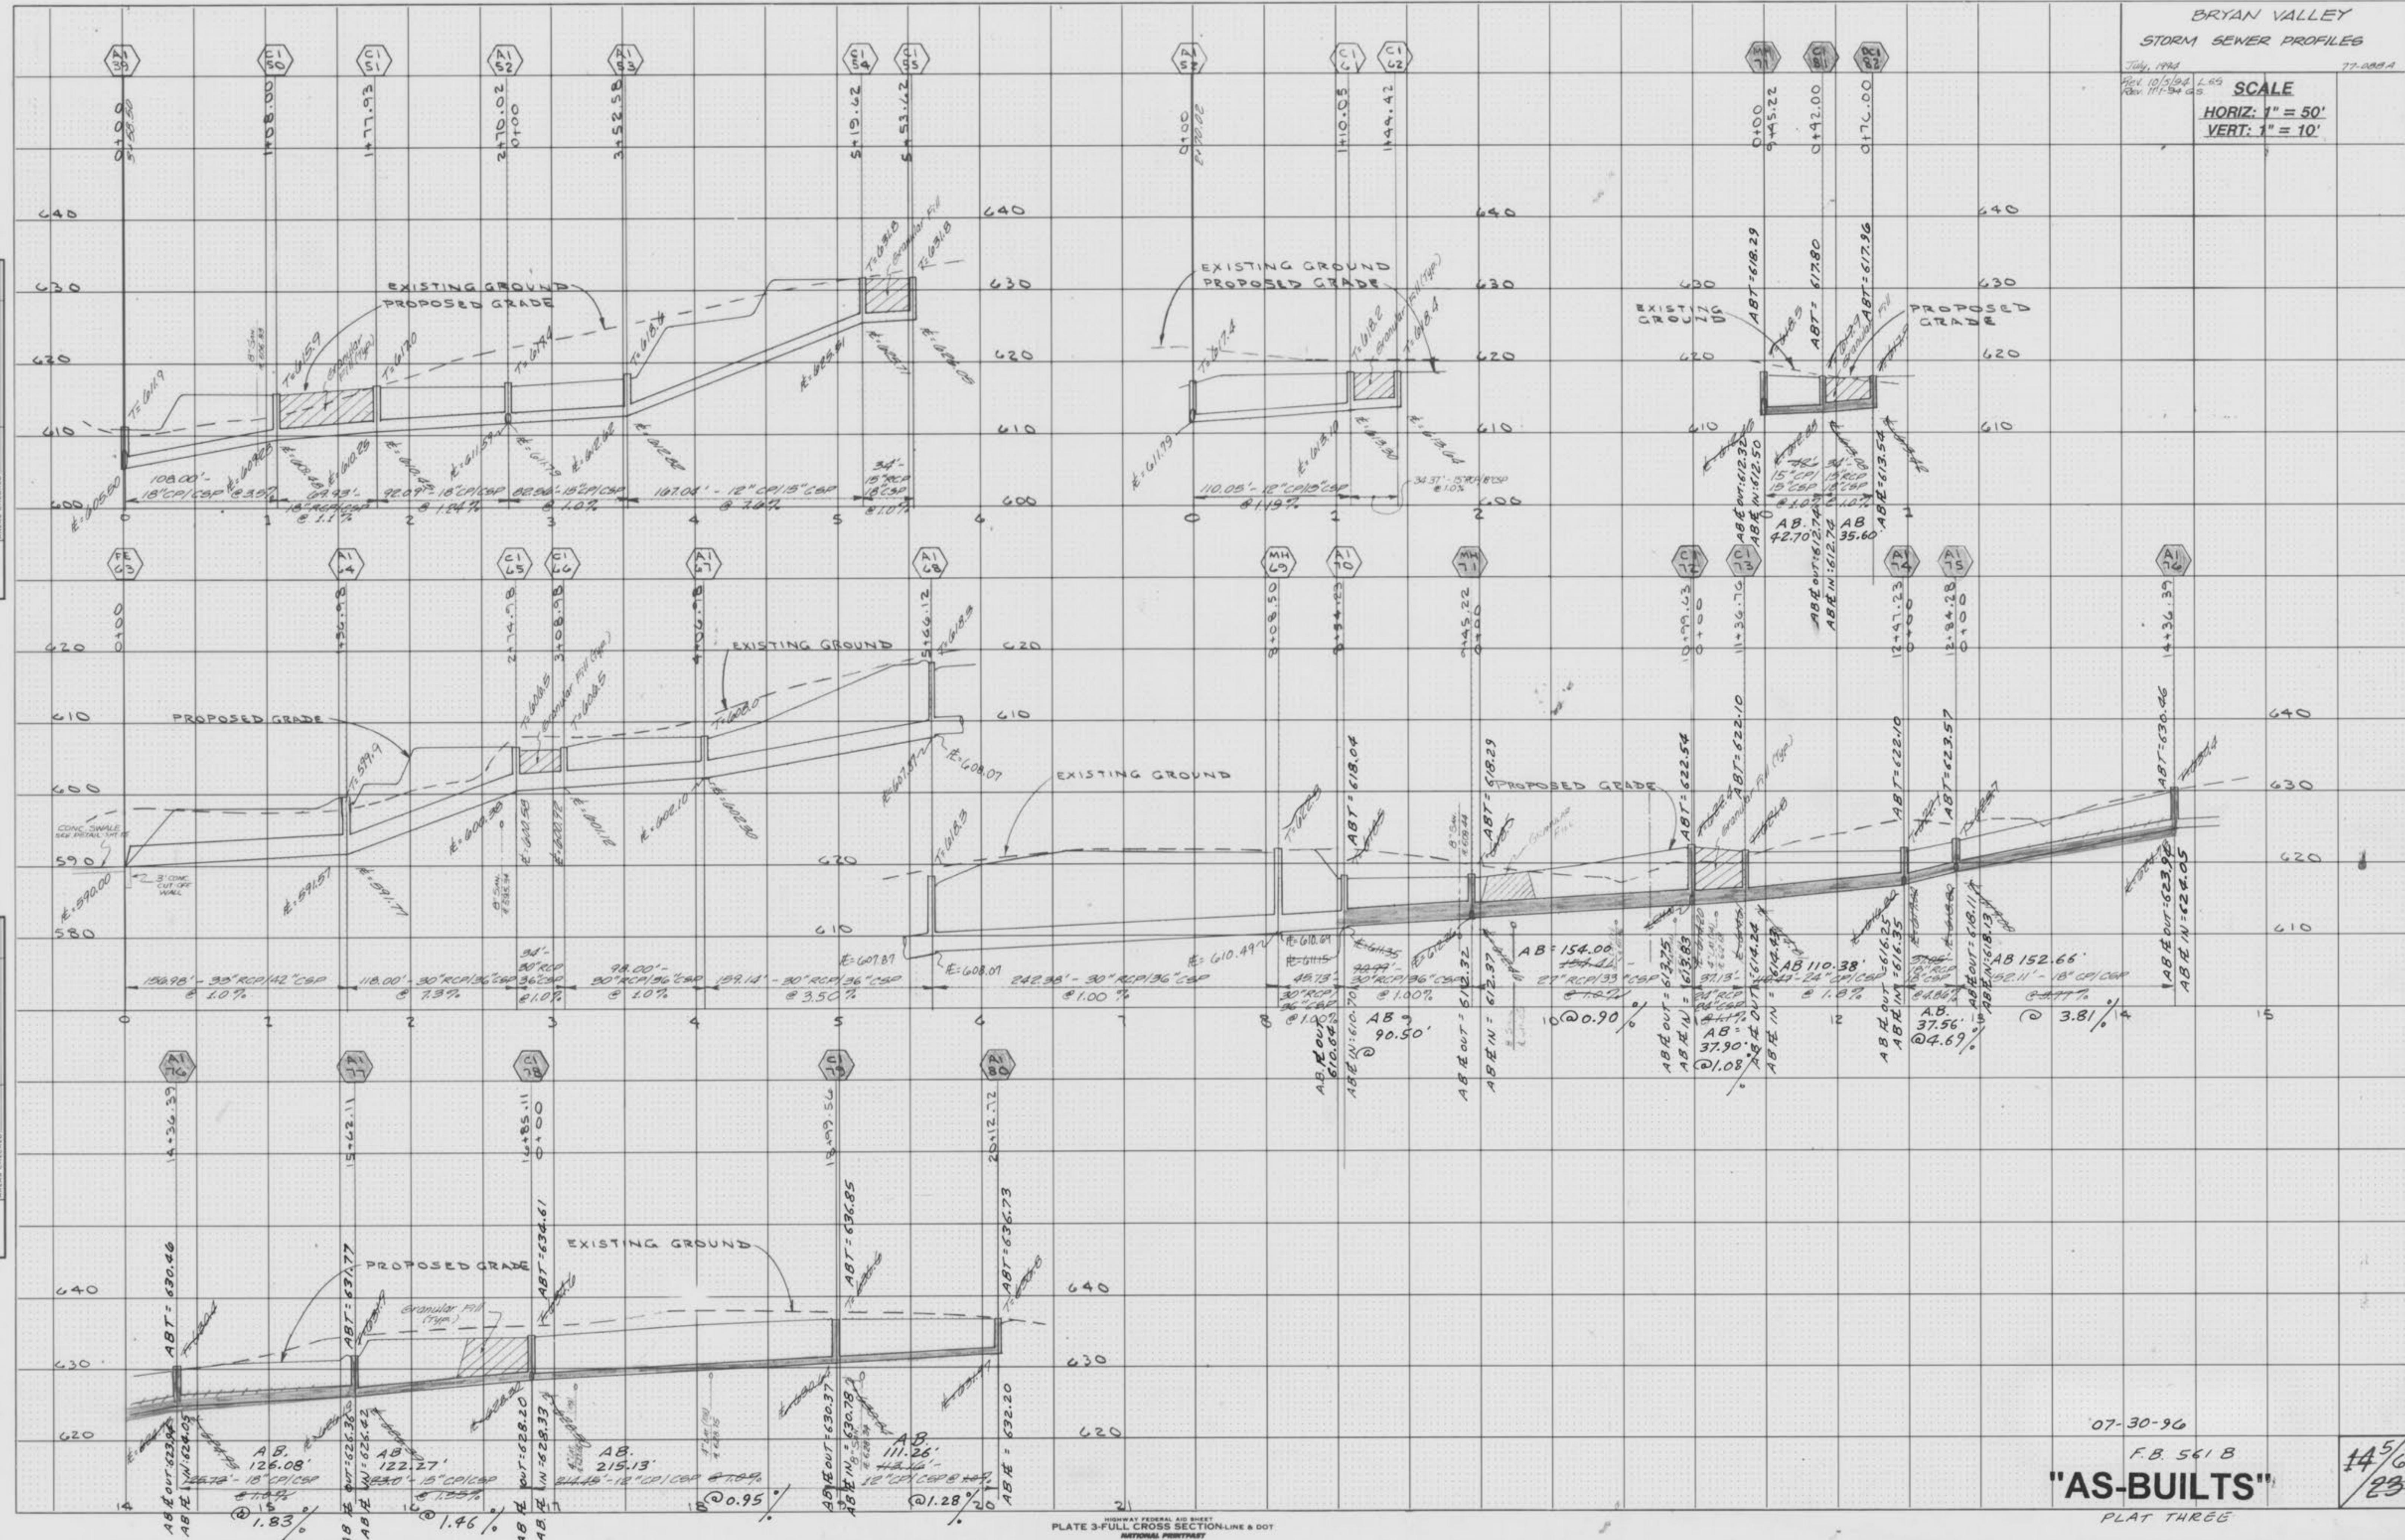

BRYAN VALLEY
STORM SEWER PROFILES

JULY, 1994

REV. 10/15/94 LSS
REV. 11/15/94 G.S.

SCALE

HORIZ: 1" = 50'
VERT: 1" = 10'

77-088A

FINAL SURVEY	BY	DATE
SURVEYED PLOTTED TEMPLATE NOTE BOOK NO.		
AREAS CHECKED		

ORIGINAL SURVEY	BY	DATE
SURVEYED PLOTTED TEMPLATE NOTE BOOK NO.		
AREAS CHECKED		

