



# CFM SPIRIT ENERGY STORE NO. 99




## O'FALLON, MISSOURI

PREPARED FOR:  
**SPIRIT ENERGY CORP.**  
 50 SO. BEMISTON  
 CLAYTON, MO. 63105  
 (314) 725-4321

CFM SPIRIT ENERGY  
**STORE NO. 99**  
 "AS-BUILT" PROFILES

NO.	DATE	DESCRIPTION	BY

PREPARED BY:  
**AMERICAN ENGINEERING**  
 75 MIDLAND AVENUE  
 ST. LOUIS, MISSOURI, 63043  
 (314) 749-5763

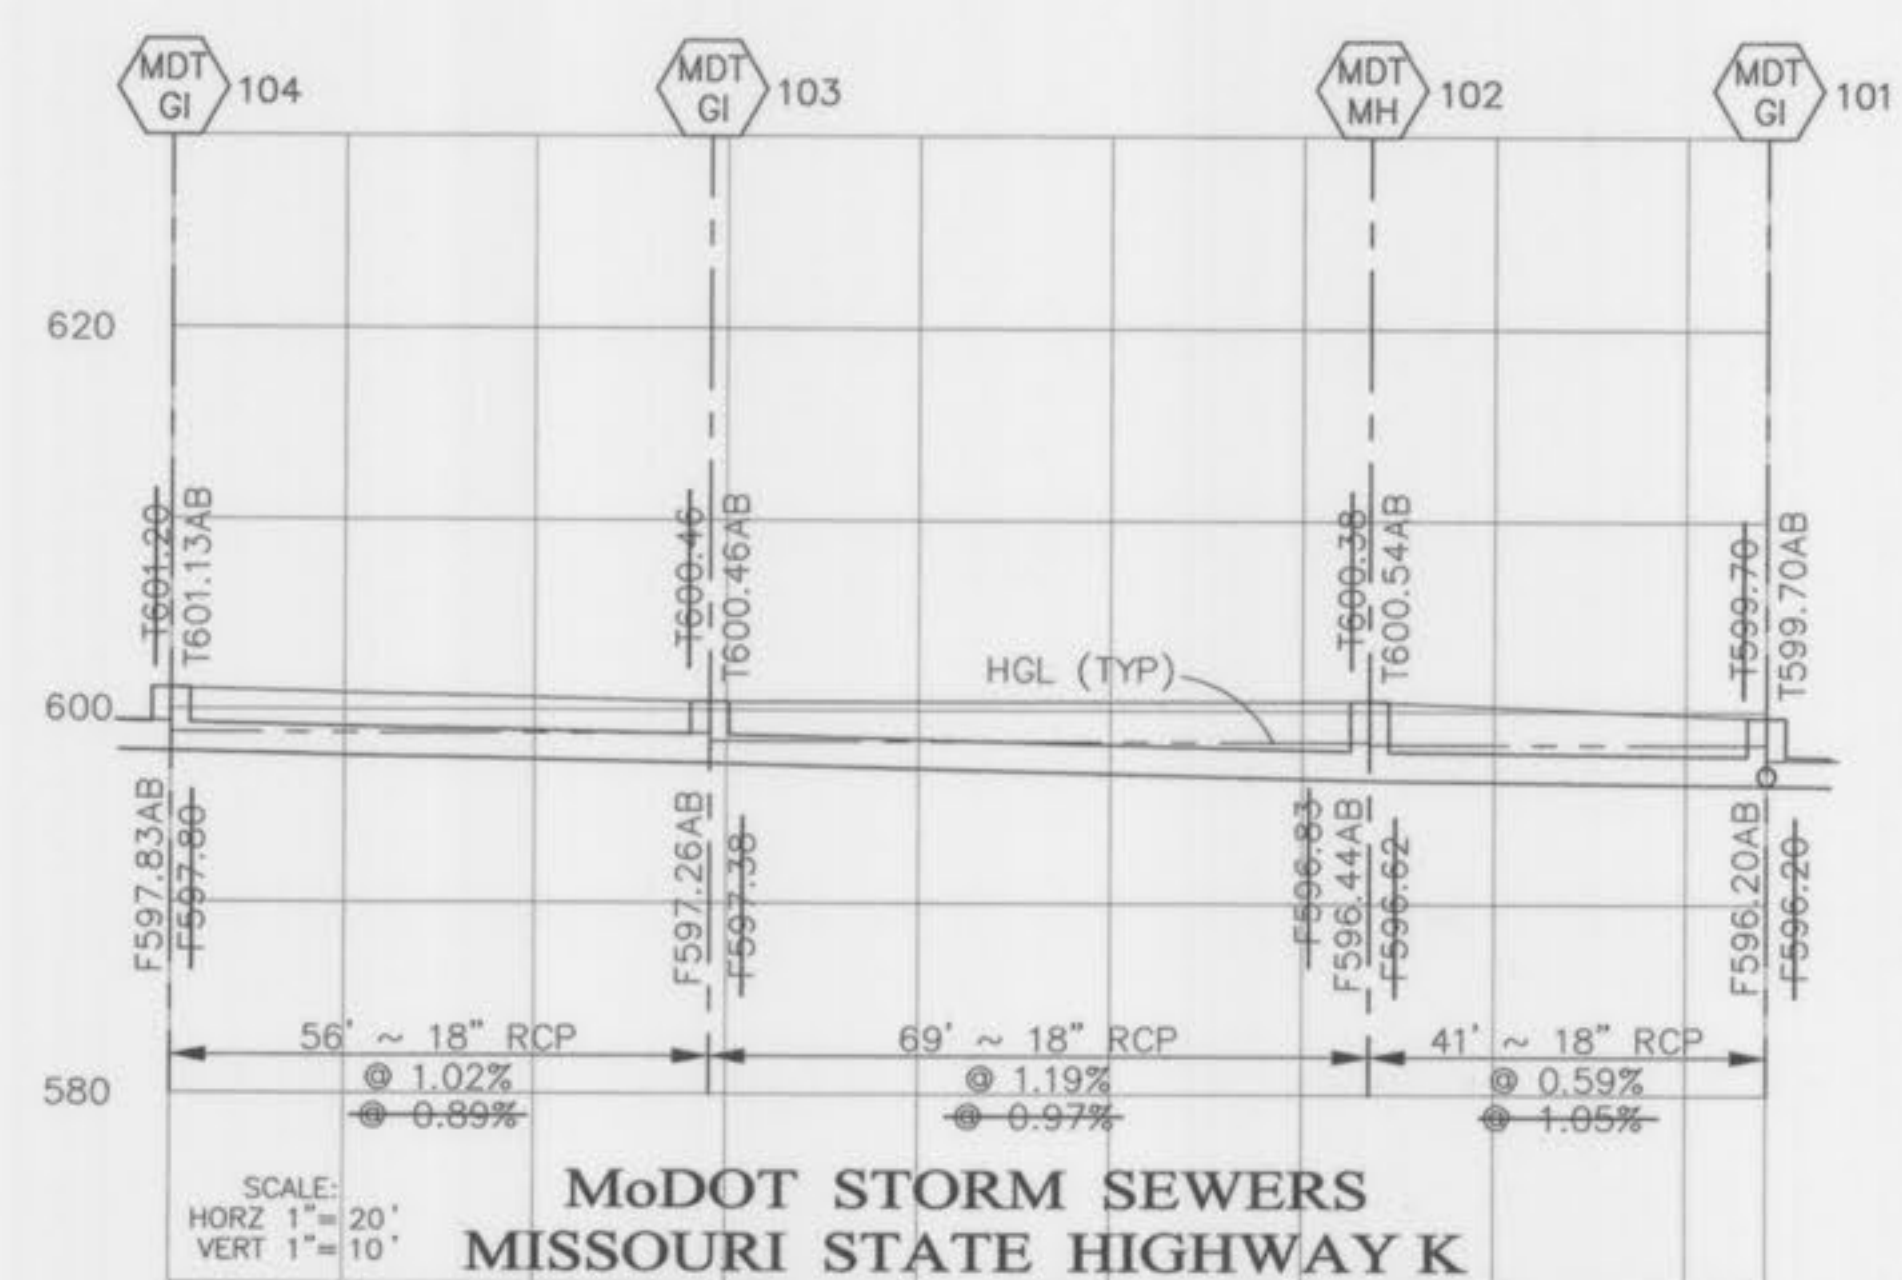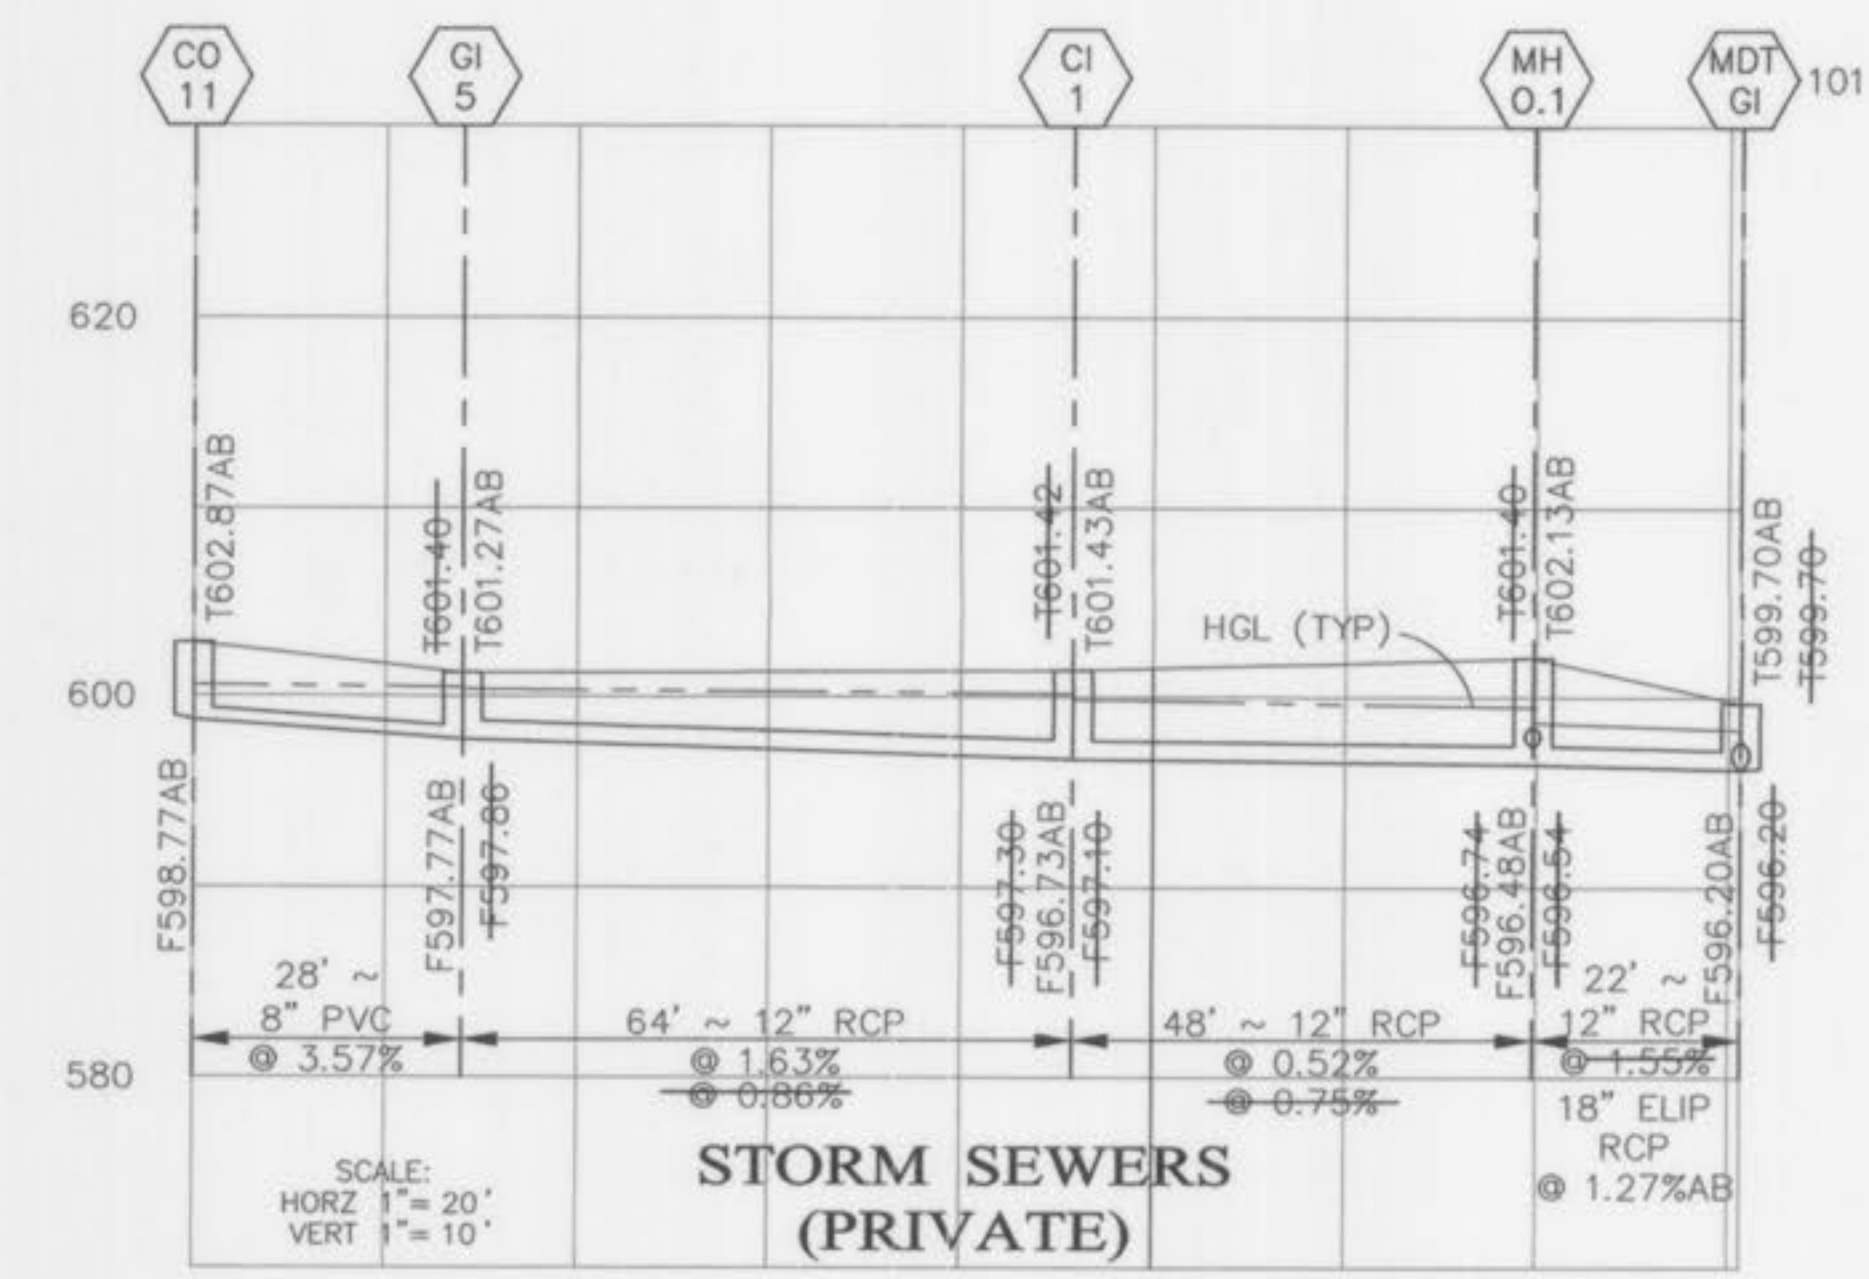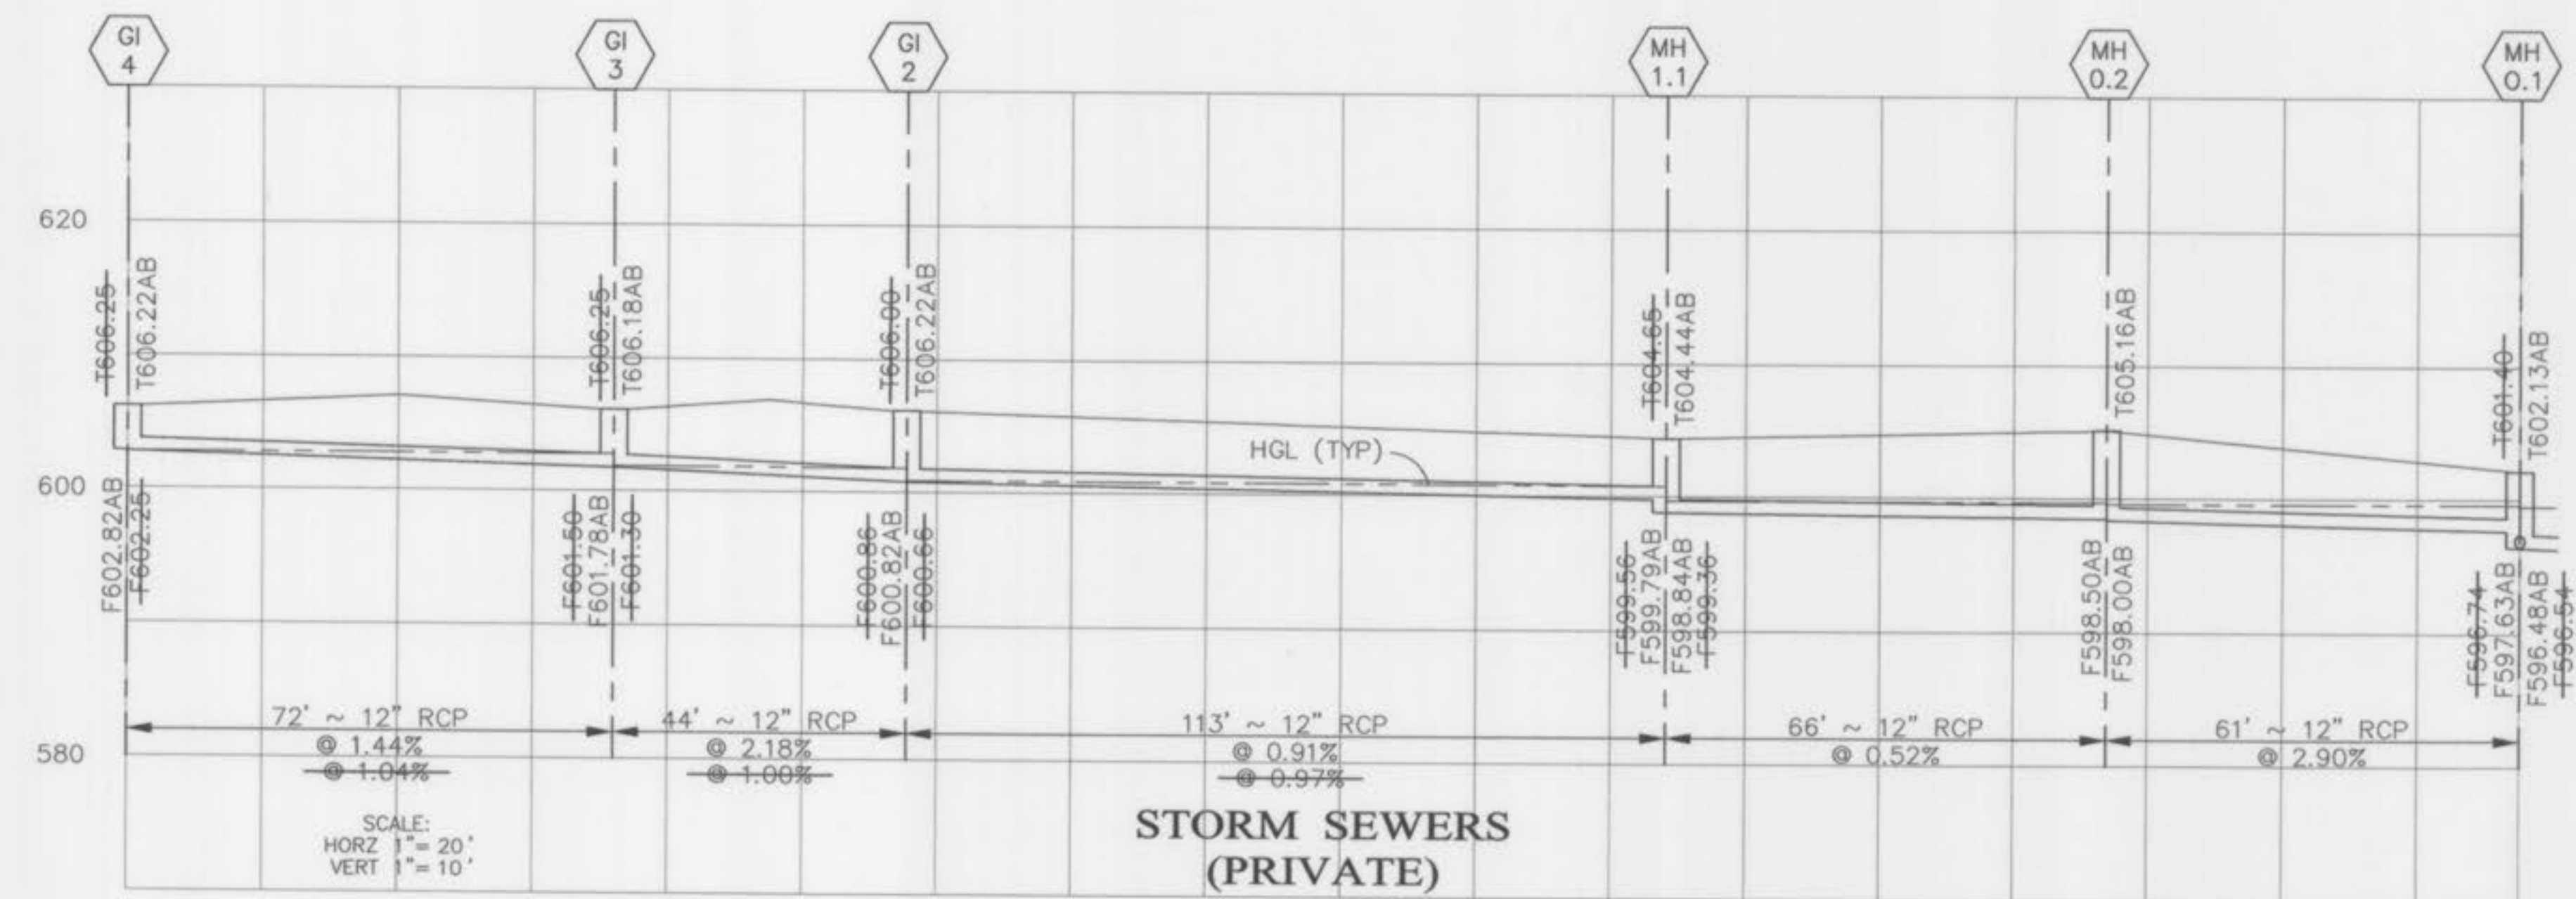

AS-BUILTS WERE MEASURED WITH BOTH THE SEWER CONTRACTOR AND THE GENERAL CONTRACTOR CONSULTED ON UNDERGROUND UTILITY CONSTRUCTION.

*Jay D. Mueller*  
**JAY D. MUELLER**  
 ENGINEER

CFM SPIRIT ENERGY STORE NO. 99  
 AS-BUILTS PROFILES

"AS-BUILTS"

SHEET 2 / 2