

City of O'Fallon

General Notes

- Gas, water and other underground utilities shall not conflict with the depth or horizontal locations of existing and proposed sanitary and storm sewers, including house laterals.
- Underground utilities have been plotted from available information and, therefore, their locations must be considered approximate only. The verification of the location of all underground utilities, either shown or not shown on these plans, shall be the responsibility of the contractor, and shall be located prior to grading or construction of improvements.
- Polyvinyl Chloride (PVC) shall conform to the requirements of ASTM D-3034 Standard Specifications for the PSM Polyvinyl Chloride (PVC) Sewer Pipe and Fittings, SDR-35.
- Storm sewers 18" in diameter or smaller shall be ASTM C-14.
- Storm sewers 21" in diameter or larger shall be ASTM C-76, Class II.
- All storm sewer pipe under pavement, regardless of size, shall be reinforced concrete pipe (ASTM C-76, Class III) unless noted otherwise on the plans.
- Corrugated metal pipe shall conform to the standard specifications for corrugated culvert pipe N-36, A.A.S.H.O. See plans for gauge. All pipe shall be aluminized or bituminous coated.
- All filled places under buildings, proposed sanitary and storm sewer lines, and/or paved areas including trench backfills shall be compacted to 90% of maximum density as determined by the "Modified A.A.S.H.O. T-180 Compaction Test" (ASTM D-1597) unless otherwise specified by the local governing authority specifications. All tests will be verified by a Soils Engineer.
- All earth-filled places within State, County, or City roads (Highways) shall be compacted to 90% of maximum density as determined by the "Standard Proctor Test A.A.S.H.O. T-99" (ASTM D-698) unless otherwise specified by local governing authority specifications. All tests will be verified by a Soils Engineer.
- All storm and sanitary trench backfills shall be water jetted. Granular fill will be used under paved areas.
- Easements shall be provided for storm sewers, sanitary sewers, and all utilities on the record plat. See record plat for location and size of easements. This does not apply to house laterals.
- No area shall be cleared without the permission of the developer.
- All grade shall be within 0.2 feet (more or less) of those shown on the grading plan.
- No slope shall be greater than 3:1 and shall be either sodded or seeded and mulched.
- Hazard markers will consist of three (3) standard specification, "Manual on Uniform Traffic Control Devices", end of roadway markers mounted on two (2) pound "U" channel sign post. Each marker shall consist of an eighteen (18) inch diamond reflectorized red panel. The bottom of each panel shall be mounted a minimum of four (4) feet above the elevation of the pavement surface.
- All manhole and curb inlet tops built without elevations furnished by the Engineer will be the responsibility of the sewer contractor. At the time of construction stake-out of the sewer lines, all curb and grate inlets will be face staked. If normal face stakes fall in line with sewer construction, the Engineer will set these stakes on a double offset. It shall be the responsibility of the sewer contractor to preserve all face stakes from destruction.
- All standard street curb inlets to have front of inlet 2 feet behind curb.
- The minimum vertical distance from the low point of the basement to the flowline of a sanitary sewer at the corresponding house connection shall not be less than the diameter of the sanitary sewer plus a vertical distance of not less than 2-1/2 feet.
- Water lines, valves, sleeves, meters and etc. shall meet all specifications and installation requirements of the local governing authority.
- All cast iron pipe for water mains shall conform to A.W.W.A. specification C-106 and/or C-108. The cast iron fittings shall conform to A.W.W.A. specification C-110. All rubber gasket joints for water cast iron pressure pipe and fittings shall conform to A.W.W.A. specification C-111.
- All water hydrants and valves shall be cast iron and installed in accordance with plans and details.
- All sanitary and storm sewers shall meet all specifications and installation requirements of the local governing authority.
- All PVC water pipe shall have a minimum pressure rating of PR-200 or SDR-21.
- All PVC sanitary sewer pipe shall be PR-35 or equal with crushed stone bedding uniformly graded between 1" and 1/4" size. This bedding shall extend from 6" below the pipe to 12" above the top of the pipe.
- All grading on Missouri State Highway Right-of-Way shall be seeded and mulched and all disturbed Right-of-Way markers shall be reset at the completion of grading.
- All streets must meet the specifications and installation requirements of the City of O'Fallon.
- All sanitary manhole tops shall be set 0.2' higher than the proposed ground except in pavement areas.
- All sanitary service lines shall have a 6" diameter for Multi-family and a 4" diameter for Single-family developments.
- Manhole frame and cover shall be Clay and Bailey No. 2008 for Neenah P-1736 or Deeter 1315 or approved equal.
- The Duckett Creek Sewer District shall be notified at least 48 hours prior to construction of sanitary sewers for coordination and inspection.
- All existing improvements damaged or destroyed during construction shall be replaced or repaired in kind.
- Brick shall not be used on manholes.
- Sewer contractor shall maintain 24' vertical separation between all storm sewers and the sludge force main. Contractor shall be responsible for verifying separation prior to storm sewer installation.
- This tract is served by:

St Charles Gas Co.
Water District No. 2
Union Electric Co.
Southwestern Bell
Duckett Creek Sewer Dist.
Wentzville Fire Dist
Francis Howell

"AS-BUILTS"


CARRIAGE HILLS SUBDIVISION

PHASE TWO

A FRACTIONAL PART OF U.S. SURVEY 1669,
TOWNSHIP 46 NORTH, RANGE 3 EAST
5th PRINCIPAL MERIDIAN,
O'FALLON, ST. CHARLES COUNTY, MISSOURI



Location Map

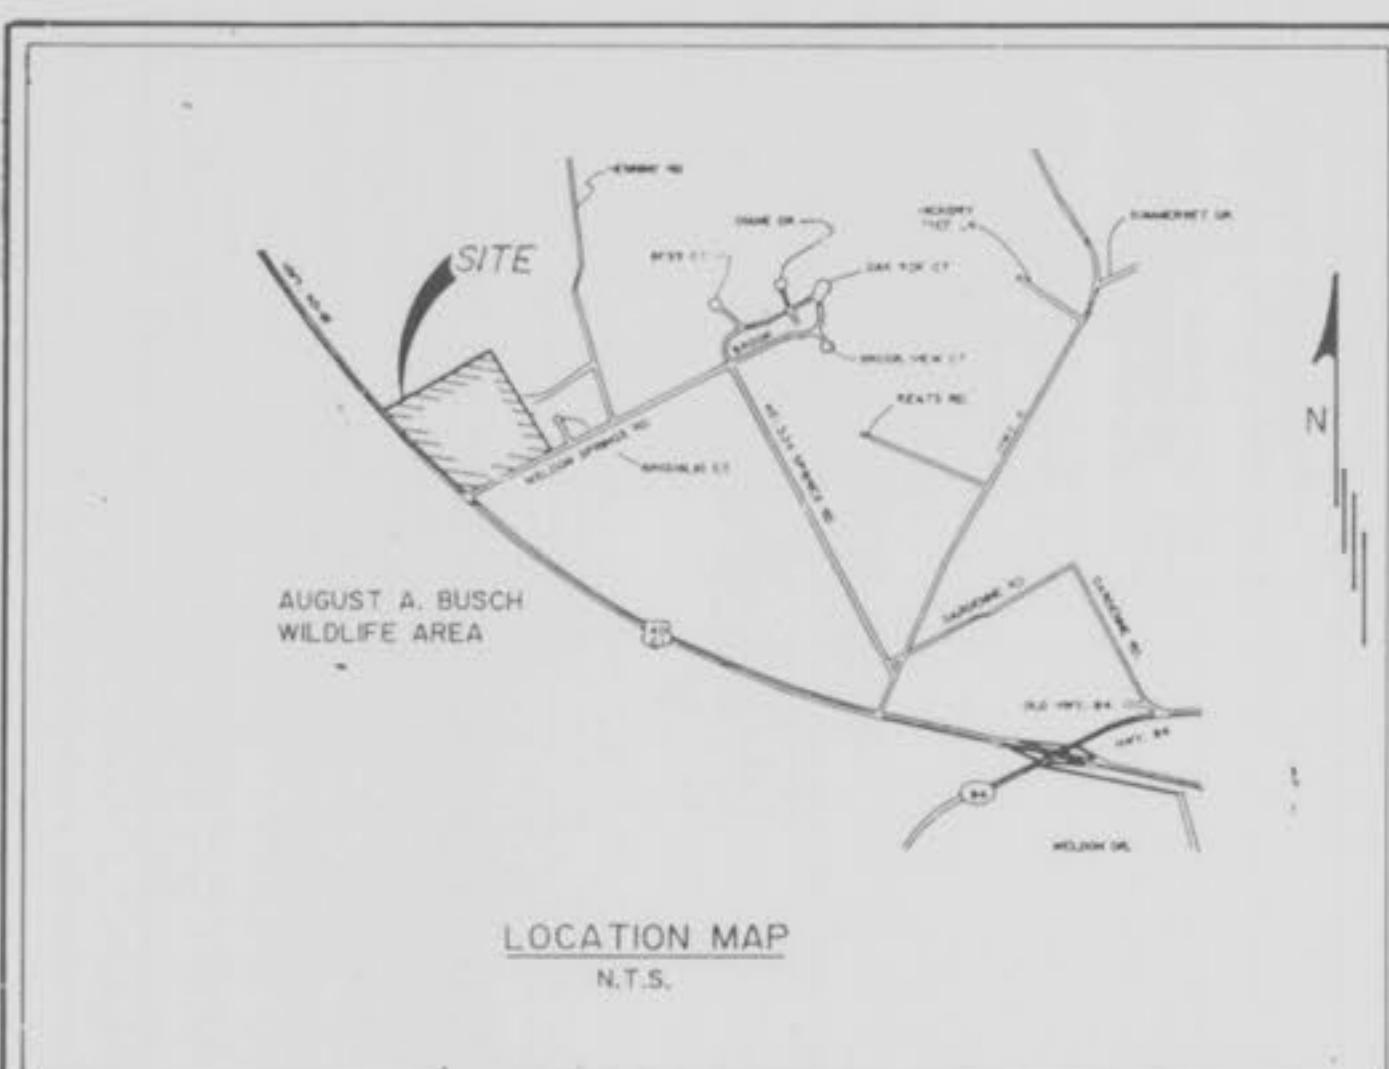

Key Map

This is to certify to City of O'Fallon,
that these "As-Built" sewer plans are
based on actual field surveys conducted
during March, 1989 and the results are
shown here on.

by Pickett Ray & Silver

Delmar F. Vincent
MO R.L.S. No. 1869

3/20/89
Date 4/9/89

ENGINEERS AUTHENTICATION	
The responsibility for professional engineering liability on the project is hereby limited to the set of plans authenticated by the seal, signature and date hereunder attached. Responsibility is limited to the original plans and to the work performed and specifically excludes revisions after this date unless reauthenticated.	
PICKETT RAY & SILVER, INC.	
Civil Engineers Planners Land Surveyors	
133 Mid Rivers Mall Dr. St. Peters, MO 63376 441-1711 278-1211	
PREPARED FOR:	
Purler-Cannon-Schulte, Inc. 828 O'Fallon Road St. Charles, Missouri 441-6221	
DRAWN <u>JWE</u> DATE <u>3-20-89</u> CHECKED <u> </u> DATE <u> </u>	
FIELD BOOK	PROJECT # <u>89-047 A</u> JOB ORDER # <u>4253</u>

City of O'Fallon, Mo.

CARRIAGE HILLS PHASE II-A AS-BUILTS

Index

Sheet	Description
1	COVER SHEET
2	FLAT PLANS
4-5	GRADING PLANS
6	STREET PROFILES
3-7	SANITARY PROFILES
4+6	SANITARY & STORM PROFILES
5+6	STORM SEWER PROFILES
10-11	DRAINAGE AREA MAP
6-12-13	WATER MAIN LAYOUT
14-18	DETAILS

Benchmark

REFERENCE BENCHMARK - CHISELED SQUARE ON TOP OF WINGWALL AT EAST END OF WESTBOUND U.S. HIGHWAYS 40 & 61 BRIDGE OVER DARDENNE CREEK. ELEV. 405.92 FEET NOV/87 74, U.S. DEPT. OF HOUSING AND DEV. NATIONAL FLOOD INSURANCE STUDY, COMMUNITY-PANEL NO. 290315 0250 A, PAGE 250 OF 3501.

SITE BENCHMARK NO. 1 - CHISELED SQUARE ON N.W. COR. OF WESTBOUND U.S. HIGHWAYS 40 & 61 CULVERT HEADWALL, STA. 406-75 (APPROX. 0.4 MI. WEST WELDON SPRINGS RD.) ELEV. - 505.1.

SITE BENCHMARK NO. 2 - SPIKE IN S. SIDE OF TREE ON NORTH SIDE OF WELDON SPRINGS RD. (APPROX. 1.60 FEET EAST OF HWY 40-61) ELEV. 565.00.

Legend

○	Sanitary Sewer (Proposed)	C.I.	Curb Inlet
○	Sanitary Sewer (Existing)	D.C.I.	Double Curb Inlet
○	Storm Sewer (Proposed)	G.I.	Grate Inlet
○	Storm Sewer (Existing)	A.I.	Area Inlet
○	Water Line & Size	D.A.I.	Double Area Inlet
○	Tee & Valve	C.C.	Concrete Collar
○	Hydrant	F.E.	Flared End Section
○	Cap	E.P.	End Pipe
18	Lot or Building Number	E.D.	Energy Dissipator
○	Existing Fence Line	M.H.	Manhole
○	Existing Tree Line	C.P.	Concrete Pipe
○	Street Sign	R.C.P.	Reinforced Concrete Pipe
○	Direction of Proposed Residence	C.M.P.	Corrugated Metal Pipe
○	Existing Contour	C.I.P.	Cast Iron Pipe
○	Proposed Contour	P.V.C.	Polyvinyl Chloride
○	Grouted Rip-Rap	V.C.P.	Vitrified Clay Pipe
○	End of Lateral	C.O.	Clean Out
○	Asphalt Pavement	V.T.	Vent Trap
○	Concrete Pavement		
○	Storm/Sanitary Structure		
○	Test Hole		
○	Power Pole		
○	Light Standard		

"AS-BUILTS" 3-20-89 KAW.
2. Rev per City of O'Fallon - 10-12-89, JWE.
1. Rev per City of O'Fallon & Duckett Creek; 10-12-89 DWD

MISSOURI


STATE

HIGHWAY

40-61

Not Part of Subdivision
This area not included in Drainage Calc.

NOTE: SHADeD "BALLOONS"
INDICATE "AS-BUILT" STRUCTURES.

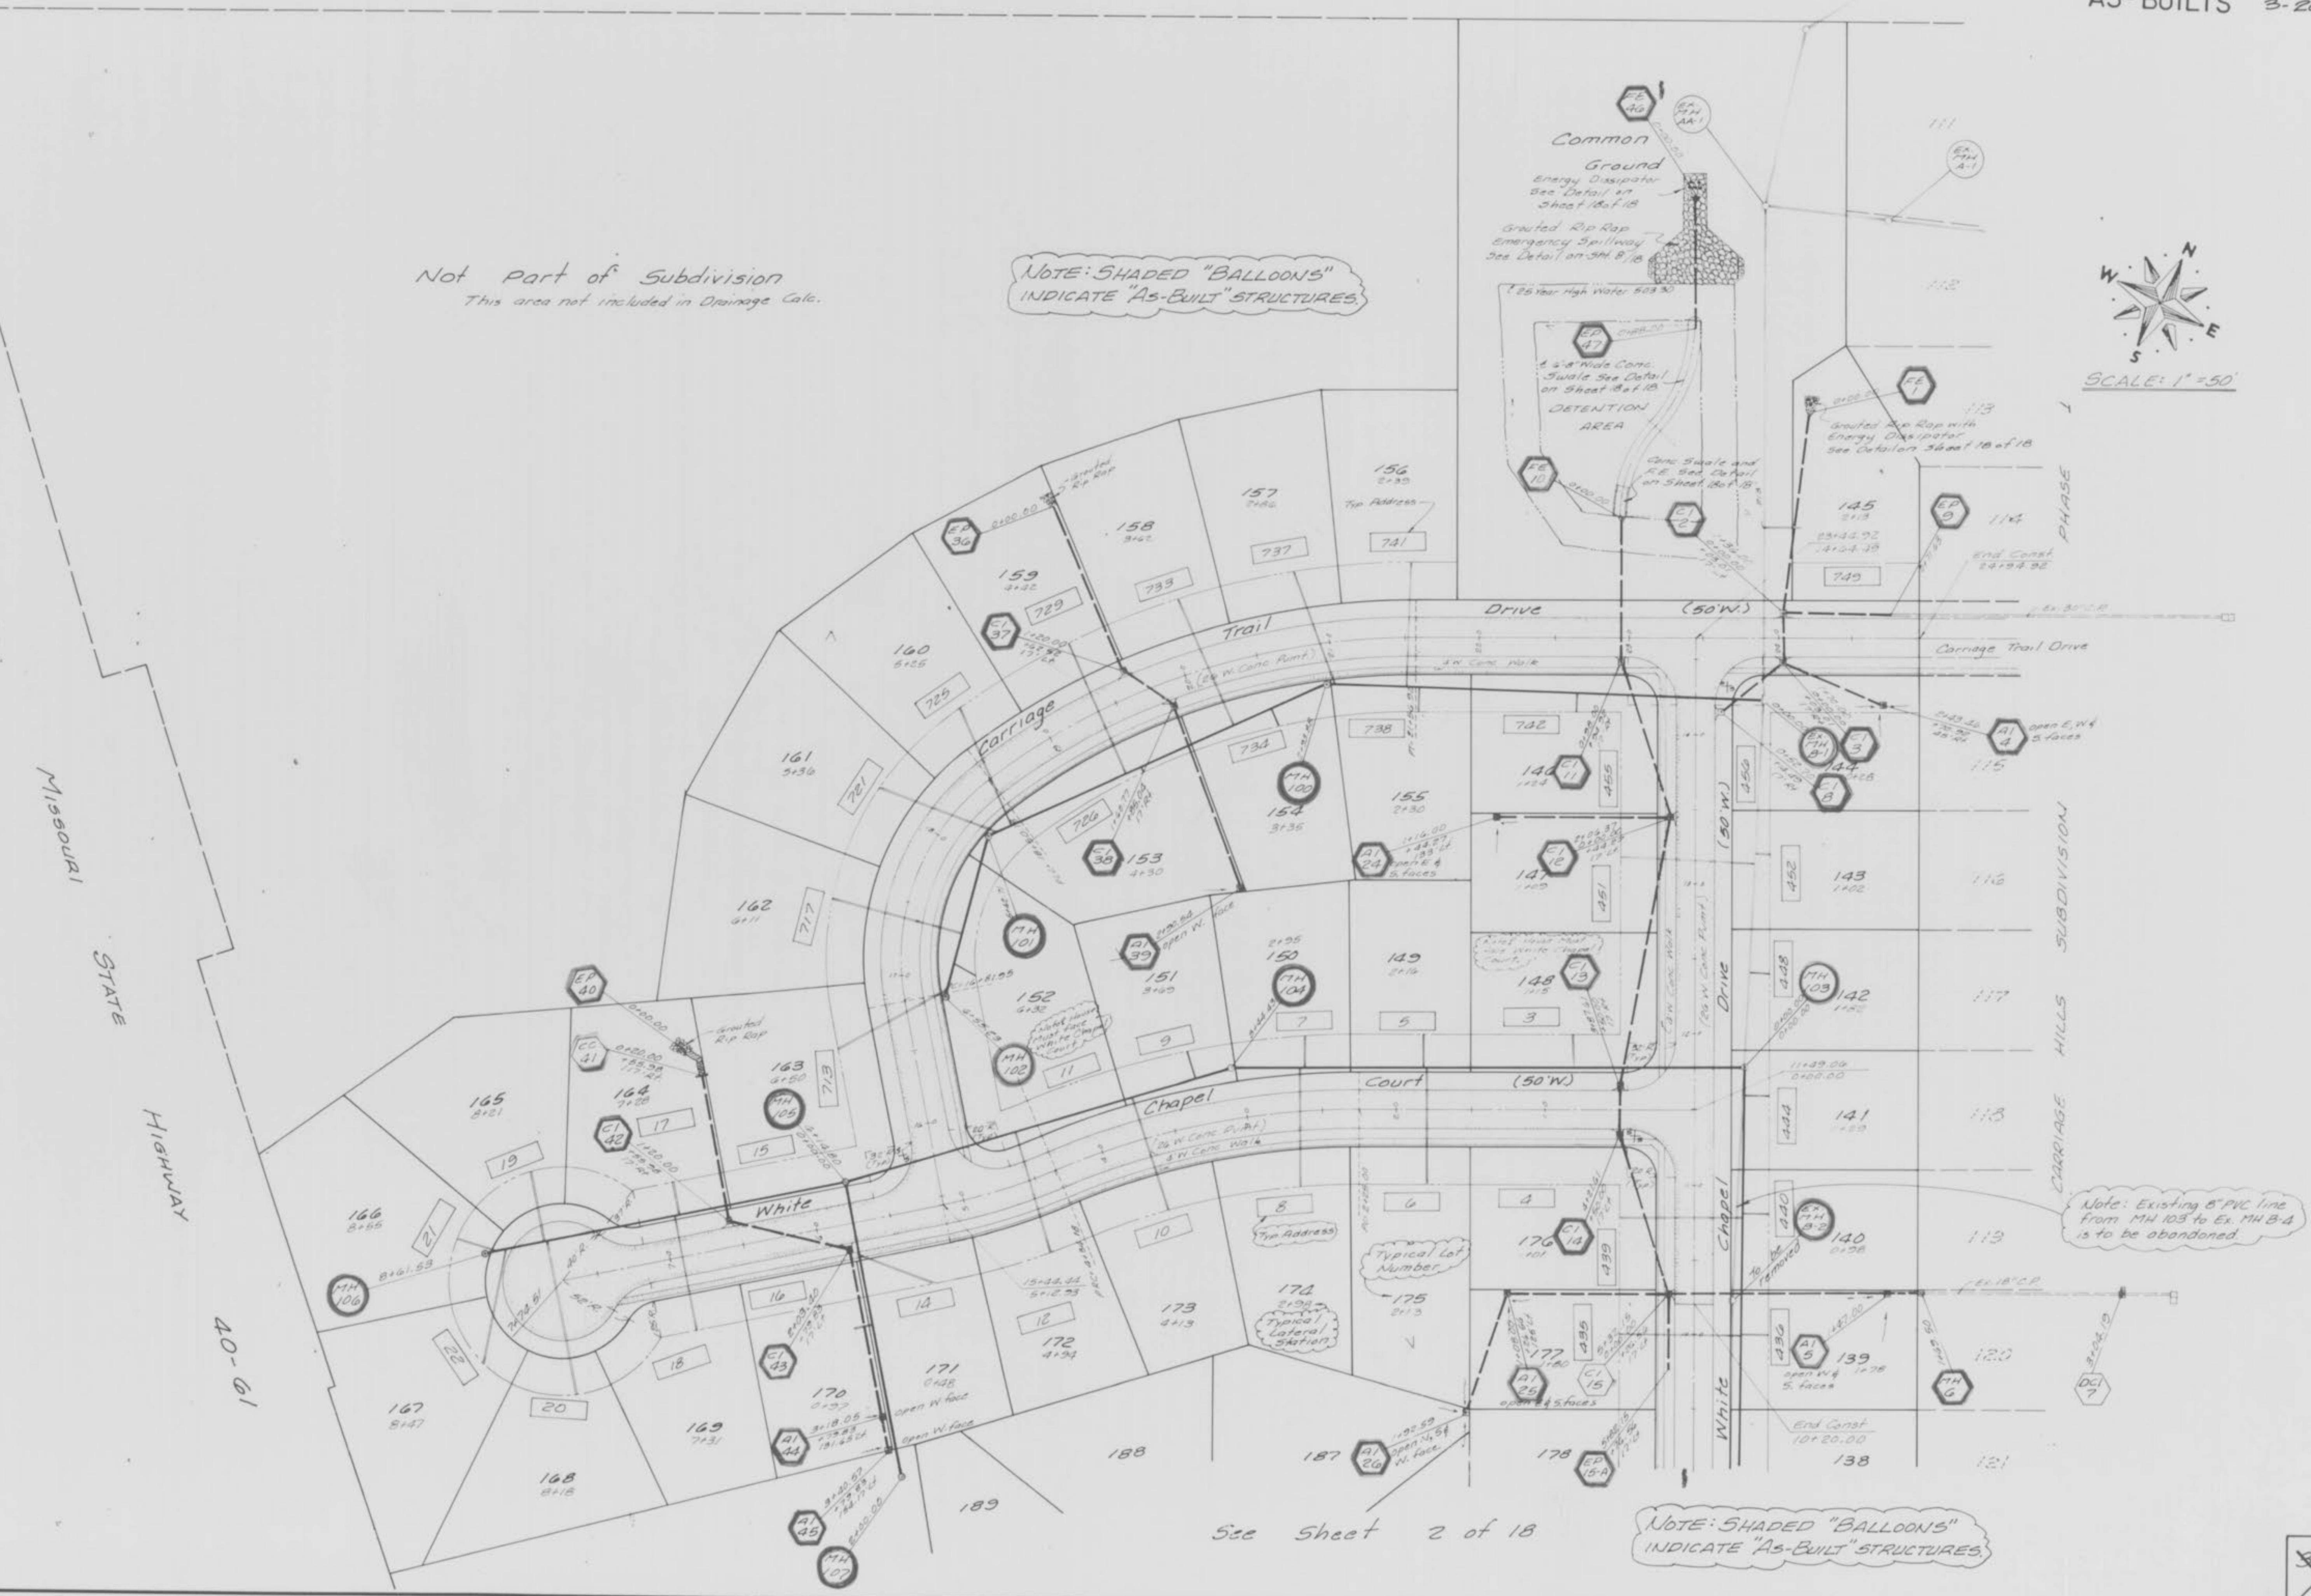


SANITARY SEWER PROFILES
CARRIAGE HILLS - PHASE 2
Aug. 1989
89-037A

"AS-BUILTS" 3-20-90

NOTE: A.B. = "AS-BUILT"

FINAL SURVEY
SURVEYED
PLOTTED
NOTE BOOK
NO.
APPROVED
DATE


ORIGINAL SURVEY
SURVEYED
PLOTTED
NOTE BOOK
NO.
APPROVED
DATE

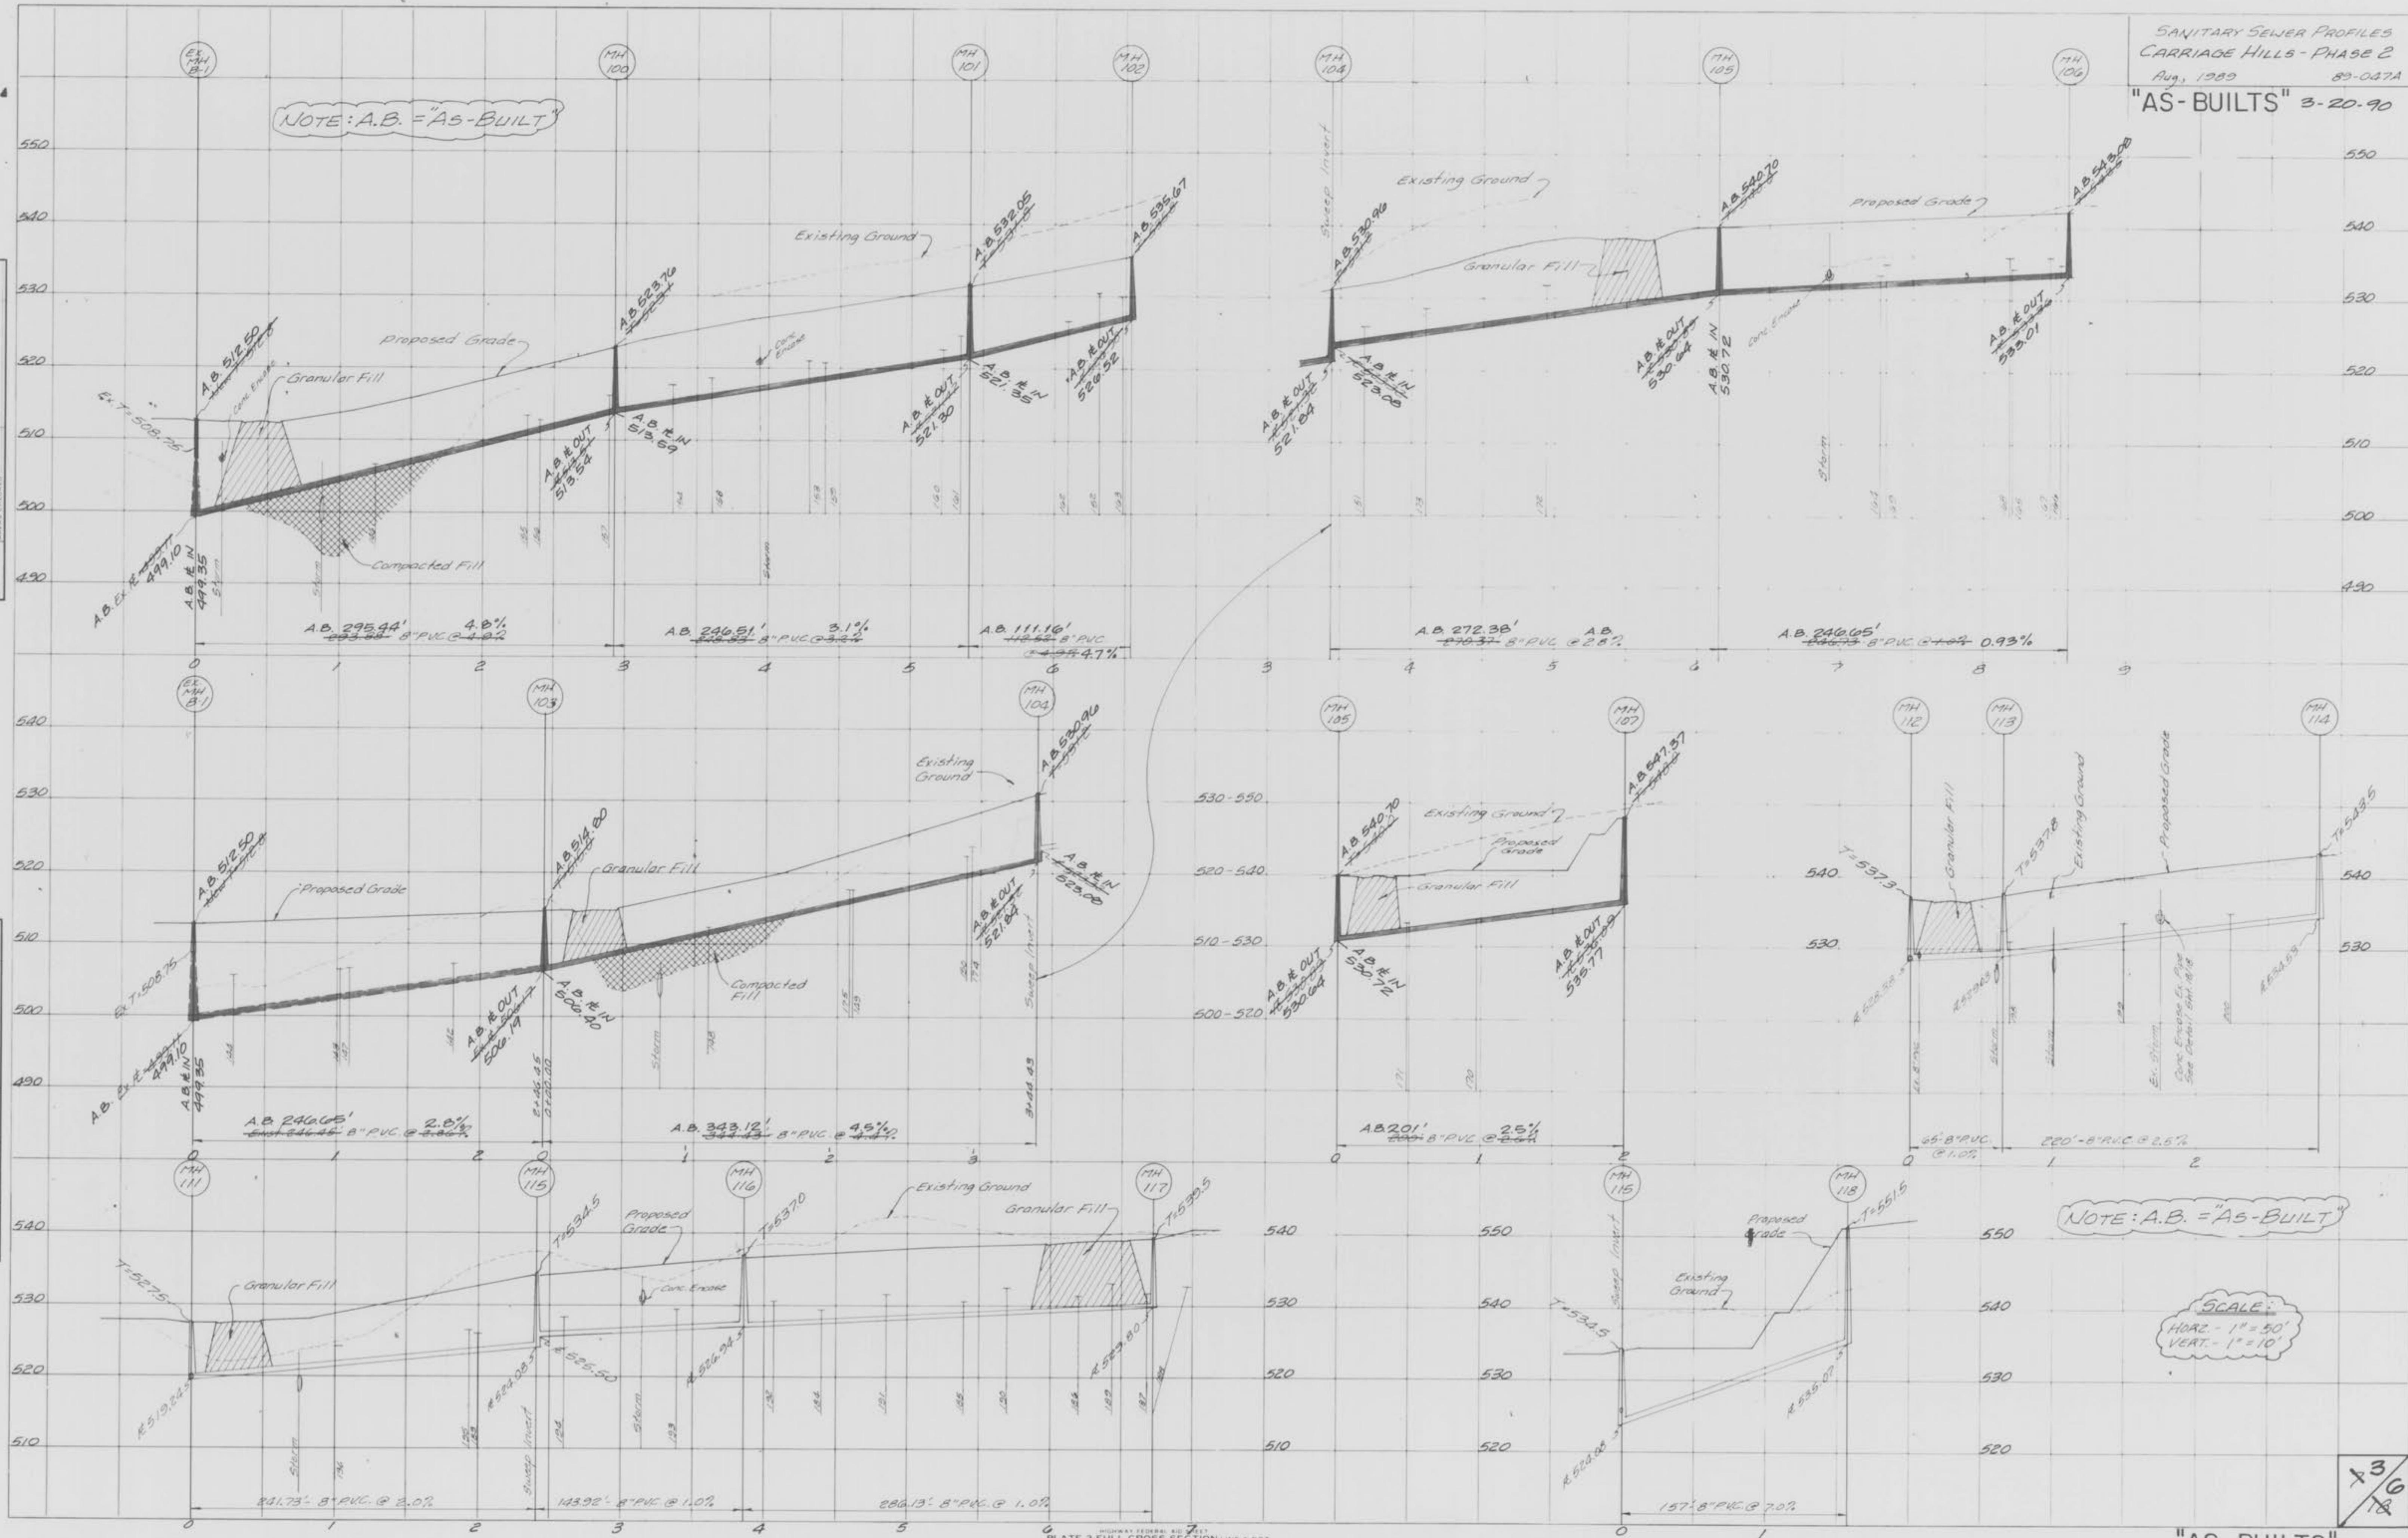

SANITARY & STORM SEWER PROFILES
CARRIAGE HILLS - PHASE 2
Aug. 1989
89-047A

"AS-BUILTS" 3-20-90

SCALE:
HORZ. - 1" = 50'
VERT. - 1" = 10'

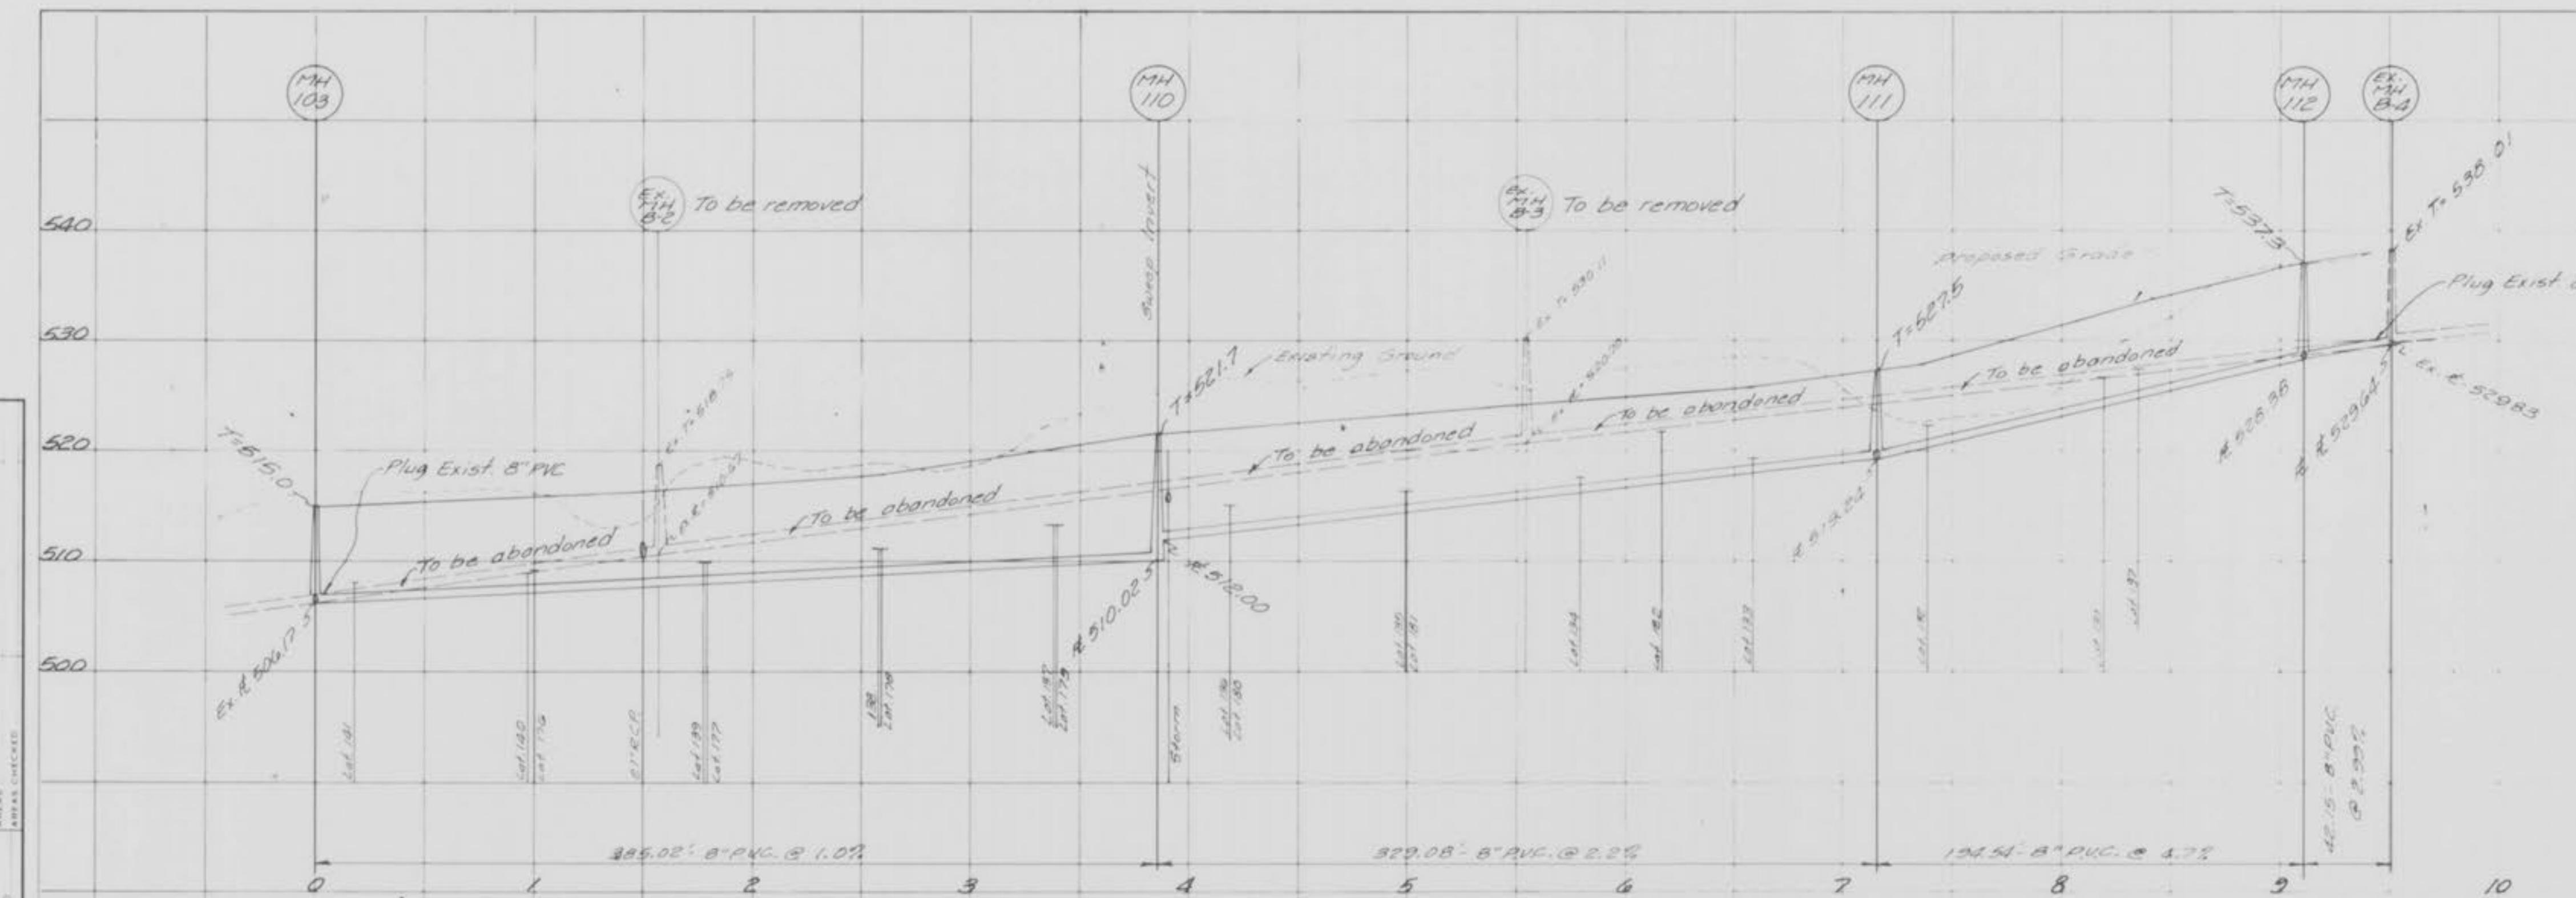

DETENTION CALCULATIONS (25 Year)

Total Area of Tract 65.97 Acres
 Area of Future Commercial 7.83 Acres
 Developed Q of Tract 65.97 Ac. @ 3.20 = 215.06 cfs.
 Undeveloped Q of Tract 65.97 Ac. @ 2.31 = 152.39 cfs.
 Differential Runoff = 62.67 cfs.
 Developed Q of Comm. 7.83 Ac. @ 4.75 = 37.19 cfs.
 Undeveloped Q of Comm. 7.83 Ac. @ 2.31 = 18.03 cfs.
 Differential Runoff = 19.10 cfs.
 Storage Required 81.77 cfs. x 1800 (30 min) = 149,180 cu ft
 Storage of Dry Pond @ elev. 503.30 = 160,403 cu ft.

OVERFLOW PIPE CALCULATIONS

Capacity of 33" C.S.P. as an orifice
 $Q = C \cdot A \cdot V_2 g h$
 $Q = 0.6 \cdot 5.94 \sqrt{2(32.2)} \cdot 7.925$
 $Q = 3.56 \sqrt{510.97}$
 $Q = 3.56 \times 22.59$
 $Q = 81.12 \text{ cfs.}$
 Constant $C = 0.6$
 $a = 5.94$
 $g = 32.2$
 $h = 7.925$


Q to Dry Pond (25 Years) = 169.87 cfs.
 Out Overflow Pipe = 80.82 cfs.
 Storage Required = 88.45 cfs.
 88.45×1800 (30 min) = 159,570 cu ft.

EMERGENCY SPILLWAY (Grouted Rip Rap)

Q to Dry Pond for 100 Year = 216.29 cfs.
 $Q = a \times \frac{1.486}{n} \times R^{3/4} \times 5^{1/4}$
 $Q = 43.55 \times \frac{1.486}{0.0225} \times 0.773 \times 0.10$
 $Q = 222.33 \text{ cfs.}$
 $a = 43.55$
 $W_P = 64.42$
 $S = 0.1 \quad S^{1/2} = 0.10$
 $R = 69.82 = 0.68 \quad R^{1/4} = 0.773$
 $n = 0.0225$

SIDE SLOPE
 $Q = a \times \frac{1.486}{n} \times R^{3/4} \times 5^{1/4}$
 $Q = 9.76 \times \frac{1.486}{0.0225} \times 0.596 \times 0.577$
 $Q = 221.46 \text{ cfs.}$
 $a = 9.76$
 $W_P = 21.10$
 $S = 0.383 \quad S^{1/2} = 0.577$
 $R = 21.10 = 0.46 \quad R^{1/4} = 0.596$
 $n = 0.0225$

(NOTE: A.B. = "AS-BUILT")

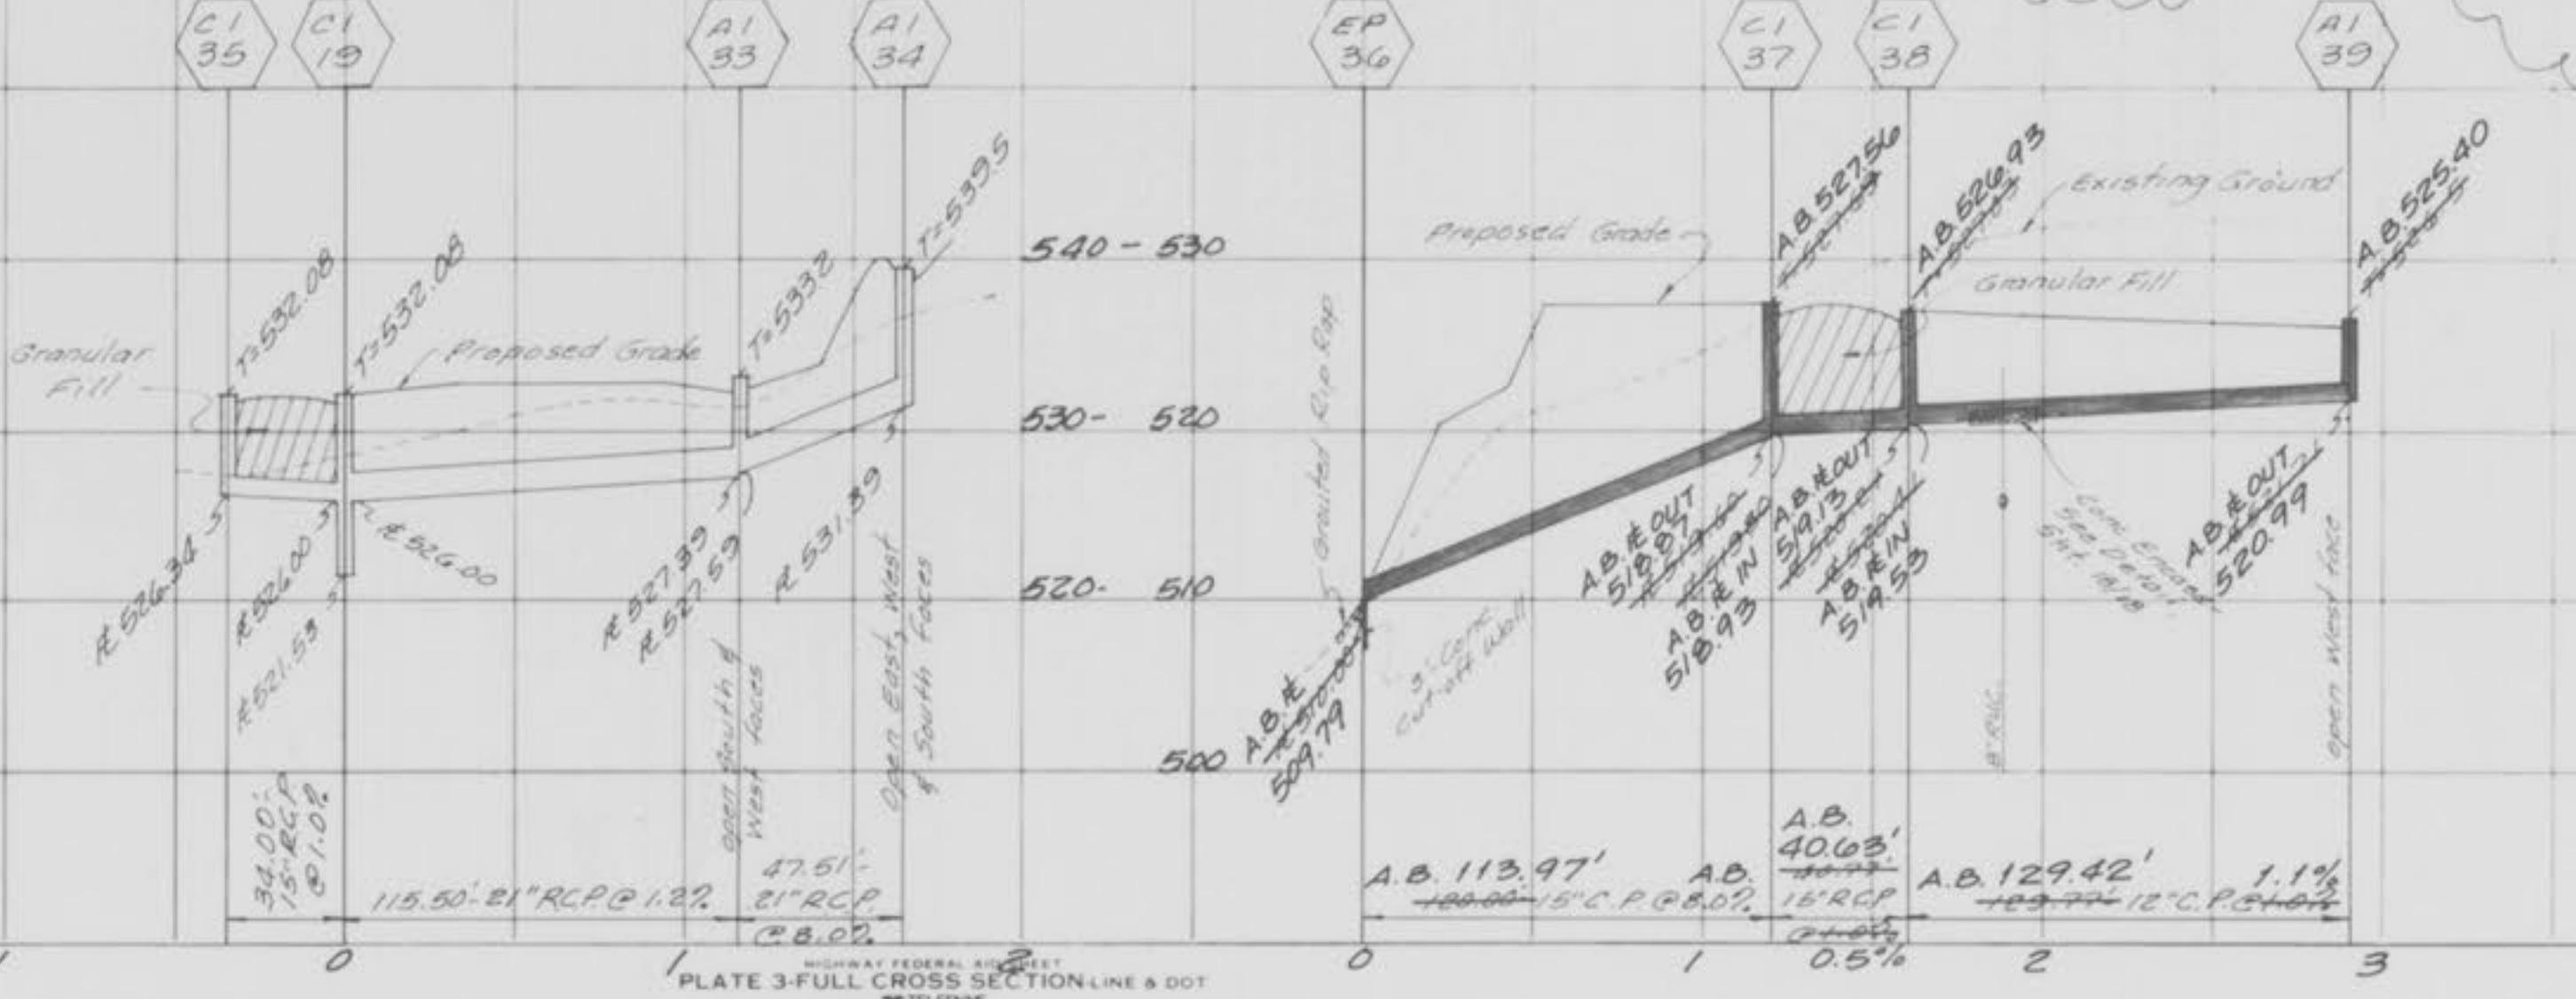

84/6
 78
 "AS-BUILTS"
 CARRIAGE HILLS PHASE II-A

Storm Sewer Profiles
CARRIAGE HILLS PHASE 2
Aug., 1989
89-047 A

"AS-BUILTS" 3-20-90

SCALE:
HORZ - 1" = 50'
VERT. - 1" = 10'

FINAL SURVEYED
SURVEYED
NOTE BOOK
TEMPERATE
AREA'S CHECKED

ORIGINAL SURVEYED
SURVEY
NOTE BOOK
TEMPERATE
AREA'S CHECKED

