


GENERAL NOTES

- Underground utilities have been plotted from available information and therefore their locations shall be considered approximate only. The verification of the location of all underground utilities, either shown or not shown on these plans, shall be the responsibility of the contractor, and shall be located prior to any grading and/or construction of improvements.
- All standard curb inlets are to have front-of-inlet 2' (two feet) behind curb, within public right-of-way, unless otherwise noted.
- ~~Storm sewers 48" diameter and smaller shall be A.S.T.M. C-144 unless otherwise shown on the plans.~~
- Storm sewers 21" diameter and larger shall be A.S.T.M. C-76, Class III minimum, unless otherwise shown on the plans.
- All storm sewer pipe in the right-of-way or easement shall be reinforced concrete pipe (A.S.T.M. C-76, Class III minimum).
- Corrugated metal pipe shall conform to the standard specifications for corrugated culvert pipe AASHTO, M38, aluminized or asphalt polymer coated.
- 8" P.V.C. sanitary sewer pipe shall meet the following standards: A.S.T.M. D-3034 SDR35, with wall thickness compression joint A.S.T.M. D-3212. An appropriate rubber seal waterproofing as approved by the sewer district shall be installed between P.V.C. pipe and masonry structures.
- All filled places, including under paved areas, under buildings, under proposed storm and sanitary sewer lines, and/or paved areas, shall be compacted to 90% of maximum density as determined by the "Modified AASHTO T-180 Compaction Test" (A.S.T.M. D1557). Test shall be verified by a soils engineer.
- All trench backfills under paved areas shall be granular backfill, and water jetted. All other trench backfills may be earth material (free of large clods or stones) and shall be water jetted.
- No slope shall be steeper than 3:1. All slopes shall be seeded and mulched.
- Barricades will be constructed per the standard specifications as shown in the "Manual of Uniform Traffic Control Devices". End of roadway markers shall be mounted 4 feet above the pavement on two pound "U" channel sign posts. Each marker shall consist of an 18" diamond panel with red reflectors.
- All construction and materials used shall conform to current City of O'Fallon Standards and Specifications.
- Easements shall be provided for storm sewers, sanitary sewers, and all utilities on the record plan. See record plan for location size, and width of easements.
- All water line construction shall conform to current St. Charles Co. Water Dist. No. 2 Standards and Specifications.
- All sanitary sewer construction shall conform to current Duckett Creek Sewer District Standards and Specifications.
- The Contractor shall prevent all storm/surface water, mud or construction debris from entering the existing sanitary sewer system.
- Erosion control shall not be limited to what is shown on the plan. The contractor shall take whatever means necessary to prevent siltation and erosion from entering adjacent roadways, properties, and ditches. Such control might include channeling runoff into sediment basins, channeling runoff into areas where an extra row of straw bales are used. A silt fence might be considered, if necessary.
- All construction and materials shall conform to O'Fallon Fire Protection District Standards.
- The minimum vertical distance from the low point of the basement to the flowline of the sanitary sewer at the corresponding house connection shall not be less than two and one half feet (2 1/2') plus the diameter of the sanitary sewer.
- The most stringent of the above requirements shall apply.
- All streets and right-of-ways shown on these improvement plans will be dedicated to the City of O'Fallon for public use forever.
- When grading operations are completed or suspended for more than 30 days, permanent grass must be established at sufficient density to provide erosion control on the site. Between permanent grass seeding periods, temporary cover shall be provided according to the City of O'Fallon Specifications.
- The contractor shall place all fire hydrants within (2') two feet of the street curb.
- The contractor shall place the "steamer" outlet of the fire hydrant toward the street.
- All sanitary sewer manholes shall be waterproofed on the exterior in accordance with Missouri D.N.R. Specification 10CSR-8.120 (7)(E).
- Any wells and/or springs which may exist on this property should be located and sealed in a manner acceptable to the City of O'Fallon.
- All existing trash and debris on-site must be removed and disposed of off-site.
- Debris and foundation material from any existing on-site building or structure which is scheduled to be razed for this development must be disposed of off-site.
- Soft soils in the bottom and banks of any existing or former pond sites or tributaries should be removed, spread out, and permitted to dry sufficiently to be used as fill. None of this material should be placed in proposed public right-of-way locations or on any storm sewer location.
- Concrete Pipe Joints shall be M.S.D. Type "A" Approved Compression Joints and shall conform to the requirements of the Specification for Joints and Circular Concrete Sewer and Culvert Pipe, using flexible, watertight, rubber-type gaskets A.S.T.M. C-443 Band-Type. Gaskets depending entirely on cement for adhesion and resistance to displacement during jointing shall not be used.
- All sewer tops built without elevations furnished by the Engineer will be the responsibility of the sewer contractor.
- Gas, water, and other underground utilities shall not conflict with the depth or horizontal location of existing and proposed sanitary and storm sewers including house laterals.
- No area shall be cleared without permission of the developer.
- All sanitary laterals shown on plan are to be constructed of 4 inch P.V.C. pipe.
- Brick shall not be used on sanitary manholes.
- All gravel for rip-rap shall be high stomp ready-mix concrete.
- The Duckett Creek Sewer District shall be notified at least 48 hours prior to construction of sanitary sewers for coordination and inspections.
- All PVC sanitary sewer pipe is to be SDR-35 or equal with "clean 1/2" to 1" granular stone bedding uniformly graded. This bedding shall extend from 4" below the pipe to springline of pipe to 6" above the top of pipe.
- All pipes shall have positive drainage through manholes. No flat base structures are allowed.
- All streets within this set of improvement plans shall be Publicly maintained.

As-Builts for  
PLAT TWO & PLAT THREE

# CHERRYWOOD PARC

A TRACT OF LAND BEING PART OF SECTION 4,  
TOWNSHIP 46 N., RANGE 3 E.,  
CITY OF O'FALLON, ST. CHARLES CO., MO.

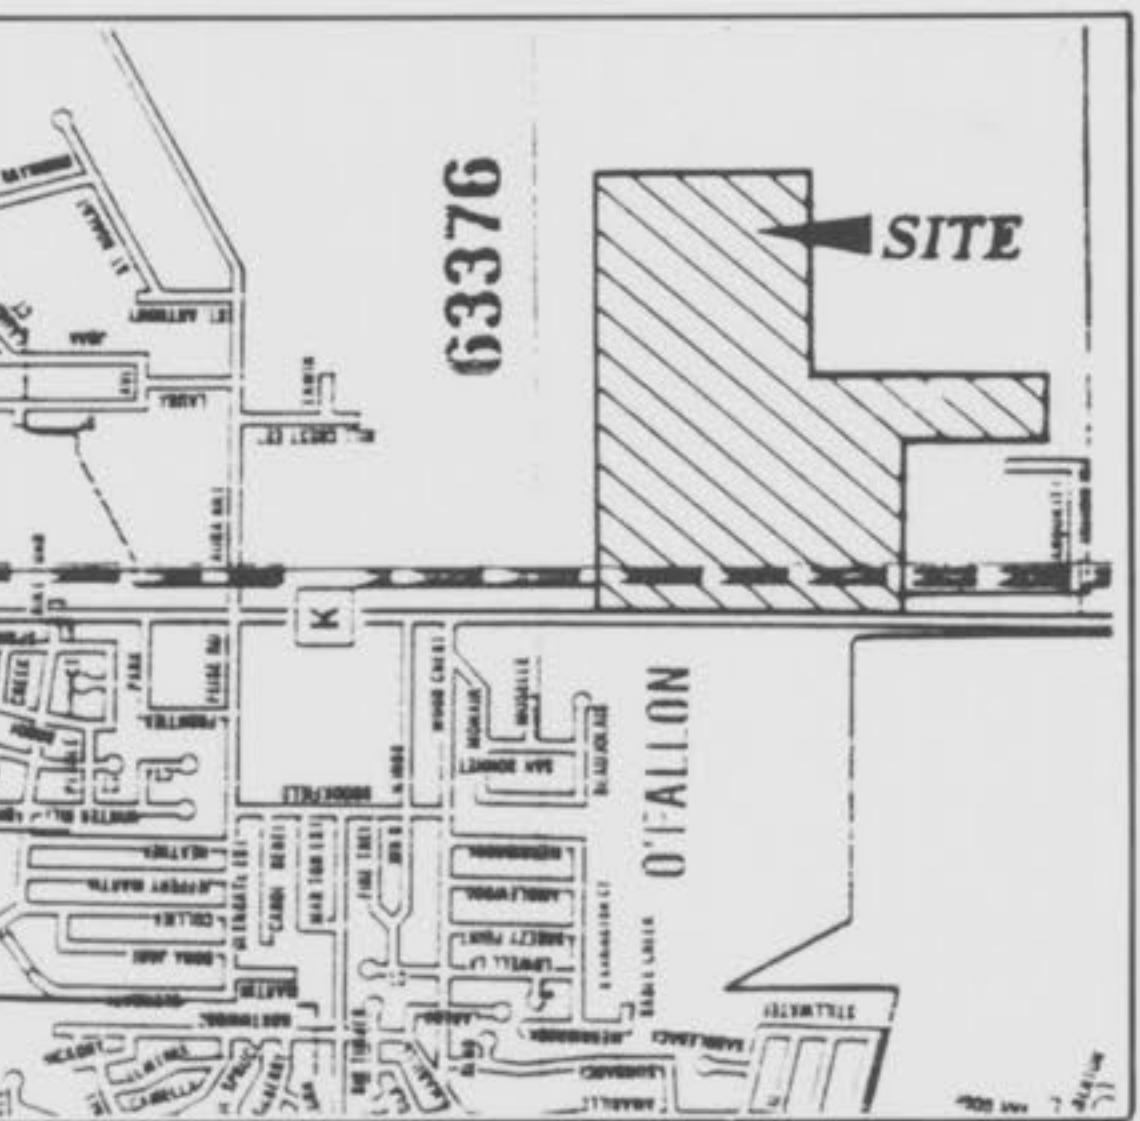

LOCATION MAP  
N.T.S.

PROJECT BENCHMARK  
FIRE HYDRANT AT S.E. CORNER  
OF DARDENNE ELEMENTARY SCHOOL  
'M' IN MUELLER  
U.S.G.S. DATUM ELEV. 574.74

DEVELOPMENT NOTES:

- AREA OF TRACT 95.01
- PRESENT ZONING R-4 SINGLE FAMILY RESIDENTIAL
- PROPOSED USE SINGLE FAMILY RESIDENTIAL SUBD.
- TOTAL LOTS PROPOSED 323
- MINIMUM LOT AREA 7,500 SQ.FT.
- SITE IS LOCATED IN OR IS SERVED BY THE FOLLOWING:

WATER DISTRICT - ST. CHARLES CO. WATER DISTRICT NO. 2  
SANITARY - DUCKETT CRK. SEWER DISTRICT  
ELECTRIC - UNION ELECTRIC CO.  
GAS - ST. CHARLES GAS CO.  
TELEPHONE - G.T.E.

7. MINIMUM SETBACK REQUIREMENTS

FRONT YARD = 25 FEET  
SIDE YARD = 6 FEET  
REAR YARD = 25 FEET

- THE DEVELOPER SHALL COMPLY WITH CURRENT TREE PRESERVATION ORDINANCE NO. 1689 AND PROVIDE LANDSCAPING AS SET FORTH IN ARTICLE 23 OF THE CITY OF O'FALLON ZONING ORDINANCE.



ST. CHARLES ENGINEERING AND SURVEYING

*Michael Newell Meiners*  
MICHAEL NEWELL MEINERS  
MISSOURI PROFESSIONAL ENGINEER NUMBER E-22483

LEGEND

	BUILDING LINE
	EXISTING SANITARY SEWER
	PROPOSED SANITARY SEWER
	EXISTING STORM SEWER
	PROPOSED STORM SEWER
	EXISTING CONTOUR
	PROPOSED CONTOUR
	EXISTING WOOD AREA
	SILTATION CONTROL
	CREEK OR DITCH
	FLOWLINE
	GAS MAIN
	TELEPHONE CABLE
	WATER MAIN
	UNDERGROUND ELECTRIC
	OVERHEAD ELECTRIC
	STREET SIGN
	GENERAL SURFACE DRAINAGE
	LIGHT STANDARD
	CLEARING AND GRADING LIMITS
	STORM SEWER DESIGNATOR
	SANITARY MANHOLE DESIGNATOR

## SHEET INDEX

COVER SHEET	1
FLAT PLAN	2 thru 3
<del>GRADING PLAN</del>	<del>1 thru 5</del>
<del>SILTATION PLAN</del>	<del>(not part of improvement plans)</del>
<del>STREET PROFILES</del>	<del>6 thru 7</del>
<del>SANITARY SEWER PROFILES</del>	<del>8 thru 9</del>
<del>STORM SEWER PROFILES</del>	<del>10 thru 11</del>
<del>DRAINAGE AREA MAP</del>	<del>12 thru 13</del>
<del>CONSTRUCTION DETAILS</del>	<del>14 thru 19</del>

PREPARED FOR


OWEN & SONS DEVELOPMENT CO.  
235 JUNGERMAN RD. SUITE 207  
ST. PETERS, MO. 63376

SANITARY & STORM AS-BUILTS  
(AS SHOWN ON PROFILES)

Revised 7/1/95 D.C. Sewer, 9/29/95, 11/16/95, 1/29/96	Sheet 1 of 19
Order No. 94-306	
Date 8/21/95	
Off. 947-0607, Fax 947-2448	
SIC ST. CHARLES ENGINEERING & SURVEYING	
801 South Fifth Street, Suite 202	
St. Charles, Missouri 63301	
As-Bu Hs Plat 2 1/2	

**CHERRYWOOD PARC  
PLAT TWO & PLAT THREE  
FLAT PLAN  
UG. 21 , 1995 94-306**

SCALE: 1" = 50'

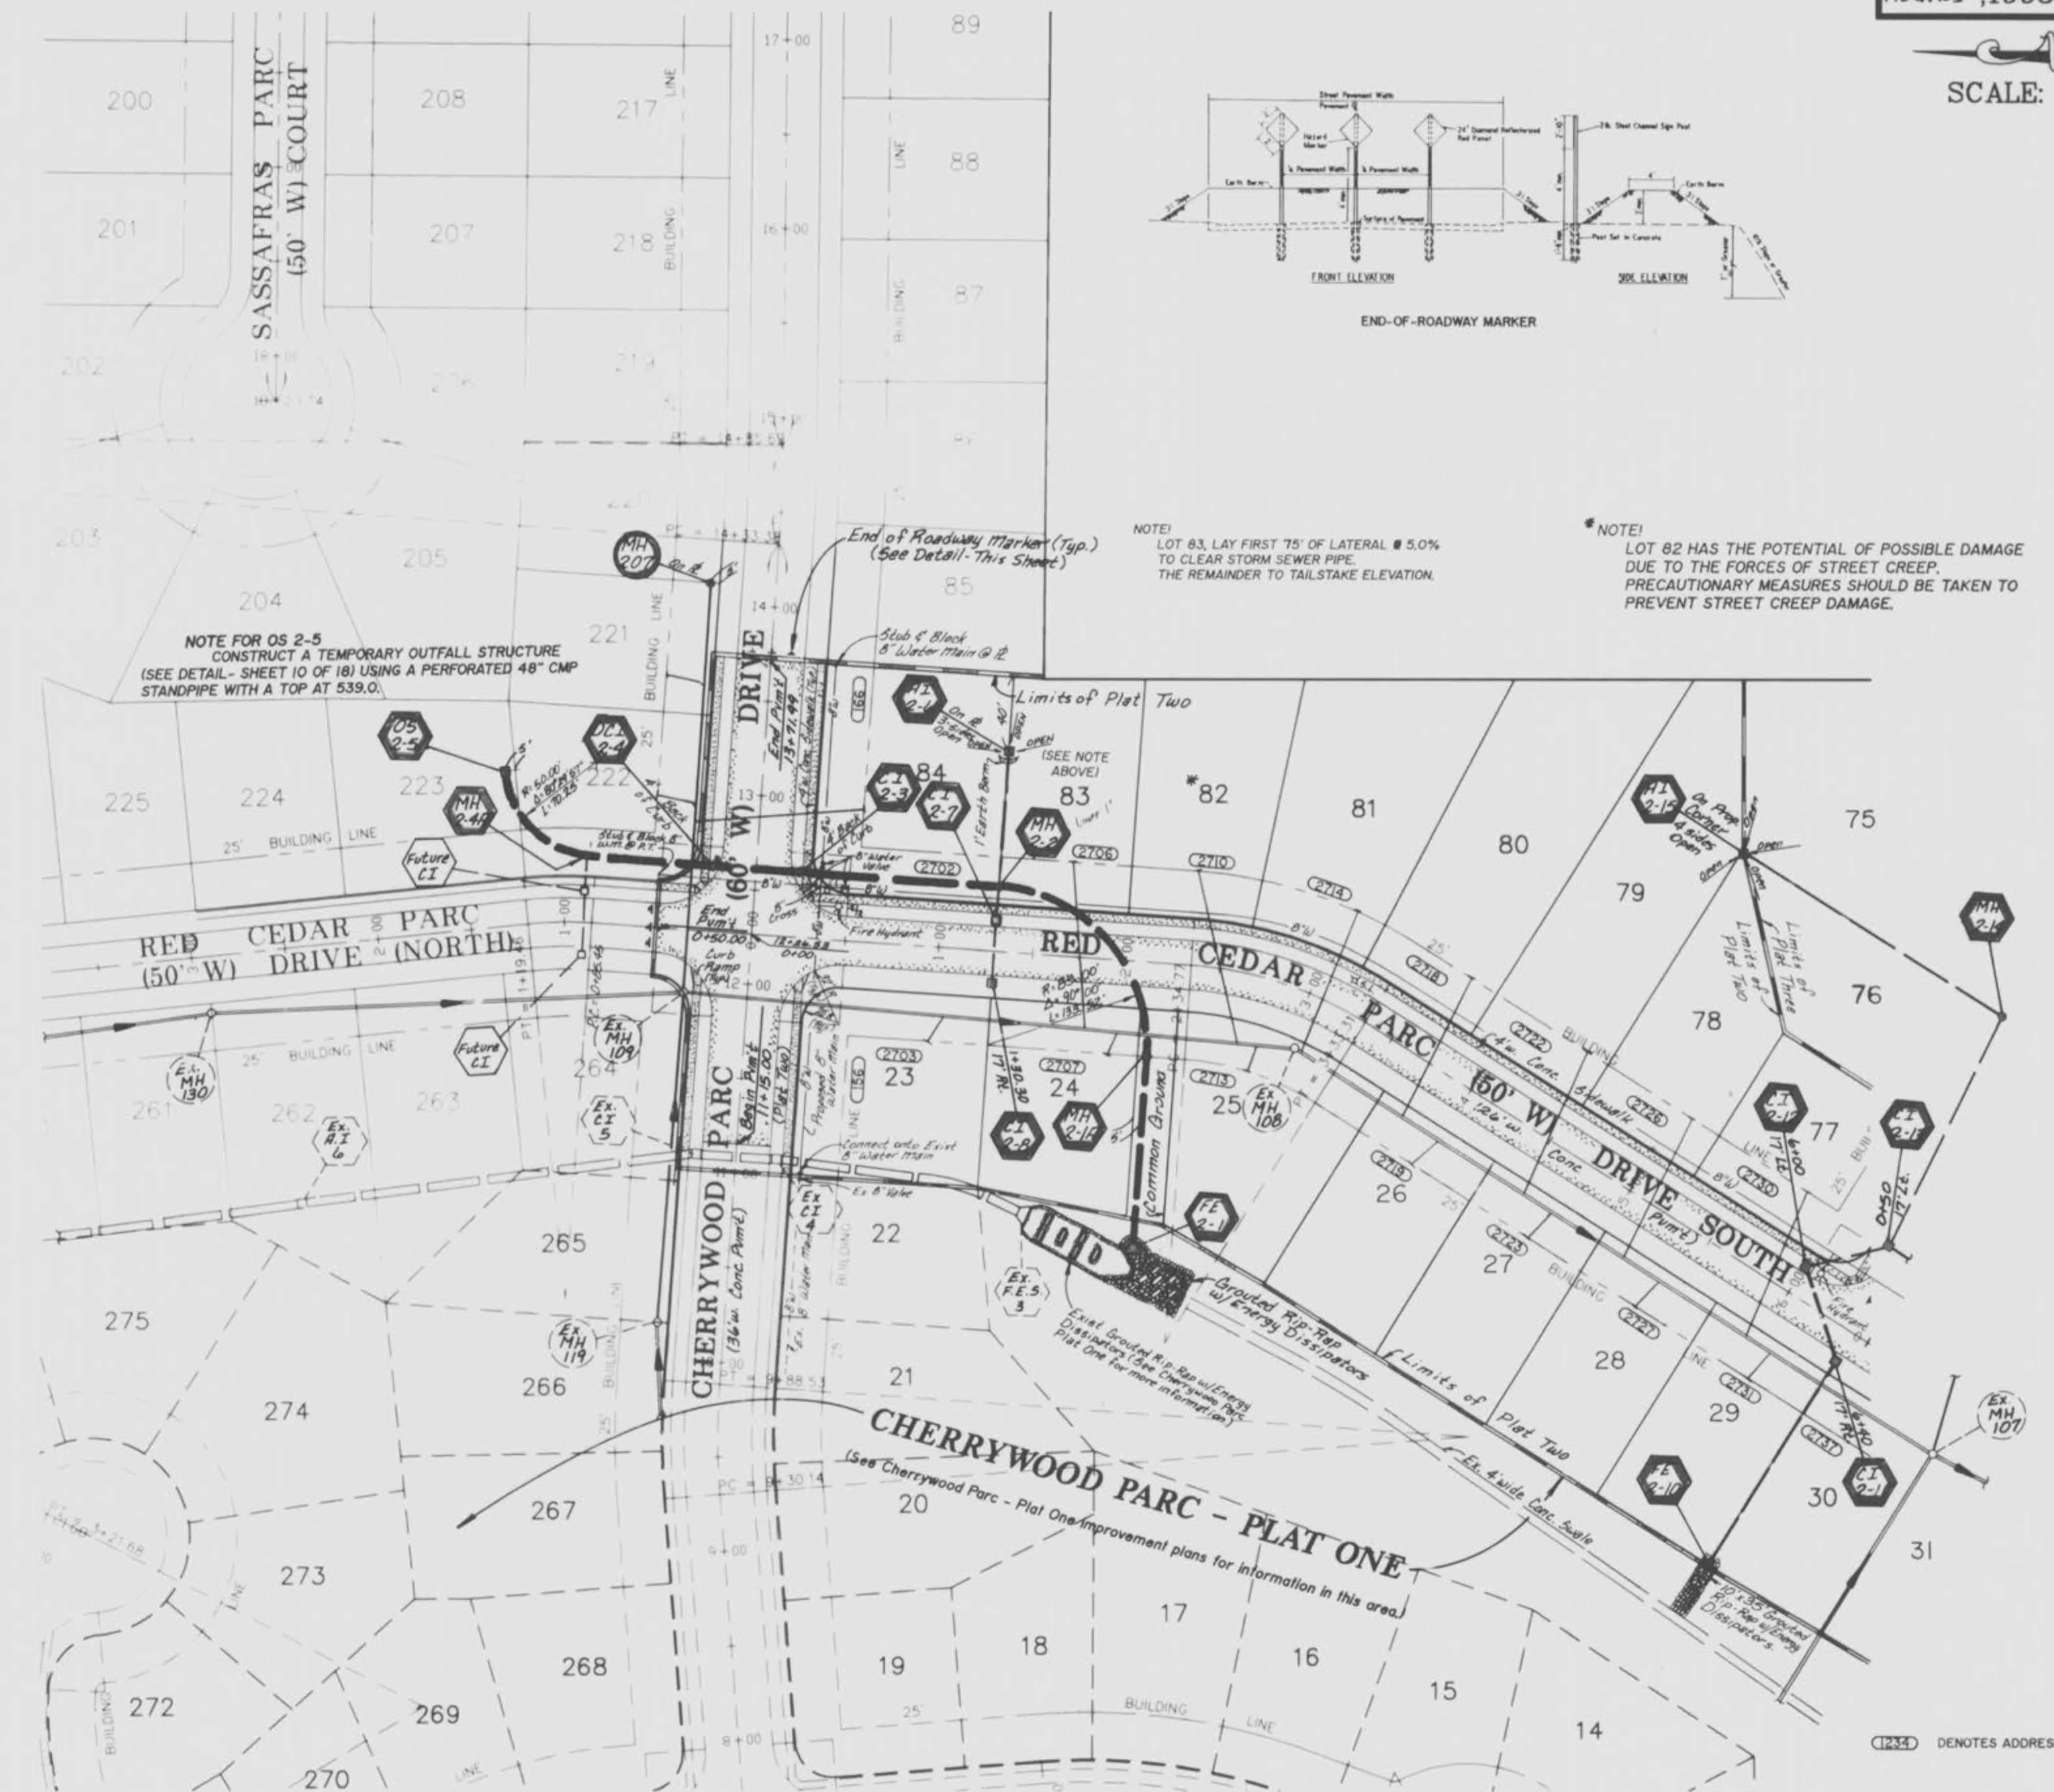

**CHERRYWOOD PARC  
PLAT TWO & PLAT THREE**

REVISED 9/1/95, 9/29/95, 10/6/95, 11/6/95

CHARLES ENGINEERING & SURVEYING  
101 S. FIFTH STREET, SUITE 202 ST. CHARLES, MO 63301  
TEL:(314) 947-0607 FAX:(314) 947-2448

SHEET 2 OF 19	
<b>YING</b> try wood arc ults P.2 /6	<b>ORDER NO.</b> 94-306
	<b>DATE</b> 8/21/95


CHERRYWOOD PARC  
PLAT TWO & PLAT THREE  
FLAT PLAN  
AUG. 21, 1994 94-306

SCALE: 1" = 50'

PROPERTY LINE OF KARLAN  
(R-1A)

N 00°00'48" W

1314.78'

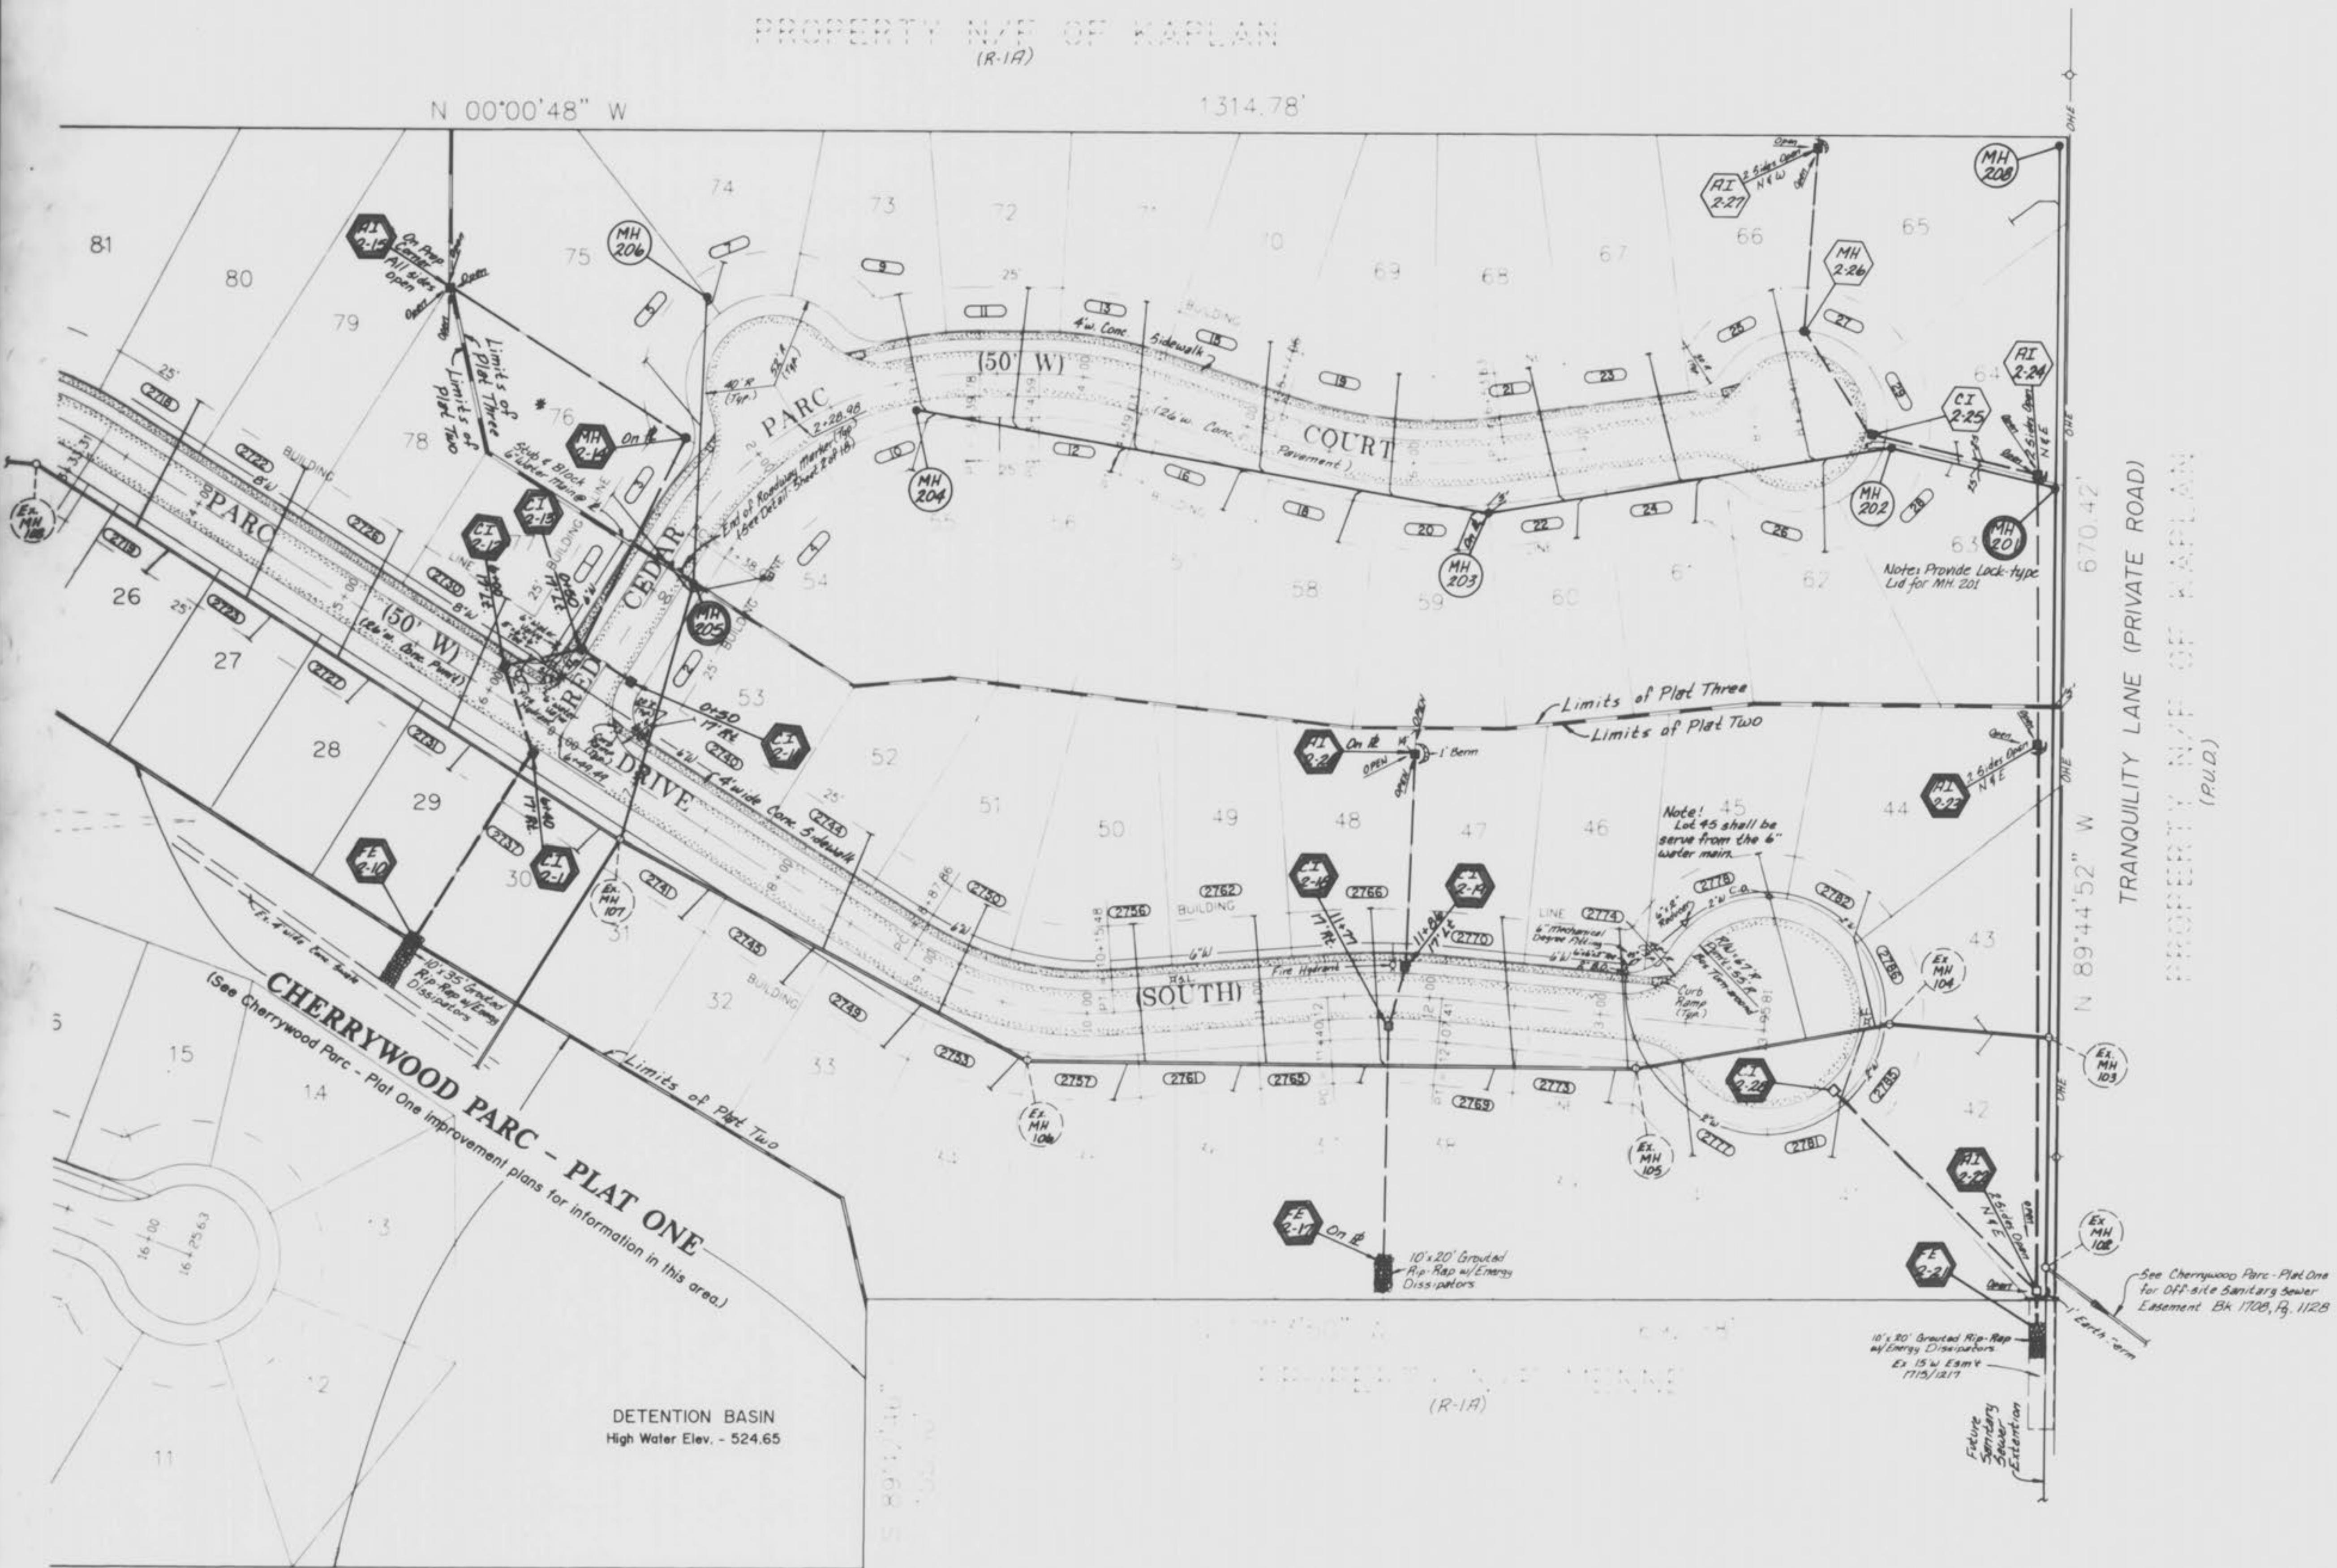

(224) DENOTES ADDRESS

N 00°08'29" W

5°36'

\* NOTE!  
LOT 76 HAS THE POTENTIAL OF POSSIBLE DAMAGE  
DUE TO THE FORCES OF STREET CREEP.  
PRECAUTIONARY MEASURES SHOULD BE TAKEN TO  
PREVENT STREET CREEP DAMAGE.

JAN 29, 1996  
SANCY & STORM AS-BUILTS  
(AS SHOWN ON PROFILES)

CHERRYWOOD PARC  
PLAT TWO & PLAT THREE

REVISED 9/1/95 per D.C.Sewer, 9/29/95, 10/16/95, 11/16/95		SHEET 3 OF 19
S C E S	ST. CHARLES ENGINEERING & SURVEYING 801 S. FIFTH STREET, SUITE 202 ST. CHARLES, MO 63301 As-Builts Plat 2 TEL: (314) 947-0660 FAX: (314) 947-3448	ORDER NO. 94-306 DATE 01/1995 3/16

## PLAT TWO





## PLAT THREE

**CHERRYWOOD PARC  
PLAT TWO & PLAT THREE  
SANITARY SEWER PROFILES**


Scales: Hor. 1" = 50'  
Rev. 9/1/95  
Vert. 1" = 10'  
Rev. 9/29/95

FINAL SURVEY	RECEIVED
DATE	BY
NOTICE BOOK NO.	STAMPED
ORIGINAL SURVEY PLOTTED	TEMPLATE
NOTICE BOOK NO.	ARSENAL CHECKED

ORIGINAL SURVEY PLOTTED	DATE
NOTICE BOOK NO.	BY
ORIGINAL SURVEY PLOTTED	TEMPLATE
NOTICE BOOK NO.	ARSENAL CHECKED

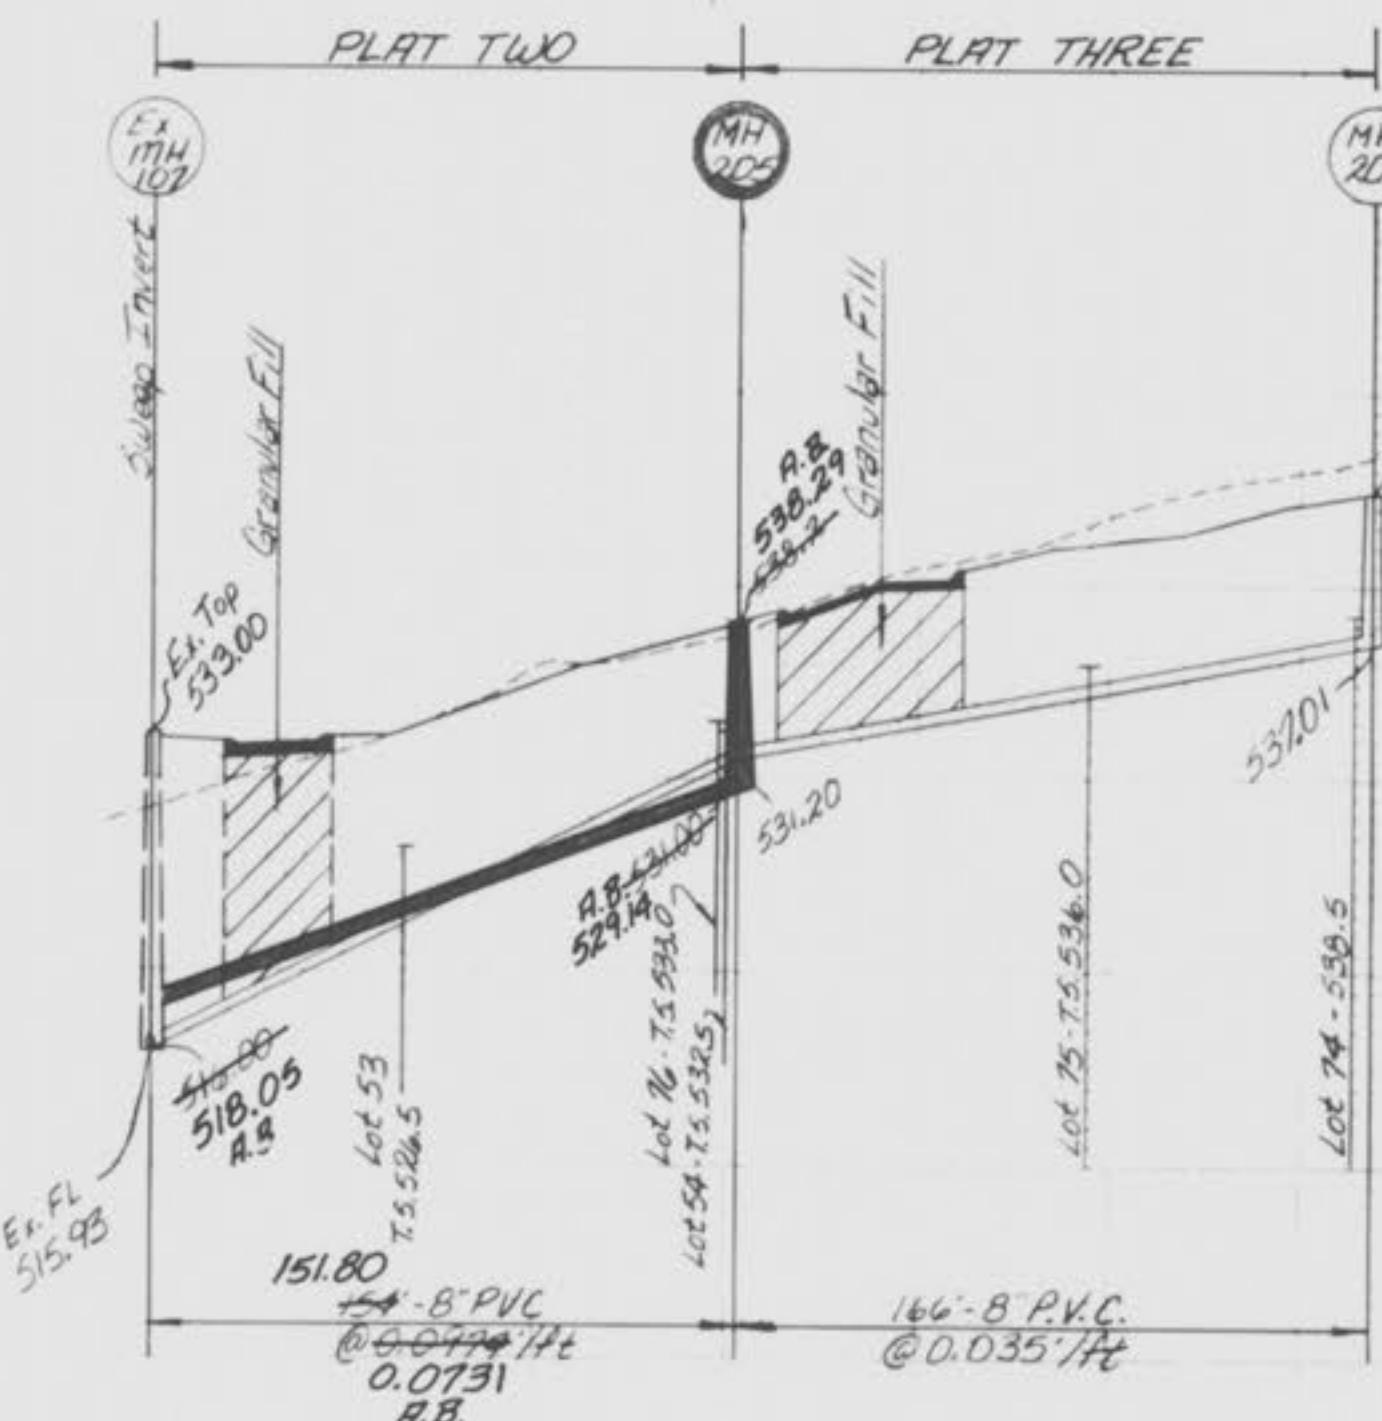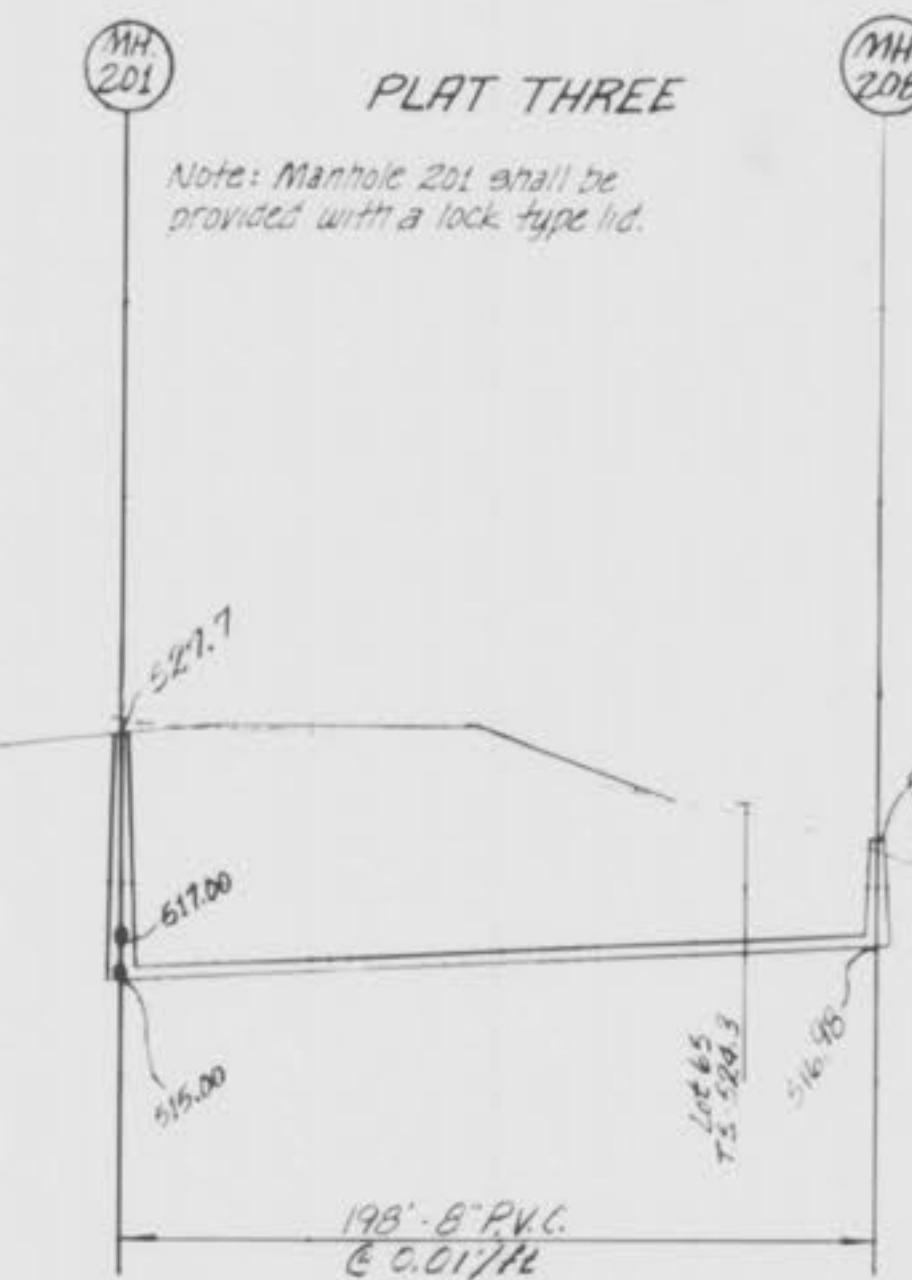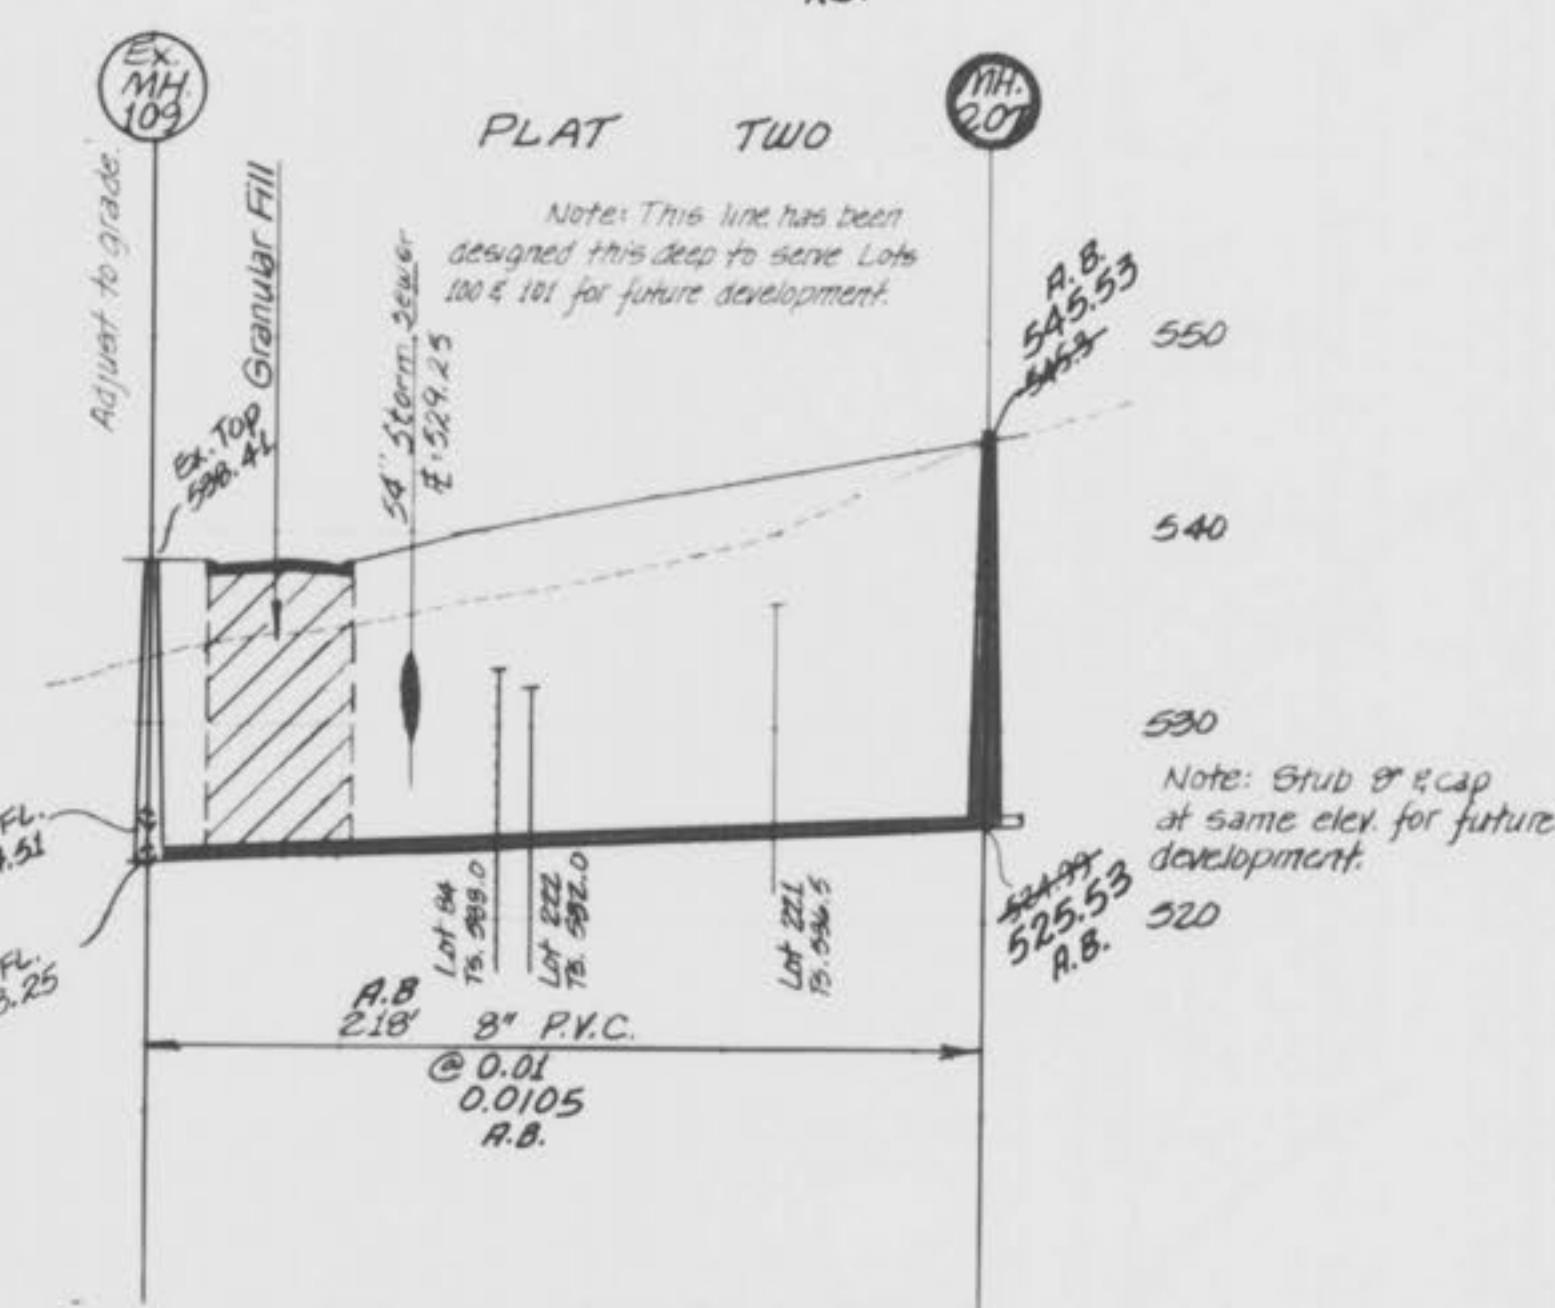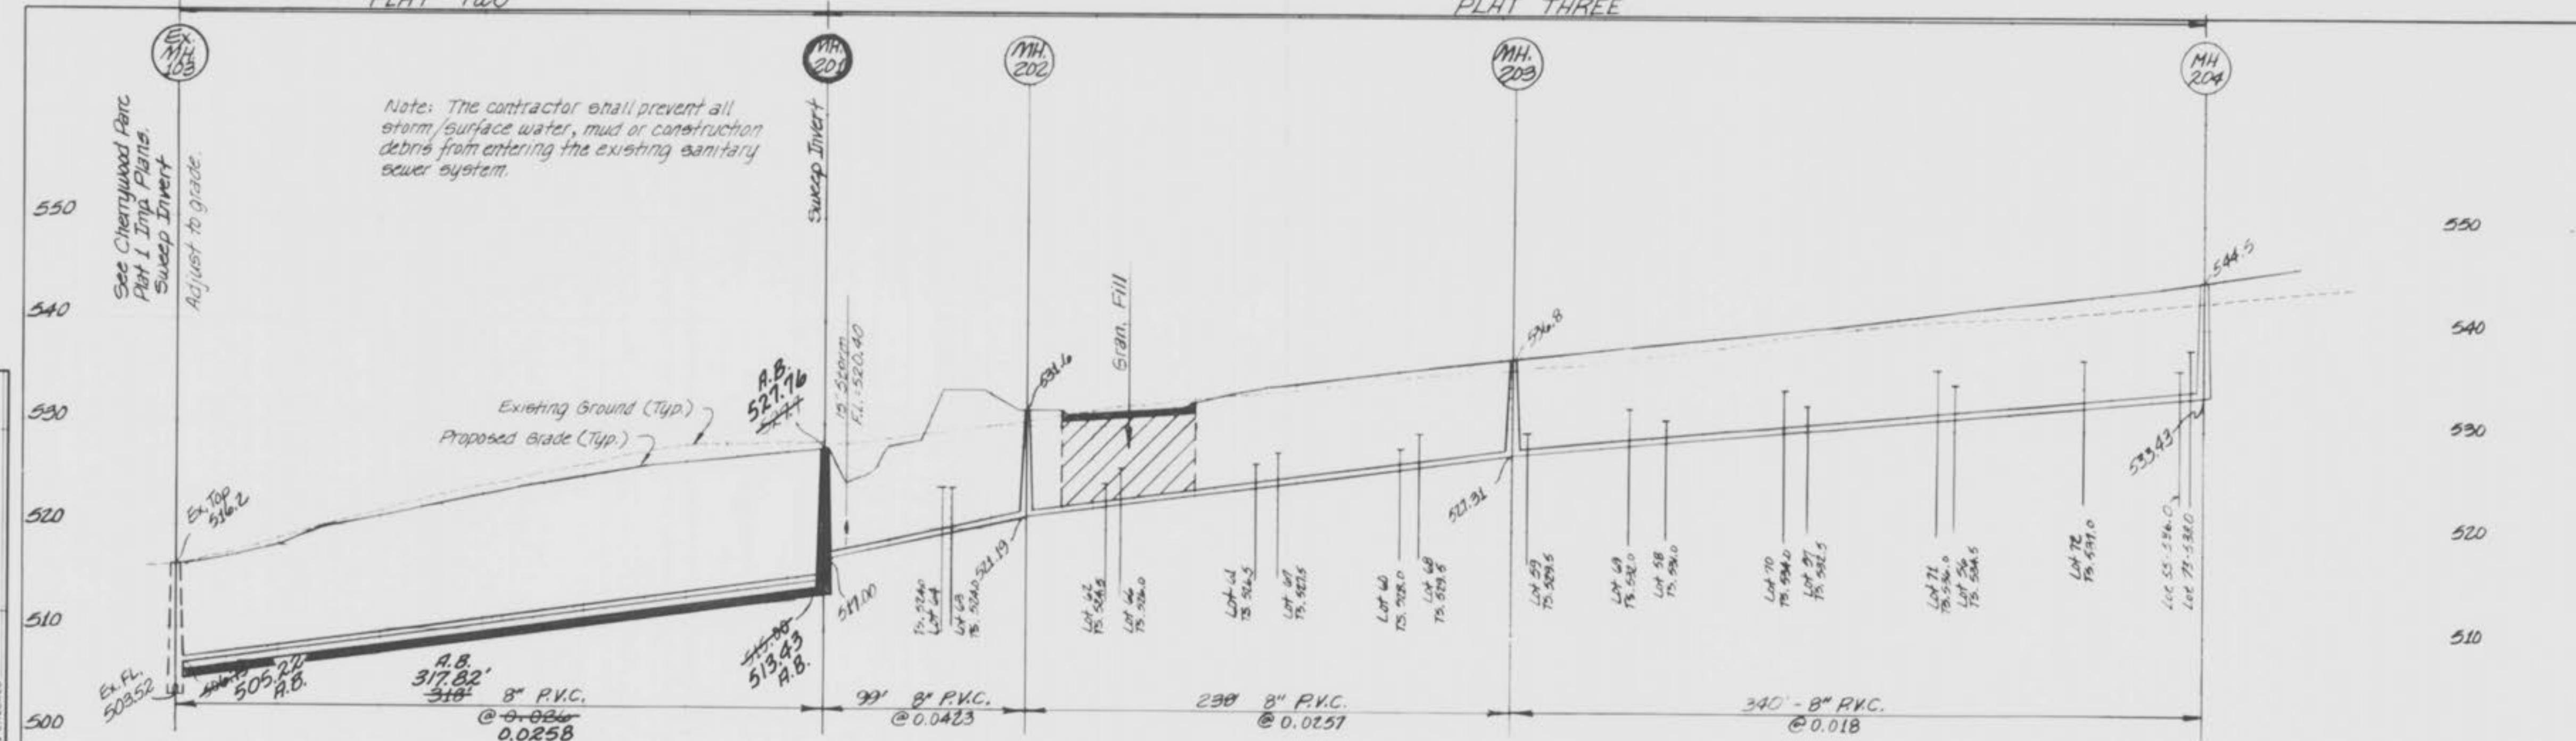

FINAL SURVEY	SURVEYED PLOTTED	BY	DATE

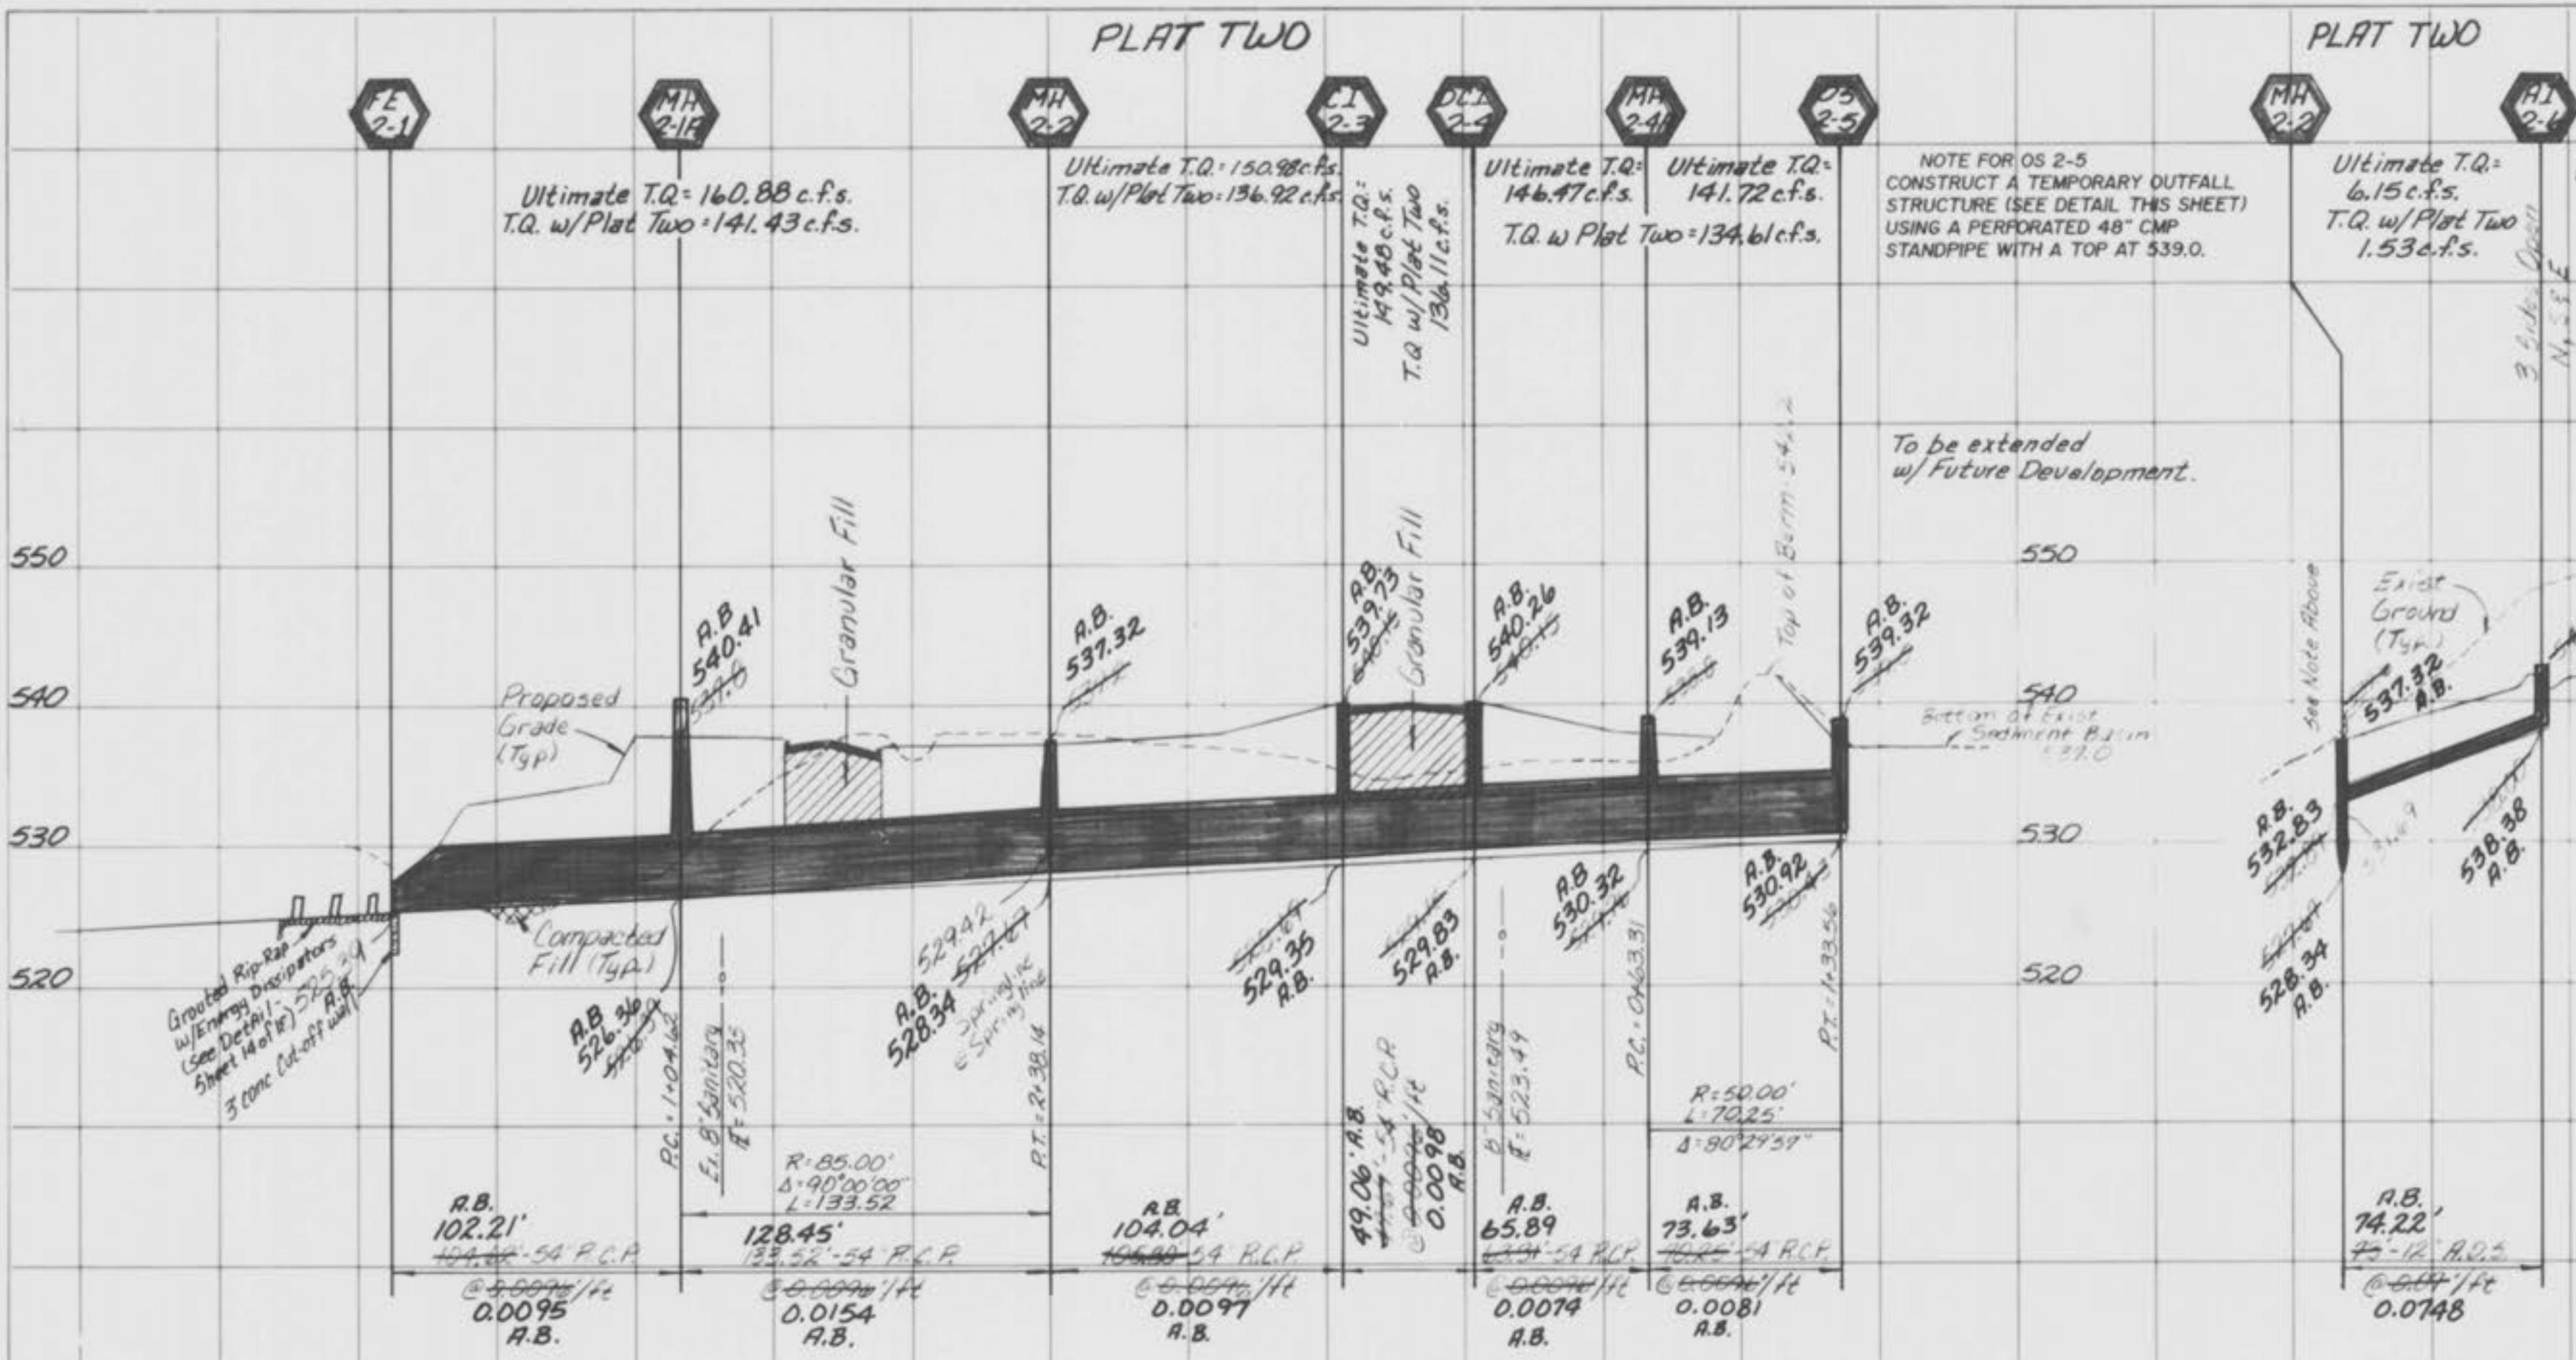


Rev 11/6/95 - City of O'Fallon

**CHERRYWOOD PARC  
PLAT TWO & PLAT THREE  
STORM SEWER PROFILES**

scale: Horiz. 1" = 50'  
Vert. 1" = 10'

ORIGINAL SURVEY	SURVEYED BLOTTED	BY _____	DATE _____
		NOTE BOOK	TEMPLATE AREA

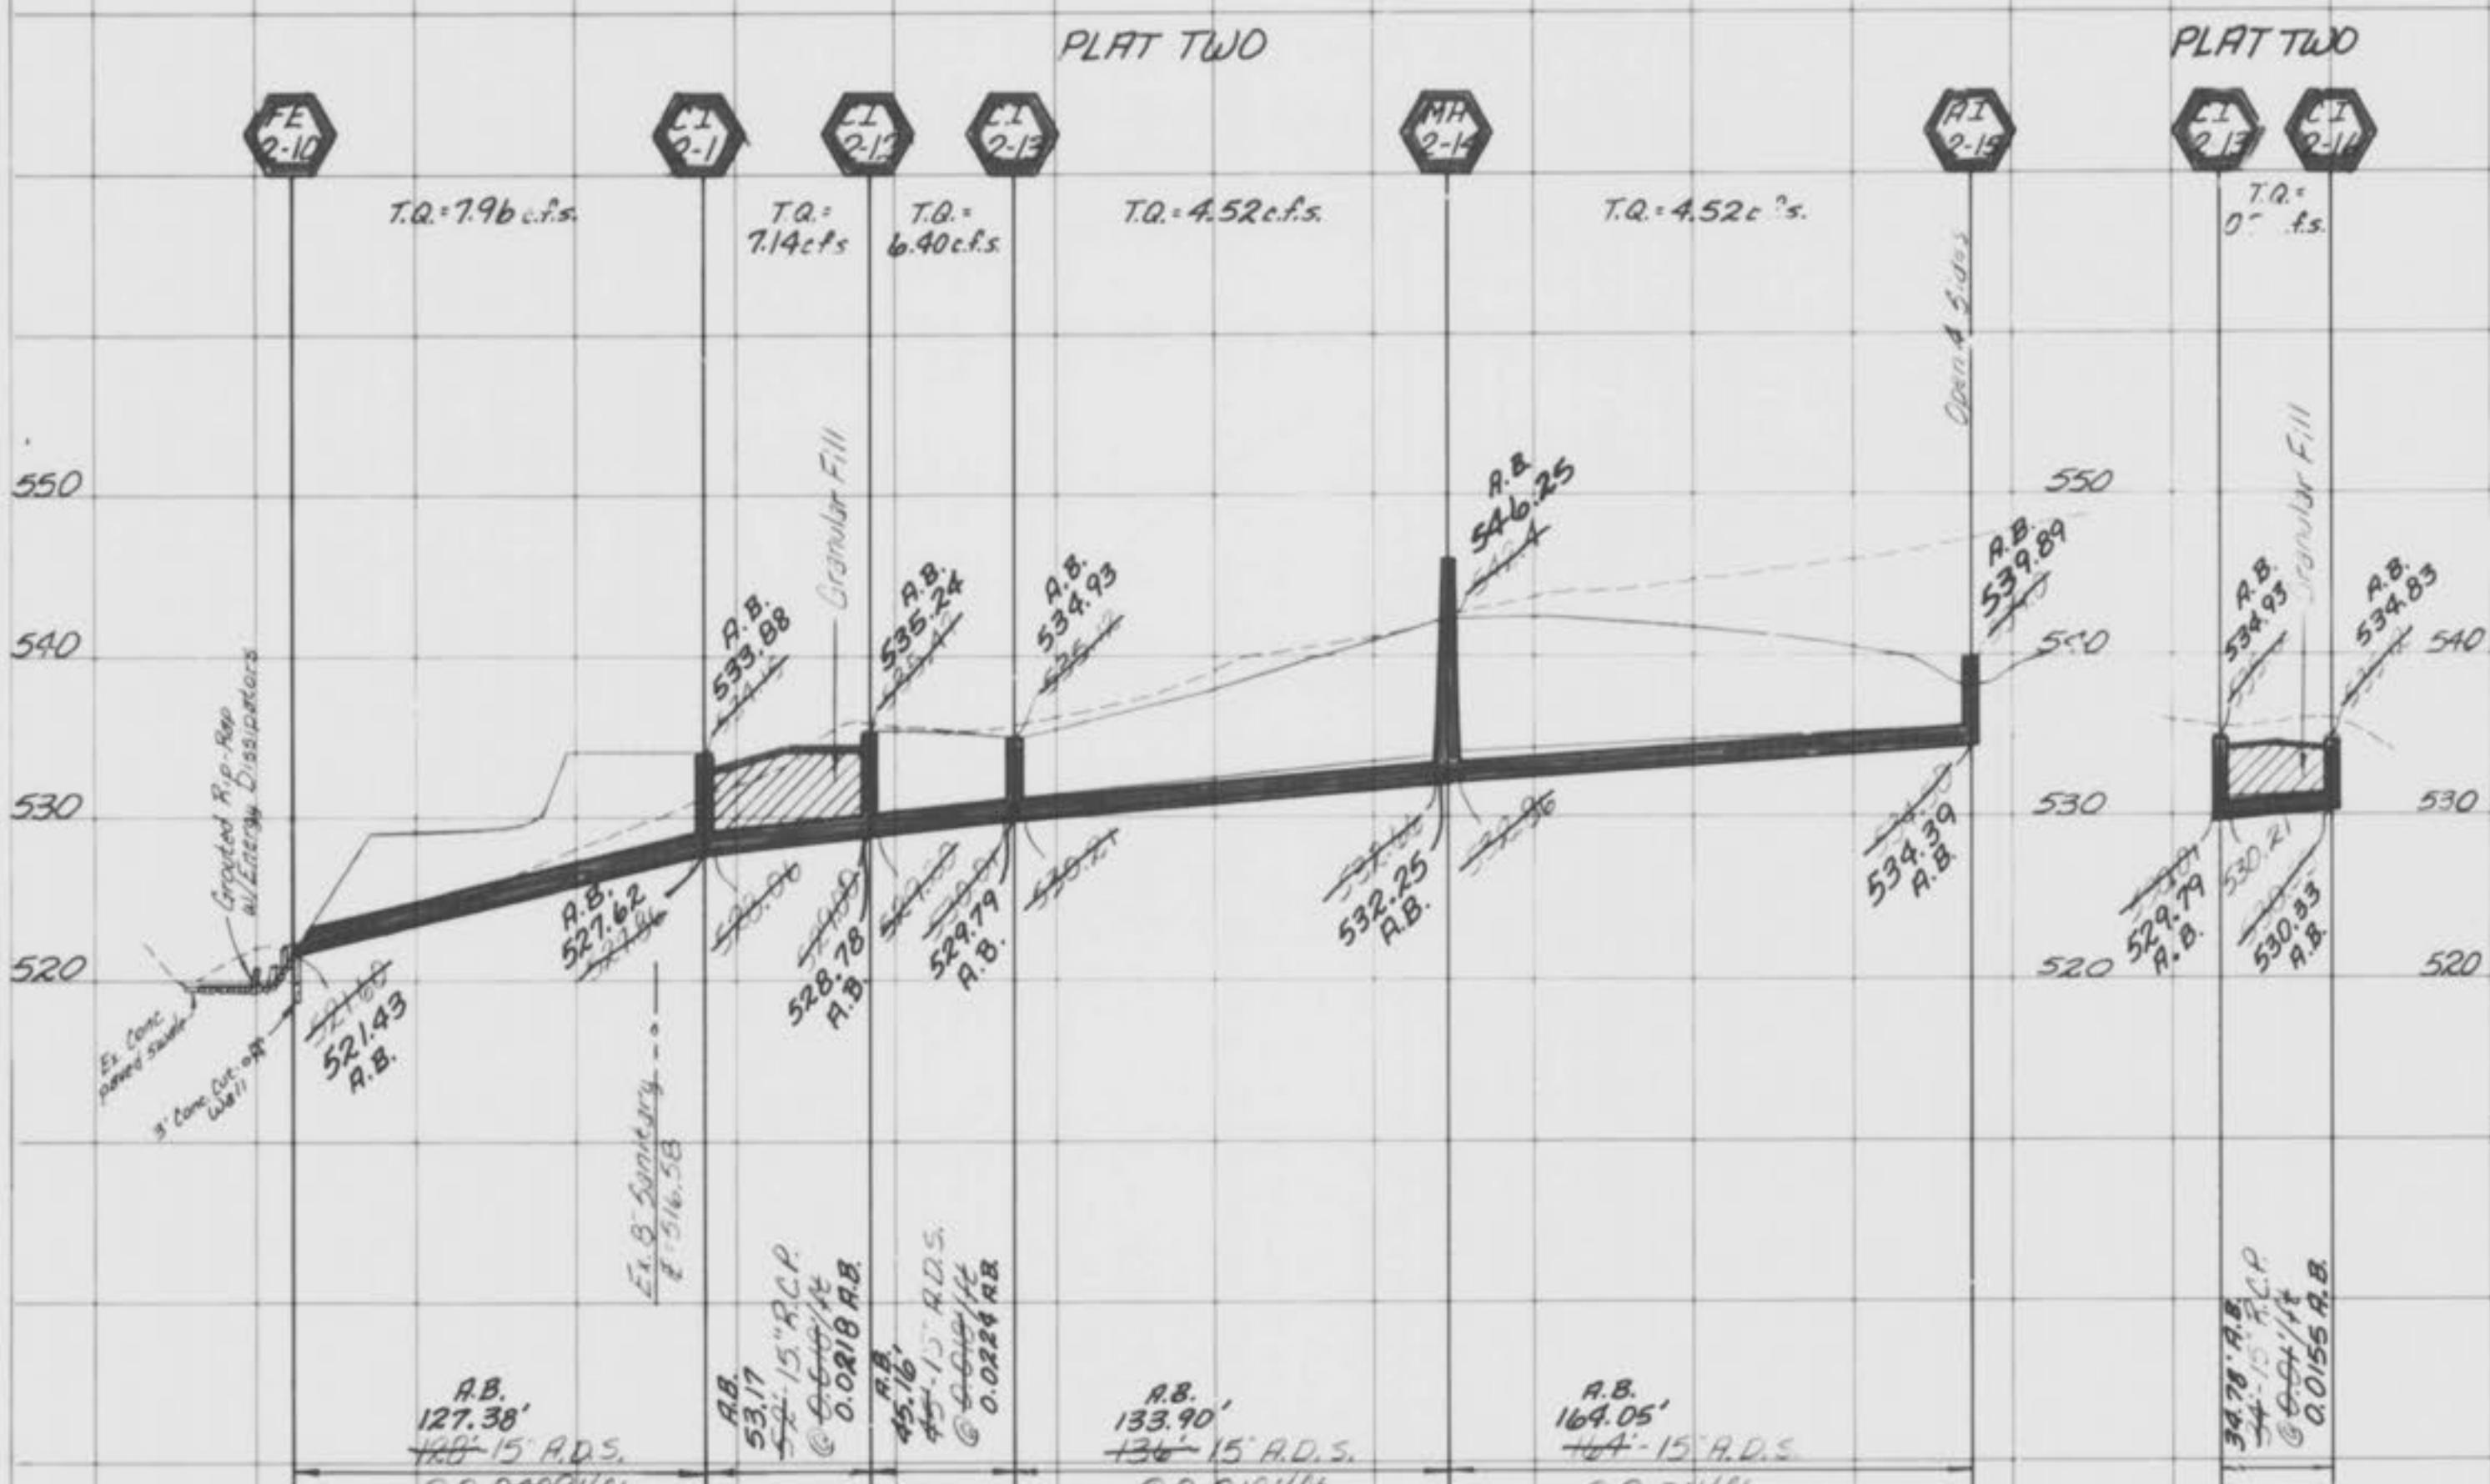

## **ANITARY & STORM AS-BUILTS (AS SHOWN ON PROFILES)**

**ANITARY & STORM AS-BUILTS  
(AS SHOWN ON PROFILES)**


Jan. 29, 1996

Cherrywood Park Plat  
1 - Bldg 51

HIGHWAY FEDERAL AID SHEET  
PLATE 3-FULL CROSS SECTION-LINE & DOT  
**NATIONAL PRINTFAST**  
PRINTED IN U.S.A.

**CHERRYWOOD PARC  
PLAT TWO & PLAT THREE  
STORM SEWER PROFILES**

Scale: Horiz. 1":50'  
Vert. 1":10'

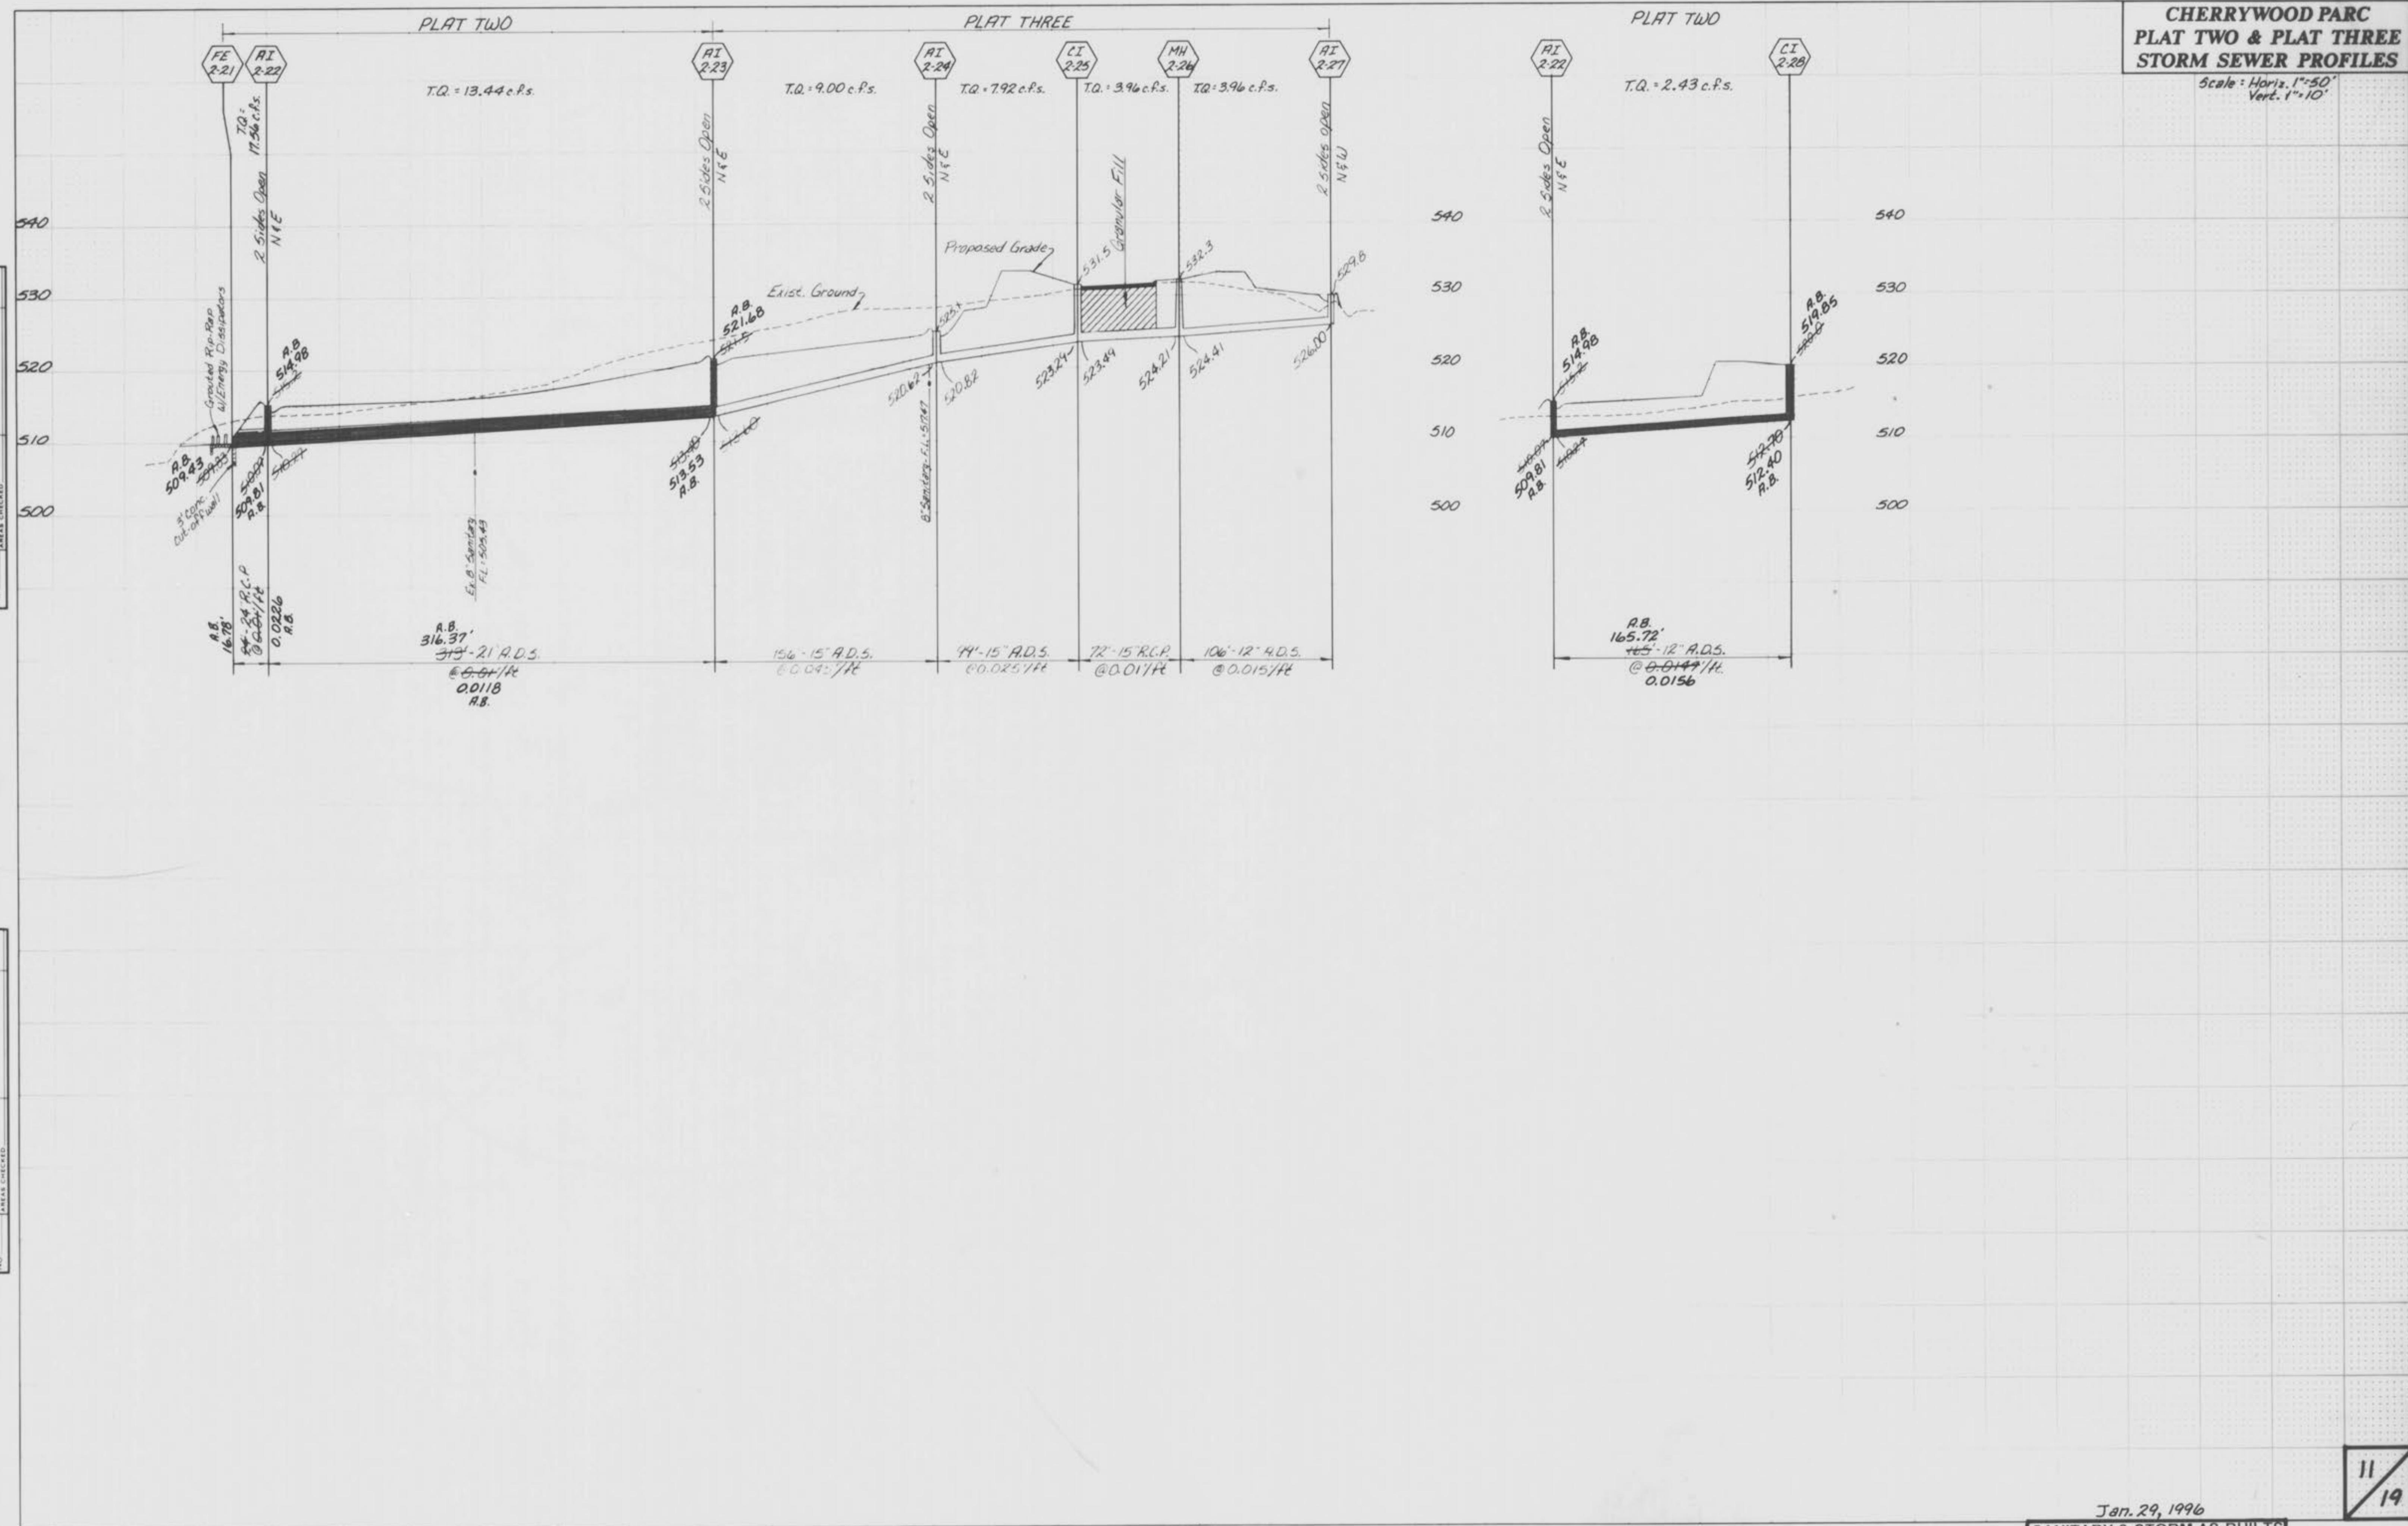

Jan. 29, 1996

**SANITARY & STORM AS-BUILTS  
(AS SHOWN ON PROFILES)**

11  
19

Cherrywood Parc Plat 2  
As-Builts 6/6