

GENERAL NOTES

- Underground utilities have been plotted from available information and therefore their locations shall be considered approximate only. The verification of the location of all underground utilities, either shown or not shown on these plans, shall be the responsibility of the contractor, and shall be located prior to any grading and/or construction of improvements.
- All standard curb inlets are to have front-of-lot 2' (two feet) behind curb, within public right-of-way, unless otherwise noted.
- Storm sewer pipe shall conform to the standard specifications for corrugated adverb pipe AASHTO, M36, ultraviolet or asphalt polymer coated.
- Storm sewer 21" diameter and larger shall be A.S.T.M. C-76, Class II minimum, unless otherwise shown on the plans.
- All storm sewer pipe to the right-of-way or easement shall be reinforced concrete pipe (A.S.T.M. C-76, Class II minimum).
- Corrugated metal pipe shall conform to the standard specifications for corrugated adverb pipe AASHTO, M36, ultraviolet or asphalt polymer coated.
- 8" P.V.C. sanitary sewer pipe shall meet the following standards: A.S.T.M. D-3034 SDR35, with wall thickness compression joint A.S.T.M. D-3212. An appropriate rubber seal gasket as approved by the sewer district shall be installed between P.V.C. pipe and masonry structures.
- All filled places, including under paved areas, under buildings, under proposed storm and sanitary sewer lines, and/or paved areas, shall be compacted to 90% of maximum density as determined by the "Modified AASHTO T-160 Compaction Test", (A.S.T.M. D1557). Test shall be verified by a soils engineer.
- All trench backfills under paved areas shall be granular backfill, and water jotted. All other trench backfills may be earth material (free of large clods or stones) and shall be water jotted.
- No slope shall be steeper than 3:1. All slopes shall be seeded and mulched.
- Barriercodes will be constructed per the standard specifications as shown in the "Manual of Uniform Traffic Control Devices". End of roadway markers shall be mounted if barriercodes are used on two (2) "W" channel sign posts. Each marker shall consist of an 18" diamond panel with red reflectors.
- All construction and materials used shall conform to current City of O'Fallon Standards and Specifications.
- Easements shall be provided for storm sewers, sanitary sewers, and all utilities on the proposed plat. See record plat for location, size, and width of easements.
- All water line construction shall conform to current St. Charles Co. Water Dist. No. 2 Standards and Specifications.
- All sanitary sewer construction shall conform to current Duckett Creek Sewer District Standards and Specifications.
- The Contractor shall prevent all storm surface water, mud or construction debris from entering the existing sanitary sewer system.
- Soil erosion control shall not be limited to what is shown on the plan. The contractor shall take whatever means necessary to prevent erosion and erosion from entering adjacent roadways, properties, and ditches. Such control might include channeling runoff into sediment basins, channeling runoff into areas where an extra row of storm holes are used. A silt fence might be considered, if necessary.
- All construction and materials shall conform to O'Fallon Fire Protection District Standards.
- The minimum vertical distance from the low point of the basement to the flowline of the sanitary sewer at the corresponding house connection shall not be less than two and one half feet (2 1/2') plus the diameter of the sanitary sewer.
- The most stringent of the above requirements shall apply.
- All streets and right-of-ways shown on these improvement plans will be dedicated to the City of O'Fallon for public use forever.
- When grading operations are completed or suspended for more than 30 days, permanent grass must be established at sufficient density to provide erosion control on the site. Between permanent grass seeding periods, temporary cover shall be provided according to the City of O'Fallon Specifications.
- The contractor shall place all fire hydrants within (7) two feet of the street curb.
- The contractor shall place the "steamer" outlet of the fire hydrant toward the street.
- All sanitary sewer manholes shall be waterproofed on the exterior in accordance with Missouri D.H.R. Specification 10CSR-8.12D (7)(6).
- Any wells and/or springs which may exist on this property should be located and sealed in a manner acceptable to the City of O'Fallon.
- All existing trash and debris on-site must be removed and disposed of off-site.
- Debris and foundation material from any existing on-site building or structure which is scheduled to be razed for this development must be disposed of off-site.
- Soft soils in the bottom and banks of any existing or former pond sites or structures should be removed, approved fill, and compacted/rope sufficiently to be used as fill. None of this material should be placed in proposed public right-of-way locations or on any storm sewer location.
- Concrete Pipe Joints shall be M.S.D. Type "A" Approved Compression Joints and shall conform to the requirements of the Specification for Joints and Circular Concrete Sewer and Culvert Pipe, using flexible, water-tight, rubber-type gaskets A.S.T.M. C-443 Band-Type. Gaskets depending entirely on cement for adhesion and resistance to displacement during jointing shall not be used.
- All sewer taps built without elevations furnished by the Engineer will be the responsibility of the sewer contractor.
- Gas, water, and other underground utilities shall not conflict with the depth or horizontal location of existing and proposed sanitary and storm sewers including house laterals.
- No area shall be cleared without permission of the developer.
- All sanitary laterals shown on plan are to be constructed of 4 inch P.V.C. pipe.
- Brick shall not be used on sanitary manholes.
- All ground for stop-caps shall be high strength ready-mix concrete.
- The Duckett Creek Sewer District shall be notified at least 48 hours prior to construction of sanitary sewers for construction and inspections.
- All PVC sanitary sewer pipe to be SDR-35 or equal with "clean" 1/2 inch to 1 inch granular stone bedding uniformly graded. This bedding shall extend from 4 inches below the pipe to springline of pipe. Immediate backfill over pipe shall consist of same size "clean" or "minus" stone from springline of pipe to 6 inches above the top of pipe.
- All pipes shall have positive drainage through manholes. No flat base structures are allowed.
- All streets within this plat of improvement plans shall be Publicly maintained.

- SPECIFICATIONS**
- Site preparation includes the clearance of all stumps, trees, bushes, shrubs, and weeds; the grubbing and removal of roots and other surface obstructions from the site; and the demolition and removal of any man-made structures. The unsuitable material shall be properly disposed of off-site. Topsoil and grass in the fill areas shall be thoroughly placed prior to the placement of any fill. The Soils Engineer shall approve the clearing operation.
 - Compaction equipment shall consist of tamping rollers, pneumatic-tired rollers, vibratory roller or high speed impact type drum rollers acceptable to the Soils Engineer. The roller shall be designed so as to avoid the creation of a layered fill without proper blending of successive fill layers.
 - The Soils Engineer shall observe and test the placement of the fill to verify that specifications are met. A series of fill density tests will be determined on each lift of fill. Interim reports showing fill quality will be made to the Owner at regular intervals.
 - The Soils Engineer shall notify the Contractor of rejection of a lift of fill or portion thereof. The Contractor shall remark the rejected portion of fill and obtain notification from the Soils Engineer of its acceptance prior to the placement of additional fill.
 - All Areas to receive fill shall be scarified to a depth of not less than 6 inches and then compacted to at least 85 percent of the maximum density as determined by the Modified AASHTO T-160 Compaction Test (ASTM-D1557). Natural slopes steeper than 1 vertical to 5 horizontal to receive fill shall have horizontal benches, cut into the slopes before the placement of any fill. The width and height to be determined by the Soils Engineer. The fill shall be loosely placed in horizontal layers not exceeding 8 inches in thickness and compacted in accordance with the specifications given below. The Soils Engineer shall be responsible for determining the acceptability of soils placed. Any unacceptable soils placed shall be removed at the Contractor's expense.
 - The exposure of operation in the fill areas will be fill, compact, verify acceptable soil density, and repetition of the exposure. The acceptable moisture contents during the filling operation are those at which satisfactory dry densities can be obtained. The acceptable moisture contents during the filling operation in the remaining areas are from 2 to 8 percent above the optimum moisture content.
 - The surface of the fill shall be finished so that it will not impound water. If at the end of a days work it would appear that there may be rain prior to the next working day, the surface shall be finished smooth. If the surface has been finished smooth for any reason, it shall be scarified before proceeding with the placement of succeeding lifts. Fill shall not be placed on frozen ground, nor shall filling operations continue when the temperature is such as to permit the layer under placement to freeze.
 - Fill placed within proposed street R.O.W. shall be compacted to 90% M.O.D. Proctor and be 2% below to 6% above optimum moisture content.
 - Soft soil in the bottom and banks of any existing or former pond sites should be removed, spread out and permitted to dry sufficiently to be used as fill. None of this material should be placed in proposed right-of-way locations or on storm sewer locations.

The use of High Density Polyethylene Corrugated Pipe with smooth interior wall will be permitted as an acceptable alternative to R.C.P. outside of Public R/W. Pipe shall meet A.S.T.M. D-2321 A.A.S.H.T.O. M-294-921. Concrete Flared End-Sections & Inlet Structures shall be required.

The sediment control plan should be implemented before grading begins. No graded area is to remain bare without being seeded and mulched. Also, when deemed necessary, positive steps should be exercised to prevent this soil from damaging adjacent property and silting up all storm drainage systems whether on or off site.

All low places whether on-site or off-site should be graded to allow drainage. This can be accomplished with temporary ditches. Any off-site drainage easements will be acquired before grading begins.

Water main must be Class 200, SDR 21 or "Ultra-Blue" PVC, installed with tracer tape and locator wire.

Fire hydrants must be 6 inch 3-way with auxiliary valve, Mueller "Centurion" or Darling "B-84-B". Hydrants must be installed with the steamer connection facing the street.

Public Water Supply District No. 2 shall be notified at least twenty-four (24) hours prior to the start of water line installation for inspection coordination.


Blow-off Hydrants and water meters shall not be located in sidewalks or driveways.

PROJECT BENCHMARK
FIRE HYDRANT AT S.E. CORNER OF DARDENNE ELEMENTARY SCHOOL "M" IN MUELLER U.S.G.S. DATUM ELEV. 574.74

- DEVELOPMENT NOTES:**
- AREA OF TRACT 95.01
 - PRESENT ZONING R-4 SINGLE FAMILY RESIDENTIAL
 - PROPOSED USE SINGLE FAMILY RESIDENTIAL SUBD.
 - TOTAL LOTS PROPOSED 323
 - MINIMUM LOT AREA 7,500 SQ.FT.
 - SITE IS LOCATED IN OR IS SERVED BY THE FOLLOWING:
WATER DISTRICT - ST. CHARLES CO. WATER DISTRICT NO. 2
SANITARY - DUCKETT CRK. SEWER DISTRICT
ELECTRIC - UNION ELECTRIC CO.
GAS - ST. CHARLES GAS CO.
TELEPHONE - G.T.E.
 - MINIMUM SETBACK REQUIREMENTS
FRONT YARD = 25 FEET
SIDE YARD = 6 FEET
REAR YARD = 25 FEET
 - THE DEVELOPER SHALL COMPLY WITH CURRENT TREE PRESERVATION ORDINANCE NO. 16689 AND PROVIDE LANDSCAPING AS SET FORTH IN ARTICLE 23 OF THE CITY OF O'FALLON ZONING ORDINANCE

AS-BUILTS FOR PLAT THREE CHERRYWOOD PARC

A TRACT OF LAND BEING PART OF SECTION 4,
TOWNSHIP 46 N., RANGE 3 E.,
CITY OF O'FALLON, ST. CHARLES CO., MO.

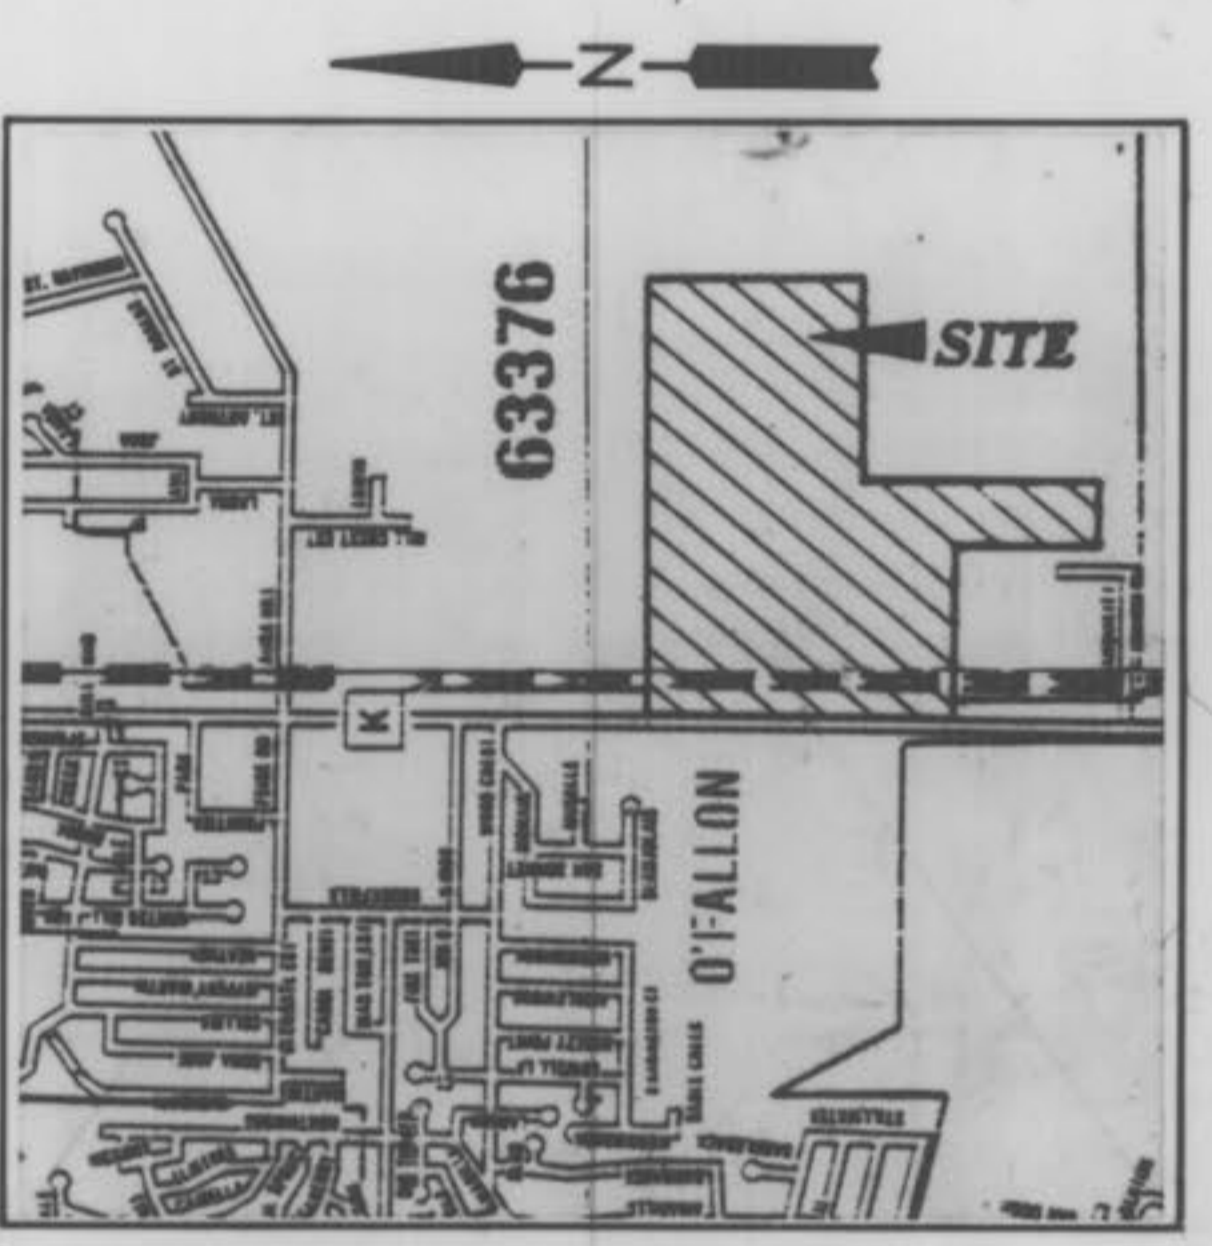

LOCATION MAP
N.T.S.


PROJECT BENCHMARK
FIRE HYDRANT AT S.E. CORNER OF DARDENNE ELEMENTARY SCHOOL "M" IN MUELLER U.S.G.S. DATUM ELEV. 574.74

- DEVELOPMENT NOTES:**
- AREA OF TRACT 95.01
 - PRESENT ZONING R-4 SINGLE FAMILY RESIDENTIAL
 - PROPOSED USE SINGLE FAMILY RESIDENTIAL SUBD.
 - TOTAL LOTS PROPOSED 323
 - MINIMUM LOT AREA 7,500 SQ.FT.
 - SITE IS LOCATED IN OR IS SERVED BY THE FOLLOWING:
WATER DISTRICT - ST. CHARLES CO. WATER DISTRICT NO. 2
SANITARY - DUCKETT CRK. SEWER DISTRICT
ELECTRIC - UNION ELECTRIC CO.
GAS - ST. CHARLES GAS CO.
TELEPHONE - G.T.E.
 - MINIMUM SETBACK REQUIREMENTS
FRONT YARD = 25 FEET
SIDE YARD = 6 FEET
REAR YARD = 25 FEET
 - THE DEVELOPER SHALL COMPLY WITH CURRENT TREE PRESERVATION ORDINANCE NO. 16689 AND PROVIDE LANDSCAPING AS SET FORTH IN ARTICLE 23 OF THE CITY OF O'FALLON ZONING ORDINANCE



ENGINEERS AUTHENTICATION
The responsibility for professional engineering liability on this project is hereby limited to the set of plans authenticated by the seal, signature, and date hereunder attached. Responsibility is disclaimed for all other engineering plans involved in the project and specifically excludes revisions after this date unless re-authenticated.

ST. CHARLES ENGINEERING AND SURVEYING
Michael Newell Meiners
MICHAEL NEWELL MEINERS
MISSOURI PROFESSIONAL ENGINEER NUMBER E-22483

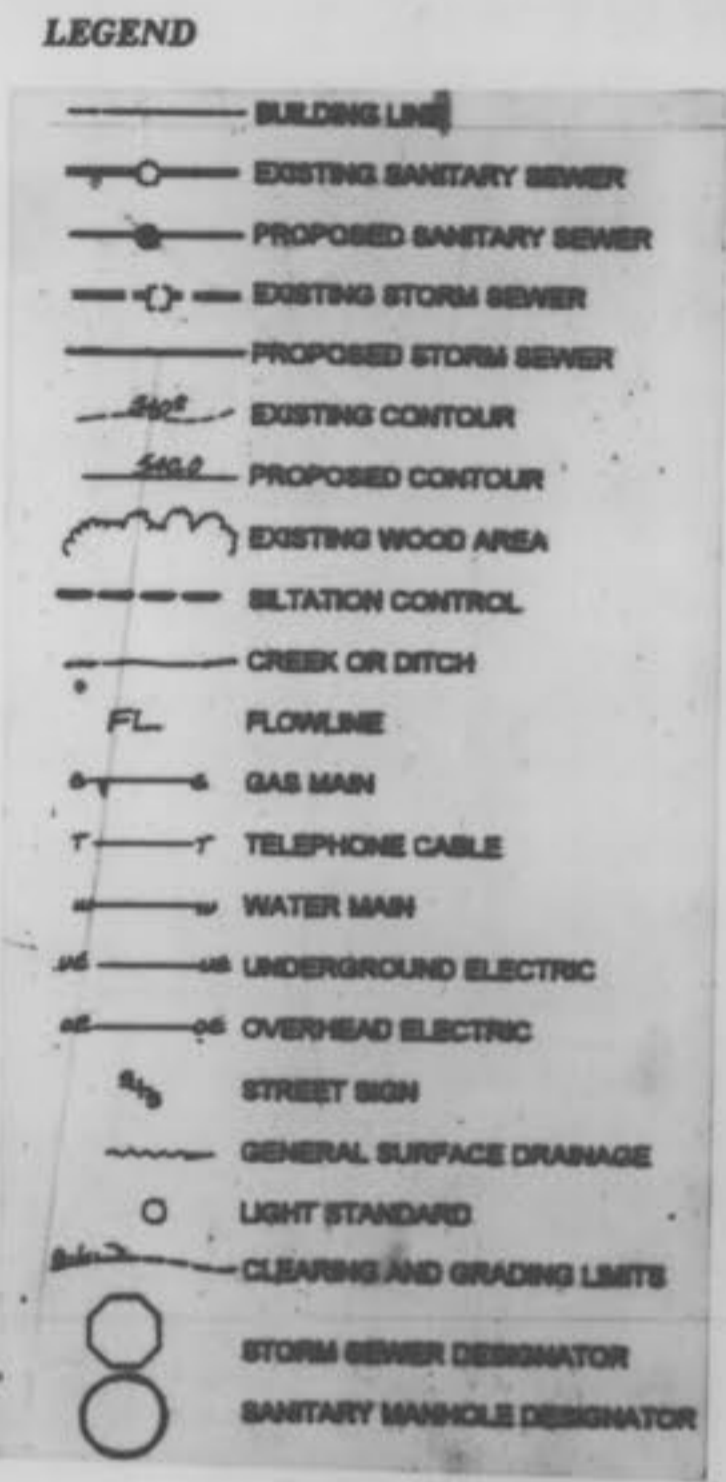

SHEET INDEX

COVER SHEET	1
FLAT PLAN	2
GRADING PLAN	3
SILTATION PLAN (not part of improvement plans)	4
STREET PROFILES	5
SANITARY SEWER PROFILES	5
STORM SEWER PROFILES	6
DRAINAGE AREA MAP	7
CONSTRUCTION DETAILS	8 thru 13

PREPARED FOR
OWEN & SONS DEVELOPMENT CO.
235 JUNGERMAN RD. SUITE 207
ST. PETERS, MO. 63376
July 18, 1996

SANITARY & STORM AS-BUILTS
(AS SHOWN ON PROFILES)

Revised Jan. 11, 1996, Jan. 15, 1996
Sheet 2 of 13
Order No. 94-306
Date 12/21/95

S/C E/S ST. CHARLES ENGINEERING & SURVEYING
801 South Fifth Street, Suite 202
St. Charles, Missouri 63301
Off. 947-0607, Fax 947-2448


SCALE: 1" = 50'

CHERRYWOOD PARC
PLAT THREE
PLAT PLAN
Dec. 27, 1995 94-306

PROPERTY N/E OF KAPLAN
(R-1A)

N 00°00'48" W

1314.78'

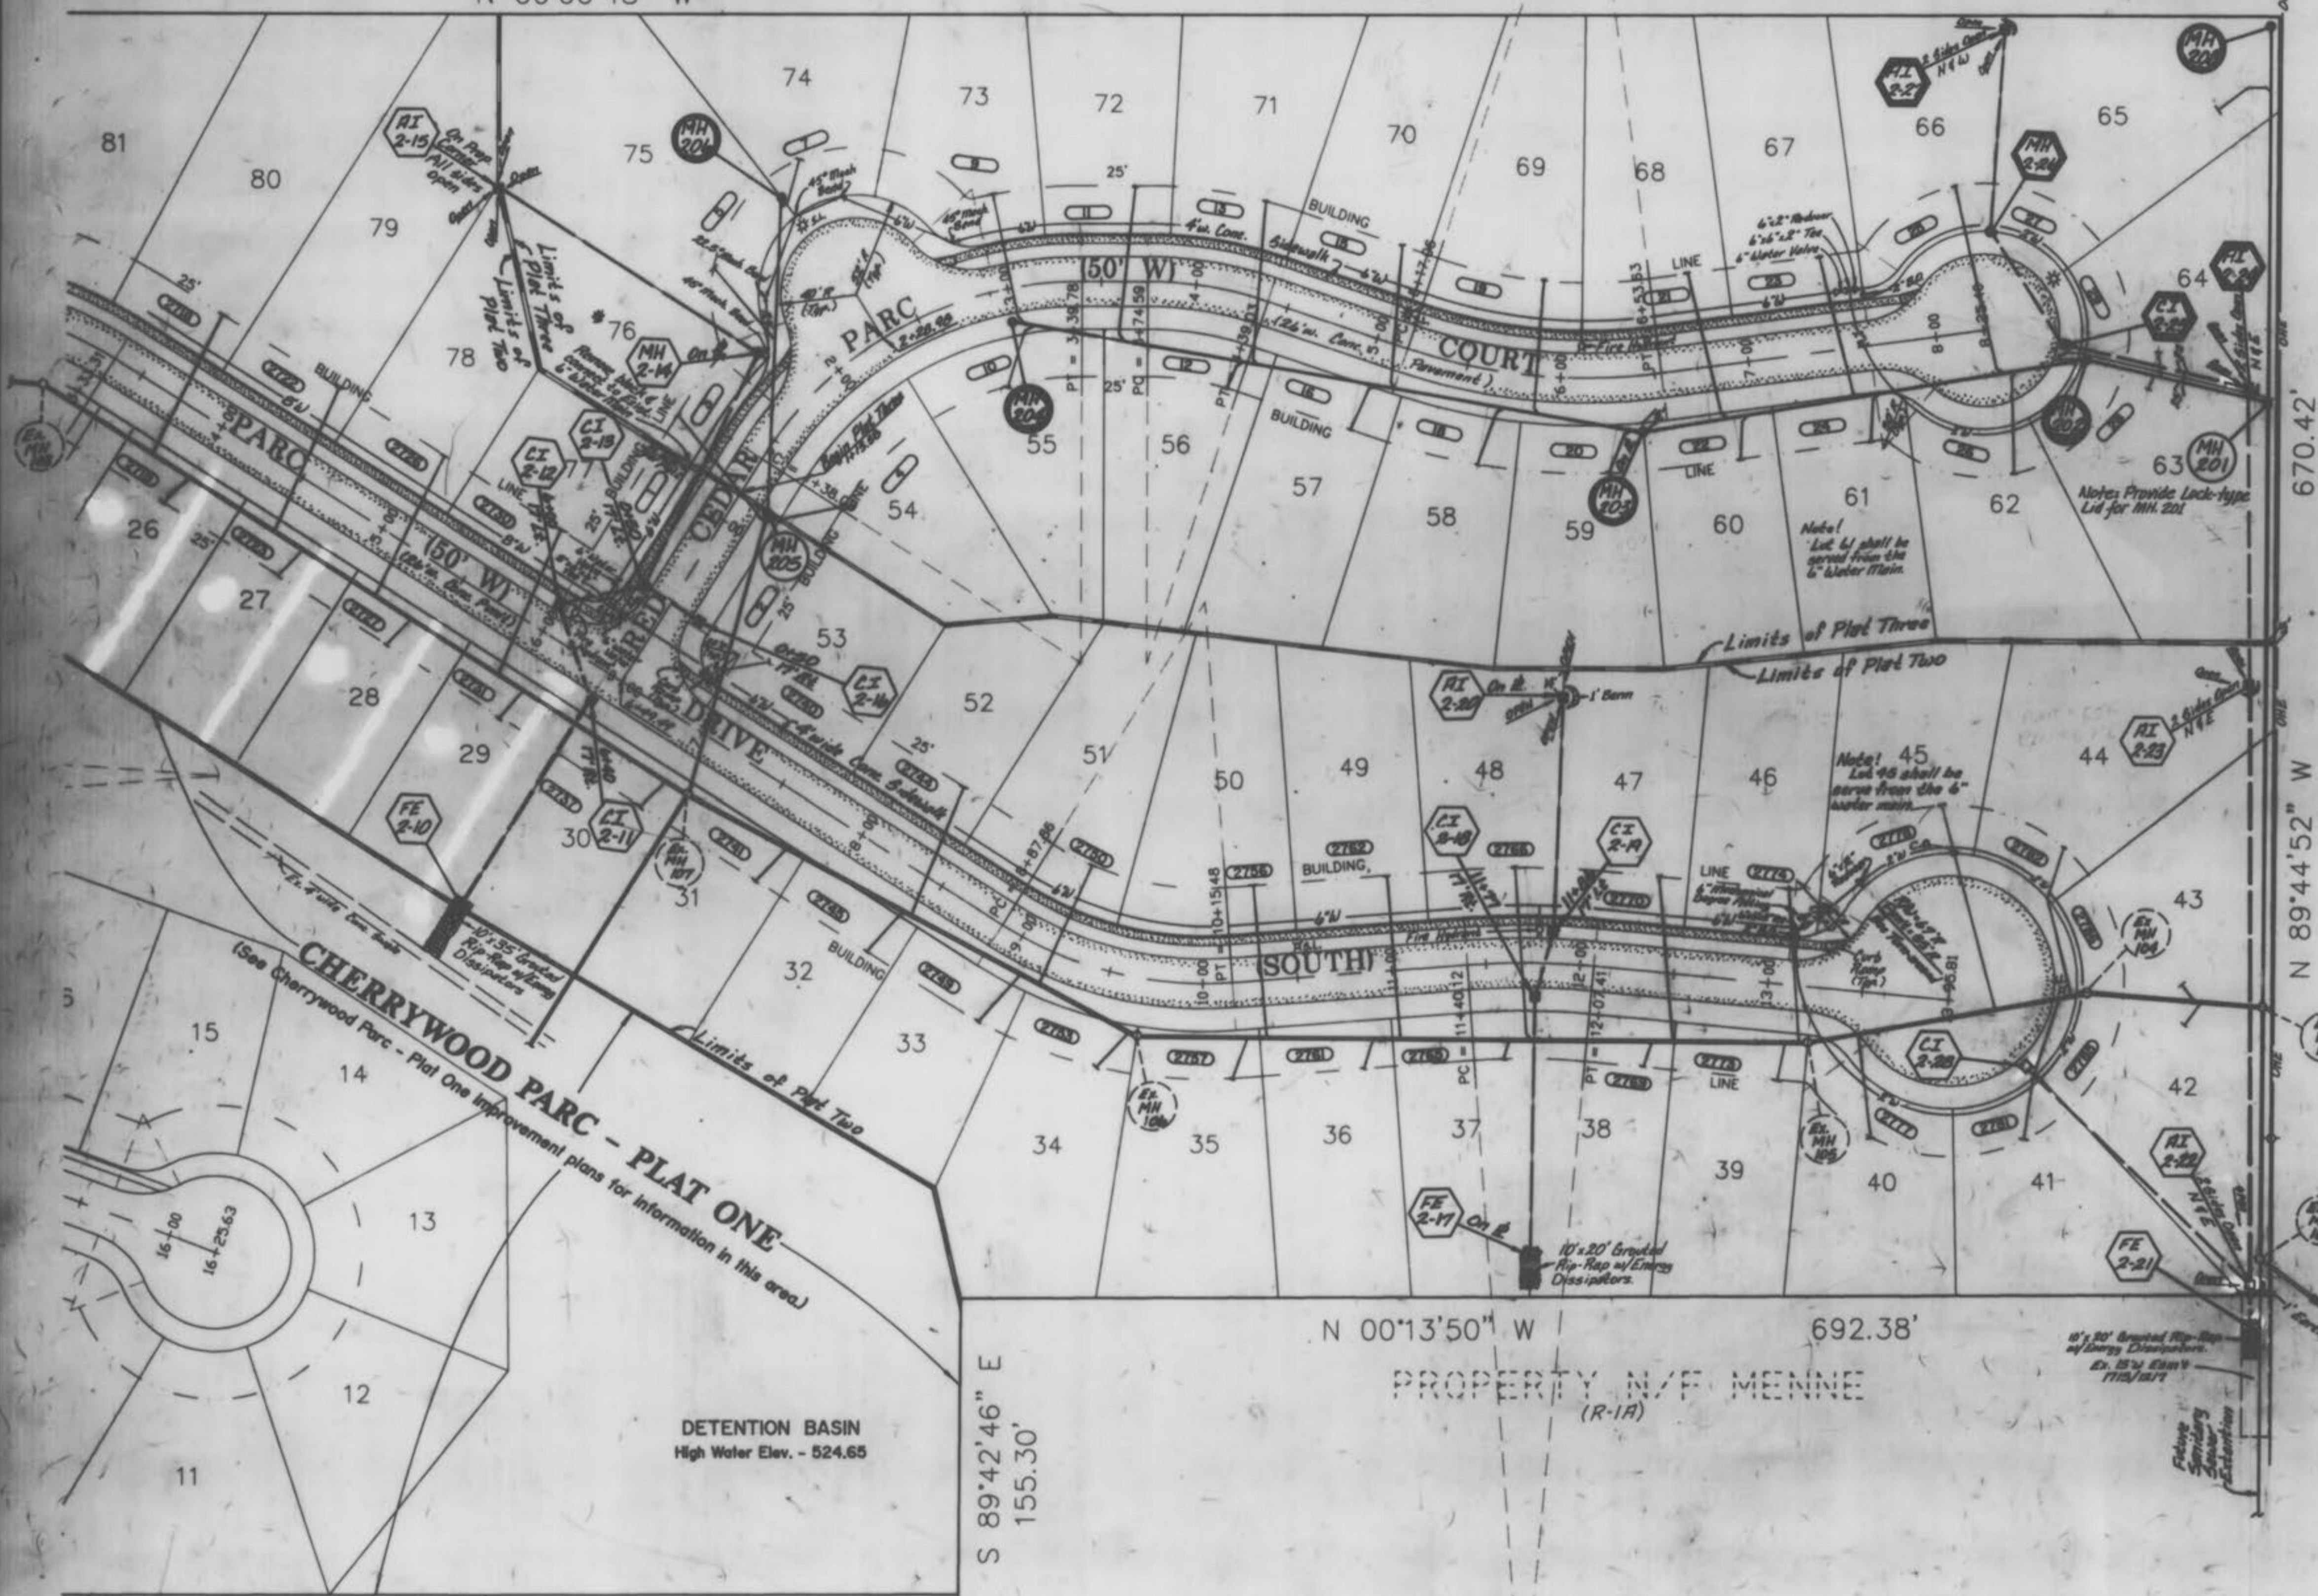

TRANQUILITY LANE (PRIVATE ROAD)
PROPERTY N/E OF KAPLAN
(P.U.D.)

CHERRYWOOD PARC - PLAT ONE
(See Cherrywood Parc - Plat One Improvement plans for information in this area.)

DETENTION BASIN
High Water Elev. - 524.65

PROPERTY N/E OF MENNE
(R-1A)

N 00°08'29" W

513.61'

S 89°42'46" E
155.30'

N 00°13'50" W

692.38'

N 89°44'52" W

670.42'

1224 DENOTES ADDRESS

NOTE:
LOT 76 HAS THE POTENTIAL OF POSSIBLE DAMAGE
DUE TO THE FORCES OF STREET CREEP.
PRECAUTIONARY MEASURES SHOULD BE TAKEN TO
PREVENT STREET CREEP DAMAGE.

CHERRYWOOD PARC
PLAT THREE

REVISED Jan. 11, 1996, Jan. 15, 1996	SHEET 2 OF 13
S C ST. CHARLES ENGINEERING & SURVEYING	
801 S. FIFTH STREET, SUITE 202 ST. CHARLES, MO 63301 TEL: 636 947-0007 FAX: 636 947-2445	
DATE July 18, 1996	BY [Signature]

SANITARY & STORM AS-BUILTS
(AS SHOWN ON PROFILES)


Rev. Jan. 15, 1996

CHERRYWOOD PARC PLAT THREE SANITARY SEWER PROFILES

Scales: Hor. 1" = 50'
Vert. 1" = 10'

DATE	
BY	
FINAL SURVEY	
REVISED	
PLOTTED	
TEMPLATE	
NOTE BOOK	
NO.	
AREAS CHECKED	

DATE	
BY	
ORIGINAL SURVEY	
REVISED	
PLOTTED	
TEMPLATE	
NOTE BOOK	
NO.	
AREAS CHECKED	

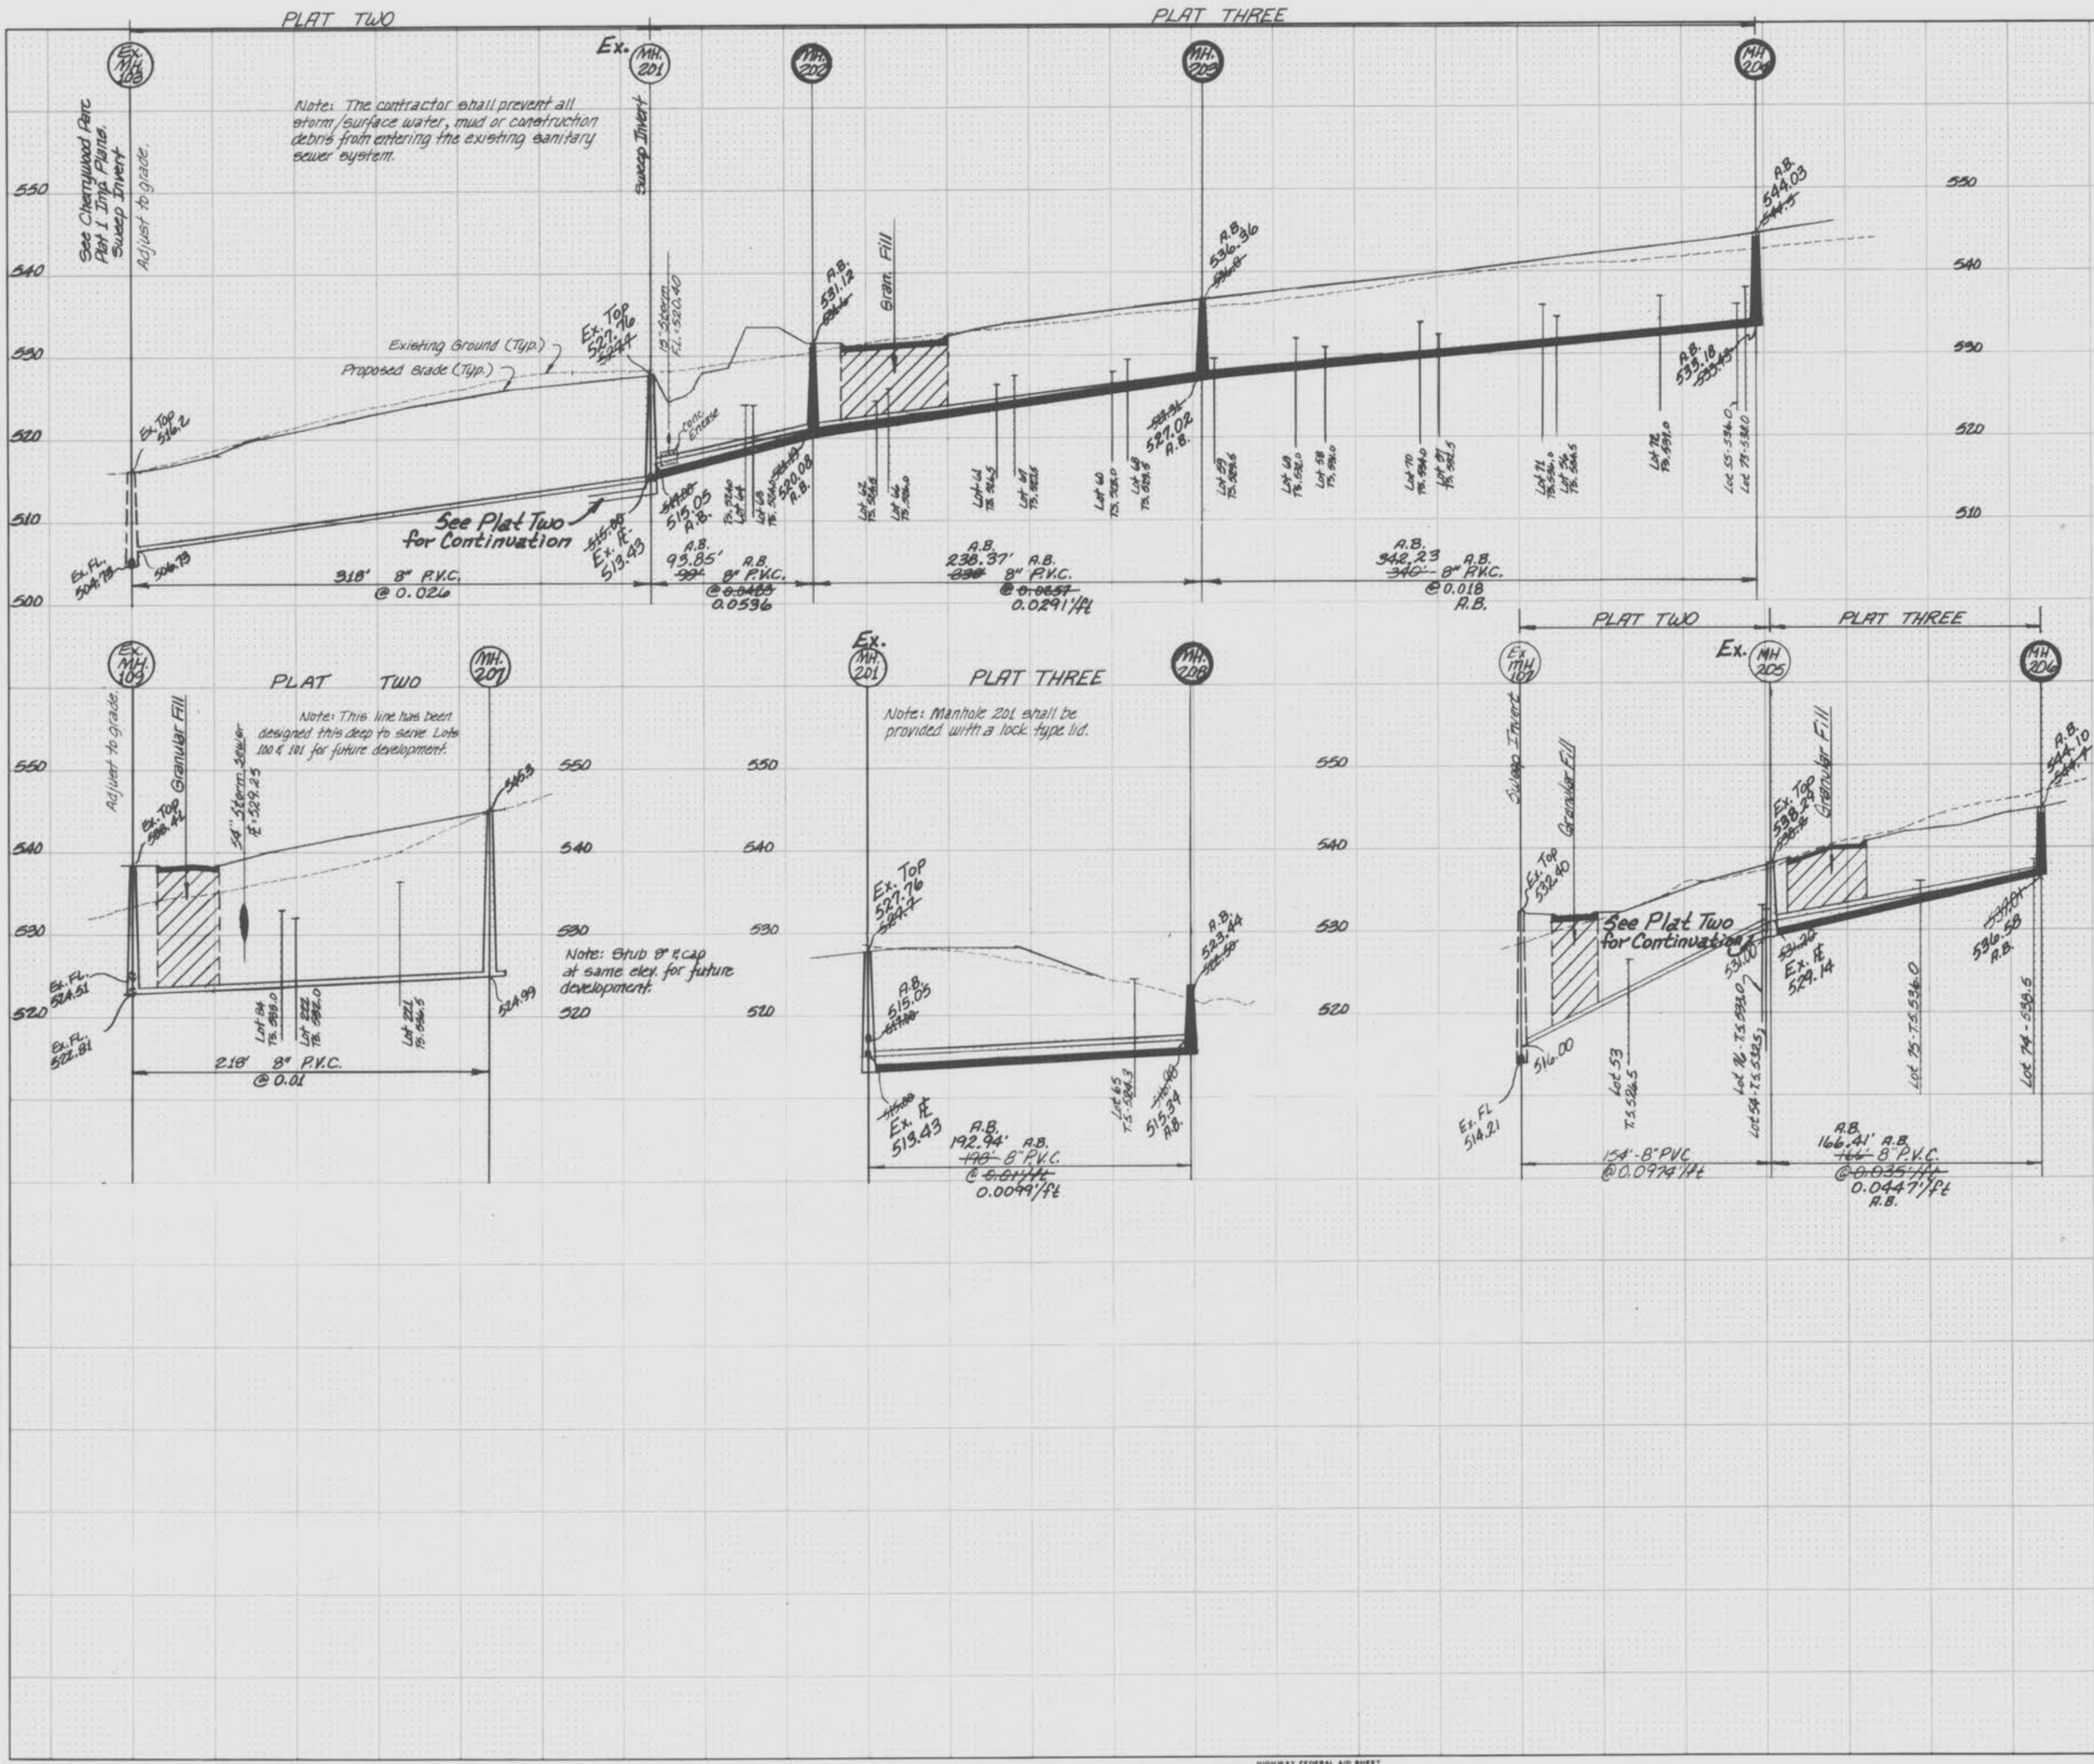

Note: The contractor shall prevent all storm/surface water, mud or construction debris from entering the existing sanitary sewer system.

Note: This line has been designed this deep to serve Lots 100 & 101 for future development.

Note: Manhole 201 shall be provided with a lock type lid.


Note: Stub & cap at same elev. for future development.

Note: See Plat Two for Continuation

Rev. Jan. 15, 1996

CHERRYWOOD PARC PLAT THREE STORM SEWER PROFILES

Scale: Horiz. 1"=50'
Vert. 1"=10'

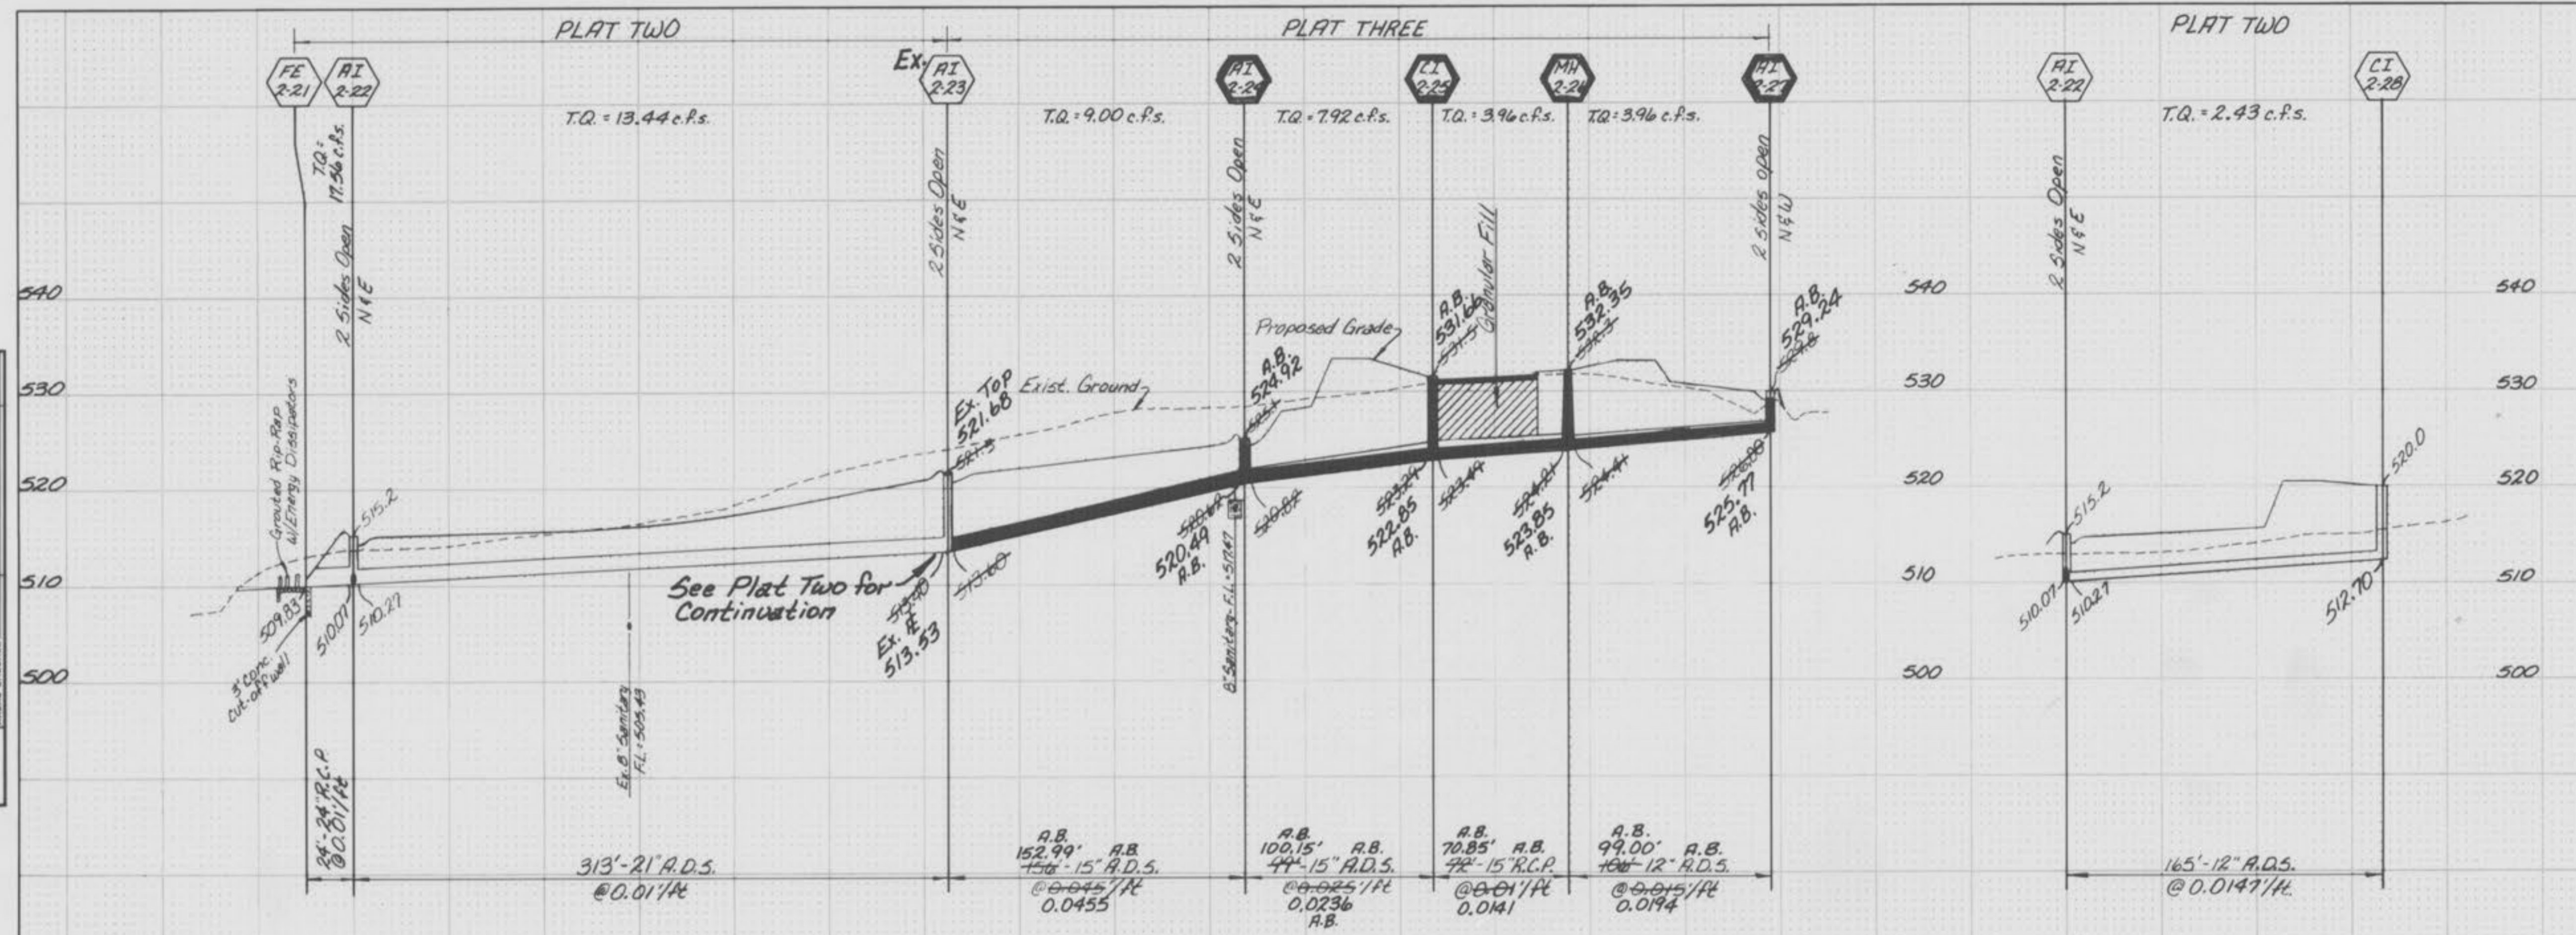

FINAL SURVEY	BY	DATE
REVISION		
NOTE BOOK		
NO.		
AREAS CHECKED		

ORIGINAL SURVEY	BY	DATE
REVISION		
NOTE BOOK		
NO.		
AREAS CHECKED		

HIGHWAY FEDERAL AID SHEET
PLATE 3-FULL CROSS SECTION-FULL DOT
NATIONAL PROJECT
PRINTED IN U.S.A.

July 18, 1996
SANITARY & STORM AS-BUILTS
(AS SHOWN ON PROFILES)

6/13

Cherrywood Parc - Plat 3
AS-BUILTS