

A SET OF AS-BUILT PLANS FOR CHILD HAVEN DAY CARE

A TRACT OF LAND IN THE NORTHWEST QUARTER OF SECTION 31, TOWNSHIP 47 NORTH, RANGE 3 EAST OF THE FIFTH PRINCIPAL MERIDIAN ST. CHARLES COUNTY, MISSOURI

GRADING NOTES

- A Geotechnical Engineer shall be employed by the owner and be on site during grading operations. All soils tests shall be verified by the Geotechnical Engineer concurrent with the grading and backfilling operations. The developer shall also supply the City construction inspector with the soil report(s) prior to or during site soil testing.
- The grading contractor shall perform a complete grading and compaction operation as shown on the plans, stated in these notes, or reasonably implied there from, all in accordance with the plans and notes as interpreted by the Geotechnical Engineer.
- The Contractor shall notify the Soils Engineer at least two days in advance of the start of the grading operation.
- All areas shall be allowed to drain. All low points shall be provided with temporary ditches.
- All filled places, including trench backfills, under buildings, proposed storm and sanitary sewer lines and/or paved areas, shall be compacted to 90% of maximum density as determined by the Modified A.A.S.H.T.O. T-180 Compaction Test, (A.S.T.M.-D-1557), or 95% maximum density as determined by the Standard Proctor Test A.A.S.H.T.O. T-99. All filled places within public roadways shall be compacted from the bottom of the fill up to 90% maximum density as determined by the Modified A.A.S.H.T.O. T-180 Compaction Test or 95% maximum density as determined by the Standard Proctor Test A.A.S.H.T.O. T-99, Method "C" (A.S.T.M.-D-698). All test shall be verified by a soils engineer concurrent with grading and backfilling operations.
- A sediment control plan that includes monitored and maintained sediment control basins and/or straw bales should be implemented as soon as possible. No graded area is to be allowed to remain bare without being seeded and mulched. Care should be exercised to prevent soil from damaging adjacent property and silting up existing downstream storm drainage systems. All erosion control systems shall be inspected and necessary corrections made within 24 hours of any rain storm resulting in 1/2 inch of rain or more.
- Debris and foundation material from any existing on-site building or structure which is scheduled to be razed for this development must be disposed of off-site.
- All trash and debris on site, either existing or from construction, must be removed and properly disposed of off-site.
- Soft soil in the bottom and banks of any existing or former pond sites or tributaries or on any sediment basins or traps should be removed, spread out and permitted to dry sufficiently to be used as fill. None of this material should be placed in proposed public right-of-way locations or on any storm sewer locations.
- Site preparation includes the clearance of all stumps, trees, bushes, shrubs, and weeds; the grubbing and removal of roots and other surface obstructions from the site; and the demolition and removal of any man-made structures. The material shall be properly disposed of off-site. Topsoil and grass in the fill areas shall be thoroughly disced prior to the placement of any fill. The Soils Engineer shall approve the discing operation.
- Compaction equipment shall consist of tamping rollers, pneumatic-tired rollers, vibratory rollers, or high speed impact type drum rollers acceptable to the Soils Engineer. The roller shall be designed so as to avoid the creation of a layered fill without proper blending of successive fill layers.
- The Soils Engineer shall observe and test the placement of the fill to verify that specifications are met. A series of fill density tests will be determined on each lift of fill. Interim reports showing fill quality will be made to the Owner at regular intervals.
- The Soils Engineer shall notify the Contractor of rejection of a lift of fill or portion thereof. The Contractor shall rework the rejected portion of fill and obtain notification from the Soils Engineer of its acceptance prior to the placement of additional fill.
- All areas to receive fill shall be scarified to a depth of not less than 6 inches and then compacted in accordance with the specifications given below. Natural slopes steeper than 1 vertical to 5 horizontal to receive fill shall have horizontal benches cut into the slopes before the placement of any fill. The width and height to be determined by the Soils Engineer. The fill shall be loosely placed in horizontal layers not exceeding 8 inches in thickness and compacted in accordance with the specifications given below. The Soils Engineer shall be responsible for determining the acceptability of soils placed. Any unacceptable soils placed shall be removed at the Contractor's expense.
- The sequence of operation in the fill areas will be fill, compact, verify acceptable soil density, and repetition of the sequence. The acceptable moisture contents during the filling operation are those at which satisfactory dry densities can be obtained. The acceptable moisture contents during the filling operation in the remaining areas are from 2 to 8 percent above the optimum moisture control.
- The surface of the fill shall be finished so that it will not impound water. If at the end of a days work it would appear that there may be rain prior to the next working day, the surface shall be finished smooth. If the surface has been finished smooth for any reason, it shall be scarified before proceeding with the placement of succeeding lifts. Fill shall not be placed on frozen ground, nor shall filling operations continue when the temperature is such as to permit the layer under placement to freeze.
- Fill and backfill should be compacted to the criteria specified in the following table:

CATEGORY	MINIMUM PERCENT COMPACTION
Fill in building areas below footings	90%
Fill under slabs, walks, and pavement	90%
Fill other than building areas	88%
Natural subgrade	88%
Pavement subgrade	90%
Pavement base course	90%

Measured as a percent of the maximum dry density as determined by modified Proctor Test (A.S.T.M.-D-1557).

Moisture content must be within 2 percent below or 4 percent above optimum moisture content if fill is deeper than 10 feet.

LEGEND

CL	CURB INLET	○	STREET LIGHT
D.C.I.	DOUBLE CURB INLET	—S&S—	EXISTING CONTOUR
A.I.	AREA INLET	—S&S—	PROPOSED CONTOUR
M.H.	MANHOLE	5'x5'	STREET SIGN
F.E.	FLARED END SECTION	—	NO PARKING SIGN
E.P.	END PIPE	—	WATER VALVE
C.P.	CONCRETE PIPE	—	BLOW OFF ASSEMBLY
R.C.P.	REINFORCED CONCRETE PIPE	—	FLOWLINE ELEVATION OF HOUSE CONNECTION
C.M.P.	CORRUGATED METAL PIPE	—	FLOWLINE ELEVATION OF SEWER MAIN
C.B.P.	CAST IRON PIPE	—	
P.V.C.	POLY VINYL CHLORIDE (PLASTIC) CLEAN OUT	—	
C.O.	CLEAN OUT	—	
—	FIRE HYDRANT	—	
—	STORM SEWER	—	
—	SANITARY SEWER	—	

LANDSCAPE LEGEND

9	INDICATES PROPOSED HARDWOOD TREE (ashes, oaks, maples, birches, sweet gums) minimum 2" caliper
24	INDICATES PROPOSED EVERGREEN TREES (pines) minimum 6 ft. height
27	INDICATES PROPOSED EVERGREEN SHRUBS (mugo pines, yews, junipers, hollies, boxwoods)
29	INDICATES PROPOSED ORNAMENTAL SHRUBS (spireas, forsythia, barberries, privets, iliacs)

**LANDSCAPING AS DEPICTED IS SUBJECT TO FINAL DESIGN BY A QUALIFIED LANDSCAPE DESIGNER

VEGETATIVE ESTABLISHMENT For Urban Development Sites APPENDIX A

Seeding Rates:
Permanent:
Tall Fescue - 30 lbs./ac.
Smooth Brome - 20 lbs./ac.
Combined Fescue @ 15 lbs./ac. and Brome @ 10 lbs./ac.


Temporary:
Wheat or Rye - 150 lbs./ac. (3.5 lbs. per square foot)
Oats - 120 lbs./ac. (2.75 lbs. per square foot)

Seeding Periods:
Fescue or Brome - March 1 to June 1
August 1 to October 1
Wheat or Rye - March 15 to November 1
Oats - March 15 to September 15

Mulch Rates: 100 lbs. per 1,000 sq. feet (4,356 lbs. per acre)

Fertilizer Rates: Nitrogen 30 lbs./ac.
Phosphate 30 lbs./ac.
Potassium 30 lbs./ac.
Lime 600 lbs./ac. ENM*

* ENM = effective neutralizing material as per State evaluation of quarried rock.

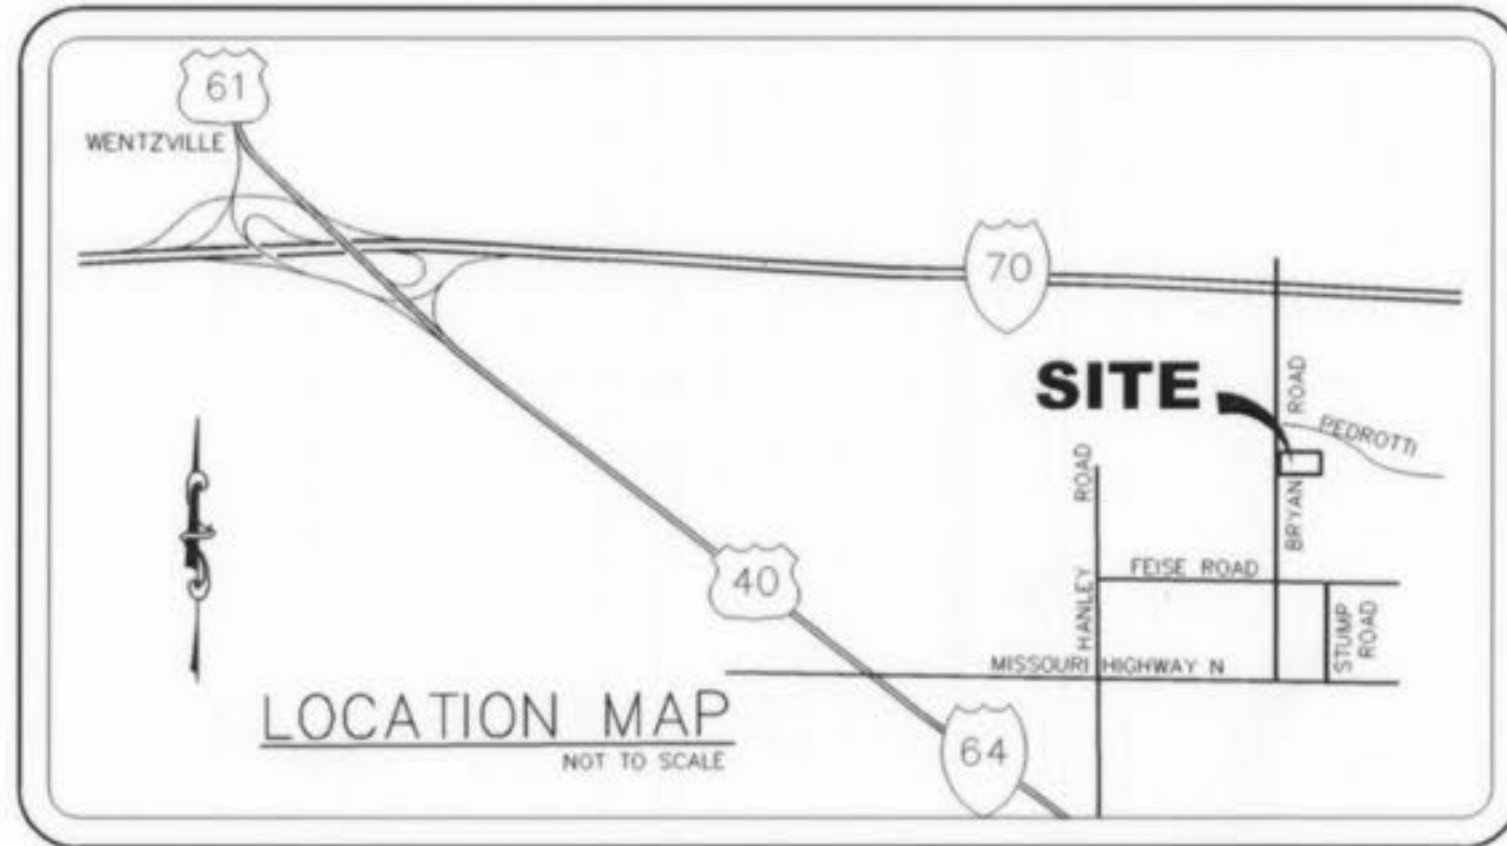

GENERAL NOTES

- Underground utilities have been plotted from available information and therefore their locations shall be considered approximate only. The verification of the location of all underground utilities, either shown or not shown on these plans shall be the responsibility of the contractor, and shall be located prior to any grading or construction of the improvements.
- All trench backfills under paved areas shall be granular backfill, and shall be compacted to 90% of the maximum density as determined by the Modified A.A.S.H.T.O. T-180 Compaction Test, (A.S.T.M.-D-1557). All other trench backfills may be earth material (free of large clods or stones). All trench backfills shall be water jetted.
- No area shall be cleared without the permission of the Project Engineer.
- The City of O'Fallon and City of O'Fallon Sewer shall be notified 48 hours prior to construction for coordination and inspection.
- All existing site improvements disturbed, damaged or destroyed shall be repaired or replaced to closely match pre-construction conditions.
- All construction and materials shall conform to the current construction standards of the City of O'Fallon.
- Any permits, licenses, easements, or approvals required to work on public or private properties or roadways are the responsibility of the developer.
- No slopes shall exceed 3(H) : 1(V).
- The Contractor shall assume complete responsibility for controlling all siltation and erosion of the project area. The Contractor shall use whatever means necessary to control erosion and siltation including, but not limited to, staked straw bales and/or siltation fabric fences (possible methods of control are detailed in the plan). Control shall commence with grading and be maintained throughout the project until acceptance of the work by the Owner and/or the City of O'Fallon and/or MODOT. The Contractor's responsibilities include all design and implementation as required to prevent erosion and the depositing of silt. The Owner and/or the City of O'Fallon and/or MODOT may at their option direct the Contractor in his methods as deemed fit to protect property and improvements. Any depositing of silt or mud on new or existing pavement or in new or existing storm sewers or swales shall be removed after each rain and affected areas cleaned to the satisfaction of the Owner and/or the City of O'Fallon and/or MODOT.
- Erosion control systems shall not be limited to what is shown on the plan. Whatever means necessary shall be taken to prevent siltation and erosion from entering natural streams and adjacent roadways, properties and ditches.
- Sidewalks, curb ramps, ramp and accessible parking spaces shall be constructed in accordance with the current approved "American with Disabilities Act Accessibility Guidelines" (ADAAC) along with the required grades, construction materials, specifications and signage. If any conflict occurs between the above information and the plans, the ADAAC guidelines shall take precedence and the contractor prior to any construction shall notify the Project Engineer.



**CALL BEFORE
YOU DIG!
1-800-DIG-RITE**

DEVELOPMENT NOTES

1. Area of Tract:	2.843 Acres
Lot 1 Area:	1.539 Acres
Lot 2 Area:	1.304 Acres
2. Existing Zoning:	R-1 Single Family Residential
3. Proposed Use:	Day Care Facility
4. Area of Building:	6,550 sq.ft.
5. The required height and building setbacks are as follows:	
Minimum Front Yard:	25 feet
Minimum Side Yard:	6 feet
Minimum Rear Yard:	25 feet
Maximum Height of Building:	35 feet
Maximum Proposed Height:	26'-4"
6. Site is served by:	
City of O'Fallon Sewer	636-281-2858
AmerenUE Company	636-639-8312
St. Charles Gas Company	636-948-8937
Public Water Supply District No. 2	636-561-3737
Verizon Telephone Company	636-332-3011
O'Fallon Fire Protection District	636-272-3493
Fort Zumwalt School District	636-272-6620

8. According to the Flood Insurance Rate Map of St. Charles County, (Community Panel number 290315 0240 E dated August 2, 1996) this property lies within Zone X. Zone X is defined as an area outside the 500 year Flood Plain Limits.

9. Parking Required: Estimated number of children = 200, Employees = 20
200 / 10 = 20 spaces
20 / 1 = 20 spaces
Total Parking Required: 40 spaces
Total Parking Provided: 44 spaces (including 2 handicap space)

Loading Required: Uses with 5,000 gross floor area be provided with 1 space and 1 for every additional 20,000 s.f.
Total Loading Required: 1 space
Total Loading Provided: 1 space

10. Landscape Required:
44 (sp.) x 270 = 11,880 S.F.
11,880 sq. ft. x 0.06 (%) = 712.80
Total Interior Landscape Required: 712.80 S.F.
Total Interior Landscape Provided: 1,298.09 S.F.
10,811.59 S.F. / 3,000 S.F. = 3.60 ~ 4 Trees
Total Open Landscape Required: 4 Trees
Total Open Landscape Provided: 30 Trees
115.08 L.F. / 40 L.F. = 2.88 ~ 3 Trees
Total Street Trees Required: 3 Trees
Total Street Trees Provided: 3 Trees

11. Site Coverage Calculations:
Building = 6,550 sq. ft.
Pavement = 33,779 sq. ft.
Green Space = 83,502.82 sq. ft.

12. All new utilities will be located underground.

13. Detention will be provided per City Ordinance 405.240

13. Reference Benchmark: Elevation 643.21 Datum (U.S.G.S.)
Existing 600 nail in power pole at the Northwest Corner of Feise Road and Bryan Road as shown on improvement plans for Feise Road, O'Fallon Project No.210-005, as prepared by George Butler Associates.

Site Benchmark: Elevation 569.15 Datum (U.S.G.S.)
Old iron pipe at the Northeast corner of the subject property, being also the Southwest corner of Lot 8 of "Hidden Meadows".

GRADING QUANTITY

2,361 cu.yds.
(INCLUDES 15% SHRINKAGE)
The above yardage is an approximation only, NOT FOR BIDDING PURPOSES. Contractors shall verify quantities prior to construction.

It is the intention of the Engineer for the earthwork to balance on-site. The Engineer shall be notified if any difficulties arise in achieving the balance.

PRINCIPALS & STANDARDS

- All excavations, grading, or filling shall have a finished grade not to exceed a 3:1 slope (33%). Steeper grades may be approved by the designated official if the excavation is through rock or the excavation or the fill is adequately protected (a designed head wall or toe wall may be required). Retaining walls that exceed a height of four (4) feet shall require the construction of safety guards as identified in the appropriate section(s) of the adopted BOCA Codes and must be approved by the City Building Department. Permanent safety guards will be constructed in accordance with the appropriate section(s) of the adopted BOCA Codes.
- Sediment and erosion control plans for sites that exceed 20,000 square feet of grading shall provide for sediment or debris basins, silt traps or filters, staked straw bales or other approved measures to remove sediment from run-off waters. Temporary siltation control measures shall be maintained until vegetative cover is established at a sufficient density to provide erosion control on the site.
- Where natural vegetation is removed during grading, vegetation shall be re-established in such a density as to prevent erosion. Permanent type grasses shall be established as soon as possible during the next seeding period after grading has been completed.
- When grading operations are completed or suspended for more than 30 days permanent grass must be established at sufficient density to provide erosion control on the site. Between permanent grass seeding periods, temporary cover shall be provided.

All finished grades (areas not to be disturbed by future improvement) in excess of 20% slopes (5:1) shall be mulched and tacked at the rate of 100 pounds per 1,000 square feet when seeded.
- Provisions shall be made to accommodate the increased runoff caused by changed soils and surface conditions during and after grading. Unvegetated open channels shall be designed so that gradients result in velocities of 2 fps (feet per second) or less. Open channels with velocities more than 2 fps and less than 5 fps shall be established in permanent vegetation by use of commercial erosion control blankets or lined with rock riprap or concrete or other suitable materials. Detention basins, diversions or any other appropriate structures shall be constructed to prevent velocities above 5 fps.
- The adjoining ground to development sites (lots) shall be provided with protection from accelerated and increased surface water, silt from erosion, and any other consequence of erosion. Run-off water from developed areas (parking lots, paved sites and buildings) above the area to be developed shall be directed to diversions, detention basins, concrete gutters and/or underground outlet systems. Sufficiently anchored straw bales may be temporarily substituted.
- Development along natural watercourses shall have residential lot lines, commercial or industrial improvements, parking areas or driveways set back a minimum of 25 feet from the top of the existing stream bank. The watercourse shall be maintained and made the responsibility of the subdivision trustees or in the case of a site plan by the property owner. Permanent vegetation should be left intact. Variances will include designed stream bank erosion control measures. FEMA and U.S. Army Corps of Engineers guidelines shall be followed where applicable regarding site development areas designated as flood plains and wetlands.
- All lots shall be seeded and mulched or sodded before an occupancy permit shall be issued except that a temporary occupancy permit may be issued by the Building Department in cases of undue hardship because of unfavorable ground conditions.

PREPARED FOR: CHILD HAVEN DAY CARE
 JIM PODHORSKY
 6 WOOD GREEN COURT
 O'FALLON, MISSOURI

DISCLAIMER OF RESPONSIBILITY
I hereby certify that the documents attached to be authorized by my seal are limited to the work shown on these documents. I am not responsible for any other documents or requirements relating to or intended to be used for any part or parts of the architectural or engineering project or survey.



Copyright 2002
Bio-Engineering Company, Inc.
All Rights Reserved

REVISIONS

NO.	DATE	DESCRIPTION

SHEET INDEX

- COVER SHEET
- SITE PLAN
- PROFILES AND DETAILS

SEWER MEASUREMENTS

THE EXISTING SEWER LENGTHS, SIZES, FLOWLINES, DEPTHS OF STRUCTURES AND SEWERS AND LOCATIONS WITH RESPECT TO EXISTING OR PROPOSED EASEMENTS HAVE BEEN MEASURED. THE RESULTS OF THOSE MEASUREMENTS ARE SHOWN ON THIS SET OF FINAL MEASUREMENT PLANS.

ALL PUBLIC SEWERS ARE LOCATED WITHIN DESIGNATED EXISTING OR PROPOSED EASEMENTS EXCEPT AS FOLLOWS:

NO. _____ DATE _____
P.E.A.S.




AS-BUILTS NOTE:
ALL DISTANCE AND SLOPE CALCULATIONS ARE FROM CENTER OF STRUCTURE TO CENTER OF STRUCTURE.

**ENGINEERING
SURVEYING**
1052 South Cloverleaf Drive
St. Peters, MO. 63376-6445
636-928-5552
FAX 928-1718

3-10-03
DATE
01-11610
PROJECT NUMBER
1 OF 3
SHEET OF
11610ASB.DWG
FILE NAME
ECF
DRAWN
DESIGNED CHECKED

AN AS-BUILT PLAN FOR CHILD HAVEN DAY CARE

A TRACT OF LAND IN
THE NORTHWEST QUARTER OF SECTION 31,
TOWNSHIP 47 NORTH, RANGE 3 EAST
OF THE FIFTH PRINCIPAL MERIDIAN
ST. CHARLES COUNTY, MISSOURI

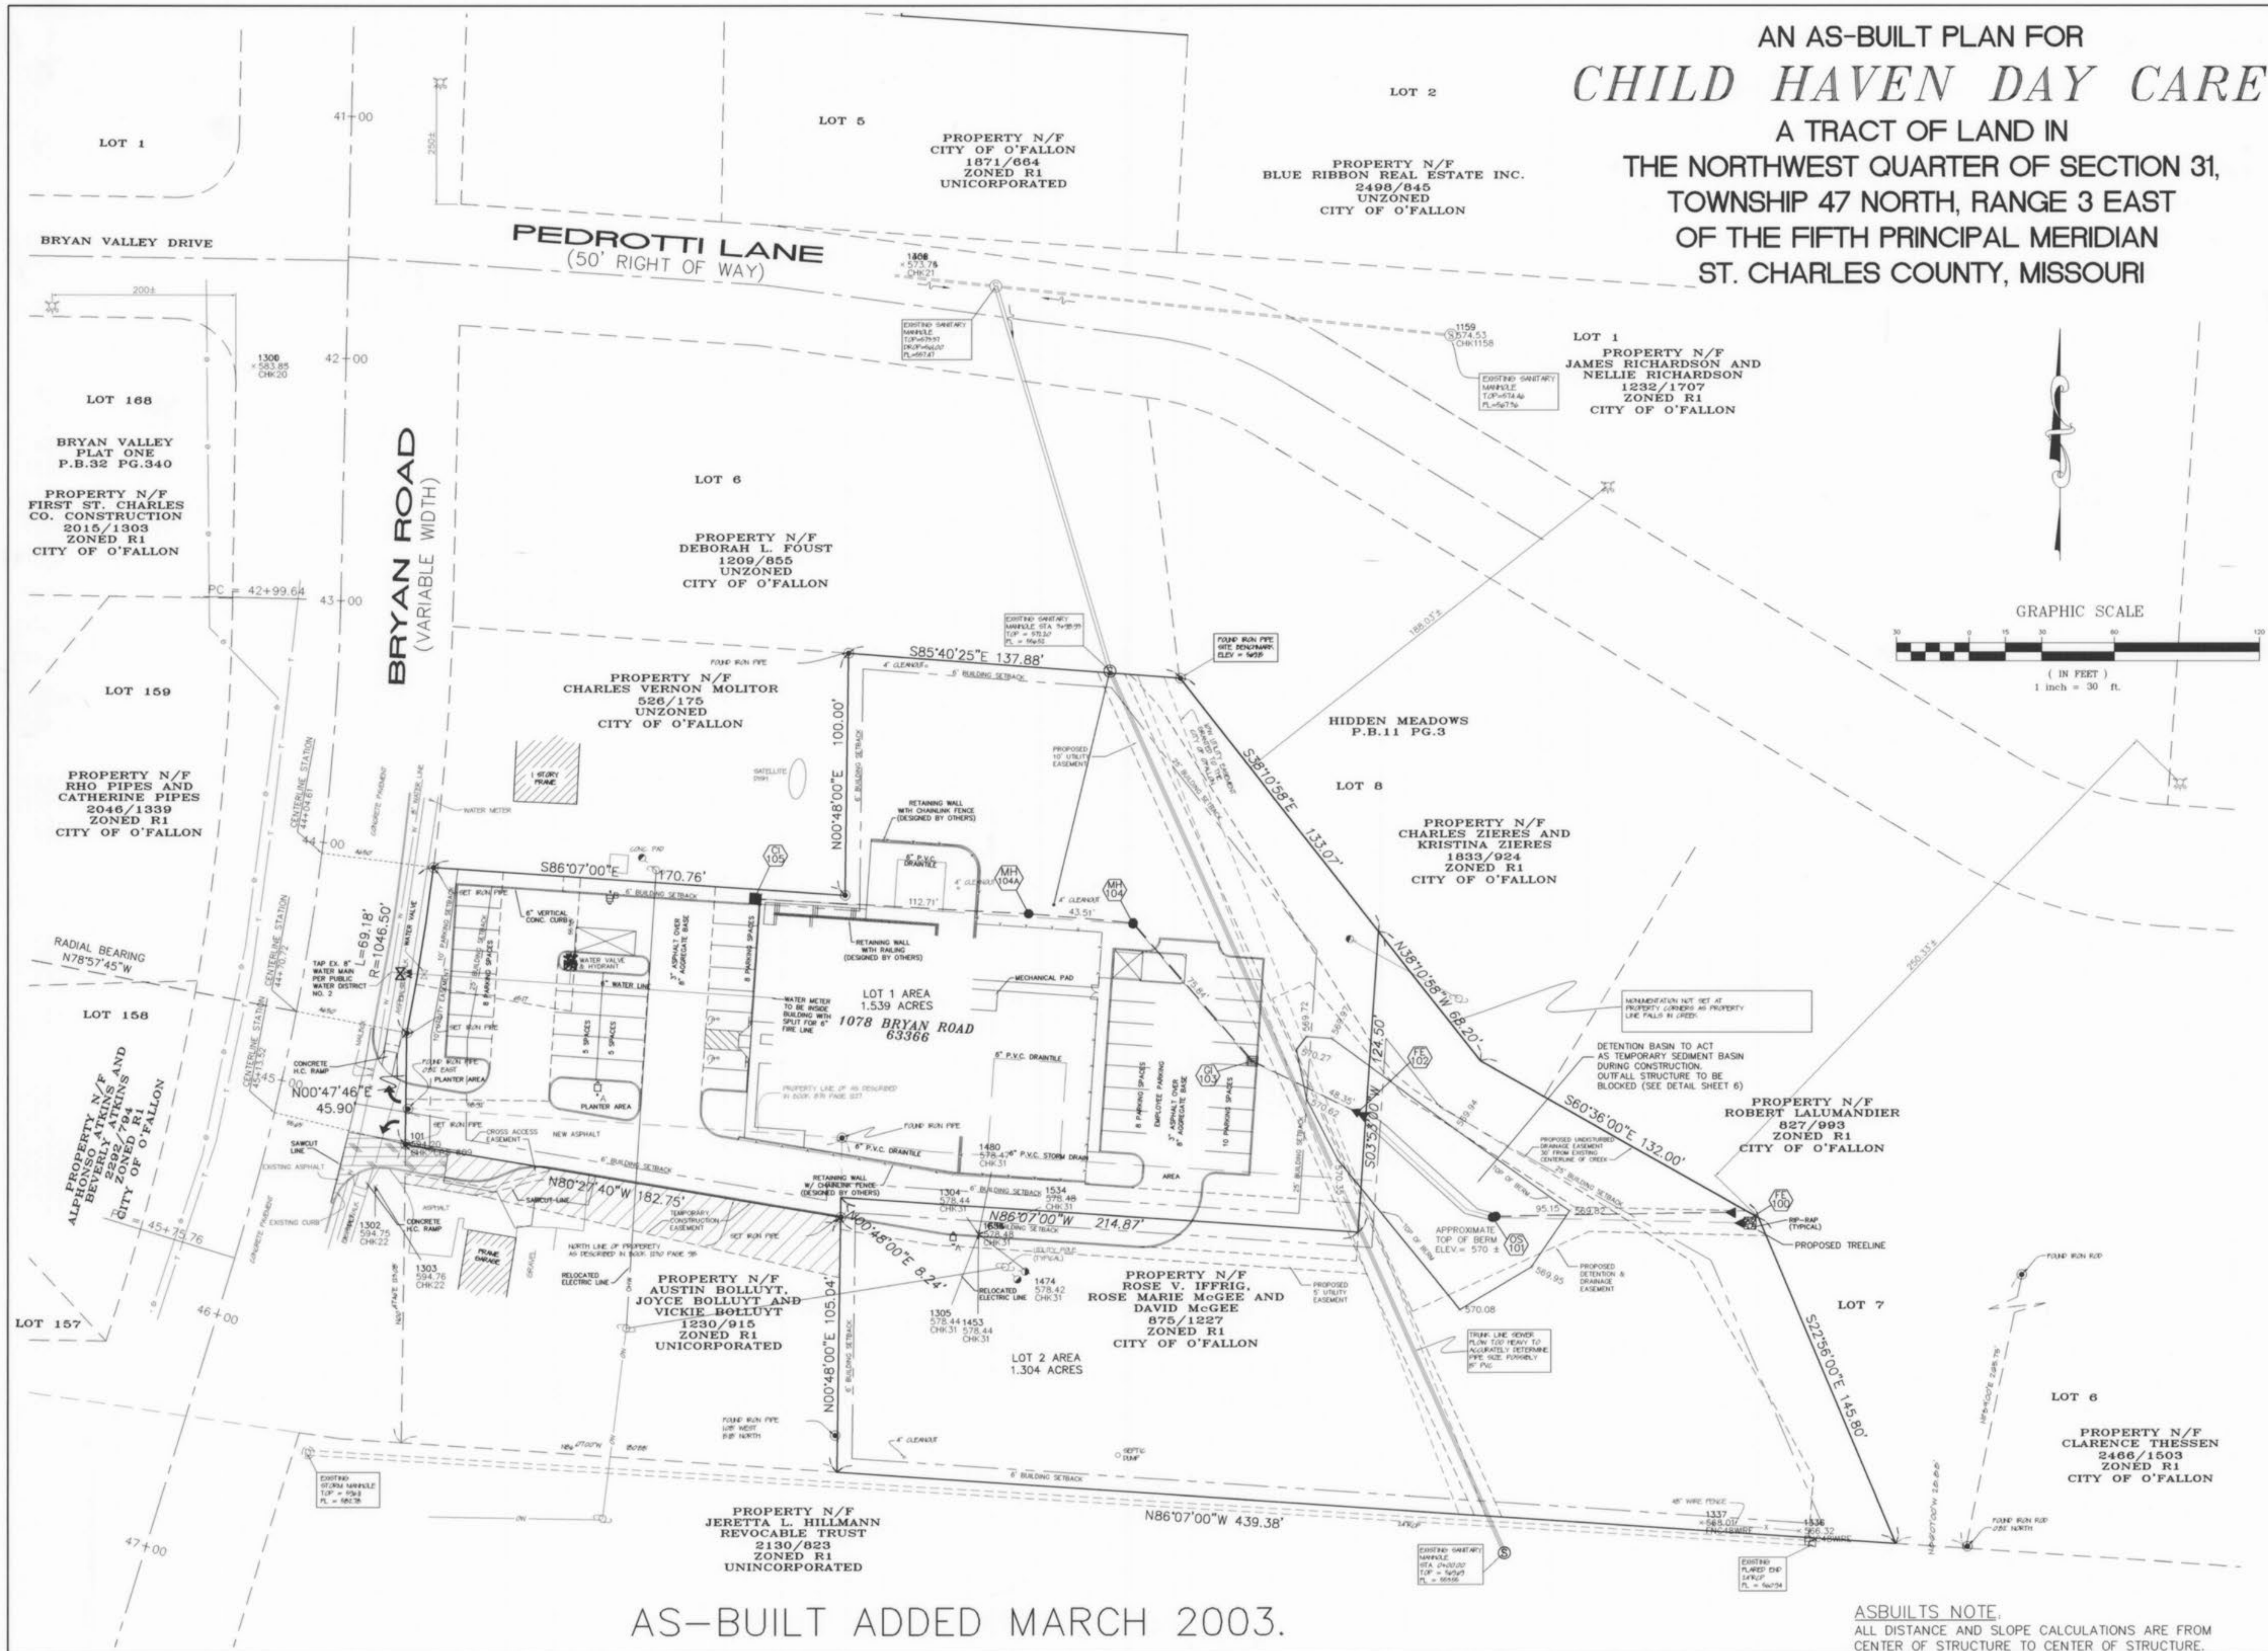

LOT 2

LOT 5

LOT 1

LOT 1

LOT 6

LOT 8

LOT 7

LOT 6


LOT 157

LOT 158

LOT 159

LOT 168

LOT 1

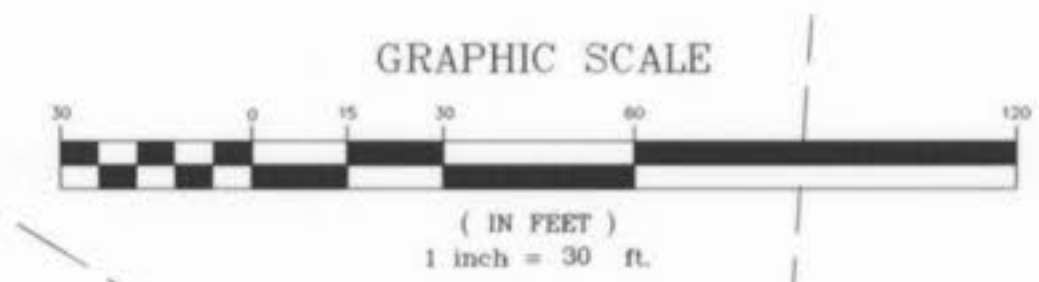


AS-BUILT ADDED MARCH 2003.

ASBUILTS NOTE:
ALL DISTANCE AND SLOPE CALCULATIONS ARE FROM
CENTER OF STRUCTURE TO CENTER OF STRUCTURE.

PREPARED FOR:
CHILD HAVEN DAY CARE
JIM PODHORSKY
6 WOOD GREEN COURT
O'FALLON, MISSOURI

DISCLAIMER OF RESPONSIBILITY
I hereby certify that the documents intended to be authorized by my seal are limited to the sheet and I hereby disclaim any responsibility for all other drawings, specifications, estimates, reports or other documents or instruments relating to or intended to be used for any part or parts of the architectural or engineering project or survey.

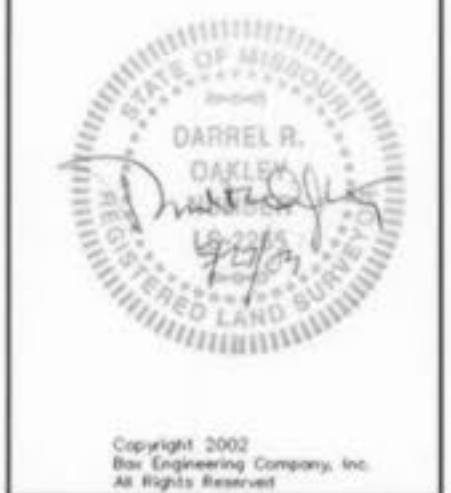

REVISIONS














NO.	DATE	DESCRIPTION

B74
ENGINEERING
PLANNING
SURVEYING
1052 South Cloverleaf Drive
St. Peters, MO. 63376-6445
636-928-5552
FAX 928-1718

03-10-03
DATE
01-11610
PROJECT NUMBER
2 OF 3
SHEET OF
11610ASB.DWG
FILE NAME
ECF
DRAWN
DESIGNED CHECKED

Child Haven 2/3


ROUND PIPE				HORIZONTAL ELLIPTICAL PIPE			
INCHES	PAVLINE WIDTH OF TRENCH (INCHES)	PAVLINE WIDTH OF TRENCH (FEET)	CONCRETE ENCUMBRANCE	INCHES	PAVLINE WIDTH OF TRENCH (INCHES)	PAVLINE WIDTH OF TRENCH (FEET)	CONCRETE ENCUMBRANCE
4	30	2.50	3.28				
6	30	2.50	3.59				
8	30	2.50	3.87				
10	30	2.50	4.09				
12	30	2.50	4.29				
15	36	3.00	5.25				
18	36	3.00	5.77	14 x 23	41	3.42	5.94
21	39	3.25	6.61				
24	42	3.50	7.39	19 x 30	49	4.08	7.68
27	45	3.75	8.18	22 x 34	53	4.42	8.61
30	49	4.09	9.30	24 x 38	58	4.83	9.70
33	53	4.42	10.33	27 x 42	62	5.17	10.71
36	56	4.67	11.43	29 x 45	66	5.50	11.72
39	59	4.92	12.49	32 x 49	71	5.92	12.74
42	63	5.25	13.38	34 x 53	75	6.25	14.05
45	70	5.83	15.67	38 x 60	83	6.92	16.18
54	77	6.42	18.15	43 x 68	92	7.67	18.81
60	84	7.00	20.73	48 x 76	101	8.42	21.59
66	91	7.58	23.45	53 x 83	109	9.08	24.35
72	98	8.17	26.37	58 x 91	118	9.83	27.45
78	105	8.75	29.30	63 x 98	126	10.50	30.50
84	112	9.33	32.57	68 x 106	135	11.25	33.91
90	119	9.92	35.90	72 x 113	143	11.92	36.99
96	126	10.50	39.37	77 x 121	152	12.67	40.89
102	133	11.08	42.99	82 x 128	160	13.33	44.45
108	140	11.67	46.75	87 x 136	168	14.00	47.79
114	147	12.25	50.66	92 x 143	176	14.67	51.70
120	154	12.83	54.72	97 x 151	185	15.42	56.01
126	161	13.42	58.92				
132	168	14.00	63.27	106 x 166	202	16.83	64.48
144	182	15.17	72.40	116 x 180	218	18.17	73.99

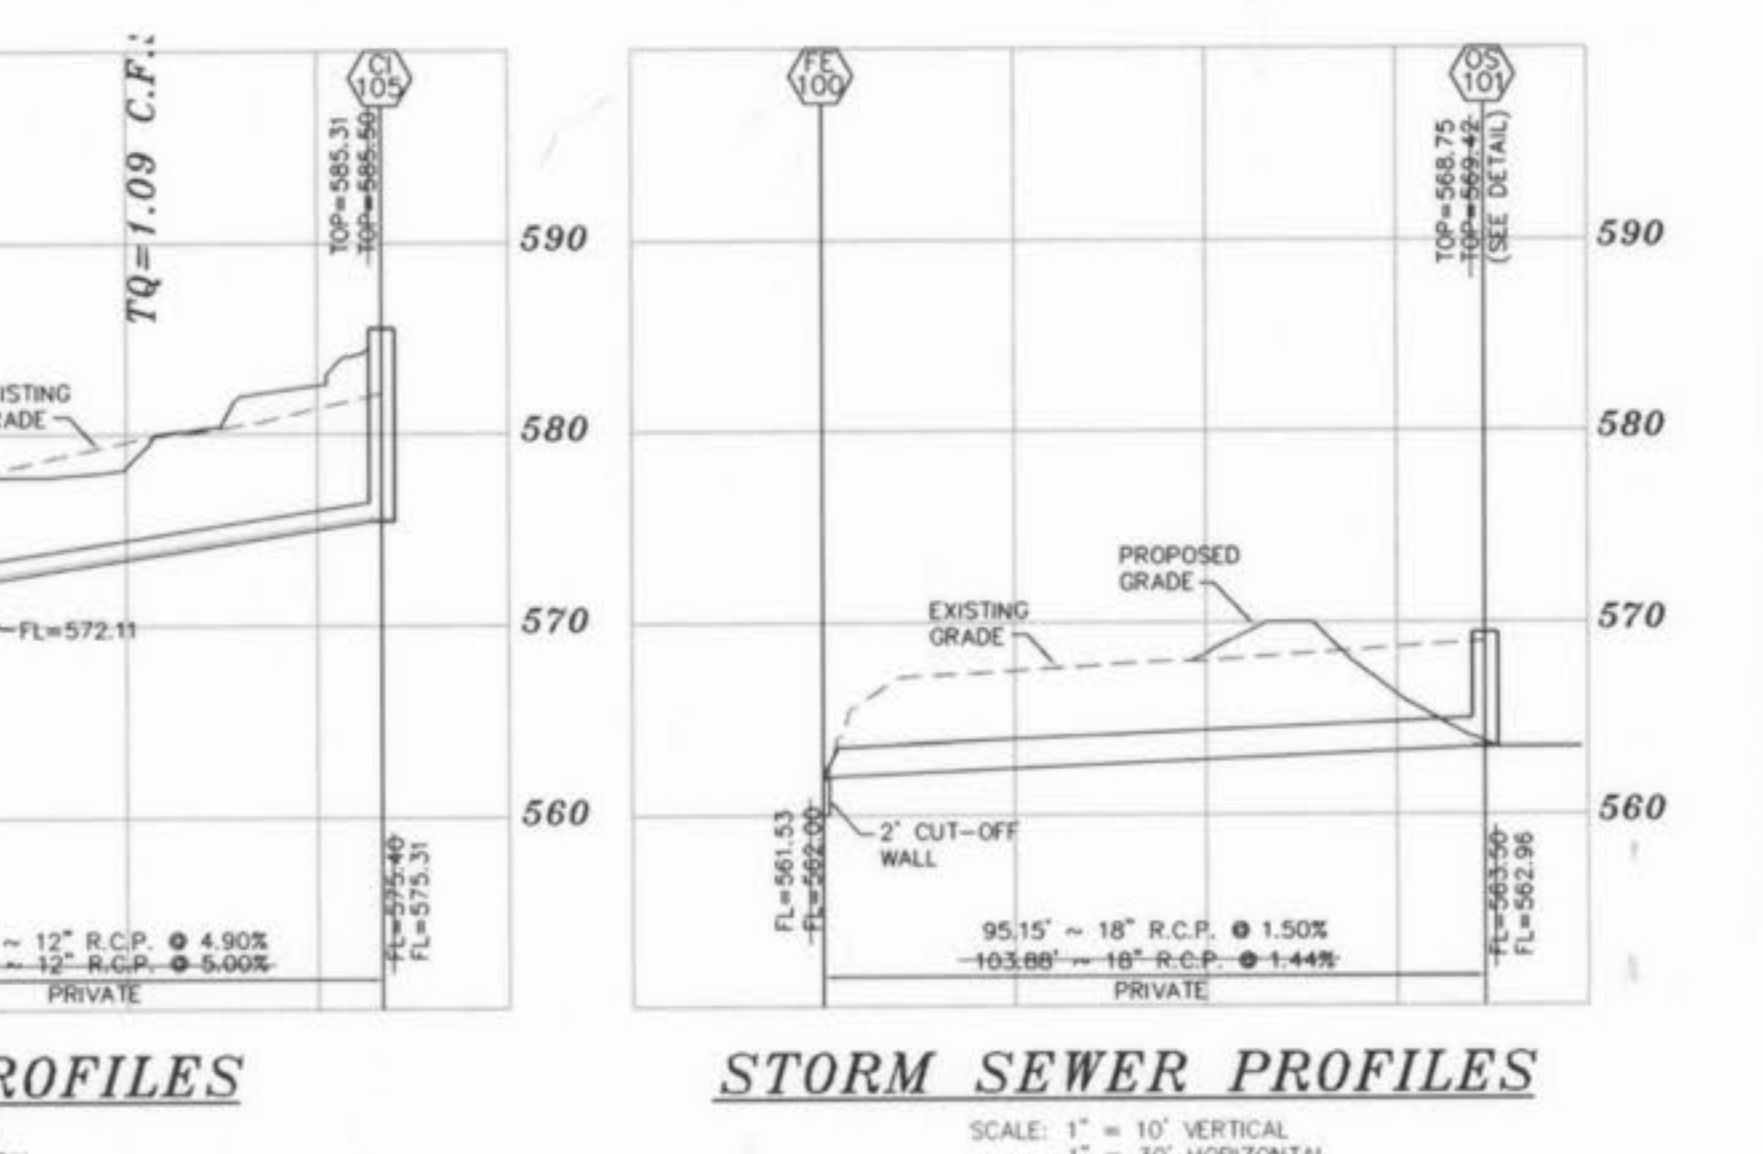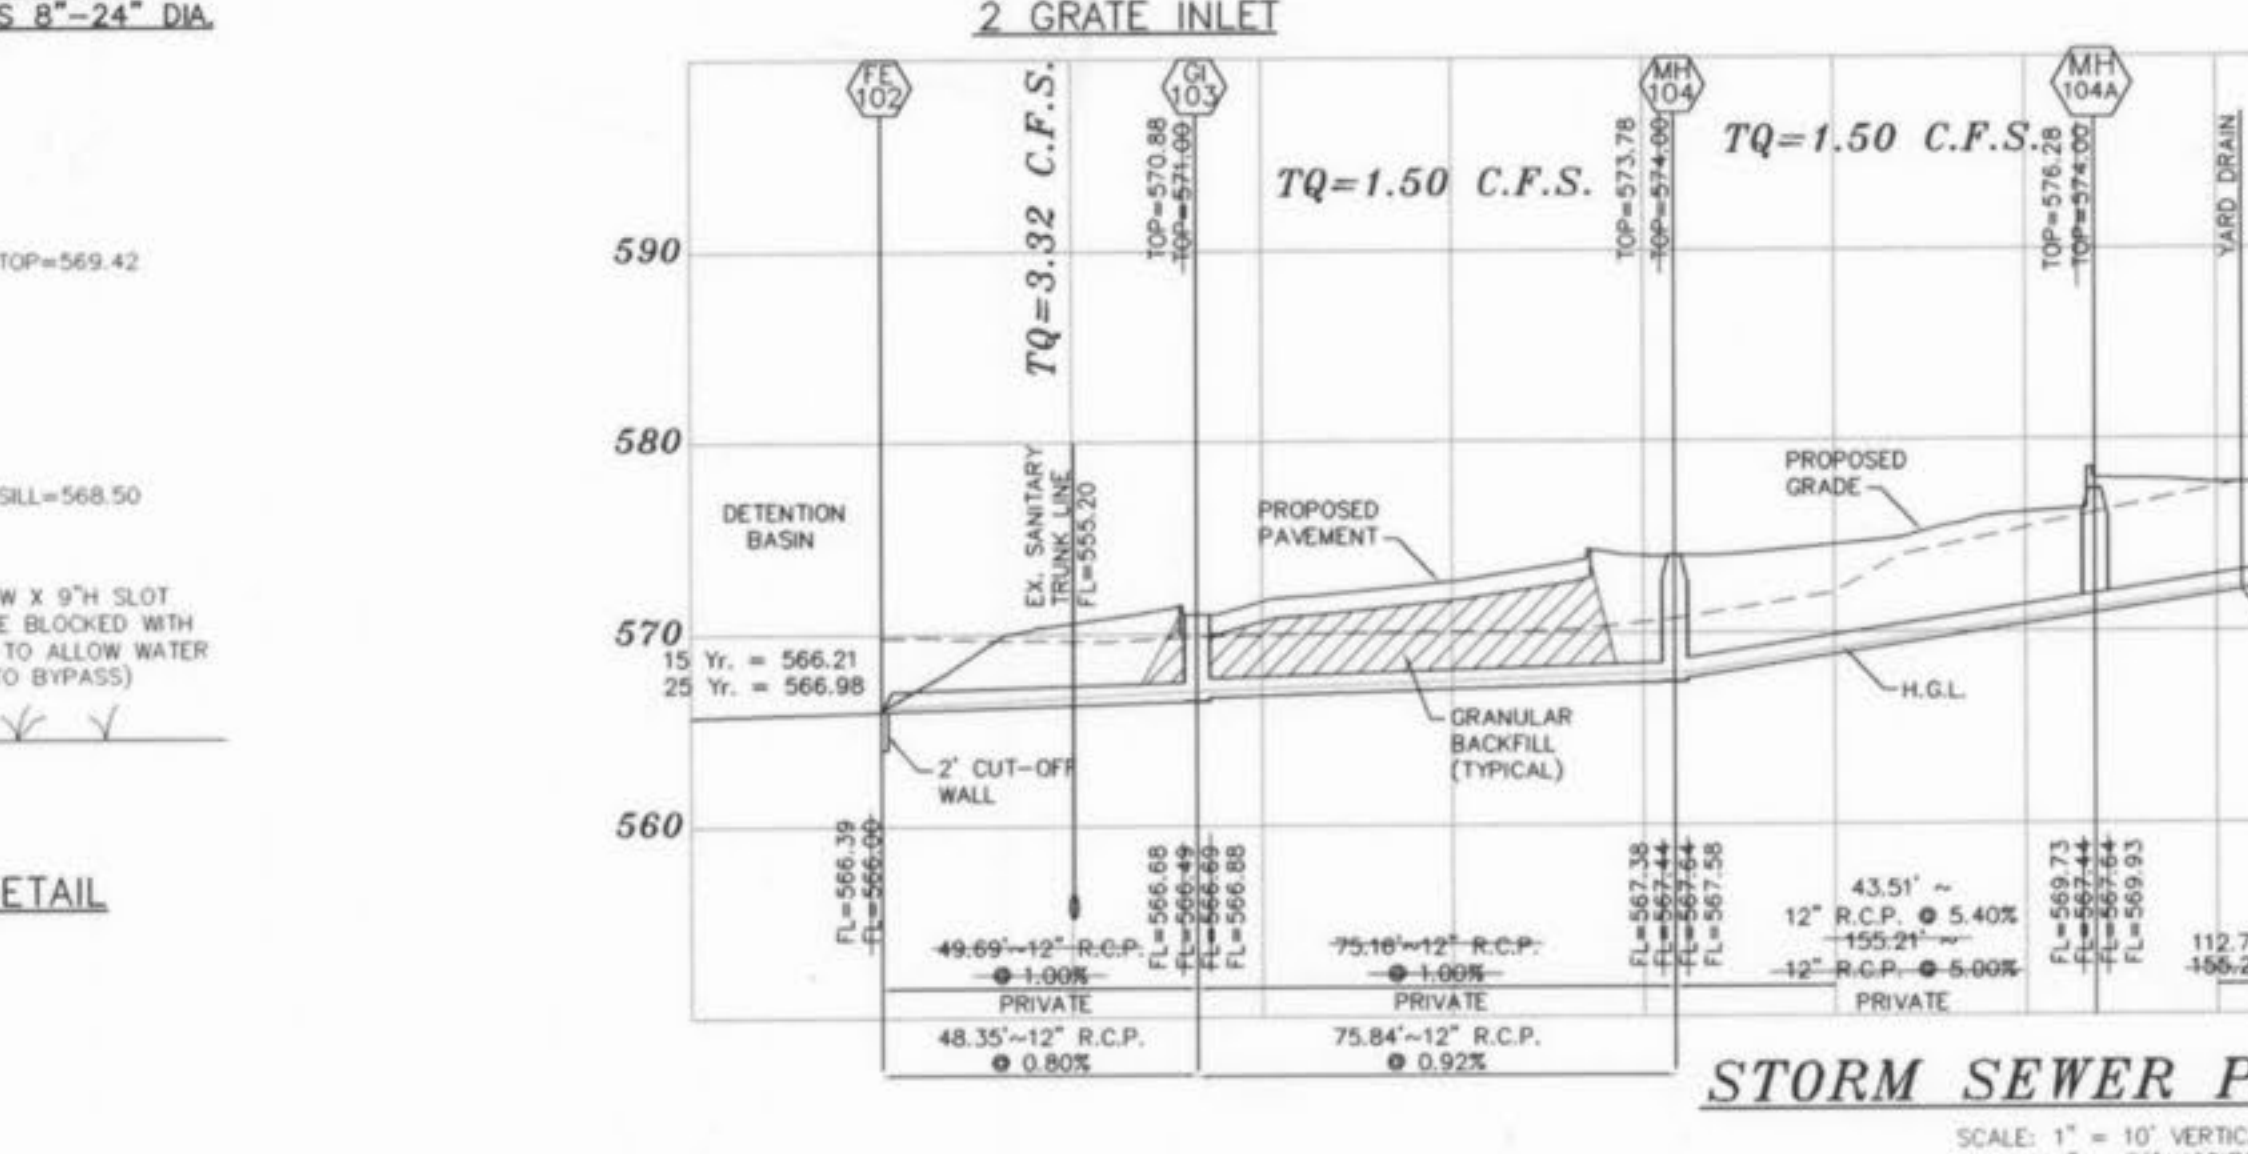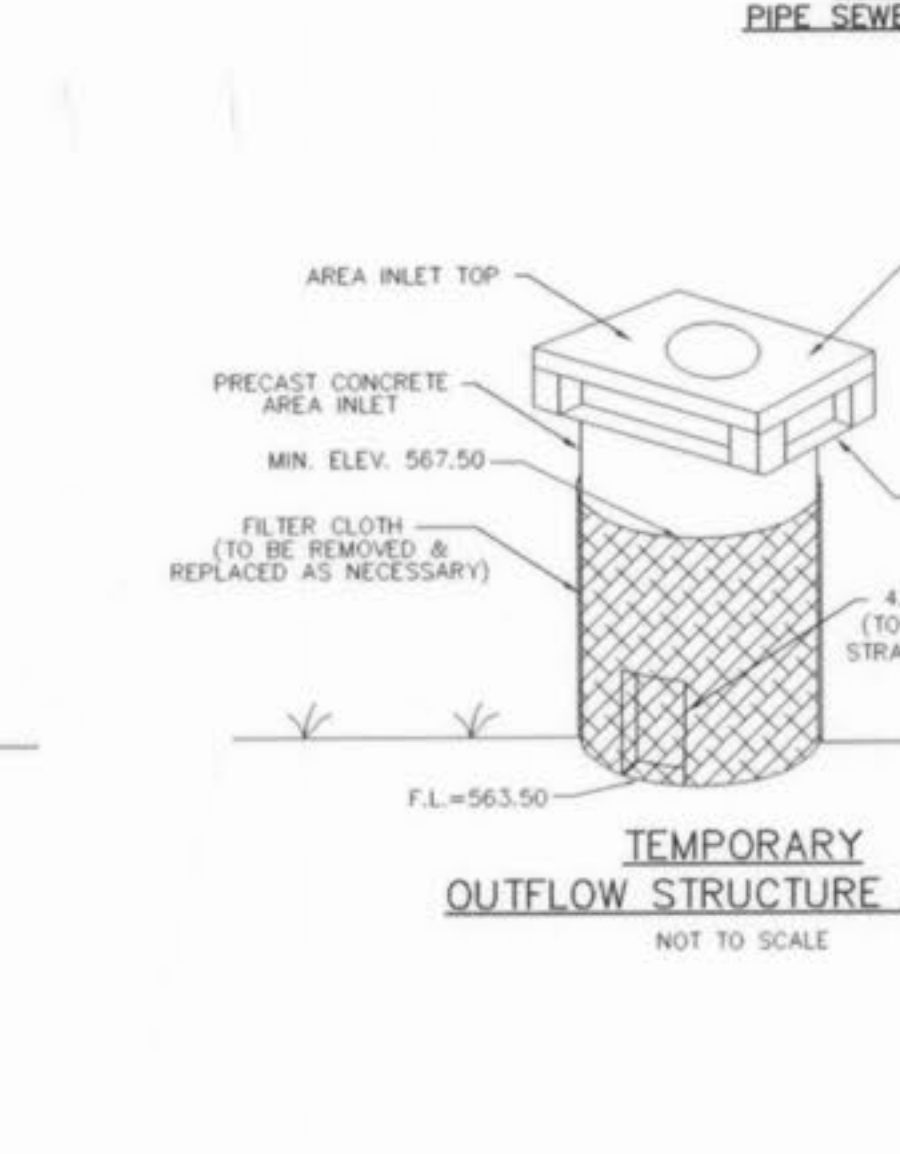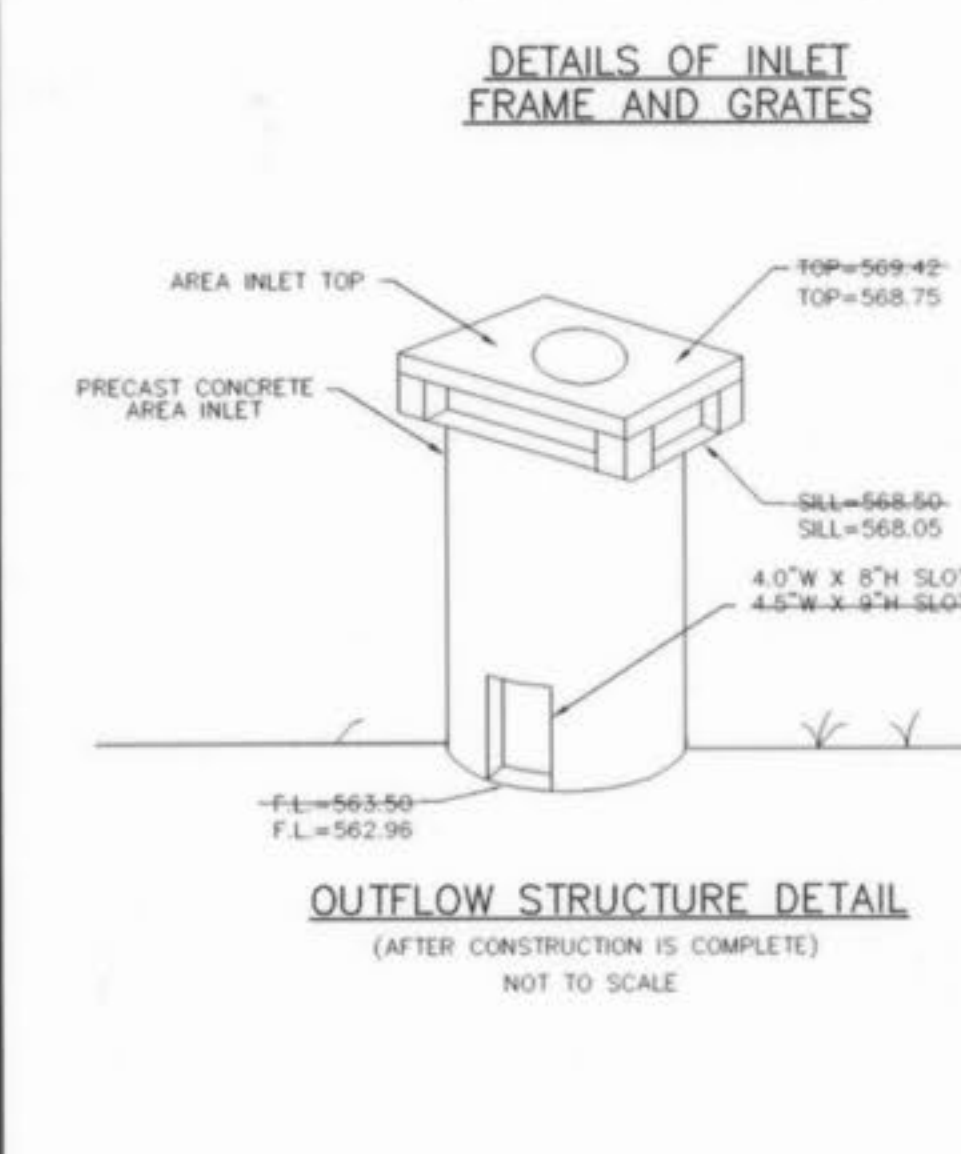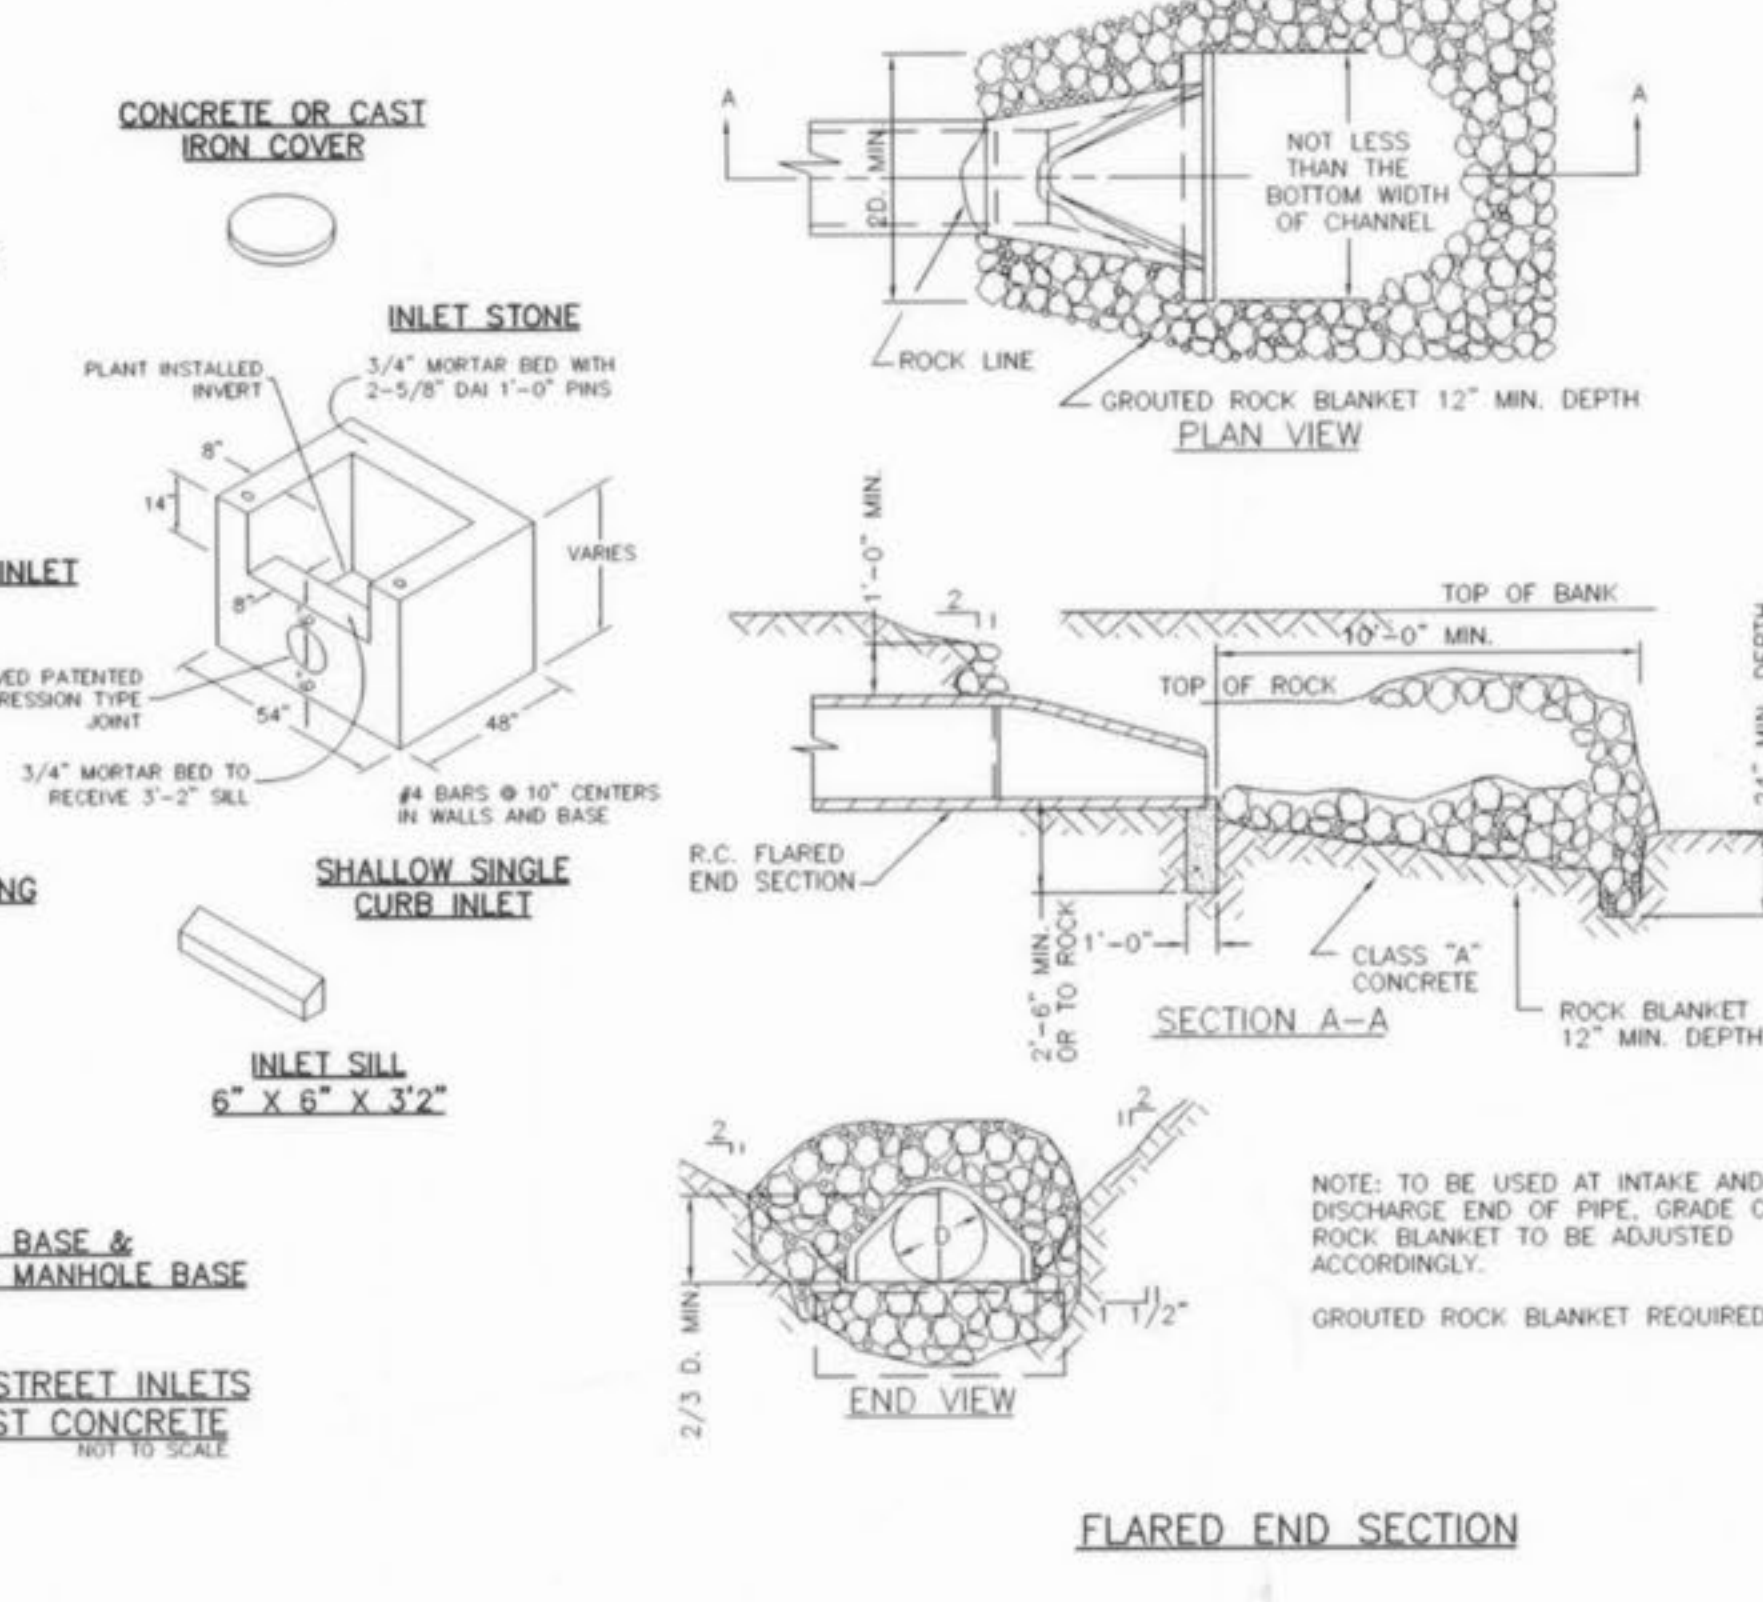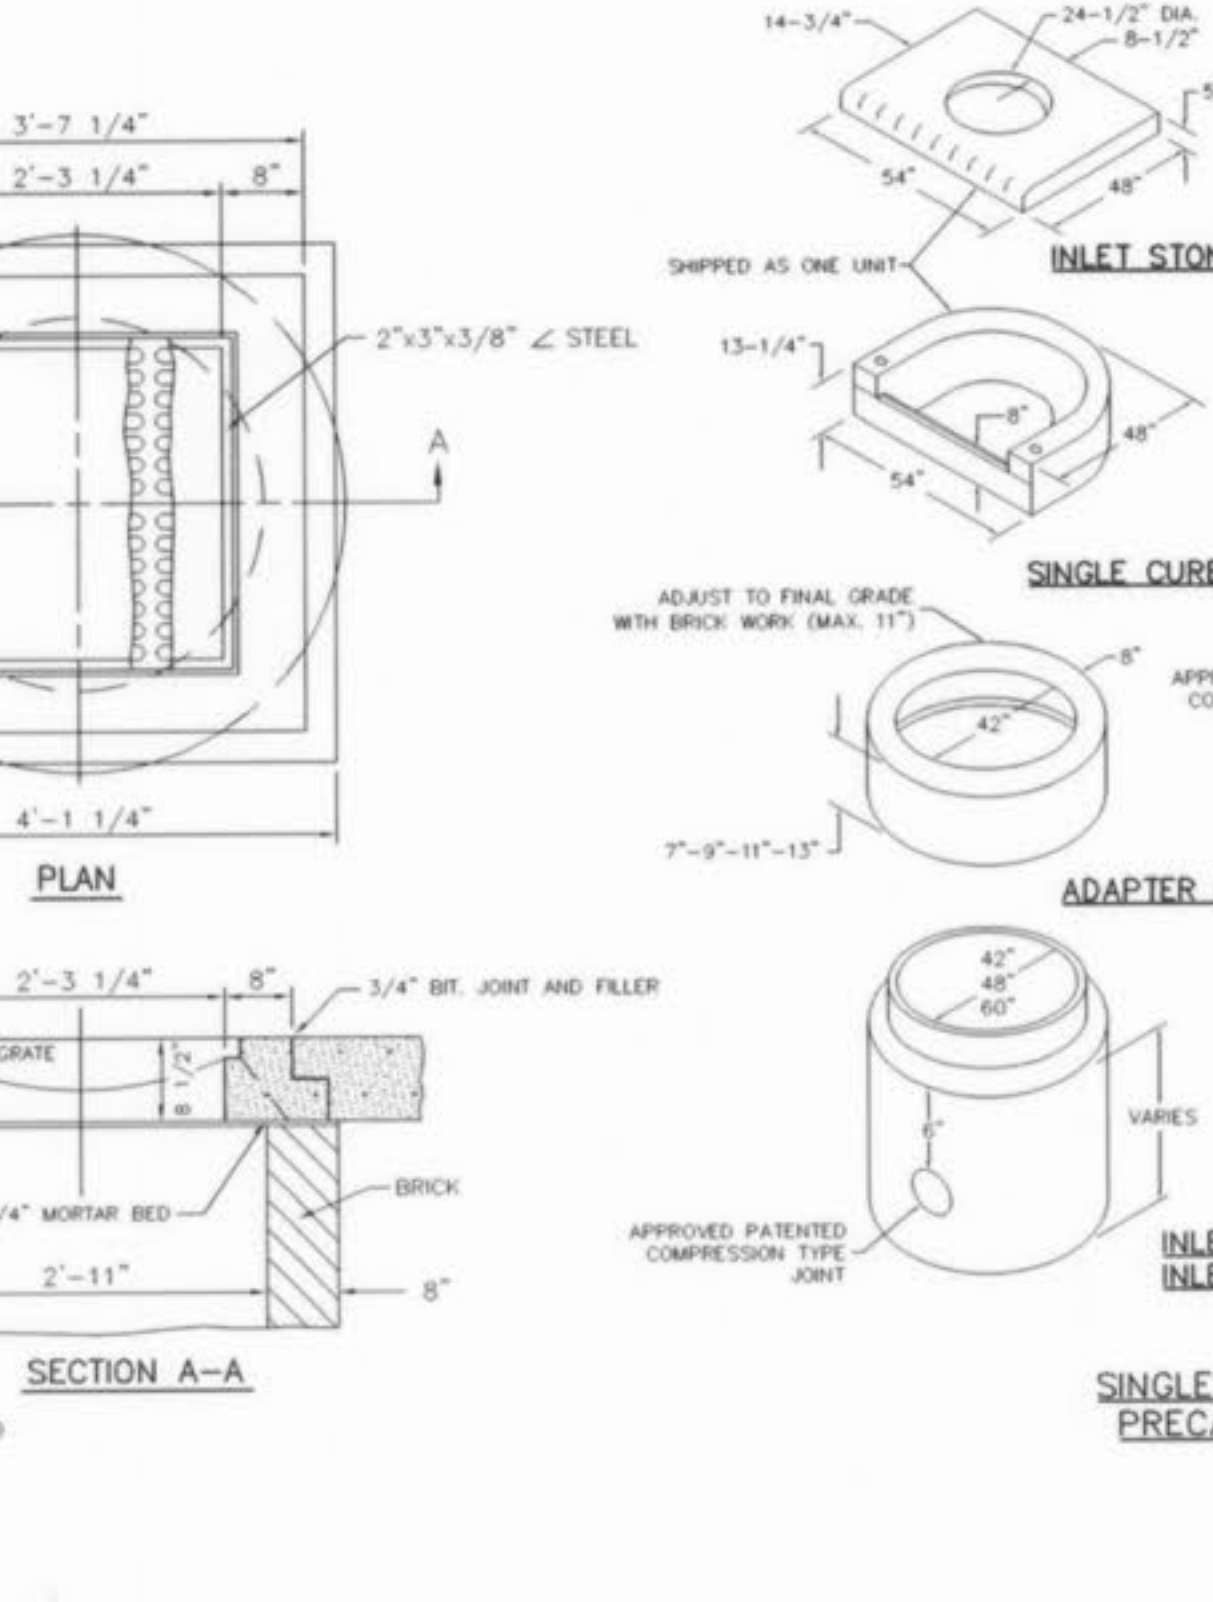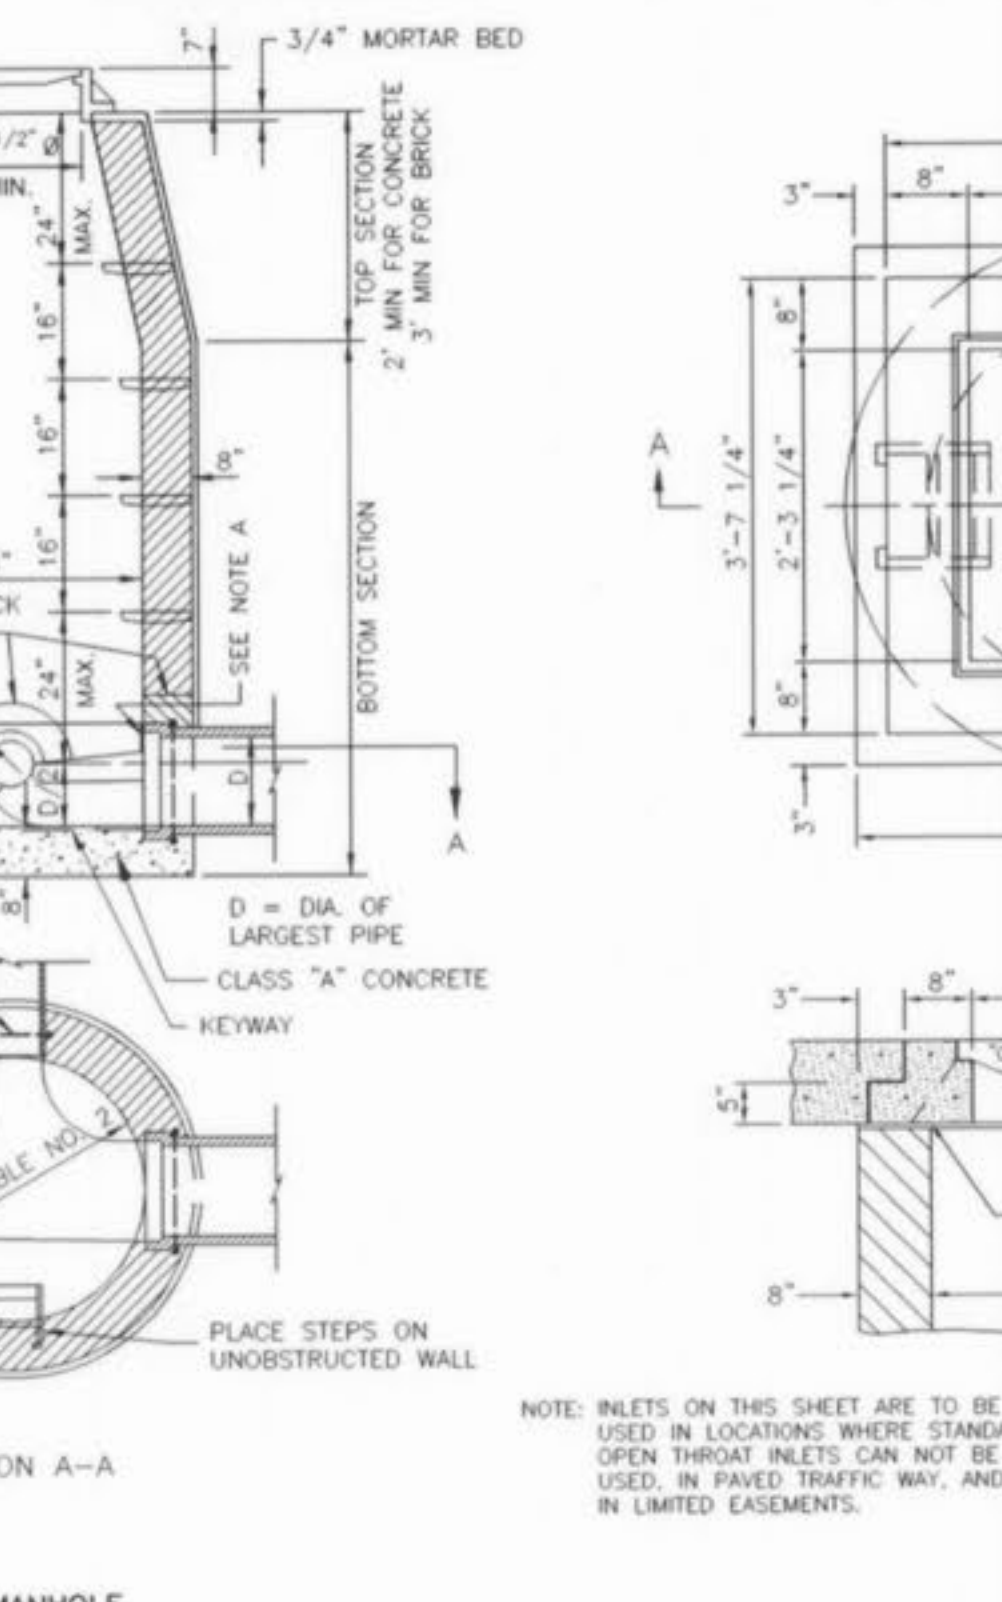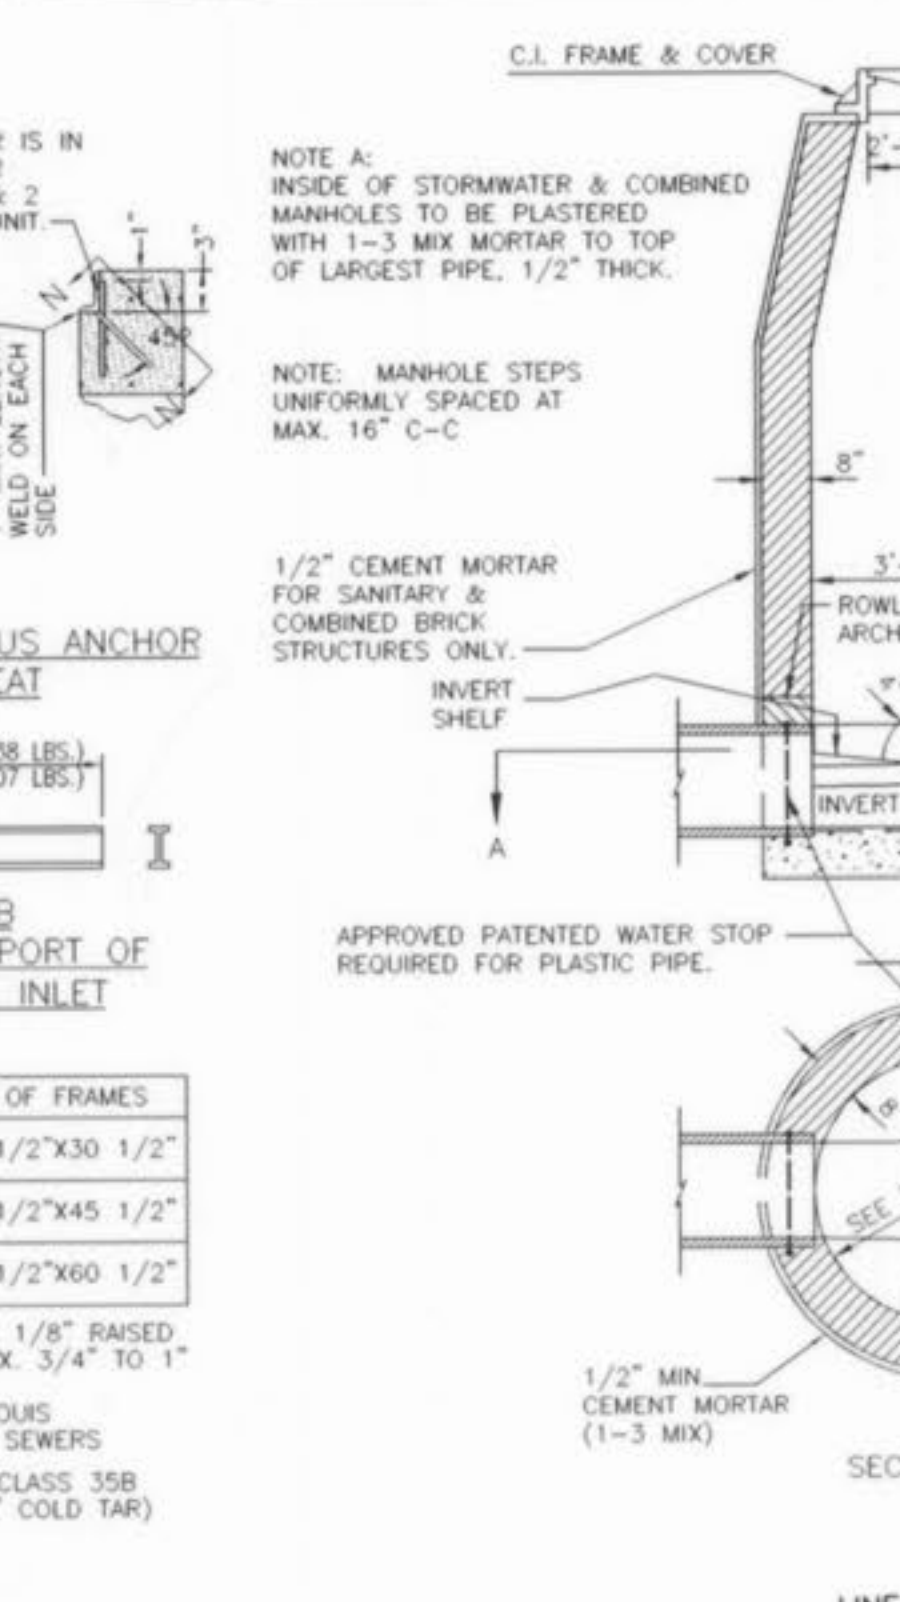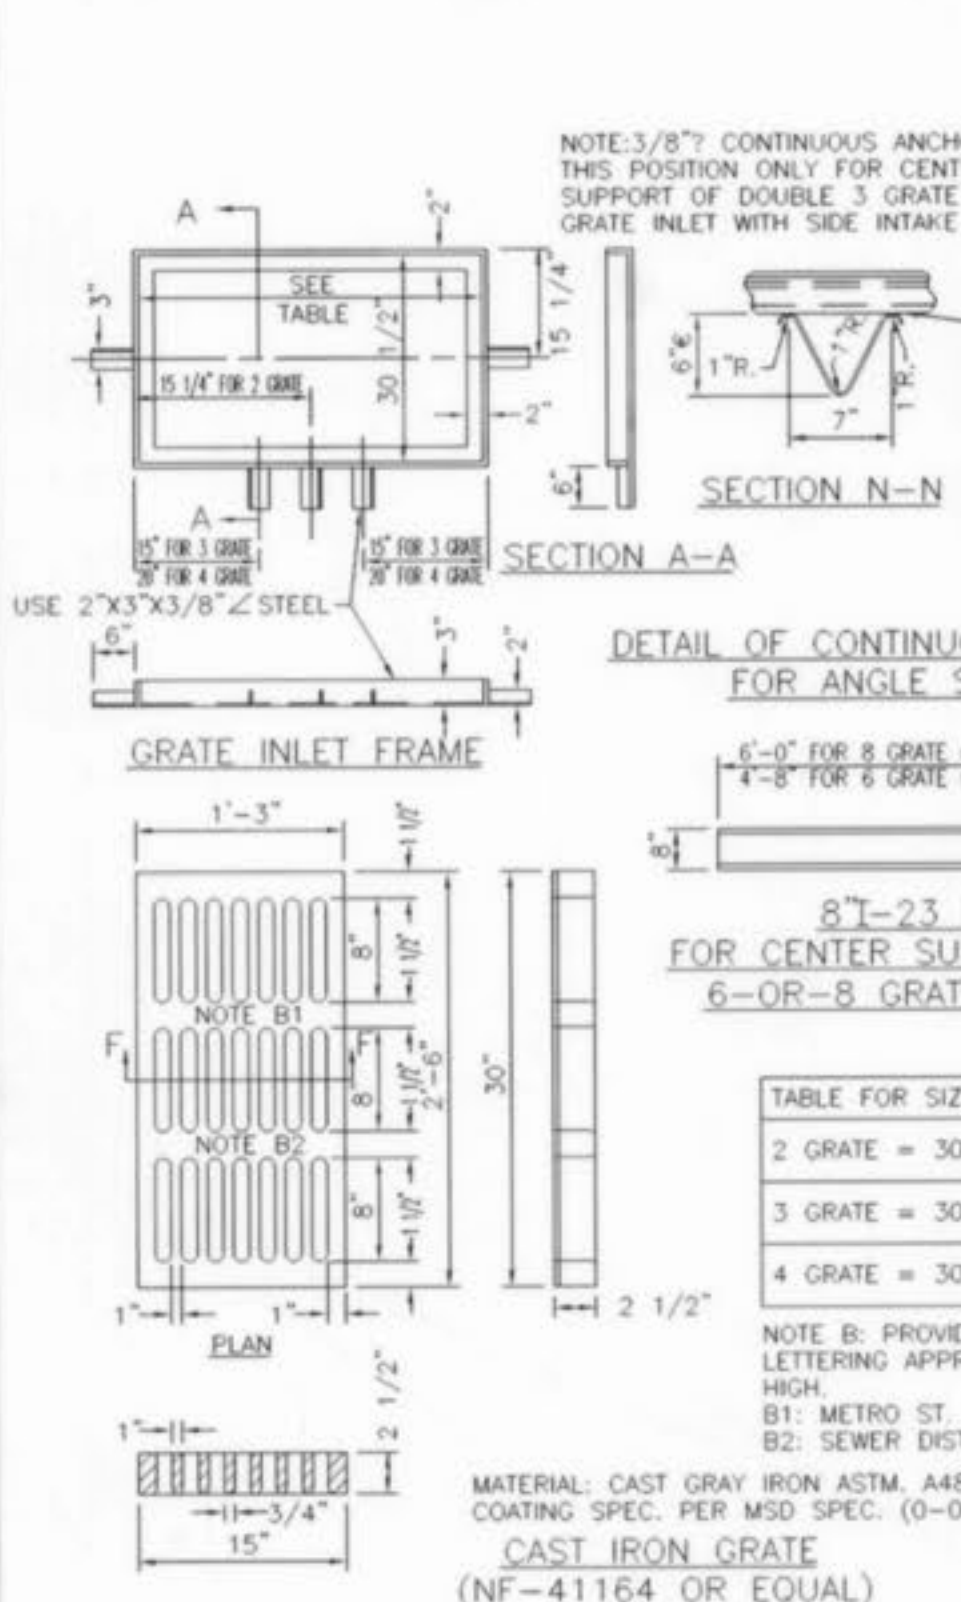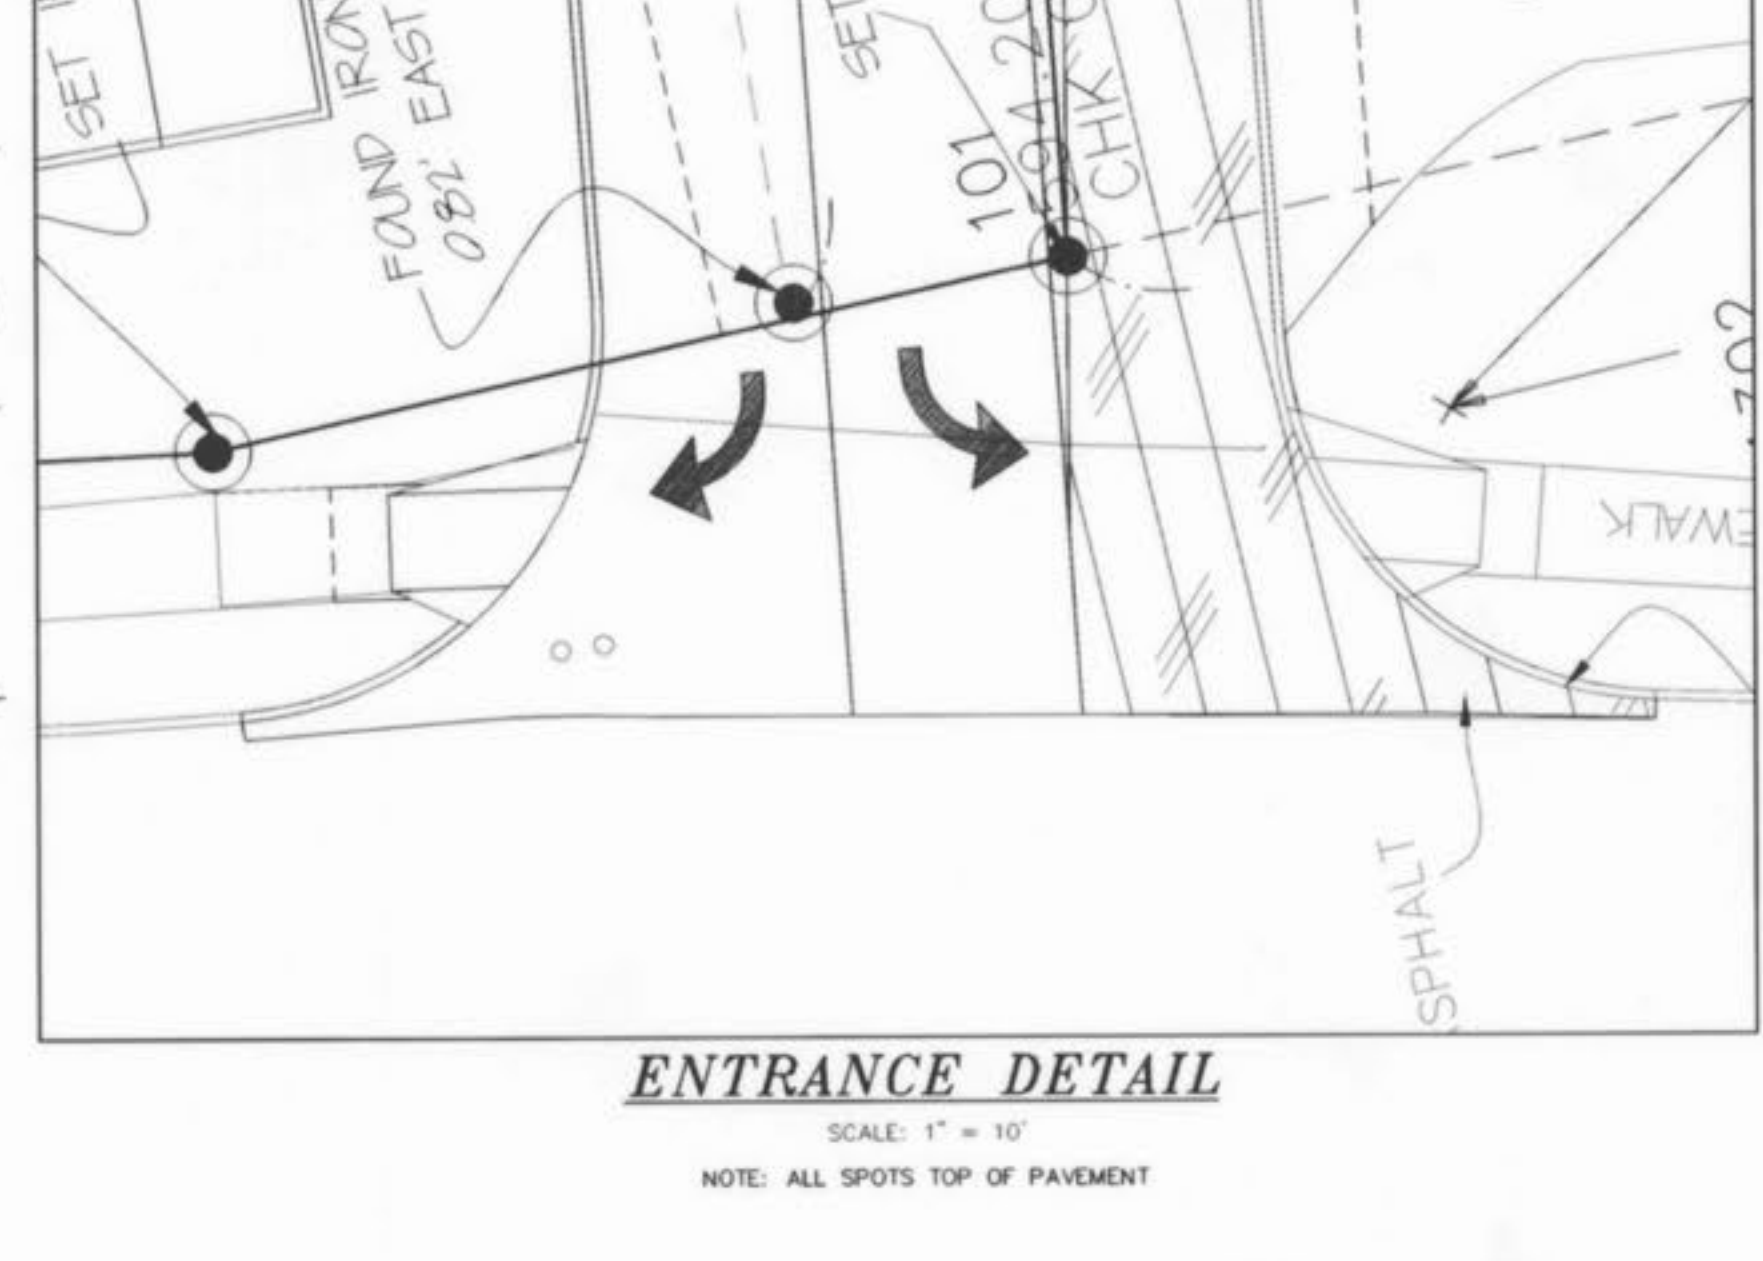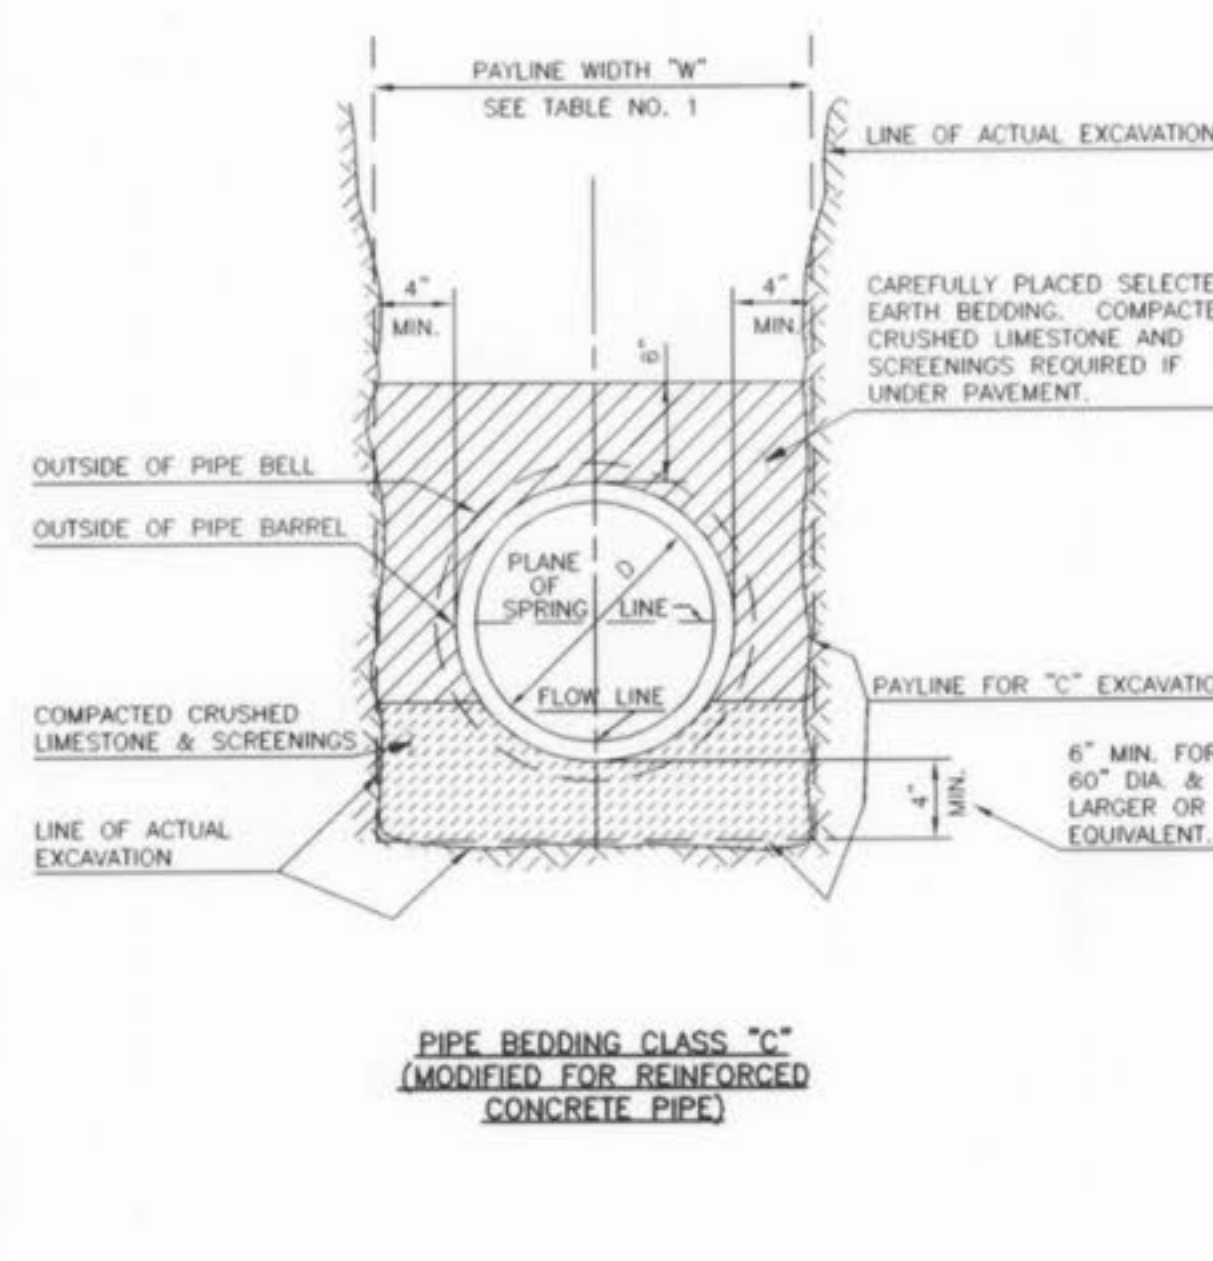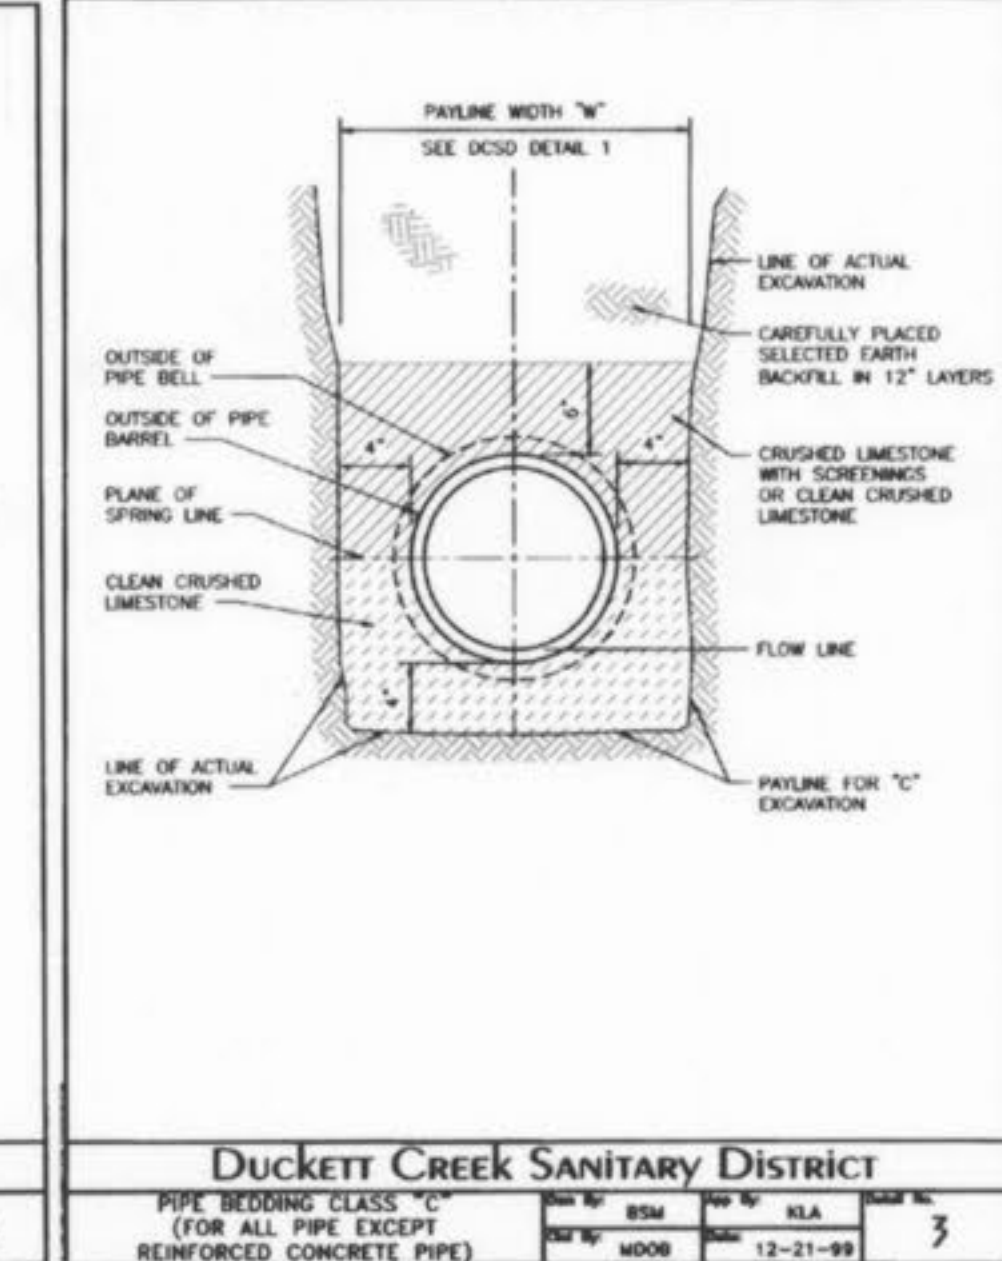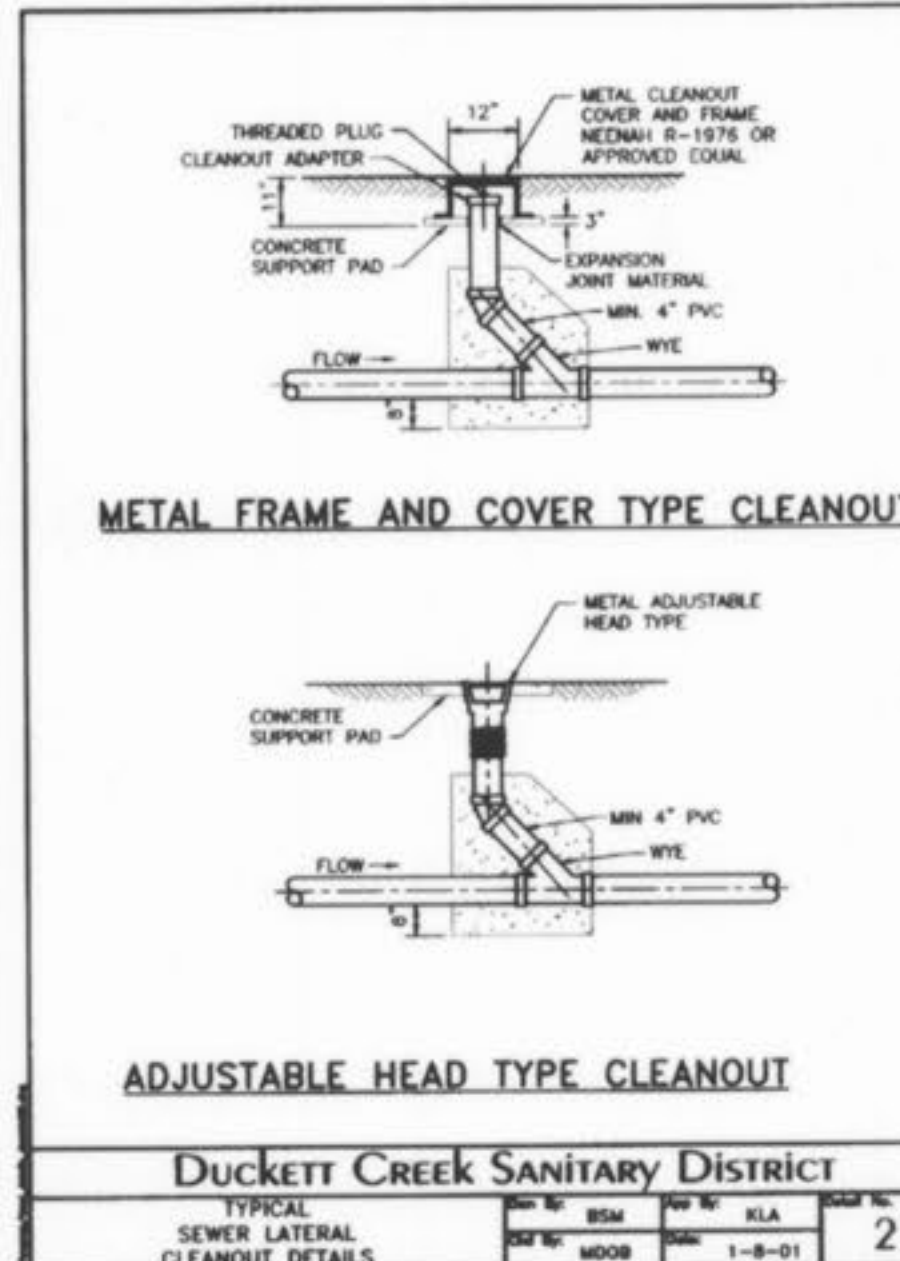

AS-BUILT ADDED MARCH 2003.

ASBUILTS NOTE:
ALL DISTANCE AND SLOPE CALCULATIONS ARE FROM CENTER OF STRUCTURE TO CENTER OF STRUCTURE.

PREPARED FOR:
CHILD HAVEN DAY CARE
JIM PODHORSKY
6 WOOD GREEN COURT
O'FALLON, MISSOURI

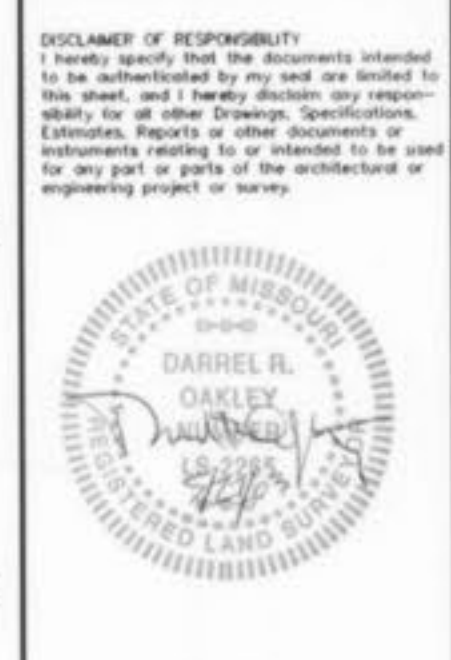

NO.	REVISIONS

BAT
ENGINEERING
PLANNING
SURVEYING
1052 South Cloverleaf Drive
St. Peters, MO. 63376-6445
636-928-5552
FAX 928-1718

03-10-03
DATE
01-11610
PROJECT NUMBER
3 OF 3
SHEET OF
11610ASB.DWG
FILE NAME
ECF
DRAWN
DESIGNED CHECKED