

LOCATION MAP

N.T.S.

GRADING NOTES

- A Geotechnical Engineer shall be employed by the owner and be on site during grading operations. All soils tests shall be verified by the Geotechnical Engineer concurrent with the grading and backfilling operations.
- The grading contractor shall perform a complete grading and compaction operation as shown on the plans, stated in these notes, or reasonably implied there from, all in accordance with the plans and notes as interpreted by the Geotechnical Engineer.
- The Contractor shall notify the Soils Engineer at least two days in advance of the start of the grading operation.
- All areas shall be allowed to drain. All low points shall be provided with temporary ditches.
- A sediment control plan that includes monitored and maintained sediment control basins and/or straw bales should be implemented as soon as possible. No graded area is to be allowed to remain bare over the winter without being seeded and mulched. Care should be exercised to prevent soil from damaging adjacent property and silting up existing downstream storm drainage system.
- Soft soil in the bottom and banks of any existing or former pond sites or tributaries should be removed, spread out and permitted to dry sufficiently to be used as fill. None of this material should be placed in proposed right-of-way locations or on storm sewer locations.
- Site preparation includes the clearance of all stumps, trees, bushes, shrubs, and weeds; the grubbing and removal of roots and other surface obstructions from the site; and the demolition and removal of any man-made structures. The unsuitable material shall be properly disposed of off-site. Topsoil and grass in the fill areas shall be thoroughly disced prior to the placement of any fill. The Soils Engineer shall approve the discing operation.
- Compaction equipment shall consist of tamping rollers, pneumatic-tired rollers, vibratory roller, or high speed impact type drum rollers acceptable to the Soils Engineer. The roller shall be designed so as to avoid the creation of a layered fill without proper blending of successive fill layers.
- The Soils Engineer shall observe and test the placement of the fill to verify that specifications are met. A series of fill density tests will be determined on each lift of fill. Interim reports showing fill quality will be made to the Owner at regular intervals.
- The Soils Engineer shall notify the Contractor of rejection of a lift of fill or portion thereof. The Contractor shall rework the rejected portion of fill and obtain notification from the Soils Engineer of its acceptance prior to the placement of additional fill.
- All areas to receive fill shall be scarified to a depth of not less than 6 inches and then compacted in accordance with the specifications given below. Natural slopes steeper than 1 vertical to 5 horizontal to receive fill shall have horizontal benches, cut into the slopes before the placement of any fill. The width and height to be determined by the Soils Engineer. The fill shall be loosely placed in horizontal layers not exceeding 8 inches in thickness and compacted in accordance with the specifications given below. The Soils Engineer shall be responsible for determining the acceptability of soils placed. Any unacceptable soils placed shall be removed at the Contractor's expense.
- The sequence of operation in the fill areas will be fill, compact, verify acceptable soil density, and repetition of the sequence. The acceptable moisture contents during the filling operation are those at which satisfactory dry densities can be obtained. The acceptable moisture contents during the filling operation in the remaining areas are from 2 to 8 percent above the optimum moisture control.
- The surface of the fill shall be finished so that it will not impound water. If at the end of a day's work it would appear that there may be rain prior to the next working day, the surface shall be finished smooth. If the surface has been finished smooth for any reason, it shall be scarified before proceeding with the placement of succeeding lifts. Fill shall not be placed on frozen ground, nor shall filling operations continue when the temperature is such as to permit the layer under placement to freeze.

GENERAL NOTES

- Underground utilities have been plotted from available information and therefore their locations shall be considered approximate only. The verification of the location of all underground utilities, either shown or not shown on these plans shall be the responsibility of the contractor, and shall be located prior to any grading or construction of the improvements.
- All manhole tops built without elevations furnished by the Engineer will be the responsibility of the sewer contractor.
- 8" P.V.C. sanitary sewer pipe shall meet the following standards. A.S.T.M.-D-3034 SDR-35, with wall thickness compression joint A.S.T.M.-D-3212. An appropriate rubber seal watertight as approved by the sewer district shall be installed between P.V.C. pipe and masonry structures.
- All filled places, including trench backfills, under buildings, proposed storm and sanitary sewer lines and/or paved areas and all filled places within public roadways shall be compacted to 95% of maximum density as determined by the "Standard Proctor Test" AASHTO T-99, Method C" (A.S.T.M.-D-698).
- All trench backfills under paved areas shall be granular backfill, and shall be compacted to 90% of the maximum density as determined by the "Modified AASHTO T-180 Compaction Test," (A.S.T.M.-D-1557). All other trench backfills may be earth material (free of large clods or stones). All trench backfills shall be water jetted.
- All sanitary house connections have been designed so that the minimum vertical distance from the low point of the basement to the flow line of a sanitary sewer at the corresponding house connection is not less than the diameter of the pipe plus the vertical distance of 2 1/2 feet.
- No area shall be cleared without the permission of the Project Engineer.
- All grades shall be within 0.2 feet of those shown on the grading plan.
- No slope shall be steeper than 3:1 or as called for in the soils report for the project. All slopes shall be sodded or seeded and mulched.
- All construction and materials used shall conform to current City of O'Fallon Standards.
- All soils test shall be verified by a Soils Engineer concurrent with the grading and backfilling operations.
- Easements shall be provided for sanitary sewers, and all utilities on the Record Plat. See Record Plat for location and size of easements.
- Maintenance and upkeep of the common ground area shall be the responsibility of the developer and/or successors.
- A 25' building line shall be established along all Public Right-Of-Way.
- All water lines shall be laid at least 10 feet horizontally, from any sanitary sewer, storm sewer, or manhole. Whenever water lines must cross sanitary sewers, laterals, or storm drains the water line shall be laid at such an elevation that the bottom of the water line is above the top of the drain or sewer. A full length of water pipe shall be centered over the sewer line to be crossed so that the joints will be equally distant from the sewer and as remote therefrom as possible. This vertical separation shall be maintained for that portion of the water line located within 10 feet horizontally, of any sewer or drain it crosses.
- All PVC water mains shall have a minimum pressure rating of PR-200 or SDR-21.
- Water lines, valves, sleeves, meters, and fittings shall meet all specifications and installation requirements of the City of O'Fallon.
- All water hydrants and valves shall be ductile iron and installed in accordance with plans and details. All ductile iron pipe for water mains shall conform to A.W.W.A. Specifications C-106 and/or C-108. The ductile iron fittings shall conform to A.W.W.A. Specification CC-110. All rubber gasket joints for water ductile iron pressure pipe and fittings shall conform to A.W.W.A. Specification C-111.
- All lots with minimum basement floors to have elevation certificates.

WATER, SANITARY & STORM SEWER AS-BUILTS

PLANS FOR CONSTRUCTION OF SANITARY SEWERS, STORM SEWERS,
PAVING, GRADING, AND WATER MAINS FOR:



A TRACT OF LAND BEING PART OF SECTION 20 AND PART OF FRACTIONAL SECTION 29
TOWNSHIP 47 NORTH, RANGE 3 EAST, ST. CHARLES COUNTY, MISSOURI


LEGEND

D.I.	CURB INLET
D.C.I.	DOUBLE CURB INLET
A.I.	AREA INLET
M.F.E.	FLARED END SECTION
E.P.	END PIPE
C.P.	CONCRETE PIPE
R.C.P.	REINFORCED CONCRETE PIPE
C.M.P.	CORRUGATED METAL PIPE
C.I.	CAST IRON PIPE
P.V.C.	POLY VINYL CHLORIDE (PLASTIC)
C.G.	CLEAN OUT
X	FIRE HYDRANT
- - -	STORM SEWER
O	SANITARY SEWER
—	STREET LIGHT
— 582 —	EXISTING CONTOUR
— 582 —	PROPOSED CONTOUR
S.S.	STREET SIGN
W.V.	WATER VALVE
B.O.	BLOW OFF ASSEMBLY
—	FLOWLINE ELEVATION OF HOUSE CONNECTION
XXX	STREET ADDRESS



KEY MAP

This is to certify that following as-built locations were located in the field and are correctly shown herein.

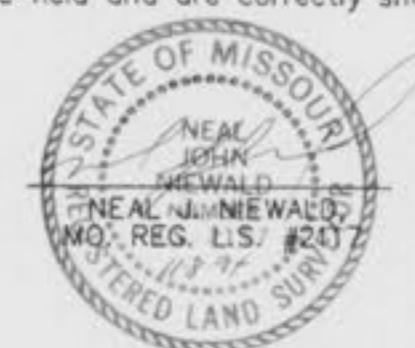

R & D EMGE INC.

306 IMPERIAL DRIVE
O'FALLON, MO 63366
314-281-1274

PREPARED FOR:

REVISIONS



ENGINEERING
PLANNING
SURVEYING

221 Point West Boulevard
St. Charles, MO 63301
314-946-6588
314-724-3330
FAX 314-947-9182

APRIL 7, 1994
DATE
92-3623
PROJECT NUMBER
1 OF 4
SHEET OF
3623CON.DWG
FILE NAME
BBB
DRAWN CHECKED

AS-BUILTS ADDED OCTOBER, 1994

Civic Park Estates Plat Two

SHEET INDEX

- 1 OF 4 - COVER SHEET
- 2 OF 4 - SITE PLAN
- 3 OF 13 - GRADING SHEET
- 3 OF 4 - WATER PLAN
- 5 OF 13 - STREET PROFILES
- 4 OF 4 - SEWER PROFILES
- 7 OF 13 - DRAINAGE AREA MAP
- 8 THRU 13 - DETAIL SHEETS

- Flood plain information is per F.I.R.M. Map # 29183 C0110 D.
- U.S.G.S. Benchmark: Elevation = 501.91
Top headwall at north side of box culvert located at southwest corner of "Sigmund Auto Service" site on West Second Street (Civic Park Drive).
- U.S.G.S. Benchmark: Elevation = 501.91
Top headwall at north side of box culvert located at southwest corner of "Sigmund Auto Service" site on West Second Street (Civic Park Drive).

A graphic scale bar with markings at 0, 50, and 100. Below it, text reads '(IN FEET)' and '1 inch = 50 ft.'

CIVIC PARK ESTATES
SAN SEWER CALC PLAT
8-4-94
FILE: 3623CON.DWG
PNTS: 3100-3162

LORETTA DRIVE

EMGE ROAD

PROPERTY N/F OF EDWARD HUME

CORONATION ESTATES

S 89°50'33"E
124.58'
S 89°51'32"E
140.54'

EMGE (40'w) ROA

CORONATION HEIGHTS

DRIVE

IMPERIAL DRIVE

PROPERTY N/F OF RUSSEL EMGE

NORFOLK & WESTERN RAILROAD (150' WIDE)

GRADING QUANTITY
29,700 cu.yds.
(INCLUDES 15% SHRINKAGE)

(INCLUDES 15% SHRINKAGE)
The above yardage is an approximation only,
NOT FOR BIDDING PURPOSES. Contractors shall
verify quantities prior to construction.

It is the intention of the Engineer for the

It is the intention of the Engineer for the
authorities to believe as above. The Engineer


earthwork to balance on-site. The Engineer shall be notified if any difficulties arise in


shall be notified if any difficulties arise in achieving the balance.

2

A circular registration stamp with a double-lined border. The outer ring contains the words "STATE OF MISSOURI" at the top and "REGISTERED LAND SURVEYOR" at the bottom, separated by small dots. The inner circle contains the name "NEAL JOHN NIEWALD" and the number "LS 1112".

AS-BUILTS ADDED OCTOBER, 1994

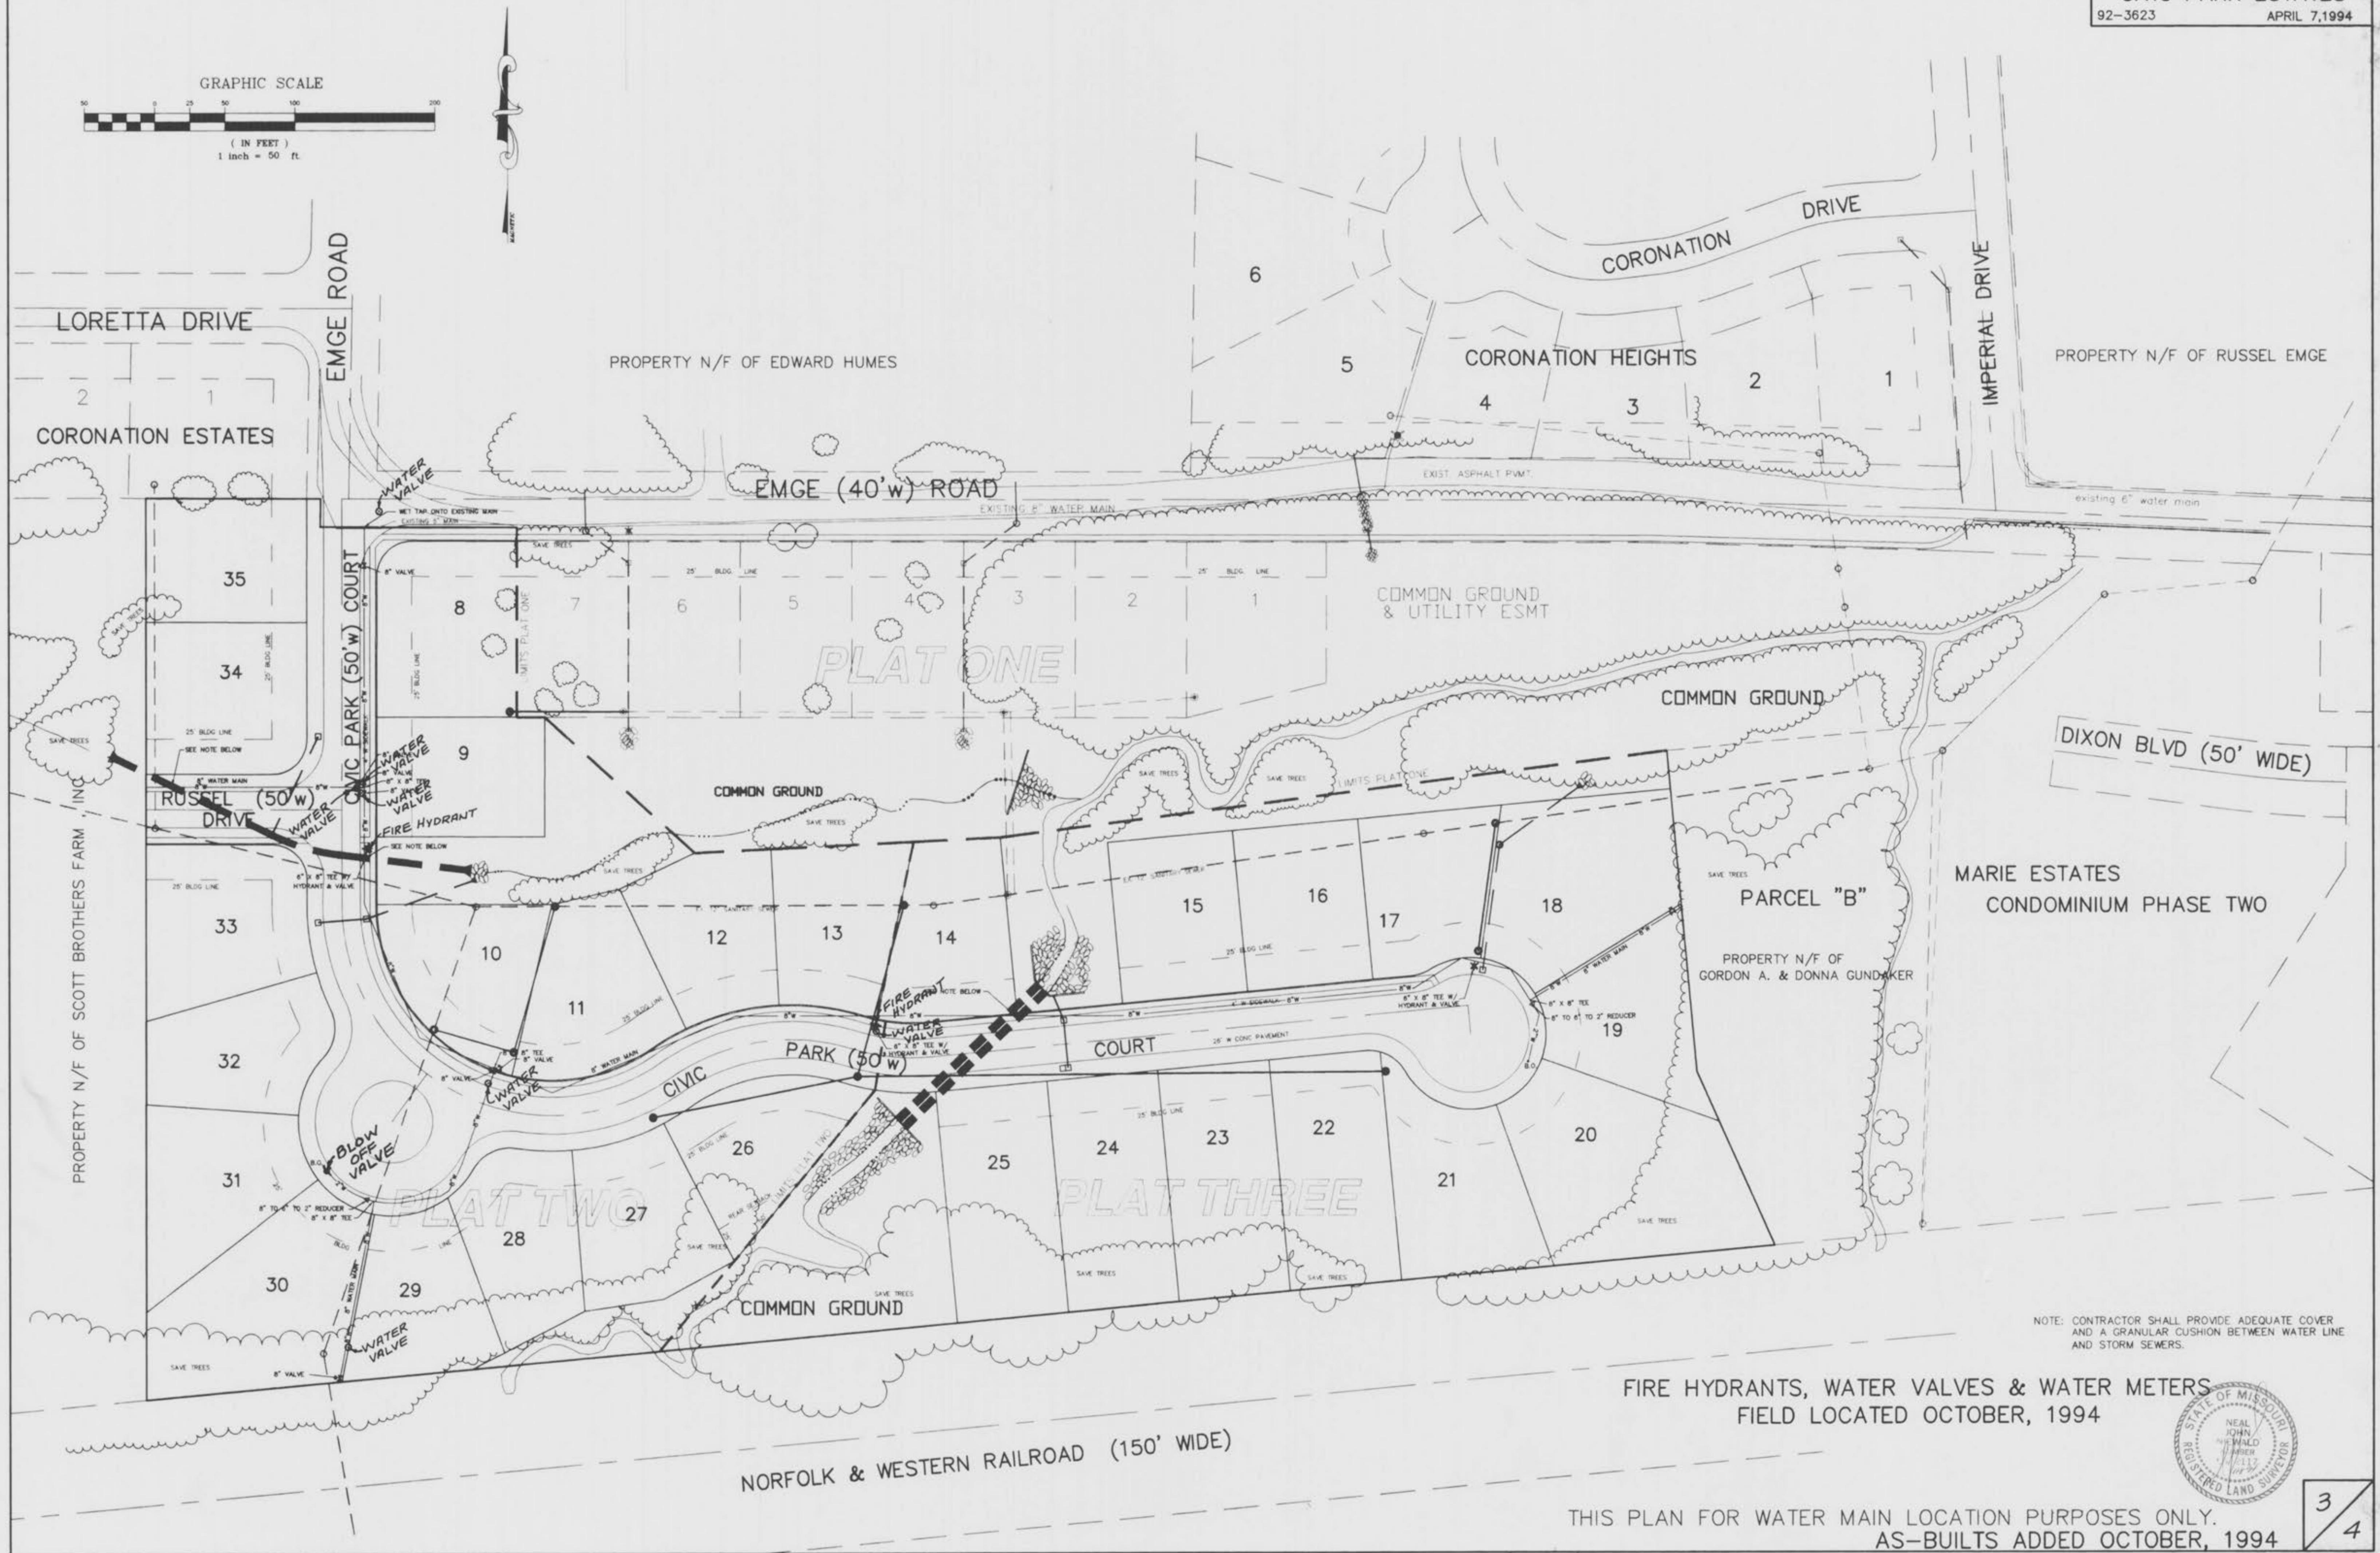

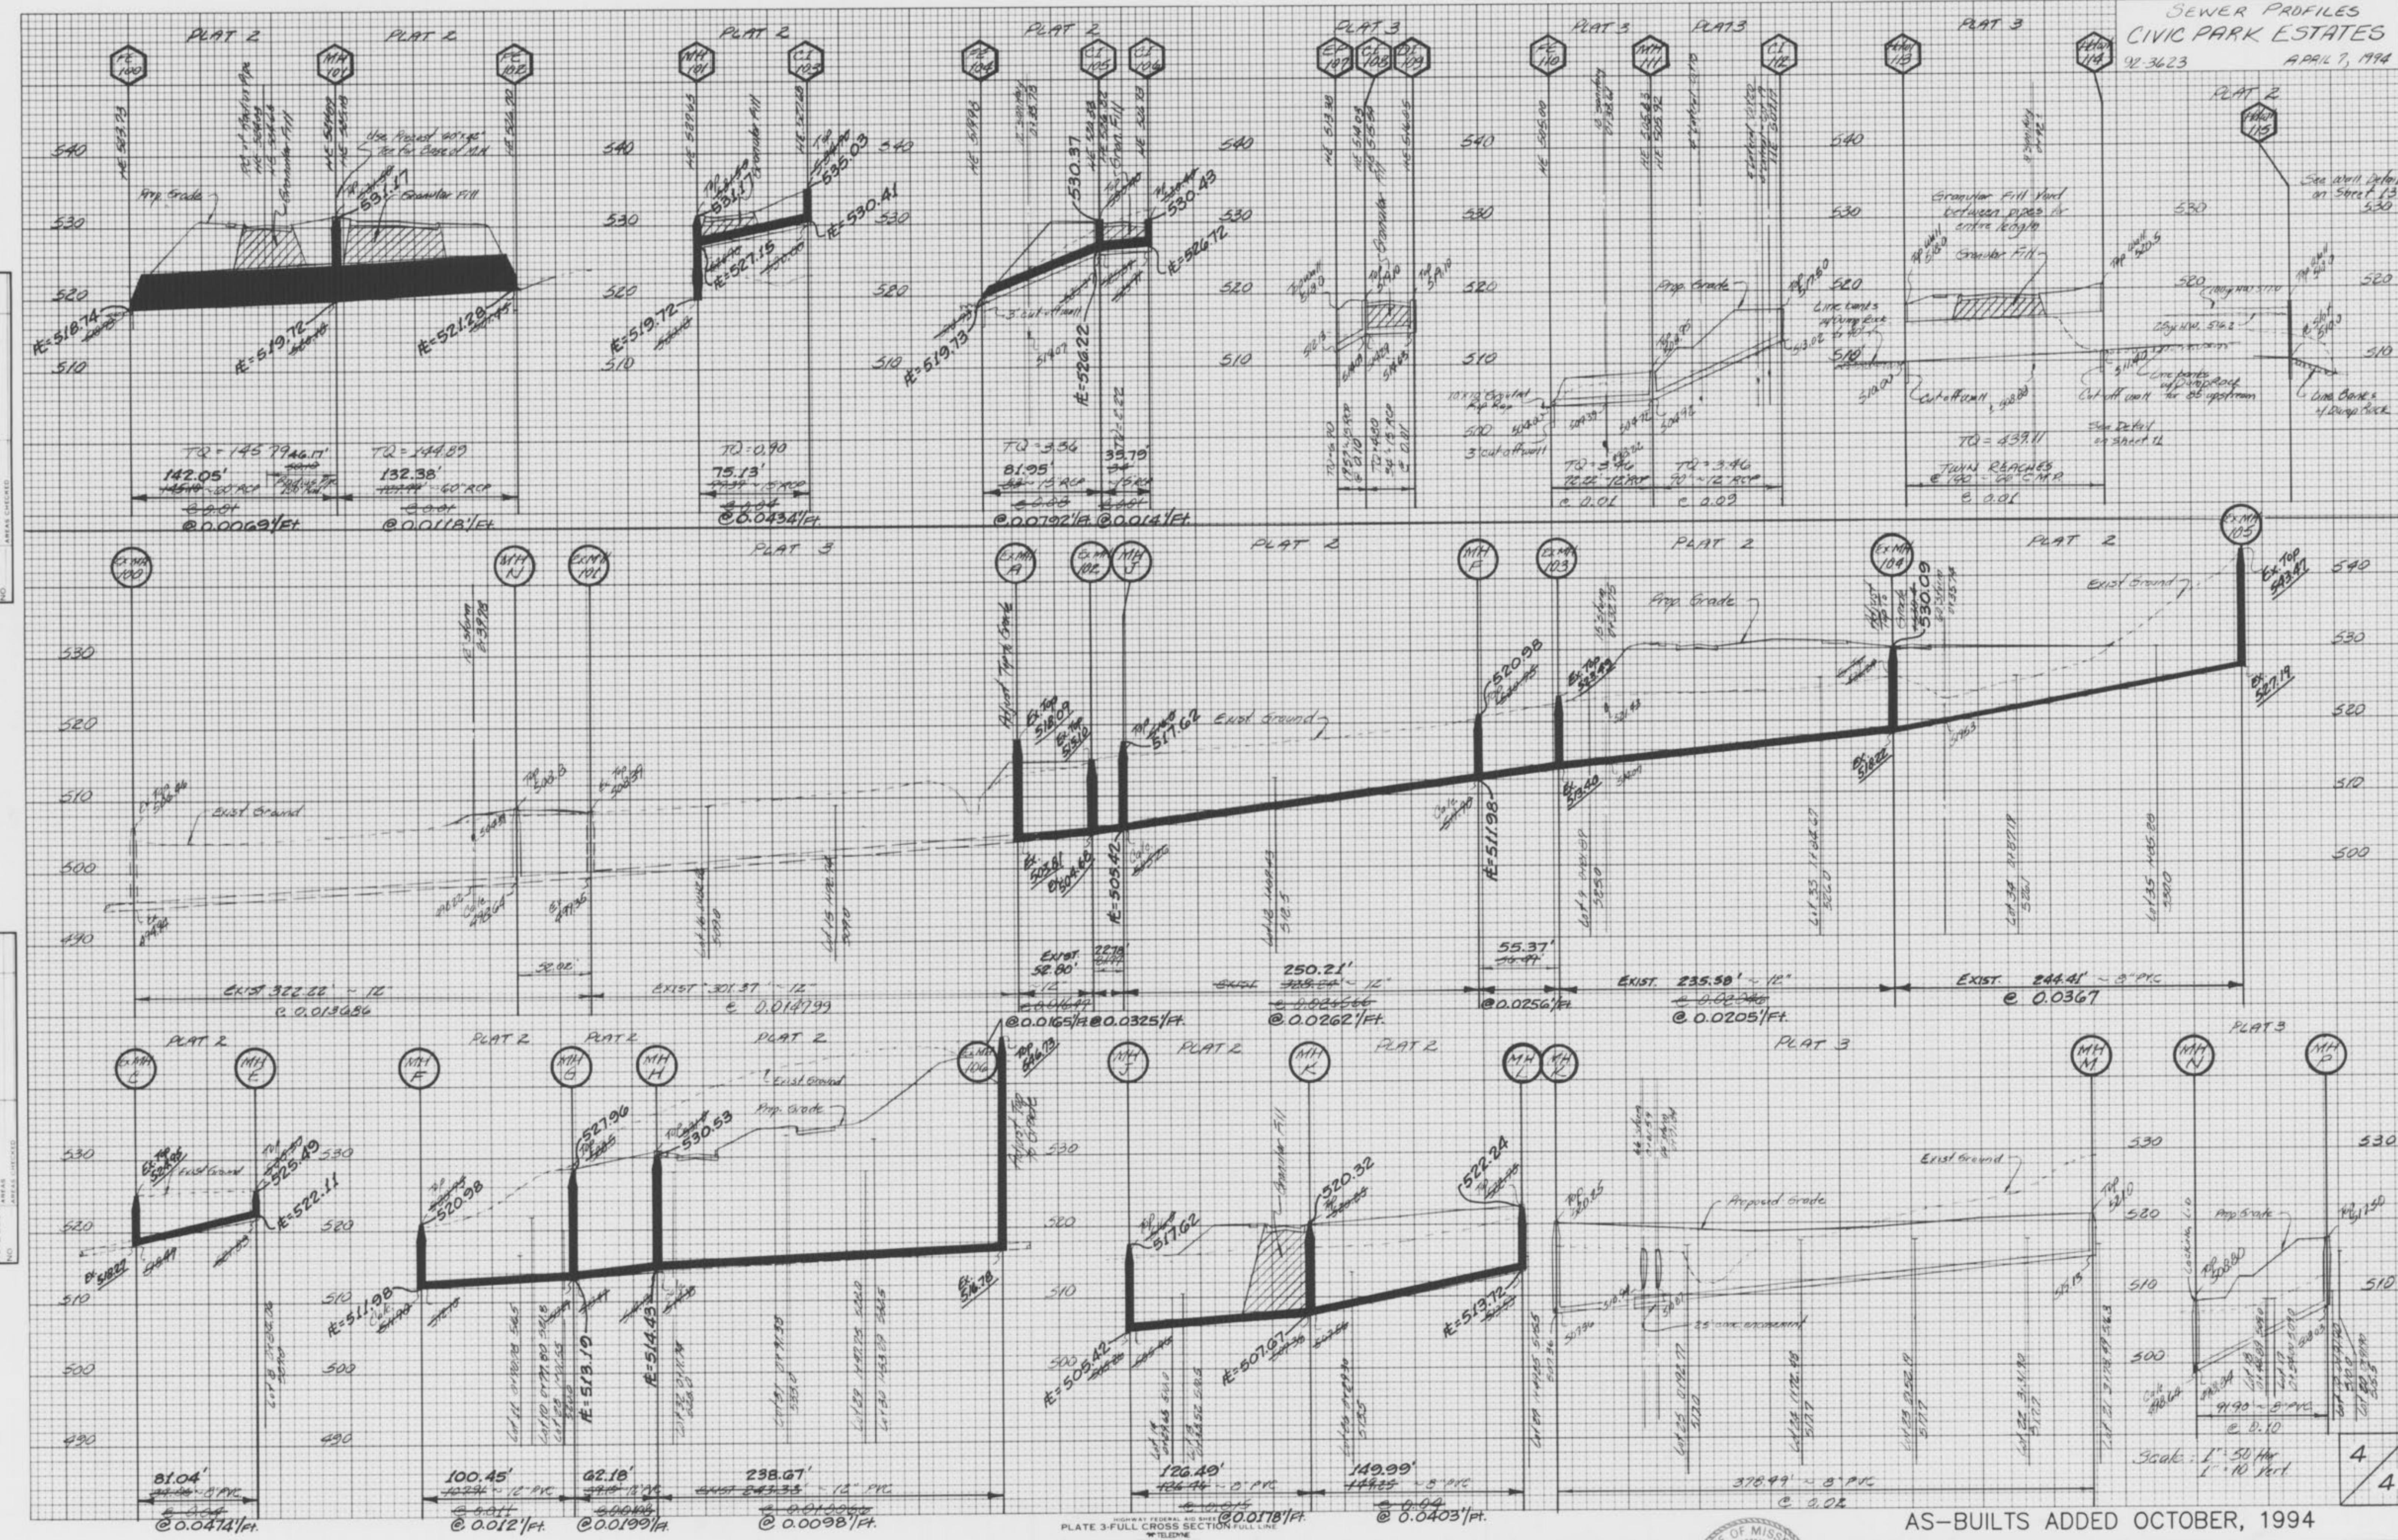

S-BUILTS ADDED OCTOBER, 1994

