

THE CROSSING AT RIVERSIDE CENTRE

A TRACT OF LAND BEING FUTURE DEVELOPMENT ON THE PLAT OF RIVERSIDE INDUSTRIAL CENTRE AS RECORDED IN PLAT BOOK 30, PAGE 288 LOCATED IN U.S. SURVEY 731, TOWNSHIP 47 NORTH, RANGE 3 EAST OF THE 5TH PRINCIPAL MERIDIAN ST. CHARLES COUNTY, MISSOURI

AS-BUILT IMPROVEMENT PLANS


SHEET INDEX

C1	TITLE SHEET
C8	SITE AND GRADING PLAN
C9	SITE AND GRADING PLAN
C13	STORM SEWER PROFILES
C14	STORM HYDRAULICS AND SANITARY PROFILE
C16	DETENTION DETAILS
C18	WATER QUALITY DETAILS


LEGEND

EXISTING SANITARY SEWER	
EXISTING STORM SEWER	
EXISTING TREE	
EXISTING BUILDING	
EXISTING CONTOUR	
SPOT ELEVATION	
EXISTING UTILITIES	
FOUND 1/2" IRON PIPE	
SET IRON PIPE	
FOUND CROSS	
FOUND STONE	
FIRE HYDRANT	
LIGHT STANDARD	
BUSH	
SIGN	
GUY WIRE	
POWER POLE	
WATER VALVE	
DENOTES RECORD INFORMATION	

SITE DEVELOPMENT PLAN
DIVISION FILE NUMBER: 19 10.02
APPROVAL DATE: 12-02-2010

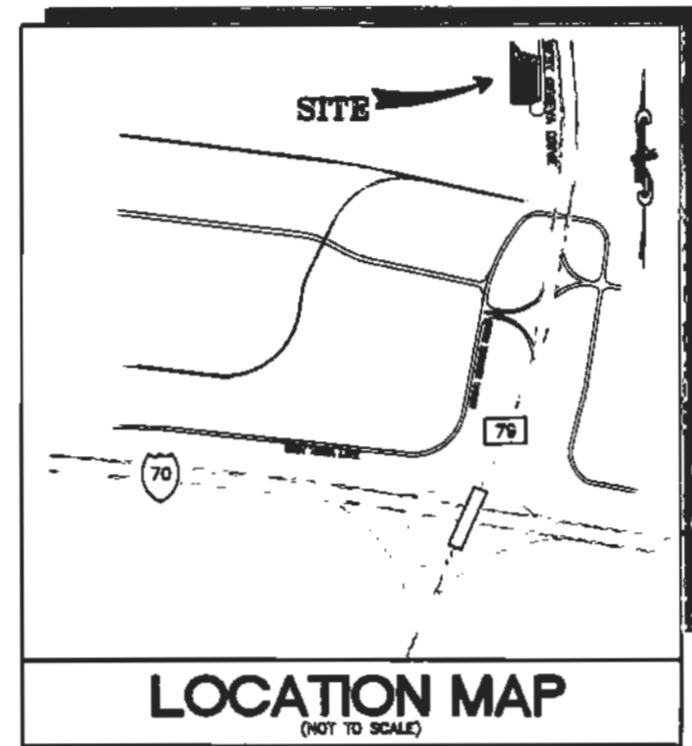

SUBJECT PROPERTY LIES WITHIN FLOOD ZONE "X" (AREAS DETERMINED TO BE OUTSIDE THE 500-YEAR FLOODPLAIN) PER NATIONAL FLOOD INSURANCE PROGRAM FLOOD INSURANCE RATE MAP FOR ST. CHARLES COUNTY, MISSOURI, AND INCORPORATED AREAS. THE F.I.R.M. IS IDENTIFIED AS MAP NO. 28183 C 0242E WITH AN EFFECTIVE DATE OF AUGUST 2, 1996.

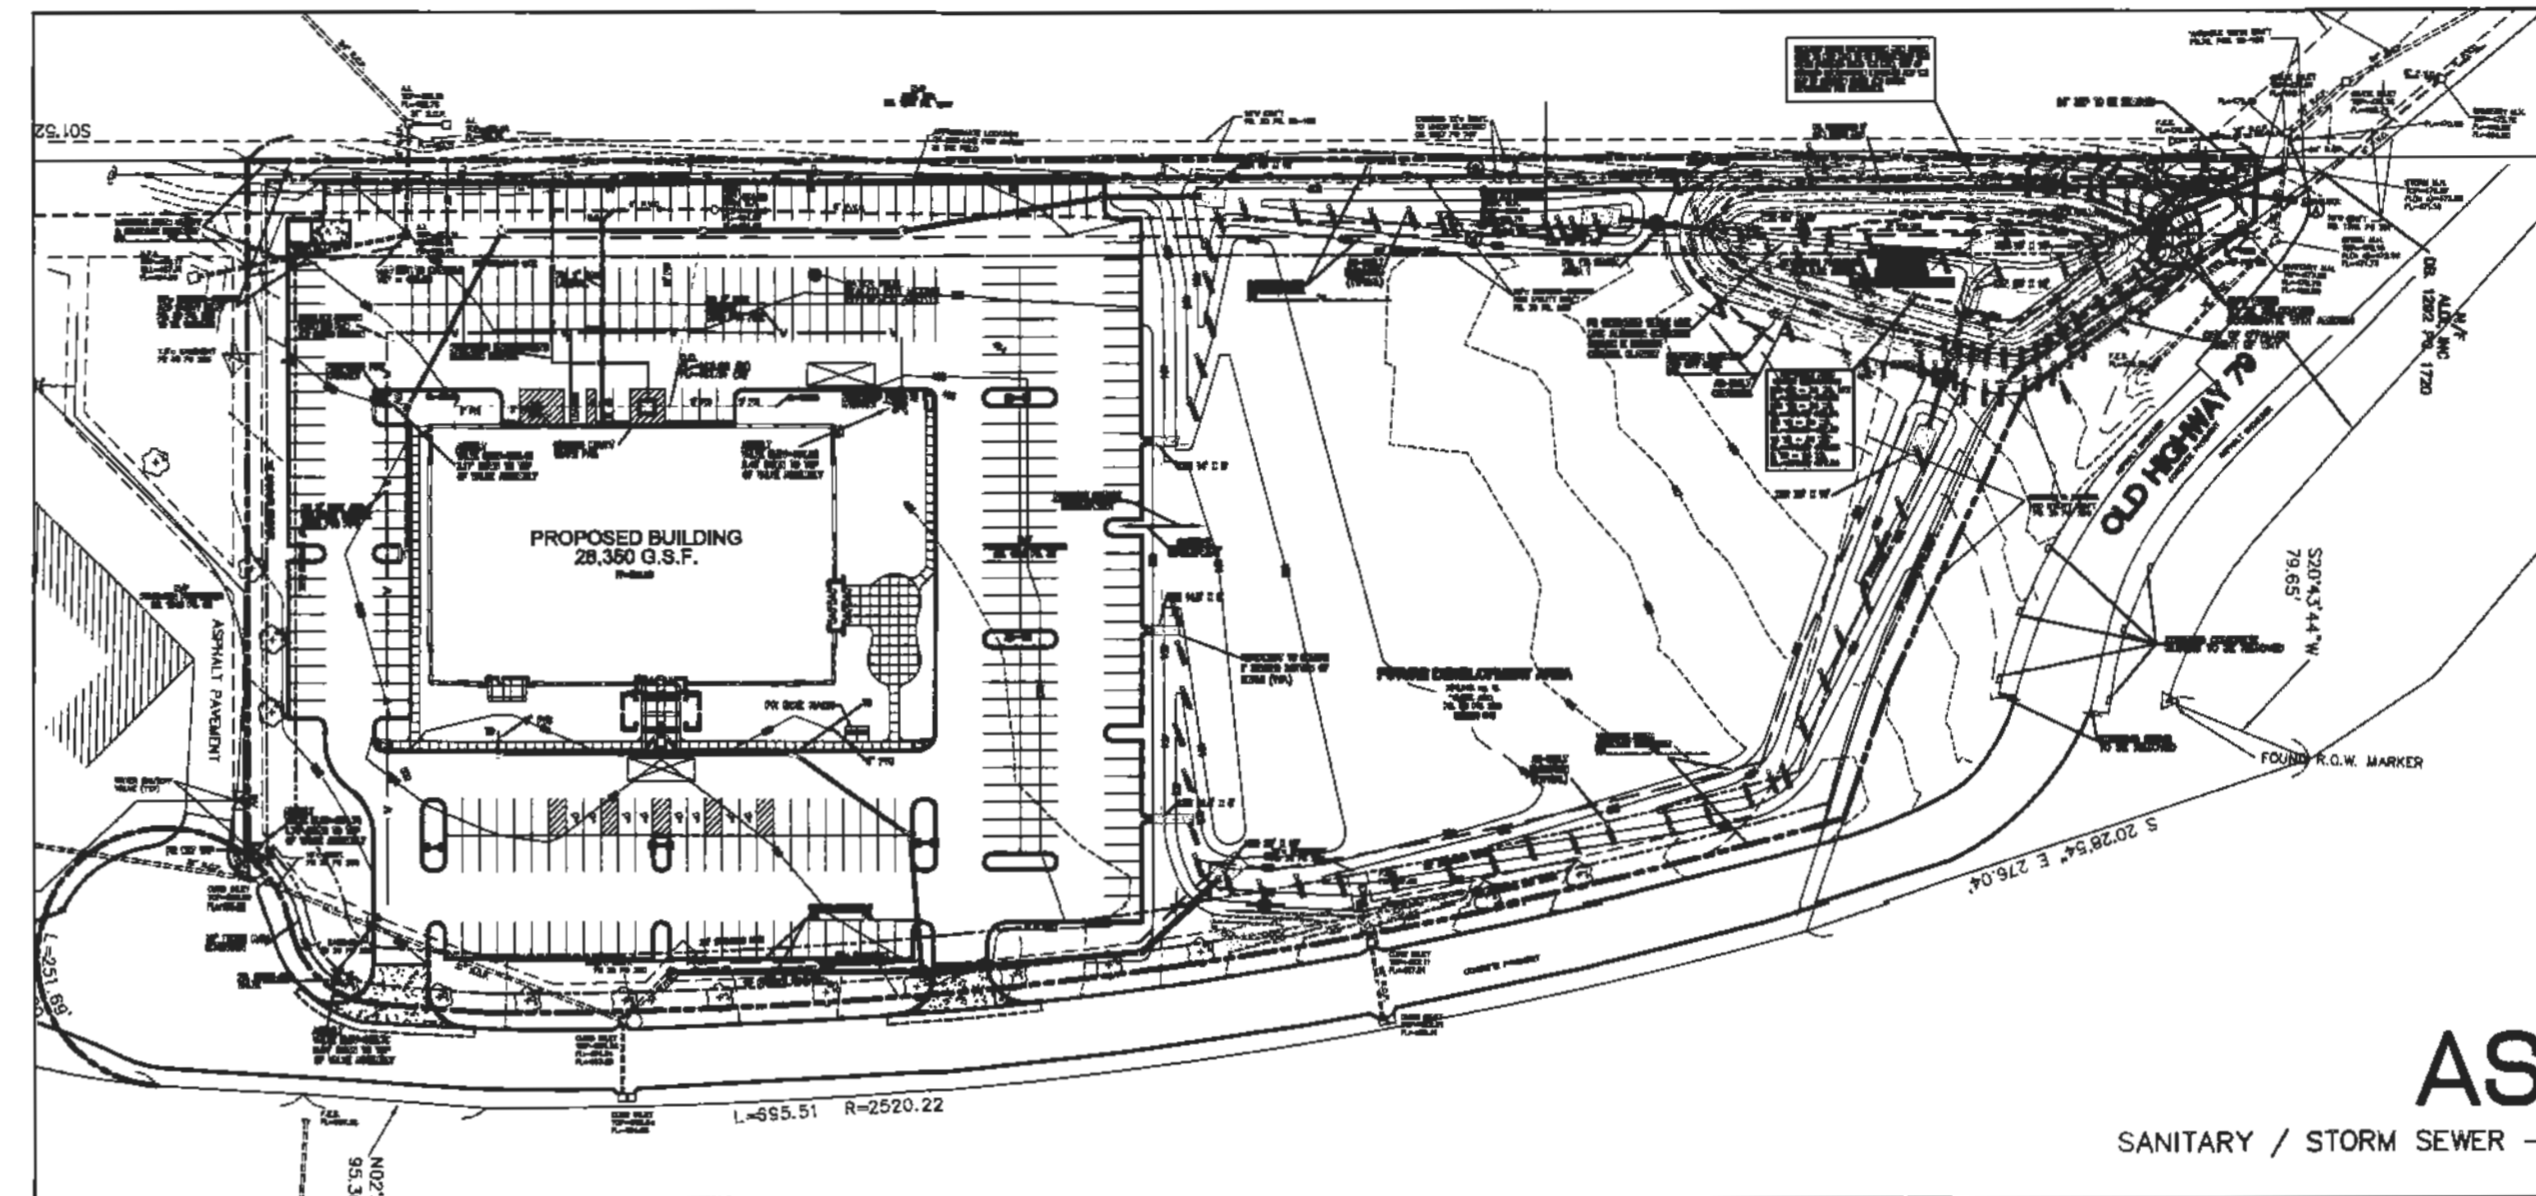

PERTINENT DATA

SITE ACREAGE	= 8.589 Ac.±
OWNER (CONTRACT)	= WINDSOR CROSSING CHURCH
SITE ADDRESS	= 6000 W GENEVA DRIVE ST. PETERS, MISSOURI 63376
ZONING	= C-3 "HIGHWAY COMMERCIAL DISTRICT"
FIRE DISTRICT	= CENTRAL COUNTY
SEWER DISTRICT	= CITY OF OFALLON
WATER SERVICE	= CITY OF OFALLON
GAS SERVICE	= LACLEDE GAS COMPANY
ELECTRIC SERVICE	= AmerenUE ELECTRIC COMPANY
PHONE SERVICE	= CENTURYLINK
WATERSHED	= BELLEAU CREEK
WUNNENBERG'S	= PAGE 31, GRID 00-15

ABBREVIATIONS

DB.	- DEED BOOK
E	- ELECTRIC
ESM'T	- EASEMENT
F.E.S.	- FLARED END SECTION
FL	- FLOWLINE
FT	- FEET
FND.	- FOUND
G	- GAS
M.H.	- MANHOLE
N/F	- NOW OR FORMERLY
PB.	- PLAT BOOK
PG.	- PAGE
P.V.C.	- POLYVINYL CHLORIDE PIPE
R.C.P.	- REINFORCED CONCRETE PIPE
SQ.	- SQUARE
T	- TELEPHONE CABLE
V.C.P.	- VETRIFIED CLAY PIPE
W	- WATER
(85'W)	- RIGHT-OF-WAY WIDTH
HSR	- HEAVY STONE REVETMENT

SITE DEVELOPMENT PLAN REQUIREMENTS:

1. THE SITE PLAN CERTIFICATE SHALL EXPIRE, AND BE OF NO EFFECT, ONE HUNDRED EIGHTY (180) DAYS AFTER THE DATE OF ISSUANCE THEREOF, UNLESS WITHIN SUCH TIME A BUILDING PERMIT FOR ANY PROPOSED WORK AUTHORIZED UNDER SAID SITE CERTIFICATE HAS BEEN ISSUED. THE SITE PLAN CERTIFICATE SHALL EXPIRE AND BE OF NO EFFECT THREE HUNDRED AND SIXTY (360) DAYS AFTER THE DATE OF ITS ISSUANCE, IF CONSTRUCTION HAS NOT BEGUN AND BEEN PURSUED DILIGENTLY ON THE PROPERTY. (ORD. NO. 1161 27.07, 10-15-81)
2. PRIOR TO APPROVAL OF A BUILDING PERMIT, A CONSTRUCTION SITE PLAN MUST BE REVIEWED AND APPROVED BY CITY STAFF.
3. THE APPROPRIATE FIRE DISTRICT WILL NEED TO REVIEW AND APPROVE THE DEVELOPMENT.
4. ANY SIGNAGE TO BE PLACED ON THE SUBJECT PROPERTY REQUIRES A SEPARATE SIGN PERMIT.
5. ANY BUSINESS OCCUPYING THE SITE REQUIRES APPROVAL OF A BUSINESS LICENSE.
6. ALL CONDITIONS OF APPROVAL SHALL BE NOTED ON THE CONSTRUCTION SITE PLANS.

SITE DEVELOPMENT PLAN CONDITIONS:

NO CONDITIONS PER CITY LETTER DATED DECEMBER 3, 2010

THE NECESSARY EASEMENTS TO BE GRANTED BY RECORDING THE EASEMENT PLAT IS A CONDITION OF APPROVAL OF THESE PLANS.

CITY OF O'FALLON
COMMUNITY DEVELOPMENT DEPARTMENT
ACCEPTED FOR CONSTRUCTION
BY: _____ DATE: _____
PROFESSIONAL ENGINEER'S SEAL
INDICATES RESPONSIBILITY FOR DESIGN

U.S.G.S. BENCHMARK

STATION SC-06
ELEV. = 529.23 (NGVD 1929 (1991))
THE STATION IS LOCATED ON THE EAST SHOULDER OF NORTH BOUND LANE OF MO. HWY 79 ABOUT 4 MILE NORTH OF I-70. IT IS 2808' NORTH OF THE NORTH END OF THE RAILROAD OVERPASS AT APPROXIMATE HWY 79 STATION 5374+52 AND ON A LINE EXTENDED FROM THE NORTHERLY FENCE ENCLOSED THE LOADING DOCKS OF WAINWRIGHT INDUSTRIES, INC., 14.82 FEET S.E. OF A COTTON PICKER SPINDLE IN THE JOINT OF PAVEMENT AND THE SHOULDER; 14.72' N.E. OF ANOTHER; 12.4 FEET EASTERLY OF THE JOINT BETWEEN THE PAVEMENT AND SHOULDER; AND 2.05' SOUTH OF A CARSONITE WITNESS POST.

UTILITY LOCATES

MISSOURI ONE-CALL
1 800 344-7463
CITY OF O'FALLON
TRAFFIC
(636) 376-5502
ENGINEERING
(636) 376-5556
CONSTRUCTION INSPECTION
(636) 376-5565



UTILITY NOTE:

UNDERGROUND FACILITIES, STRUCTURES AND UTILITIES HAVE BEEN PLOTTED FROM AVAILABLE SURVEYS, RECORDS AND INFORMATION, AND THEREFORE DO NOT NECESSARILY REFLECT THE ACTUAL EXISTENCE, NON-EXISTENCE, SIZE, TYPE, NUMBER, OR LOCATION OF THESE FACILITIES, STRUCTURES AND UTILITIES. THE CONTRACTOR SHALL BE RESPONSIBLE FOR VERIFYING THE ACTUAL LOCATION OF ALL UNDERGROUND FACILITIES, STRUCTURES, AND UTILITIES, EITHER SHOWN OR NOT SHOWN ON THESE PLANS. THE UNDERGROUND FACILITIES, STRUCTURES, AND UTILITIES SHALL BE LOCATED IN THE FIELD PRIOR TO ANY GRADING, EXCAVATION OR CONSTRUCTION OF IMPROVEMENTS. THESE PROVISIONS SHALL IN NO WAY ABSOLVE ANY PARTY FROM COMPLYING WITH THE UNDERGROUND FACILITY SAFETY AND DAMAGE PREVENTION ACT, CHAPTER 319 RSMo.

PROPERTY DESCRIPTION

A tract of land being the "FUTURE DEVELOPMENT" area of Riverside Industrial Centre as recorded in Plat Book 30 page 288 of the St. Charles County, Missouri records in U.S. Survey 731, Township 47 North, Range 3 East, Fifth Principal Meridian, City of O'Fallon, St. Charles County, Missouri, and being more particularly described as follows:

Beginning at the southwest corner of above said "FUTURE DEVELOPMENT" area, also being the northwest corner of Lot 1 of above said Riverside Industrial Centre, thence along the west line of said "FUTURE DEVELOPMENT" area North 01 degree 52 minutes 41 seconds West 1,045.14 feet to the northwest corner of said "FUTURE DEVELOPMENT" area, thence along the northerly line of said "FUTURE DEVELOPMENT" area North 89 degrees 43 minutes 22 seconds East 33.04 feet to the southwesterly line of Old Highway 79, thence along last said southwesterly line the following courses and distances: South 38 degrees 25 minutes 10 seconds East 149.93 feet, South 67 degrees 17 minutes 06 seconds East 168.19 feet, and South 73 degrees 10 minutes 02 seconds East 73.47 feet to a point on a curve on the westerly line of West Geneva Drive, 50 feet wide, thence departing last said southwesterly line along last said westerly line the following courses and distances: Southeasterly along last said curve to the right, for which the radius point bears South 71 degrees 50 minutes 08 seconds West 2,407.22 feet and a chord which bears South 09 degrees 52 minutes 59 seconds East 711.60 feet, an arc distance of 714.08 feet, South 02 degrees 31 minutes 45 seconds West 58.10 feet to the beginning of a curve to the right for which the radius point bears North 87 degrees 28 minutes 15 seconds West 50.00 feet, Southwesterly along last curve with a chord which bears South 38 degrees 58 minutes 45 seconds West 59.41 feet, an arc distance of 63.62 feet to a point of reverse curvature. Southwesterly along a curve to the left for which the radius point bears South 14 degrees 34 minutes 15 seconds East 67.00 feet and a chord which bears South 56 degrees 30 minutes 10 seconds West 43.46 feet, an arc distance of 44.26 feet to the southerly line of above said "FUTURE DEVELOPMENT" area, thence departing last said westerly line along last said southerly line South 88 degrees 08 minutes 27 seconds West 363.57 feet to the point of beginning, containing 374,148 square feet or 8.589 acres, more or less.

AS-BUILT

SANITARY / STORM SEWER - WATER QUALITY FEATURE - WATER LINE

The existing sewer lengths, sizes, flowlines, depths of structures and sewers locations with respect to existing or proposed easements have been measured. Water Quality Features, Retention Basins and drainage swales have been measured. Fire hydrants and valves have been measured. The results of those measurements are shown on this set of Final Measurement plans. Since the sanitary wye locations have been plotted from information provided by the sewer contractor or other sources, I disclaim any responsibility for that specific information.

All public sewers are located within designated existing or proposed easements.

Randall S. Rosson 3-9-16
Randall S. Rosson, P.L.S. NO. 2005-000171

Agency Contacts

Sanitary Sewer City of O'Fallon 100 N. Main St. O'Fallon, MO. 63366 Contact: 636-281-2858	Central County Fire 1 Timberbrook Dr. St. Peters, MO. 63385 636-970-9700
Water City of O'Fallon 100 N. Main St. O'Fallon, MO. 63366 Contact: 636-281-2858	Ameren UE 200 Callahan Road Wentzville, MO. 63385 636-639-8312
Storm Sewer City of O'Fallon 100 N. Main St. O'Fallon, MO. 63366 636-281-2858	Gas Laclede Gas Company 3950 Forest Park Ave. St. Louis, MO. 63134 314-658-5437
	Telephone Century Link 1151 Century Link Dr. Wentzville, MO. 63385 636-332-7030

	WATER QUALITY	02/17/11
	CITY APPROVAL	02/01/11
	CITY COMMENTS	01/26/11
	CITY COMMENTS	01/13/11

THE CROSSING AT RIVERSIDE CENTRE

TITLE SHEET

STOCK & ASSOCIATES
Consulting Engineers, Inc.

257 Chesterfield Business Parkway
St. Louis, MO 63005
PH. (636) 530-9100
FAX (636) 530-9130
e-mail: general@stockassoc.com
Web: www.stockassoc.com

02/17/11

GEORGE M. STOCK E-25116
CIVIL ENGINEER
CERTIFICATE OF AUTHORITY
NUMBER: 000995

DRAWN BY:	DATE:	CHECKED BY:	DATE:	JOB NUMBER:	SHEET:
P.R.G.	12/21/10	G.M.S.	12/21/10	210-4626.2	C1

CITY OF O'FALLON CONSTRUCTION WORK HOURS PER CITY ORDINANCE 3429 AS SHOWN IN SECTION 500.420 OF THE MUNICIPAL CODE OF THE CITY OF O'FALLON ARE AS FOLLOWS:

OCTOBER 1 THROUGH MAY 31
7:00 A.M. TO 7:00 P.M. MONDAY THROUGH SUNDAY
JUNE 1 THROUGH SEPTEMBER 30
8:00 A.M. TO 8:00 P.M. MONDAY THROUGH FRIDAY
7:00 A.M. TO 8:00 P.M. SATURDAY AND SUNDAY

THE AREA OF THIS PHASE OF DEVELOPMENT IS: 8.59 AC
THE AREA OF LAND DISTURBANCE IS: 7.21 AC
NUMBER OF PROPOSED LOTS IS: 1
BUILDING SETBACK INFORMATION, FRONT 30 FEET
SIDE 25 FEET
REAR 50 FEET

THE ESTIMATED SANITARY FLOW IN GALLONS PER DAY IS 6950

PARKING CALCULATIONS
REQUIRED PARKING BASED ON CLASSIFICATION: CHURCH
REQUIRED PARKING = 1 SPACE PER 3 SEATS
NUMBER OF SEATS IN BUILDING = 1014
TOTAL REQUIRED = 1014/3 = 338 SPACES
TOTAL PROVIDED: 338 SPACES

ACCESSIBLE SPACES
REQUIRED: 301-400 SPACES PROVIDED
REQUIRED: 8 ACCESSIBLE SPACE (1 VAN ACCESSIBLE)
PROVIDED: 8 ACCESSIBLE SPACES (2 VAN ACCESSIBLE)

LOADING CALCULATIONS:
REQUIRED: 1 PER 5000 SF + 1 PER EACH ADDITIONAL 20,000 SF = 2 REQ'D
PROVIDED: 2




BIKE RACK REQUIREMENTS:
4 RACK SPACES REQUIRED PER PLANNING AND ZONING
PROVIDED: 4 RACK SPACES

PREPARED FOR:
OWNER/CONTRACTOR
WINDSOR CROSSING CHURCH
114 NORTH EARTHERTON
CHESTERFIELD, MO 63005
CONTACT: ART KUIPER

MISSOURI DEPT. OF NATURAL RESOURCES

PERMIT NO. - MOR10D698
EXPIRATION DATE: 02/07/2012

G:\ORAW6001\2104626\SURVEY\CITYAUBUILD\14626-Ross2-banham.dwg Mar 09, 2016 11:10am

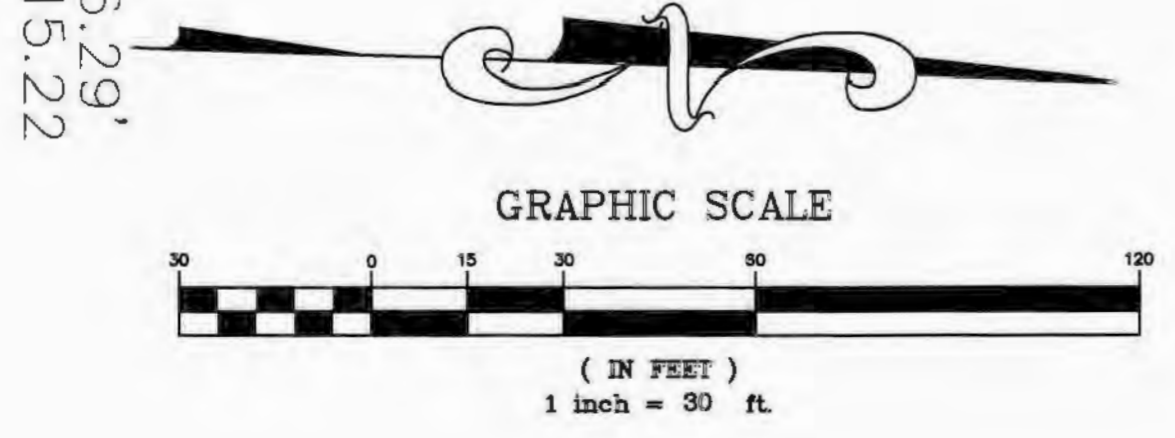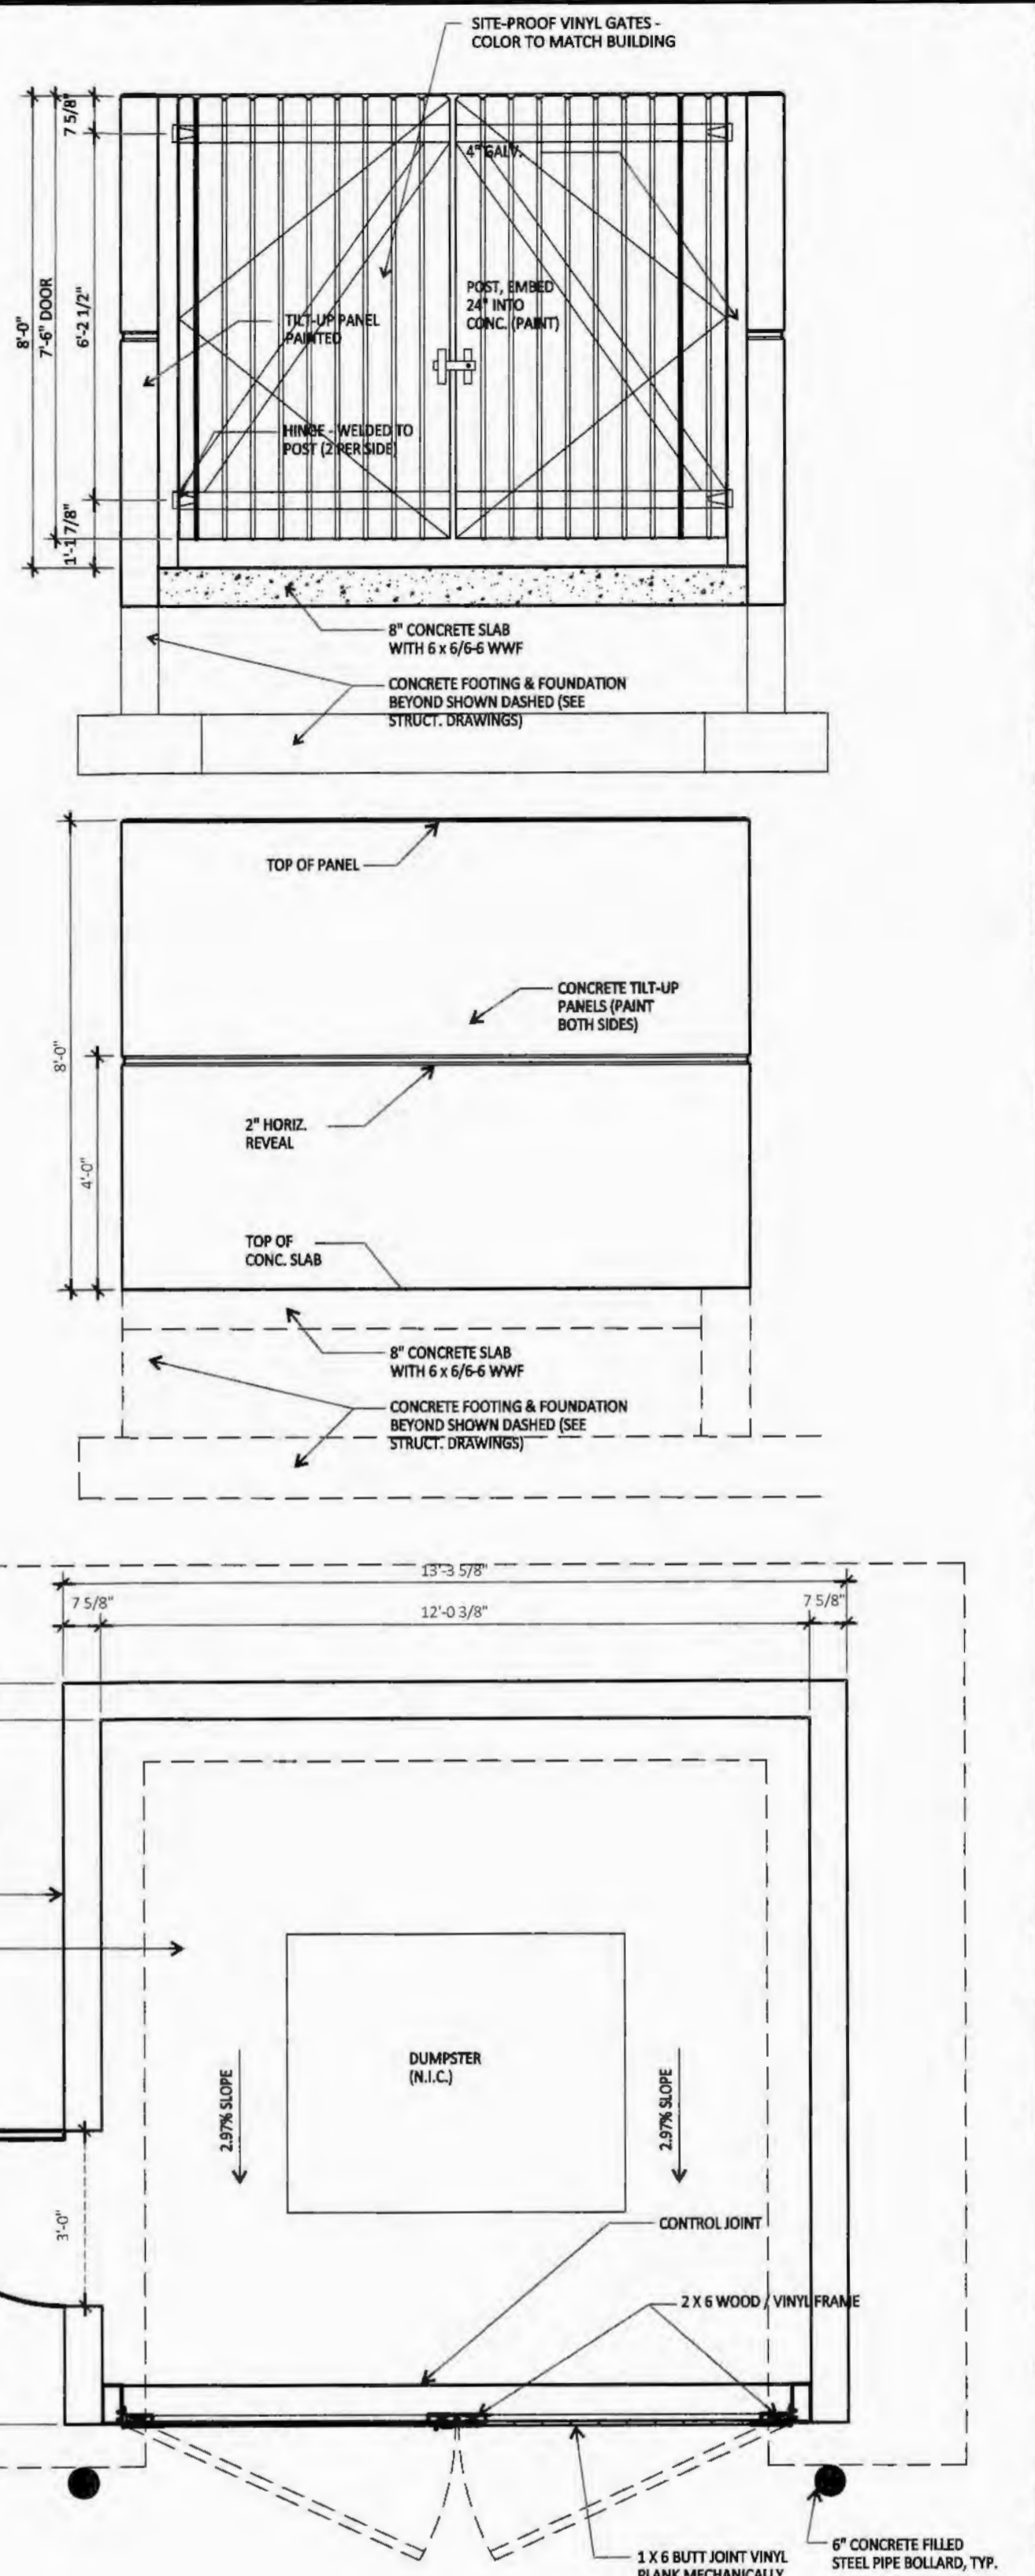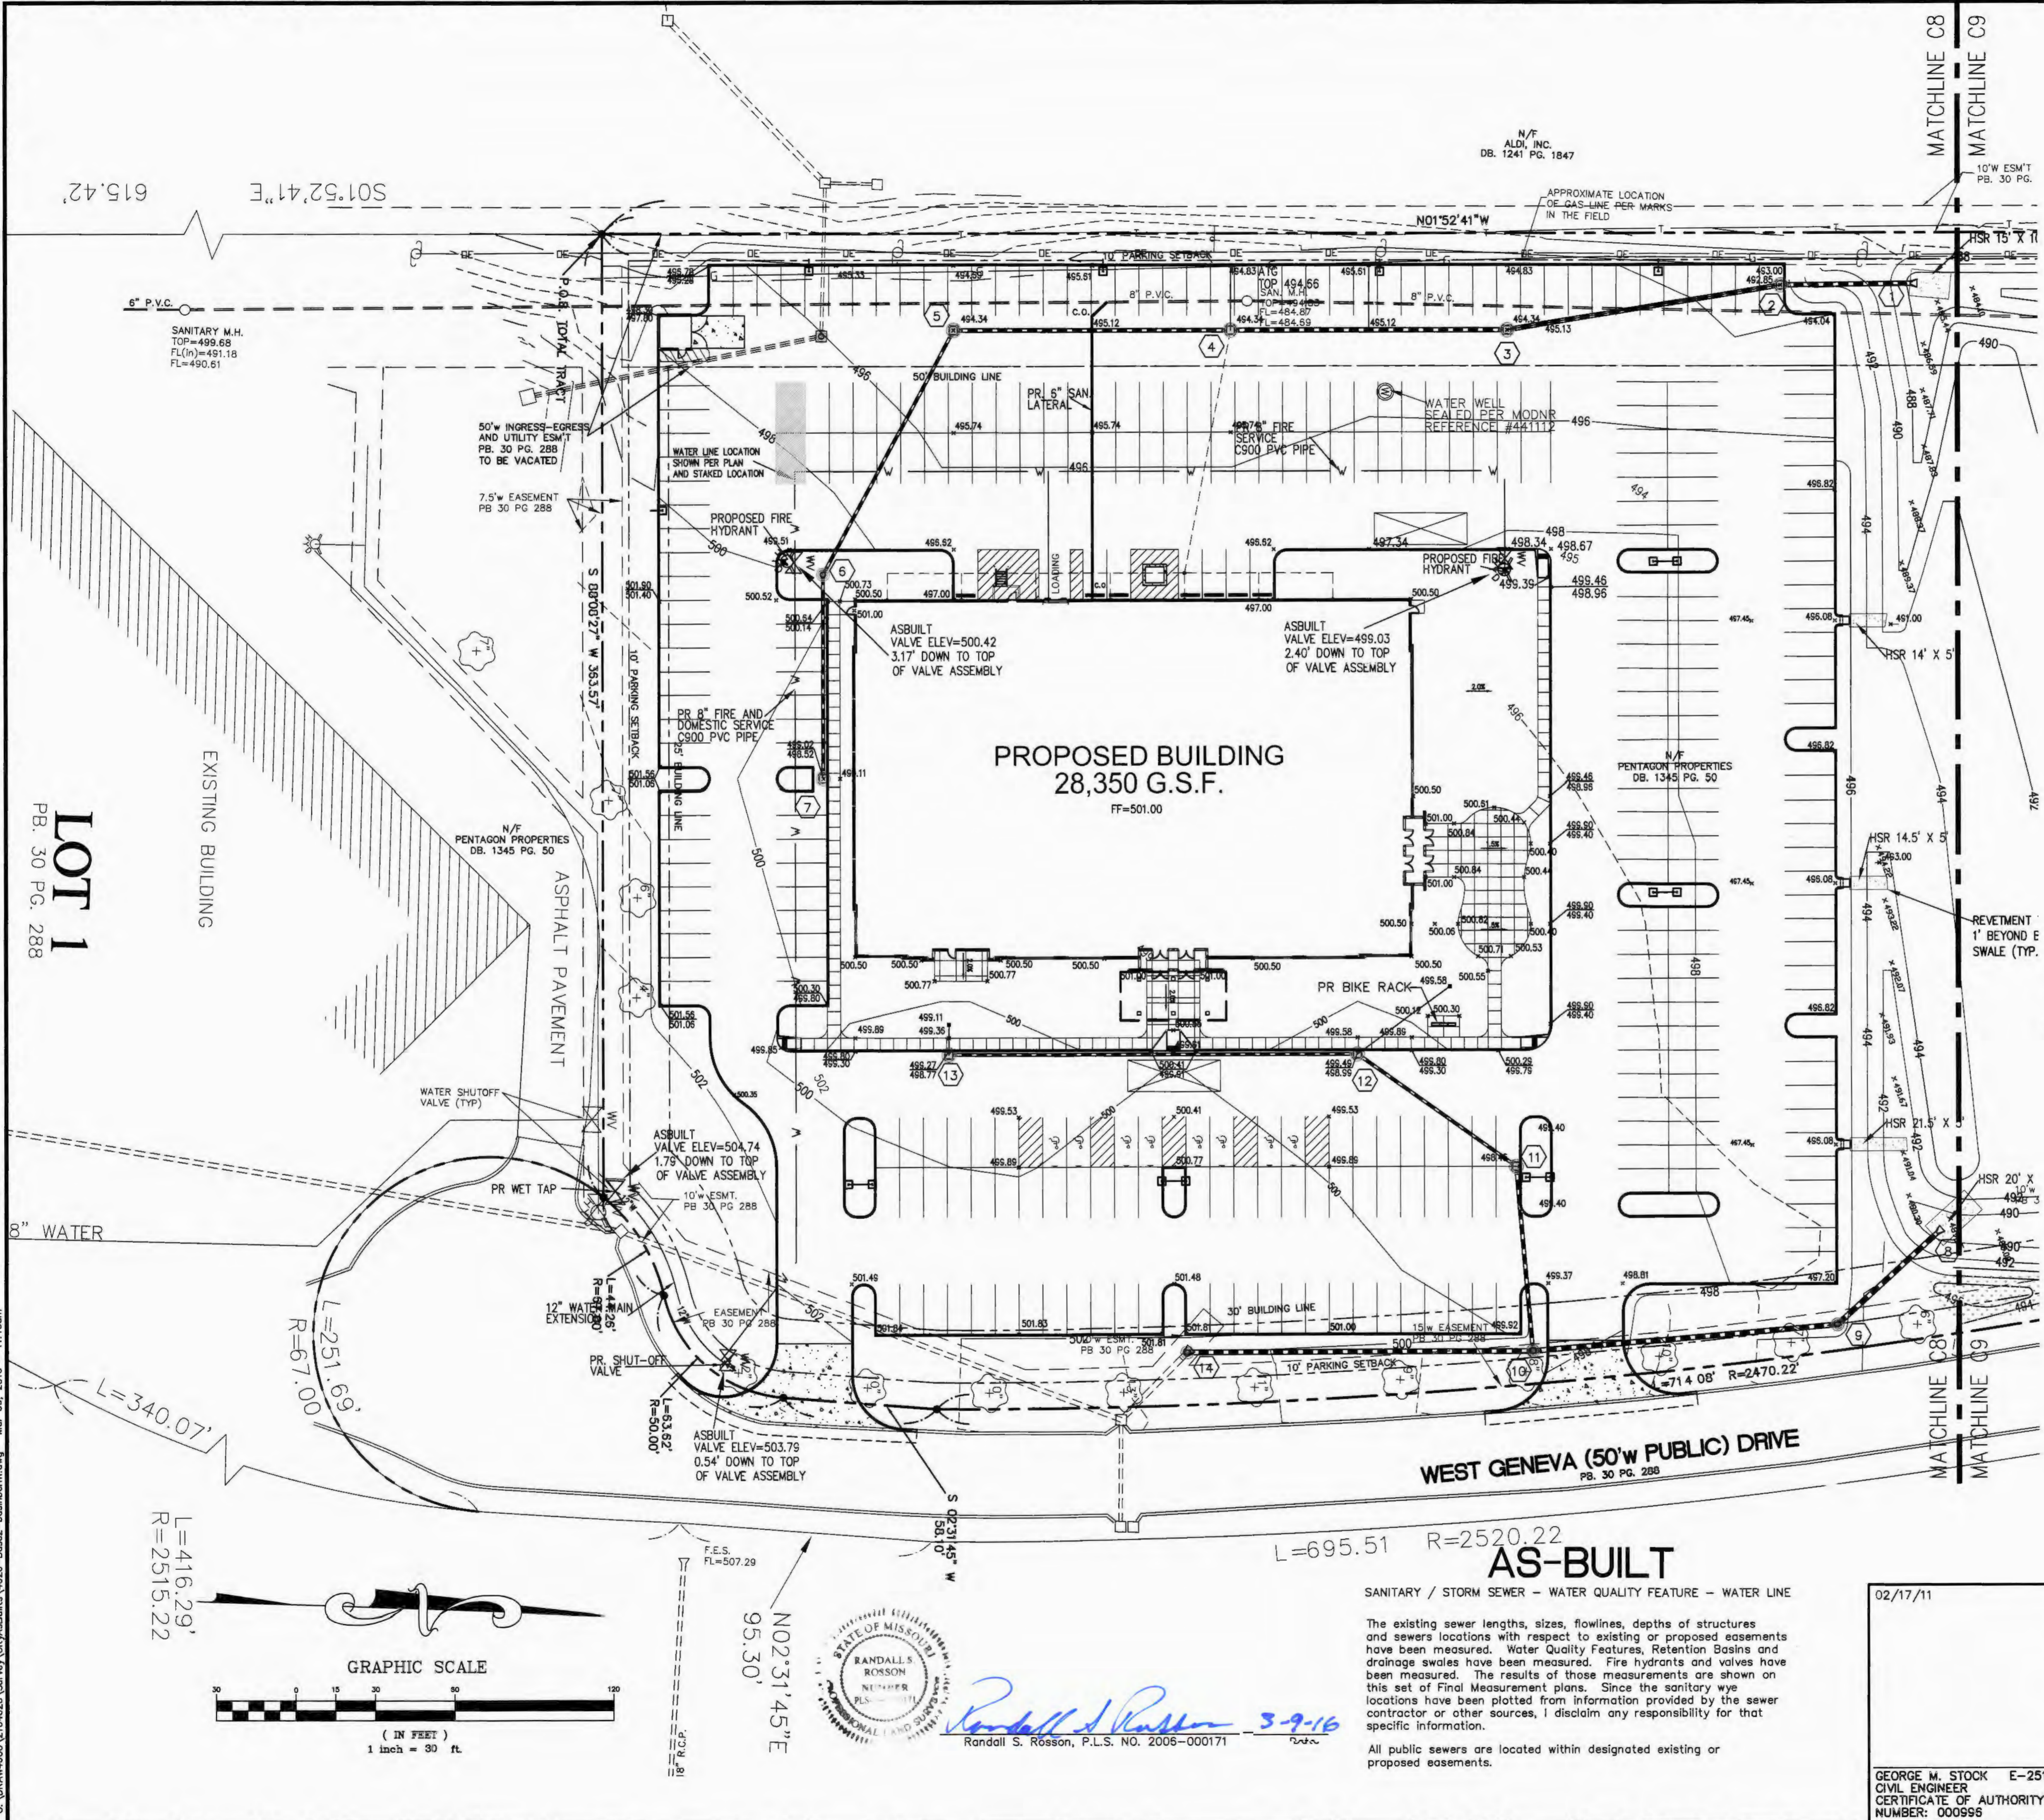

STATE OF MISSOURI
RANDALL S. ROSSON
REGISTERED PROFESSIONAL LAND SURVEYOR
No. 00000171
3-9-16

THE CROSSING AT RIVERSIDE CENTRE
SITE AND GRADING PLAN

STOCK & ASSOCIATES
Consulting Engineers, Inc.

257 Chesterfield Business Parkway
St. Louis, MO 63005
PH. (636) 530-9100
FAX (636) 530-9130
e-mail: general@stockassoc.com
Web: www.stockassoc.com

DRAWN BY: P.R.G.	DATE: 12/21/10	CHECKED BY: G.M.S.	DATE: 12/21/10	JOB NUMBER: 210-4626	SHEET: C8
---------------------	-------------------	-----------------------	-------------------	-------------------------	--------------

AS-BUILT

SANITARY / STORM SEWER - WATER QUALITY FEATURE - WATER LINE

The existing sewer lengths, sizes, flowlines, depths of structures and sewers locations with respect to existing or proposed easements have been measured. Water Quality Features, Retention Basins and drainage swales have been measured. Fire hydrants and valves have been measured. The results of those measurements are shown on this set of Final Measurement plans. Since the sanitary ways locations have been plotted from information provided by the sewer contractor or other sources, I disclaim any responsibility for that specific information.


All public sewers are located within designated existing or proposed easements.

THE MAINTENANCE INSTRUCTIONS FOR THE POST CONSTRUCTION BEST MANAGEMENT PRACTICES ARE INCLUDED IN THE DETENTION REPORT



Randall S. Rosson 3-9-16
 Randall S. Rosson, P.L.S. NO. 20065-000171 Date

SANITARY SEWER CONSTRUCTION MAIN SWITCH OVER TO NEW MAIN TO BE COORDINATED WITH OTHER FACILITIES USING THE MAIN CITY OF O'FALLON CONSTRUCTION INSPECTOR AND THE CITY OF O'FALLON WATER AND SEWER DEPARTMENT FOR SCHEDULING.

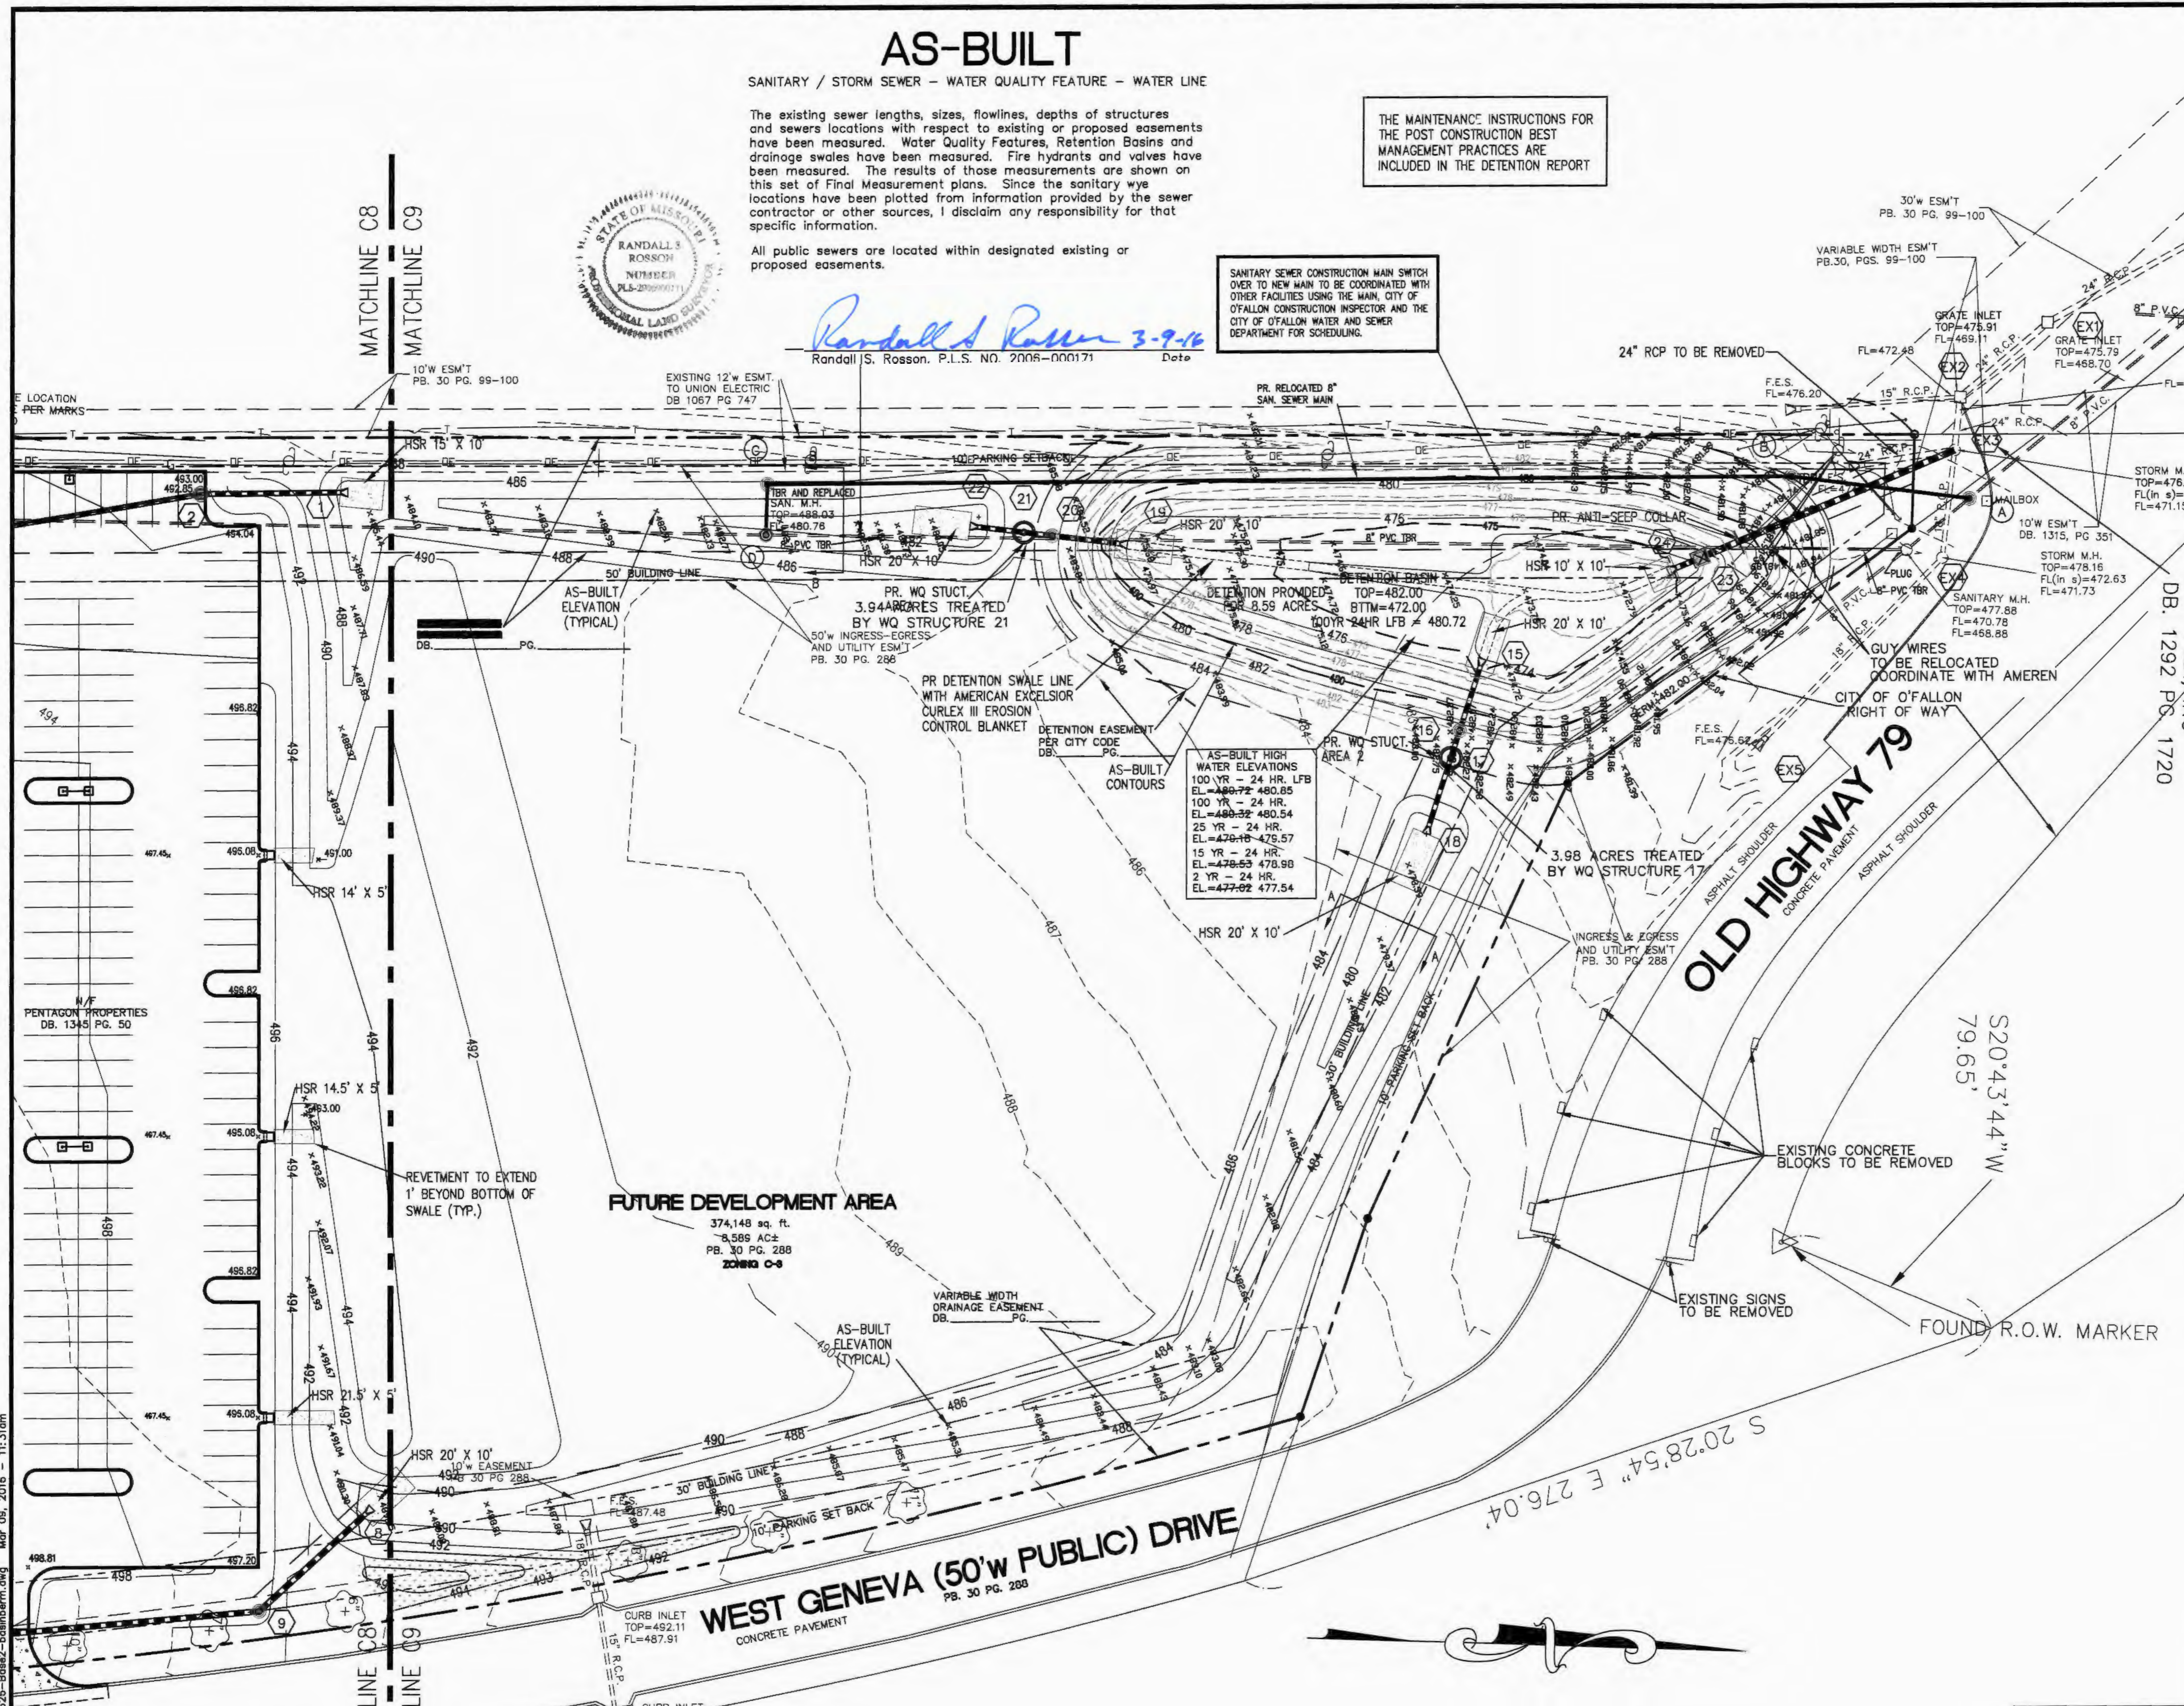

Stream Channel:

Project #:	210-4626
Name:	Crossing
Calculated:	PRG 12-08-10
Checked:	swale A-A
Station #:	swale A-A
Roughness Coefficient (n):	Concrete 0.012
Asphalt smooth	0.013
Asphalt rough	0.016
Gravel beds straight	0.025
Gravel beds plus large boulders	0.040
Earth winding w/ grass	0.050
Earth straight w/ grass	0.026

Manning Equation: $Q = (1.49n)A R^{2/3} S^{1/2}$


FIND DEPTH OF WATER AND WIDTH OF THE CHANNEL:

INPUT:

Top Of bank Elevation =	484.00
Bot. Elevation =	480.00
Stream Slope =	0.0223 (ft/ft)
Side Slope:	Horizontal (H) = 3
Vertical (V) =	1
W (Bottom width) =	3 (ft)

OUTPUT:

Depth =	0.72 (ft)
Velocity =	5.34 (ft/sec)
Water Surface Elev. =	480.72
Free Board =	3.28 (ft)
Water Surface Width =	7.30 (ft)
Perimeter =	7.53 (ft)
Cross section Area =	3.69 (ft ²)

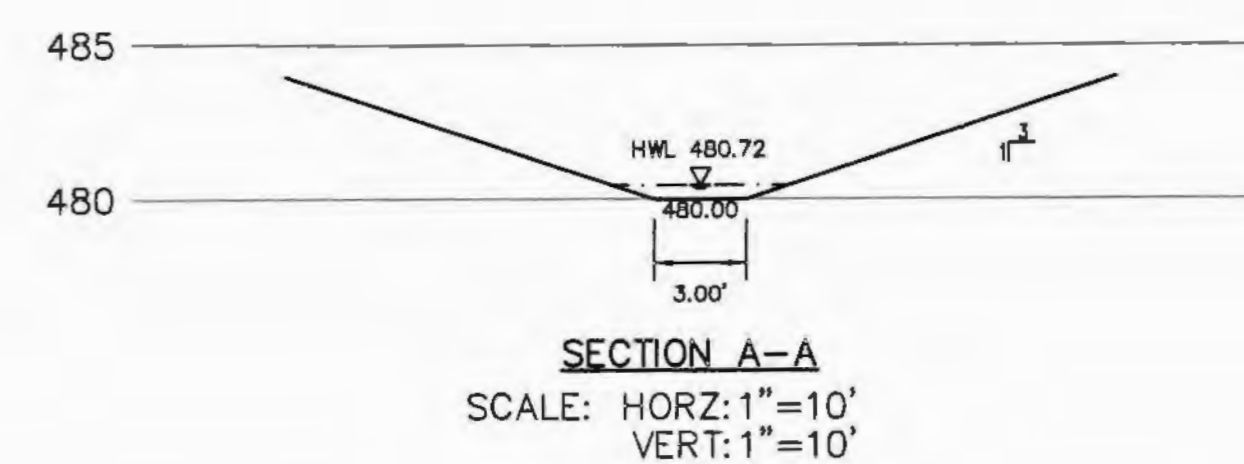

Stream Channel:

Project #:	210-4626
Name:	Crossing
Calculated:	PRG 12-08-10
Checked:	swale A-A
Station #:	swale A-A
Roughness Coefficient (n):	Concrete 0.012
Asphalt smooth	0.013
Asphalt rough	0.016
Gravel beds straight	0.025
Gravel beds plus large boulders	0.040
Earth winding w/ grass	0.050
Earth straight w/ grass	0.026

Manning Equation: $Q = (1.49n)A R^{2/3} S^{1/2}$


FIND DEPTH OF WATER AND WIDTH OF THE CHANNEL:

INPUT:

Top Of bank Elevation =	485.00
Bot. Elevation =	482.00
Stream Slope =	0.0223 (ft/ft)
Side Slope:	Horizontal (H) = 3
Vertical (V) =	1
W (Bottom width) =	3 (ft)

OUTPUT:

Depth =	0.52 (ft)
Velocity =	4.52 (ft/sec)
Water Surface Elev. =	482.52
Free Board =	3.48 (ft)
Water Surface Width =	6.12 (ft)
Perimeter =	6.29 (ft)
Cross section Area =	2.37 (ft ²)

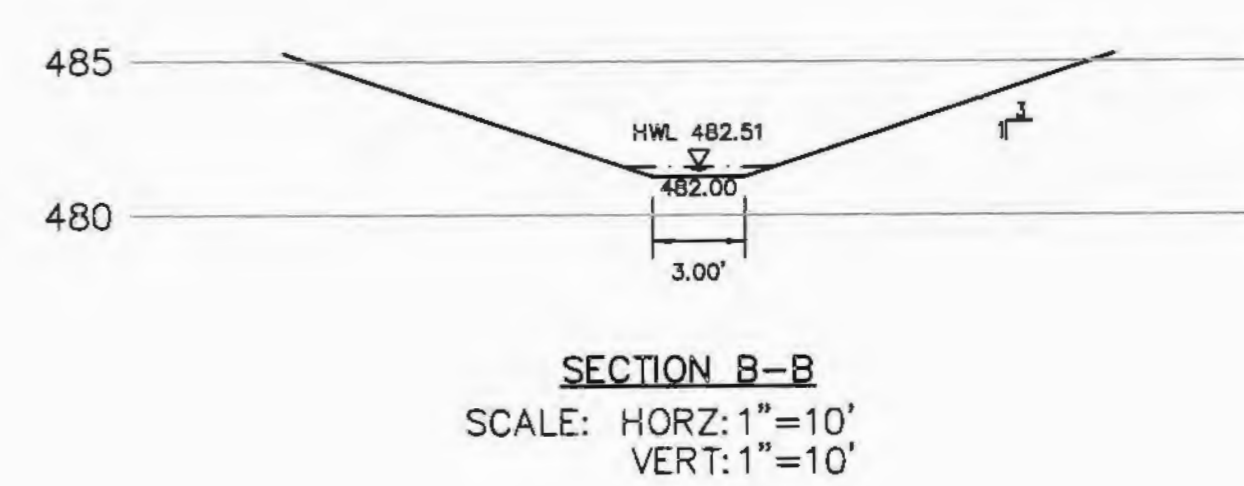

- ▲ WATER QUALITY 02/17/11
- ▲ CITY APPROVAL 02/01/11
- ▲ CITY COMMENTS 01/26/11
- ▲ CITY COMMENTS 01/13/11

THE CROSSING AT RIVERSIDE CENTRE
 SITE AND GRADING PLAN


STOCK & ASSOCIATES
 Consulting Engineers, Inc.

257 Chesterfield Business Parkway
 St. Louis, MO 63005
 PH. (636) 530-9100
 FAX (636) 530-9130
 e-mail: general@stockassoc.com
 Web: www.stockassoc.com


DATE: 02/17/11

GEORGE M. STOCK E-25116
 CIVIL ENGINEER
 CERTIFICATE OF AUTHORITY
 NUMBER: 000995


DRAWN BY: P.R.G. DATE: 12/21/10
 CHECKED BY: G.M.S. DATE: 12/21/10
 JOB NUMBER: 210-4626
 SHEET: C9

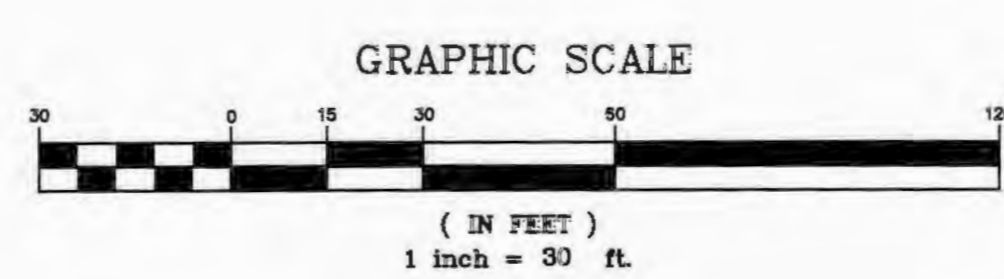

D:\VBA\4626\2104626\Survey\City\as-built\4626-Base2-bombardier.dwg Mar 08, 2016 - 11:31am

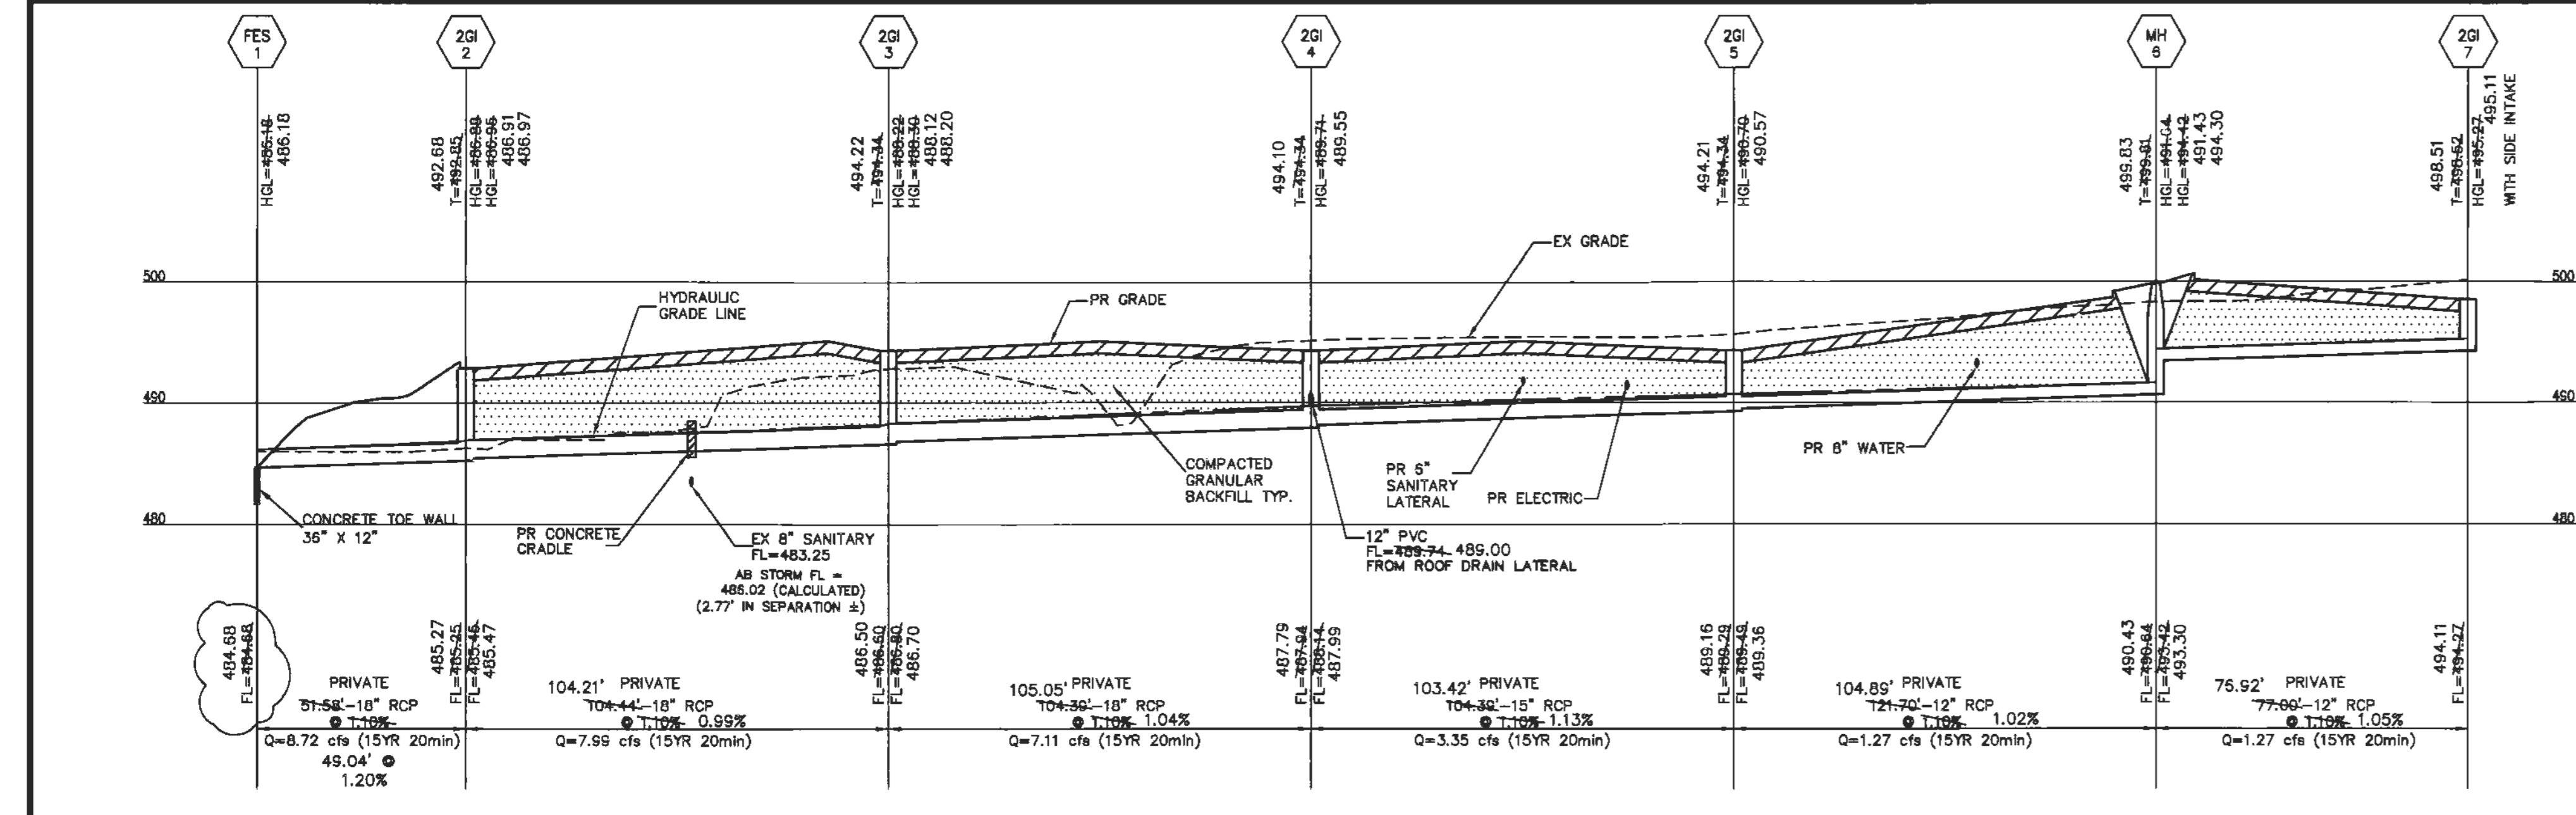


STORM SEWERS
SCALE: HORZ: 1"=30'
VERT: 1"=10'

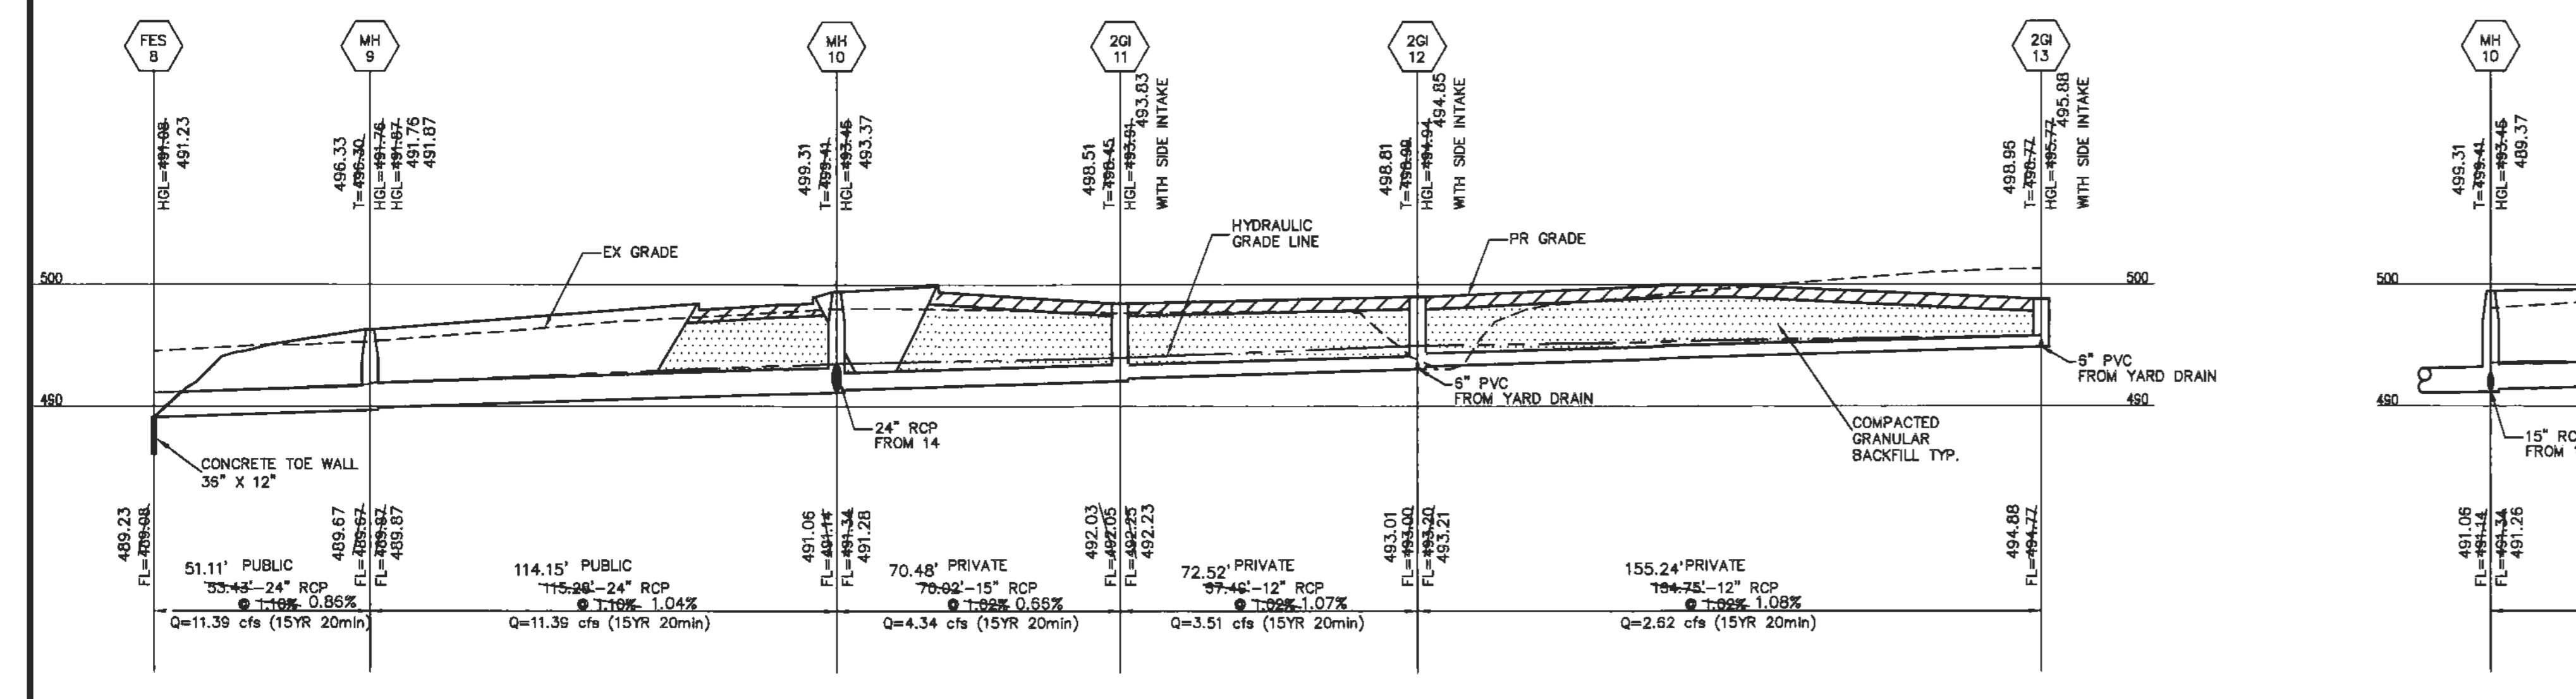

STORM SEWERS
SCALE: HORZ: 1"=30'
VERT: 1"=10'

STORM SEWERS
SCALE: HORZ: 1"=30'
VERT: 1"=10'

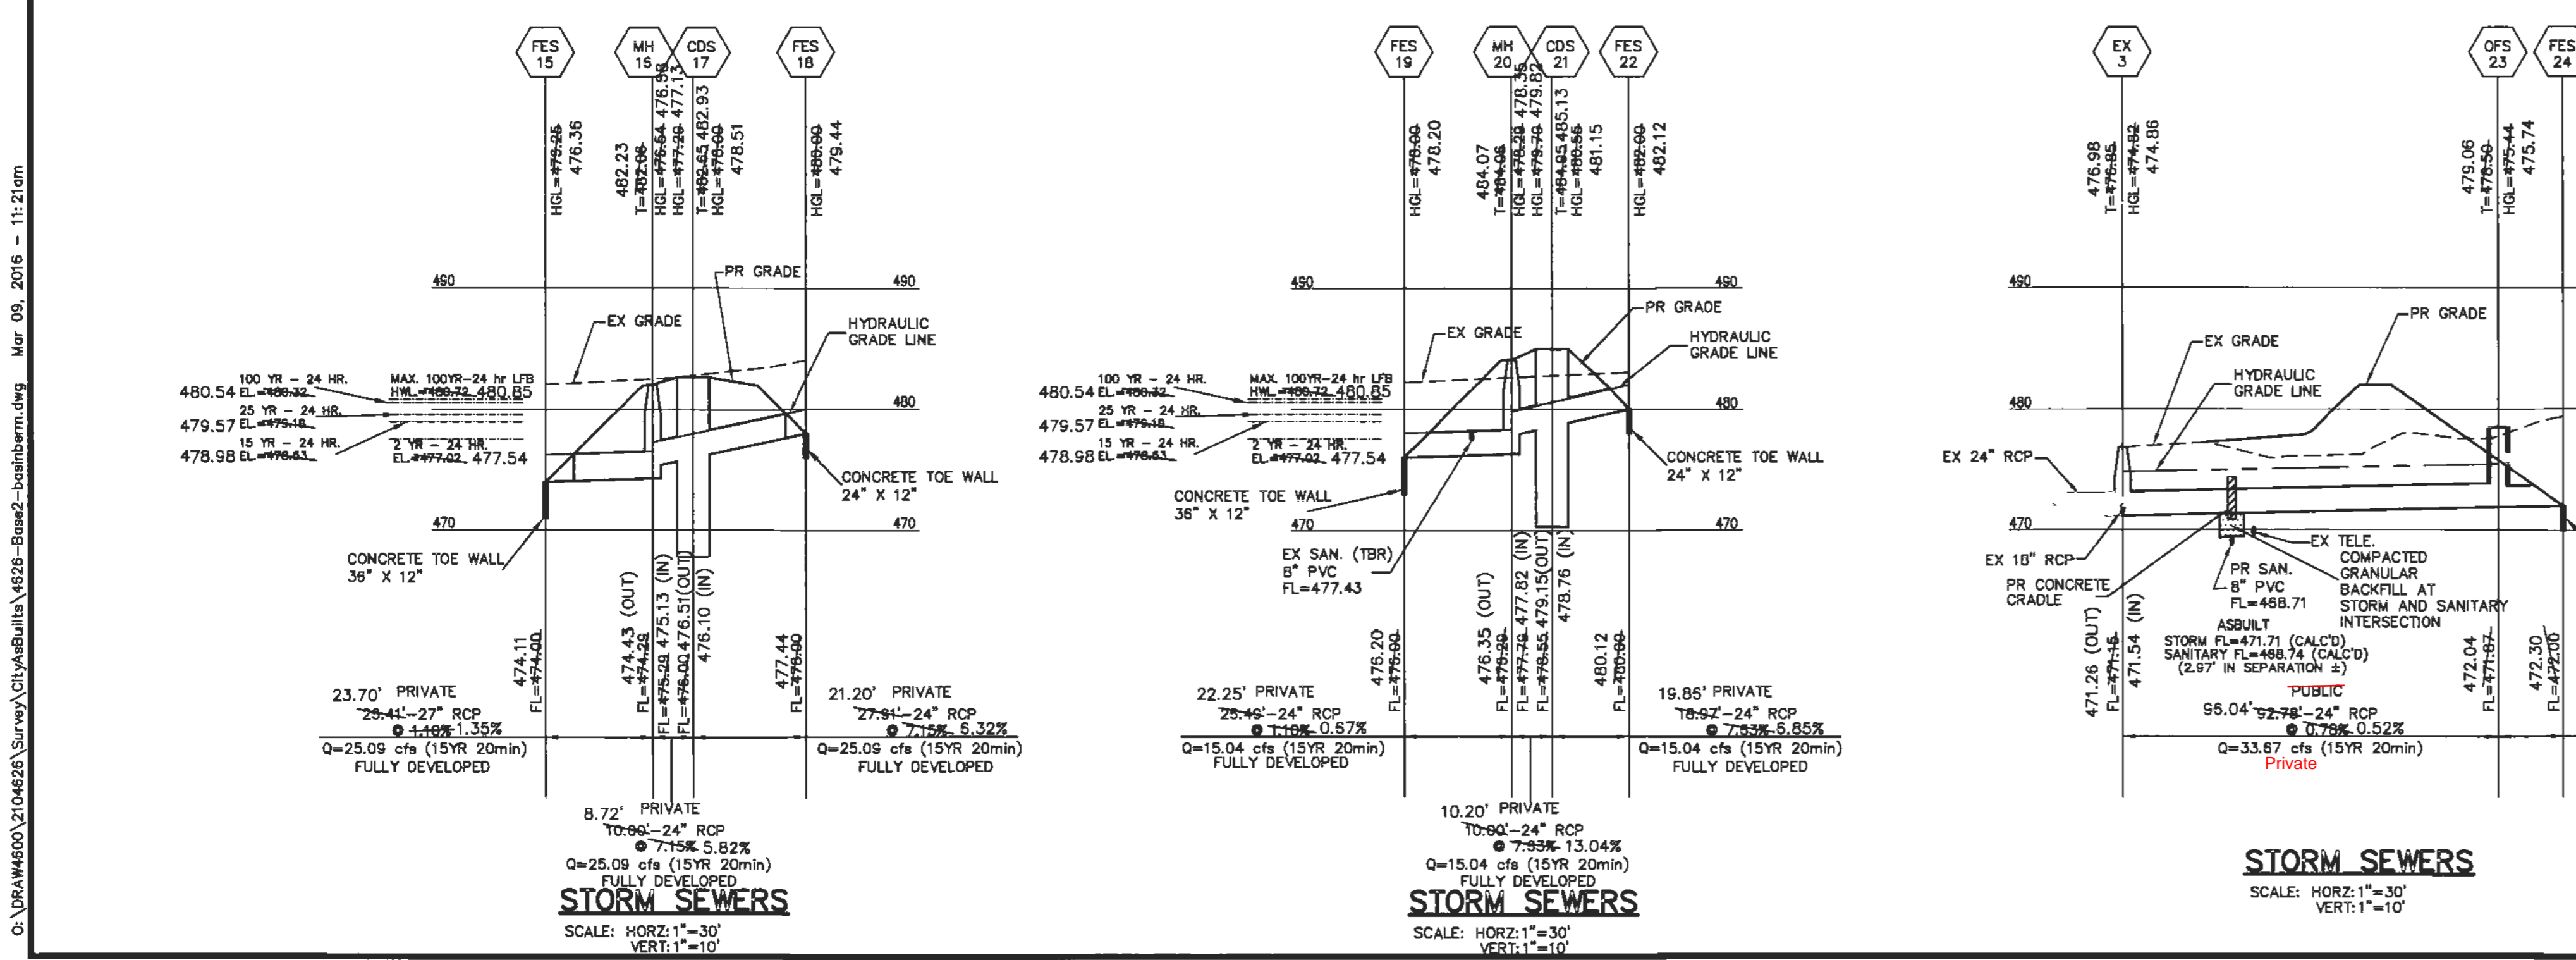

STORM SEWERS
SCALE: HORZ: 1"=30'
VERT: 1"=10'

STORM SEWERS
SCALE: HORZ: 1"=30'
VERT: 1"=10'

STORM SEWERS
SCALE: HORZ: 1"=30'
VERT: 1"=10'

STORM SEWER NOTE

ALL DETAILS SHOWN ON THIS SHEET ARE FOR THE CONVENIENCE OF THE CONTRACTOR. THE DETAILS ARE TO BE VERIFIED PER METROPOLITAN ST. LOUIS SEWER DISTRICT STANDARDS FOR STORM SEWERS, & CITY OF O'FALLON CONSTRUCTION SPECIFICATIONS. ALL METHODS, MEANS AND MATERIALS SHALL CONFORM TO M.S.D. CURRENT STANDARD CONSTRUCTION SPECIFICATIONS.

CONSTRUCTION NOTES:

1. ALL R.C.P. SHALL BE CLASS III UNLESS NOTED OTHERWISE.
2. ALL P.V.C. SHALL BE SDR 35 UNLESS NOTED OTHERWISE.
3. ALL NEW PIPE DESIGNATED PUBLIC WILL NOT BE MAINTAINED BY THE CITY UNTIL IT IS ACCEPTED FOR MAINTENANCE


ALL SEWERS SHOWN ARE PRIVATE, UNLESS OTHERWISE NOTED. ENGINEER APPROVED SHOP DRAWINGS MUST BE SUBMITTED TO THE CITY OF O'FALLON

AS-BUILT
SANITARY / STORM SEWER - WATER QUALITY FEATURE - WATER LINE

The existing sewer lengths, sizes, flowlines, depths of structures and sewers locations with respect to existing or proposed easements have been measured. Water Quality Features, Retention Basins and drainage swales have been measured. Fire hydrants and valves have been measured. The results of those measurements are shown on this set of Final Measurement plans. Since the sanitary wye locations have been plotted from information provided by the sewer contractor or other sources, I disclaim any responsibility for that specific information.

All public sewers are located within designated existing or proposed easements.

Randall S. Rosson 3-9-16
Randall S. Rosson, P.L.S. NO. 2006-000171 Date

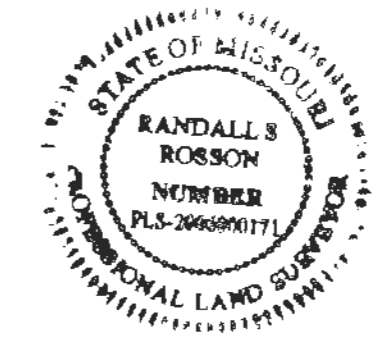

- △ WATER QUALITY 02/17/11
- △ CITY APPROVAL 02/01/11
- △ CITY COMMENTS 01/25/11
- △ CITY COMMENTS 01/13/11

02/17/11


THE CROSSING AT RIVERSIDE CENTRE
STORM SEWER PROFILES

Stock & Associates
Consulting Engineers, Inc.

257 Chesterfield Business Parkway
St. Louis, MO 63005
PH. (636) 530-9100
FAX (636) 530-9130
e-mail: general@stockassoc.com
Web: www.stockassoc.com

GEORGE M. STOCK CIVIL ENGINEER NUMBER: 000996	E-25115	DATE: 12/21/10	CHECKED BY: G.M.S.	DATE: 12/21/10	DATE: 12/21/10	JOB NUMBER: 210-4626	SHEET: C13
---	---------	----------------	--------------------	----------------	----------------	----------------------	------------

C:\DRAWING\2104626\SURVEY\CITY\SUBMITTA\626-Base2-boanberrm.dwg Mar 09, 2016 - 11:21am

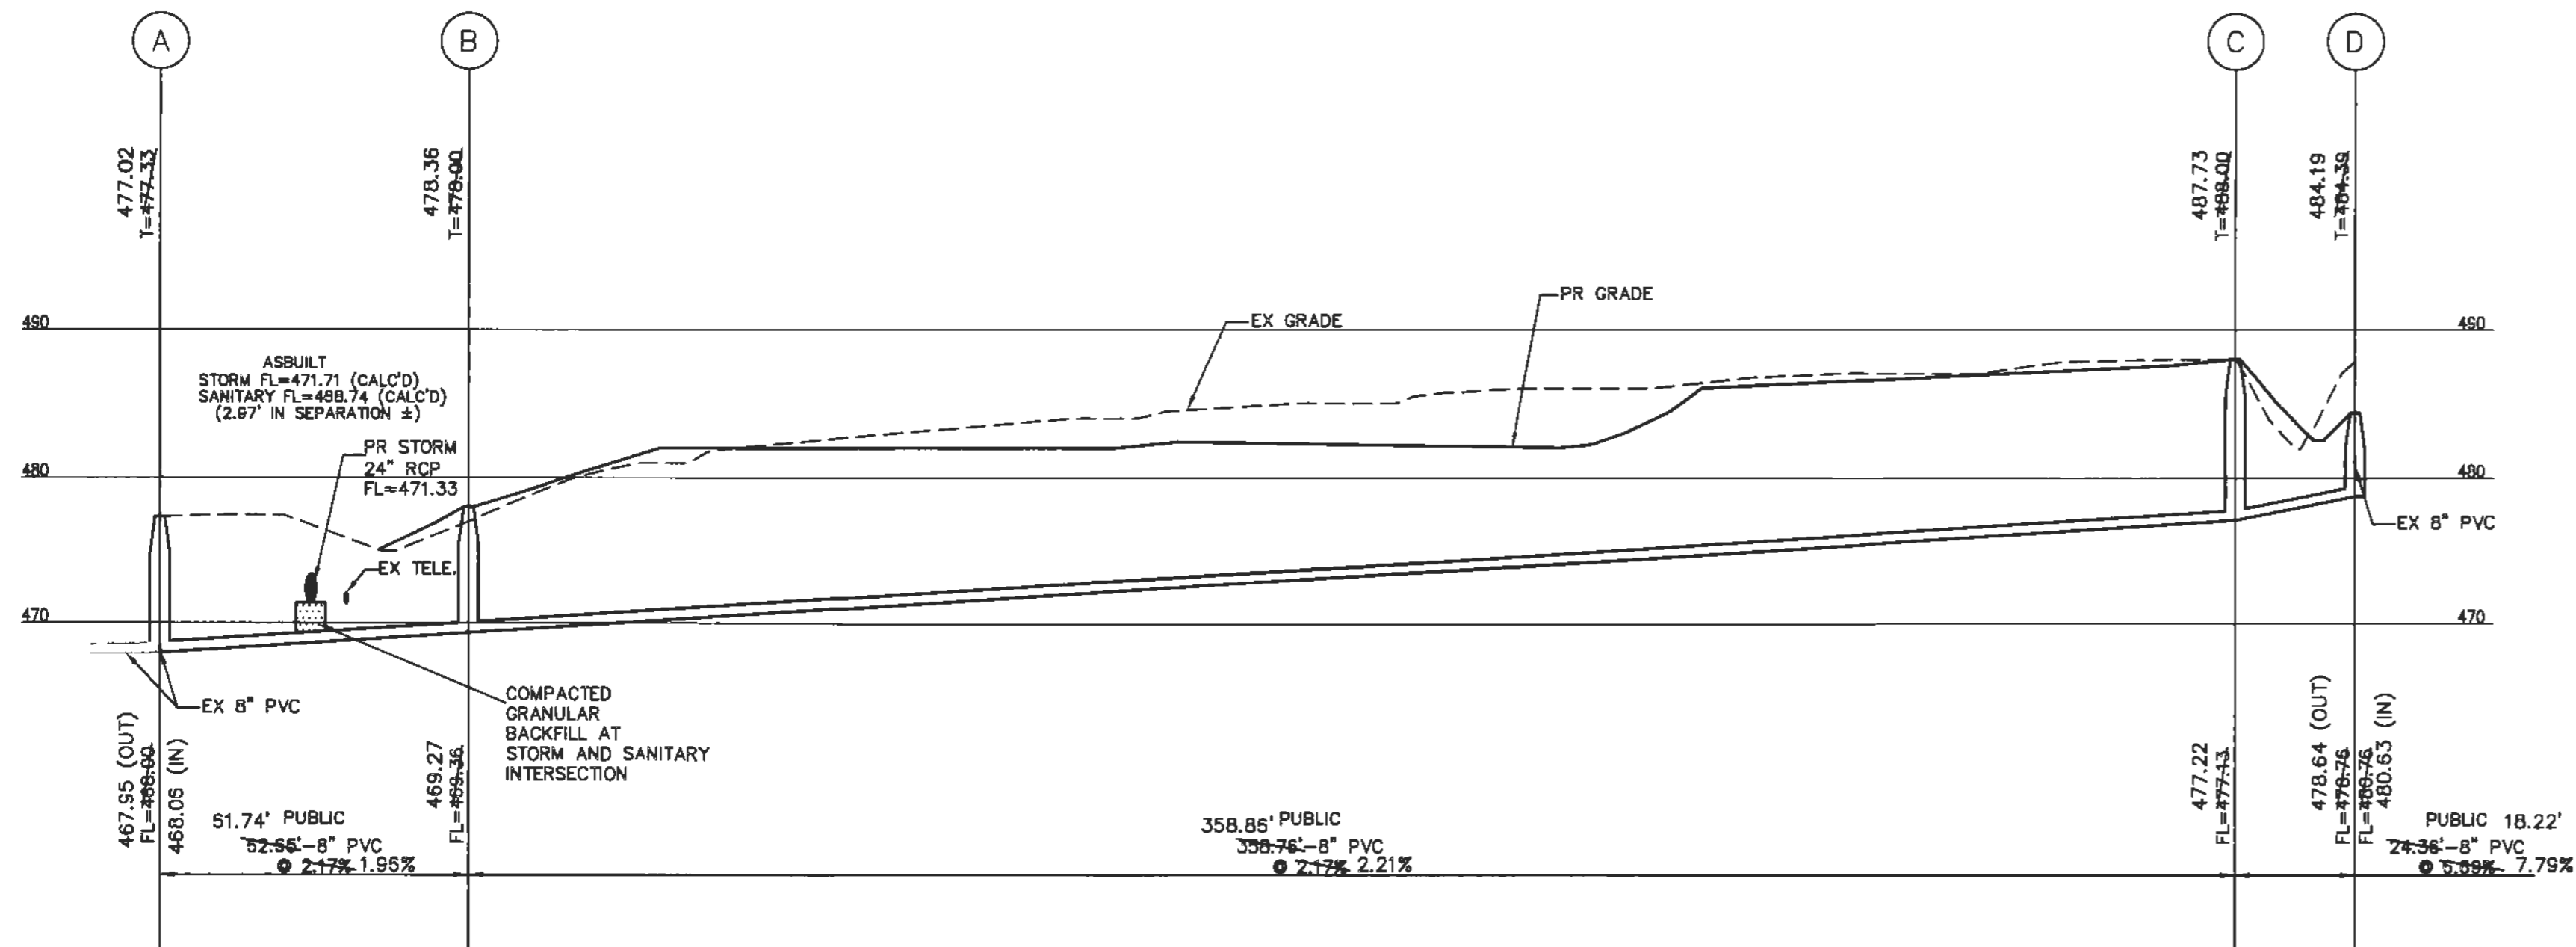

SANITARY SEWER NOTE
 ALL DETAILS SHOWN ON THIS SHEET ARE FOR THE CONVENIENCE OF THE CONTRACTOR. THE DETAILS ARE TO BE VERIFIED PER MSD STANDARDS FOR SANITARY SEWERS & CITY OF FALLON CONSTRUCTION SPECIFICATIONS.

- CONSTRUCTION NOTES:**
1. ALL R.C.P. SHALL BE CLASS III UNLESS NOTED OTHERWISE.
 2. ALL P.V.C. SHALL BE SDR 35 UNLESS NOTED OTHERWISE.
- ALL SEWERS SHOWN ARE PRIVATE, UNLESS OTHERWISE NOTED.
 ENGINEER APPROVED SHOP DRAWINGS MUST BE SUBMITTED TO THE CITY OF FALLON

SANITARY SEWER CONSTRUCTION MAIN SWITCH OVER TO NEW MAIN TO BE COORDINATED WITH OTHER FACILITIES USING THE MAIN, CITY OF FALLON CONSTRUCTION INSPECTOR AND THE CITY OF FALLON WATER AND SEWER DEPARTMENT FOR SCHEDULING.

SANITARY SEWERS
 SCALE: HORZ: 1"=30'
 VERT: 1"=10'

AS-BUILT

SANITARY / STORM SEWER - WATER QUALITY FEATURE - WATER LINE

The existing sewer lengths, sizes, flowlines, depths of structures and sewers locations with respect to existing or proposed easements have been measured. Water Quality Features, Retention Basins and drainage swales have been measured. Fire hydrants and valves have been measured. The results of those measurements are shown on this set of Final Measurement plans. Since the sanitary wye locations have been plotted from information provided by the sewer contractor or other sources, I disclaim any responsibility for that specific information.

All public sewers are located within designated existing or proposed easements.

Randall S. Rosson 3-9-16
 Randall S. Rosson, P.L.S. NO. 2006-000171 Date



HYDRAULIC CALCULATION SHEET (SEE DRAINAGE AREA MAP SHEET FOR P.I. AND Q (inflow) FOR EACH STRUCTURE)

Project name:		The Crossing at Riverside Centre		Calculated By:		PRG																			
Project number:		210-4626		Checked By:		GMS																			
Project Location:		Ofallon, MO		Date:		7/11/2011																			
LINE		FLOW LINE ELEVATIONS		Length		Flowline		Pipe Size		Full Flow		Bend Coefficients:		HEAD LOSS		Hydraulic Elevations		Structure		TOP		Free		Structure	
Structure Number	Upper structure	Lower structure	Upper	Lower	(ft)	Grade ft/ft	(in.)	Cap. (cfs)	Total (Q) (cfs)	Mean Full Flow Vel.(V) (ft/s)	Bend Coef.	Velocity (ft/s)	Q _{Vs} (ft ³ /s)	Pipe Coef. (n)	Hr (ft)	Junction (ft)	Bend (ft)	Total H _{fr} + Dia. → H _l	Upper F.L. → H _l	Lower H.E. → H _l	Lower H.E. → H _l	Upper H.E. + H _{fr} → H _l	Structure Elevation	Free Board	Structure Number
EX5	EX5	EX4	476.71	472.70	95.21	0.0422	18	21.63	4.20	2.38	0	0.09	0.37	0.013	0.15	0.00	0.00	0.00	478.21	475.11	474.96	478.21	478.21	0.00	EX5
EX4	EX4	EX3	472.70	471.26	37.86	0.0379	18	20.51	4.20	2.38	0.43	0.09	0.37	0.013	0.06	0.00	0.04	0.04	474.20	474.92	474.86	474.96	478.19	3.23	EX4
EX3	EX3	EX2	471.26	470.85	18.74	0.0219	24	33.55	25.84	8.23	0	1.05	27.15	0.013	0.24	1.38	0.00	1.38	473.26	473.48	473.24	474.86	476.85	1.99	EX3
EX2	EX2	EX1	469.14	468.64	40.30	0.0124	24	25.27	33.47	10.65	0.43	1.76	58.99	0.013	0.88	1.27	0.45	1.72	471.14	471.52	470.64	473.24	475.90	2.66	EX2
EX1			468.64																			470.64			EX1
HYDRAULIC FLOW LINE = assume top pipe																									
23	23	EX3	472.04	471.54	96.04	0.0052	24	16.37	21.64	6.89	0	0.74	15.94	0.013	0.88	0.00	0.00	0.00	474.04	475.74	474.86	475.74	479.06	3.32	23
EX3			471.26																			474.86			EX3
HYDRAULIC FLOW LINE = assume top pipe																									
22	22	21	480.12	478.76	19.86	0.0685	24	59.36	15.04	4.79	0	0.36	5.35	0.013	0.09	0.00	0.00	0.00	482.12	481.24	481.15	482.12	482.12	0.00	22
21	21	20	479.15	477.82	10.20	0.1304	24	81.91	15.04	4.79	0	0.36	5.35	0.013	0.05	0.00	0.00	0.00	481.15	479.87	479.82	481.15	485.13	3.98	21
20	20	19	476.35	476.20	22.25	0.0067	24	18.62	15.04	4.79	DROP	0.36	5.35	0.013	0.10	0.00	0.00	0.00	478.35	478.30	478.20	478.35	484.07	5.72	20
19			476.20																			478.20			19
HYDRAULIC FLOW LINE = assume top pipe																									
18	18	17	477.44	476.10	21.20	0.0632	24	57.03	25.09	7.99	0	0.99	24.85	0.013	0.26	0.00	0.00	0.00	479.44	478.77	478.51	479.44	480.00	0.56	18
17	17	16	476.51	475.13	8.72	0.1583	24	90.24	25.09	7.99	0	0.99	24.85	0.013	0.11	0.00	0.00	0.00	478.51	477.24	477.13	478.51	482.93	4.42	17
16	16	15	474.43	474.11	23.70	0.0135	27	36.08	25.09	6.31	DROP	0.62	15.51	0.013	0.16	0.00	0.00	0.00	476.68	476.52	476.36	476.68	482.23	5.55	16
15			474.11																			476.36			15
HYDRAULIC FLOW LINE = assume top pipe																									
14	14	10	492.84	491.26	130.23	0.0121	24	24.99	7.07	2.25	0	0.08	0.56	0.013	0.13	0.00	0.00	0.00	494.84	493.50	493.37	494.84	501.20	6.36	14
10			491.06																			493.37			10
HYDRAULIC FLOW LINE = assume top pipe																									
13	13	12	494.88	493.21	155.24	0.0108	12	3.71	2.62	3.34	0	0.17	0.45	0.013	0.84	0.00	0.00	0.00	495.88	495.69	494.85	495.88	498.96	3.08	13
12	12	11	493.01	492.23	72.52	0.0108	12	3.70	3.51	4.47	0.43	0.31	1.09	0.013	0.70	0.24	0.07	0.32	494.01	494.54	493.83	494.85	498.81	3.96	12
11	11	10	492.03	491.28	70.48	0.0106	15	6.68	4.32	3.52	0.47	0.19	0.83	0.013	0.31	0.00	0.15	0.15	493.28	493.69	493.37	493.83	498.51	4.68	11
10	10	9	491.06	489.87	114.15	0.0104	24	23.16	11.39	3.63	0.06, 0.7	0.20	2.32	0.013	0.29	0.17	0.14	0.31	493.06	492.16	491.87	493.37	499.31	5.94	10
9	9	8	489.67	489.23	51.11	0.0086	24	21.05	11.39	3.63	0.43	0.20	2.32	0.013	0.13	0.00	0.09	0.09	491.67	491.36	491.23	491.76	496.33	4.57	9
8			489.23																			491.23			8
HYDRAULIC FLOW LINE = assume top pipe																									
7	7	6	494.11	493.30	76.92	0.0105	12	3.67	1.27	1.62	0	0.04	0.05	0.013	0.10	0.00	0.00	0.00	495.11	494.40	494.30	495.11	498.51	3.40	7
6	6	5	490.43	489.36	104.89	0.0102	12	3.61	1.27	1.62	DROP	0.04	0.05	0.013	0.13	0.00	0.00	0.00	491.43	490.70	490.57	491.43	499.83	8.40	6
5	5	4	489.16	487.99	103.42	0.0113	15	6.89	3.35	2.73	0.65	0.12	0.39	0.013	0.28	0.13	0.03	0.16	490.41	489.83	489.55	490.57	494.21	3.64	5
4	4	3	487.79	486.70	105.05	0.0104	18	10.73	7.11	4.02	0	0.25	1.79	0.013	0.48	0.26	0.00	0.26	489.29	488.68	488.20	489.55	494.10	4.55	4
3	3	2	486.50	485.47	104.21	0.0099	18	10.47	7.99	4.52	0	0.32	2.54	0.013	0.60	0.12	0.00	0.12	488.00	487.57	486.97	488.12	494.22	6.10	3
2	2	1	485.27	484.68	49.04	0.0120	18	11.55	8.72	4.93	0.06	0.38	3.30	0.013	0.34	0.12	0.02	0.14	486.77	486.52	486.18	486.91	492.68	5.77	2
1			484.68																			486.18			1
HYDRAULIC FLOW LINE = assume top pipe																									

FORMULAS:
 MEAN FULL FLOW VELOCITY $V = Q_{ACT} / A_{PIPE}$
 FRICTION LOSS (H_f): $H_f = 2.47 n^2 (L V^{1.48}) / d^{4.75}$
 VELOCITY HEAD: $V_h = V^2 / 2g$
 JUNCTION LOSSES (JUNC.): $[Q_{out} V_{out} - \sum (Q_{in} V_{in})] \times 1.33 / [Q_{out}]$
 BEND LOSSES (BEND) = $(V^3) \times$ ANGLE COEFFICIENT
Notes:
 1. IF MORE THAN ONE INCOMING LINE, CALC. EACH BEND LOSS AND ADD TOGETHER.
 2. NO STRUCTURE LOSSES TO BE CALCULATED AT A DROP
 3. IF $Q_{V(hin)} > Q_{V(hout)}$, NO JUNCTION LOSSES TO BE CALCULATED.

- △ WATER QUALITY 02/17/11
- △ CITY APPROVAL 02/01/11
- △ CITY COMMENTS 01/26/11
- △ CITY COMMENTS 01/13/11

THE CROSSING AT RIVERSIDE CENTRE
 STORM HYDRAULICS AND SANITARY PROFILE







Stock & Associates
 Consulting Engineers, Inc.

257 Chesterfield Business Parkway
 St. Louis, MO 63005
 PH. (636) 530-9100
 FAX (636) 530-9130
 e-mail: general@stockassoc.com
 Web: www.stockassoc.com

DATE: 02/17/11
 DRAWN BY: P.R.G. DATE: 12/21/10 CHECKED BY: G.M.S. DATE: 12/21/10 JOB NUMBER: 210-4626 SHEET: C14



GEORGE M. STOCK E-25115
 CIVIL ENGINEER
 CERTIFICATE OF AUTHORITY
 NUMBER: 000995

C:\DRAWING\2104626\Survey\City\AsBuilt\4626-Base2-banberm.dwg Mar. 05. 2016 11:21am

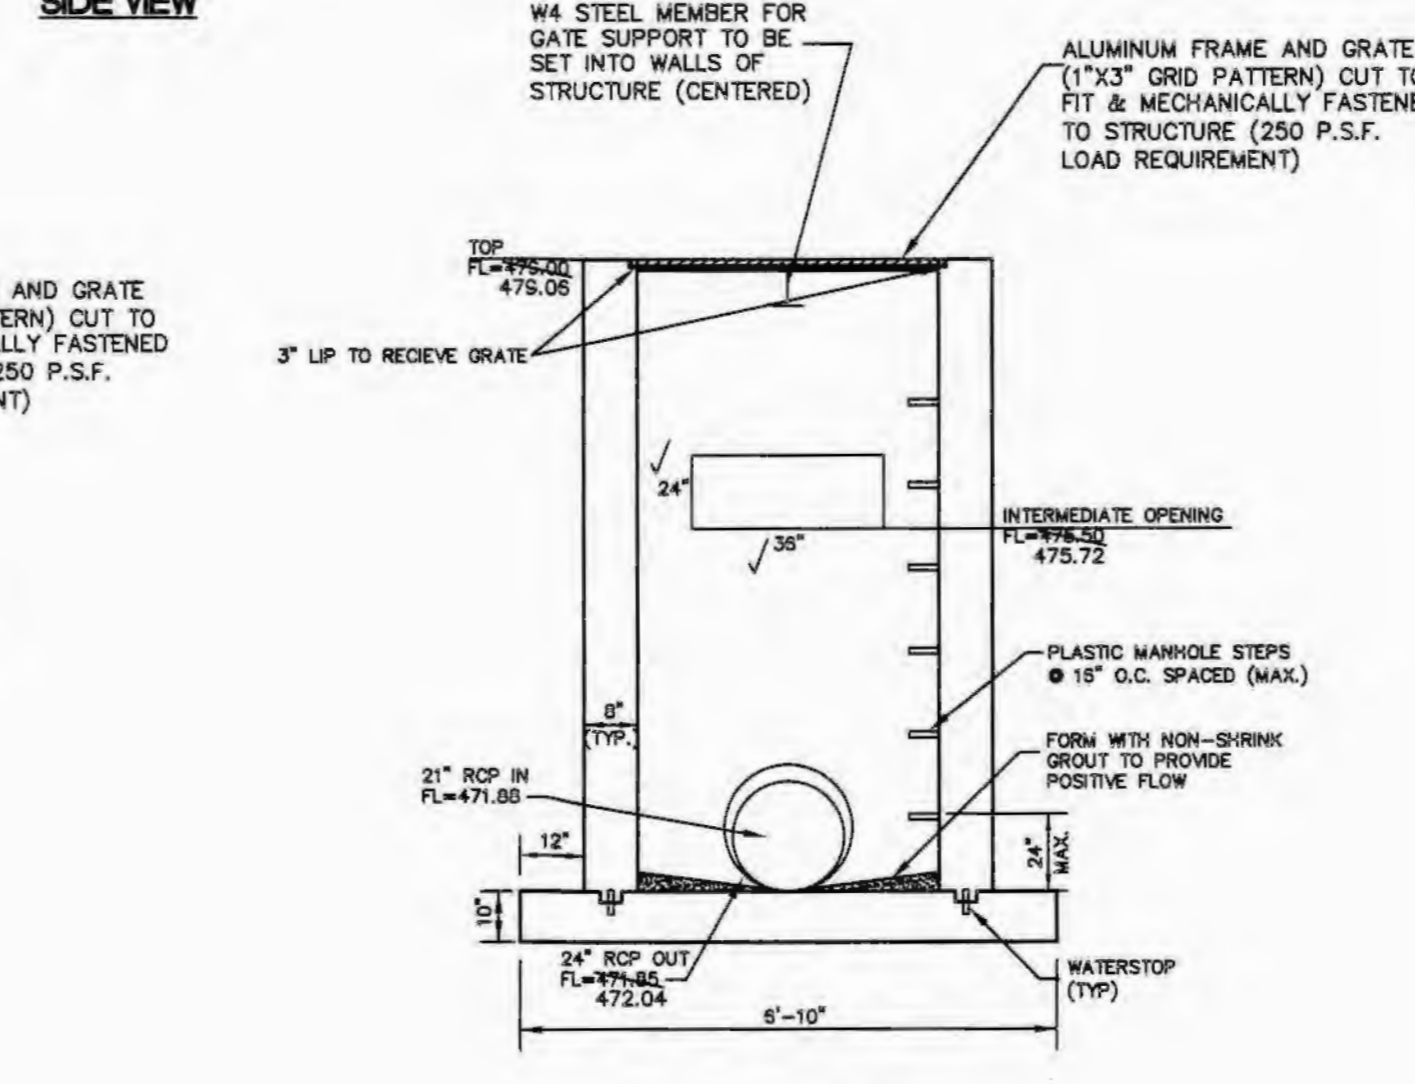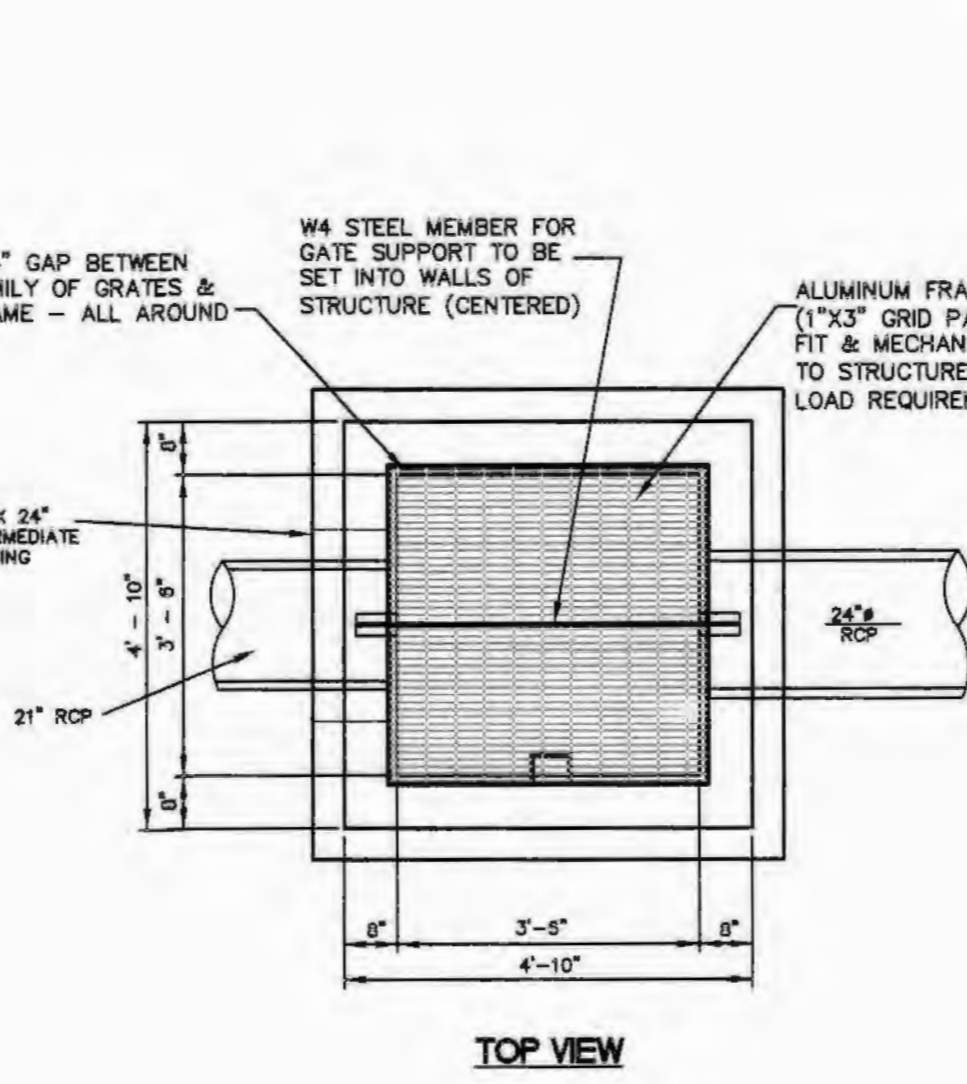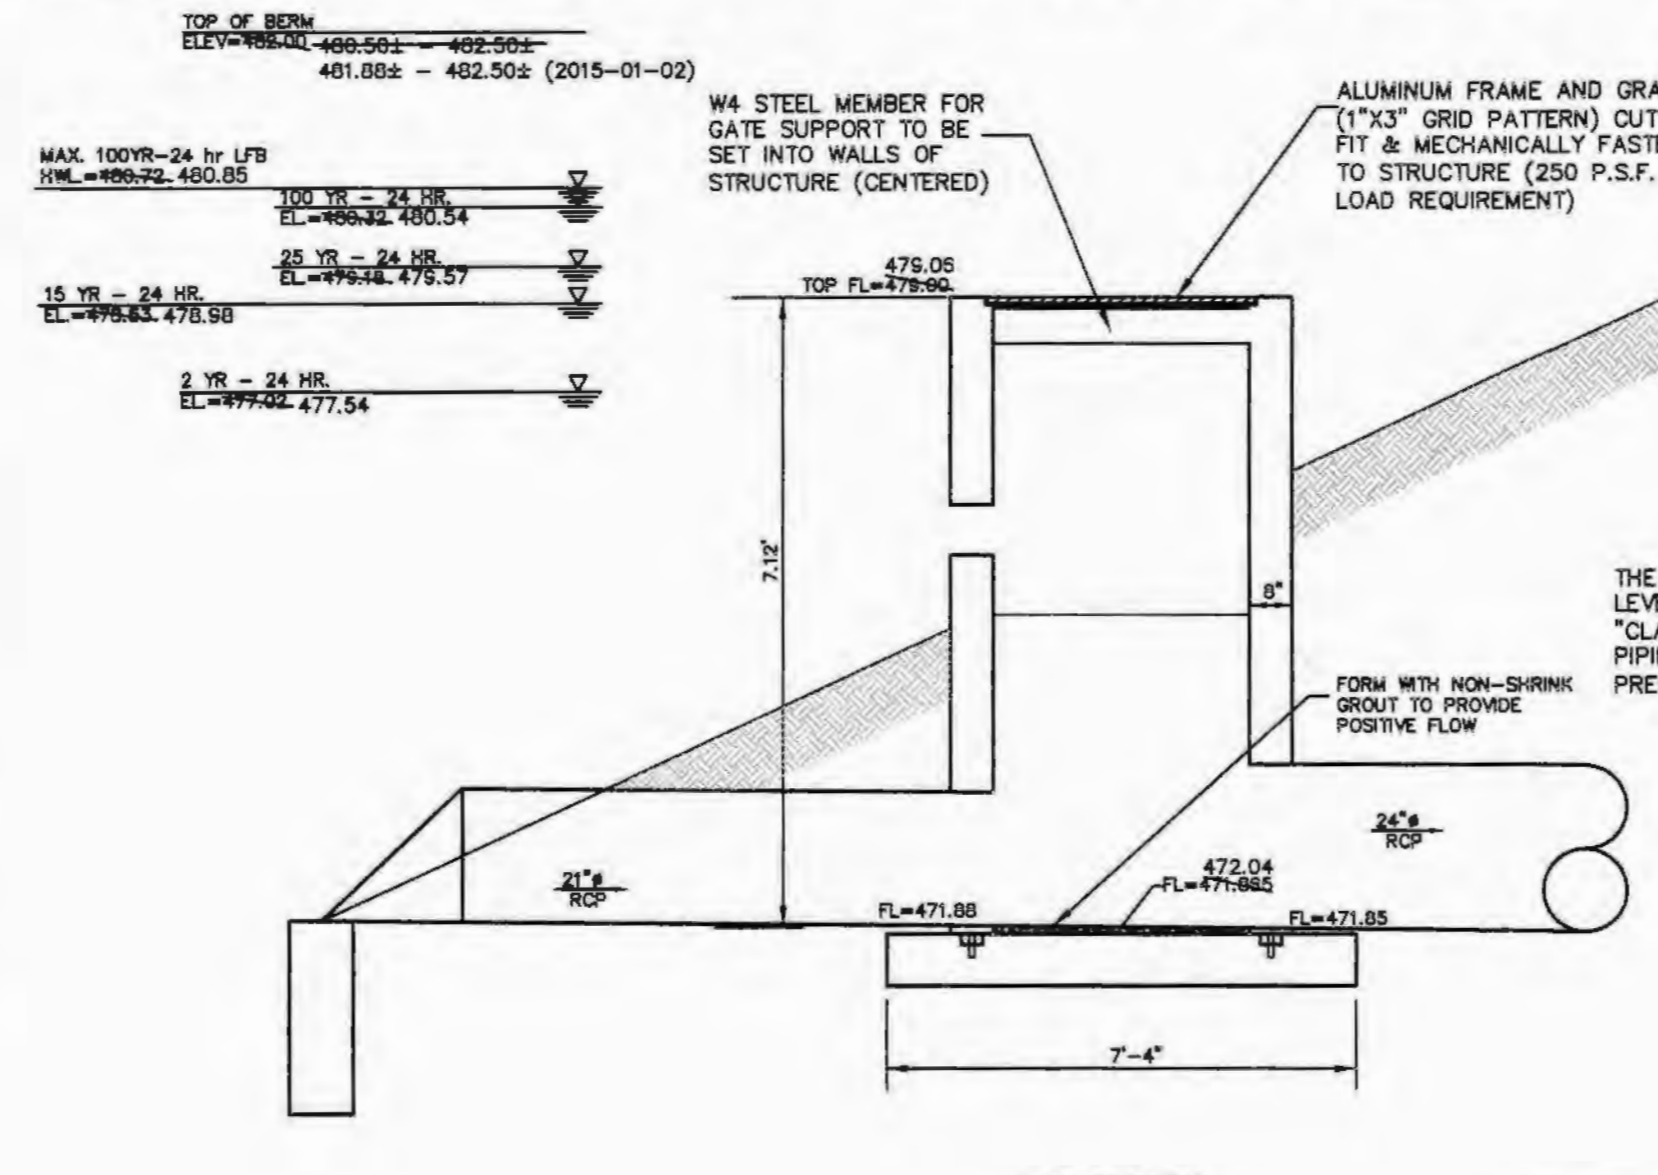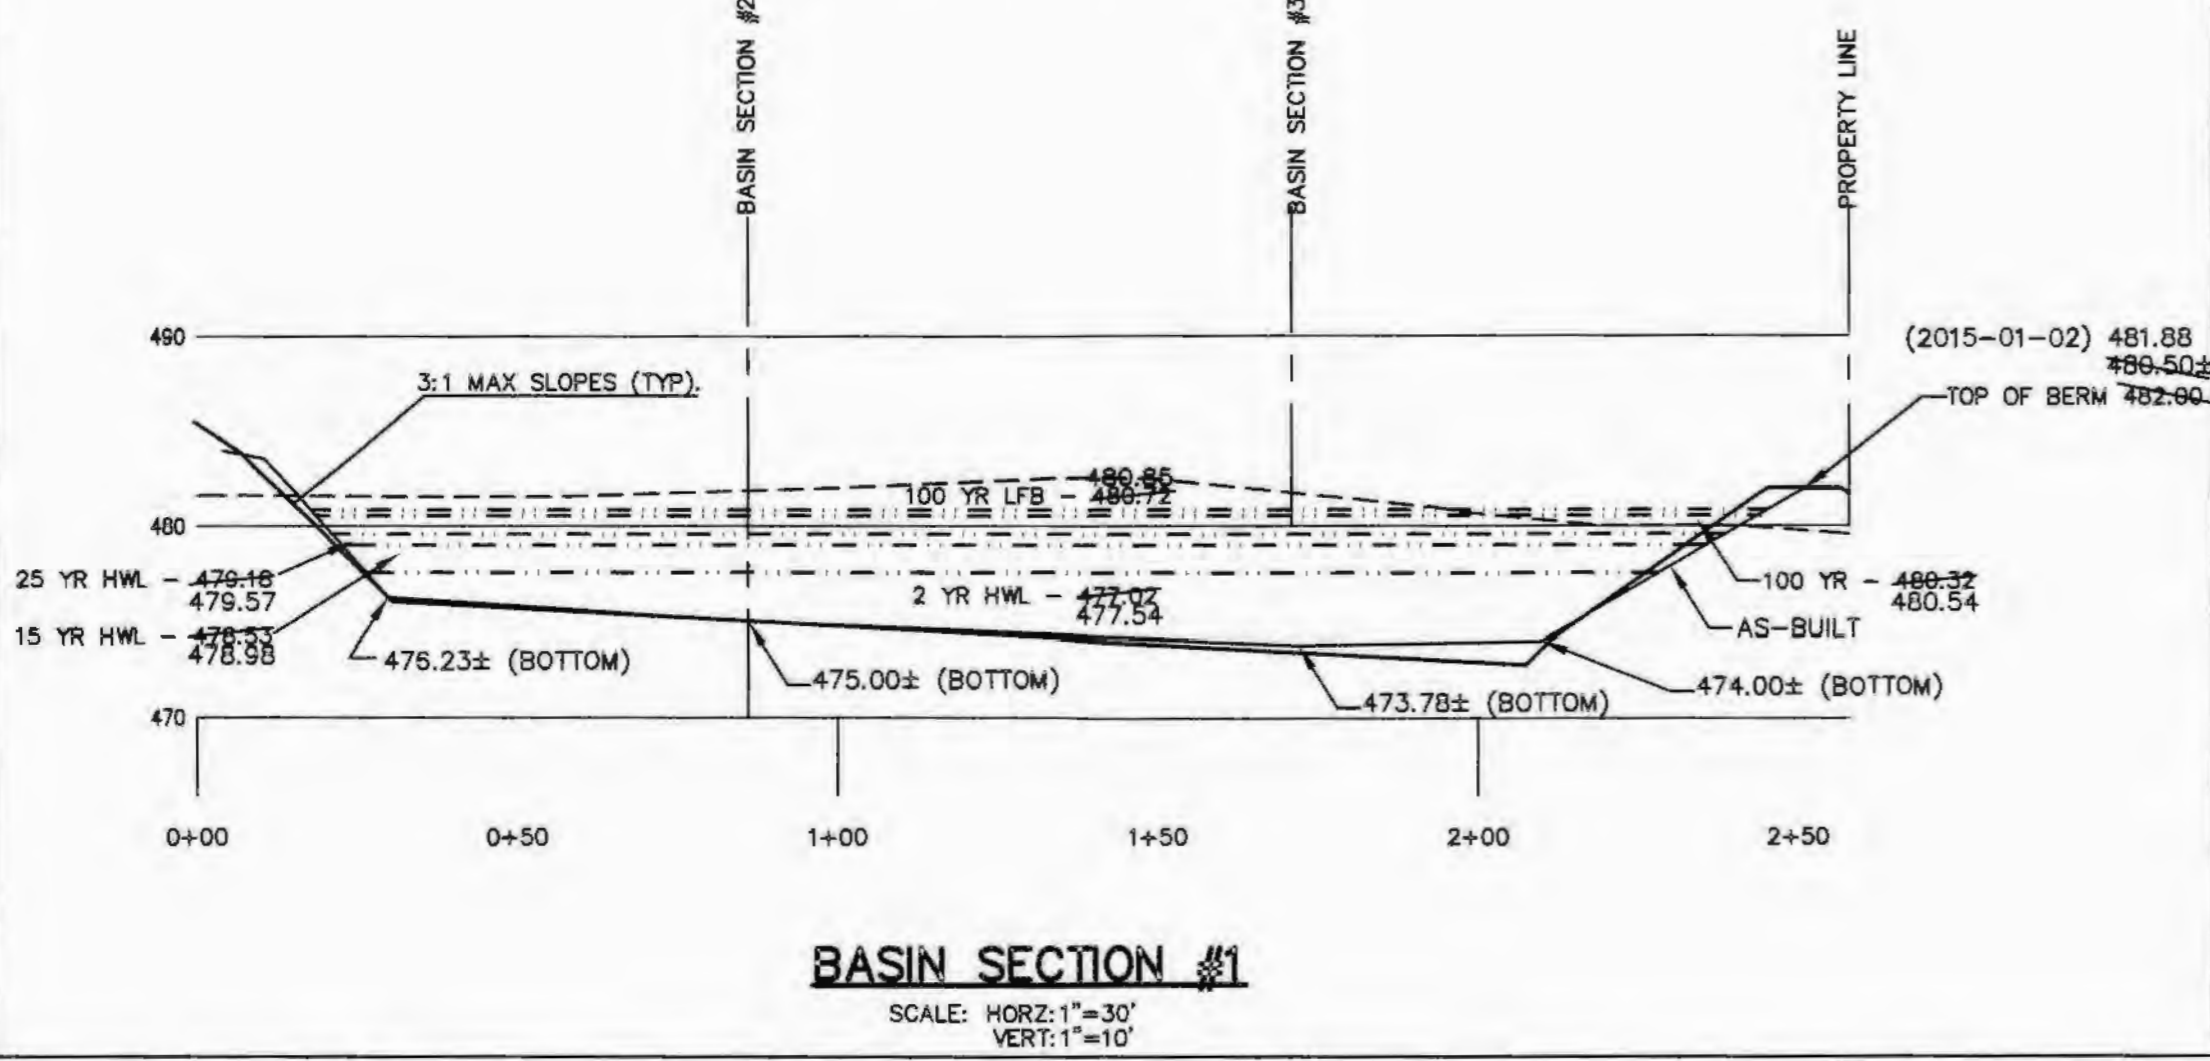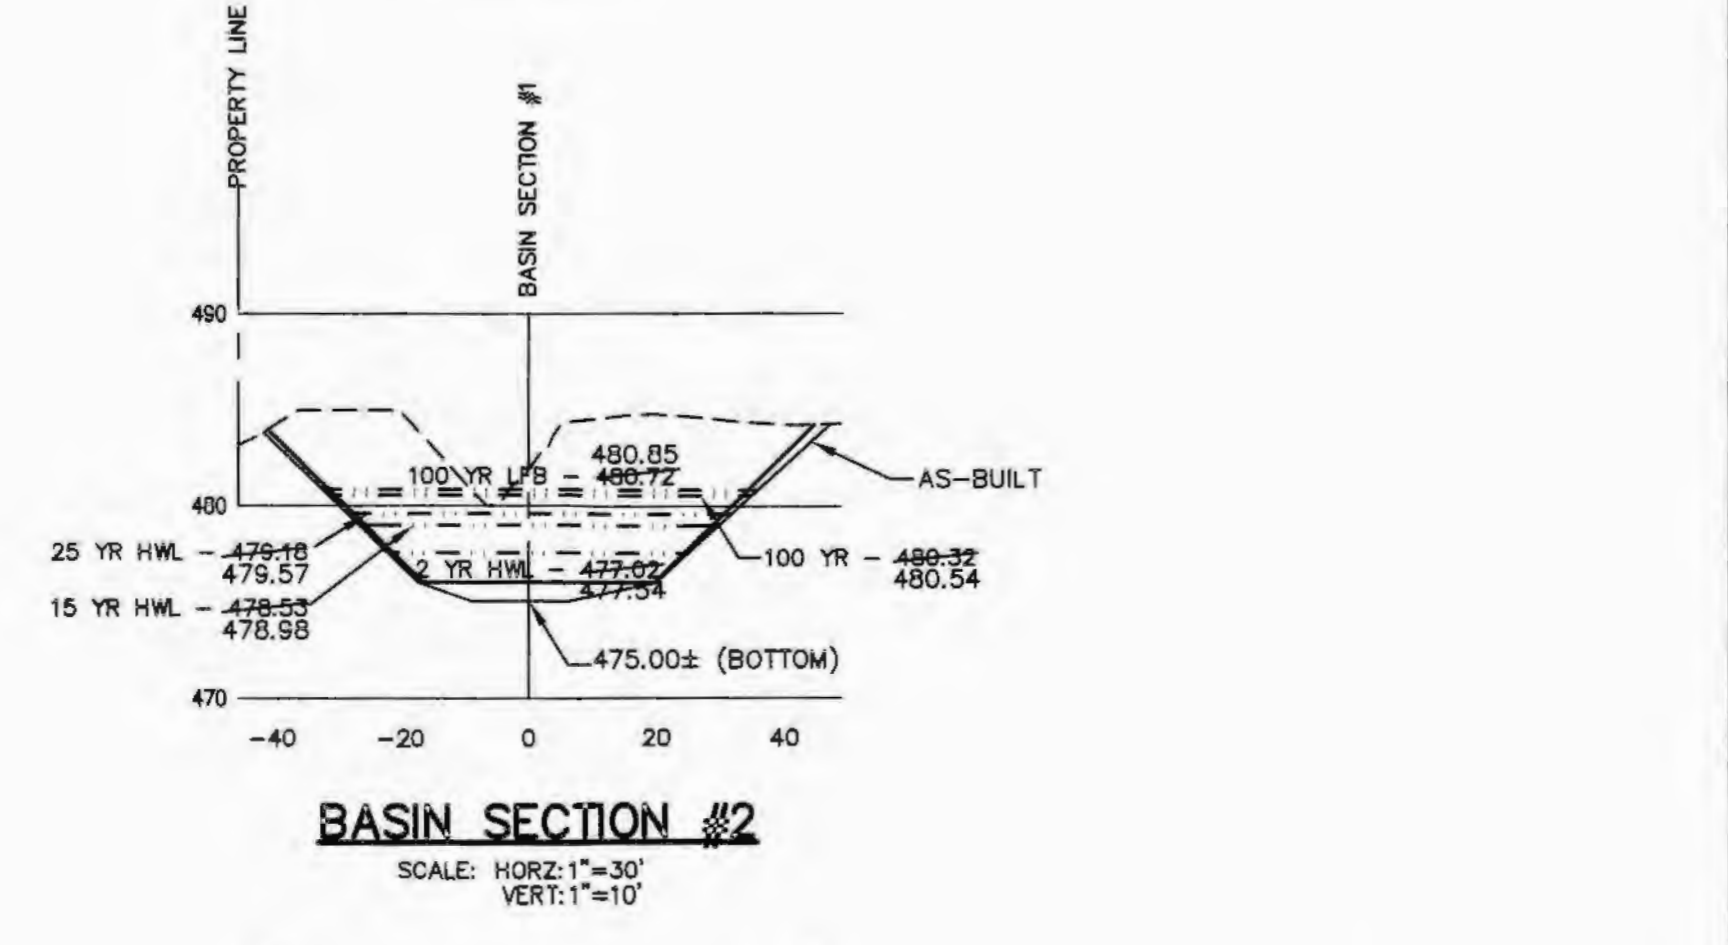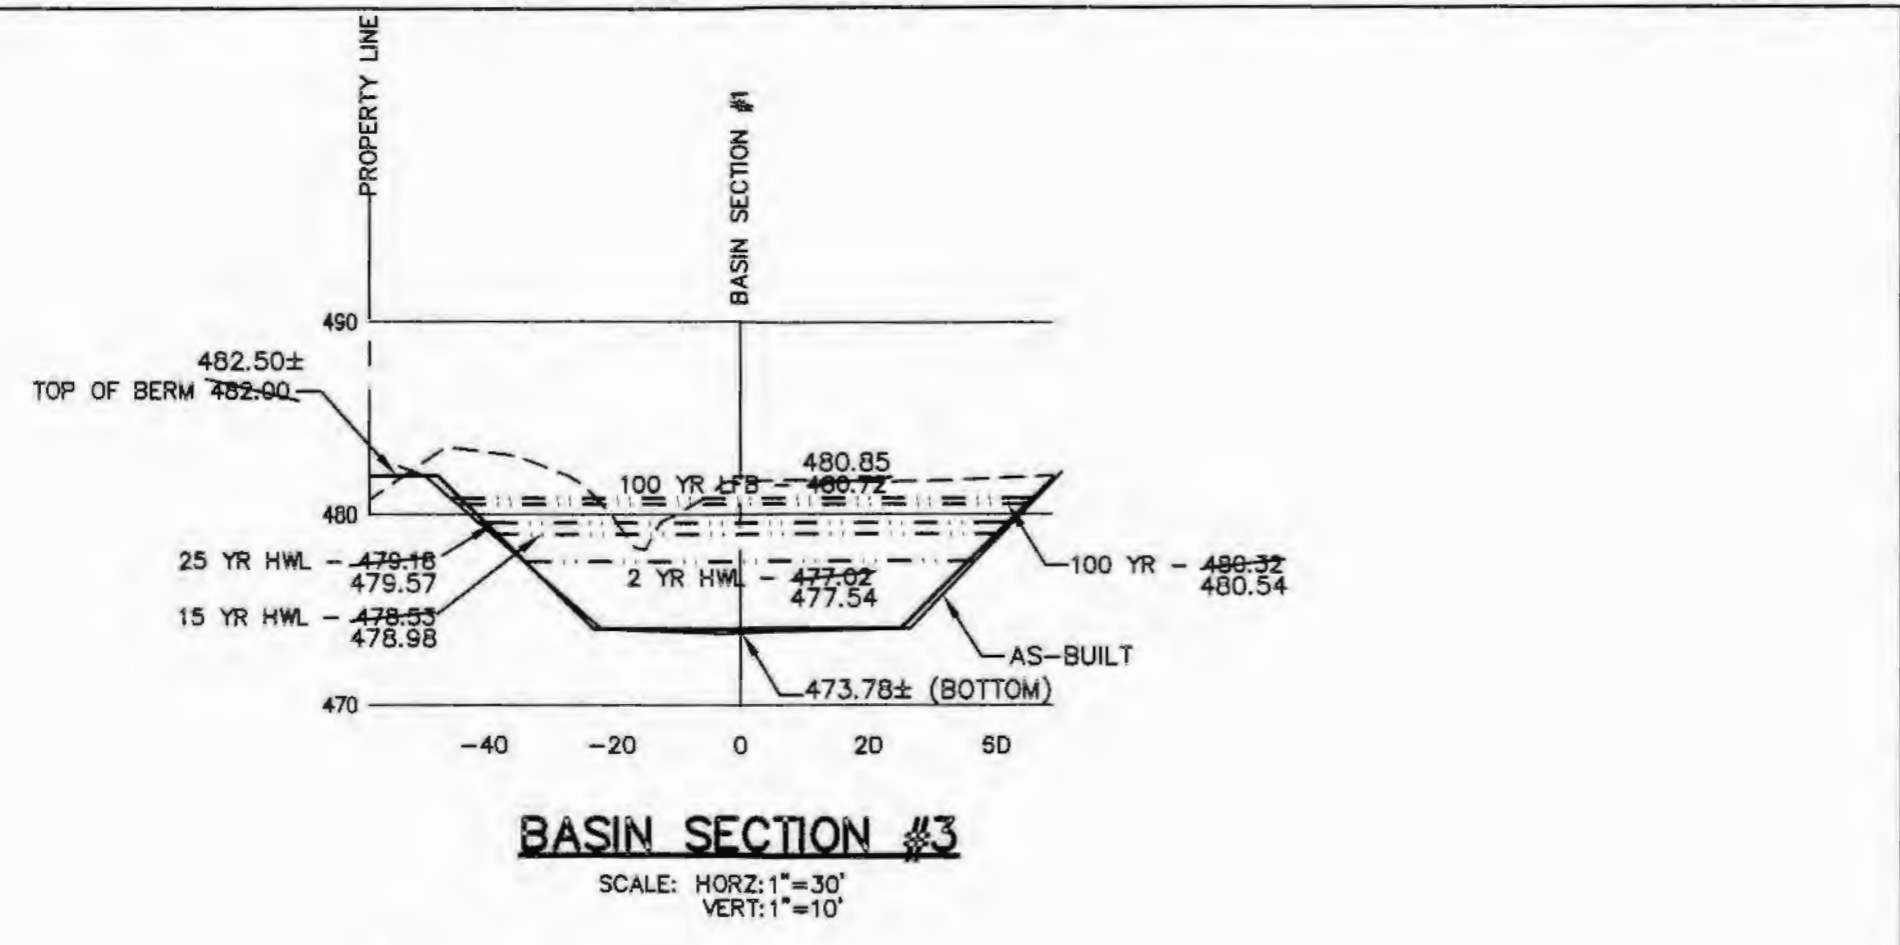

DETENTION STRUCTURE DETAILS

NOTE: ENGINEER APPROVED SHOP DRAWINGS MUST BE SUBMITTED TO THE CITY OF O'FALLON FOR REVIEW AND APPROVAL PRIOR TO THE CONSTRUCTION OF THE STRUCTURE

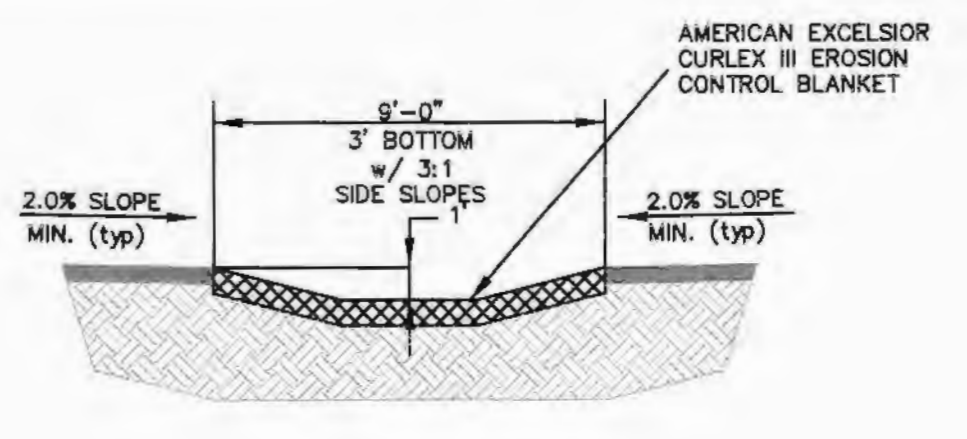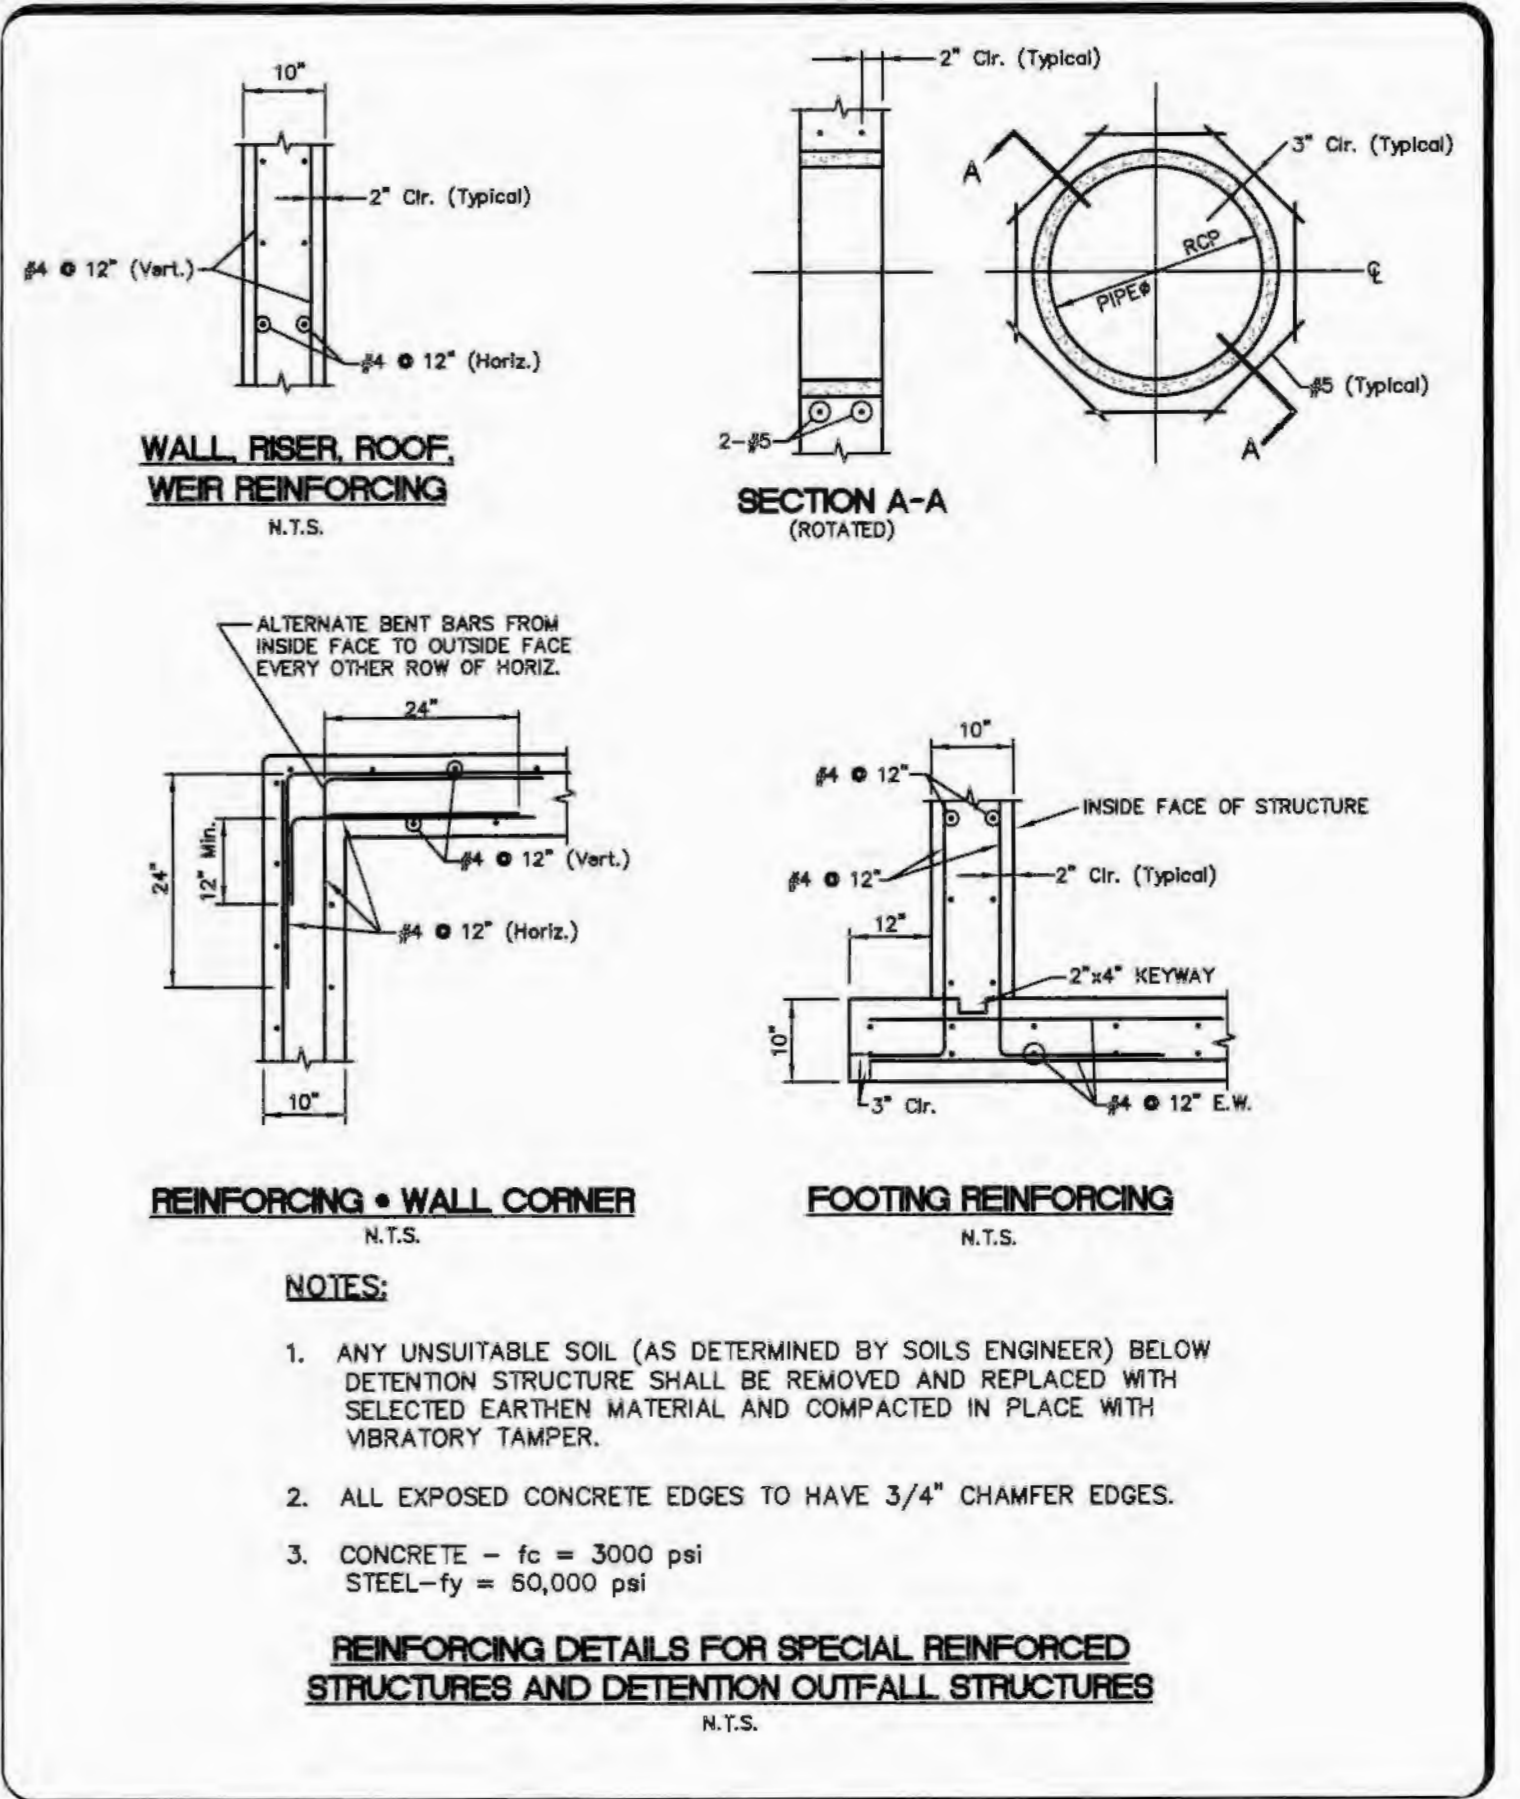

Stream Channel:

Project #: 210-4626
 Name: Crossings
 Calculated: PRG 12-17-10
 Checked:
 Station #: Detention Swale

Roughness Coefficient (n)	
Concrete	0.012
Asphalt smooth	0.013
Asphalt rough	0.016
Gravel beds, straight	0.025
Gravel beds plus large boulders	0.040
Earth swales w/ grass	0.050
Earth, straight w/ grass	0.025

Manning Equation: $Q = (1.49/n)A^{2/3}S^{1/2}$

FIND DEPTH OF WATER AND WIDTH OF THE CHANNEL:

INPUT:

Top of bank Elevation =	2.00
Stream Slope =	0.015 (ft/ft)
W (Bottom width) =	3 (ft)

OUTPUT:

Depth =	0.94 (ft)
Velocity =	5.07 (ft/sec)
Water Surface Elev. =	1.94
Free Board =	0.06 (ft)

Top of bank Elevation =	2.00
Bot. Elevation =	1.00
Horizontal (H) =	3
Vertical (V) =	1

Water Surface Width =	8.62 (ft)
Perimeter =	8.92 (ft)
Free Board =	0.06 (ft)
Cross section Area =	5.44 (ft ²)

2YR 20MIN SWALE CALCULATIONS

WATER QUALITY 02/17/11
 CITY APPROVAL 02/01/11
 CITY COMMENTS 01/26/11
 CITY COMMENTS 01/13/11


AS-BUILT

SANITARY / STORM SEWER - WATER QUALITY FEATURE - WATER LINE

The existing sewer lengths, sizes, flowlines, depths of structures and sewers locations with respect to existing or proposed easements have been measured. Water Quality Features, Retention Basins and drainage swales have been measured. Fire hydrants and valves have been measured. The results of those measurements are shown on this set of Final Measurement plans. Since the sanitary wye locations have been plotted from information provided by the sewer contractor or other sources, I disclaim any responsibility for that specific information.

All public sewers are located within designated existing or proposed easements.

Randall S. Rosson 3-9-16
 Randall S. Rosson, P.L.S. NO. 2006-000171

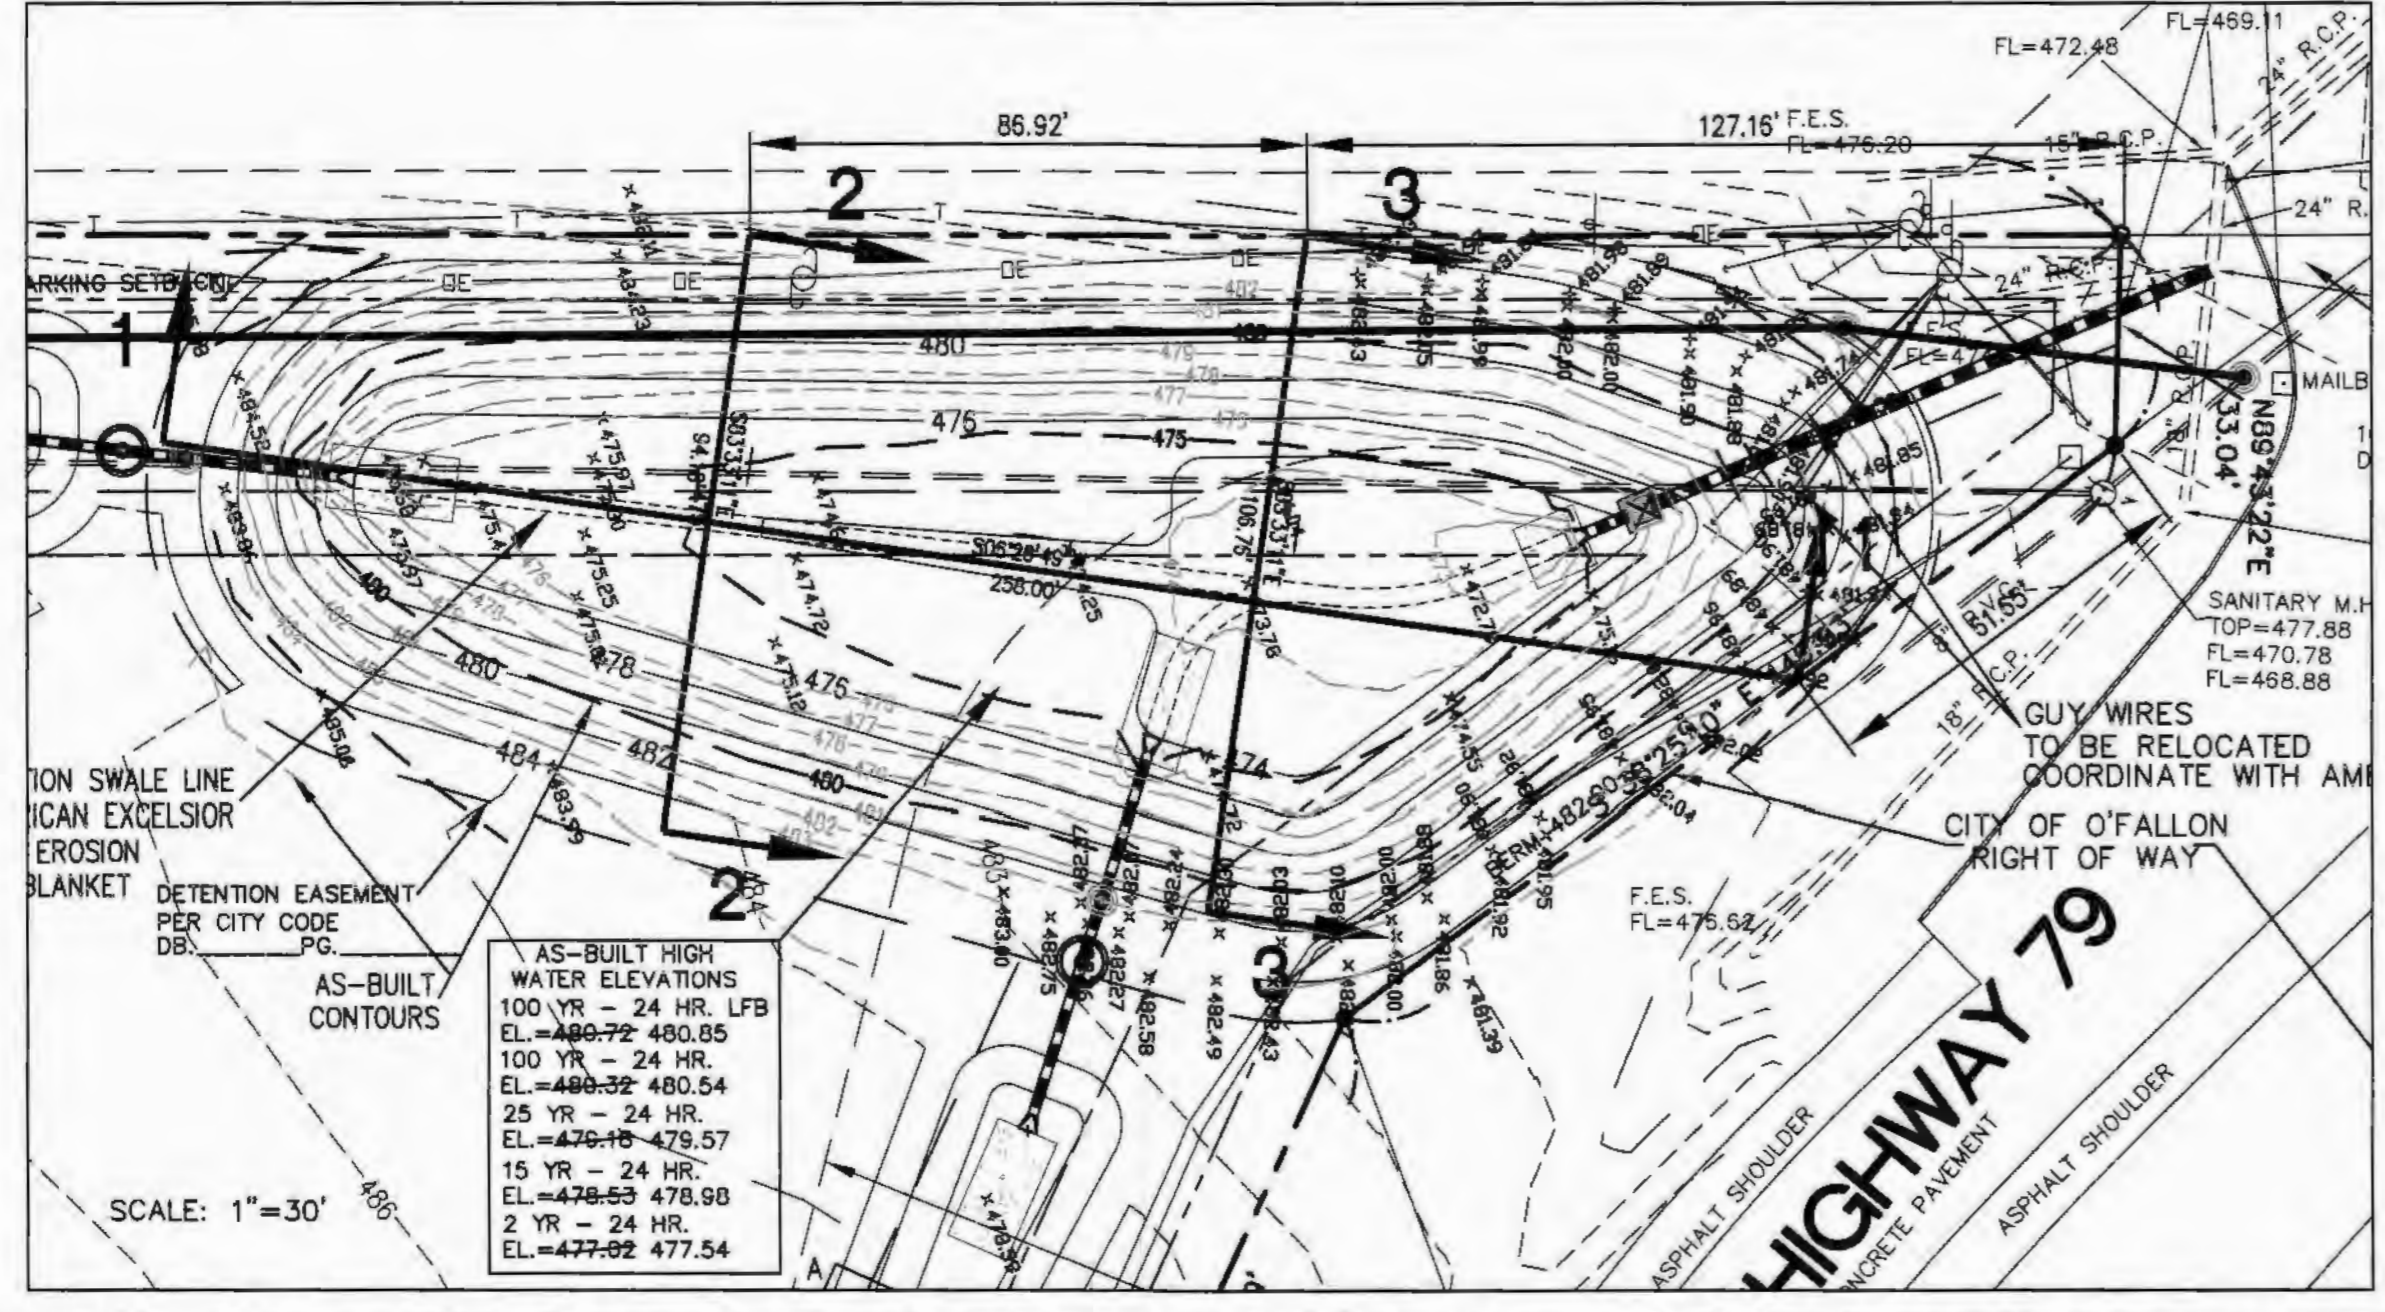

02/17/11

THE CROSSING AT RIVERSIDE CENTRE

DETENTION DETAILS

STOCK & ASSOCIATES

Consulting Engineers, Inc.

257 Chesterfield Business Parkway
 St. Louis, MO 63005
 PH. (636) 530-9100
 FAX (636) 530-9130
 e-mail: general@stockassoc.com
 Web: www.stockassoc.com

DRAWN BY:	DATE:	CHECKED BY:	DATE:	JOB NUMBER:	SHEET:
P.R.G.	12/21/10	G.M.S.	12/21/10	210-4626	C16

GEORGE M. STOCK E-25115
 CIVIL ENGINEER
 CERTIFICATE OF AUTHORITY
 NUMBER: 000596

C:\DRAWING\2104626\SURVEY\CITY\AS-BUILT\626-Base2-basinberm.dwg Mar 05, 2016 11:22am

PLAN VIEW
CDS 21

SECTION B-B

SECTION A-A

MATERIALS LIST - PROVIDED BY CONTECH

COUNT	DESCRIPTION	INSTALLED BY
1	FIBERGLASS INLET & CYLINDER	CONTECH
1	2400 MICRON SEP. SCREEN	CONTECH
1	SEALANT FOR JOINTS	CONTRACTOR
1	GRADE RINGS/RISERS	CONTRACTOR
1	824" FRAME AND COVER	CONTRACTOR
2	812"x4" CLEAN OUT COVER	CONTRACTOR

SITE DESIGN DATA

WATER QUALITY FLOW RATE	3.78 CFS
PEAK FLOW RATE	15.04 CFS
RETURN PERIOD OF PEAK FLOW	25 YRS

GENERAL NOTES

- CONTECH TO PROVIDE ALL MATERIALS UNLESS NOTED OTHERWISE.
- DIMENSIONS MARKED WITH () ARE REFERENCE DIMENSIONS. ACTUAL DIMENSIONS MAY VARY.
- FOR SITE SPECIFIC DRAWINGS WITH DETAILED DIMENSIONS AND WEIGHTS, PLEASE CONTACT YOUR CONTECH CONSTRUCTION PRODUCTS REPRESENTATIVE. www.contech-us.com
- CDS WATER QUALITY STRUCTURE SHALL BE IN ACCORDANCE WITH ALL DESIGN DATA AND INFORMATION CONTAINED IN THIS DRAWING.
- STRUCTURE SHALL MEET AASHTO H20 AND CASTINGS SHALL MEET AASHTO M206 LOAD RATING, ASSUMING GROUNDWATER ELEVATION AT, OR BELOW, THE OUTLET PIPE INVERT ELEVATION. ENGINEER OF RECORD TO CONFIRM ACTUAL GROUNDWATER ELEVATION.
- PVC HYDRAULIC SHEAR PLATE IS PLACED ON SHELF AT BOTTOM OF SCREEN CYLINDER. REMOVE AND REPLACE AS NECESSARY DURING MAINTENANCE CLEANING.

INSTALLATION NOTES

- ANY SUB-BASE BACKFILL DEPTH, AND/OR ANTI-FLOTATION PROVISIONS ARE SITE-SPECIFIC DESIGN CONSIDERATIONS AND SHALL BE SPECIFIED BY ENGINEER OF RECORD.
- CONTRACTOR TO PROVIDE EQUIPMENT WITH SUFFICIENT LIFTING AND REACH CAPACITY TO LIFT AND SET THE CDS MANHOLE STRUCTURE (LIFTING CLUTCHES PROVIDED).
- CONTRACTOR TO ADD JOINT SEALANT BETWEEN ALL STRUCTURE SECTIONS, AND ASSEMBLE STRUCTURE.
- CONTRACTOR TO PROVIDE, INSTALL, AND GROUT PIPES. MATCH PIPE INVERTS WITH ELEVATIONS SHOWN.
- CONTRACTOR TO TAKE APPROPRIATE MEASURES TO ASSURE UNIT IS WATER TIGHT, HOLDING WATER TO FLOWLINE INVERT MINIMUM. IT IS SUGGESTED THAT ALL JOINTS BELOW PIPE INVERTS ARE GROUTED.

STRUCTURE WEIGHT
APPROXIMATE HEAVIEST PICK = 14,500 LBS.

CONTECH PROPOSAL DRAWING

Table 4: Drainage to CDS Hydrodynamic Separator Area 1

STEP 1: Compute Rv(Volumetric Runoff Coefficient)

Drainage Area(A): 2.56 A(Acres - to BMP)
%Impervious: 86.0 I(%)
Rv(Volumetric Runoff Coefficient): 0.82 Rv= .05+ .009*I

STEP 2: Compute Curve Number(CN)
Rainfall Depth(P): 1.14 P(Inches)* *Rainfall Depth = 1.14" for WQ Storm
Compute Runoff Volume(Qa): 0.94 Qa=P*Ar
Compute CN: 98.1 CN=1000/((10+5P+10Qa-10I)(Qa^2 + 1.25QaP)^.5)

STEP 3: Compute Peak Runoff Rate for Water Quality(WQ) Storm
Time of Concentration(tc): 6 Minutes (Assumed)
(tc): 0.10 Hours
Compute Initial Abstraction(Ia): 0.038 Ia=(200/CN)-2
Compute Ia/P Ratio: 0.03344 Ia/P
Unit Peak Factor(qu): 1000 From Figure D.11.2
Drainage Area(Am): 0.0040 sq. mi. (Am=A/640)
Post-Developed Peak Discharge for Water Quality(WQ) Storm (Qp): 3.76 cfs Qp=qu*Am*Qa

STEP 4: Water Quality Volume (WQV)
Drainage Area(A): 2.56 A(Acres - to BMP)
%Impervious: 86.0 I(%)
(WQV): 8.729 Cu. FT [WQV=[1.14*(.05+.009)*A/12]*43560]

Wq Flow Rate Capacity Required: 3.76 c.f.s.
Wq Flow Rate Capacity Provided: 3.80 c.f.s.
BMP Selected: CDS-3035

PLAN VIEW
CDS 17

SECTION B-B

SECTION A-A

MATERIALS LIST - PROVIDED BY CONTECH

COUNT	DESCRIPTION	INSTALLED BY
1	FIBERGLASS INLET & CYLINDER	CONTECH
1	2400 MICRON SEP. SCREEN	CONTECH
1	SEALANT FOR JOINTS	CONTRACTOR
1	GRADE RINGS/RISERS	CONTRACTOR
1	824" FRAME AND COVER	CONTRACTOR
2	812"x4" CLEAN OUT COVER	CONTRACTOR

SITE DESIGN DATA

WATER QUALITY FLOW RATE	2.31 CFS
PEAK FLOW RATE	25.08 CFS
RETURN PERIOD OF PEAK FLOW	25 YRS

GENERAL NOTES

- CONTECH TO PROVIDE ALL MATERIALS UNLESS NOTED OTHERWISE.
- DIMENSIONS MARKED WITH () ARE REFERENCE DIMENSIONS. ACTUAL DIMENSIONS MAY VARY.
- FOR SITE SPECIFIC DRAWINGS WITH DETAILED DIMENSIONS AND WEIGHTS, PLEASE CONTACT YOUR CONTECH CONSTRUCTION PRODUCTS REPRESENTATIVE. www.contech-us.com
- CDS WATER QUALITY STRUCTURE SHALL BE IN ACCORDANCE WITH ALL DESIGN DATA AND INFORMATION CONTAINED IN THIS DRAWING.
- STRUCTURE SHALL MEET AASHTO H20 AND CASTINGS SHALL MEET AASHTO M206 LOAD RATING, ASSUMING GROUNDWATER ELEVATION AT, OR BELOW, THE OUTLET PIPE INVERT ELEVATION. ENGINEER OF RECORD TO CONFIRM ACTUAL GROUNDWATER ELEVATION.
- PVC HYDRAULIC SHEAR PLATE IS PLACED ON SHELF AT BOTTOM OF SCREEN CYLINDER. REMOVE AND REPLACE AS NECESSARY DURING MAINTENANCE CLEANING.

INSTALLATION NOTES

- ANY SUB-BASE BACKFILL DEPTH, AND/OR ANTI-FLOTATION PROVISIONS ARE SITE-SPECIFIC DESIGN CONSIDERATIONS AND SHALL BE SPECIFIED BY ENGINEER OF RECORD.
- CONTRACTOR TO PROVIDE EQUIPMENT WITH SUFFICIENT LIFTING AND REACH CAPACITY TO LIFT AND SET THE CDS MANHOLE STRUCTURE (LIFTING CLUTCHES PROVIDED).
- CONTRACTOR TO ADD JOINT SEALANT BETWEEN ALL STRUCTURE SECTIONS, AND ASSEMBLE STRUCTURE.
- CONTRACTOR TO PROVIDE, INSTALL, AND GROUT PIPES. MATCH PIPE INVERTS WITH ELEVATIONS SHOWN.
- CONTRACTOR TO TAKE APPROPRIATE MEASURES TO ASSURE UNIT IS WATER TIGHT, HOLDING WATER TO FLOWLINE INVERT MINIMUM. IT IS SUGGESTED THAT ALL JOINTS BELOW PIPE INVERTS ARE GROUTED.

STRUCTURE WEIGHT
APPROXIMATE HEAVIEST PICK = 14,500 LBS.

CONTECH PROPOSAL DRAWING

Table 5: Drainage to CDS Hydrodynamic Separator Area 2

STEP 1: Compute Rv(Volumetric Runoff Coefficient)

Drainage Area(A): 1.96 A(Acres - to BMP)
%Impervious: 67.8 I(%)
Rv(Volumetric Runoff Coefficient): 0.66 Rv= .05+ .009*I

STEP 2: Compute Curve Number(CN)
Rainfall Depth(P): 1.14 P(Inches)* *Rainfall Depth = 1.14" for WQ Storm
Compute Runoff Volume(Qa): 0.75 Qa=P*Ar
Compute CN: 95.9 CN=1000/((10+5P+10Qa-10I)(Qa^2 + 1.25QaP)^.5)

STEP 3: Compute Peak Runoff Rate for Water Quality(WQ) Storm
Time of Concentration(tc): 6 Minutes (Assumed)
(tc): 0.10 Hours
Compute Initial Abstraction(Ia): 0.085 Ia=(200/CN)-2
Compute Ia/P Ratio: 0.07434 Ia/P
Unit Peak Factor(qu): 1000 From Figure D.11.2
Drainage Area(Am): 0.0031 sq. mi. (Am=A/640)
Post-Developed Peak Discharge for Water Quality(WQ) Storm (Qp): 2.31 cfs Qp=qu*Am*Qa

STEP 4: Water Quality Volume (WQV)
Drainage Area(A): 1.96 A(Acres - to BMP)
%Impervious: 67.8 I(%)
(WQV): 5.357 Cu. FT [WQV=[1.14*(.05+.009)*A/12]*43560]

Wq Flow Rate Capacity Required: 2.31 c.f.s.
Wq Flow Rate Capacity Provided: 3.00 c.f.s.
BMP Selected: CDS-3025

ALTHOUGH WATER QUALITY STRUCTURES PROVIDE ENOUGH STORM WATER CLEANSING TO MEET THE REQUIREMENTS FOR THIS PHASE OF THE DEVELOPMENT ANY FUTURE DEVELOPMENT WILL REQUIRE THAT THE WATER QUALITY BE REEVALUATED

AS-BUILT

SANITARY / STORM SEWER - WATER QUALITY FEATURE - WATER LINE

The existing sewer lengths, sizes, flowlines, depths of structures and sewers locations with respect to existing or proposed easements have been measured. Water Quality Features, Retention Basins and drainage swales have been measured. Fire hydrants and valves have been measured. The results of those measurements are shown on this set of Final Measurement plans. Since the sanitary wye locations have been plotted from information provided by the sewer contractor or other sources, I disclaim any responsibility for that specific information.

All public sewers are located within designated existing or proposed easements.

DATE: 2/21/11
DRAWN: [Signature]
CHECKED: [Signature]
PROJECT NO: 430435-02
SHEET: 1 OF 1

DATE: 3-9-16
Rondall S. Rosson, P.L.S. NO. 2006-000171 Date

THE CROSSING AT RIVERSIDE CENTRE
WATER QUALITY DETAILS

Stock & Associates
Consulting Engineers, Inc.

257 Chesterfield Business Parkway
St. Louis, MO 63005
PH. (636) 530-9100
FAX (636) 530-9130
e-mail: general@stockassoc.com
Web: www.stockassoc.com

GEORGE M. STOCK E-25115
CIVIL ENGINEER
CERTIFICATE OF AUTHORITY
NUMBER: 000995

DRAWN BY: P.R.G. DATE: 12/21/10 CHECKED BY: G.M.S. DATE: 12/21/10 DATE: 12/21/10 SHEET: C18