



PAGE AVE. EXTENSION

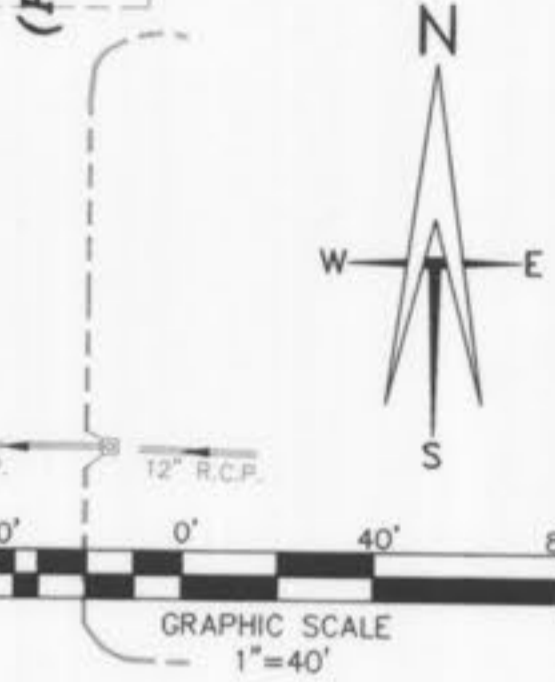

11/30/09 ADDRESSED CITY COMMENTS
12/22/09 ADDRESSED CITY COMMENTS

DELMAR GARDENS
SKILLED NURSING
CARE
AS-BUILTS

ST. CHARLES ENGINEERING & SURVEYING, INC.
801 S. FIFTH STREET, SUITE 202
ST. CHARLES, MO 63301
TEL: (636) 947-0607 FAX: (636) 947-9448

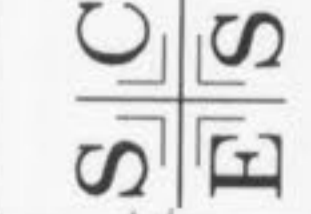

12/22/09
ORDER NO. 08-0198-01
DATE 09/18/09
1

USGS BENCHMARK:
SC 05 RESET ELEV 525.92
STANDARD MISSOURI DNR GRS ALUMINUM DISK STAMPED
"SC 05 RESET 2000", SET IN A 12 INCH DIAMETER
CONCRETE MONUMENT. THE STATION IS LOCATED IN
COTTEVILLE MO ATHWART FROM COTTEVILLE FIRE STATION
AND NEAR ST. JOSEPH CATHOLIC CHURCH PARKING LOT ON
THE WEST RIGHT OF WAY OF MOTHERSHEAD ROAD.

SITE BENCHMARK: ELEV 564.32
PK NAIL IN SIDEWALK AT SOUTHWEST CORNER OF PAGE
AND TWIN CHIMNEYS BLVD.