


PLAN	SURVEYED	DATE
	ALIGNED	BY
	NOTE BOOK	
	NO.	

PROFILE	SURVEYED	DATE
	GRADES CHECKED	BY
	NOTE BOOK	
	NO.	


AS-BUILTS
DOMINO'S PIZZA

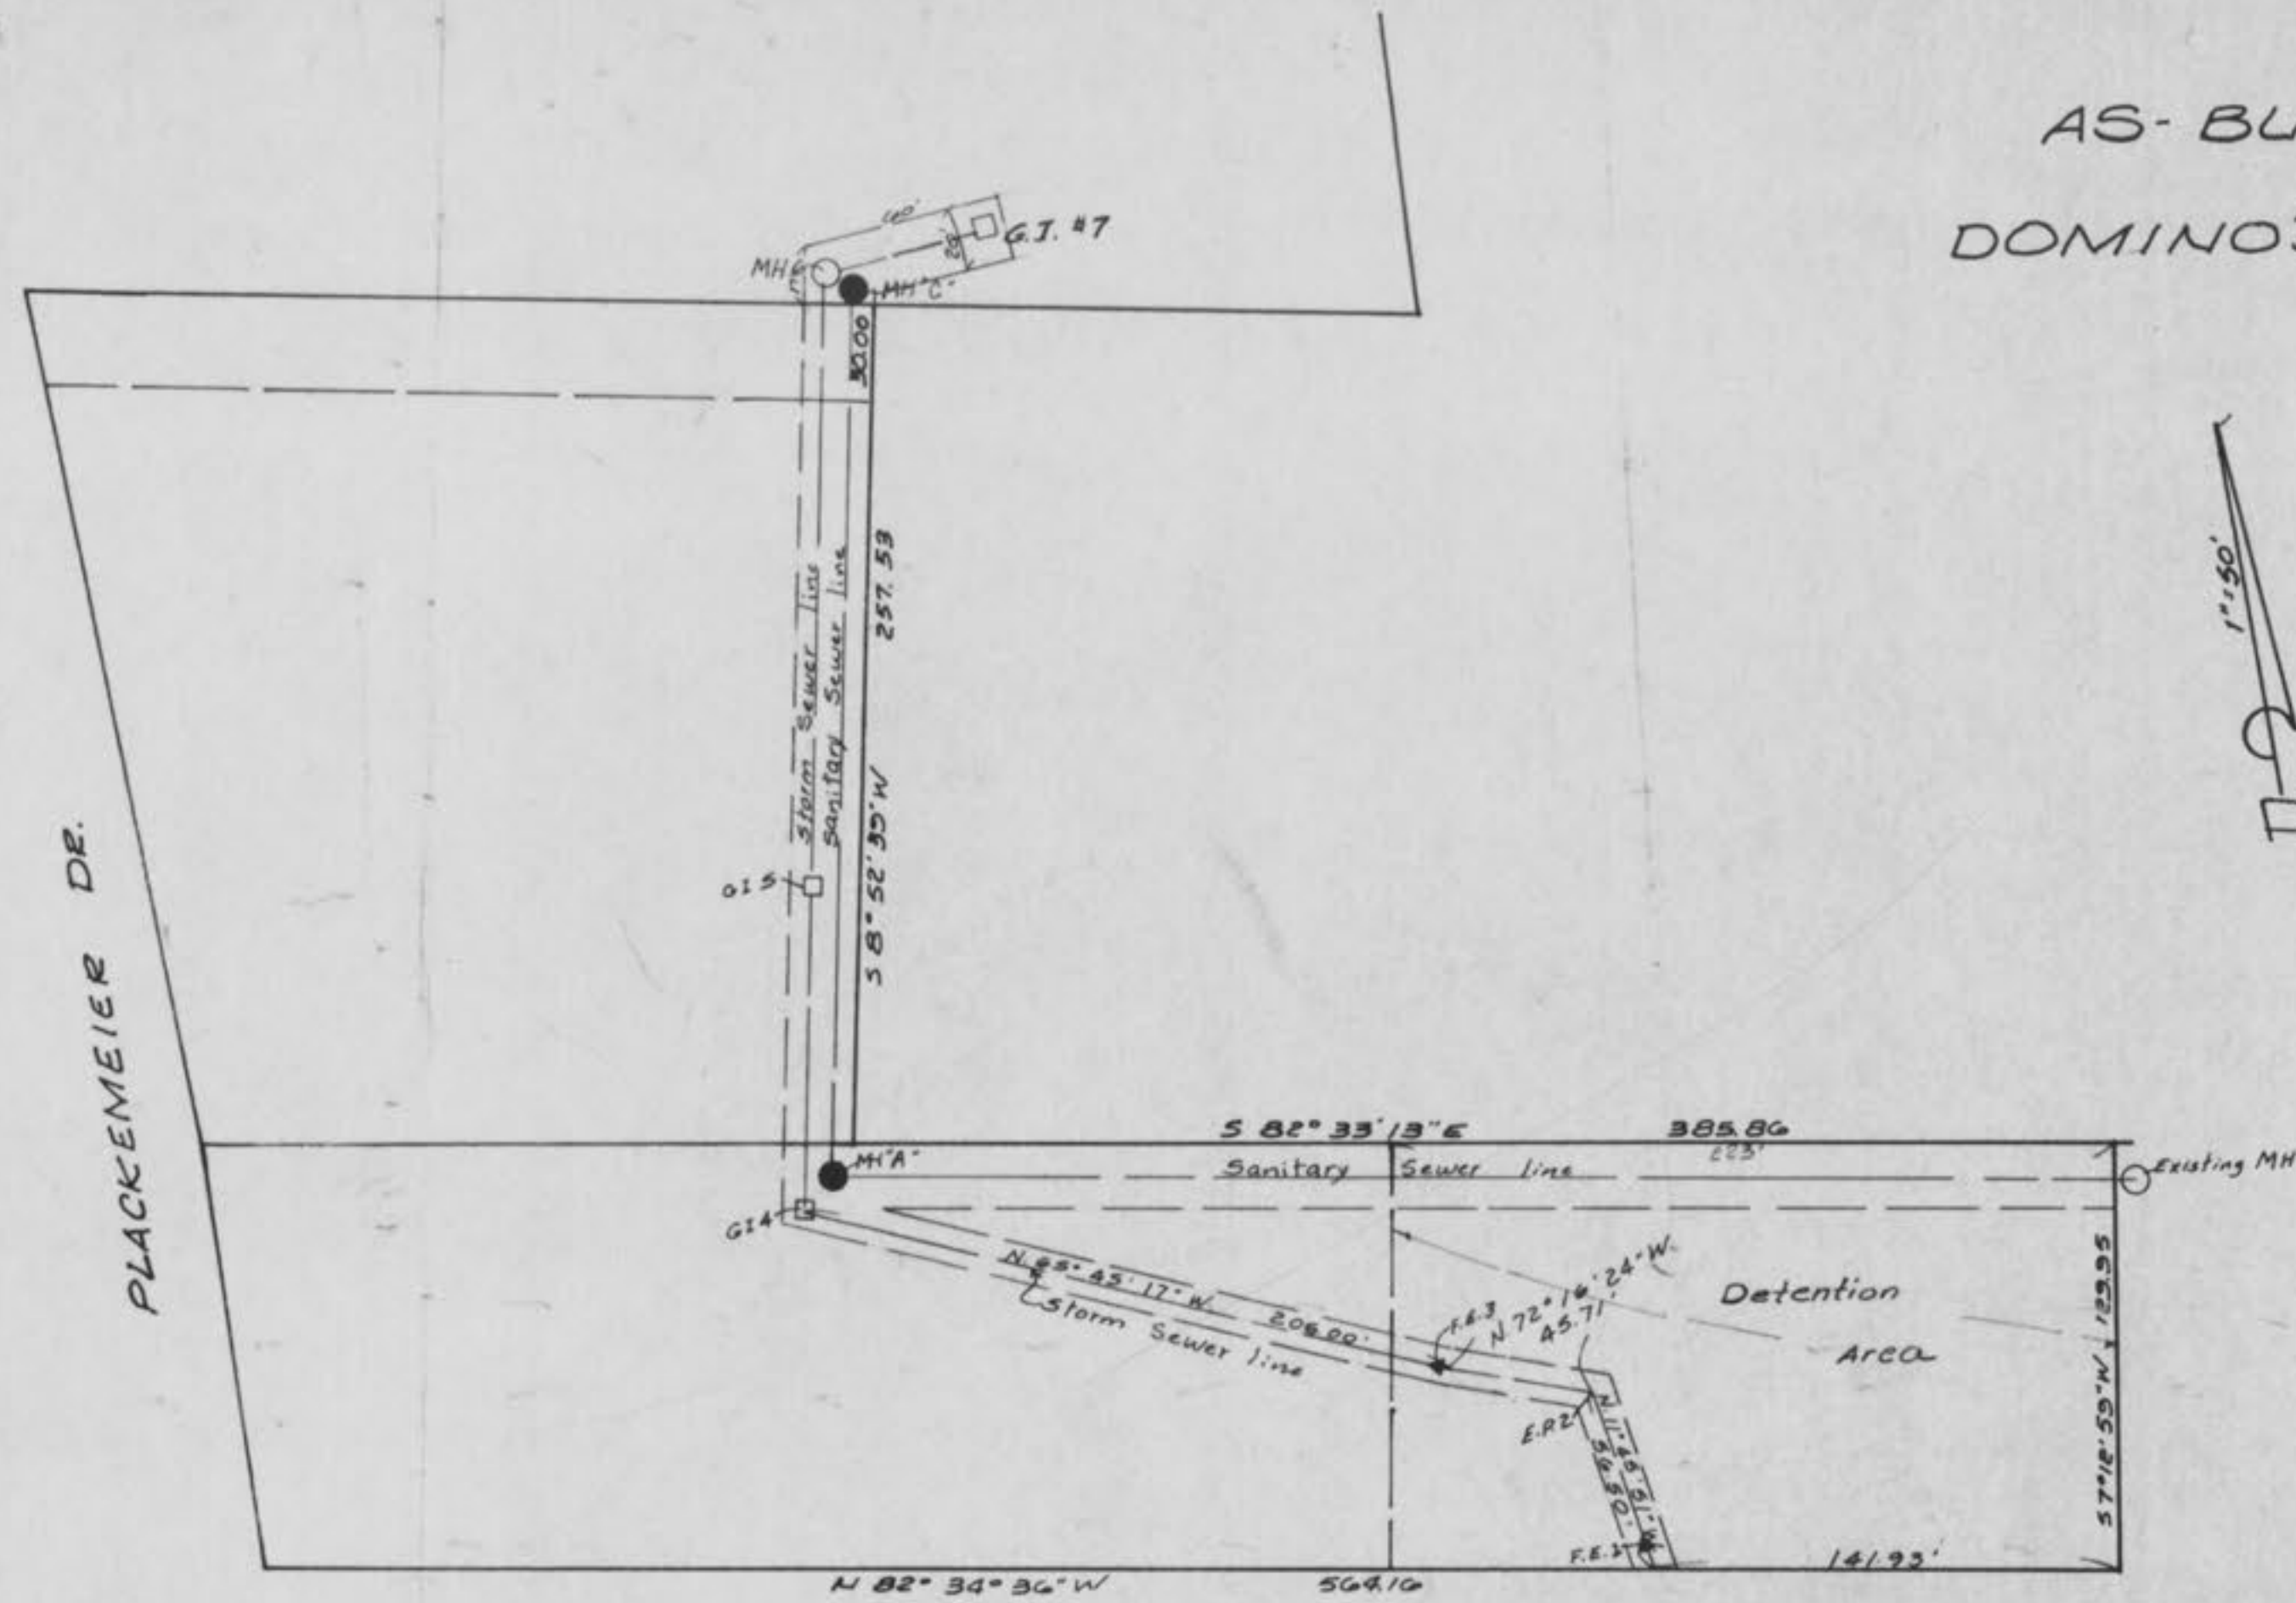

LANDMARK SURVEYING, INC.
802 E. MAIN
Wentzville, Missouri 63386

AS-BUILTS

DATE 10-26-05

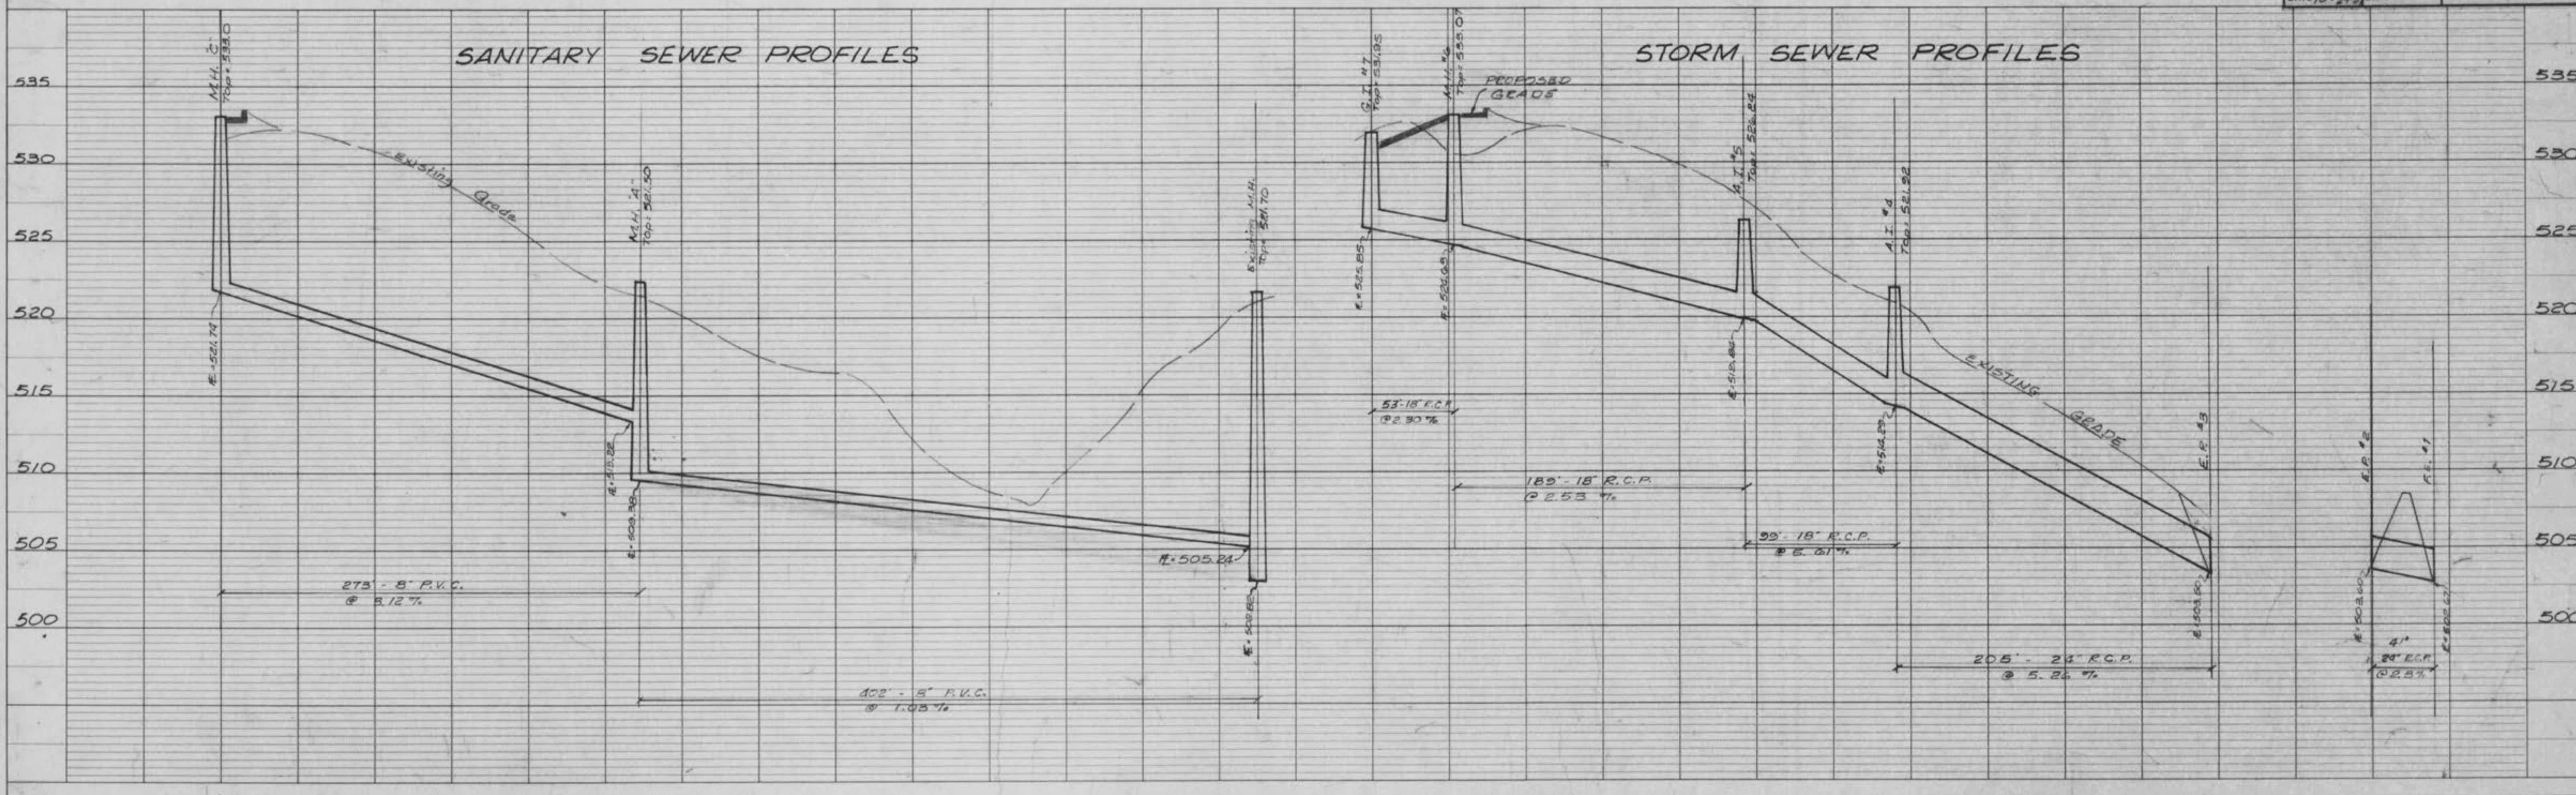

HIGHWAY FEDERAL AID SHEET
PLATE 1-SINGLE PLAN AND PROFILE-LINE & DOT
WILSON
PRINTED IN U.S.A.