

COMMERCIAL

GENERAL NOTES

- GN # 1 Driveway locations shall not interfere with the sidewalk, handicap ramps, or curb inlet curbs.
GN # 2 Sidewalks, curb ramps, ramps and accessible parking spaces shall be constructed in accordance with the current approved "American with Disabilities Act Accessibility Guidelines" (ADAAG) along with the required grades, construction materials, specifications and signage.
GN # 3 Truncated domes for curb ramps located in public right of way shall meet ADA requirements and shall be constructed using red pre cast truncated domes per pavement details.
GN # 4 Any proposed pavilions or playground areas will need a separate permit from the Building Division.
GN # 5 The Contractor is responsible to call Missouri One Call and The City of O'Fallon for the location of utilities.
GN # 6 All proposed utilities and/or utility relocations shall be located underground.
GN # 7 All proposed fencing requires a separate permit through the Planning and Development Division.
GN # 8 All construction operations and work zone traffic control within the right of way will follow MoDOT or M.U.T.C.D. standards whichever is more stringent.
GN # 9 All free standing signs shall be located a minimum of ten (10) feet away from any right of way line and/or property line and a minimum of three (3) feet from the back of curbing or sidewalk.
GN # 10 All subdivision identification or directional sign(s) must have the locations and sizes approved and permitted separately through the Planning and Development Division.
GN # 11 Materials such as trees, organic debris, rubble, foundations, and other deleterious material shall be removed from the site and disposed of in compliance with all applicable laws and regulations.
GN # 12 Twenty-four (24) hours prior to starting any of the work covered by the above plans and after approval thereof, the developer shall make arrangements with the Construction Inspection Office to provide for inspection of the work, sufficient in the opinion of the City Engineer.
GN # 13 The City Engineer or their duly authorized representative shall make all necessary inspections of City infrastructure, escrow items or infrastructure located on the approved plans.

Erosion Control Notes

- EN # 1 The Permittee shall assume complete responsibility for controlling all siltation and erosion of the project area.
EN # 2 All erosion control systems are to be inspected and corrected weekly, especially within 48 hours of any rain storm resulting in one-half inch of rain or more.
EN # 3 Erosion control devices (silt fence, sediment basin, etc.) shall be in accordance with St. Charles County Soil and Water Conservation District Erosion and Sediment Control guidelines.
EN # 4 This development is required to provide long term post construction BMP's such as: low impact design, source control and treatment controls that protects water quality and controls run off to maximum extent practical in compliance with Phase II Illicit Storm Water Discharge Guidelines.
EN # 5 Graded areas shall be seeded and mulched (strawed) within 14 days of stopping land disturbance activities.
EN # 6 This development is required to provide long term post construction BMP's such as: low impact design, source control and treatment controls that protects water quality and controls run off to maximum extent practical in compliance with Phase II Illicit Storm Water Discharge Guidelines.

Grading Notes

- GRN #1 Developer must supply City construction inspectors with soil reports prior to and during site grading.
1. Maximum dry density
2. Optimum moisture content
3. Maximum and minimum allowable moisture content
4. Curve must be plotted to show density from a minimum of 90% Compaction and above as determined by the "Modified AASHTO T-180 Compaction Test" (A.S.T.M.-D-1157) or from a minimum of 95% as determined by the "Standard Proctor Test ASSHTO T-99, Method C" (A.S.T.M.-D-698).
5. Curve must have at least 5 density points with moisture content and sample locations listed on document
6. Specific gravity
7. Natural moisture content
8. Liquid limit
9. Plastic limit
GRN #2 All fill placed in areas other than proposed storm sewers, sanitary sewers, proposed roads, and paved areas shall be compacted from the bottom of the fill up in 8" lifts and compacted to 90% maximum density as determined by Modified AASHTO T-180 compaction test or 95% of maximum density as determined by the Standard Proctor Test AASHTO T-99.
GRN # 3 The surface of the fill shall be finished so it will not impound water.
GRN # 4 All sediment and detention basins are to be constructed during the initial phase of the grading operation or in accordance with the approved SWPPP.
GRN # 5 When grading operations are complete or suspended for more than 14 days, permanent grass must be established at sufficient density to provide erosion control on site.
GRN # 6 No slopes shall exceed 3 (horizontal): 1 (vertical) unless otherwise approved by the soils report and specifically located on the plans and approved by the City Engineer.
GRN # 7 All low places whether on site or off shall be graded to provide drainage with temporary ditches.
GRN # 8 All existing wells on site shall be capped per DNR standards.

Grading Notes Continued

- GRN #10 All trench back fills under paved areas shall be granular back fill, and compacted mechanically.
a) Depth, Trench back fills less than 8 feet deep shall be probed to a depth extending half the depth of the trench back fill, but not less than 3 feet.
b) Equipment, The jetting probe shall be a metal pipe with an interior diameter of 1.5 to 2 inches.
c) Method, Jetting shall be performed from the lowest surface topographic point and proceed toward the highest point, and from the bottom of the trench back fill toward the surface.
d) Surface Bridging, The contractor shall identify the locations of the surface bridging (the tendency for the upper surface to crust and arch over the trench rather than collapse and consolidate during the jetting process).
GRN #11 Site grading.
a. Within City right-of-way. Material is to be placed in eight (8) inch to twelve (12) inch loose lifts and compacted per the approved compaction requirements.
b. Outside of City right-of-way. Material is to be placed in eight (8) inch to twelve (12) inch loose lifts and compacted per the approved compaction requirements.

Sanitary Sewer Notes

- SAN # 1 All sanitary sewer installation is to be in accordance with M.S.D. 2007 standards and specifications except as modified by the City of O'Fallon Ordinances.
SAN # 2 Brick shall not be used in the construction of sanitary sewer structures.
SAN # 3 Connections at all sanitary structures are to be made with A-Lock joint or equal
SAN # 4 All sanitary laterals shall be a minimum of 4" residential, 6" commercial diameter pipe.
SAN # 5 All sanitary mains shall be a minimum of 8" diameter pipe.
SAN # 6 All sanitary sewer lines with a slope greater than 20% will require concrete or concrete collar.
SAN # 7 All manholes built within the 100-year flood plain must have lock type watertight manhole covers.
SAN # 8 All sanitary sewer mains must have a minimum of 42" cover.
SAN # 9 When sanitary mains cross over storm lines the sanitary main must be ductile iron pipe for 10 feet on each side of the crossing.
SAN # 10 Eases with concrete both sanitary and storm sewer at crossing when storm sewer is within 18 inches above sanitary sewer.
SAN # 11 The sanitary sewers should run diagonally through the side yards to minimize any additional utility easements required.
SAN # 12 All sanitary sewer structures shall be waterproofed on the exterior in accordance to Missouri DNR specifications 10CSR-8.120 (7)(E).
SAN # 13 All sanitary sewer pipe shall be SDR35 or equal.
SAN # 14 All sanitary sewer manholes and pipes will be tested to the following specifications.
SAN # 15 Add 1" minus rock back fill to all sanitary sewer and all other utilities that lie within the 1:1 shear plane of the road.

Storm Sewer Notes

- STM # 1 All storm sewer installation is to be in accordance with M.S.D. 2007 standards and specifications except as modified by the City of O'Fallon ordinances.
STM # 2 Brick shall not be used in the construction of storm sewer structures.
STM # 3 A 5/8" trash bar shall be installed horizontally in the center of the opening(s) in all curb inlets and area inlets.
STM # 4 HDPE pipe is to be N-12WT or equal and to meet ASTM F1417 water tight field test.
STM # 5 Eases with concrete both sanitary and storm sewer at crossing when storm sewer is within 18 inches above sanitary sewer.
STM # 6 The storm sewers should run diagonally through the side yards to minimize any additional utility easements required.
STM # 7 All concrete pipes will be installed with O-ring rubber type gaskets.
STM # 8 Connections at all storm structures are to be made with A-lock joint or equal.
STM # 9 Pre-cast concrete inlet covers are not to be used.
STM # 10 The swale in the detention basins shall have a minimum 1% longitudinal slope and be lined with a permanent erosion control blanket that will allow infiltration of storm water.
STM # 11 All storm sewer shall be reinforced concrete pipe or HDPE pipe.
STM # 12 The discharge point of all lined and sections shall be protected by rip-rap or other approved means.
STM # 13 Rip-rap shall be placed and sections will be evaluated in the field by the Engineer, Contractor, and City Inspectors after installation for effectiveness and field modified, if necessary to reduce erosion on and off site.
STM # 14 Add 1" minus rock back fill to all storm sewer that lie within the 1:1 shear plane of the road.

Water Notes

- WN # 1 Fire hydrants shall be a maximum of 500' apart.
WN # 2 Coordinate with the water company on the location of water meters.
WN # 3 All water main must have a minimum of 42" of cover.
WN # 4 Provide water valves to isolate the system.
WN # 5 All water mains shall be class 200 SDR 21 or equal with locator/tracer wires
WN # 6 DISINFECTING:
Disinfecting shall be accomplished by placing sufficient hypo chlorite granule (HTH) in each section of pipe to achieve a chlorine residual in the pipeline, upon initial filling, of 50 mg/L (PPM).
WN # 7 PRESSURE TESTING:
Immediately following disinfection, the piping shall be pumped to a pressure (at the lowest point in the project) of 150 psi or higher where the working pressure is higher than 150 PSI as determined by the City.
WN # 8 All tops for valves, meters, and manholes are to be constructed to within 1 inch (0.08") of finish grade.


Water Notes

- WN #10 BACTERIOLOGICAL TESTING:
After satisfactory disinfection and pressure testing, a sample shall be taken by the contractor in the presence of a City representative and submitted to a laboratory approved by the Missouri Department of Natural Resources and the City for bacteriological analysis.
After 24 hours, a second sample shall be taken in a like manner and submitted for analysis.
The two samples taken on consecutive days, a minimum of 24 hours apart, must be found to be "safe" by the testing laboratory, and copies of the test results must be supplied to the City.

Roadway Notes

- RN # 1 All paving (public and private) to be in accordance with 2006 St. Charles County Standards and Specifications except as modified by the City of O'Fallon ordinances.
RN # 2 If the intersecting road does not have a curb, then the curb on the new entrance shall begin 10' from the edge of the existing road.
RN # 3 Provide 6" of concrete over 4" of MoDot type 1 or type 5 aggregate rock or asphalt equivalent for minor residential streets per City Code 406.370.
RN # 4 Multi-use trail (when required) shall have a minimum of 3" Type "C" Asphalt over 4" aggregate base per City requirements.
RN # 5 Type C (BP-1) Compaction requirements shall be 98% minimum density according to St. Charles Co. Standard Specifications.
RN # 6 Provide pavement striping at any point where the multi-use trail crosses existing or proposed pavement.
RN # 7 All street stub outs over 250' in length will require a temporary turnaround.
RN # 8 All sub grade in cut or fill will need to conform to the City of O'Fallon Compaction requirements
RN # 9 Material Testing And Frequency. Materials for construction shall be tested and inspected per the appropriate ASTM code or at the City Engineer's discretion.
1. Concrete.
a. Cylinders/compressive strength.
b. Percent air and temperature.
c. Slumps.
d. If concrete is batched from more than one (1) plant, then the aforementioned guidelines will be applicable to each plant.
2. Sub grade and base.
a. Proof roll as described in Section 405.210(B).
b. One (1) compaction test per two hundred fifty (250) feet of mainline paving, three (3) tests per intersection, five (5) tests within cul-de-sacs and one (1) test per repair slab.
c. Gradation test for sub base material.
3. Asphalt.
a. One (1) set of compaction tests per two hundred fifty (250) feet of mainline.
b. One (1) bulk density test per paving operation.
RN # 10 Approval Of Sub grade And Base (Sub base).
RN # 11 In all fill areas in the roadways, soil tests shall be submitted and approved by the City Engineer for each foot of fill and at least one (1) test and an average of one (1) test within every two hundred fifty (250) feet.
RN # 12 No traffic will be allowed on new concrete pavement until it has cured for seven (7) days and it reaches three thousand five hundred (3,500) psi within 28 days.
RN # 13 Prior to placement of aggregate base material on sub grade and prior to placement of pavement on base material, the sub grade and base must be proof-rolled with a fully loaded (ten (10) ton load) tandem truck or equivalent tire vehicle with one (1) pass down each driving lane no faster than three (3) miles per hour.

PROJECT TITLE: EL TIO PEPE MEXICAN RESTAURANT
315 WEST TERRA LANE
O'FALLON, ST. CHARLES, MISSOURI 63366
Issue Date: 04/12/2017

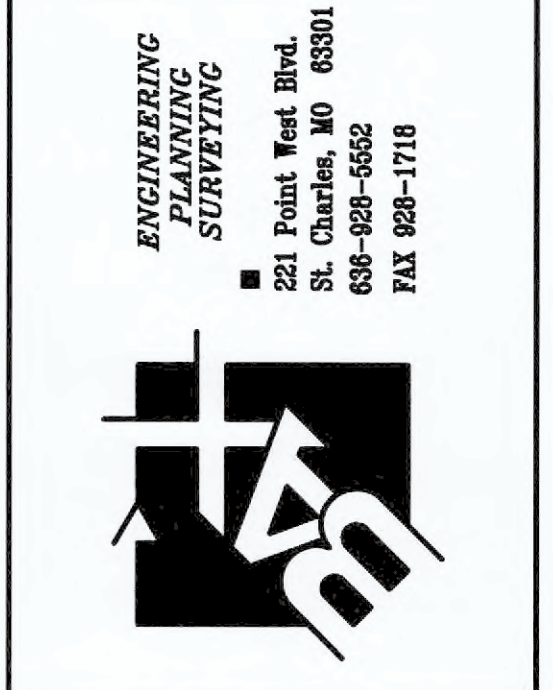

DISCLAIMER OF RESPONSIBILITY: I hereby specify that the documents intended to be authorized by my seal are limited to this sheet, and I hereby disclaim any responsibility for all other Drawings, Specifications, Estimates, Reports or other documents or instruments relating to or intended to be used for any part or parts of the architecture or engineering project or survey.

REFERENCE DRAWING



Table with 2 columns: DATE, CITY COMMENTS. Includes entries for 09/19/17, 10/04/17, and 08/08/17.

Developer / Owner: WR HOLMAN, LLC
2 HICKORY HILL DRIVE
O'FALLON, MISSOURI 63366
(636) 734-1815


COMMERCIAL NOTES

P+Z No. 33-14.01
CUP No. 33-14.01.01
Page No. 2 of 18

FILE: P:\2017\17-001\17-001.dwg DATE: 04/12/2017 10:58:10 AM USER: JHARRIS

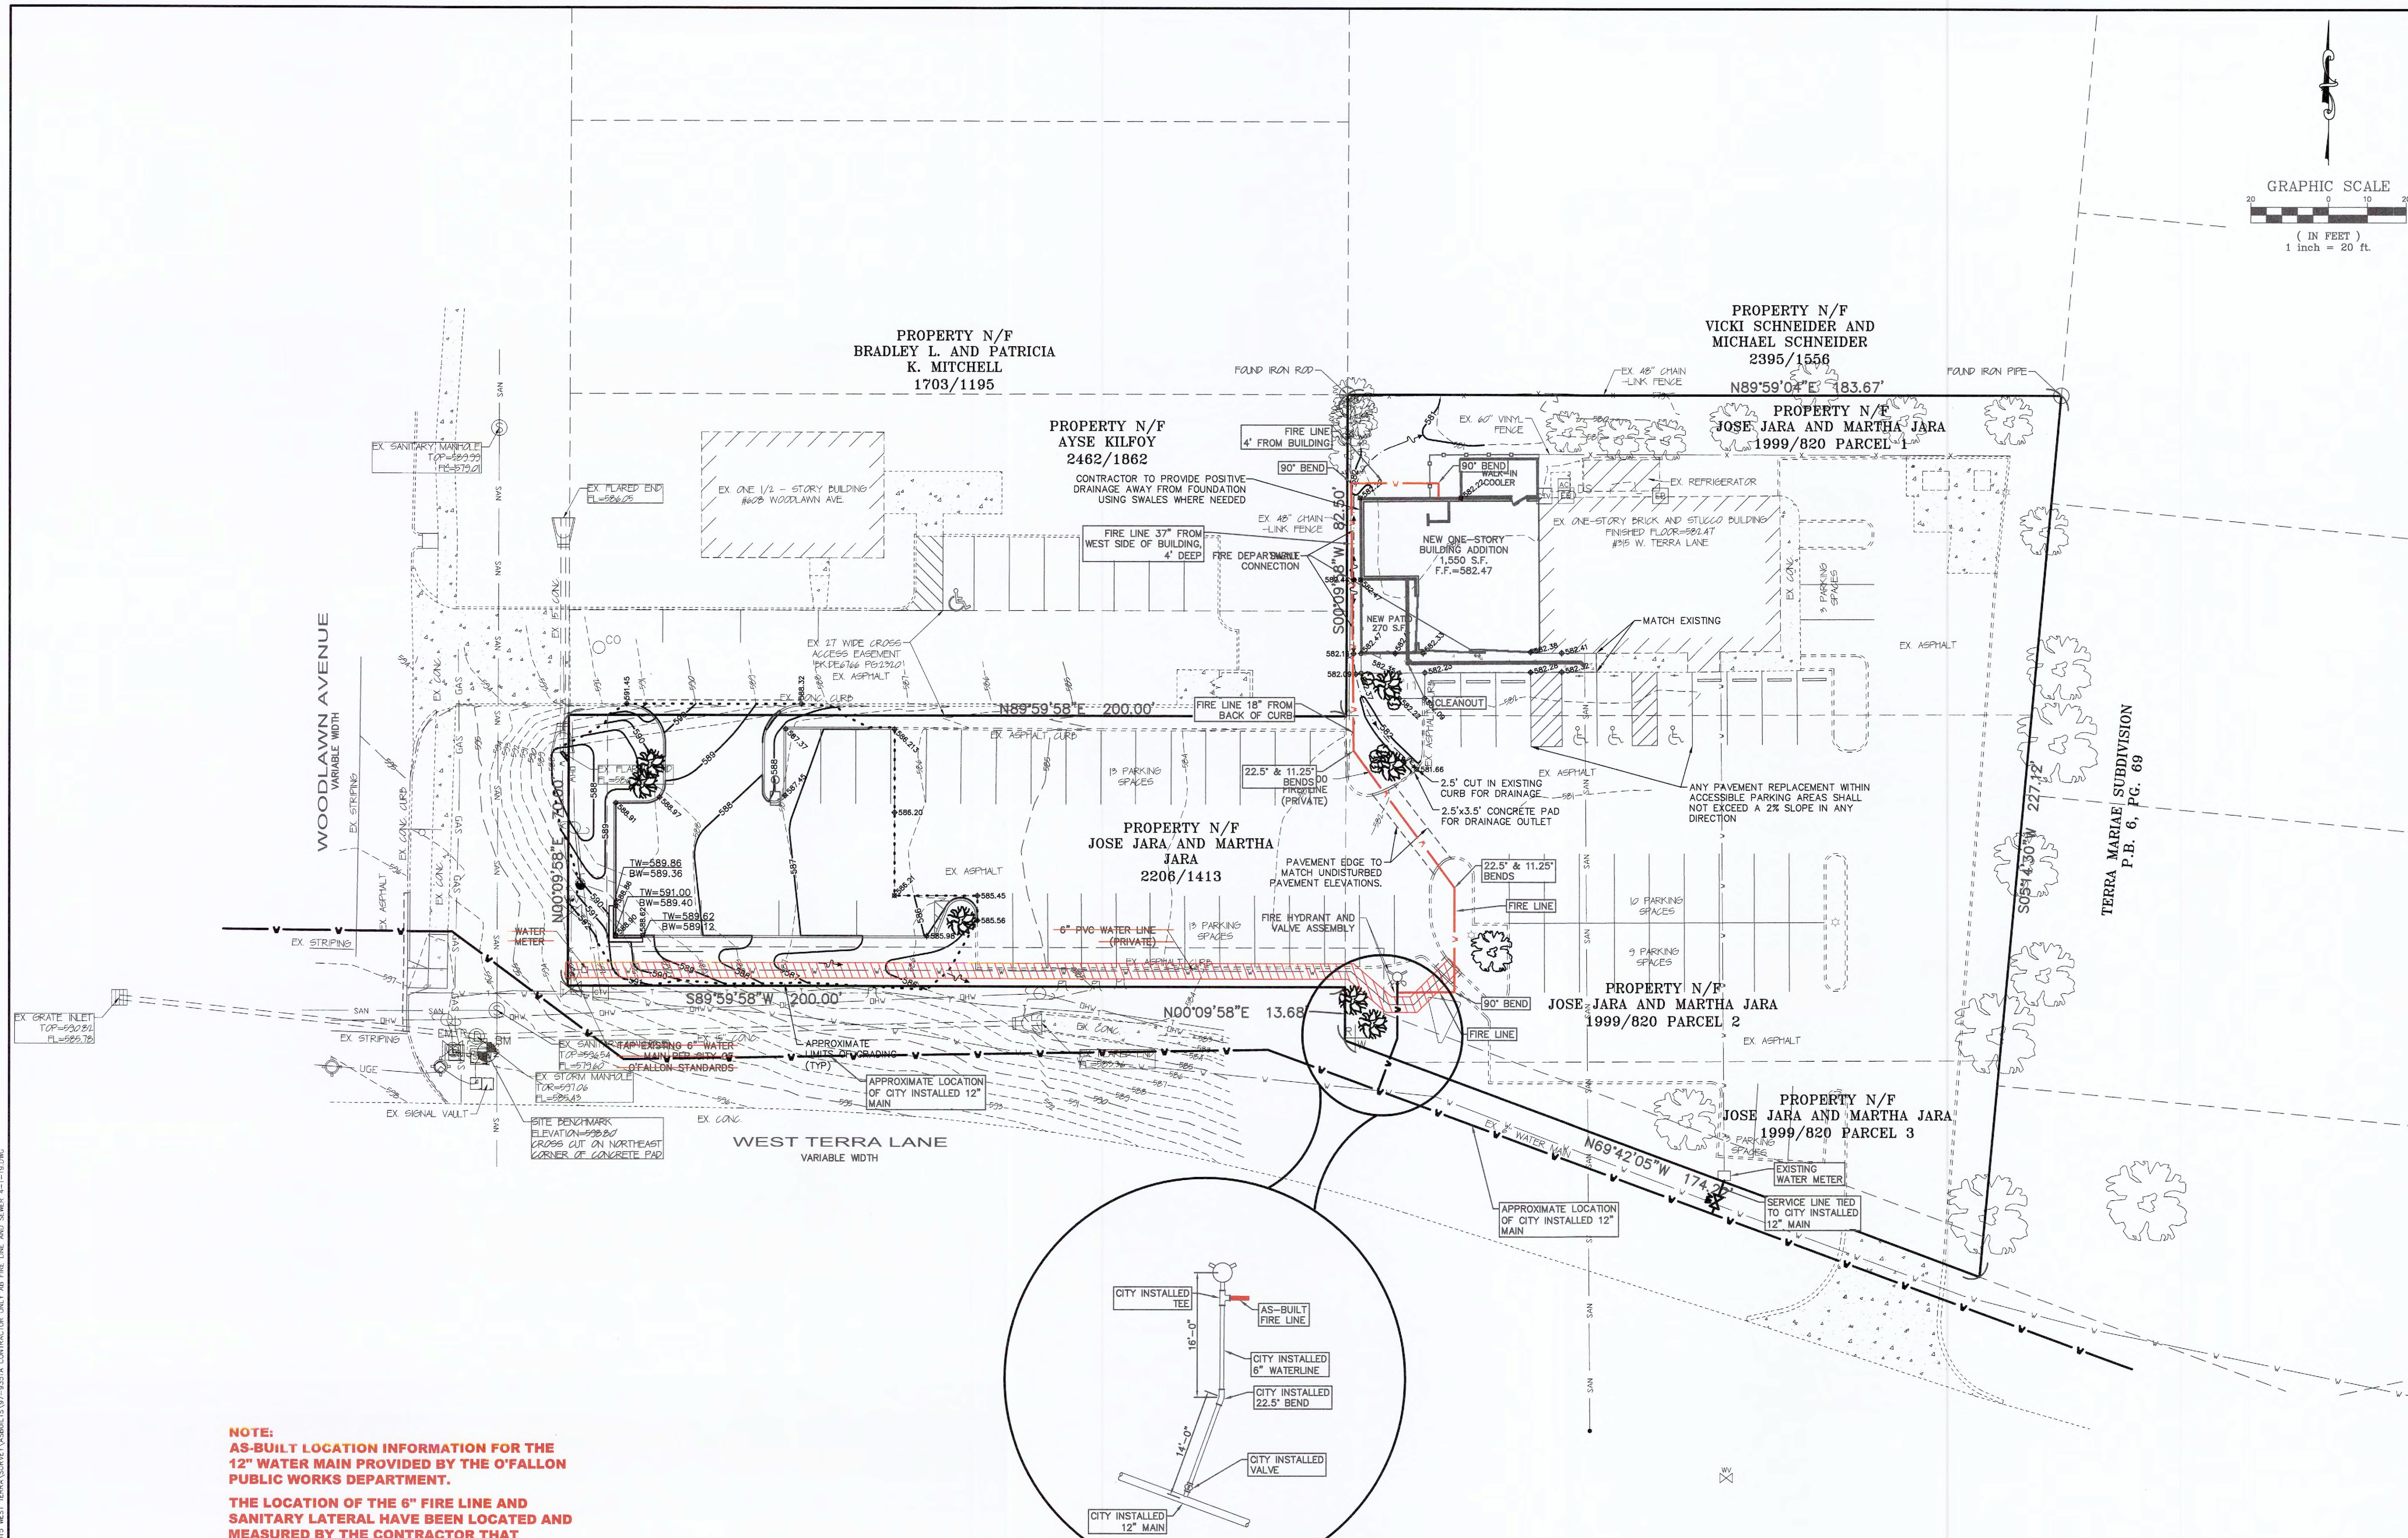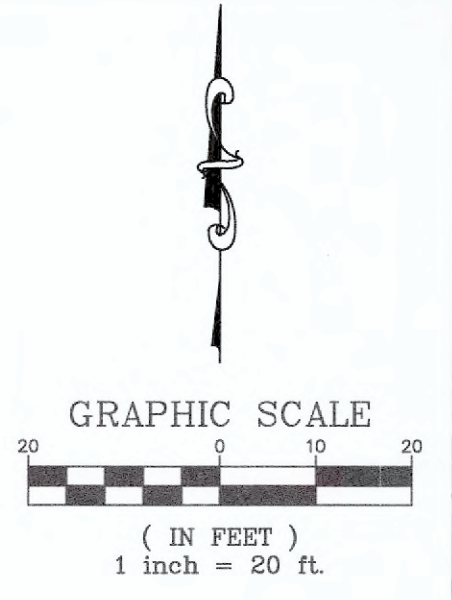

NOTE:
AS-BUILT LOCATION INFORMATION FOR THE 12" WATER MAIN PROVIDED BY THE O'FALLON PUBLIC WORKS DEPARTMENT.
THE LOCATION OF THE 6" FIRE LINE AND SANITARY LATERAL HAVE BEEN LOCATED AND MEASURED BY THE CONTRACTOR THAT INSTALLED AND CONSTRUCTED THEM AND THE RESULTS OF THOSE MEASUREMENTS ARE SHOWN ON THIS SET OF AS-BUILT WATERLINE PLANS.

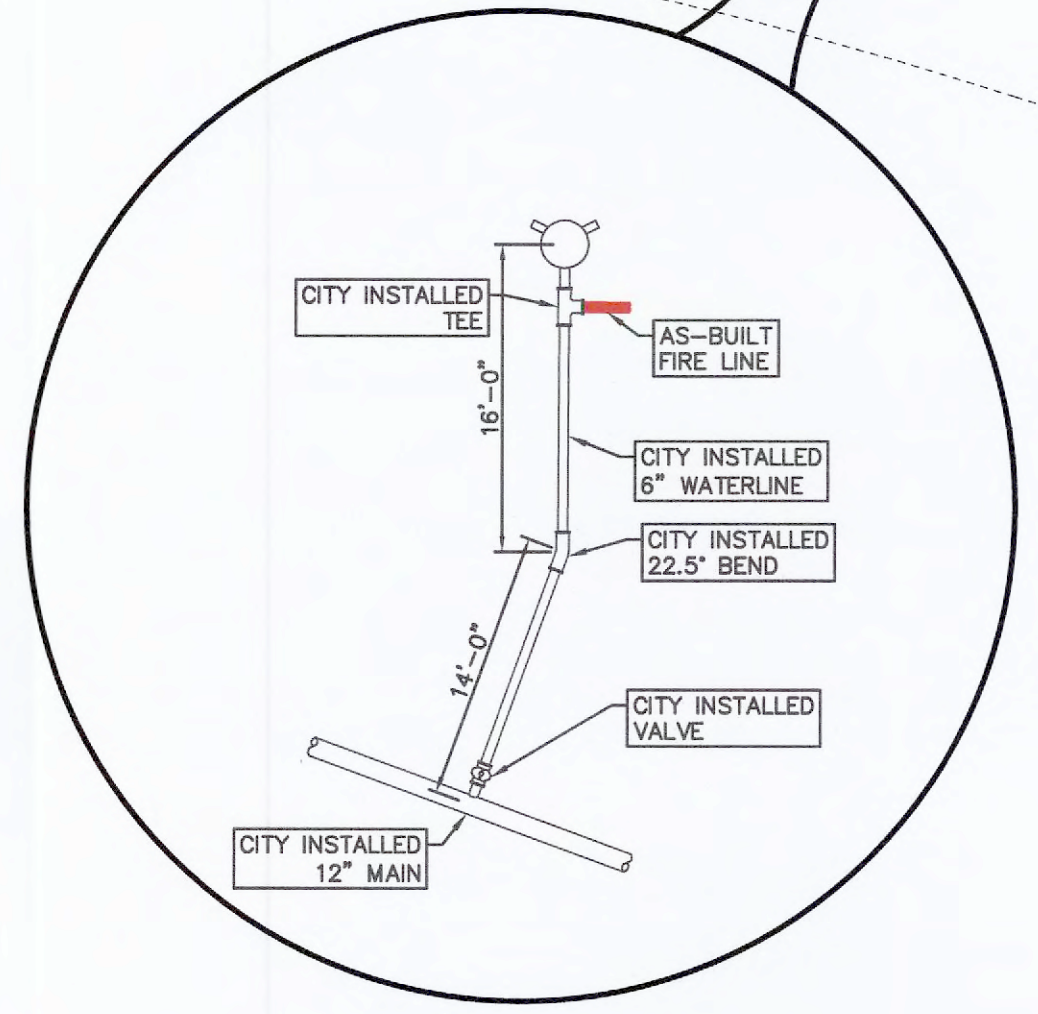

AS-BUILT WATERLINE PLAN




CALL BEFORE YOU DIG!
 1-800-DIG-RITE

PROJECT TITLE:
 EL TIO PEPE MEXICAN RESTAURANT
 315 WEST TERRA LANE
 O'FALLON, ST. CHARLES, MISSOURI 63366
 Issue Date: 04/12/2017

ENGINEERING PLANNING SURVEYING
 221 Point West Blvd.
 St. Charles, MO 63301
 636-929-5592
 FAX 636-929-1718



DISCLAIMER OF RESPONSIBILITY
 I hereby specify that the documents intended to be authorized by my seal are limited to this sheet, and I hereby disclaim any responsibility for all other Drawings, Specifications, Estimates, Reports or other documents or instruments relating to or intended to be used for any part of the project of the architecture or engineering project.

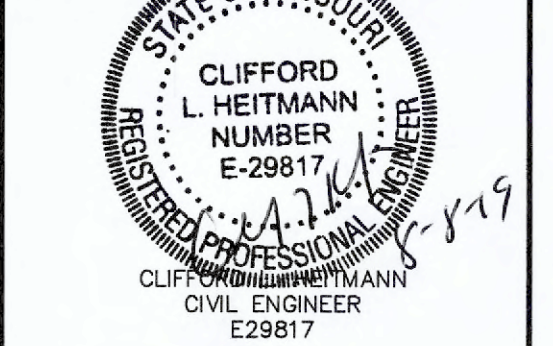

Copyright 2017
 Box Engineering Company, Inc.
 Engineering Authority No. 000655
 Surveying Authority No. 000144
 All Rights Reserved

REVISIONS

DATE	CITY COMMENTS
09/19/17	CITY COMMENTS
10/04/17	CITY COMMENTS
08/08/19	AS-BUILT PLANS

Developer / Owner:
 WR HOLMAN, LLC
 2 HICKORY HILL DRIVE
 O'FALLON, MISSOURI 63366
 (636) 734-1815

GRADING PLAN

P+Z No. 33-14.01
CUP No. 33-14.01.01
Page No. 5 of 18

UNDERGROUND UTILITIES HAVE BEEN PLOTTED FROM AVAILABLE INFORMATION AND THEREFORE THEIR LOCATIONS SHALL BE CONSIDERED APPROXIMATE ONLY. THE VERIFICATION OF THE LOCATION OF ALL UNDERGROUND UTILITIES, EITHER SHOWN OR NOT SHOWN ON THESE PLANS SHALL BE THE RESPONSIBILITY OF THE CONTRACTOR, AND SHALL BE LOCATED PRIOR TO ANY GRADING OR CONSTRUCTION OF THE IMPROVEMENTS.

BENDS	"b"	"c"	"d"	"e"	"f"
6"-11 1/4"	8"	15"	12"	24"	10"
6"-22 1/2"	8"	19"	12"	24"	13"
6"-45"	8"	30"	12"	24"	15"
6"-90"	8"	30"	12"	24"	28"
6"-11 1/4"	8"	20"	12"	24"	10"
6"-22 1/2"	8"	25"	12"	24"	18"
6"-45"	8"	31"	12"	24"	24"
6"-90"	8"	38"	12"	24"	38"
12"-11 1/4"	8"	30"	12"	24"	15"
12"-22 1/2"	8"	35"	12"	24"	25"
12"-45"	8"	40"	12"	24"	40"
12"-90"	8"	50"	12"	24"	60"
16"-11 1/4"	TL	28"	20"	24"	28"
16"-22 1/2"	TL	36"	20"	24"	39"
16"-45"	TL	50"	20"	24"	58"
16"-90"	TL	61"	20"	24"	80"
20"-11 1/4"	TL	34"	24"	28"	28"
20"-22 1/2"	TL	48"	24"	28"	39"
20"-45"	TL	74"	24"	28"	58"
20"-90"	TL	136"	24"	28"	80"
24"-11 1/4"	TL	40"	28"	28"	40"
24"-22 1/2"	TL	56"	28"	28"	49"
24"-45"	TL	101"	28"	28"	60"
24"-90"	TL	186"	28"	28"	80"
30"-11 1/4"	TL	46"	34"	30"	49"
30"-22 1/2"	TL	79"	34"	30"	60"
30"-45"	TL	154"	34"	30"	60"
30"-90"	TL	285"	34"	30"	60"

TEES	"a"	"b"	"c"	"d"
6"x6"x6"	12"	24"	24"	18"
6"x6"x8"	12"	24"	24"	18"
6"x6"x12"	12"	24"	24"	18"
6"x8"x6"	12"	24"	24"	18"
6"x8"x8"	12"	24"	24"	18"
6"x8"x12"	12"	24"	24"	18"
6"x12"x6"	12"	24"	24"	18"
6"x12"x8"	12"	24"	24"	18"
6"x12"x12"	12"	24"	24"	18"
12"x12"x6"	12"	24"	24"	18"
12"x12"x8"	12"	24"	24"	18"
12"x12"x12"	12"	24"	24"	18"
24"x24"x18"	18"	36"	28"	13"


NOTES:
 1. 2" & 4" FITTINGS EQUIVALENT TO 6" FITTINGS.
 2. TAPPING SLEEVES TO HAVE BACKING BLOCKS SAME SIZE AS REQUIRED FOR FITTINGS.
 3. "L" = TOTAL LENGTH OF FITTING MINUS CLEARANCE FOR BELLS.

INTERNAL WATER PRESSURE 6" through 12"=200 psi
 INTERNAL WATER PRESSURE 15" through 30"=210 psi
 BEARING PRESSURE OF SOIL=2000 psi

BACKING BLOCKS
 NOT TO SCALE

CITY OF O'FALLON
 ENGINEERING DEPARTMENT
 O'FALLON, MISSOURI

**BACKING BLOCK
 DETAILS AND LOCATIONS**

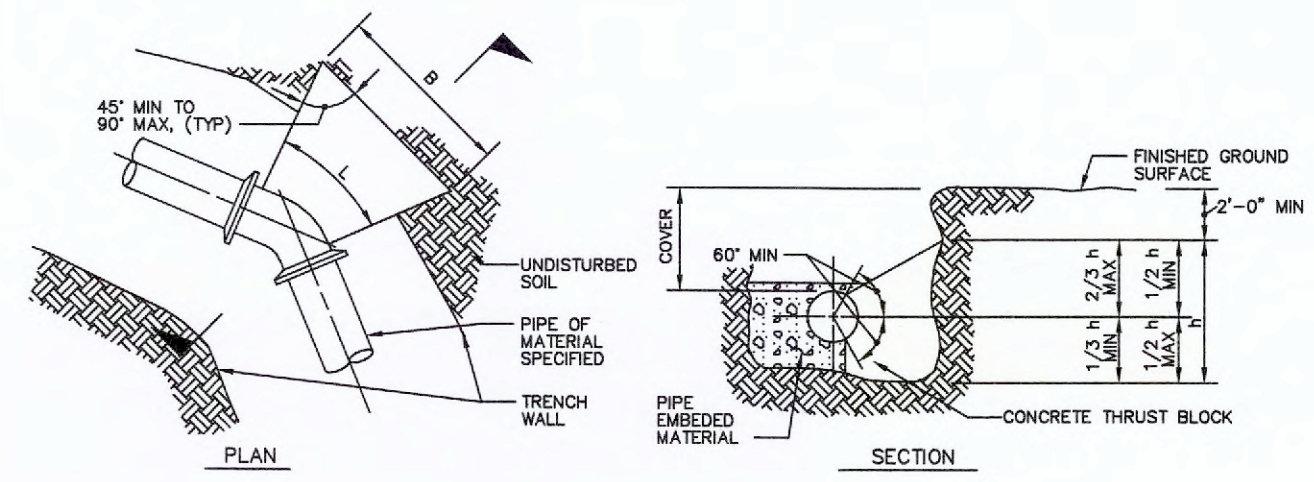


- NOTES:
 1. AREA OF BLOCK A = BxH. BLOCK AREAS ARE SHOWN ON GENERAL LAYOUT OR TABLE.
 2. $B = h = \sqrt{A}$, EXCEPT WHERE TOP OF BLOCK IS WITHIN 2 FEET FROM GROUND SURFACE, THEN $B = A/h$.
 3. MINIMUM BLOCK DIMENSION (B & h) SHALL BE AT LEAST OD OF PIPE OR 1 FOOT FOR PIPE OD 12" OR LESS.
 4. THE BOTTOM OF THE BLOCK SHALL EXTEND AT LEAST TO THE BOTTOM OF THE TRENCH IN ALL CASES.
 5. L=FITTING LENGTH MINUS CLEARANCE FOR BELLS.
 6. DETAIL IS SHOWN FOR CAST IRON PIPE; DETAIL IS SIMILAR FOR OTHER TYPES OF PIPE.
 7. DIMENSIONS FOR THRUST BLOCKS FOR FIRE HYDRANT ASSEMBLY ARE SHOWN FIRE HYDRANT ASSEMBLY DETAIL.

SIZE	BEND	THRUST AREA	B	H
18"	22 1/2"	4 SF	2'	2'
16"	45"	8 SF	2.8'	2.8'

CONCRETE THRUST BLOCKING
 NOT TO SCALE

CITY OF O'FALLON
 ENGINEERING DEPARTMENT
 O'FALLON, MISSOURI

**CONCRETE THRUST
 BLOCKING DETAILS**

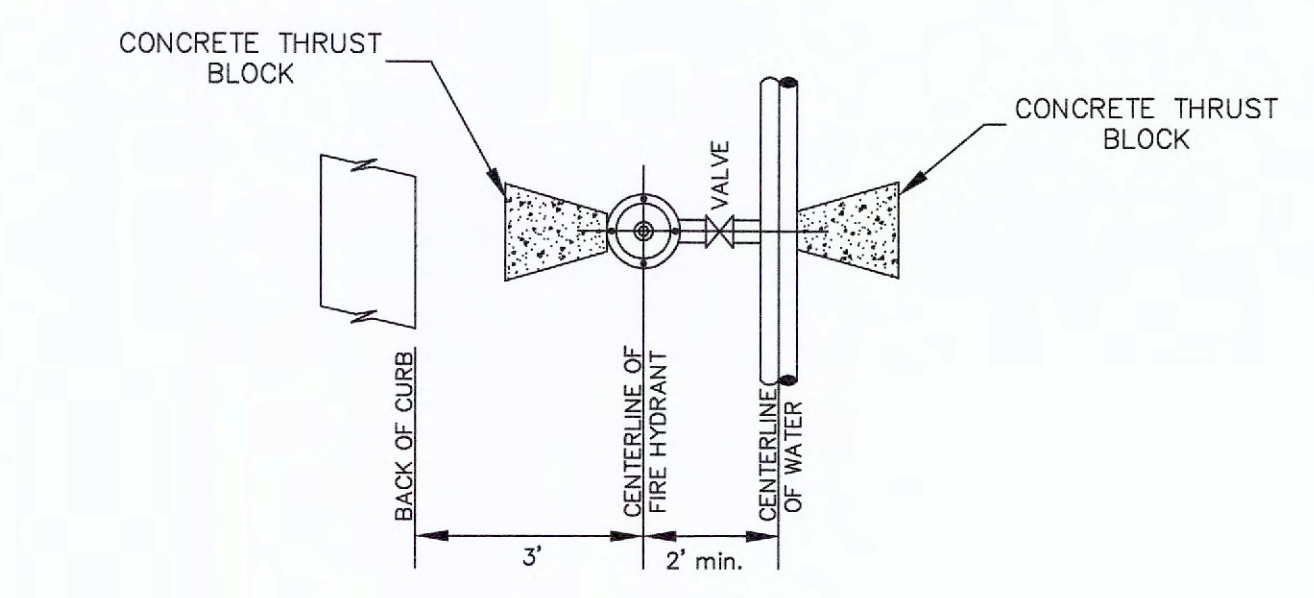


CONFIGURATION
 ALL FIRE HYDRANTS SHALL BE 3' OFF BACK OF CURB
 ALL WATER MAINS SHALL BE A MIN. OF 5' OFF BACK OF CURB

**TYPICAL WATER MAIN AND FIRE
 HYDRANT LOCATIONS**
 NOT TO SCALE

CITY OF O'FALLON
 ENGINEERING DEPARTMENT
 O'FALLON, MISSOURI


**WATER MAIN
 FIRE HYDRANT DETAIL**

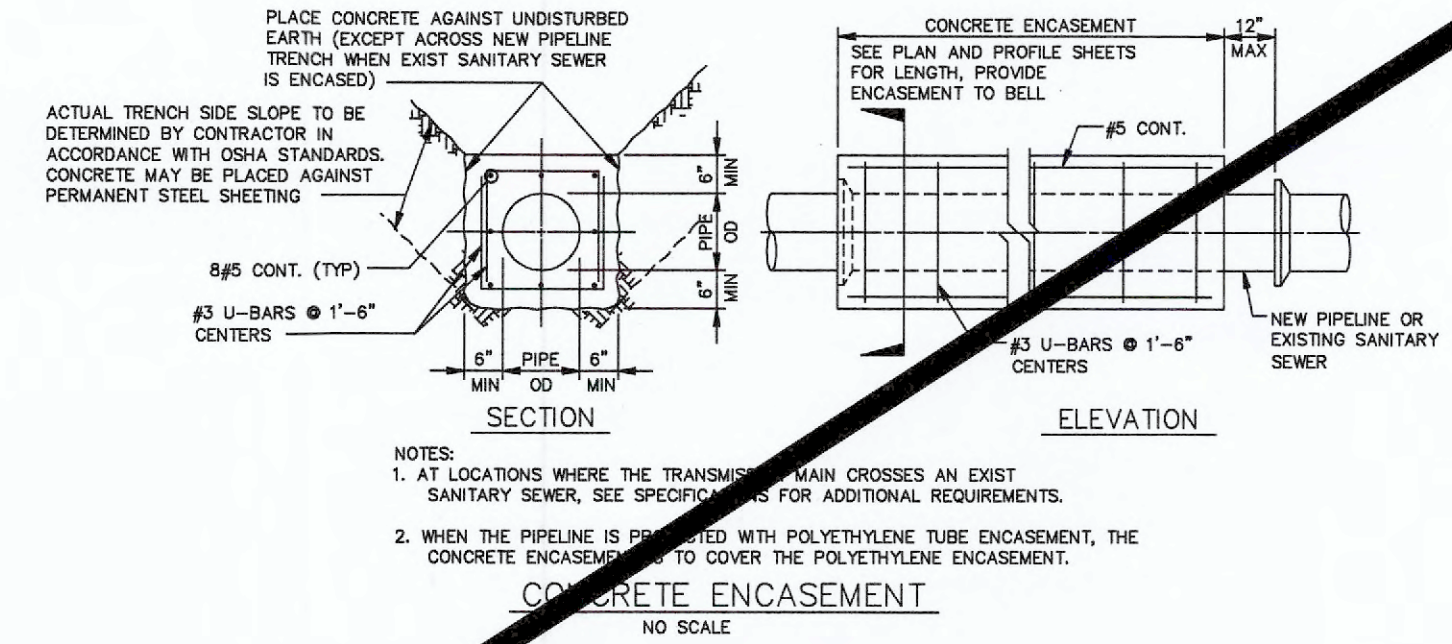

- NOTES:
 1. AT LOCATIONS WHERE THE TRANSMISSION MAIN CROSSES AN EXIST SANITARY SEWER, SEE SPECIFICATIONS FOR ADDITIONAL REQUIREMENTS.
 2. WHEN THE PIPELINE IS PROTECTED WITH POLYETHYLENE TUBE ENCASUREMENT, THE CONCRETE ENCASUREMENT TO COVER THE POLYETHYLENE ENCASUREMENT.

CITY OF O'FALLON
 ENGINEERING DEPARTMENT
 O'FALLON, MISSOURI

**CONCRETE ENCASUREMENT
 DETAILS**

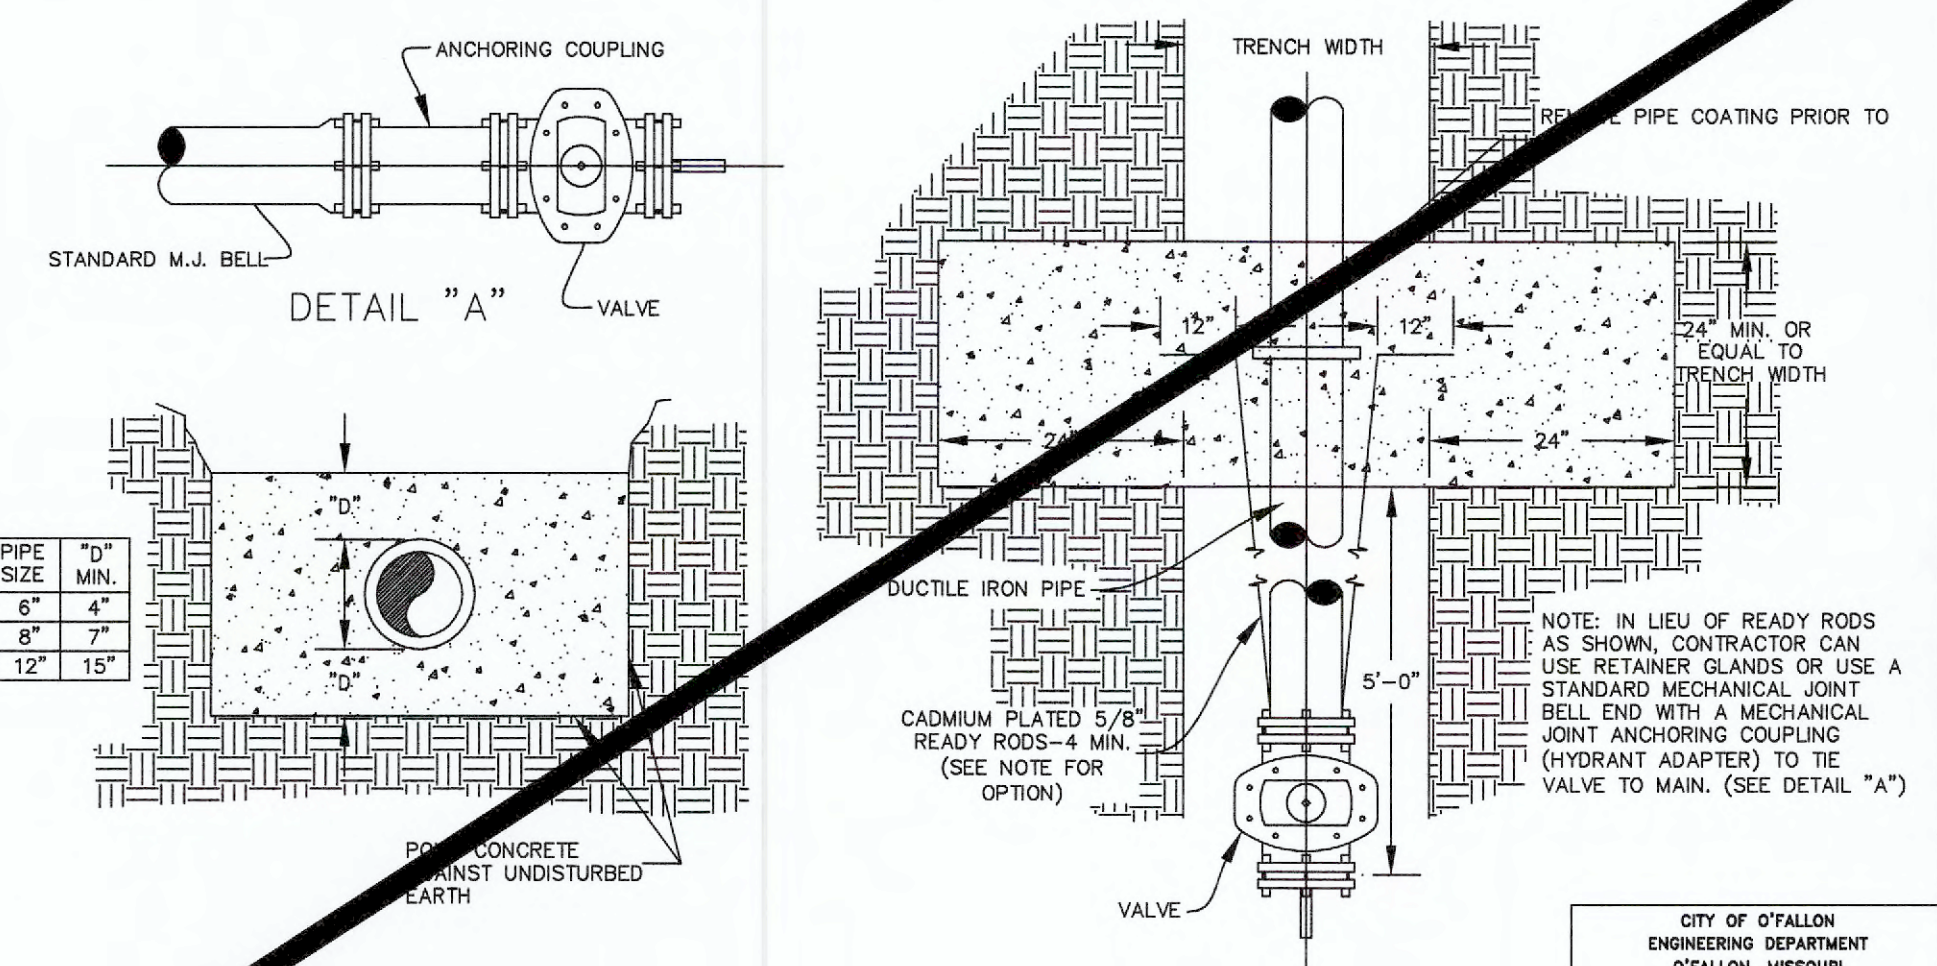


PIPE SIZE	"D" MIN.
6"	4"
8"	7"
12"	15"

STRADDLE BLOCK DETAIL
 NOT TO SCALE

CITY OF O'FALLON
 ENGINEERING DEPARTMENT
 O'FALLON, MISSOURI

**STRADDLE BLOCK
 DETAILS**

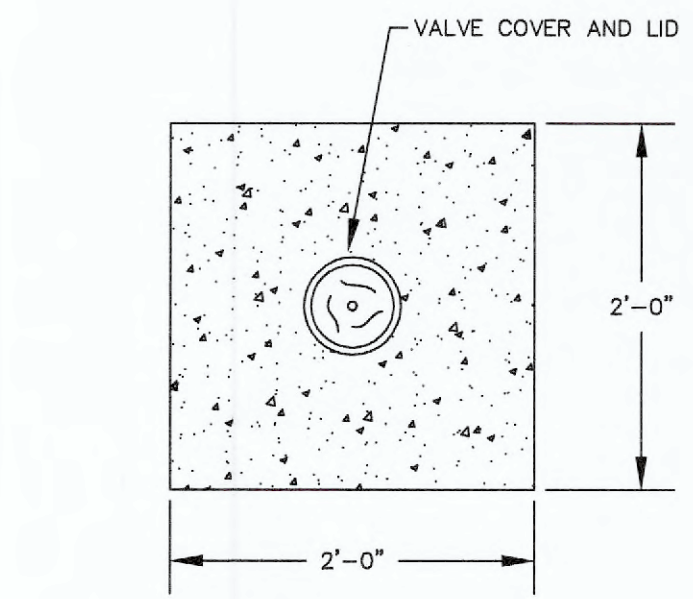


**TOP VIEW
 CONCRETE COLLAR**
 NOT TO SCALE

- Note: 1. Concrete collar joint pattern is required in paved areas such as roadways, driveways, sidewalks or other areas of paved surfaces.
 2. Concrete collars are optional in other non-paved areas.

CITY OF O'FALLON
 ENGINEERING DEPARTMENT
 O'FALLON, MISSOURI


**CONCRETE
 COLLAR DETAIL**

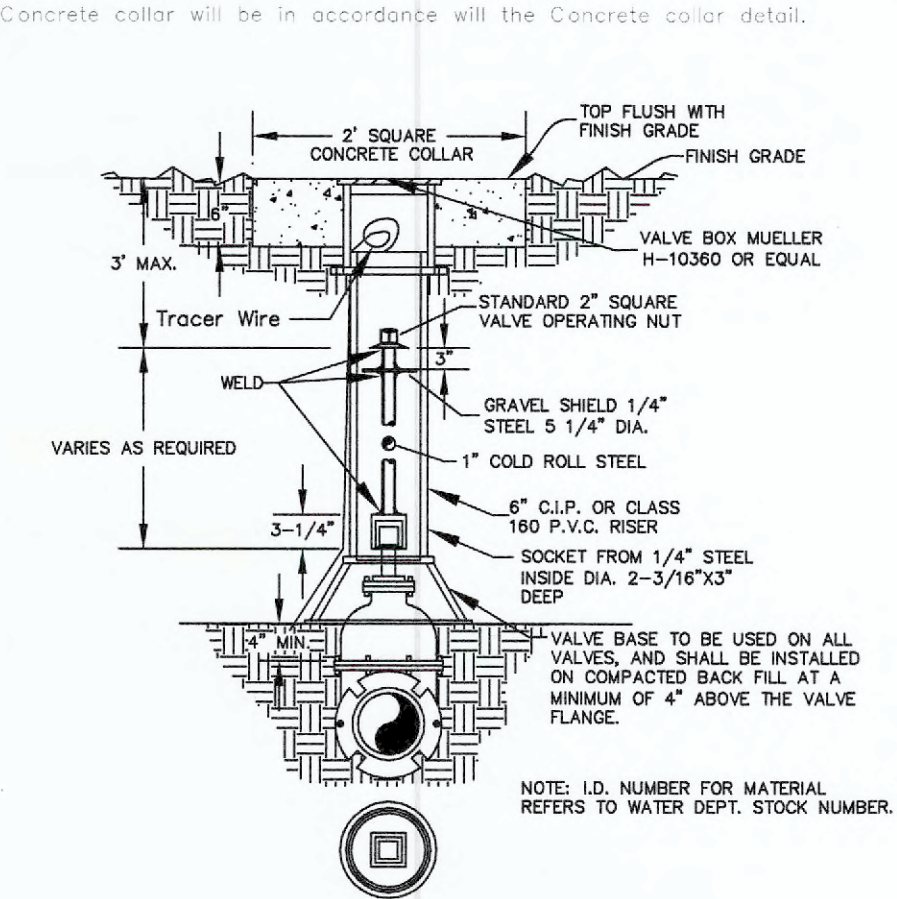

WATER VALVE DETAIL
 NOT TO SCALE

CITY OF O'FALLON
 ENGINEERING DEPARTMENT
 O'FALLON, MISSOURI

**WATER
 VALVE DETAIL**

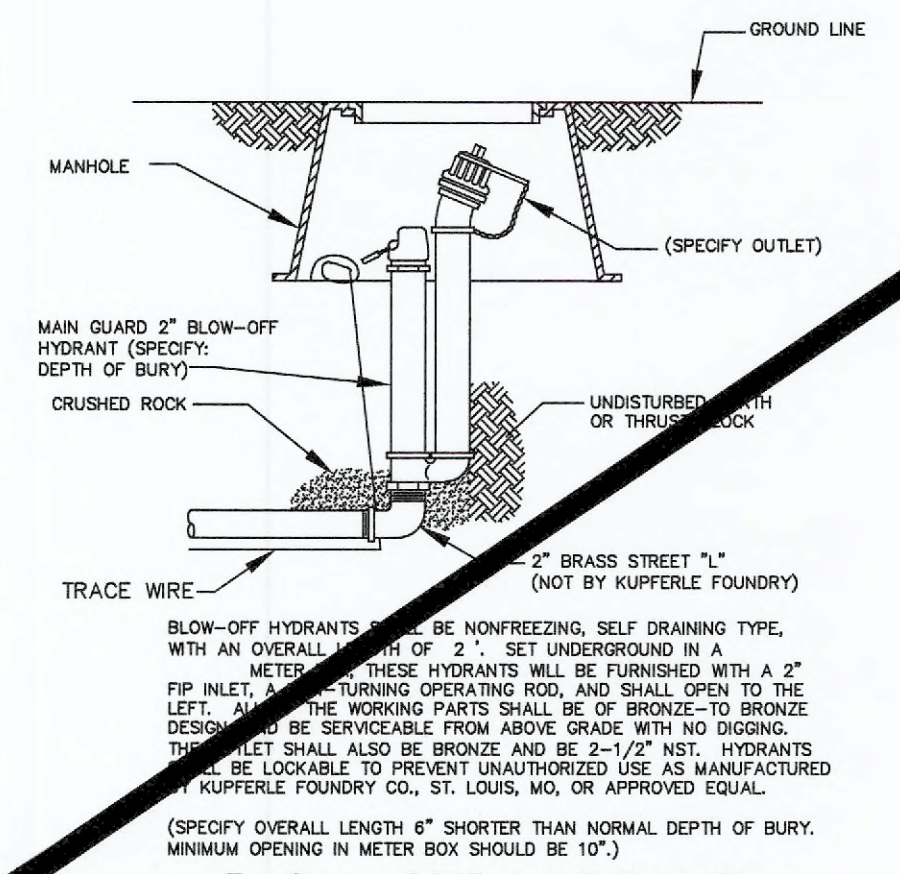

BLOW-OFF HYDRANT
 NOT TO SCALE

CITY OF O'FALLON
 ENGINEERING DEPARTMENT
 O'FALLON, MISSOURI


**BLOW-OFF
 HYDRANT DETAIL**

PROJECT TITLE:
 EL TIJO PEPE MEXICAN
 RESTAURANT

315 WEST TERRA LANE
 O'FALLON, ST. CHARLES,
 MISSOURI 63366

ENGINEERING
 PLANNING
 SURVEYING

221 Point West Blvd.
 St. Charles, MO 63301
 636-929-5552
 FAX 929-1718

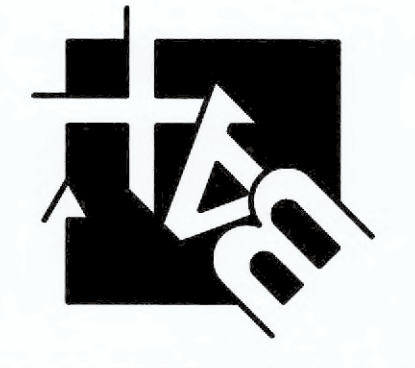

DISCLAIMER OF RESPONSIBILITY
 I hereby specify that the documents intended to be authorized by my seal are limited to this sheet, and I hereby disclaim any responsibility for all other drawings, specifications, estimates, reports or other documents or instruments relating to or intended to be used for any part or parts of the architecture or engineering project or survey.

REFERENCE
 DRAWING

REVISIONS	
09/19/17	CITY COMMENTS
10/04/17	CITY COMMENTS
08/08/19	AS-BUILT PLANS

Developer / Owner:
 WR HOLMAN, LLC
 2 HICKORY HILL DRIVE
 O'FALLON, MISSOURI 63366
 (636) 734-1815

WATER SERVICE DETAILS

P+Z No.
 33-14.01

CUP No.
 33-14.01.01

Page No.
 10 of 18

LAST DATE OF REVISION: 04/12/2017
 PROJECT: 33-14.01-01
 SHEET: 10 OF 18
 DRAWING: WATER SERVICE DETAILS
 CONTRACTOR: WR HOLMAN, LLC
 ENGINEER: CITY OF O'FALLON
 SURVEYOR: CITY OF O'FALLON

REFERENCE DRAWINGS ONLY
ENGINEERS SEAL DOES NOT APPLY
TO DETAILS BELOW.

616.8.33 (TA-33) Lane Closure on Left or Right Lane on Divided Highway- MT

SPEED Permanent Posted (mph)	SIGN SPACING (ft.)		TAPER LENGTH (ft.)		OPTIONAL BUFFER LENGTH (ft.) (B)	CHANNELIZER SPACING (ft.)	
	Undivided (S)	Divided (S)	Shoulder (T1)	Lane (T2)		Tapers	Buffer/ Work Areas
0-35	-	200	70	245	280	35	40
40-45	-	500	150	540	400	40	80
50-55	-	1000	185	660	560	50	80
60-70	-	SA - 1000 SB - 1500 SC - 2640	235	840	840	60	120

1. Shoulder taper length based on 10 ft. (standard shoulder width) offset. 2. Lane taper length based on 12 ft. (standard lane width) offset.

URBAN	RURAL UNDIVIDED	SIGN HEIGHT 7' Post	MAXIMUM WORK ZONE LENGTH (L)	Channelizer		Protective Vehicle	
				Truck or Trailer Mounted Arrow Panel	Work Space	Truck Mounted Attenuator (TMA)	Work Space
		1' Portable 7' Post	1 Mi.	(Advanced Warning Rail System) For Long Term Operations			
		1' Portable 7' Post	2 Mi.				

A protective vehicle shall be used while work is in progress. The protective vehicle shall be equipped with a TMA and flashing arrow panel and positioned at least 150 ft. in advance of the work space. The protective vehicle may be eliminated if the roadway is posted at 45 mph or below, the work vehicle is positioned in advance of the work space, and the work vehicle is equipped with a flashing arrow panel and uses activated rotating lights or strobe lights.

All vehicles, equipment, workers and their activities should be restricted to one side of the pavement.

The open lane shall be provided with a 10 ft. minimum driving surface at all times. This may include a portion of the shoulder, provided the shoulder is of adequate strength to handle traffic.

For short duration operations, signs and channelizers may be reduced or eliminated.

For mobile operations where workers are on foot and move with the operation, channelizers may be reduced or eliminated.

For operations in which channelizers are not used, the arrow mode shall be displayed on any flashing arrow panel located downstream of the taper.

Supplemental warning methods may be used to call attention to the work zone.

Additional warning signs shall be erected at each intersection with another state highway within the work zone. Upon the discretion of the supervisor, additional warning signs may be erected at other intersections within the work zone.




For nighttime operations, review EPG 616.6.83 WARNING LIGHTS for use of sequential lights.

If rumble strips are used, review EPG 616.6.87 RUMBLE STRIPS.

For long-term operations, EPG 616.6.2.2 Flags and Advance Warning Rail System.

SEE EPG 616.12 WORK ZONE SPEED LIMITS FOR SPEED LIMIT GUIDELINES.

TA-33 1/16

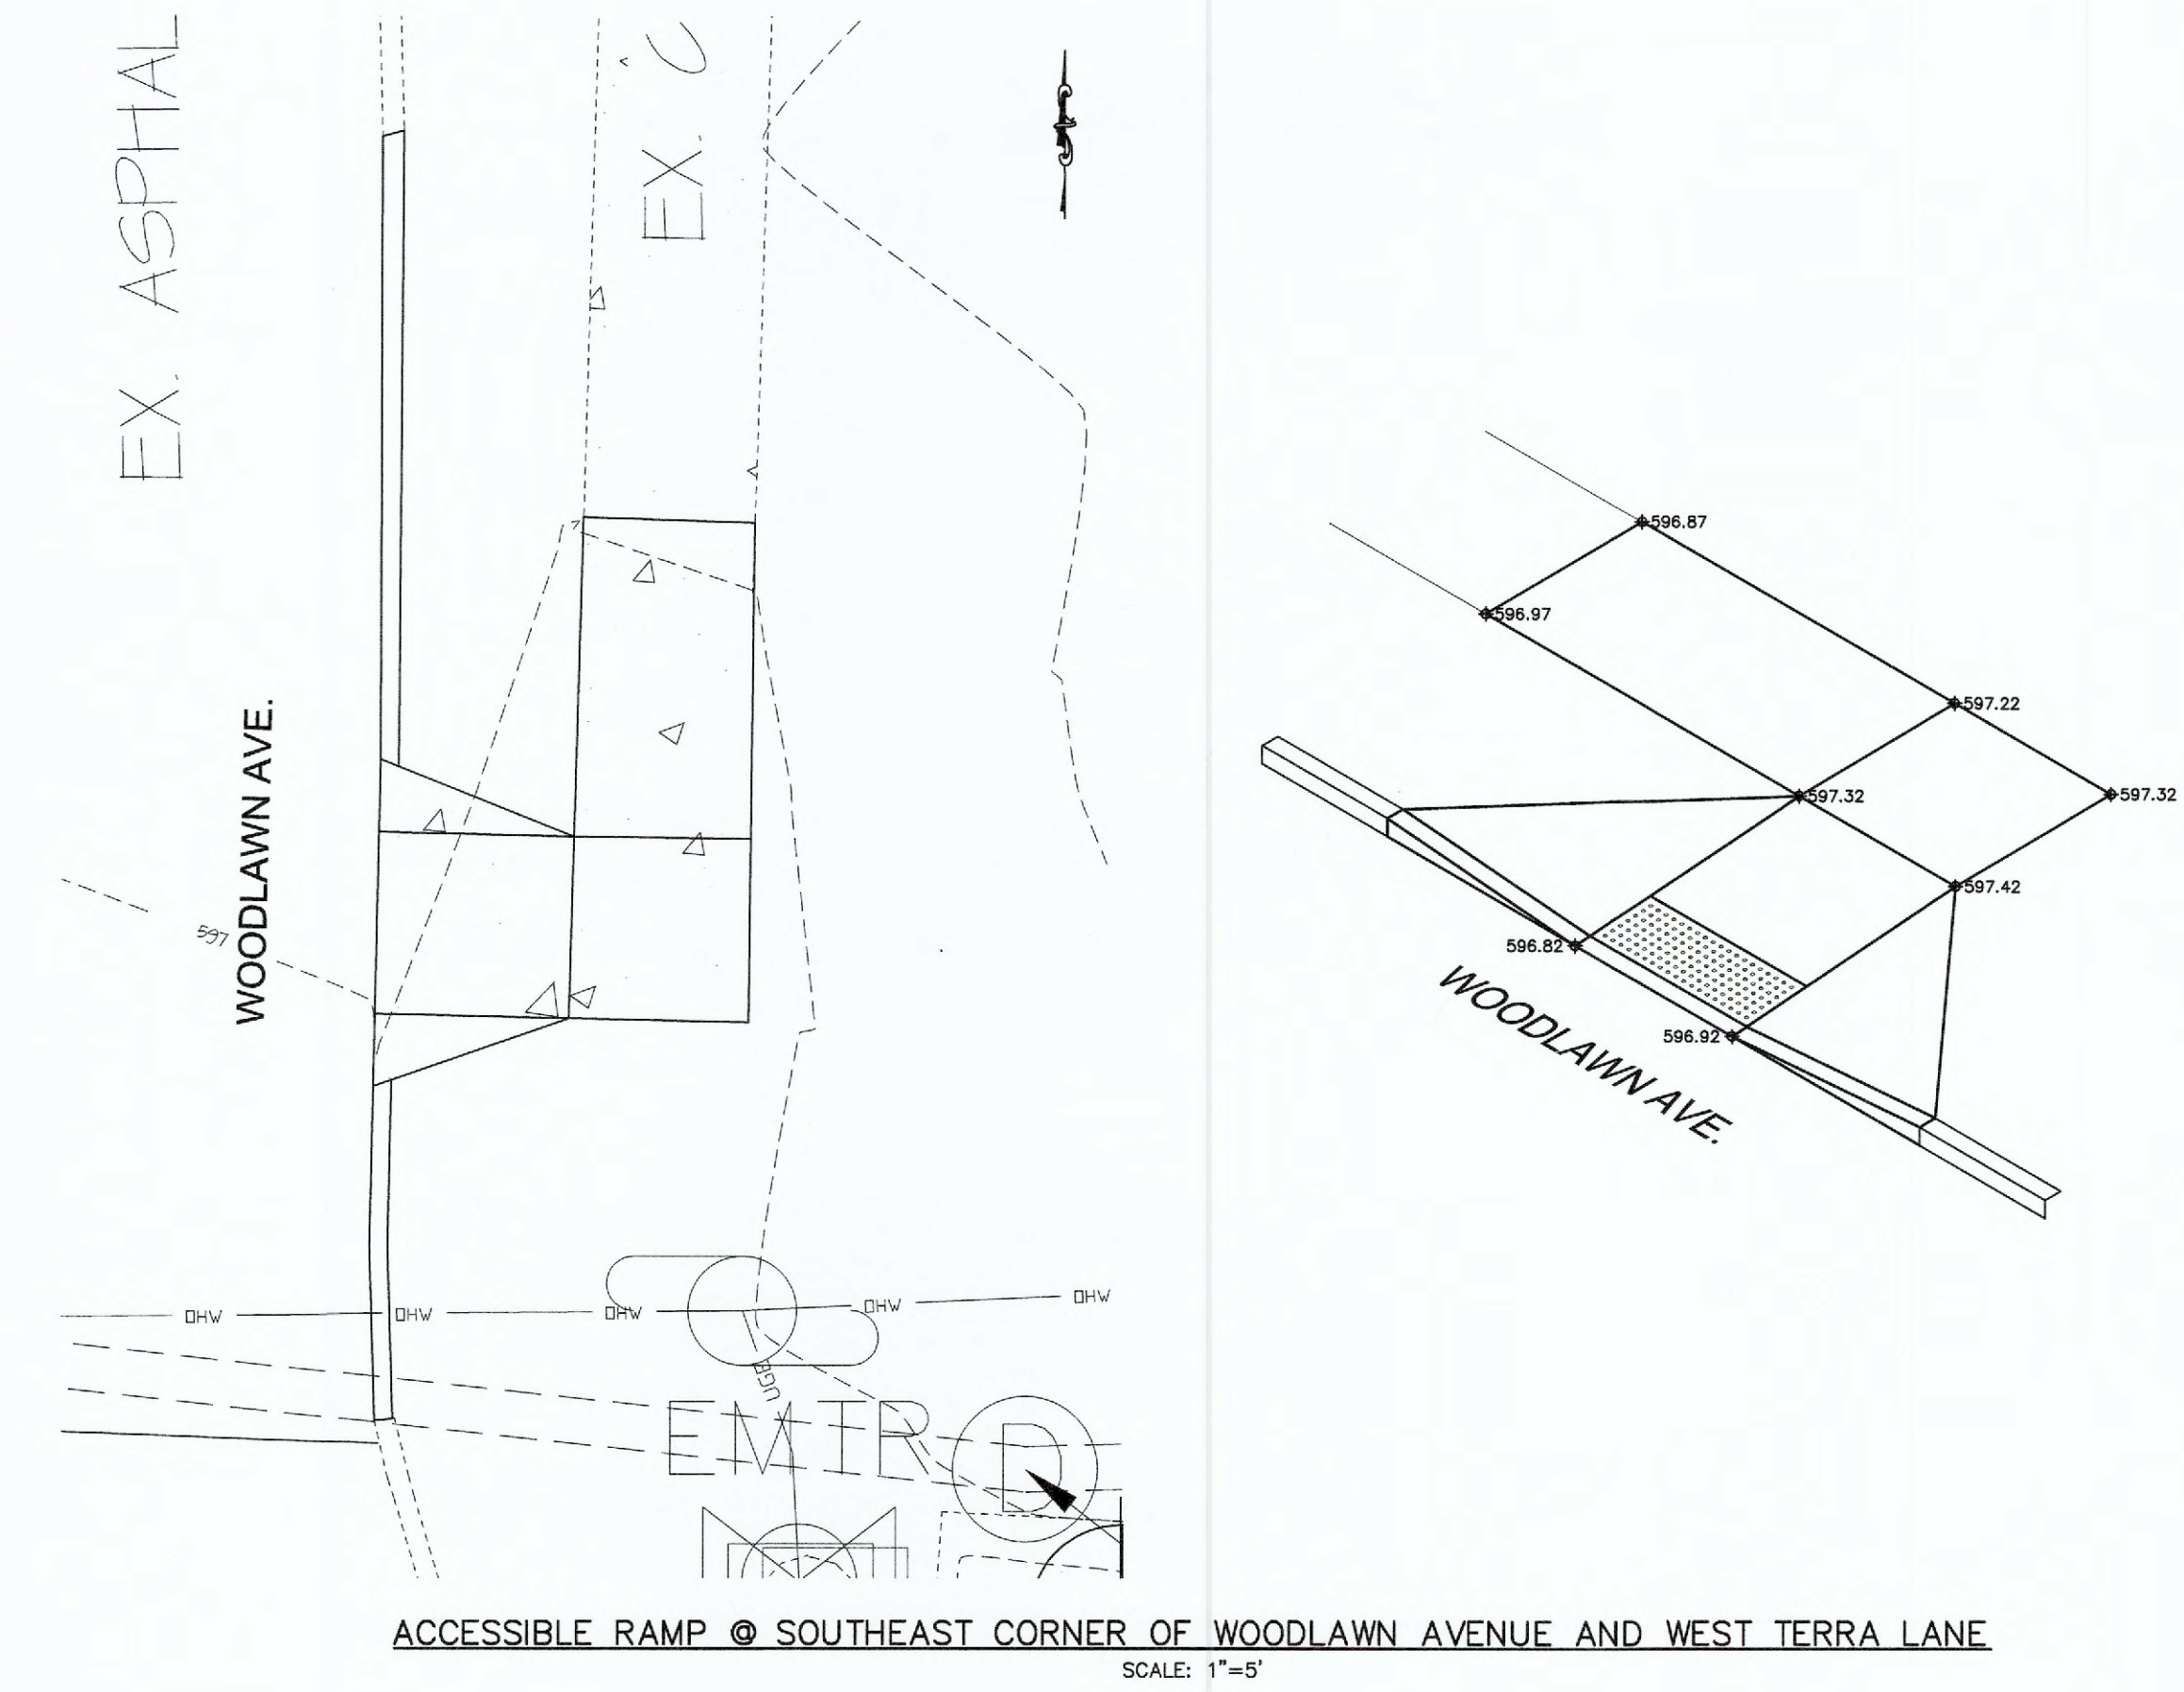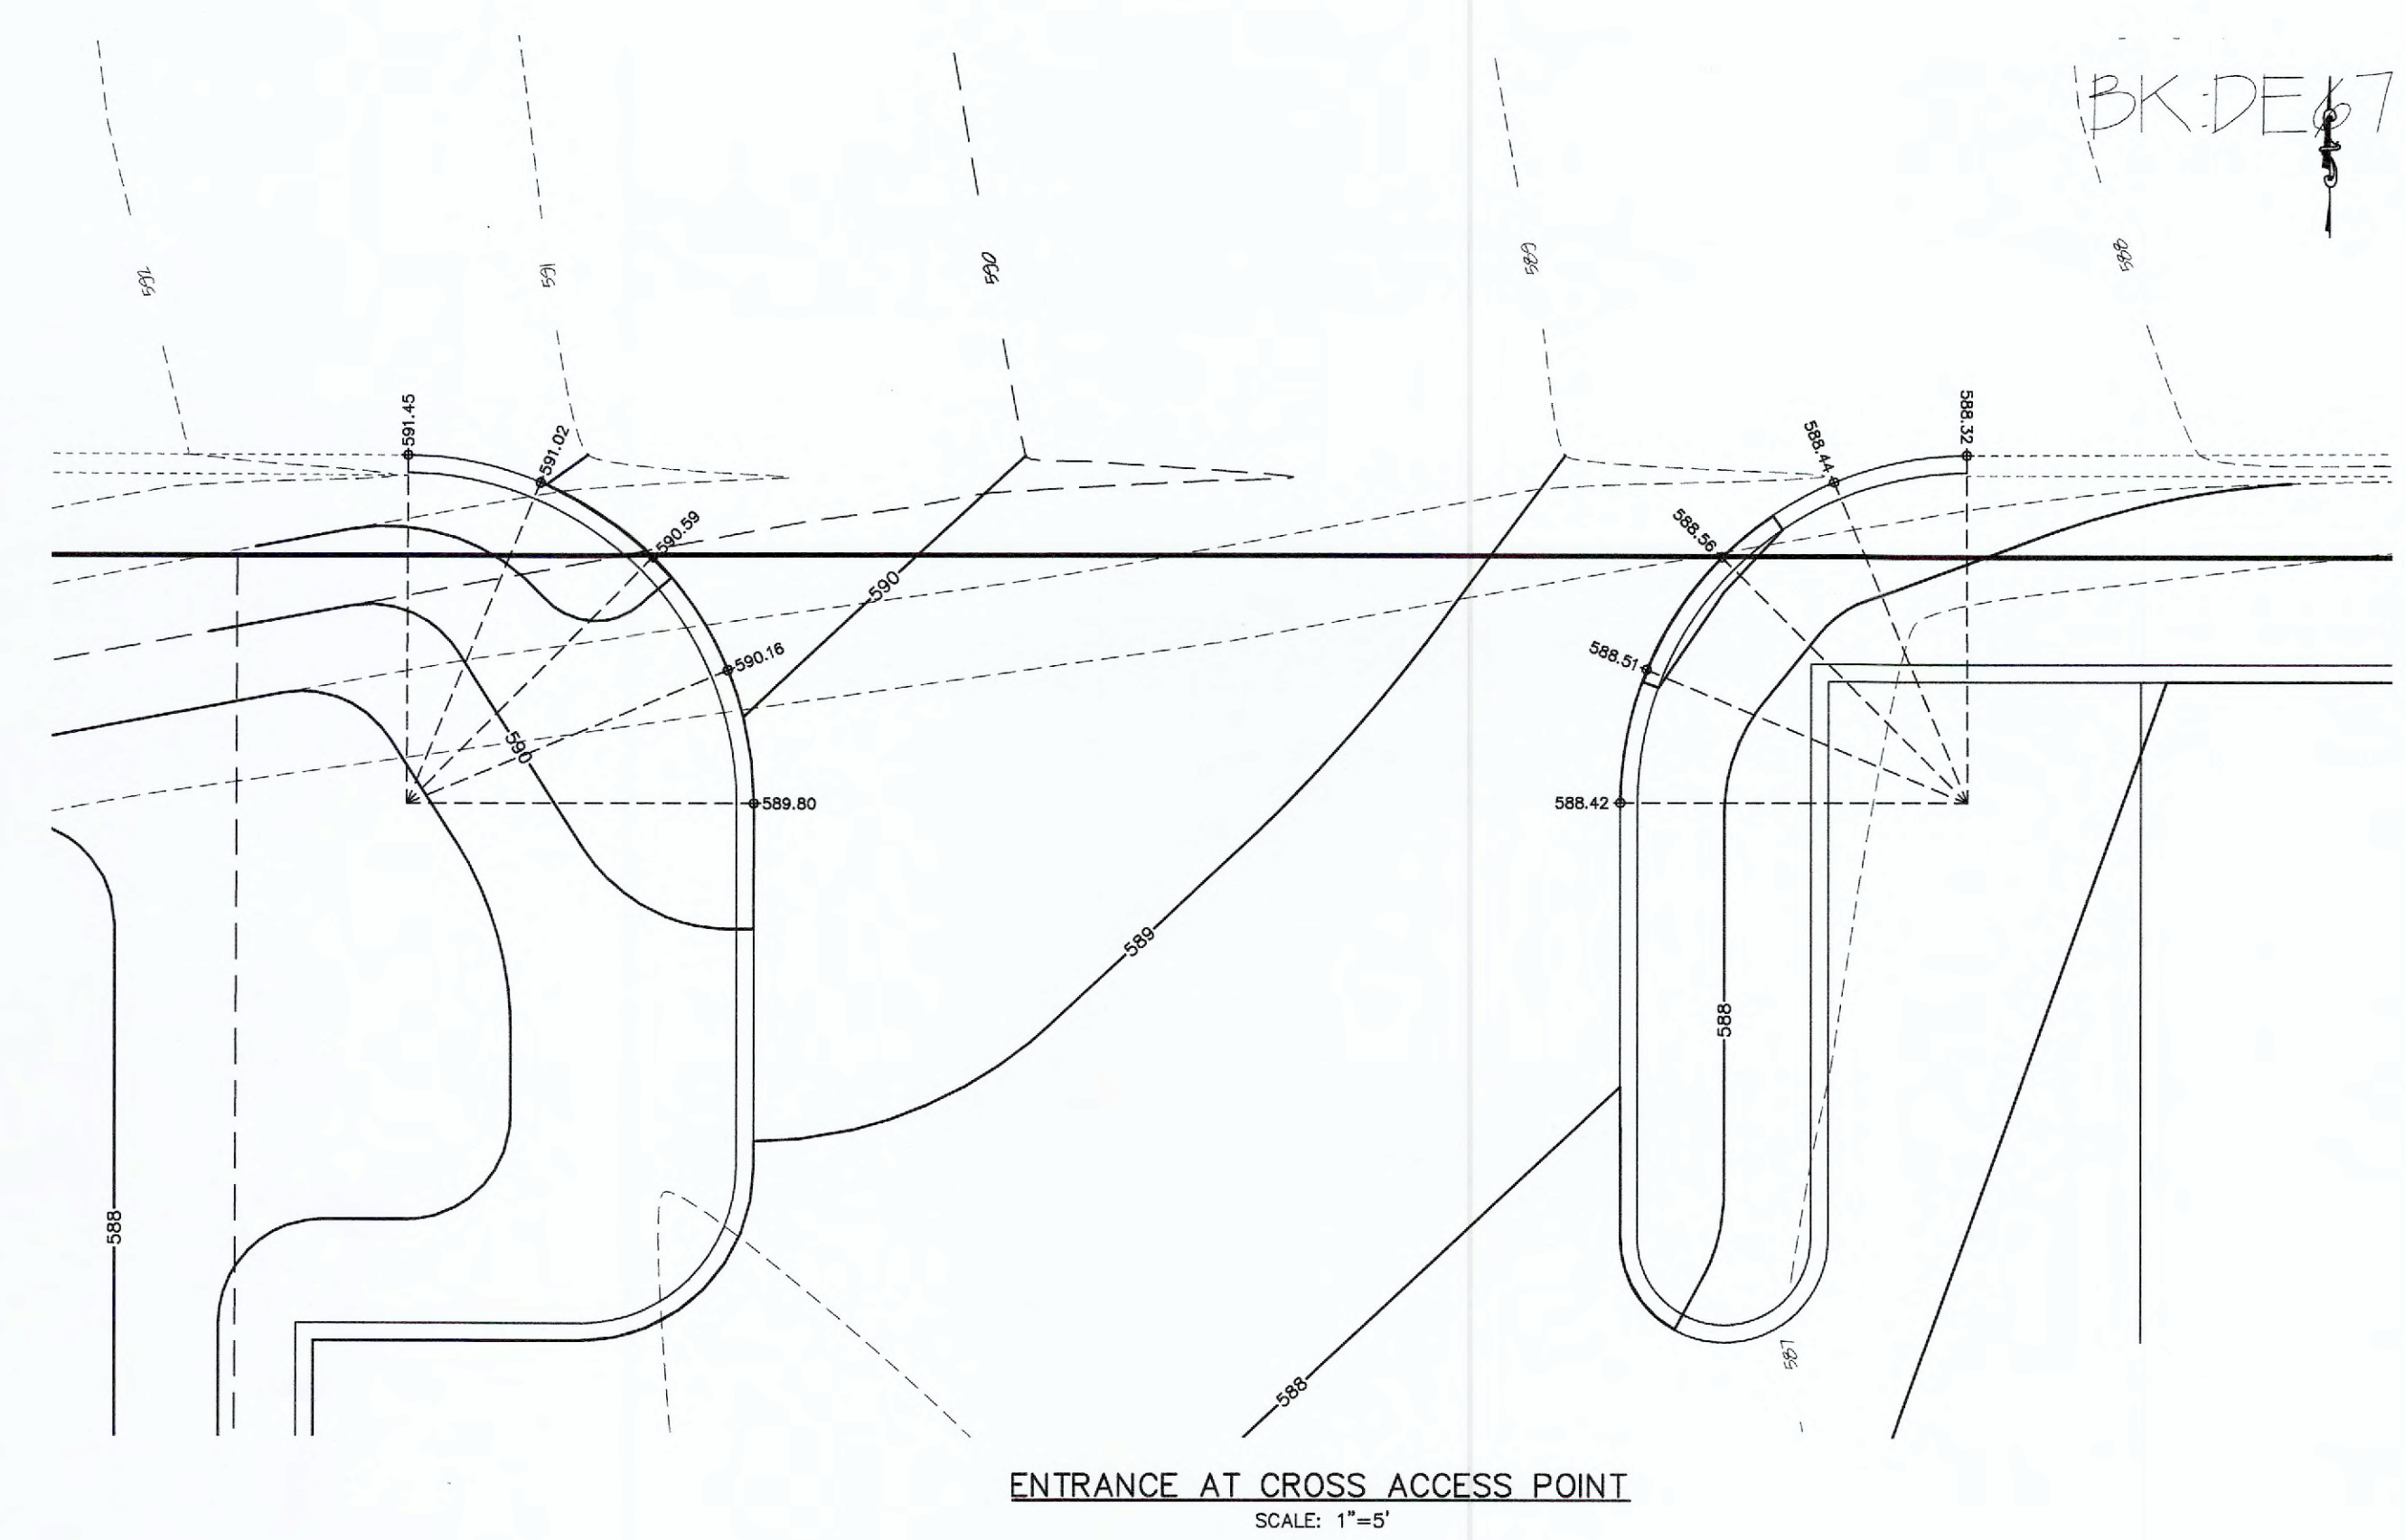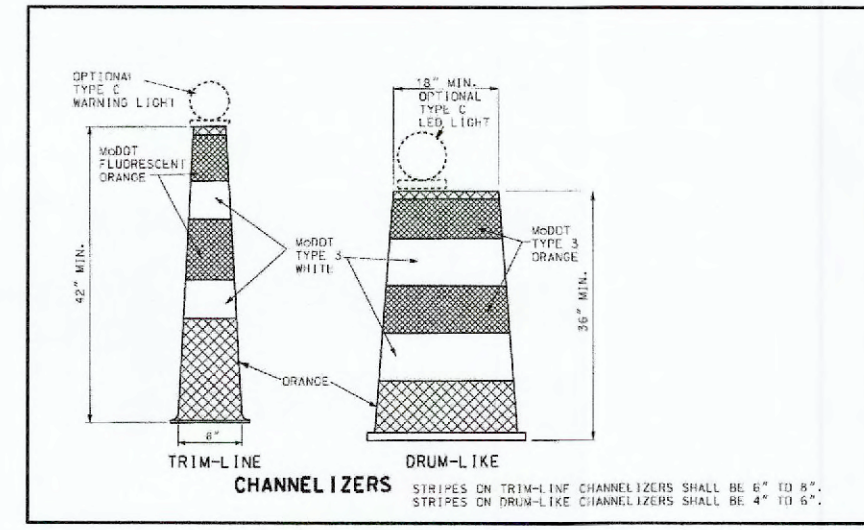

PROJECT TITLE:
EL TIO PEPE MEXICAN RESTAURANT
315 WEST TERRA LANE
O'FALLON, ST. CHARLES,
MISSOURI 63366

Box Project # 97-9851A Issue Date: 04/12/2017

ENGINEERING SURVEYING
221 Post West Blvd.
St. Charles, MO 63301
636-928-6502
FAX 928-1718

DISCLAIMER OF RESPONSIBILITY
I hereby specify that the documents intended to be authorized by my seal are limited to this sheet, and I hereby disclaim any responsibility for all other drawings, Specifications, Estimates, Reports or other documents or instruments relating to or intended to be used for any part or parts of the architectural or engineering project.

STATE OF MISSOURI
CLIFFORD L. HEITMANN
NUMBER E-29817
REGISTERED PROFESSIONAL CIVIL ENGINEER E29817

Copyright 2017
Box Engineering Company, Inc.
Engineering Authority No. 000655
Surveying Authority No. 000144
All Rights Reserved

REVISIONS	
09/19/17	CITY COMMENTS
10/04/17	CITY COMMENTS
08/08/19	AS-BUILT PLANS

Developer / Owner:
WR HOLMAN, LLC
2 HICKORY HILL DRIVE
O'FALLON, MISSOURI 63366
(636) 734-1815

ENTRANCE DETAILS

P+Z No.
33-14.01

CUP No.
33-14.01.01

Page No.
15 of 18

AS-BUILT WATERLINE PLAN

LAST SAVE: 8/17/2019 8:17:00 AM BY: BRYAN WARD
FILE LOCATION: \\s:\data\project\33-14.01\33-14.01-1815.dwg
PROJECT: 33-14.01-1815-AS-BUILT PLANS

STORM WATER POLLUTION PREVENTION PLAN

- A. PURPOSE:**
- The purpose of the Storm Water Pollution Prevention Plan (SWPPP) is to inform the Developer/Contractor of the following objectives they are required to meet:
- Prevent erosion where construction activities shall occur.
 - Prevent pollutants from mixing with storm water.
 - Prevent pollutants from being discharged by trapping them on-site, before they can affect the receiving waters.
 - All regulations of Missouri Department of Natural Resources are met.
 - All regulations of the Environmental Protection Agency are met.
 - All regulations of the local municipality are met.
- B. PROJECT DESCRIPTION:**
- The project is located in the Lower Dardenne Creek Watershed Boundary (071100090105) in O'Fallon, Missouri. The project disturbs approximately 0.22 acres.
- The project activities consist of the construction of ONE new building addition and associated parking lot. The site will be protected by the various erosion protection measures listed below:
- Siltation Control:** The entire perimeter of the project that allows storm water to exit will have siltation control installed. Details of these devices are depicted on the detail plans prepared by Box Engineering Company, Inc.
 - Revegetation:** The site will consist of varying ground slopes, upon completion of the grading activities the slope prone to erosion will be seeded and strowed to stabilize the slope and prevent erosion.
 - Bioretention area:** The site will have a bioretention area to treat stormwater runoff from the parking lot.
- C. MAINTENANCE AND INSPECTION:**
- Regular Maintenance:** Weekly inspections of the project will include: (a) The repair of any sediment (silt) fence and/or stacked straw bale barriers damaged or out of place; (b) The removal of any accumulated trash and/or debris; and (c) The removal of any externally deposited waste materials.
- Periodic Inspections:** Following each rain of more than 0.50 inch in 24 hours, the site will be inspected, and any necessary maintenance will be provided for a period of one year following the completion of the above remediation measures. Summaries of the maintenance and the inspections will be maintained and shall be kept available from the owner. An inspection report shall be filed on site for every inspection. The report shall detail the findings of the inspection and if any action was required. The inspection form needs to include, name of the site, name of the inspector, permit number, date of inspection, major observations and actions taken to correct problems and the signature of the inspector. The inspection reports need to be kept on file by the permittee for three years after the project is completed.
- The field inspections will be conducted in a systematic manner to minimize the possibility of any significant feature being overlooked. A detailed checklist will be developed and followed for the examination. Particular attention will be given to detecting evidence of erosion, slope instability, undue settlement, displacement, and tilting. Photographs and drawings will be used freely to record conditions in order to minimize descriptions. The field inspection will include appropriate features and items, including potential hazards to human life or property.
- The condition of the slopes and vegetative cover will be evaluated and examined for erosion.
- Measures will be taken to promote the growth of vegetation and repair of damage caused by erosion and sedimentation. The inspection will also provide recommendations for measures that need to be undertaken immediately, based on the experience and judgment of the inspector. Necessary follow up inspections will be made as necessary to verify that any maintenance, alteration, or repair measures are accomplished by methods acceptable by standard engineering practice.

Table 60-5 Soil Stabilization Schedule

Soil Disturbance Activity or Condition	Required Stabilization Time
Soil disturbance has ceased in areas greater than 2,000 square feet.	14 days
After construction of dikes, swales, diversions, and other concentrated flow areas.	5 days
When slopes are steeper than 3 horizontal to 1 vertical.	7 days
When slopes are greater than 3% and longer than 150 feet.	14 days
Perimeter controls around soil stockpiles.	End of workday
Stabilization or covering of inactive stockpiles.	30 days
When land disturbance is completed, permanent soil stabilization must be installed.	30 days



SPILL AND SITE POLLUTION:

Should an accidental spill occur refer to material safety data sheets. Any spills of hazardous materials in quantities in excess of reportable quantities as defined by EPA or the state agency regulations, shall be immediately reported to the EPA National Response Center (800-424-8802) and Missouri Department of Natural Resources (573-634-2436). Reportable spills for petroleum products is greater than 50 gallons. All other reportable hazardous materials and their quantities may be found on the web site at <http://www.dnr.mo.gov> on the local number is 573-640-9750. Federal law requires the responsible party to report any release of oil if it reaches or threatens a sewer, lake, creek, stream, river, groundwater, wetlands, or area like a

An emergency spill kit is required to be onsite for all potential spills.

VEGETATION ESTABLISHMENT For Urban Development Sites APPENDIX A

- SEEDING RATES:**
- PERMANENT:**
 Tall Fescue - 30 lbs./ac.
 Smooth Brome - 20 lbs./ac.
 Combined - Fescue @ 15 lbs./ac. AND Brome @ 10 lbs./ac.
- TEMPORARY:**
 Wheat or Rye - 150 lbs./ac. (3.5 lbs. per s.f.)
 Oats - 120 lbs./ac. (2.75 lbs. per s.f.)
- SEEDING PERIODS:**
 Fescue or Brome - March 1 to June 1
 August 1 to October 1
 Wheat or Rye - March 15 to November 1
 Oats - March 15 to September 15
- MULCH RATES:**
 100 lbs. per 1000 sq. ft. (4,356 lbs. per ac.)
- FERTILIZER RATES:**
 Nitrogen 30 lbs./ac.
 Phosphate 30 lbs./ac.
 Potassium 30 lbs./ac.
 Lime 600 lbs./ac. ENM*
- * ENM = effective neutralizing material as per State evaluation of quarried rock.

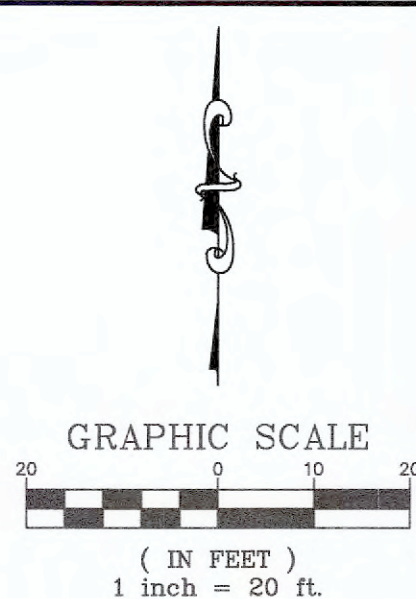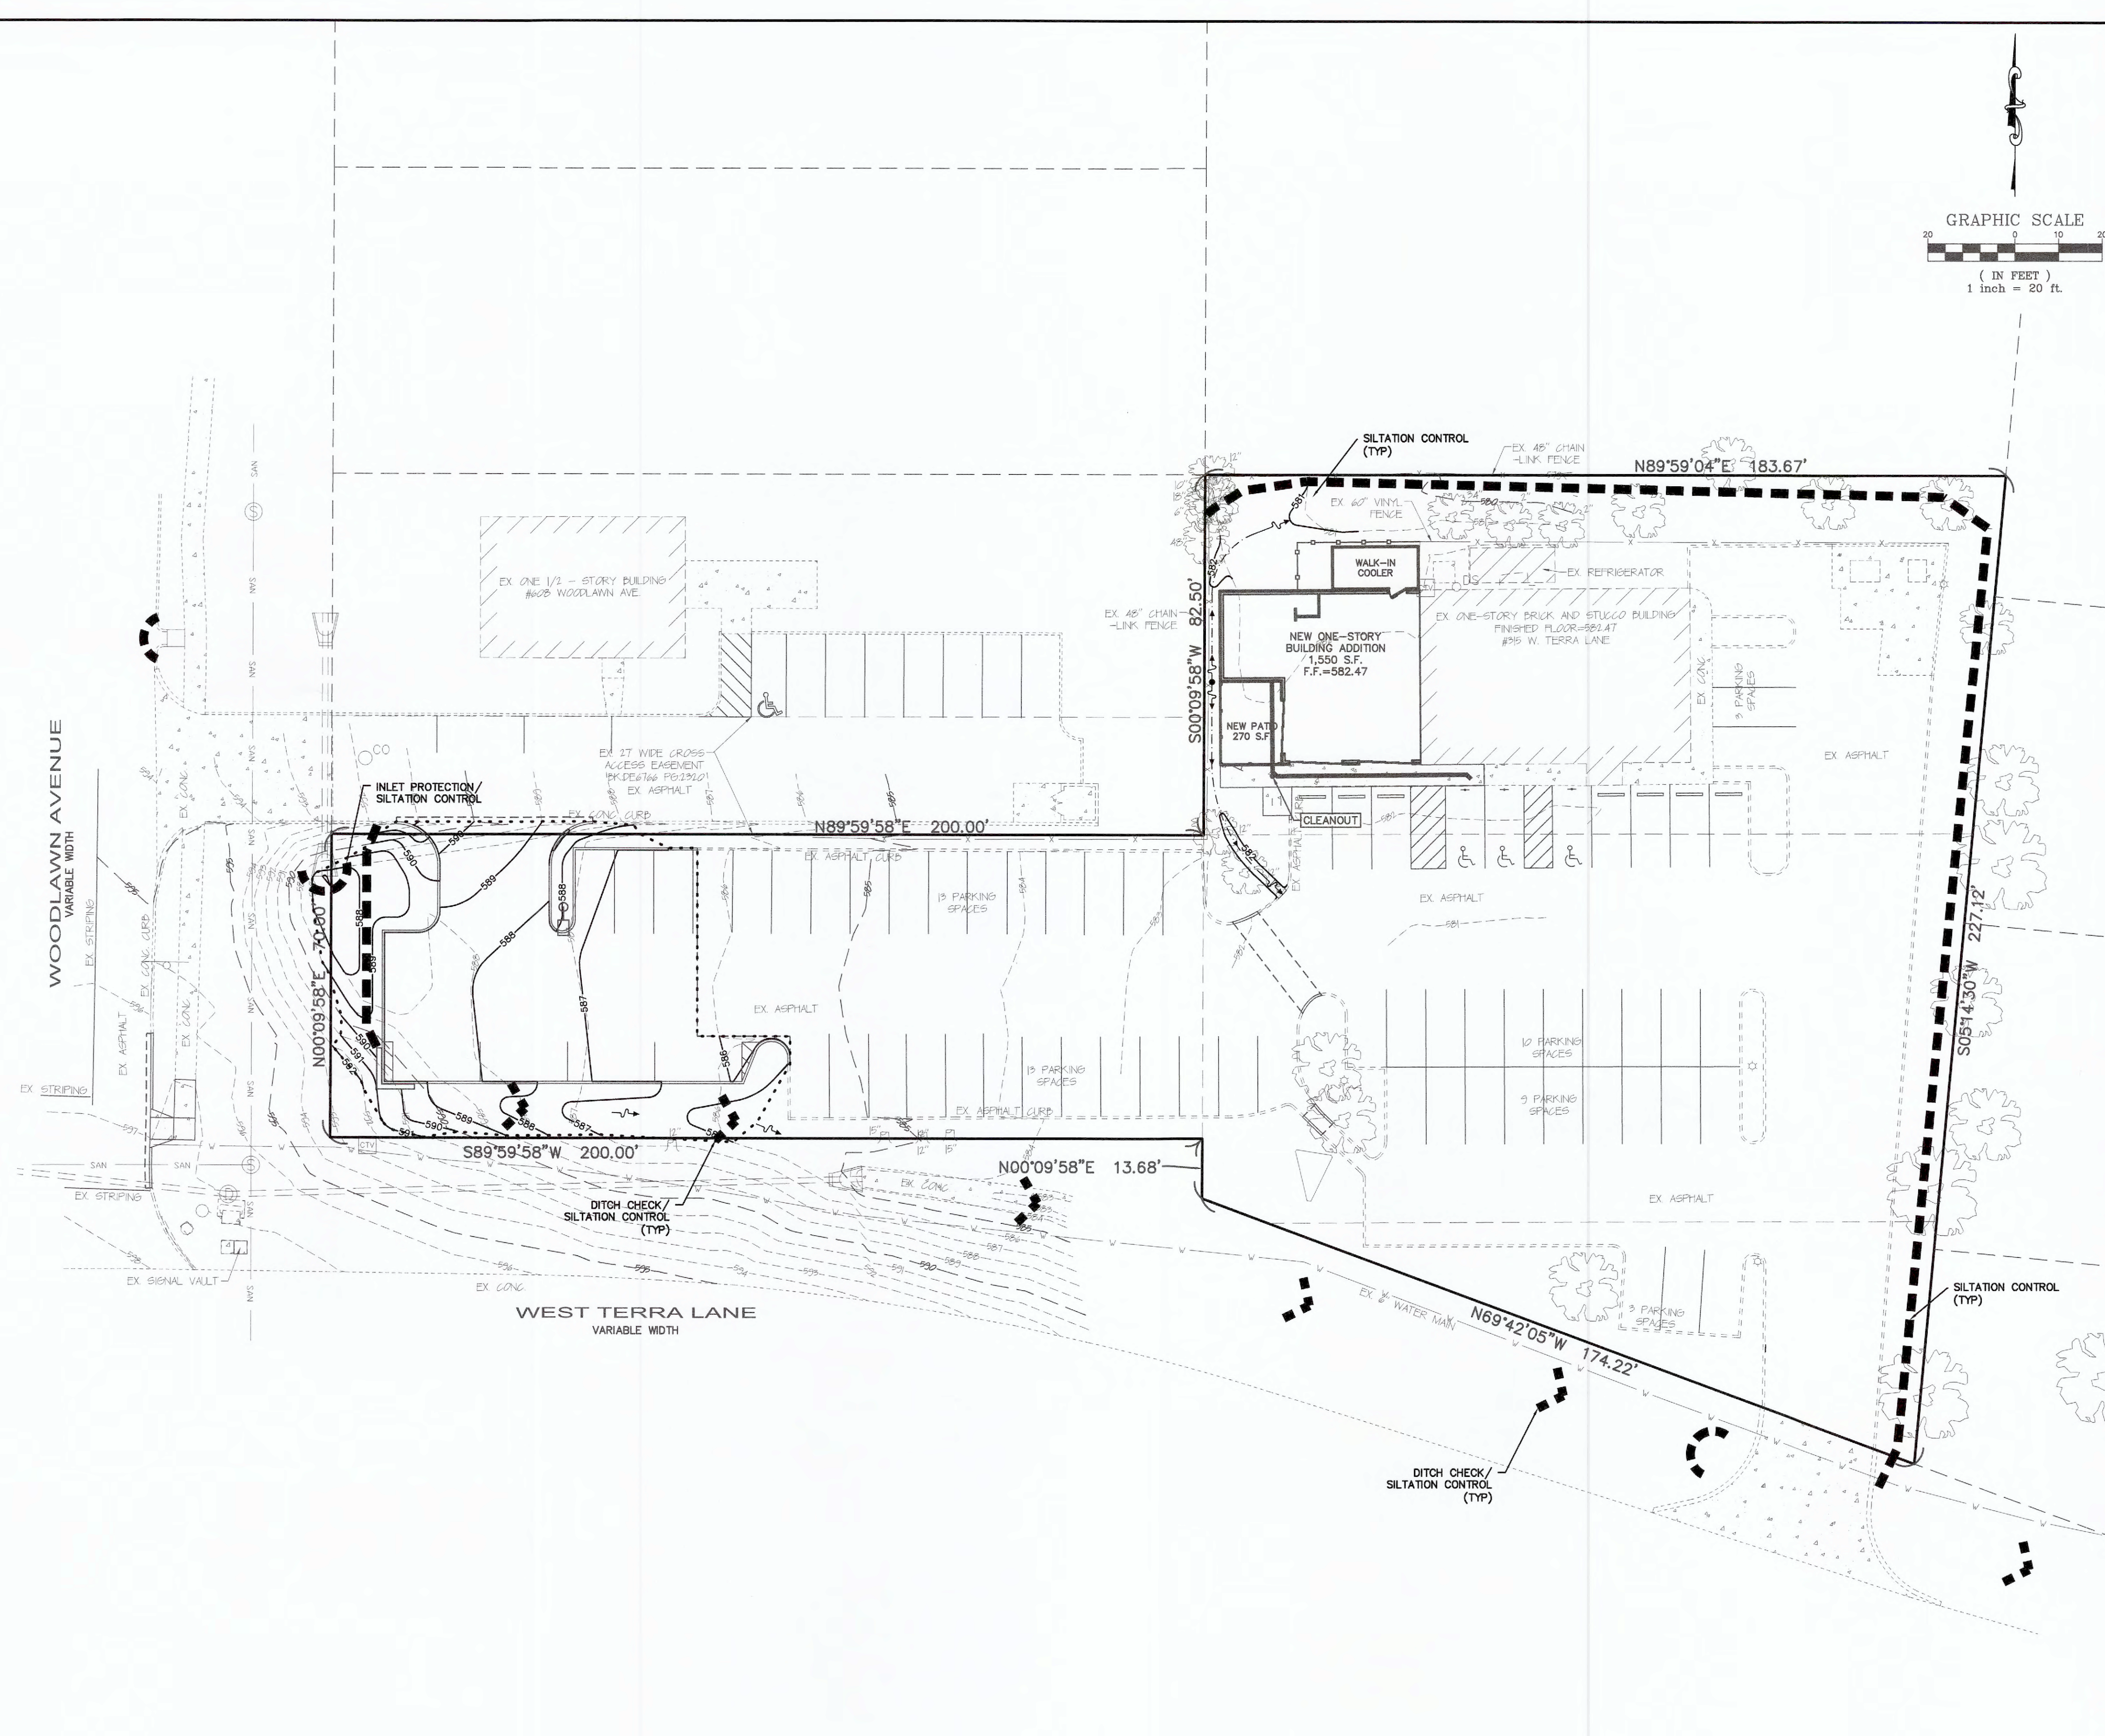

PROJECT TITLE:
 EL TIO PEPE MEXICAN RESTAURANT
 315 WEST TERRA LANE
 O'FALLON, ST. CHARLES, MISSOURI 63366

Box Project # 87-8851A Issue Date 04/12/2017

ENGINEERING PLANNING SURVEYING

221 Point West Blvd.
 St. Charles, MO 63301
 636-928-6552
 FAX 636-928-1718

DISCLAIMER OF RESPONSIBILITY
 I hereby certify that the documents intended to be authorized by my seal are limited to this sheet, and I hereby disclaim any responsibility for all other drawings, specifications, estimates, reports or other documents or instruments relating to or intended to be used for any part or parts of the architectural or engineering project or projects.

STATE OF MISSOURI
 REGISTERED PROFESSIONAL ENGINEER
 CLIFFORD L. HEITMANN
 NUMBER E-29817

Copyright 2017
 Box Engineering Company, Inc.
 Engineering Authority No. 000655
 Surveying Authority No. 000144
 All Rights Reserved

REVISIONS

DATE	REVISION
09/19/17	CITY COMMENTS
10/04/17	CITY COMMENTS
08/08/19	AS-BUILT PLANS

Developer / Owner:
 WR HOLMAN, LLC
 2 HICKORY HILL DRIVE
 O'FALLON, MISSOURI 63366
 (636) 734-1815

SWPPP

P+Z No.
33-14.01

CUP No.
33-14.01.01

Page No.
16 of 18

AS-BUILT WATERLINE PLAN

MISSOURI ONE CALL SYSTEM
 800-451-4646
 STOP CALL BEFORE YOU DIG

CALL BEFORE YOU DIG!
 1-800-DIG-RITE

UNDERGROUND UTILITIES HAVE BEEN PLOTTED FROM AVAILABLE INFORMATION AND THEREFORE THEIR LOCATIONS SHALL BE CONSIDERED APPROXIMATE ONLY. THE VERIFICATION OF THE LOCATION OF ALL UNDERGROUND UTILITIES, EITHER SHOWN OR NOT SHOWN ON THESE PLANS SHALL BE THE RESPONSIBILITY OF THE CONTRACTOR, AND SHALL BE LOCATED PRIOR TO ANY GRADING OR CONSTRUCTION OF THE IMPROVEMENTS.

