

AS-BUILTS ADDED OCTOBER 2005



PROPERTY N/F
GILBERT &
MAE ROSE PRIZE
2223/1285

PROPERTY N/F
DOUGLAS & MARY PRIZE
BK.1212/PG.1505

AS-BUILT SITE PLAN
**THE ENCLAVE AT
DEER CREEK**

02-11841 OCTOBER 2005

SECTION 13
SECTION 24

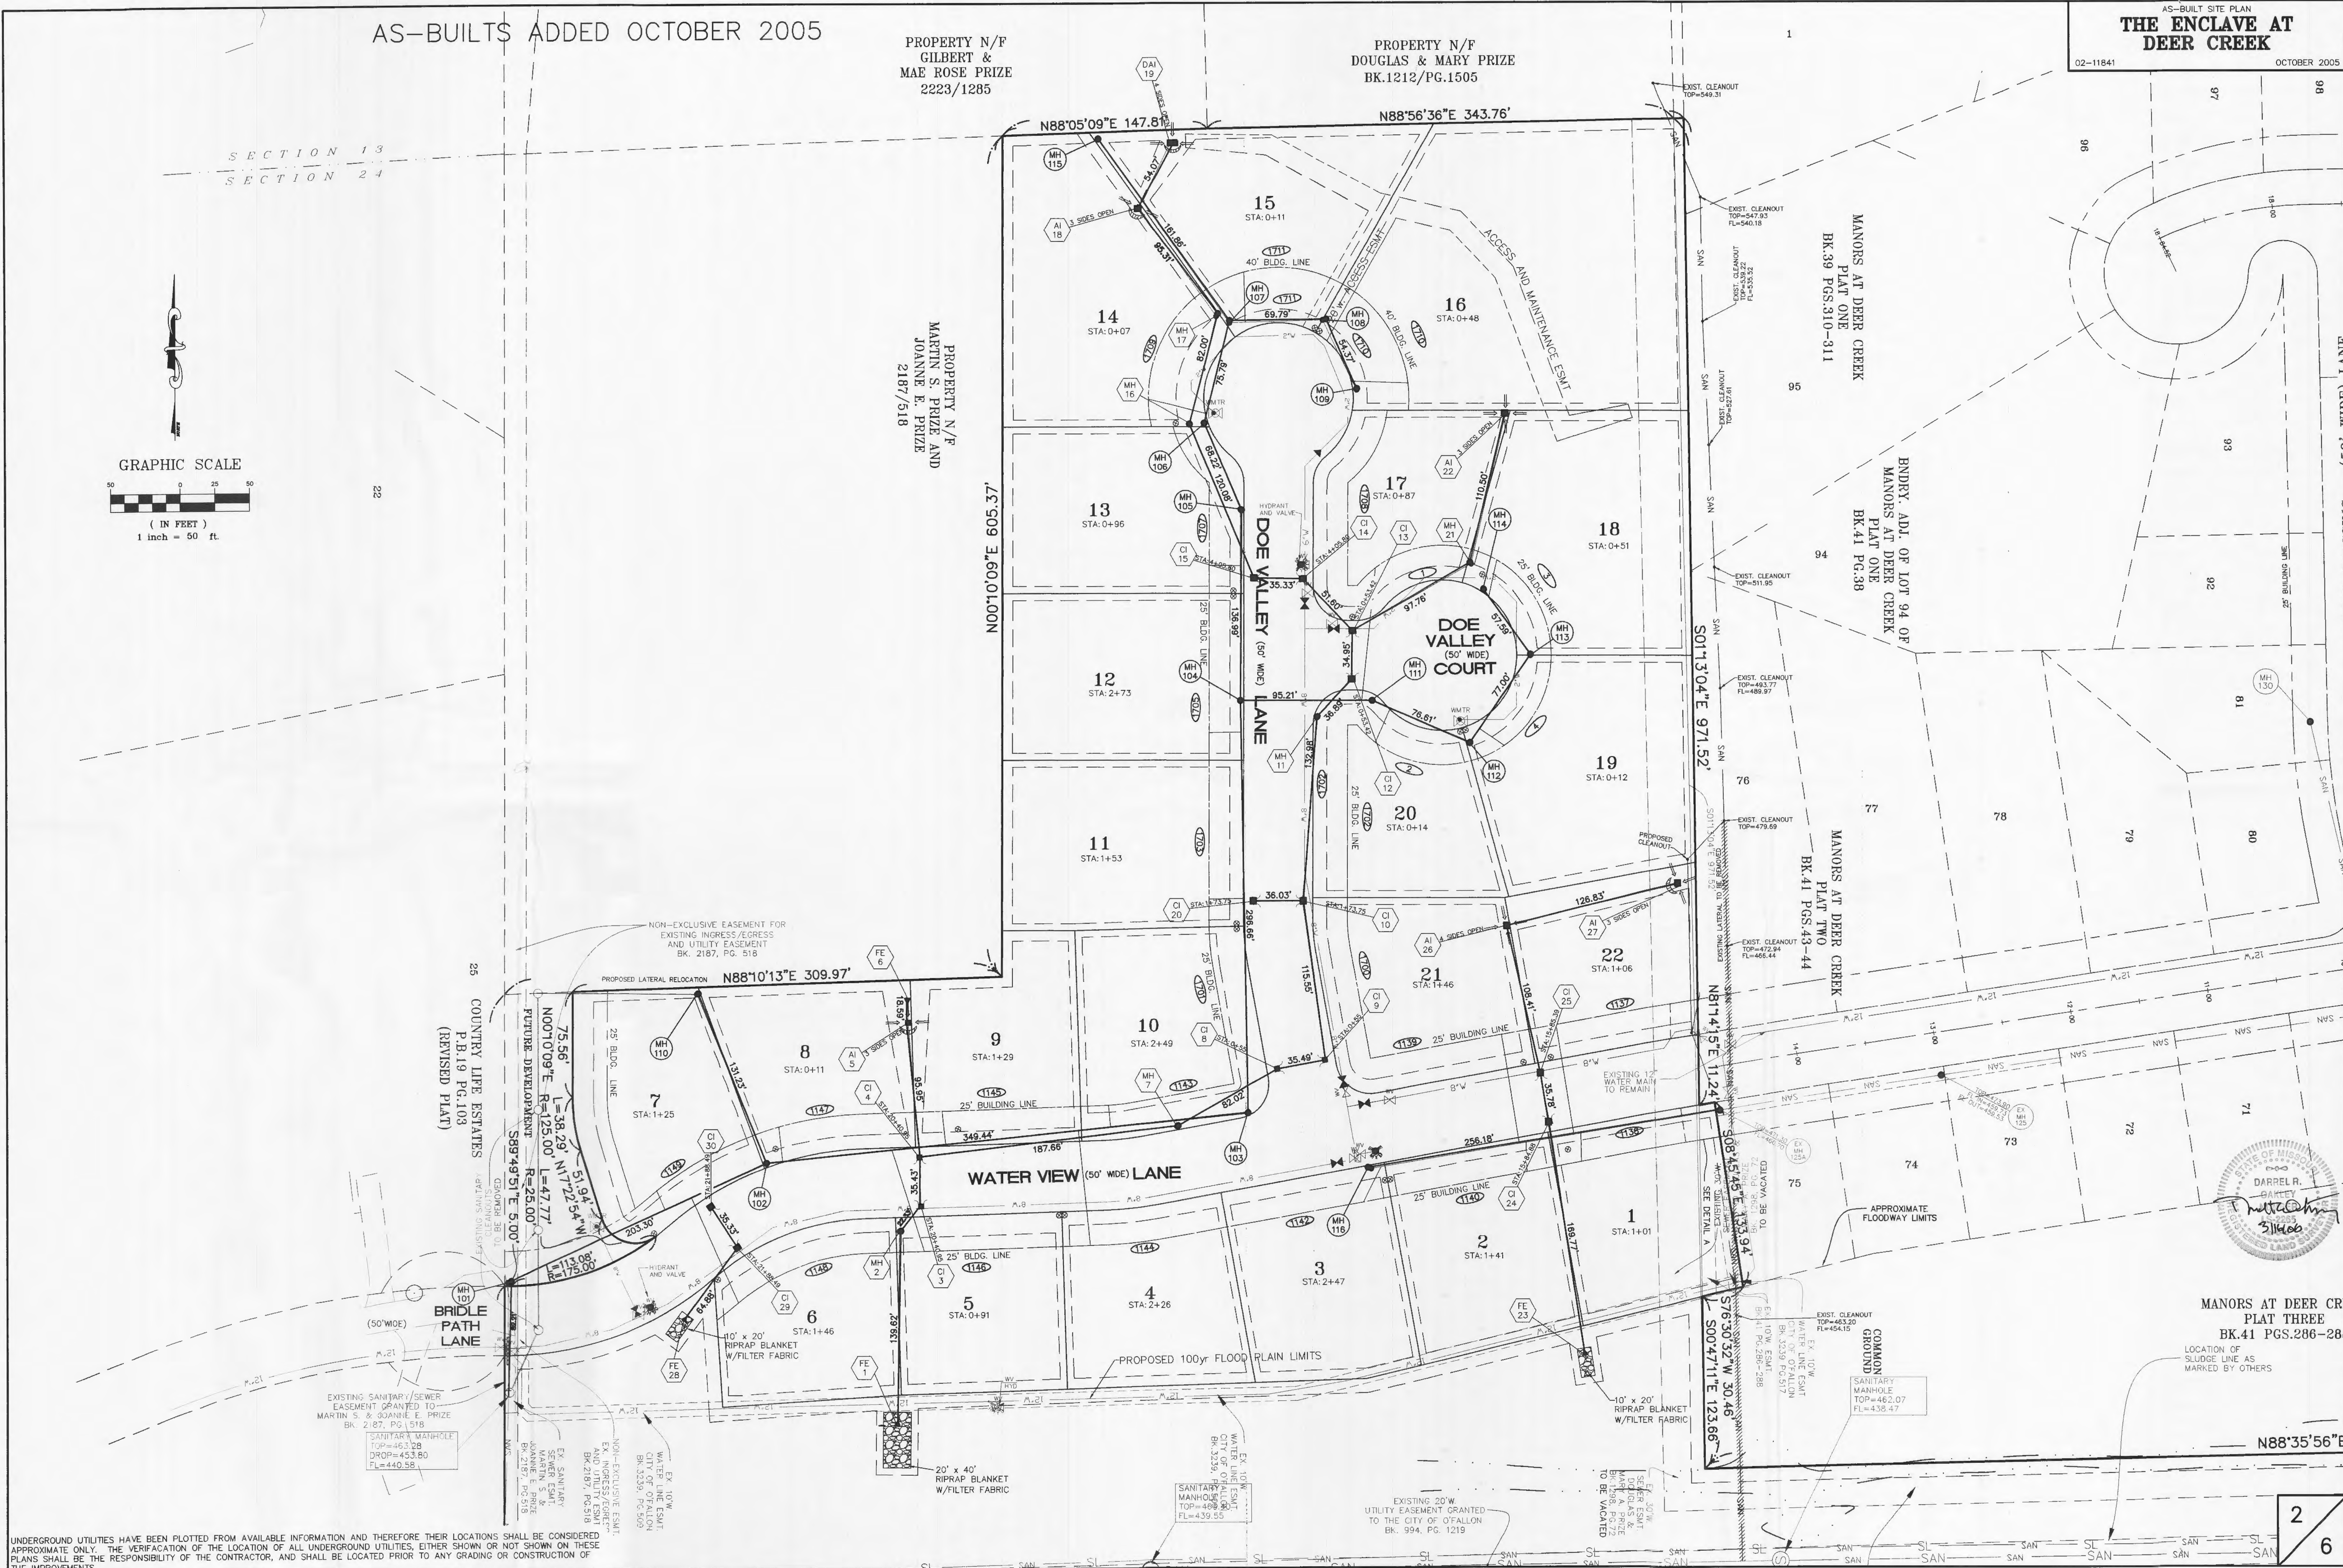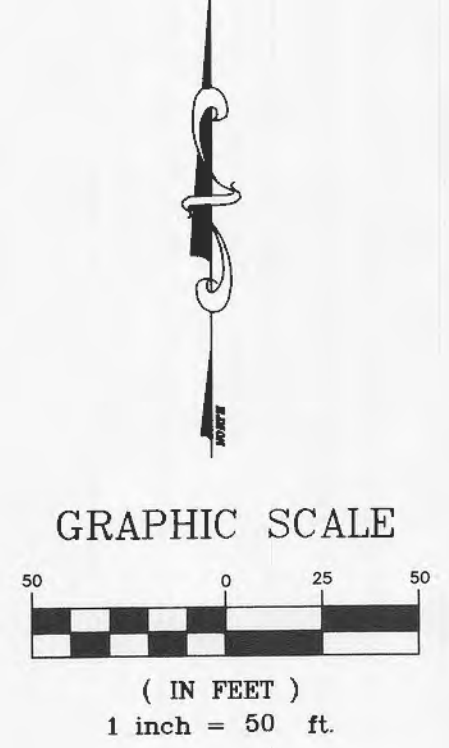

MANORS AT DEER CREEK
PLAT THREE
BK.41 PGS.286-288

LOCATION OF
SLUDGE LINE AS
MARKED BY OTHERS

2
6

UNDERGROUND UTILITIES HAVE BEEN PLOTTED FROM AVAILABLE INFORMATION AND THEREFORE THEIR LOCATIONS SHALL BE CONSIDERED APPROXIMATE ONLY. THE VERIFICATION OF THE LOCATION OF ALL UNDERGROUND UTILITIES, EITHER SHOWN OR NOT SHOWN ON THESE PLANS SHALL BE THE RESPONSIBILITY OF THE CONTRACTOR, AND SHALL BE LOCATED PRIOR TO ANY GRADING OR CONSTRUCTION OF THE IMPROVEMENTS.

E:\DWG\A11500PLUS\11841-PRIZETRACK\Survey\asbuilts\11841ASB.dwg, SitePlan SHE2, 3/16/2006 3:44:04 PM, Sta 75 SZ


AS-BUILT SITE PLAN
THE ENCLAVE AT DEER CREEK

02-11841 OCTOBER 2005

MANORS AT DEER CREEK
 PLAT THREE
 BK.41 PGS.286-288

WETLAND AREA

WATER LEVEL WILL FLUCTUATE WITH THE SEASONS.

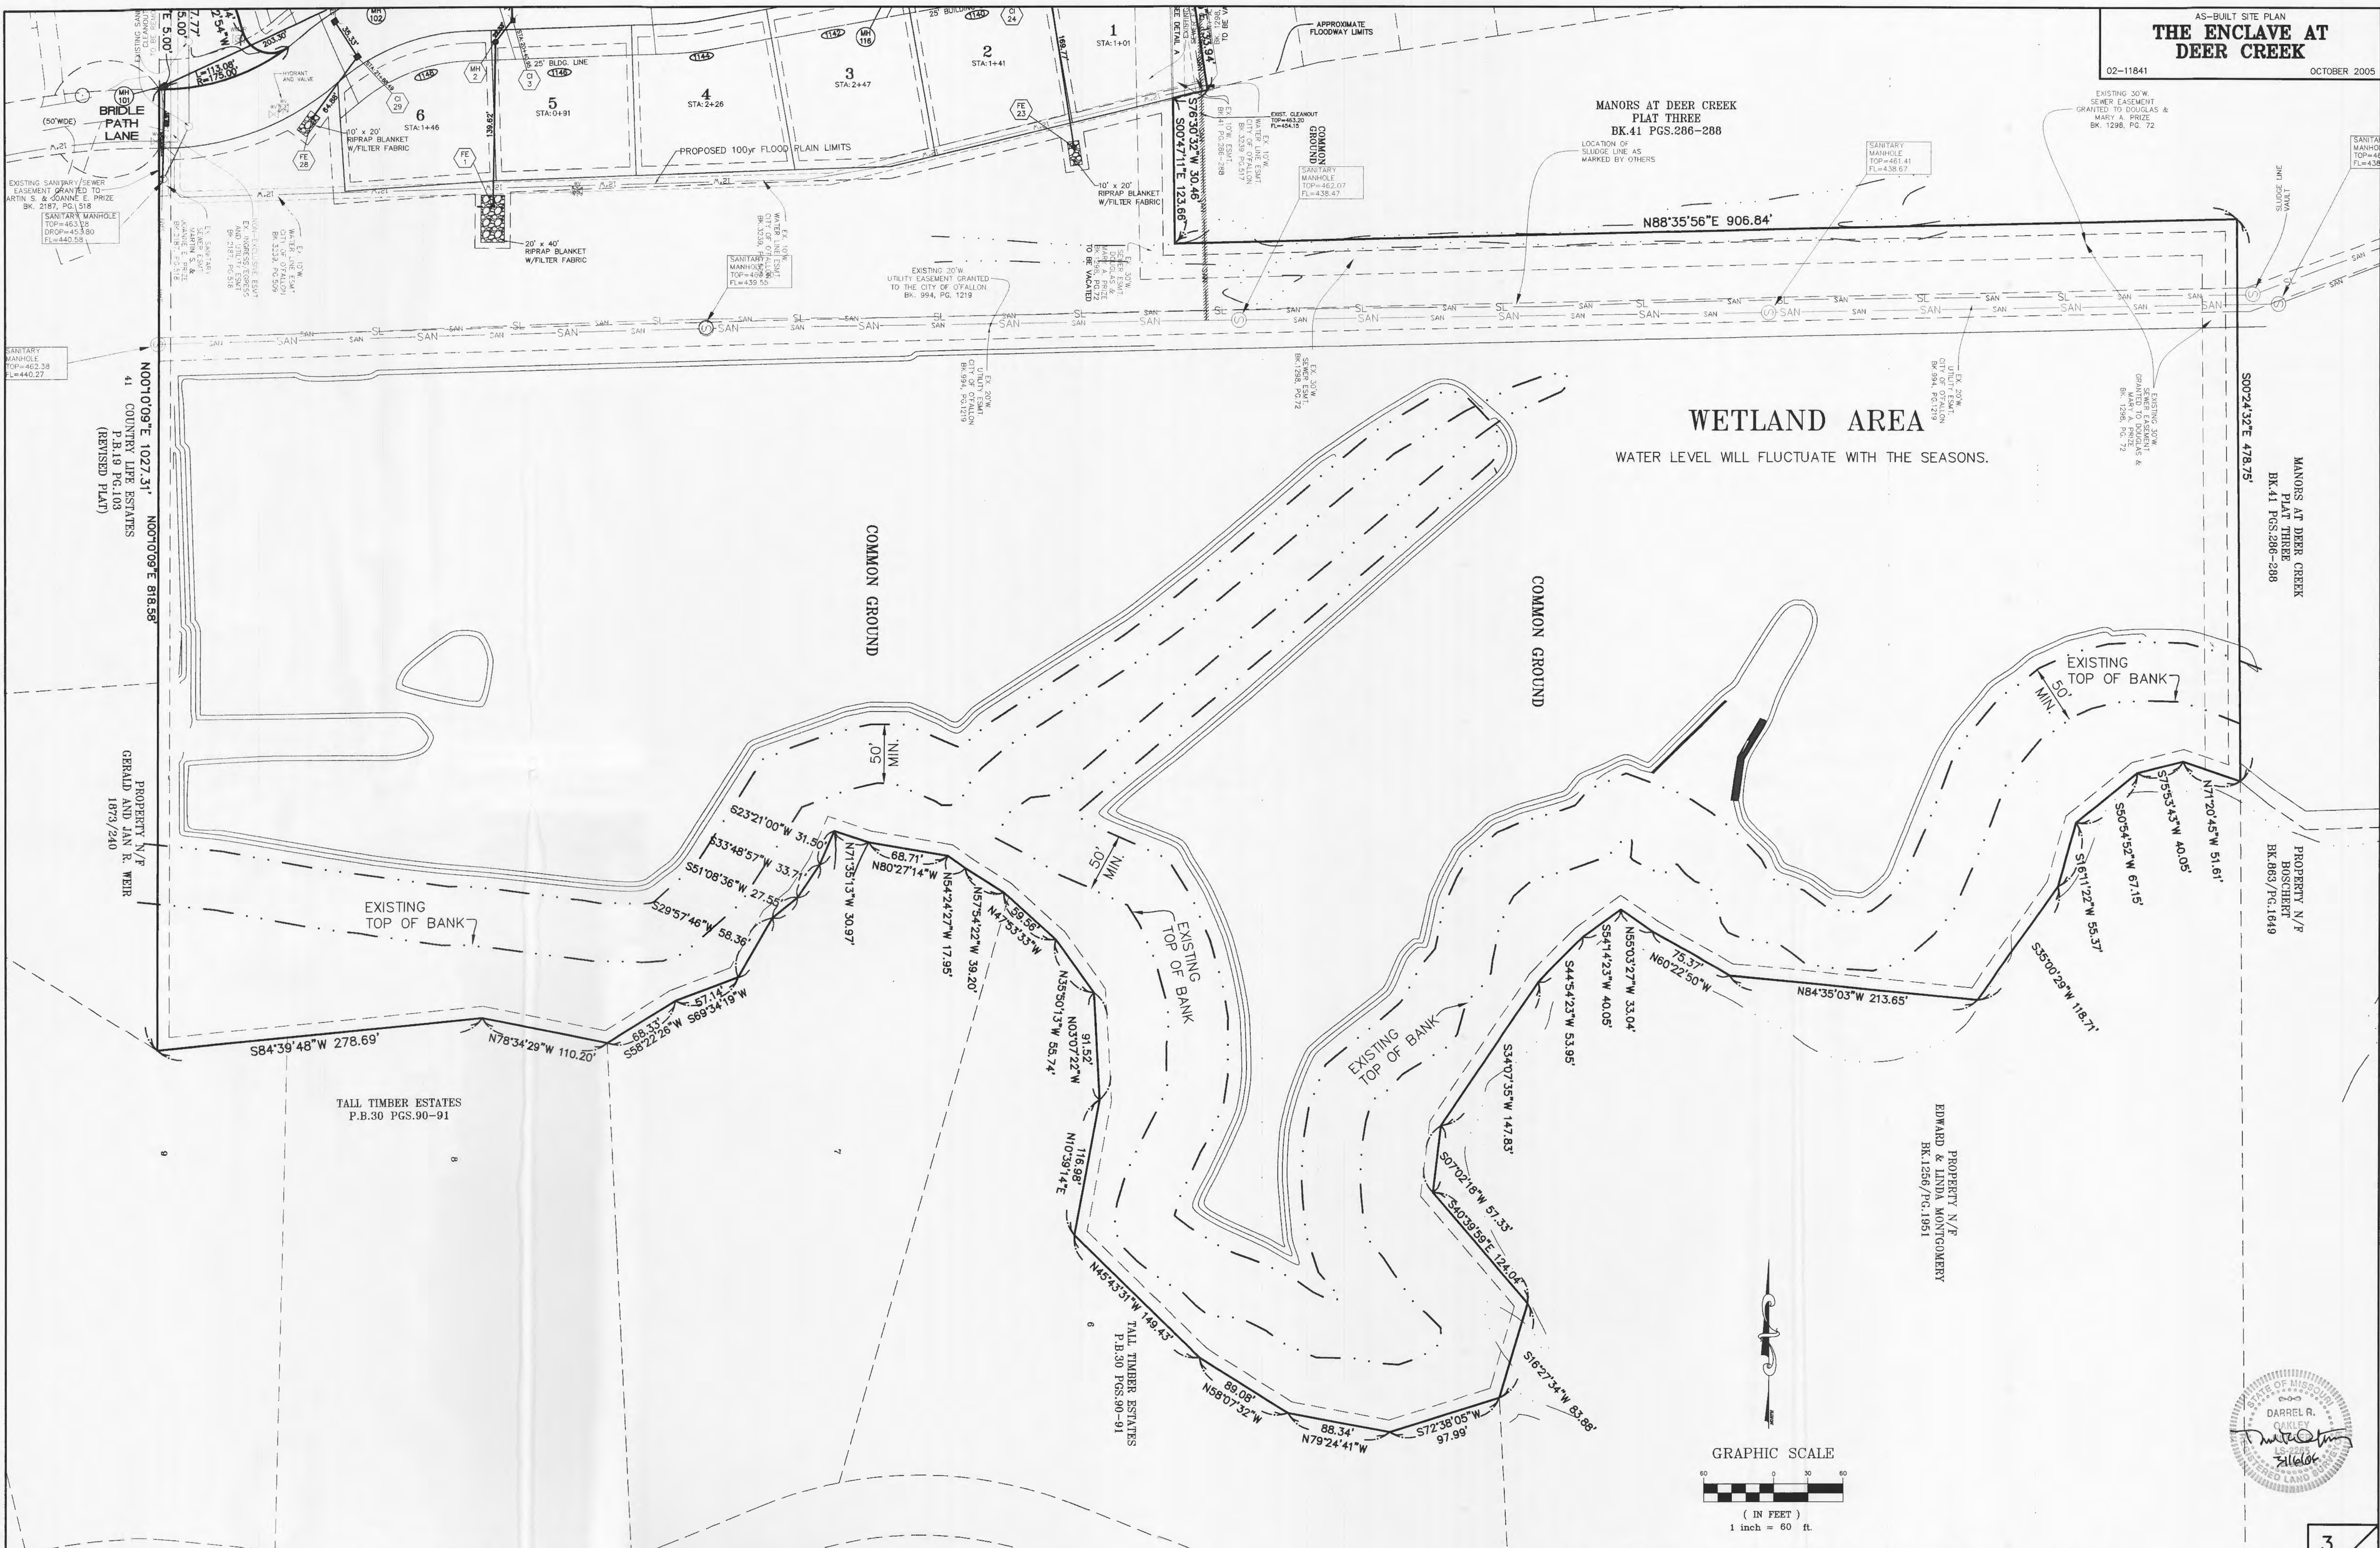


UNDERGROUND UTILITIES HAVE BEEN PLOTTED FROM AVAILABLE INFORMATION AND THEREFORE THEIR LOCATIONS SHALL BE CONSIDERED APPROXIMATE ONLY. THE VERIFICATION OF THE LOCATION OF ALL UNDERGROUND UTILITIES, EITHER SHOWN OR NOT SHOWN ON THESE PLANS SHALL BE THE RESPONSIBILITY OF THE CONTRACTOR, AND SHALL BE LOCATED PRIOR TO ANY GRADING OR CONSTRUCTION OF THE IMPROVEMENTS.

AS-BUILTS ADDED OCTOBER 2005



AS-BUILT SANITARY SEWER PROFILES
THE ENCLAVE AT DEER CREEK

02-11841 OCTOBER 2005

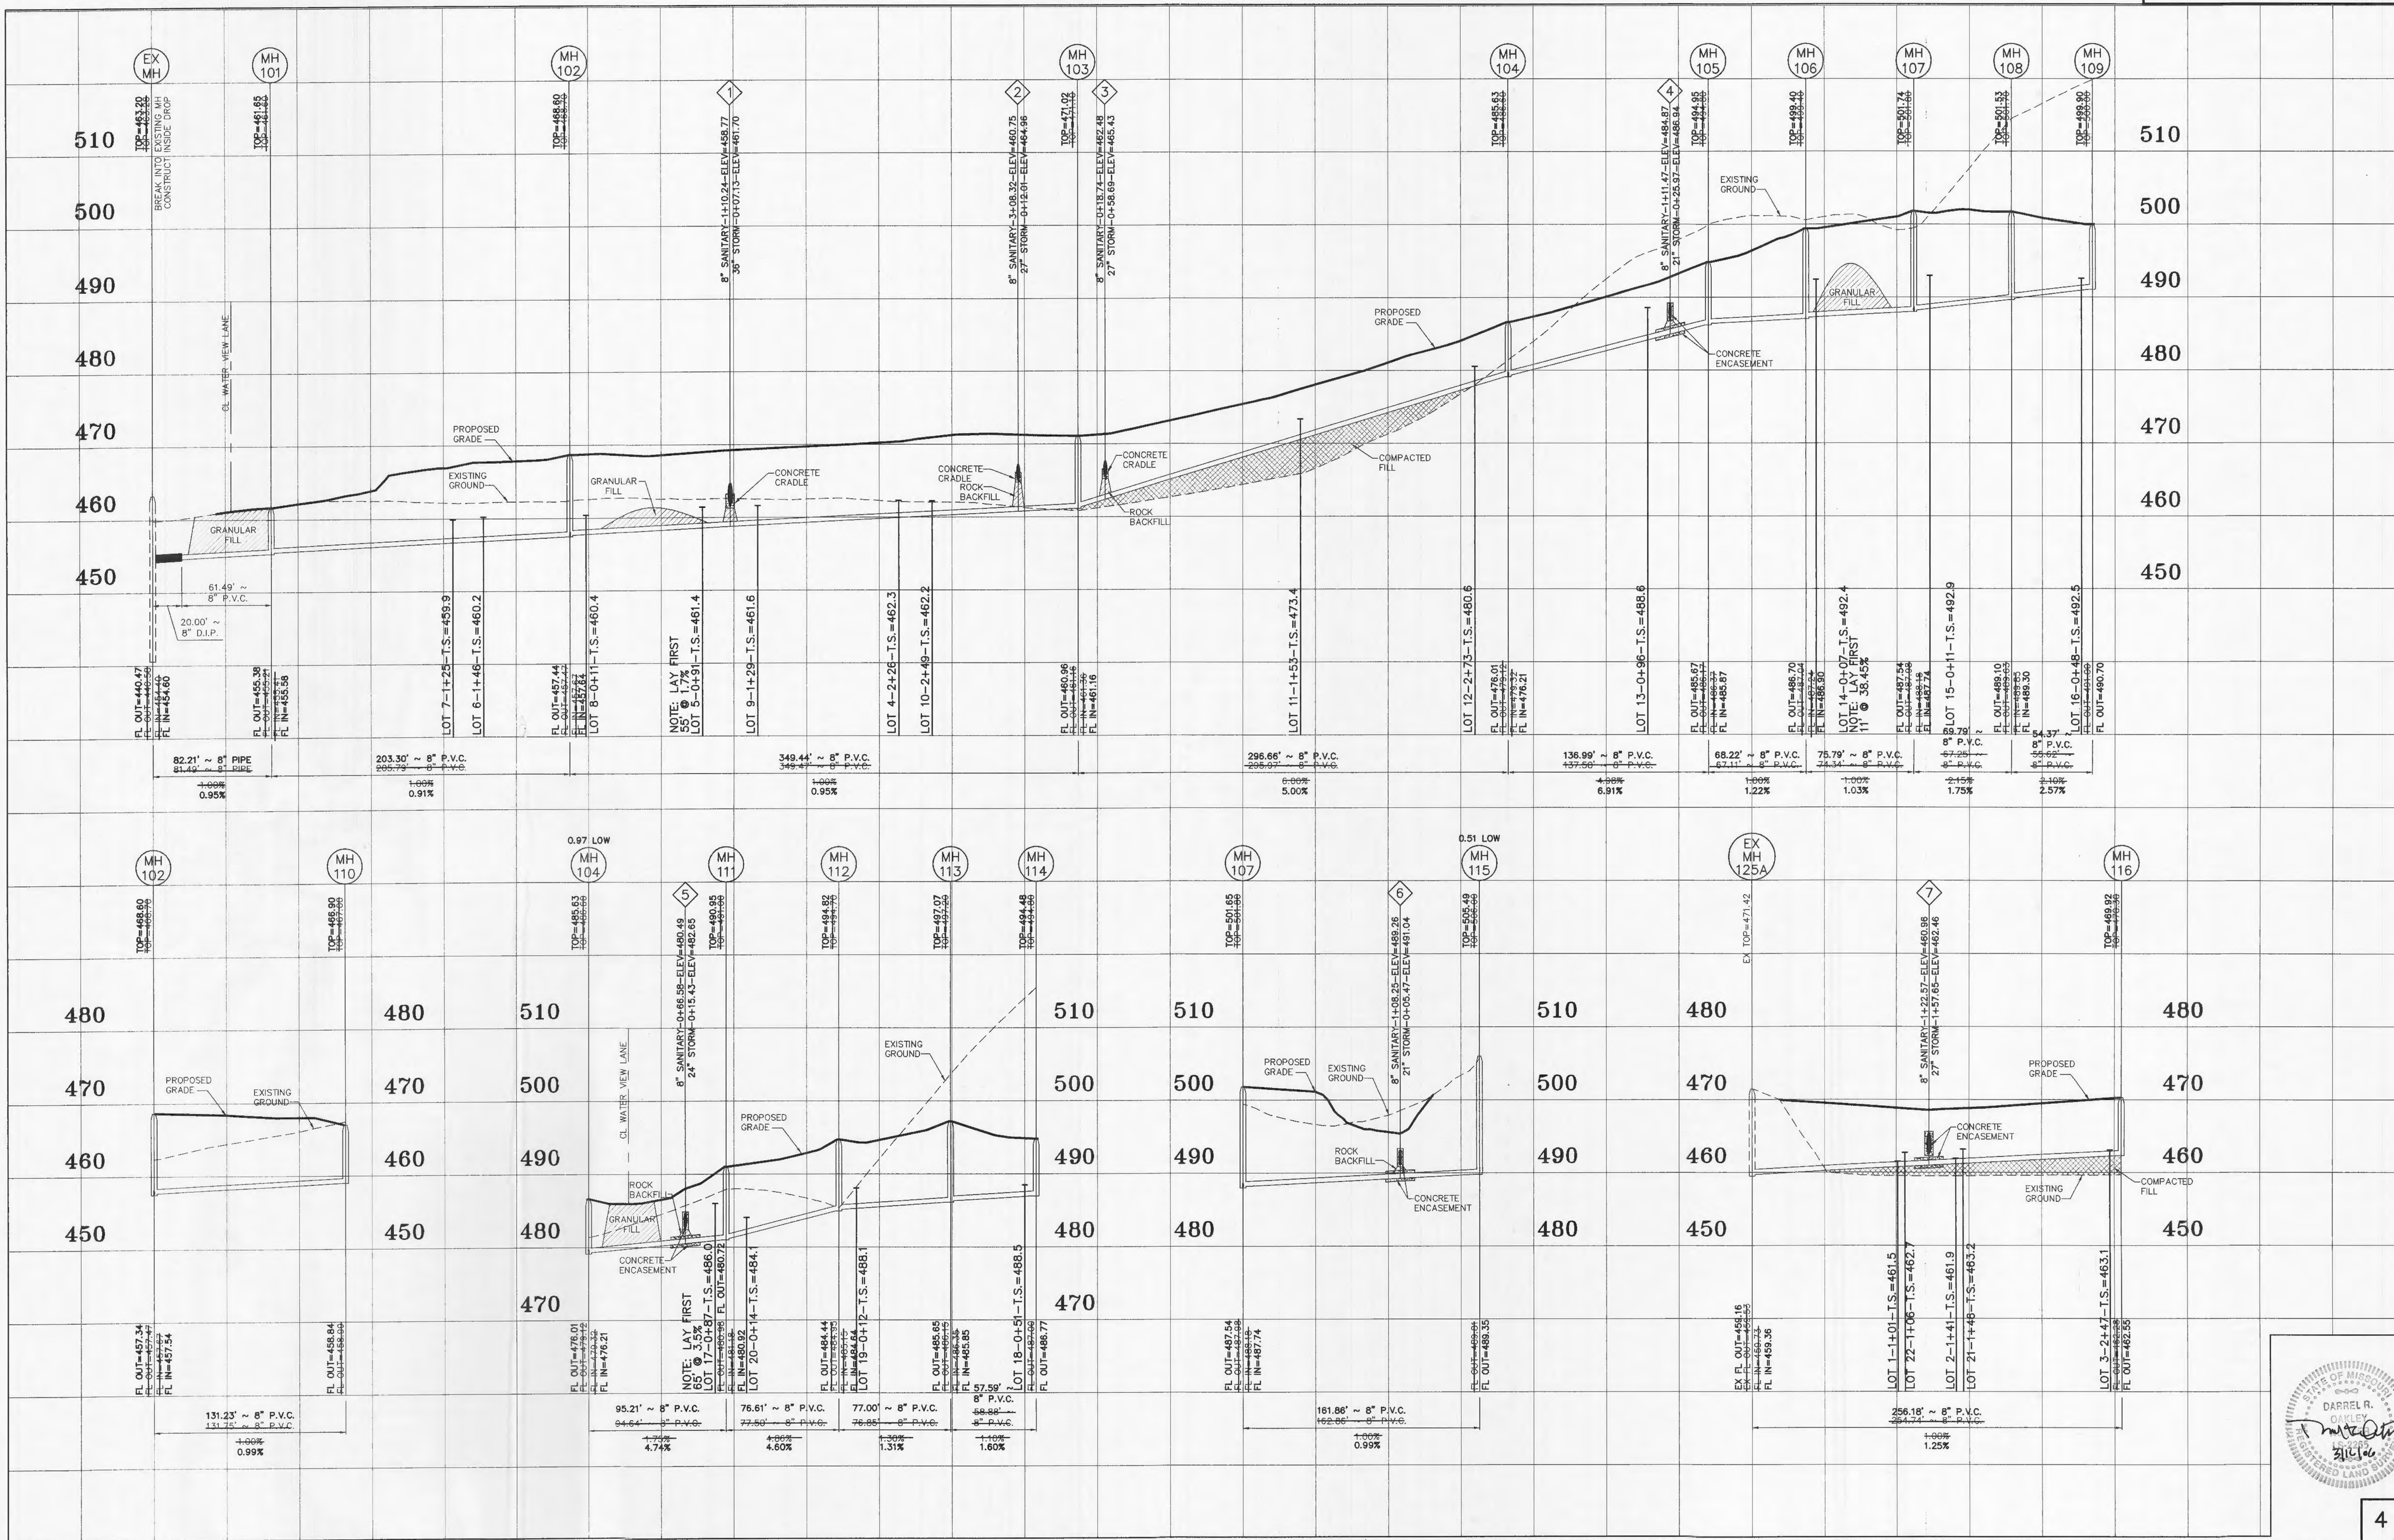

AS-BUILTS ADDED OCTOBER 2005

ALL SANITARY SEWER LATERAL TAILSTAKE ELEVATIONS HAVE BEEN DESIGNED FOR AN 8' BASEMENT FOUR IN HOMES WITH THE TOP OF FOUNDATION ELEVATION BEING SET A MINIMUM OF 2.5' ABOVE THE TOP OF CURB ELEVATION AT THE DRIVEWAY.

UNDERGROUND UTILITIES HAVE BEEN PLOTTED FROM AVAILABLE INFORMATION AND THEREFORE THEIR LOCATIONS SHALL BE CONSIDERED APPROXIMATE ONLY. THE VERIFICATION OF THE LOCATION OF ALL UNDERGROUND UTILITIES, EITHER SHOWN OR NOT SHOWN ON THESE PLANS SHALL BE THE RESPONSIBILITY OF THE CONTRACTOR, AND SHALL BE LOCATED PRIOR TO ANY GRADING OR CONSTRUCTION OF THE IMPROVEMENTS.

SCALE: VERTICAL = 1"=10'
 HORIZONTAL = 1"=50'



BAX PROJECT NAME : THE ENCLAVE AT DEER CREEK
 BAX PROJECT NO. : 02-11841
 DESIGN DATE : 02-07-06
 DESIGNED BY : RKC
 SUBMITTED: 02-07-06 FILENAME: 11841ASB

UPP STR	LOW STR	L	DIA	UPPER FL LN	LOWER FL LN	PS	UPPER ST EL	DEPTH HY GR	UPPER HY EL	LOWER HY EL	HYDR GRADE	FR HEAD	VEL	VEL HEAD	JUNC LOSS	TURN LOSS	CURVE LOSS	STR SHADE	INL CAP	DR AREA	PI	Q	TQ	PIPE CAP	REMARKS	
C130	C129	35	15	462.36	461.99	1.05	467.45	1.65	465.80	465.80	.00010	0.00	0.39	0.00	0.00	0.00	0.00	2.34	1.53	0.18	2.64	0.48	0.48	6.61	1	
C129	FE28	65	15	461.79	461.02	1.19	467.59	1.79	465.80	465.78	.00020	0.01	0.72	0.01	0.01	0.00	0.00	2.34	1.53	0.15	2.64	0.40	0.88	7.04	2	100yrHW=465.78
A127	A126	127	12	465.70	464.40	1.03	470.40	3.73	466.67	466.09	.00360	0.46	2.72	0.12	0.12	0.00	0.00	3-S	7.01	0.81	2.64	2.14	2.14	3.61	3	
A126	C125	108	24	464.20	463.20	0.92	467.92	1.83	466.09	465.88	.00070	0.08	1.97	0.06	0.05	0.08	0.00	4-S	9.35	1.53	2.64	4.04	6.18	21.73	4	
C125	C124	36	24	463.00	462.74	0.73	468.69	2.81	465.88	465.79	.00120	0.04	2.50	0.10	0.05	0.00	0.00	LOW	3.40	0.61	2.64	1.66	7.94	19.28	5	
C124	FE23	170	27	462.54	460.83	1.01	468.68	2.89	465.79	465.62	.00090	0.16	2.38	0.09	0.01	0.00	0.00	LOW	3.40	0.61	2.64	1.62	9.46	31.08	6	100yrHW=465.62
A122	MH21	111	12	489.34	487.59	1.76	494.39	4.24	490.15*	488.59	.00840	0.93	4.16	0.27	0.27	0.00	0.00	4-S	9.35	1.24	2.64	3.27	3.27	4.73	7	
MH21	C113	98	17	487.39	483.96	3.51	495.43	7.54	487.89*	486.24	.00840	0.82	4.16	0.27	0.13	0.13	0.00	MH	0.00	0.00	0.00	0.00	3.27	6.67	8	
C120	C110	36	15	472.65	472.01	1.78	477.34	4.08	473.26	473.26	.00010	0.00	0.38	0.00	0.00	0.00	0.00	5.98	0.47	0.26	2.64	1.18	0.47	8.61	9	
DA19	A118	54	21	497.85	490.89	12.87	500.50	2.13	498.38*	492.64	.00550	0.30	4.89	0.37	0.37	0.00	0.00	4-S	9.35	4.46	2.64	11.77	11.77	56.85	10	
A118	MH17	95	21	490.69	489.61	1.13	495.29	2.65	492.64	491.36	.00750	0.71	5.69	0.50	0.36	0.21	0.00	3-S	7.01	0.73	2.64	1.92	13.69	16.87	11	
MH17	MH16	82	21	489.41	488.40	1.23	502.05	10.79	491.26	490.15	.00750	0.61	5.69	0.50	0.25	0.25	0.00	MH	0.00	0.00	0.00	0.00	13.69	17.59	12	
MH16	C115	120	21	488.20	486.04	1.80	499.47	10.04	489.43	488.13	.00750	0.90	5.69	0.50	0.20	0.20	0.00	MH	0.00	0.00	0.00	0.00	13.69	21.25	13	
C115	C114	35	21	489.84	489.45	1.10	491.65	3.52	488.13	487.22	.00790	0.28	5.87	0.54	0.34	0.29	0.00	6.00	0.43	0.35	2.64	0.92	14.12	16.65	14	
C114	C113	52	21	485.25	483.96	2.50	491.15	3.93	487.22	486.24	.00840	0.44	6.05	0.57	0.29	0.25	0.00	6.00	0.43	0.32	2.64	0.84	14.55	25.05	15	
C113	C112	35	24	483.76	483.36	1.14	489.56	3.32	486.24	485.36	.00660	0.23	5.86	0.53	0.25	0.40	0.00	4.00	1.03	0.22	2.64	0.58	18.40	24.20	16	
C112	MH11	37	24	483.16	481.46	4.61	489.57	5.34	484.23	483.46	.00700	0.26	6.04	0.57	0.28	0.23	0.00	4.00	1.03	0.22	2.64	0.58	18.98	48.56	17	
MH11	C110	133	24	481.26	472.01	6.96	486.36	4.32	482.04*	474.01	.00700	0.94	6.04	0.57	0.25	0.25	0.00	MH	0.00	0.00	0.00	0.00	18.98	59.66	18	
C110	C19	136	24	471.81	466.14	4.91	477.23	4.54	472.69*	469.82	.00780	0.90	6.34	0.62	0.15	0.07	0.00	5.98	0.47	0.23	2.64	1.02	19.92	50.11	19	
C19	C18	35	24	465.94	465.29	1.83	471.61	1.79	469.82	468.60	.00830	0.30	6.57	0.67	0.49	0.43	0.00	4.00	1.03	0.07	2.64	0.73	20.65	30.62	20	
C18	MH7	82	27	465.09	463.92	1.43	471.60	3.00	468.60	468.04	.00490	0.40	5.45	0.46	0.00	0.16	0.00	4.00	1.03	0.14	2.64	1.08	21.68	36.99	21	
MH7	C14	188	27	463.72	461.27	1.31	470.86	2.82	468.04	466.90	.00490	0.92	5.45	0.46	0.11	0.11	0.00	MH	0.00	0.00	0.00	0.00	21.68	35.39	22	
FR6	A15	19	36	462.77	462.54	1.24	469.15	0.83	468.32	467.44	.00560	0.10	7.09	0.78	0.78	0.00	0.00	LOW	66.00	18.97	2.64	50.09	50.09	74.19	23	
A15	C14	96	36	462.34	461.34	1.04	469.15	1.71	467.44	466.90	.00560	0.54	7.09	0.78	0.00	0.00	0.00	3-S	7.01	0.00	0.00	0.00	50.09	68.09	24	
C14	C13	35	48	461.14	460.83	0.88	469.09	2.19	466.90	466.50	.00250	0.09	5.76	0.51	0.00	0.31	0.00	1.00	1.95	0.22	2.64	0.98	72.35	134.37	25	
C13	MH2	22	54	460.63	460.45	0.81	469.19	2.69	466.50	466.21	.00140	0.03	4.59	0.33	0.04	0.22	0.00	1.00	1.95	0.23	2.64	0.61	72.96	176.55	26	
MH2	FE1	140	54	460.25	458.84	1.01	469.82	3.61	466.21	465.74	.00140	0.19	4.59	0.33	0.14	0.14	0.00	MH	0.00	0.00	0.00	0.00	72.96	197.62	27	100yrHW=465.74

* INDICATES CRITICAL DEPTH

Handwritten signature and initials
 3/6/06