



AS-BUILT SITE PLAN FOR  
FALLON PARKWAY  
COLLECTOR RD. EXTENSION

96-8791E 12-26-06

PROPOSED  
RETENTION/DETENTION  
BASIN/  
COMMON GROUND

NORMAL POOL = 516.00  
15-YEAR H.W. = 519.52  
25-YEAR H.W. = 520.03  
100-YEAR H.W. = 521.67



PROPERTY N/F  
JAMES & JANICE ZWYERS  
952/1825

PROPERTY N/F  
ROBERT & LORETTA PALMER  
666/52

PROPERTY N/F  
KAPLAN LUMBER CO, INC  
BK. 1413 PG. 262

FALLON PARKWAY (60'W)

DESIGN PLAN ELEV.

EX. 10'W. ESMT.  
P.B.41 PGS.231-232

N89°48'11"E 579.83"

625

624

COMMON GROUND

604

R=28.00'  
L=12.93'

603

602


429


428

427

ASBUILT STORM & SANITARY PROFILES FOR  
**FALLON PARKWAY**  
**COLLECTOR RD. EXTENSION**


12-26-08

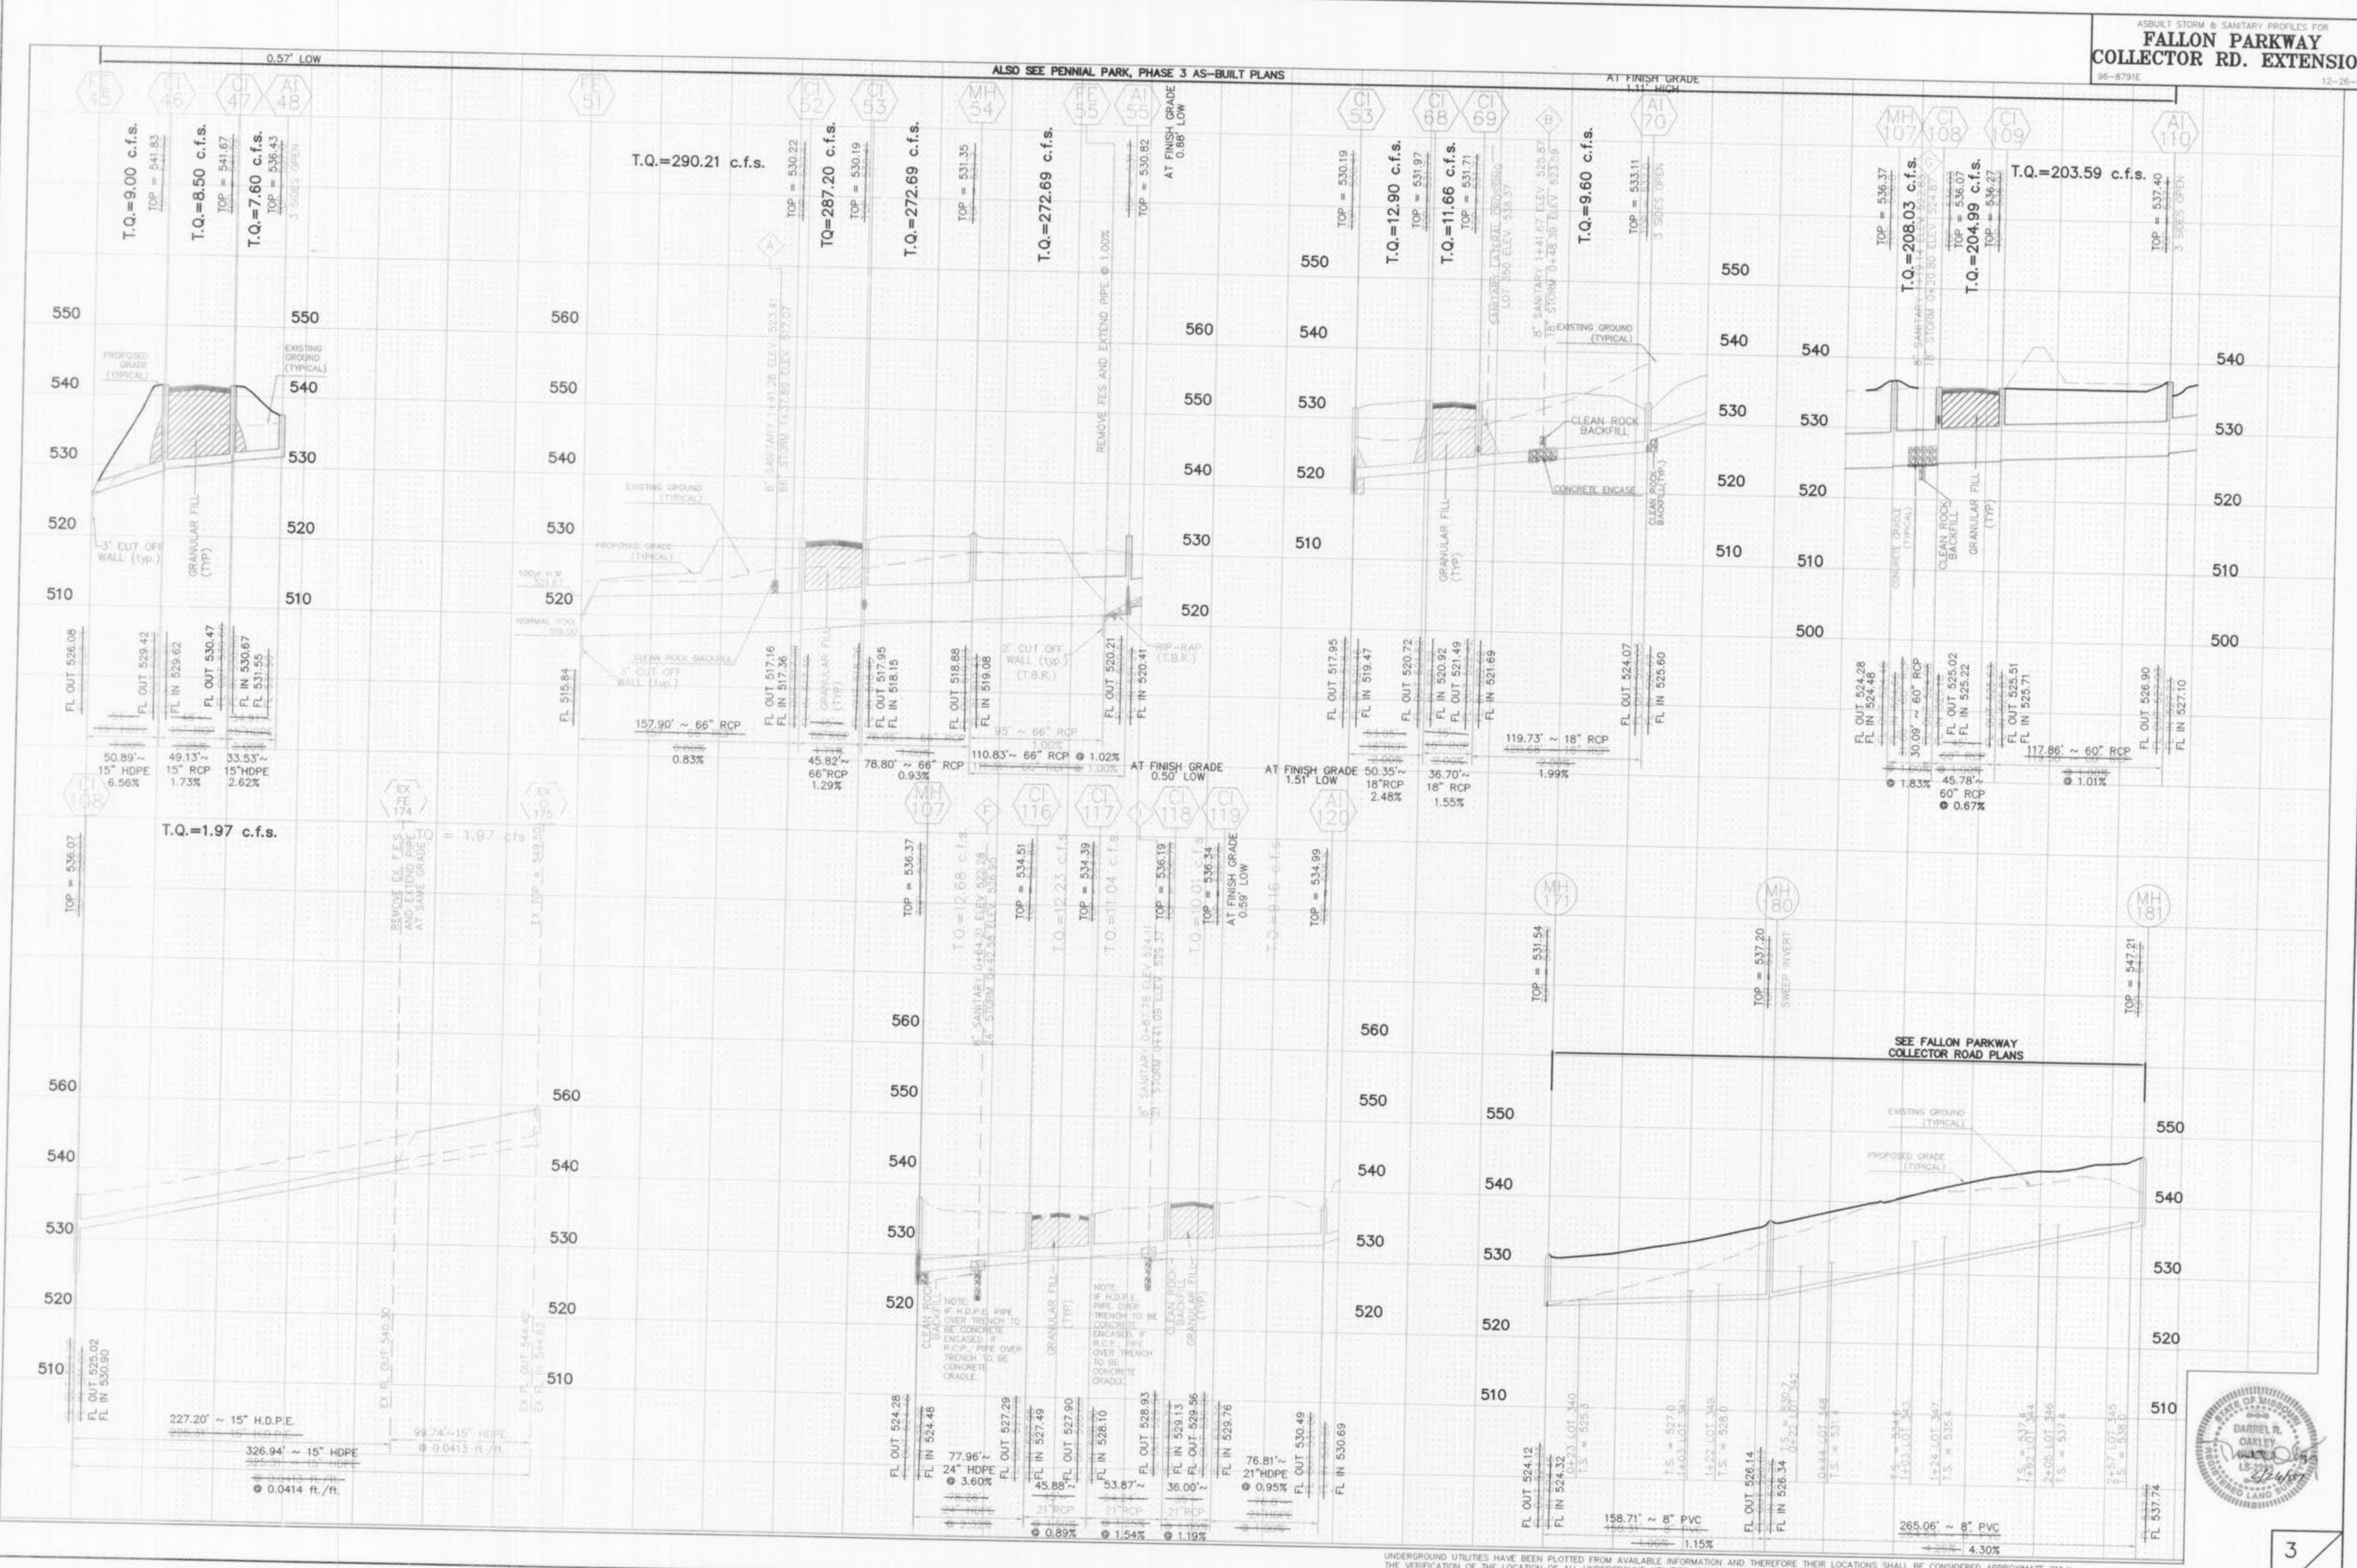

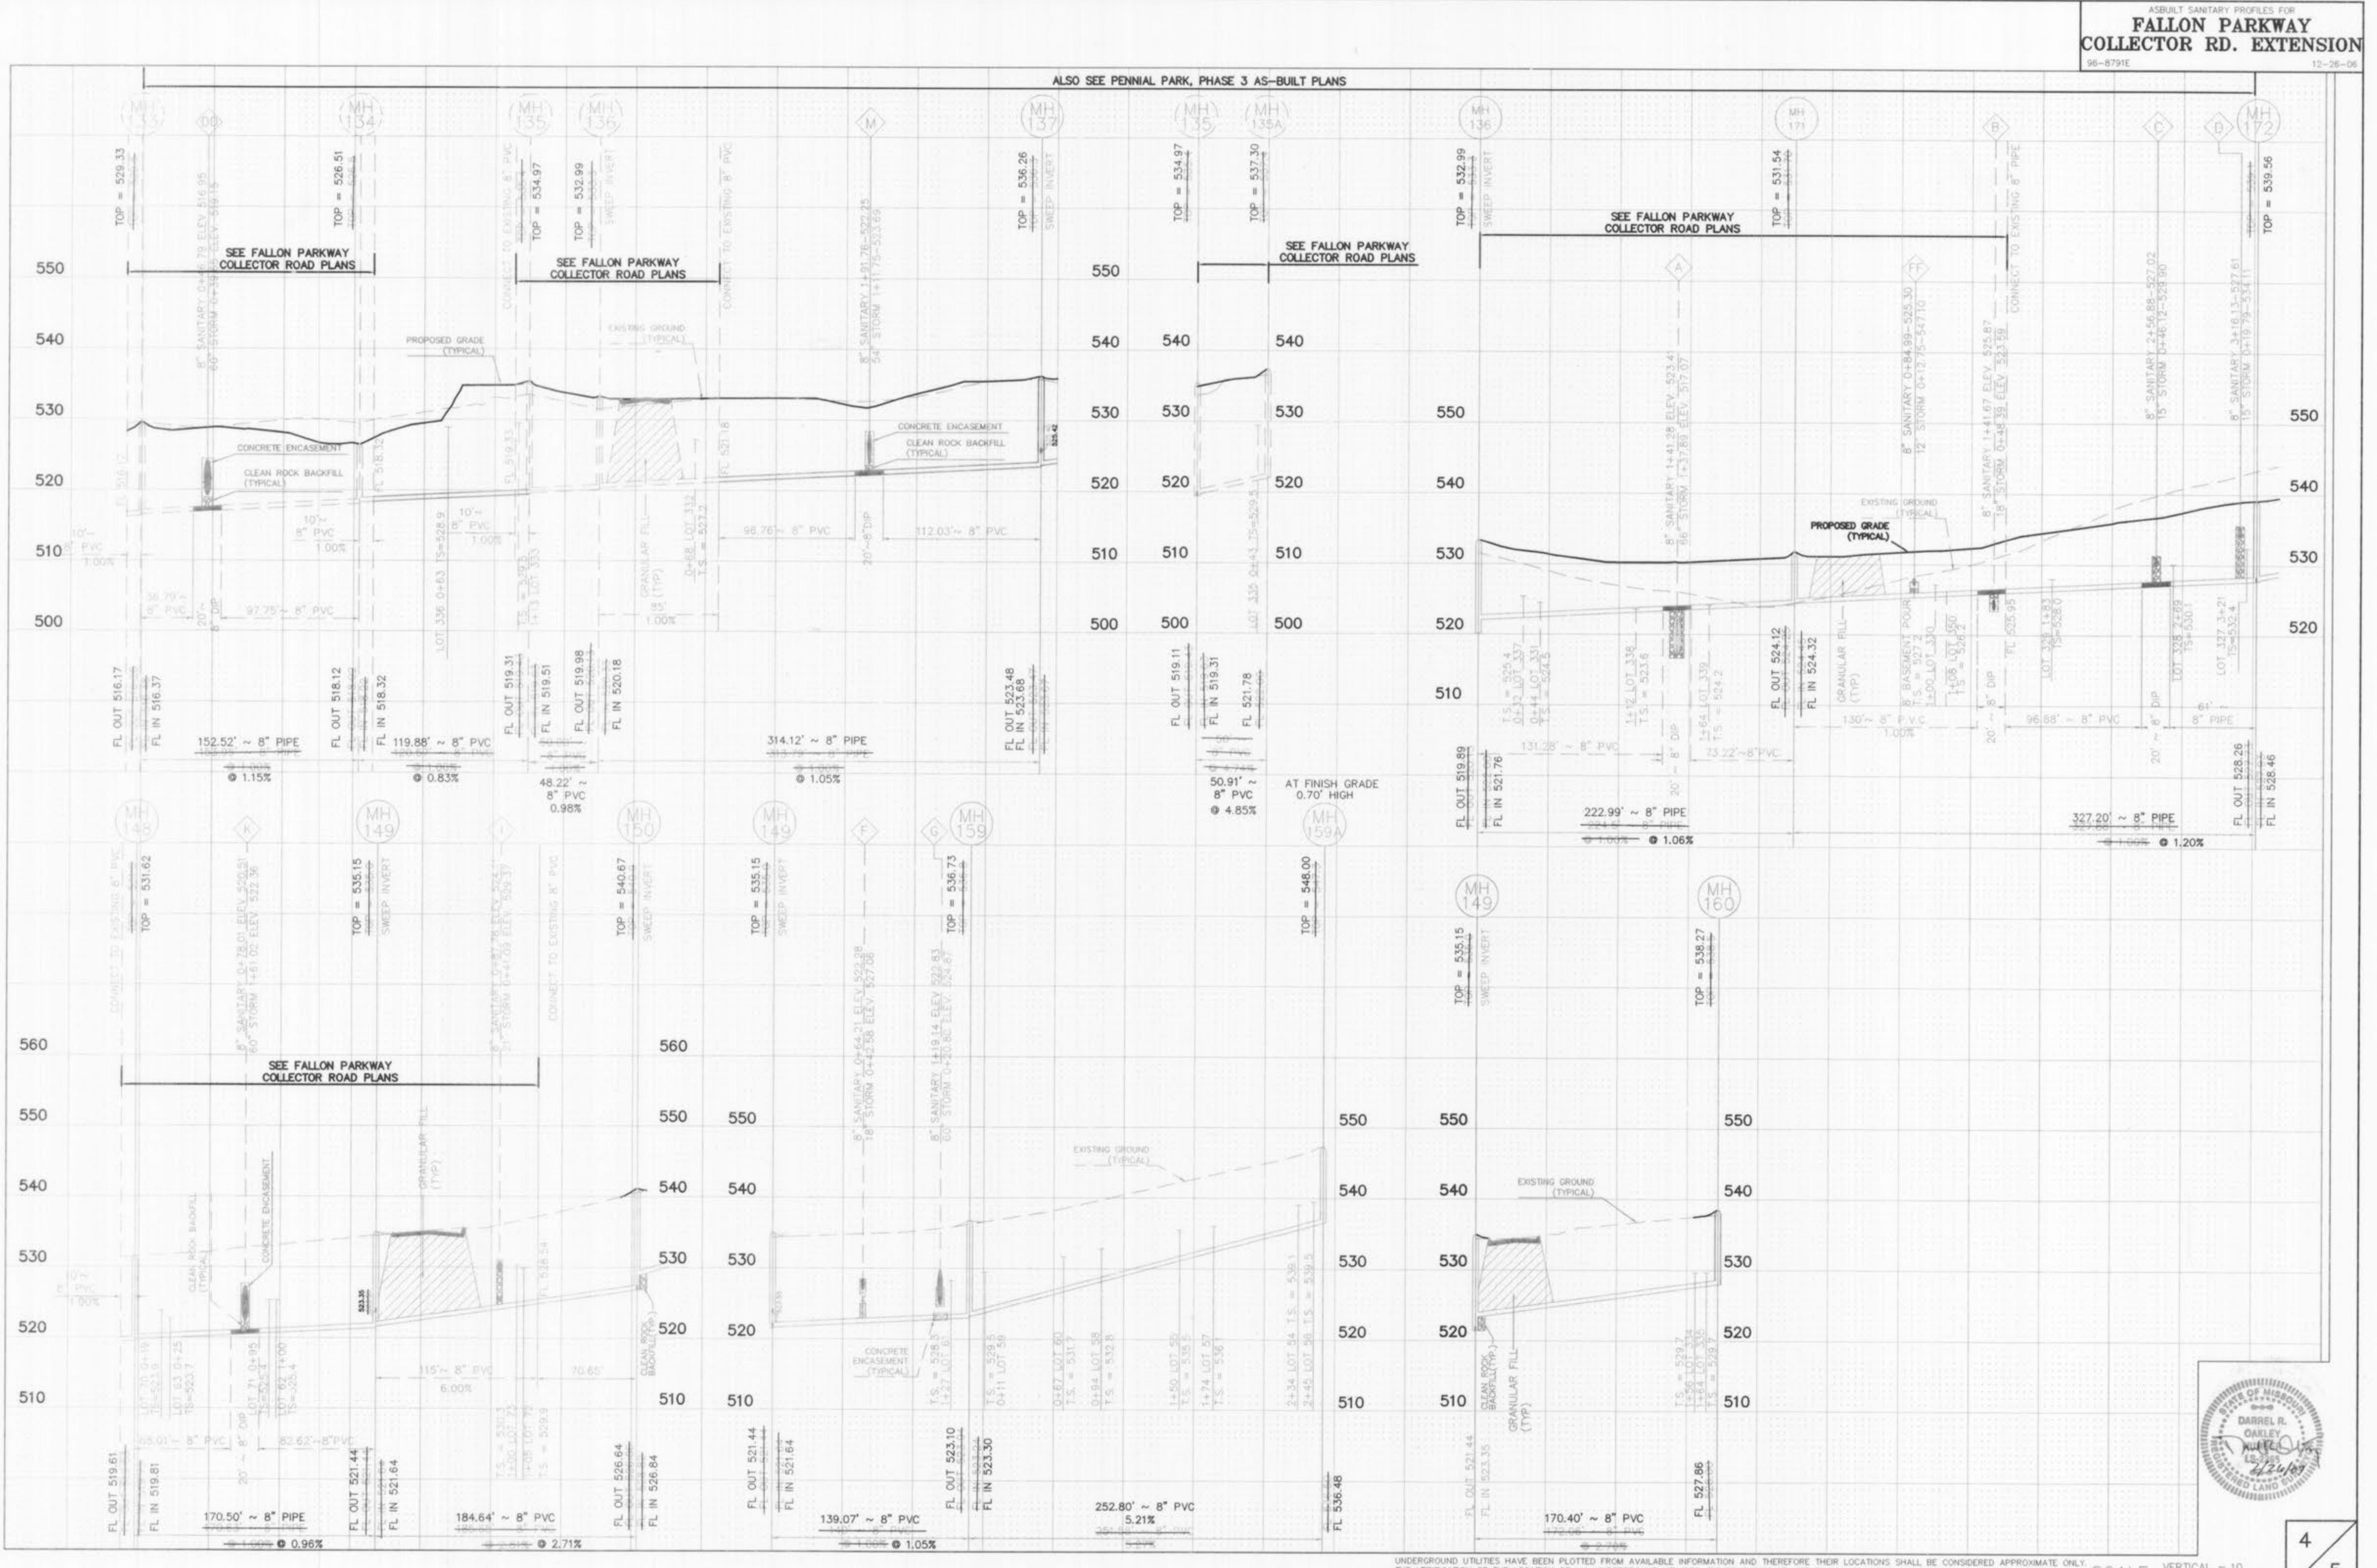

-8791

26-06

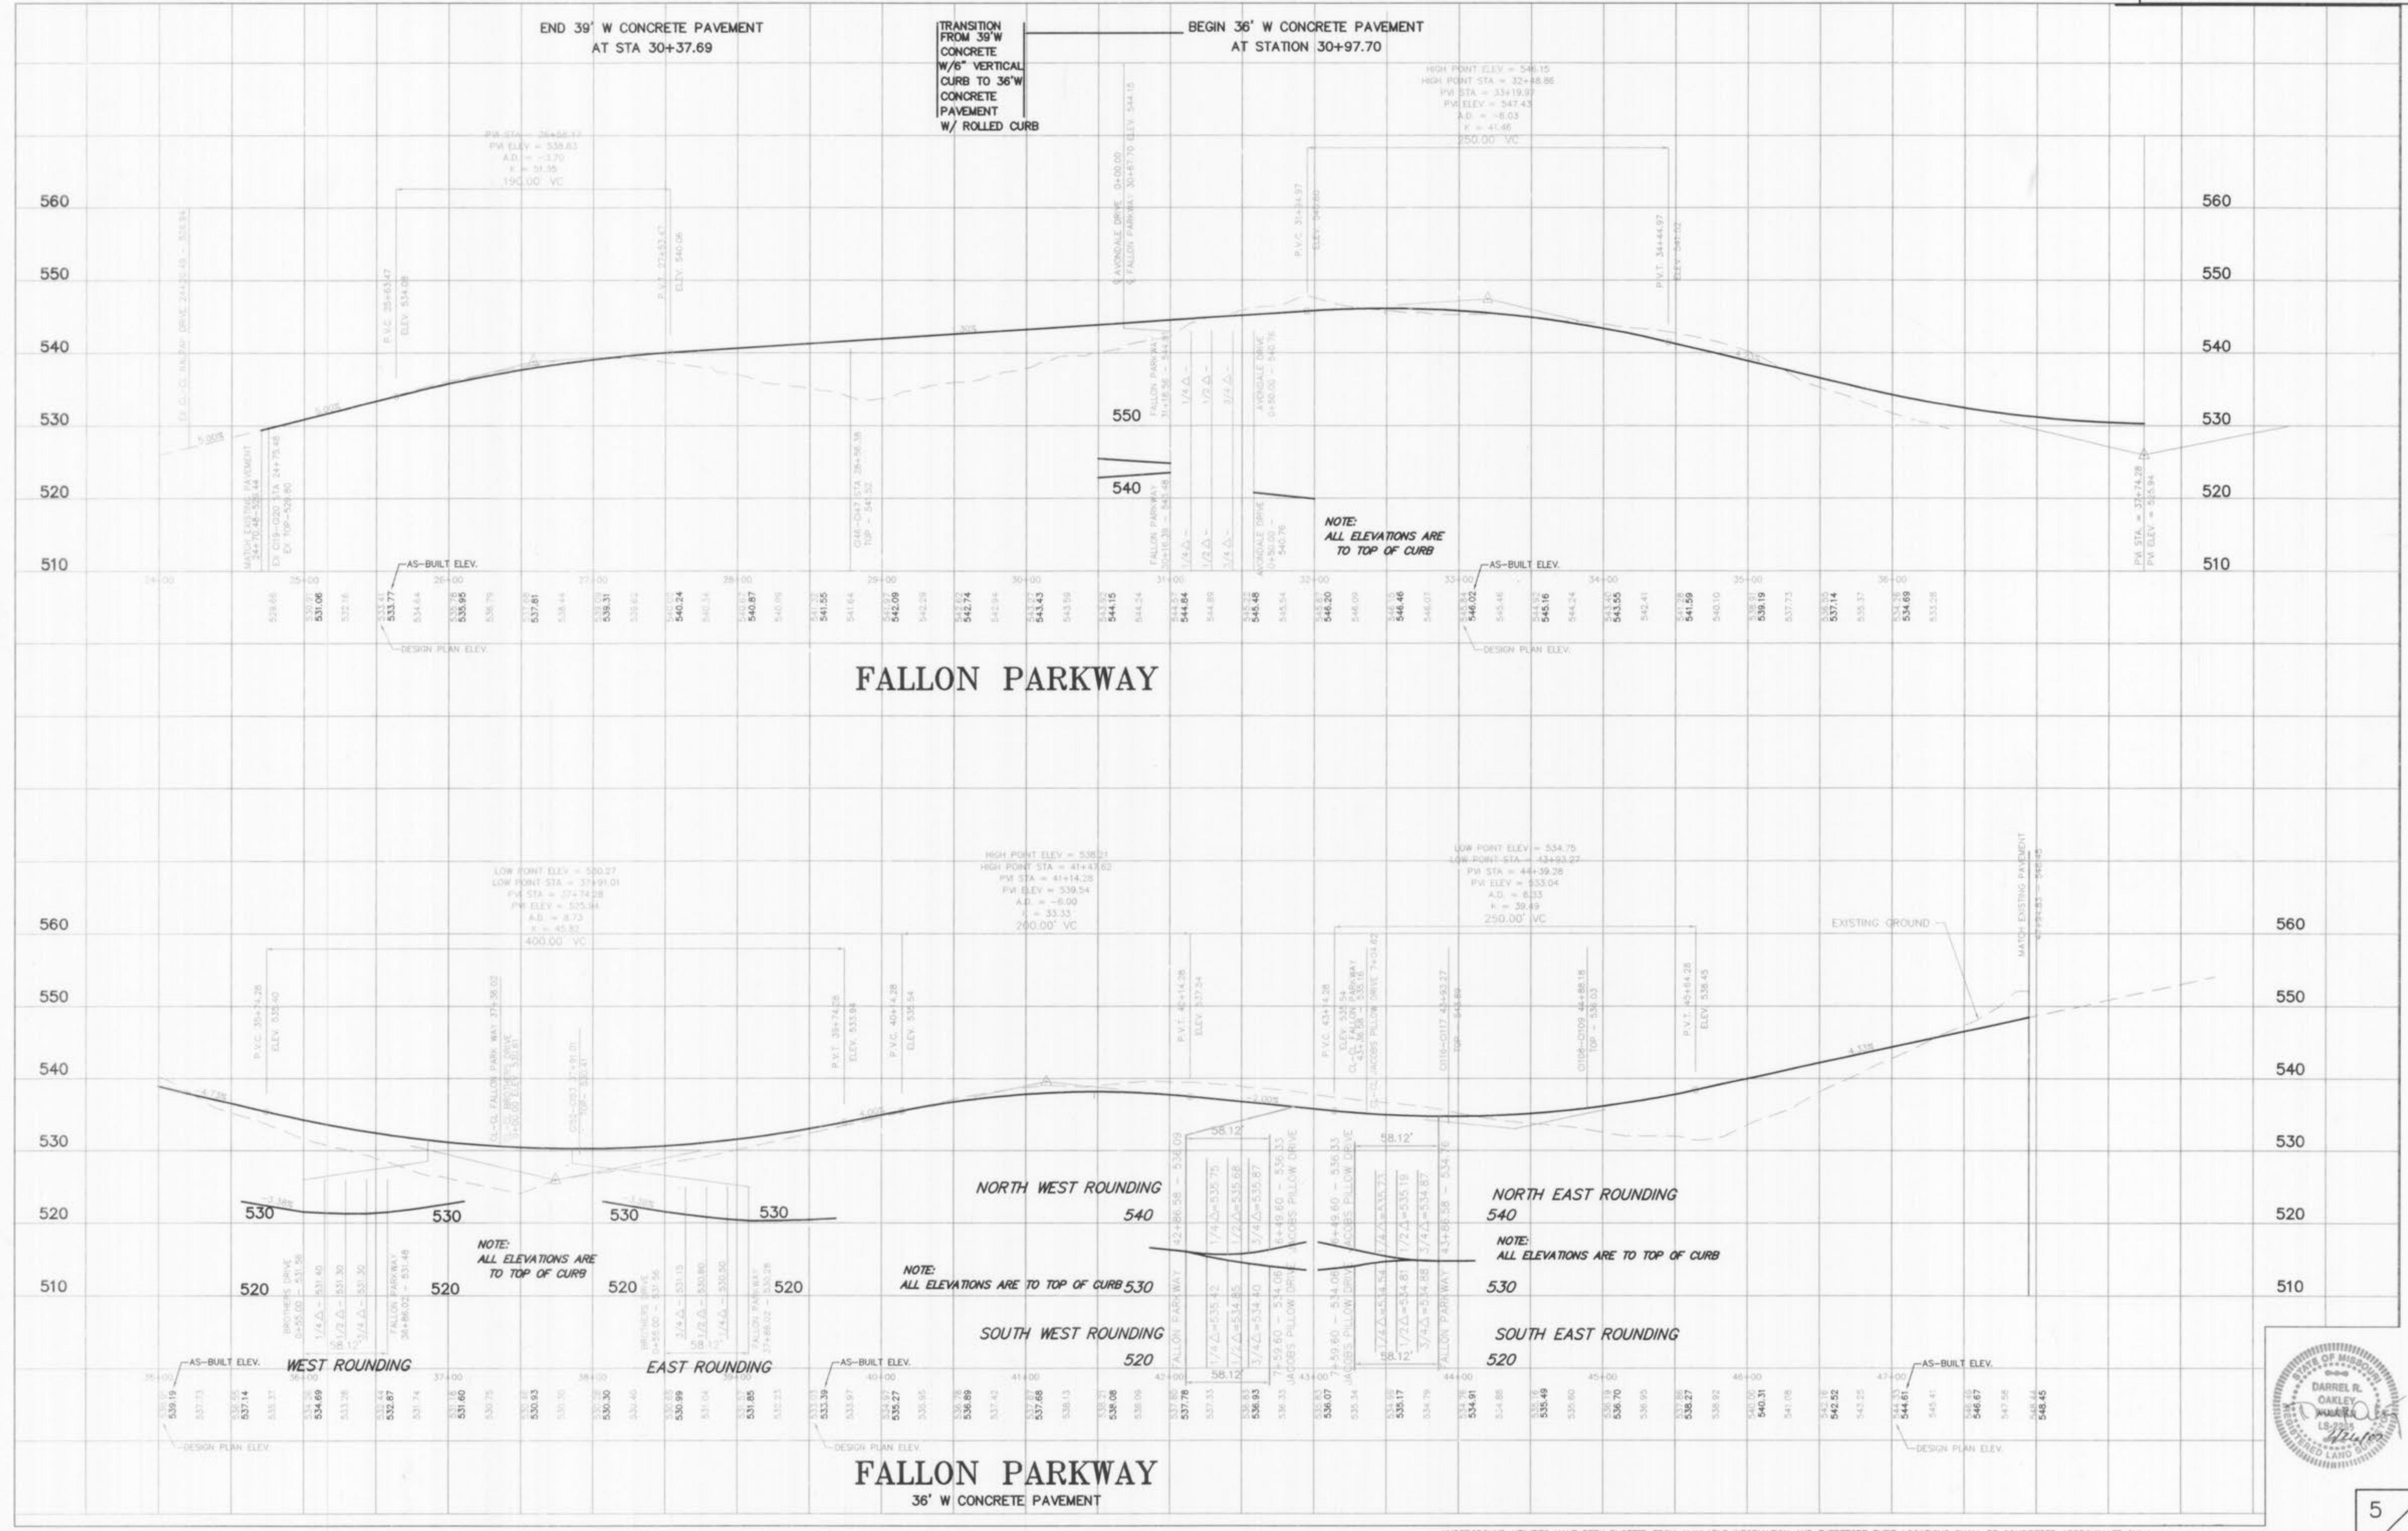

UNDERGROUND UTILITIES HAVE BEEN PLOTTED FROM AVAILABLE INFORMATION AND THEREFORE THEIR LOCATIONS SHALL BE CONSIDERED APPROXIMATE ONLY. THE VERIFICATION OF THE LOCATION OF ALL UNDERGROUND UTILITIES, EITHER SHOWN OR NOT SHOWN ON THESE PLANS SHALL BE THE RESPONSIBILITY OF THE CONTRACTOR, AND SHALL BE LOCATED PRIOR TO ANY GRADING OR CONSTRUCTION OF THE IMPROVEMENTS.

SCALE: VERTICAL = 10  
HORIZONTAL = 50

