

Drawing name: K:\ND\0306147 Fox Haven\Improvements\1147BMP.dwg Plotted date: Aug 04, 2004 - 3:21pm Plotted by: Juettkenhaus

N/F
IRENE POST
ST. CHARLES COUNTY MAP ID.
4-0046-S015-00-14
ST. CHARLES CO. "A"

GARY LEE & BARBARA HOCKELMAN
W/LIFE POWER GENERAL WARRANTY
TO IRENE C. POST
1578/767

ST. CHARLES CO. "A"

NO7°23'08"W 829.61' (ACT) 828.22' (REC)

ROW & LOIS HOWSER 512/749 O'FALLON UNZONED

LOT 10

WELDON SPRINGS GARDENS
P.B. 4 PG. 180-181
LOT 8
N/F
419/310
ST. CHARLES CO.

LOT 9

LOT 7

1098/609

CHARLES CO.

GRAPHIC SCALE

100

100


100

100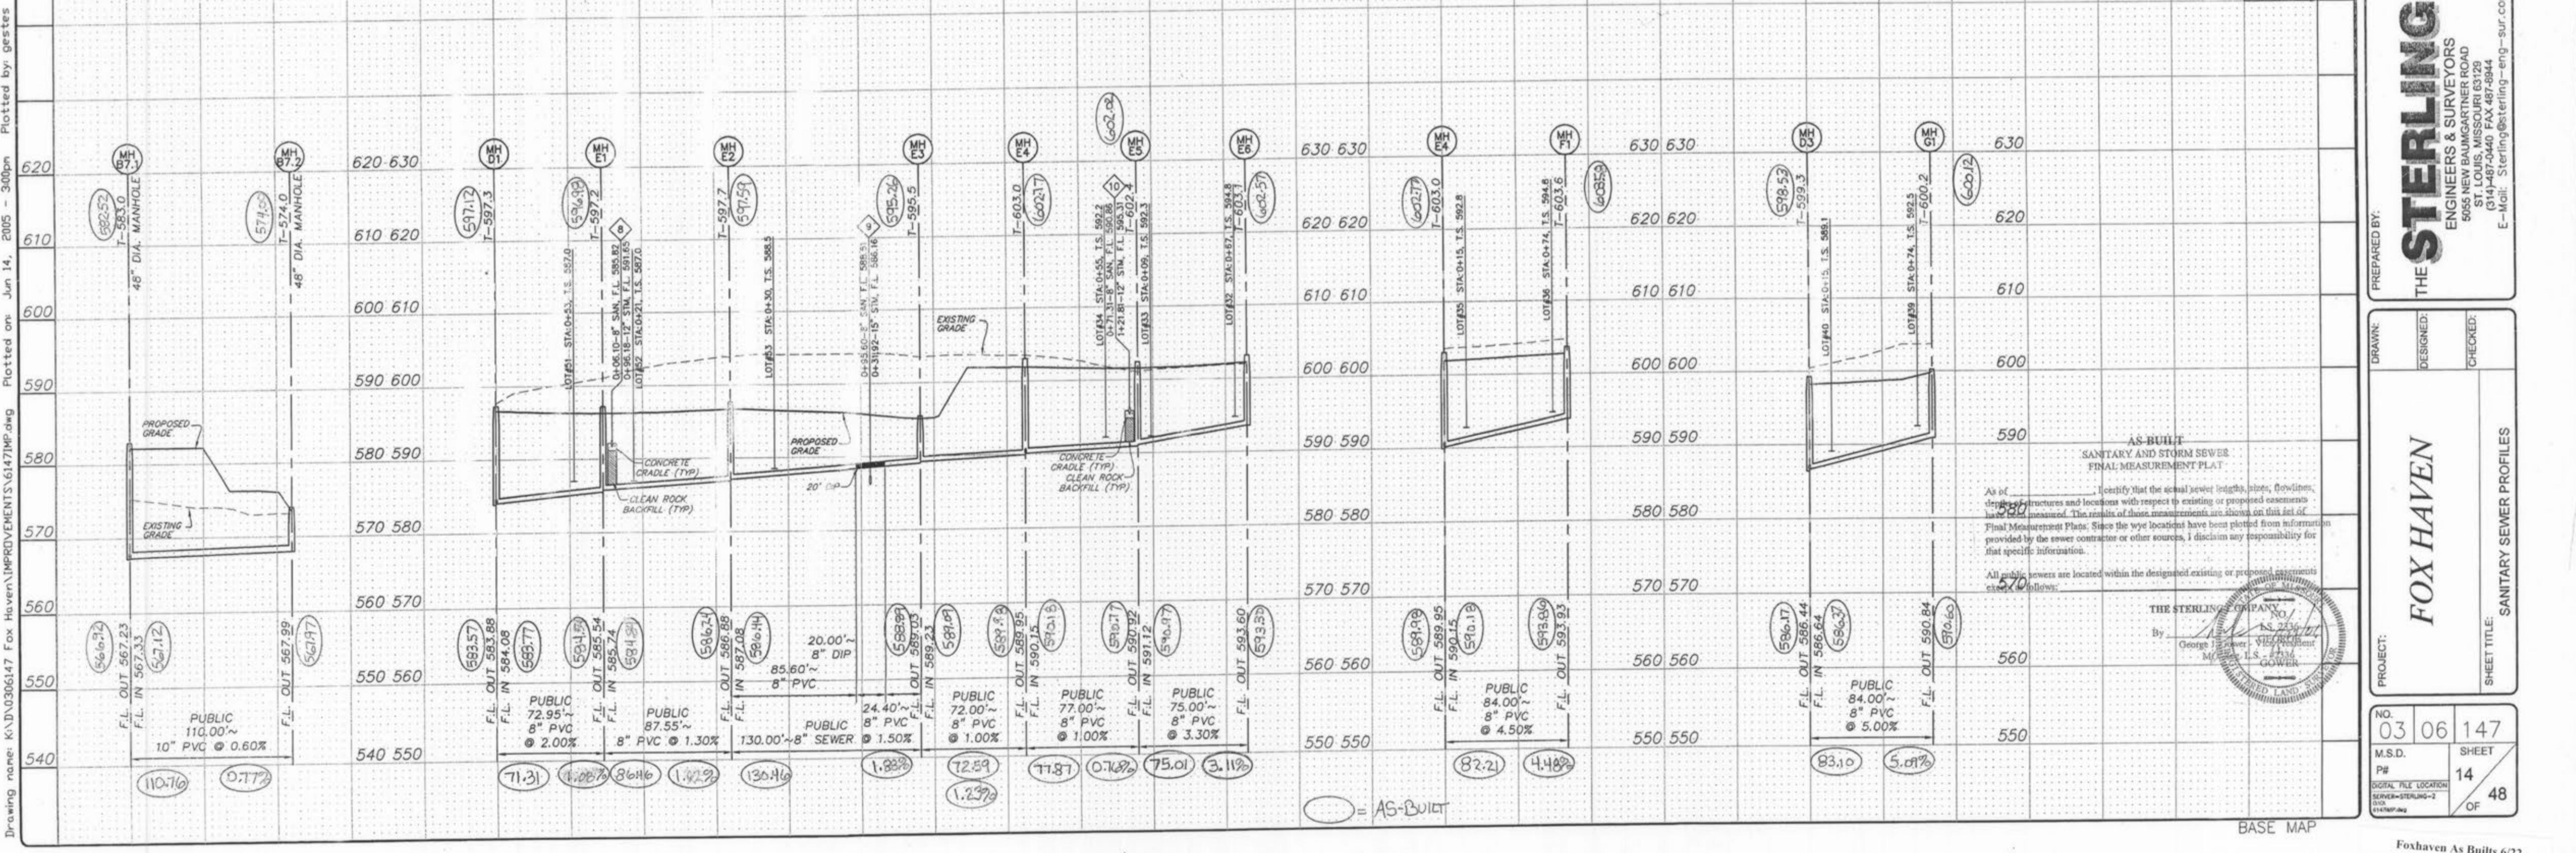

**McBride & Son Homes
Land Development, Inc.**

#1 McBride & Son Center Drive
Chesterfield, Missouri 63005
(636) 534-2000

PREPARED FOR:

STERLING CO.
ENGINEERS & SURVEYORS
505 NEW BAUMGARTNER ROAD
ST. LOUIS, MISSOURI 63129
(314) 487-2440 FAX: 487-2444
E-mail: Sterling@eng-surf.com

PREPARED BY:

FOX HAVEN
AS-BUILT
SANITARY AND STORM SEWERS
FINAL MEASUREMENT PLAT

PROJECT:

NO. 03 06 147


SHEET 14 OF 48

M.S.D. P#

DIGITAL FILE LOCATION
SERVER=STERLING-2
D:\147\06.dwg

Foxhaven As Builts 6/22

ISSUE / REMARKS / DATE	
1	03-01-04 FIRST SUBMITTAL
2	06-15-04 REVISED PER CITY & DCSD COMMENTS
3	07-20-04 REVISED PER CITY COMMENTS
4	08-04-04 REVISED PER DCSD COMMENTS
5	08-12-04 REVISED PER PWSDE COMMENTS
6	10-18-04 REVISED PER DEVELOPER COMMENTS
7	04-21-05 REVISED OUTFALL STRUCTURE 02
8	06-14-05 GRADING COMMENTS PER DEVELOPER

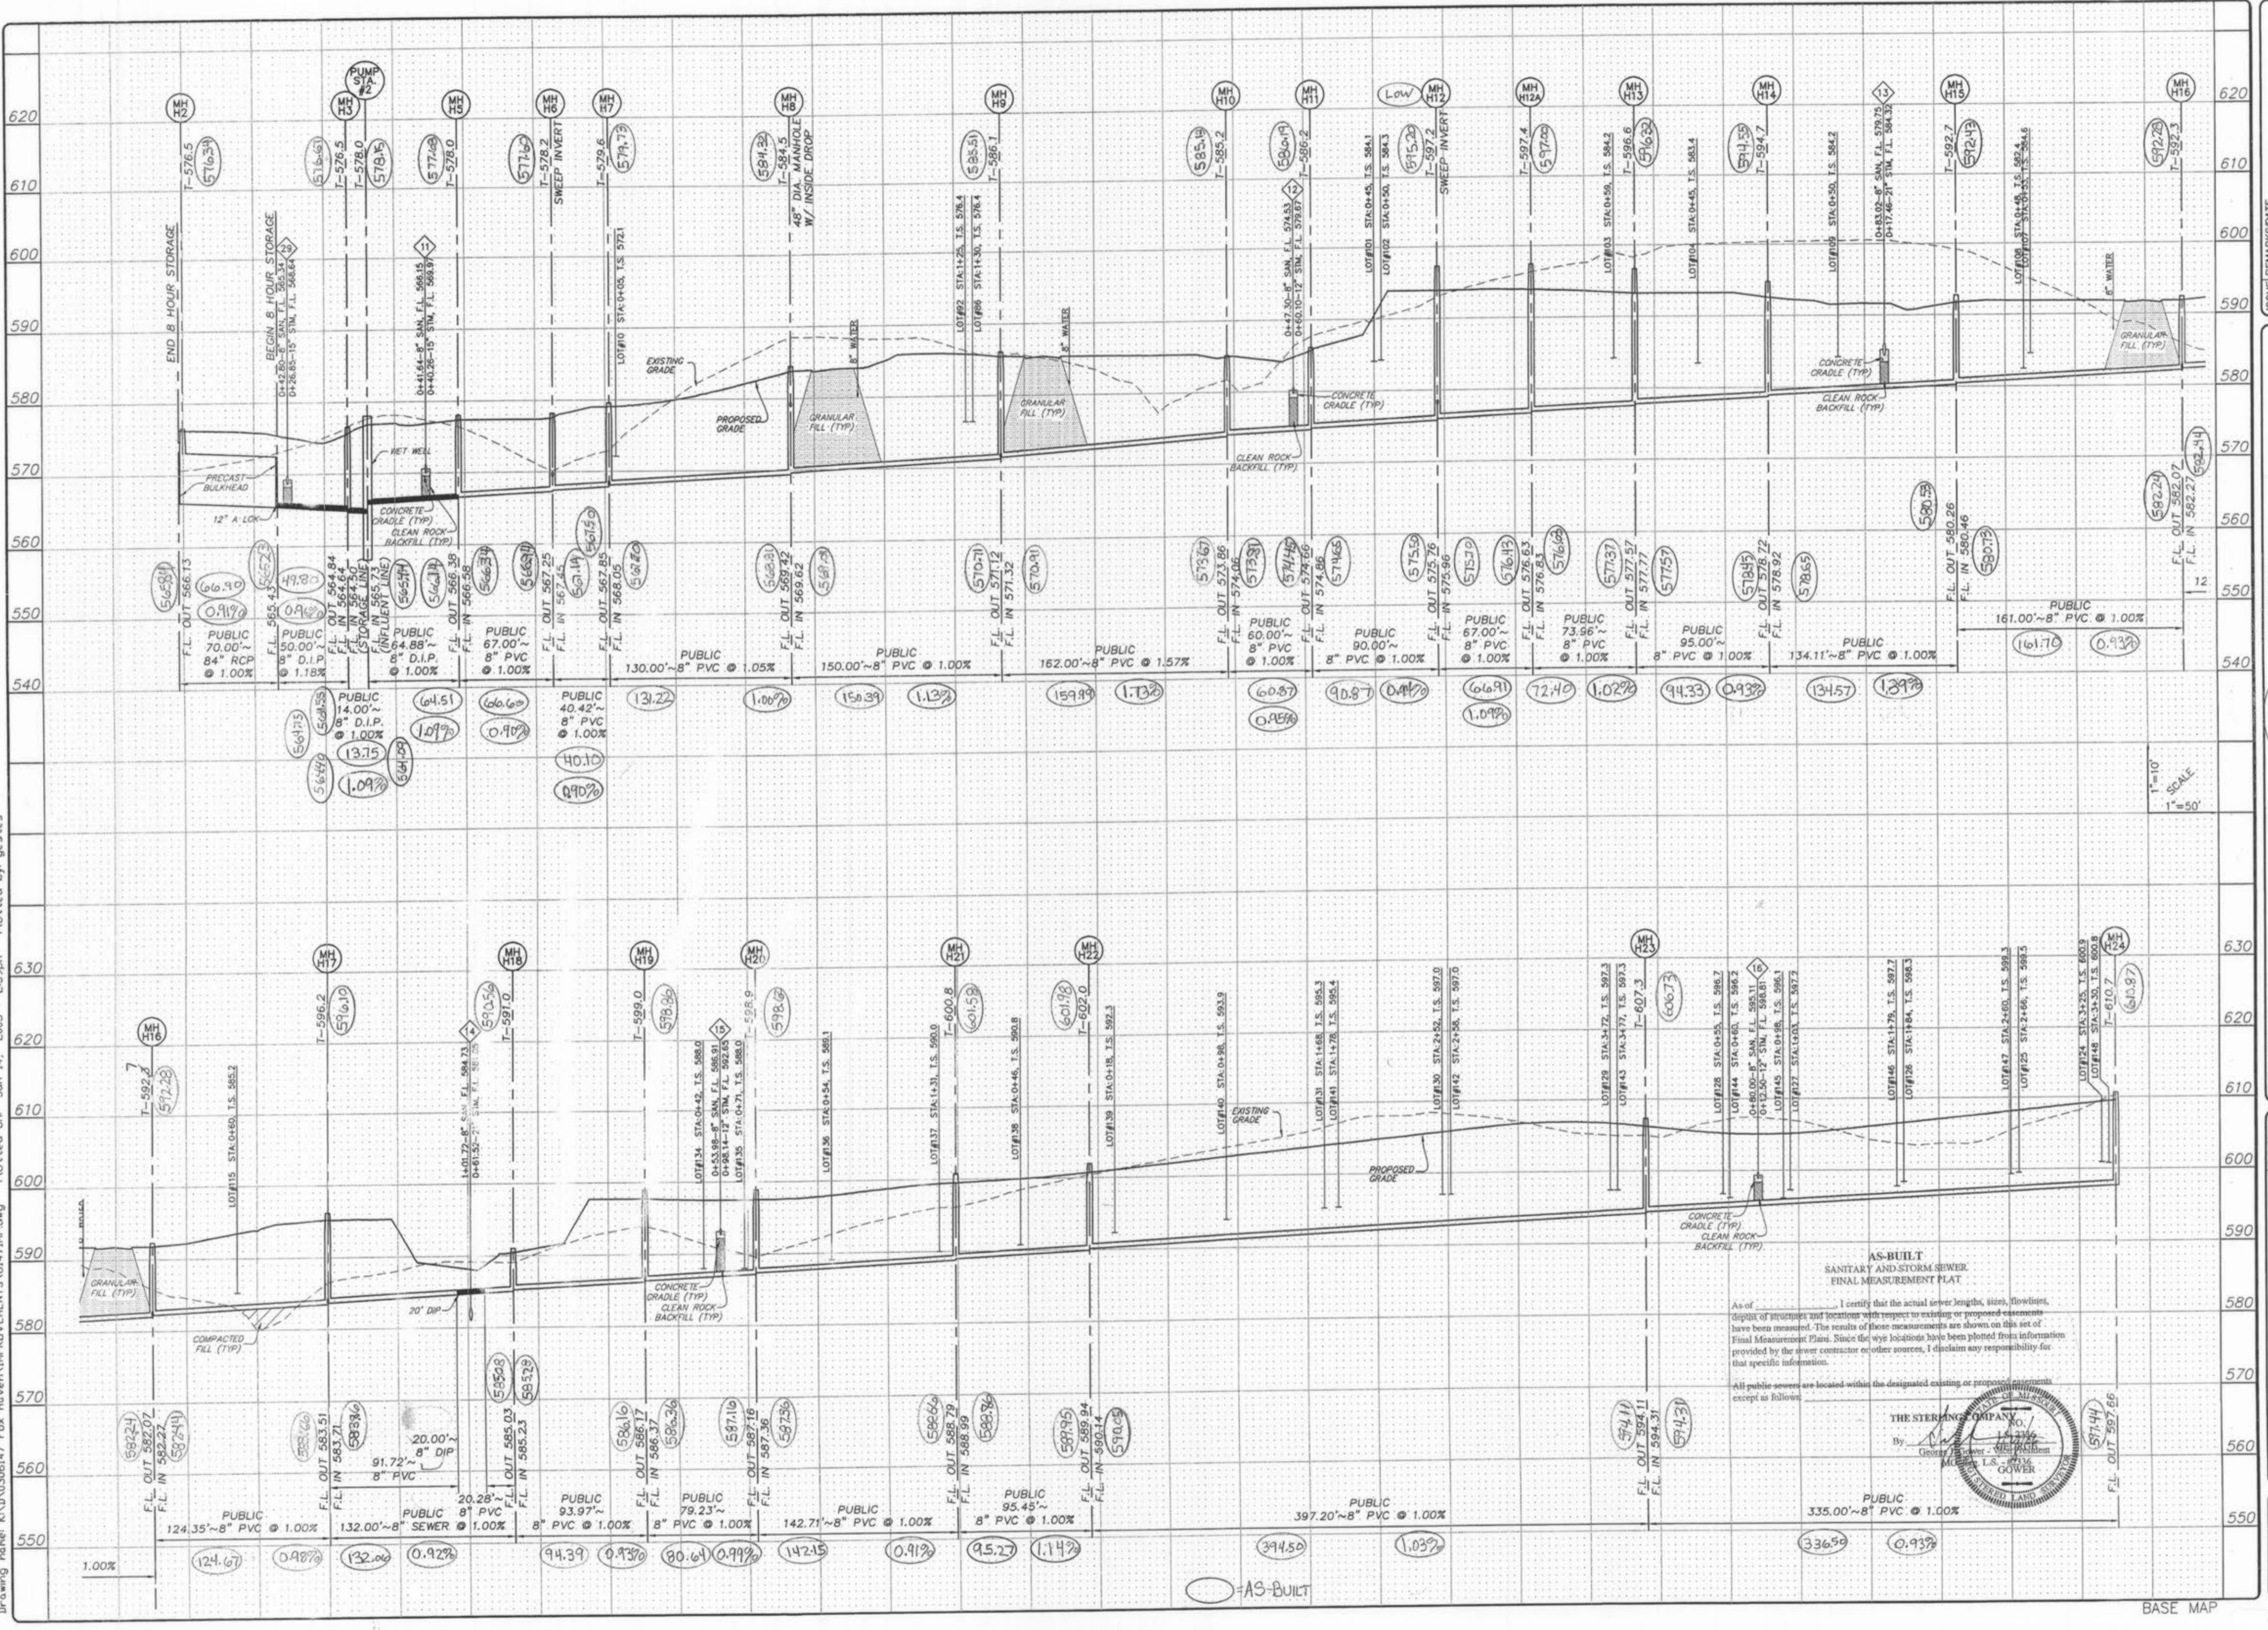

DRAWN: FOX HAVEN

DESIGNED: THE STERLING CO.

CHECKED:

APPROVED:

THE STERLING CO.

ENGINEERS & SURVEYORS

5055 NEW BAUMGARTNER ROAD

ST. LOUIS, MISSOURI 63129

(314) 487-0440 FAX 487-8944

E-Mail: Sterling@Sterling-eng-surf.com

**McBride & Son Homes
Land Development, Inc.**
#1 McBride & Son Center Drive
Chesterfield, Missouri 63005
(636) 534-2000

PREPARED FOR:



ISSUE DATE: 03-01-04 FIRST SUBMITTAL

1 03-01-04 REVISED PER CITY & DCSD COMMENTS

2 06-15-04 REVISED PER CITY COMMENTS

3 07-20-04 REVISED PER DCSD COMMENTS

4 08-04-04 REVISED PER DCSD COMMENTS

5 08-12-04 REVISED PER PWS2 COMMENTS

6 10-18-04 REVISED PER DEVELOPER COMMENTS

7 04-21-05 REVISED OUT-OF-STRUCTURE 02

8 06-14-05 GRADING COMMENTS PER DEVELOPER

9 08-12-04 REVISED OUT-OF-STRUCTURE 02

10 08-12-04 REVISED OUT-OF-STRUCTURE 02

11 04-22-05 REVISED OUT-OF-STRUCTURE 02

12 04-22-05 REVISED OUT-OF-STRUCTURE 02


125 04-22-05 REVISED OUT-OF-STRUCTURE 02

126 04-22-05 REVISED OUT-OF-STRUCTURE 02

127 04-22-05 REVISED OUT-OF-STRUCTURE 02

128 04-22-05 REVISED OUT-OF-STRUCTURE 02

129 04-22-05 REVISED

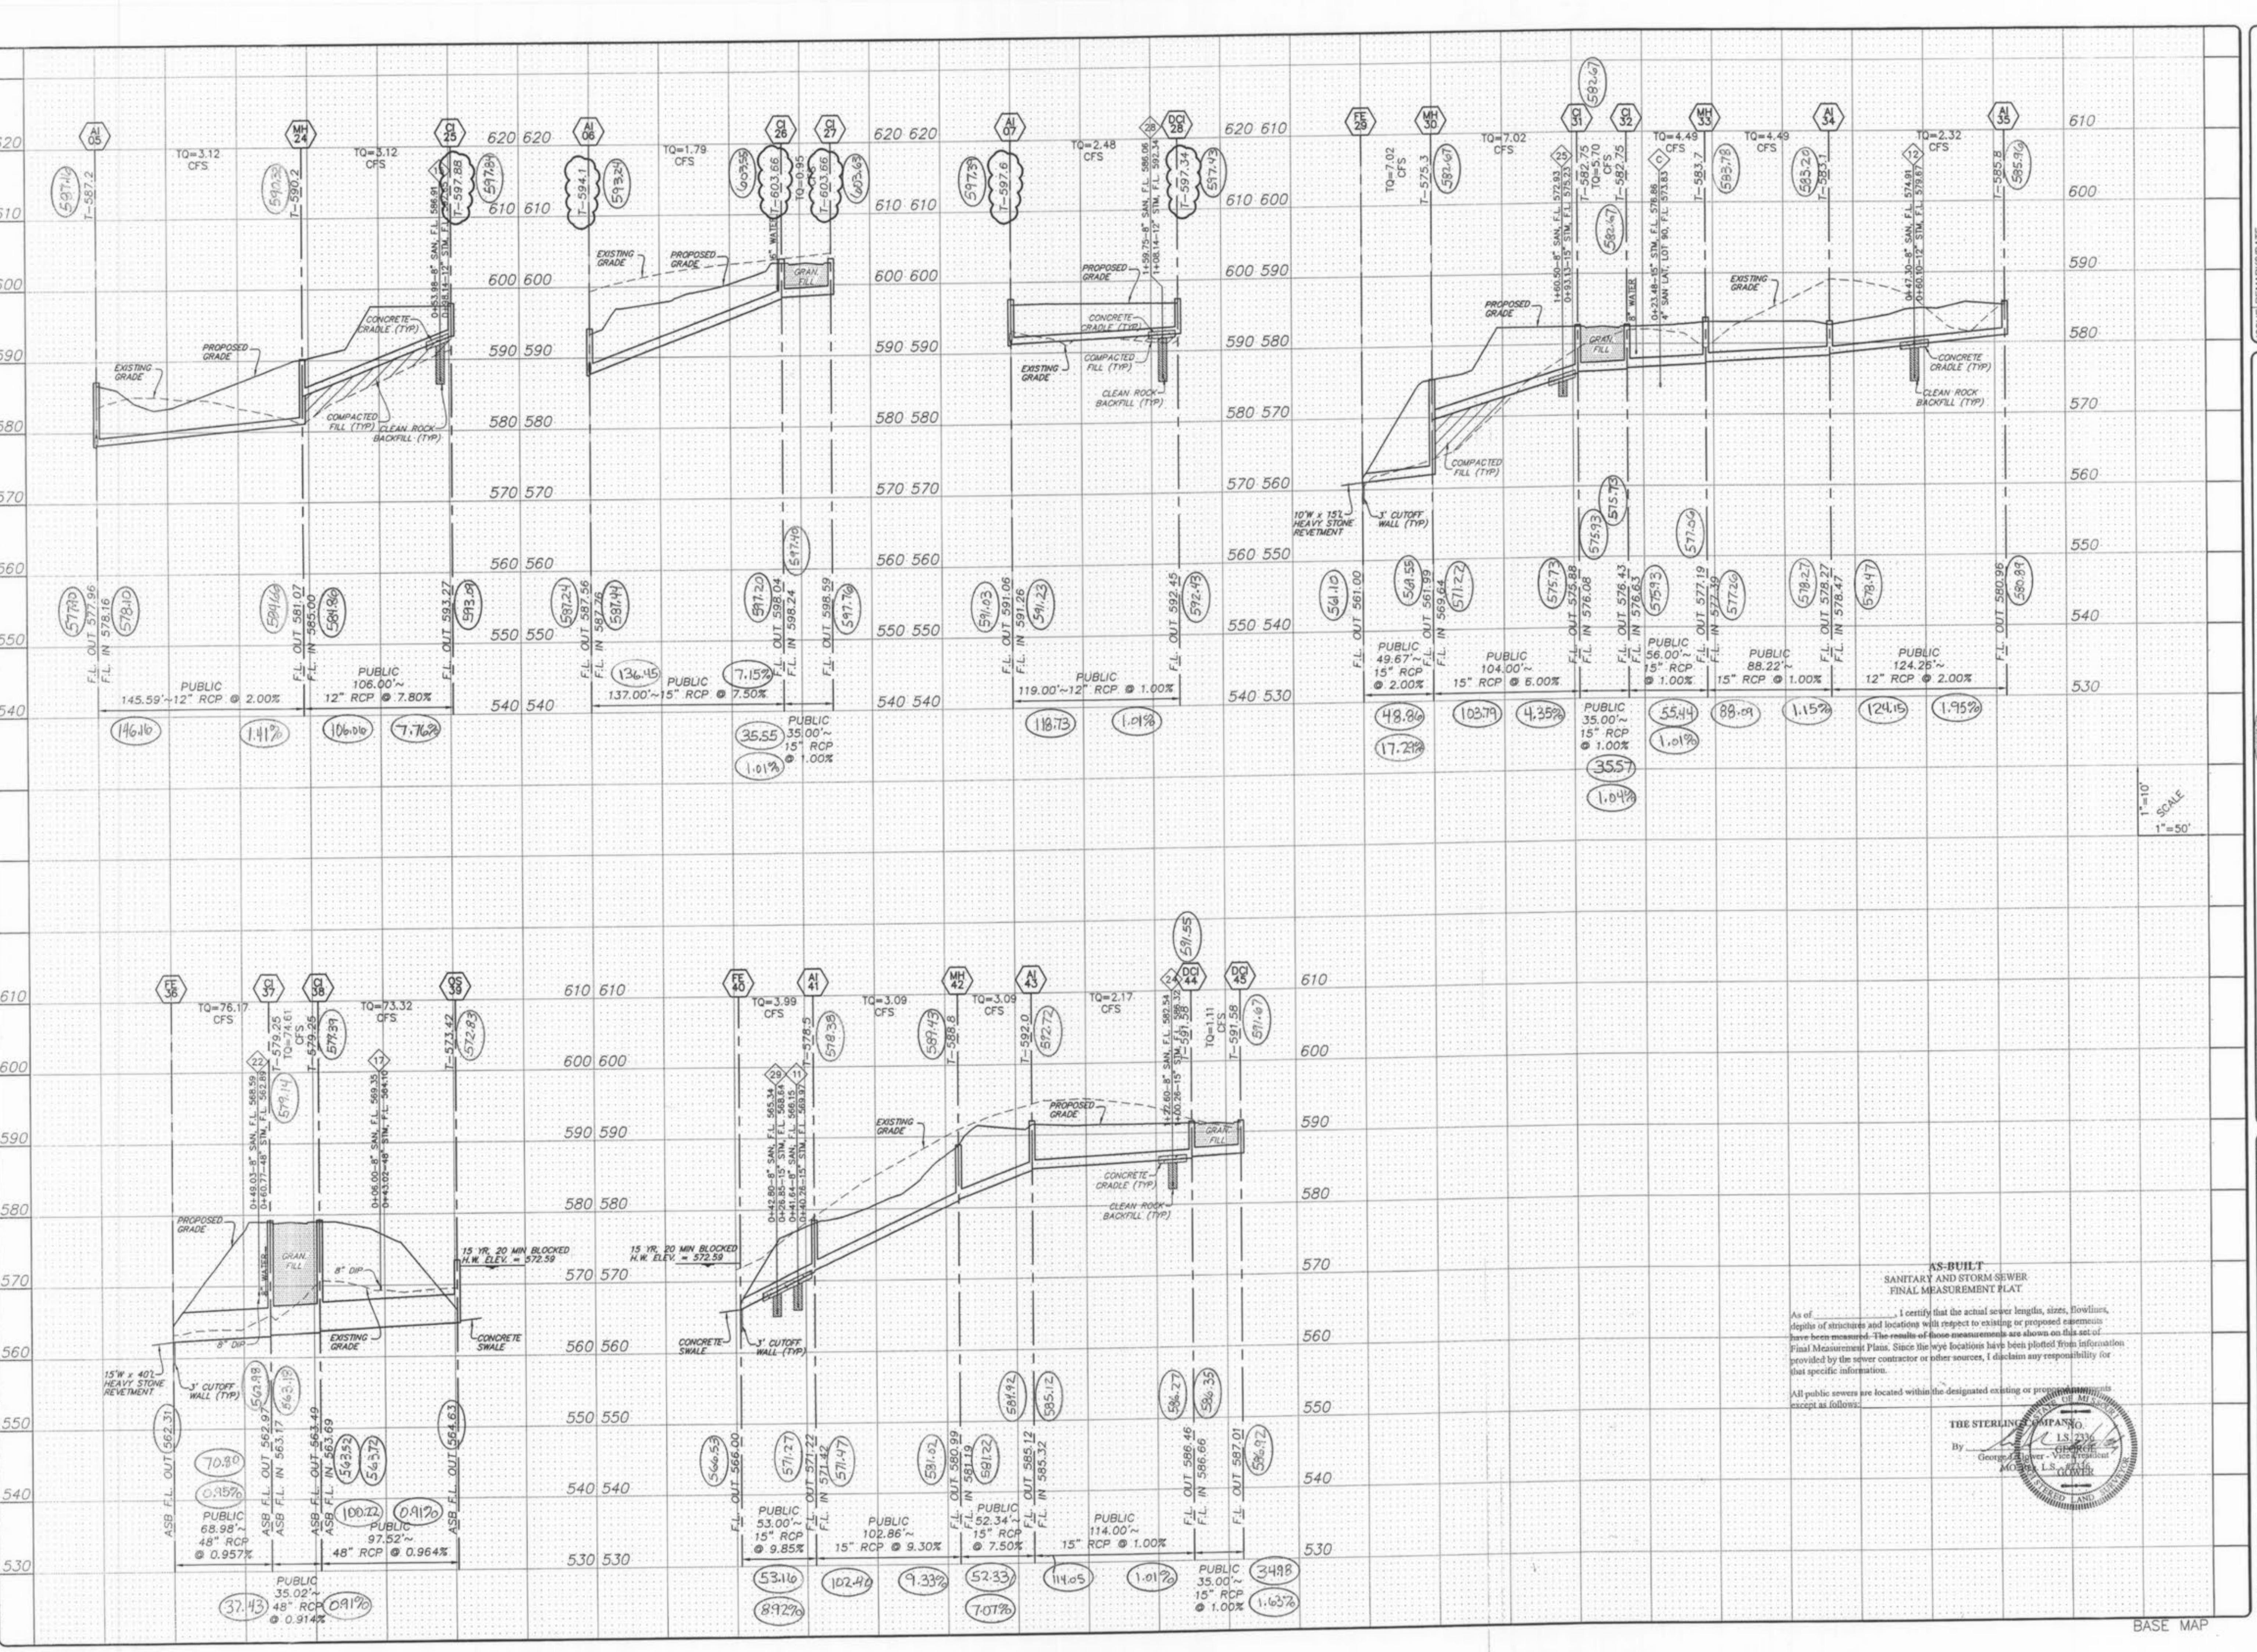


PREPARED FOR: McBride & Son Homes Land Development, Inc.
#1 McBride & Son Center Drive
Chesterfield, Missouri 63005
(636) 534-2000

1 03-01-04 FIRST SUBMITTAL
2 06-15-04 REVISED PER CITY & DCSD COMMENTS
3 07-20-04 REVISED PER CITY COMMENTS
4 08-04-04 REVISED PER DCSD COMMENTS
5 08-12-04 REVISED PER PWSF2 COMMENTS
6 10-18-04 REVISED PER DEVELOPER COMMENTS
7 04-21-05 REVISED OUTFALL STRUCTURE 02
8 06-14-05 GRADING COMMENTS PER DEVELOPER



THE STERLING CO.
ENGINEERS & SURVEYORS
5015 NEW BAUMGARTNER ROAD
ST. LOUIS, MISSOURI 63129
(314) 462-2440 AX: 462-8844
E-Mail: Sterling@sterling-ing-surf.com

DESIGNED: CHECKED:
AS-BUILT SANITARY AND STORM SEWER FINAL MEASUREMENT PLAT
As of [date] I certify that the actual sewer lengths, sizes, bowlines, depths of structures and locations with respect to existing or proposed easements have been measured. The results of those measurements are shown on this set of Final Measurement Plat. Since the wye locations have been plotted from information provided by the sewer contractor or other sources, I disclaim any responsibility for that specific information.
All public sewers are located within the designated existing or proposed easements except as follows:
THE STERLING COMPANY NO. LS 2336
By George J. Oliver - Vice President
MOS & L.S. GOLDBECK
REGISTERED LAND SURVEYOR

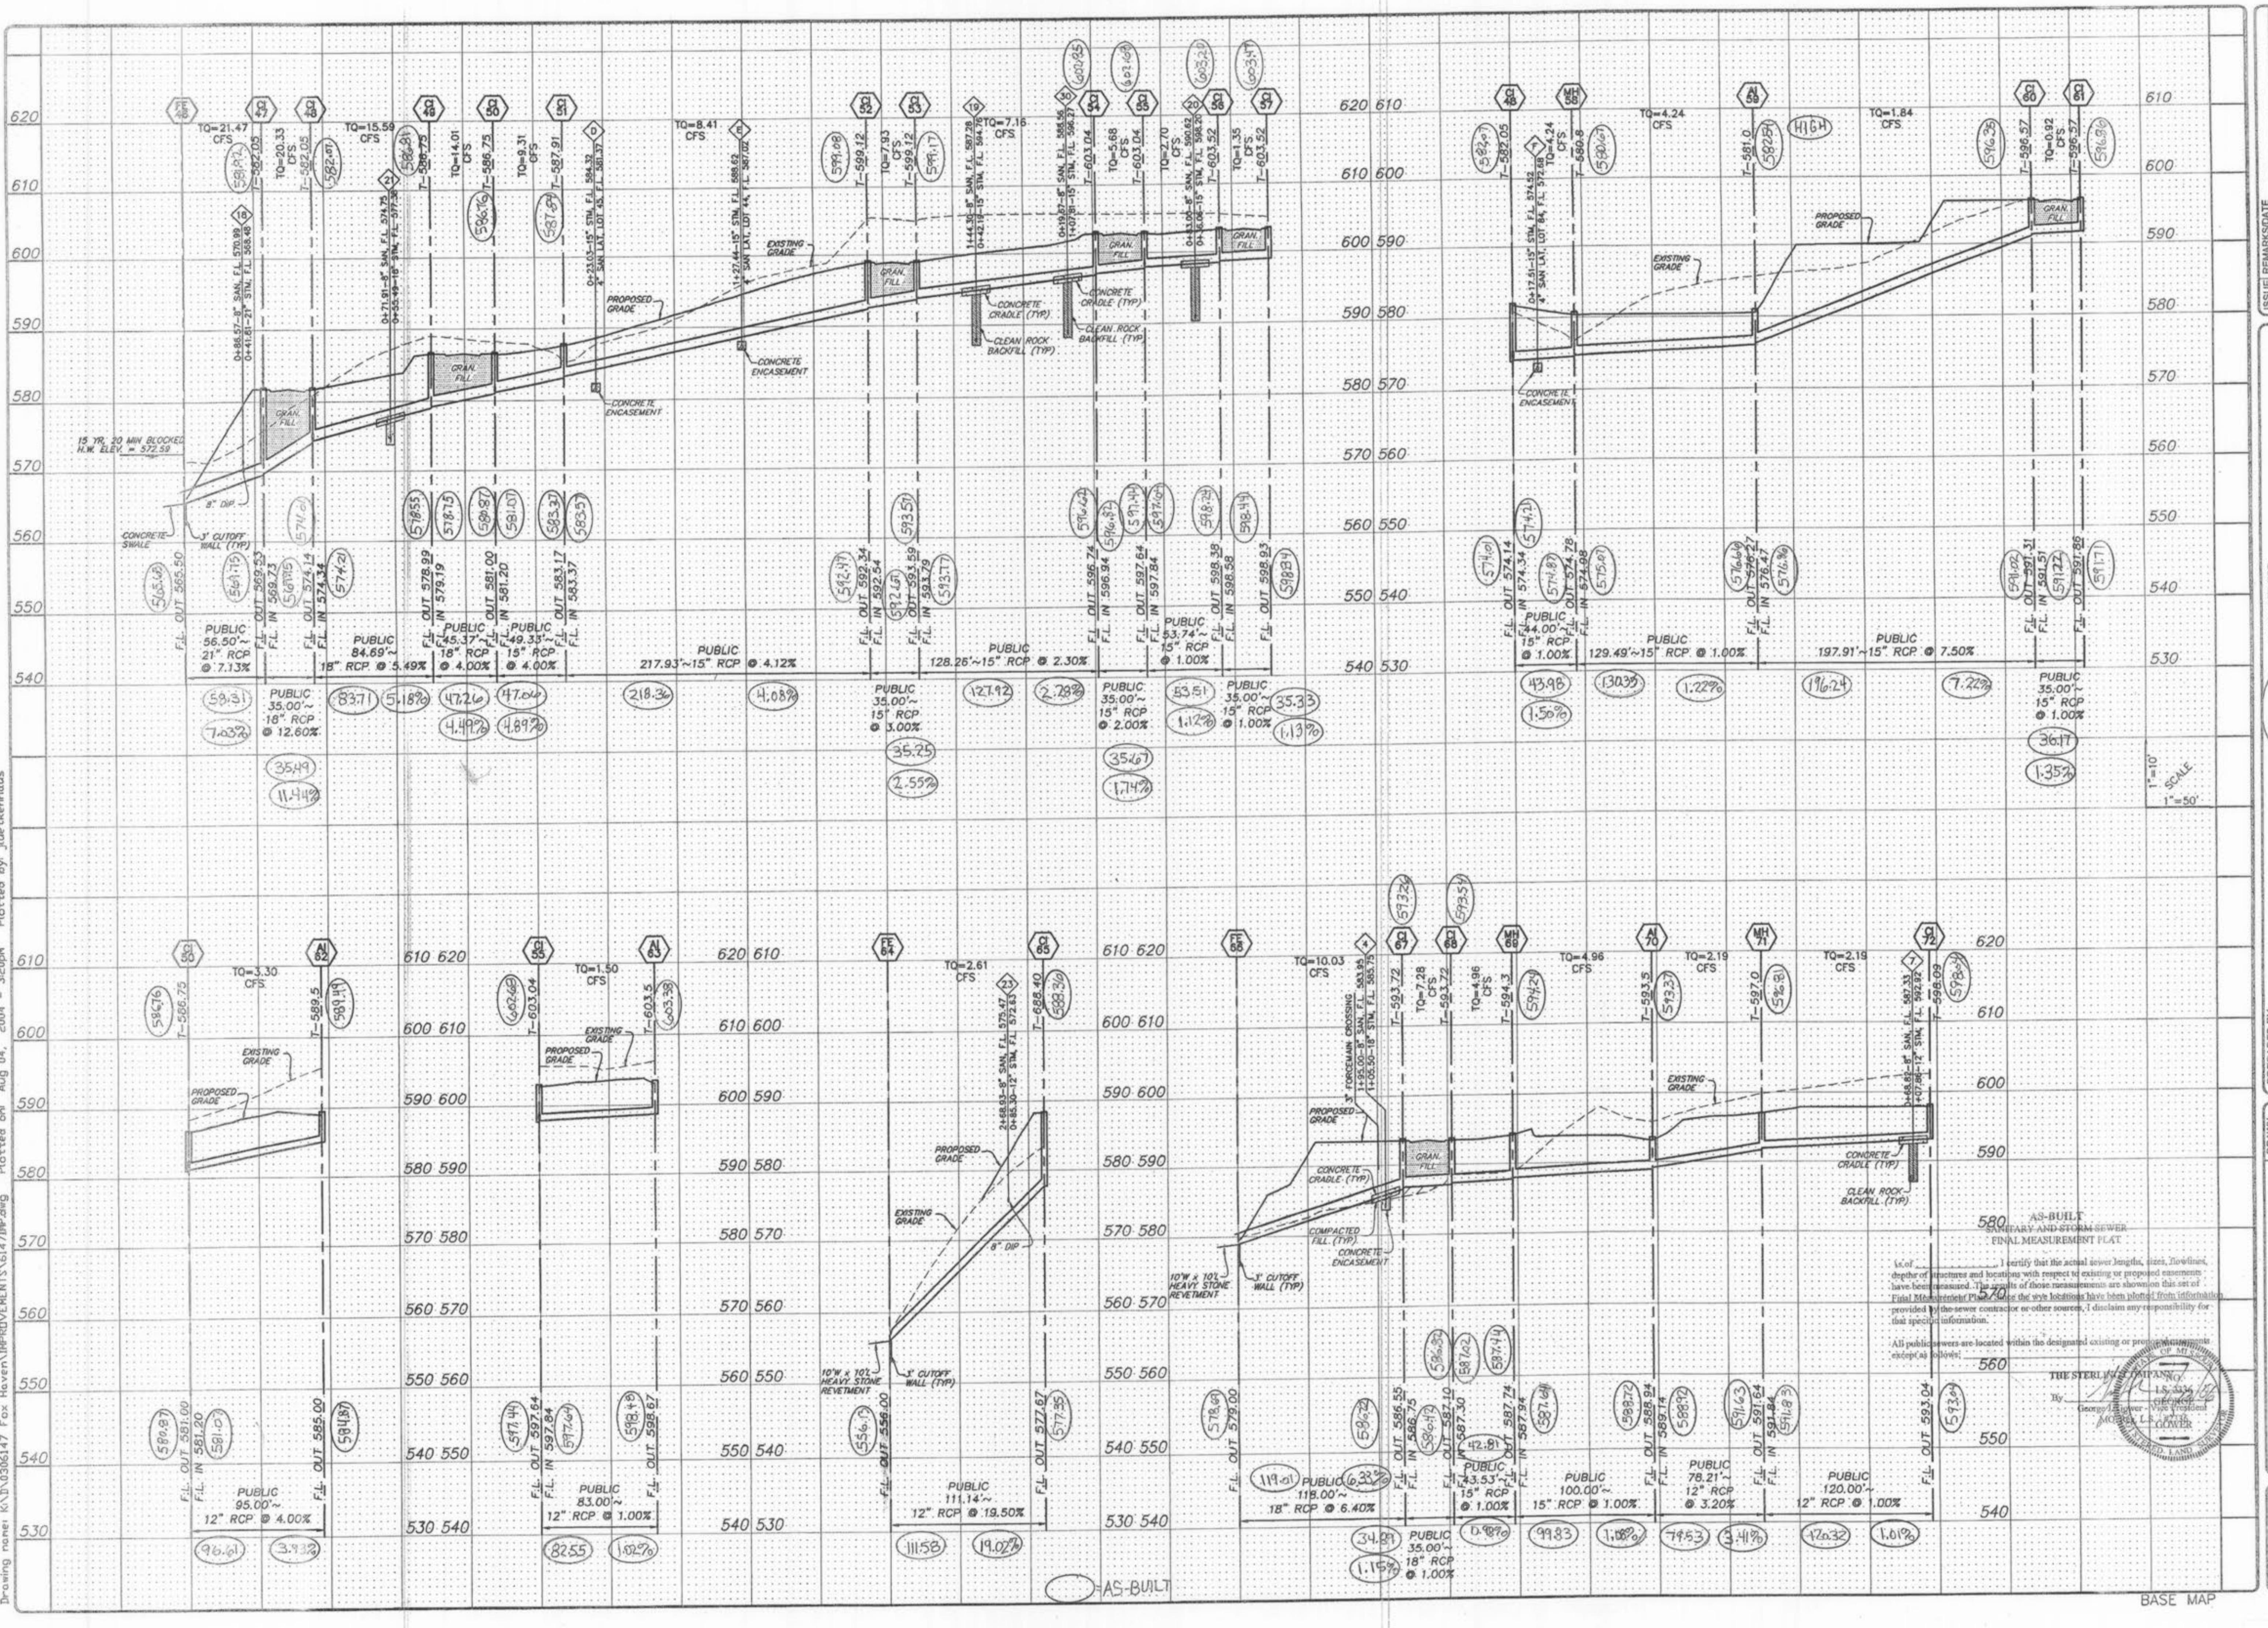

	06-15-04 REVISED PER CITY & DCSD COMMENTS
	07-20-04 REVISED PER CITY COMMENTS
	08-04-04 REVISED PER DCSD COMMENTS

*McBride & Son Homes
Land Development, Inc.*
#1 McBride & Son Center Drive
Gainesville, GA 30505

Waterfield, Missouri 63005
(636) 534-2000

THE

E-Ma
(31)
ST
5055
ENGI

114

FOX HAVEN


SHEET TIT

3 08 147

SHEET
20

48
OF

oxhaven As Builts 12/22

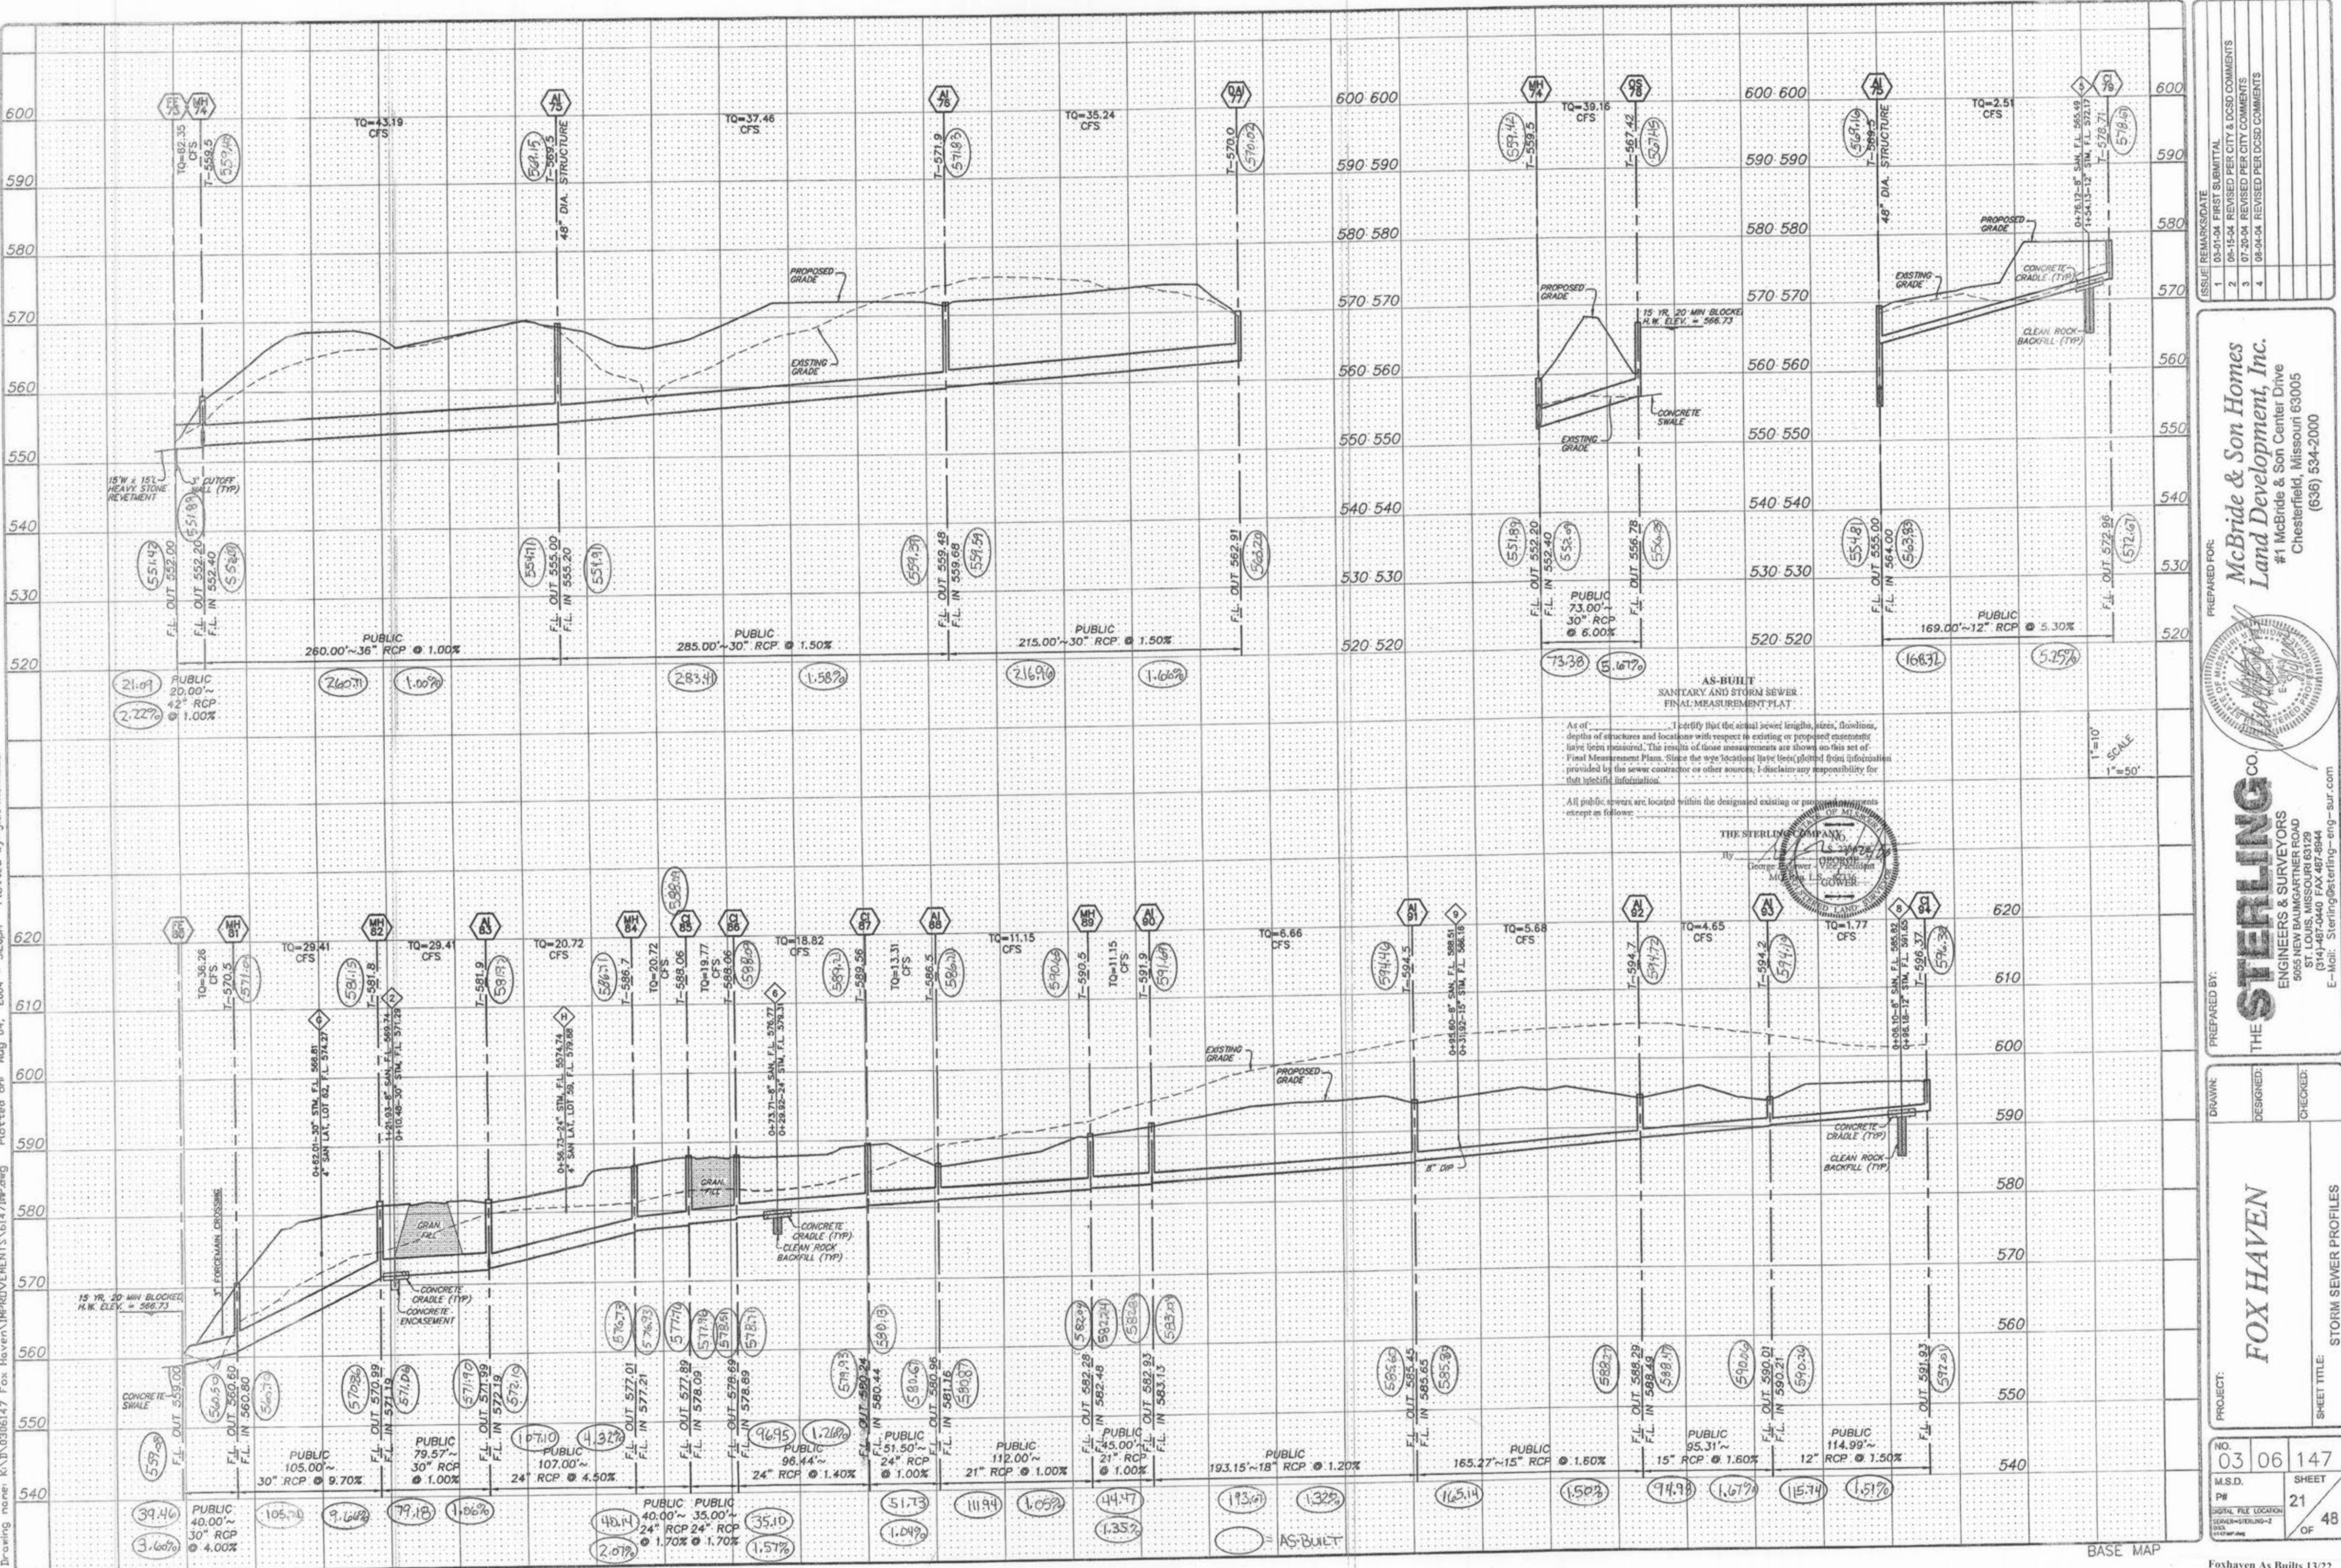

PROJECT:

NO. 03 06

M.S.D.

P#

DIGITAL FILE LOCATION

G:\ENR\STERLING-Z

DWG

JPG

SHEET

21

OF

147

48

48


48

48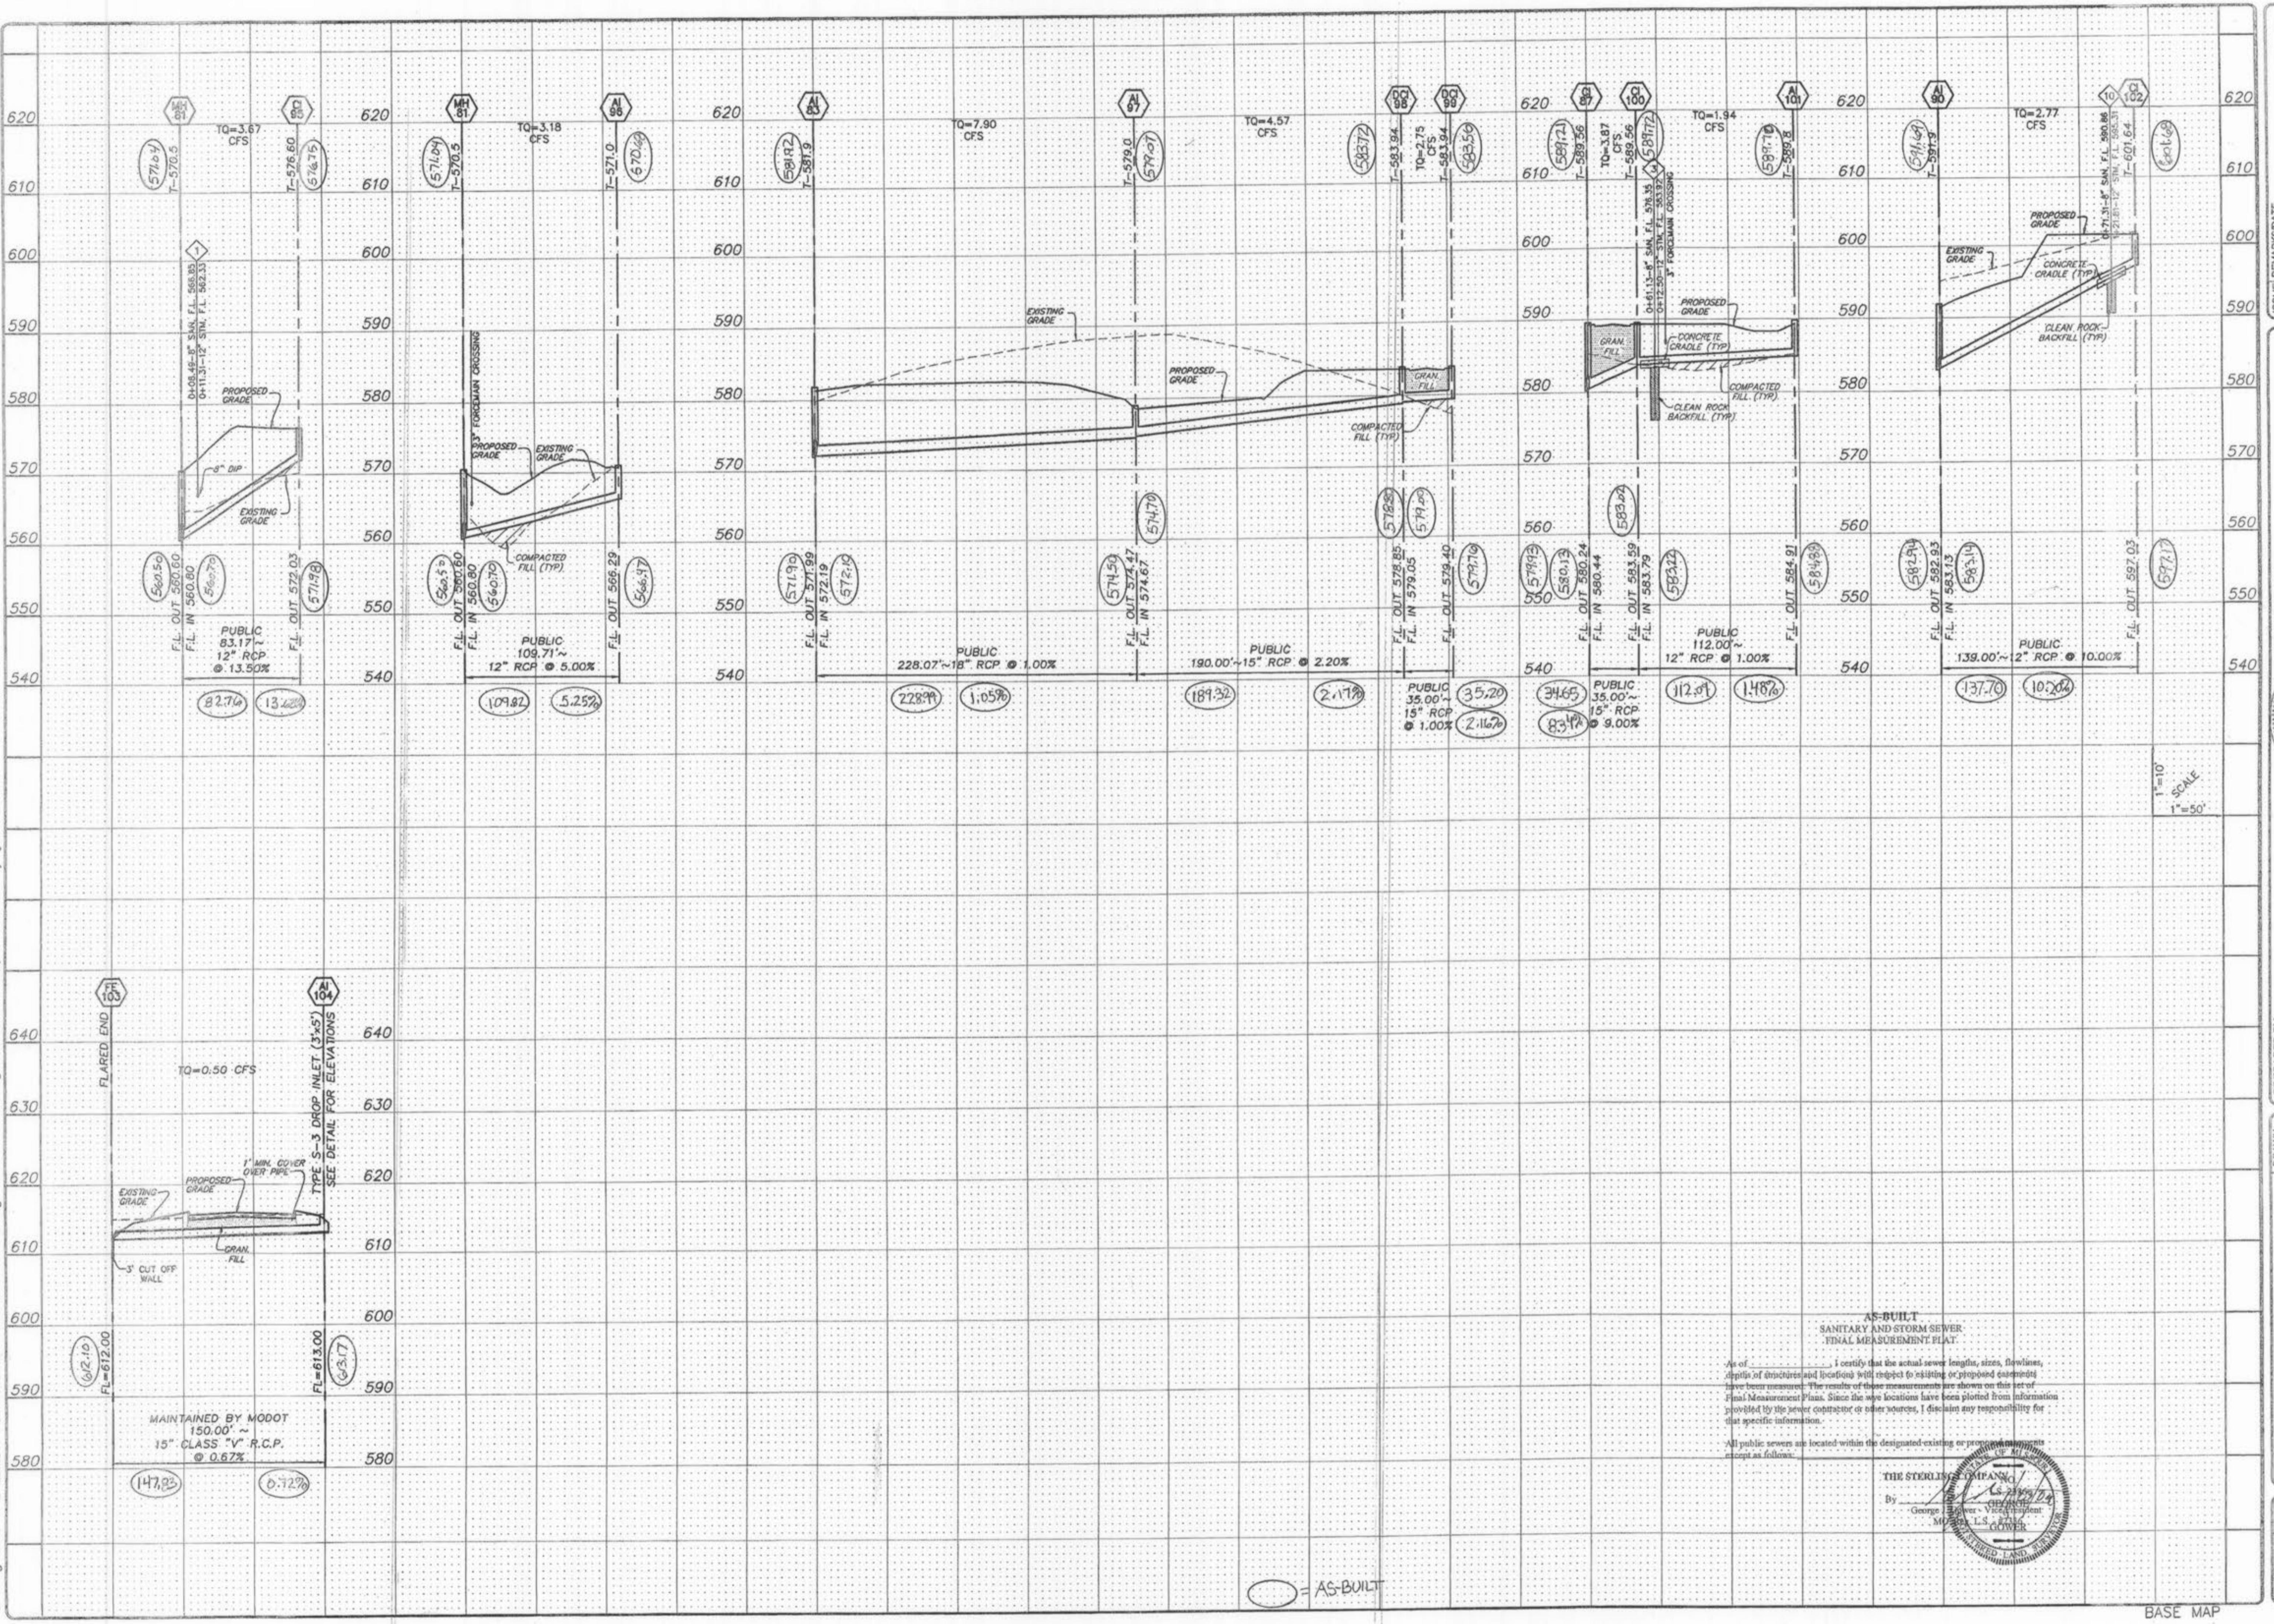

ISSUE / REMARKS DATE

1 05-01-04 FIRST SUBMITTAL

2 06-15-04 REVISED PER CITY & OGD COMMENTS

3 07-20-04 REVISED PER CITY COMMENTS

4 08-04-04 REVISED PER OGD COMMENTS

**McBride & Son Homes
Land Development, Inc.**

#1 McBride & Son Center Drive
Chesterfield, Missouri 63005
(314) 534-2000



PREPARED FOR:
THE STERLING CO.

ENGINEERS & SURVEYORS

5065 NEW BANGARTNER ROAD

ST. LOUIS, MISSOURI 63128

(314) 458-3440 FAX (314) 458-3944






E-Mail: Sterling@sterling-eng-sur.com

DRAWN: THE STERLING CO.
DESIGNED: THE STERLING CO.
CHECKED: THE STERLING CO.

PROJECT: FOX HAVEN
NO. 03 06 147
M.S.D. SHEET 22 OF 48
#147
FILE LOCATION: SERVER-STERLING-2
DATA: 441CMBJ.dwg

SHEET TITLE: STORM SEWER PROFILES


BASE MAP

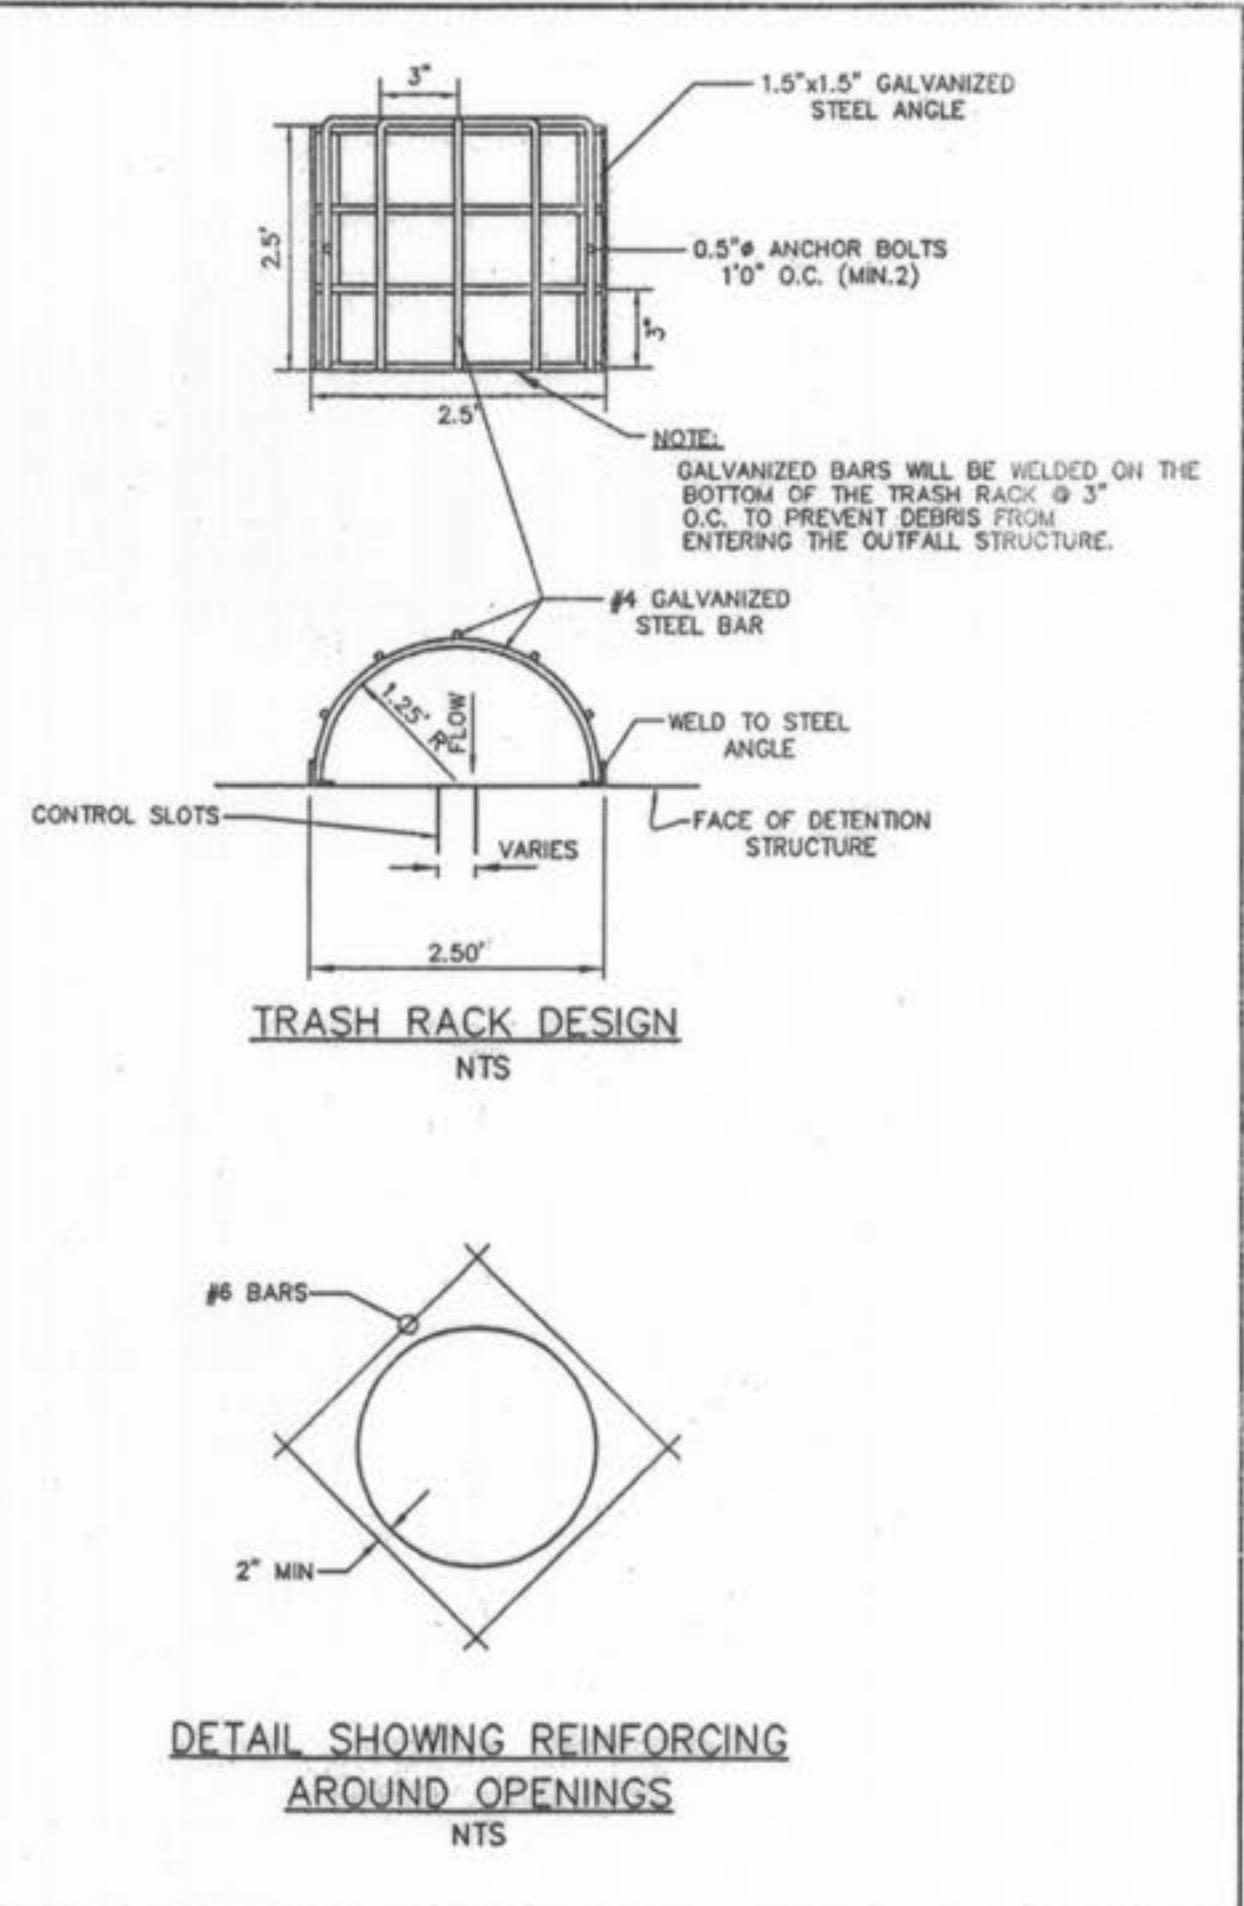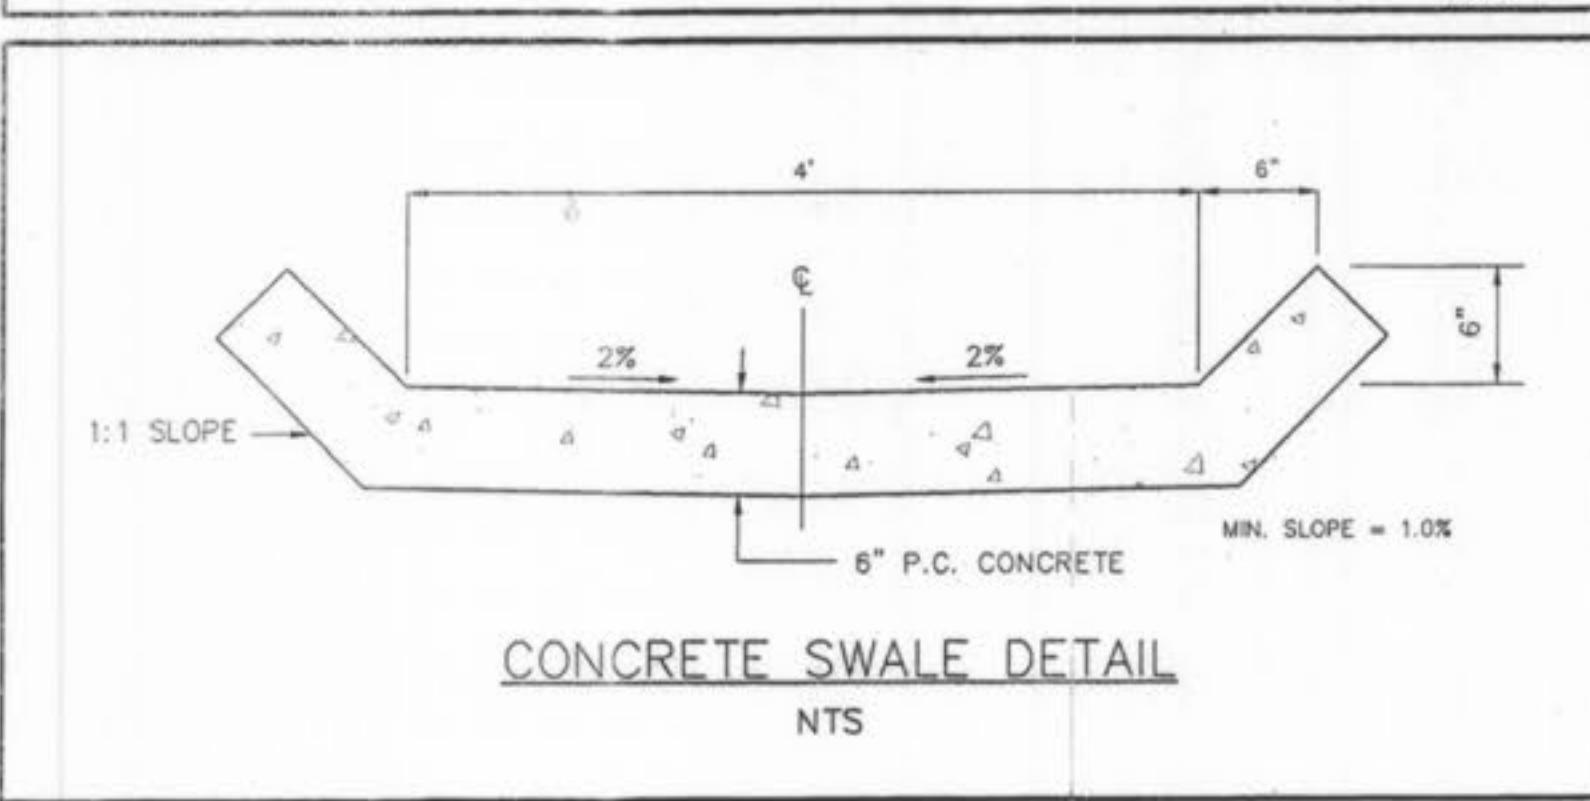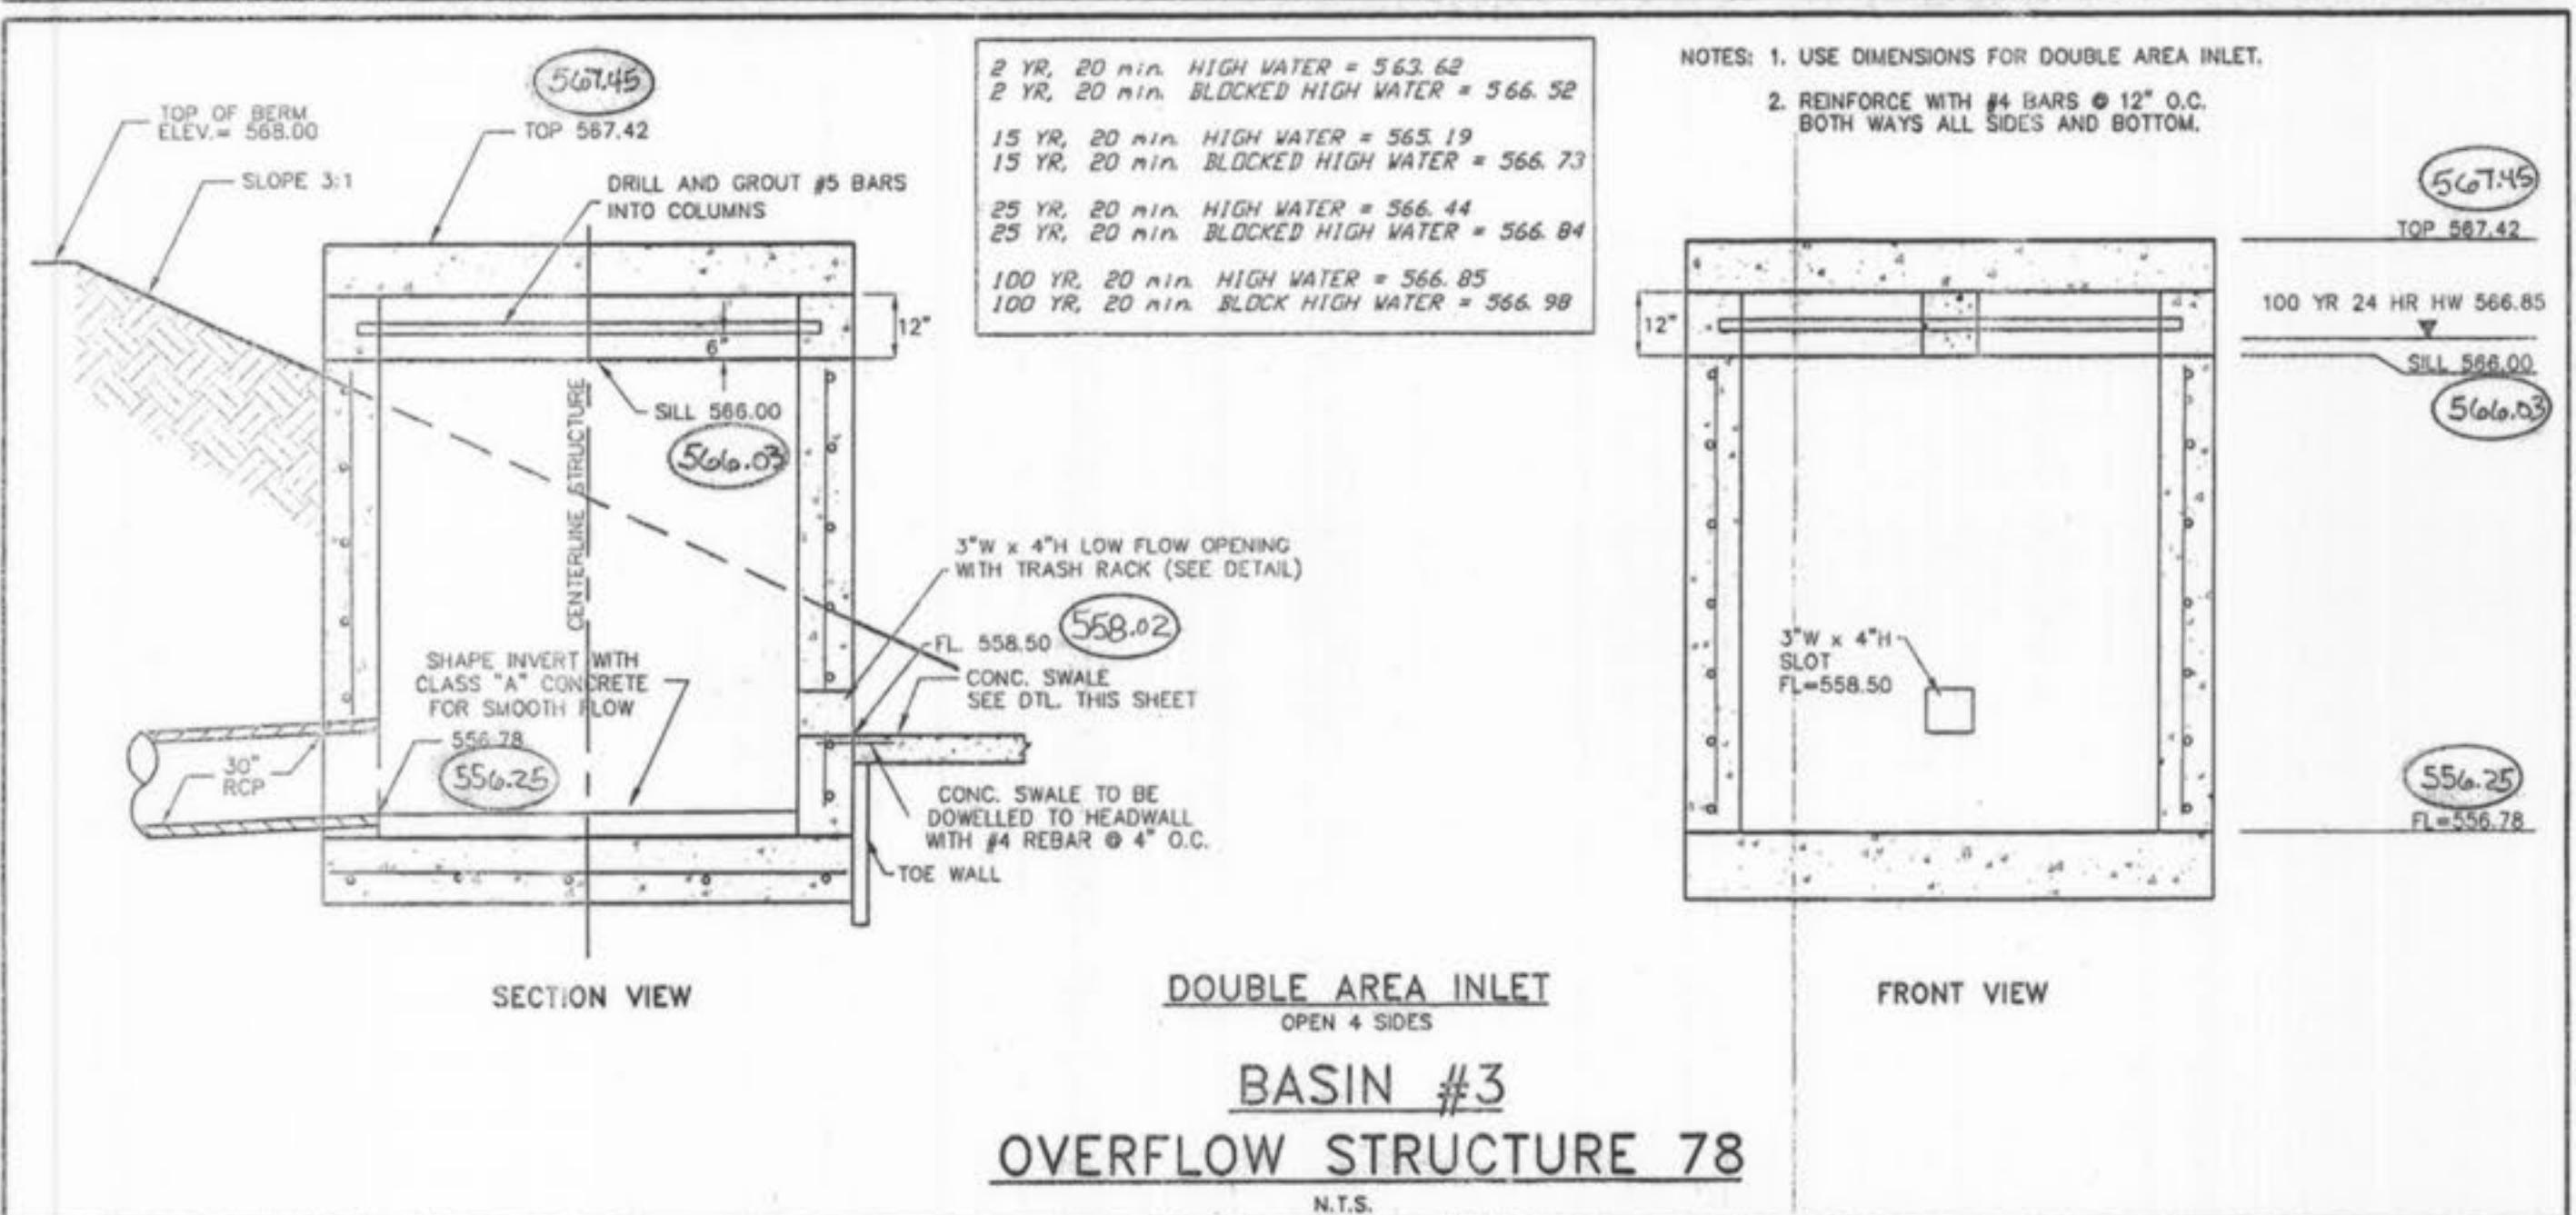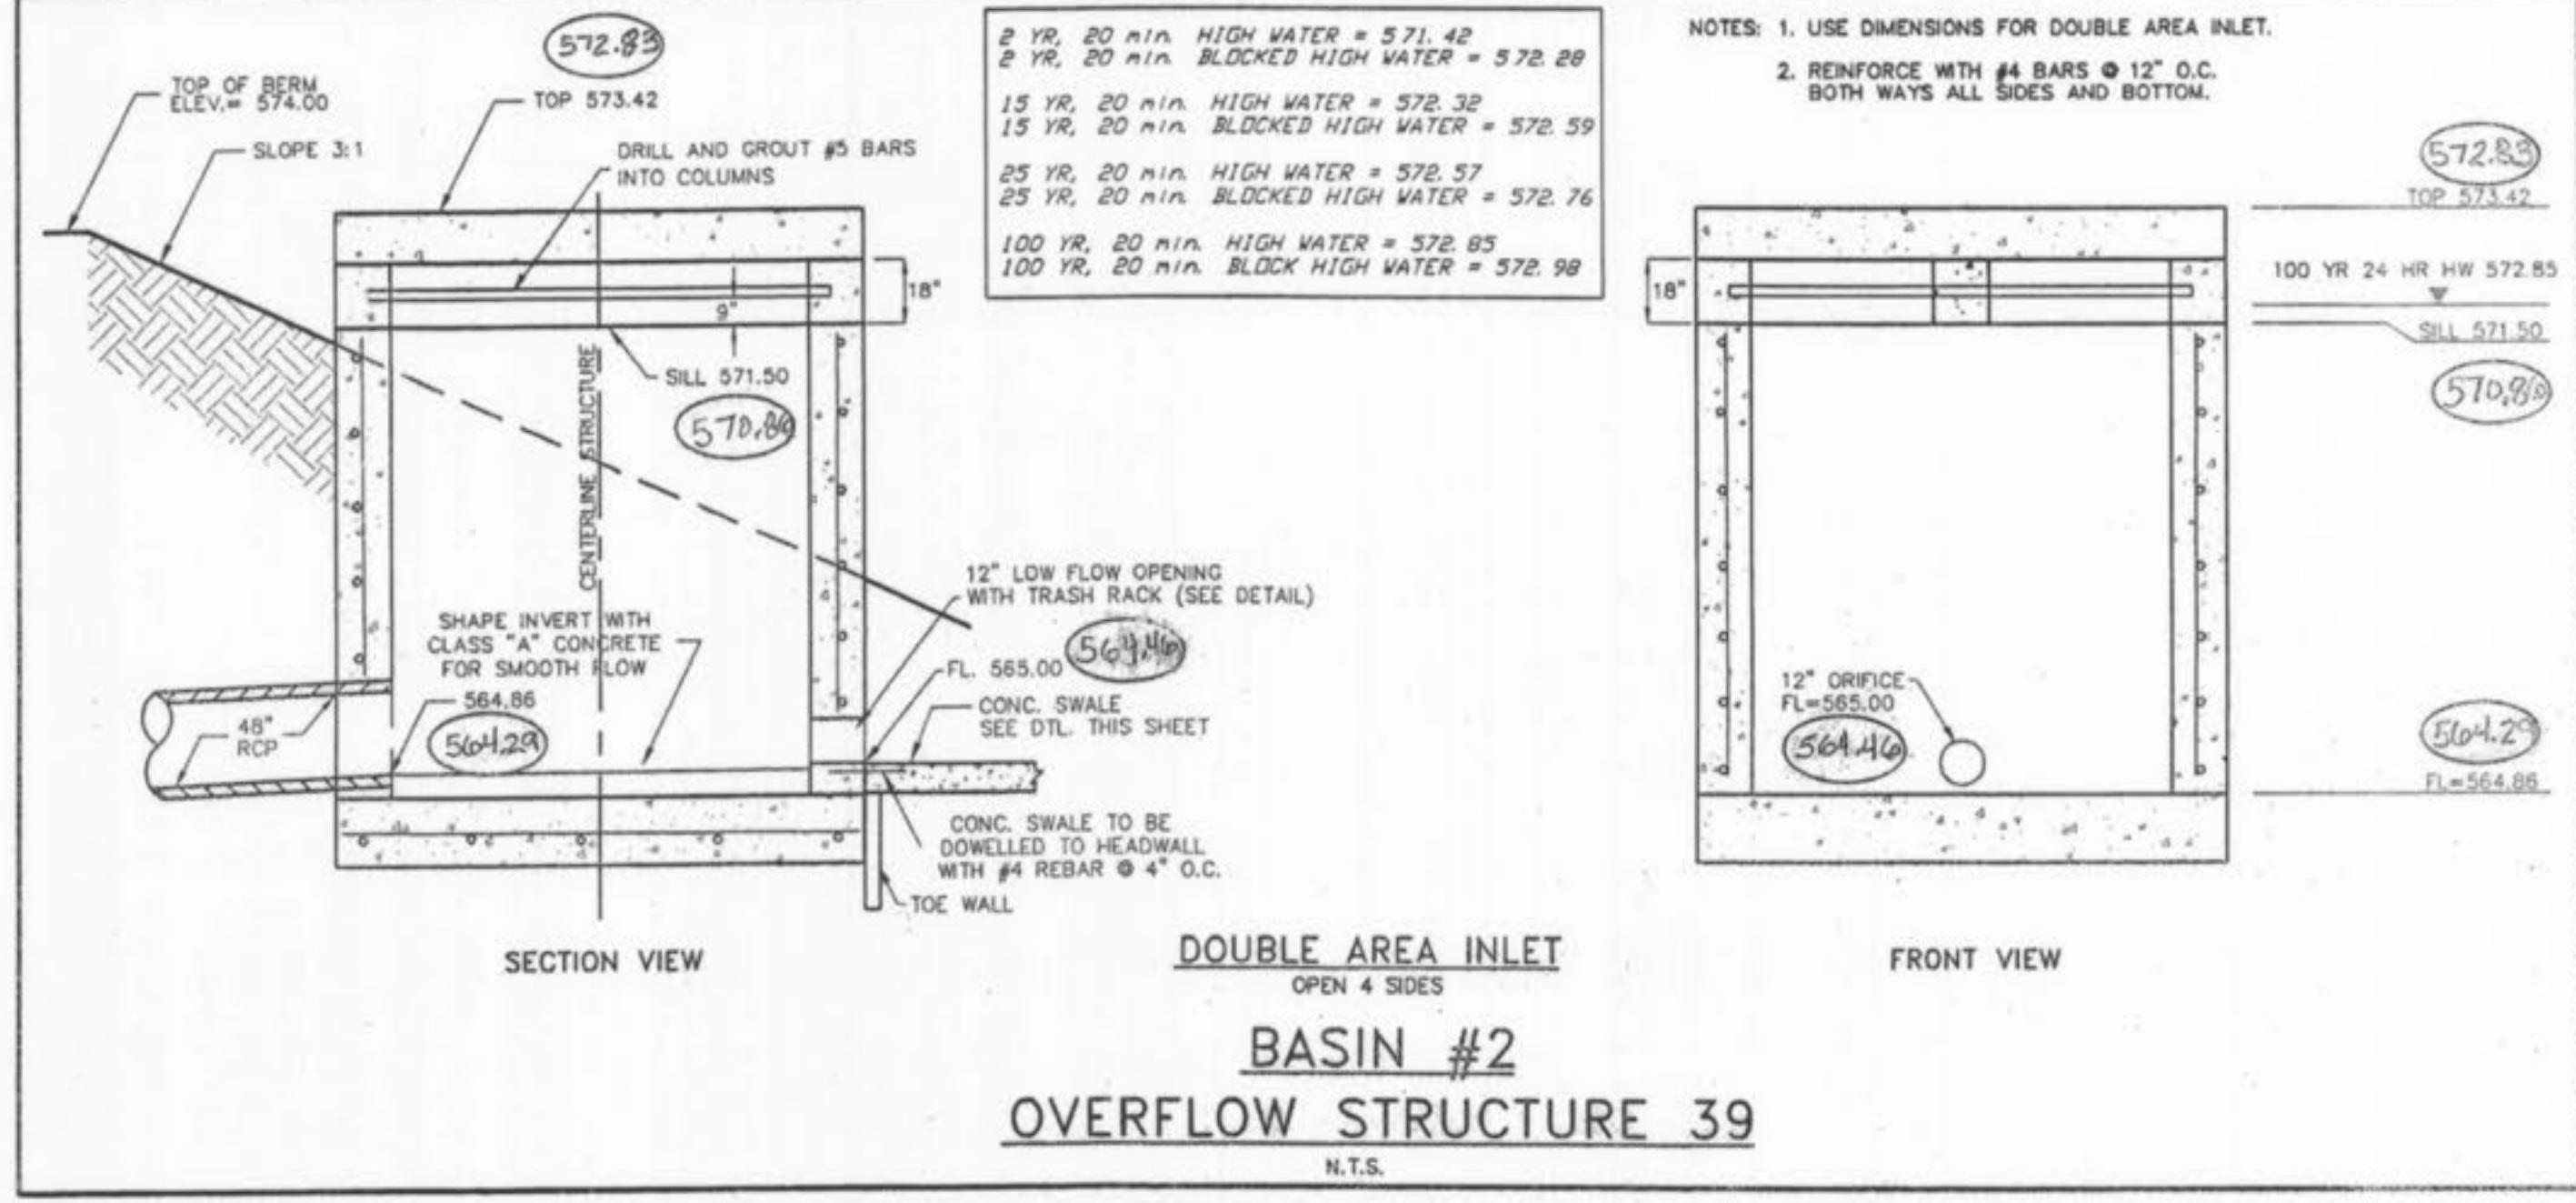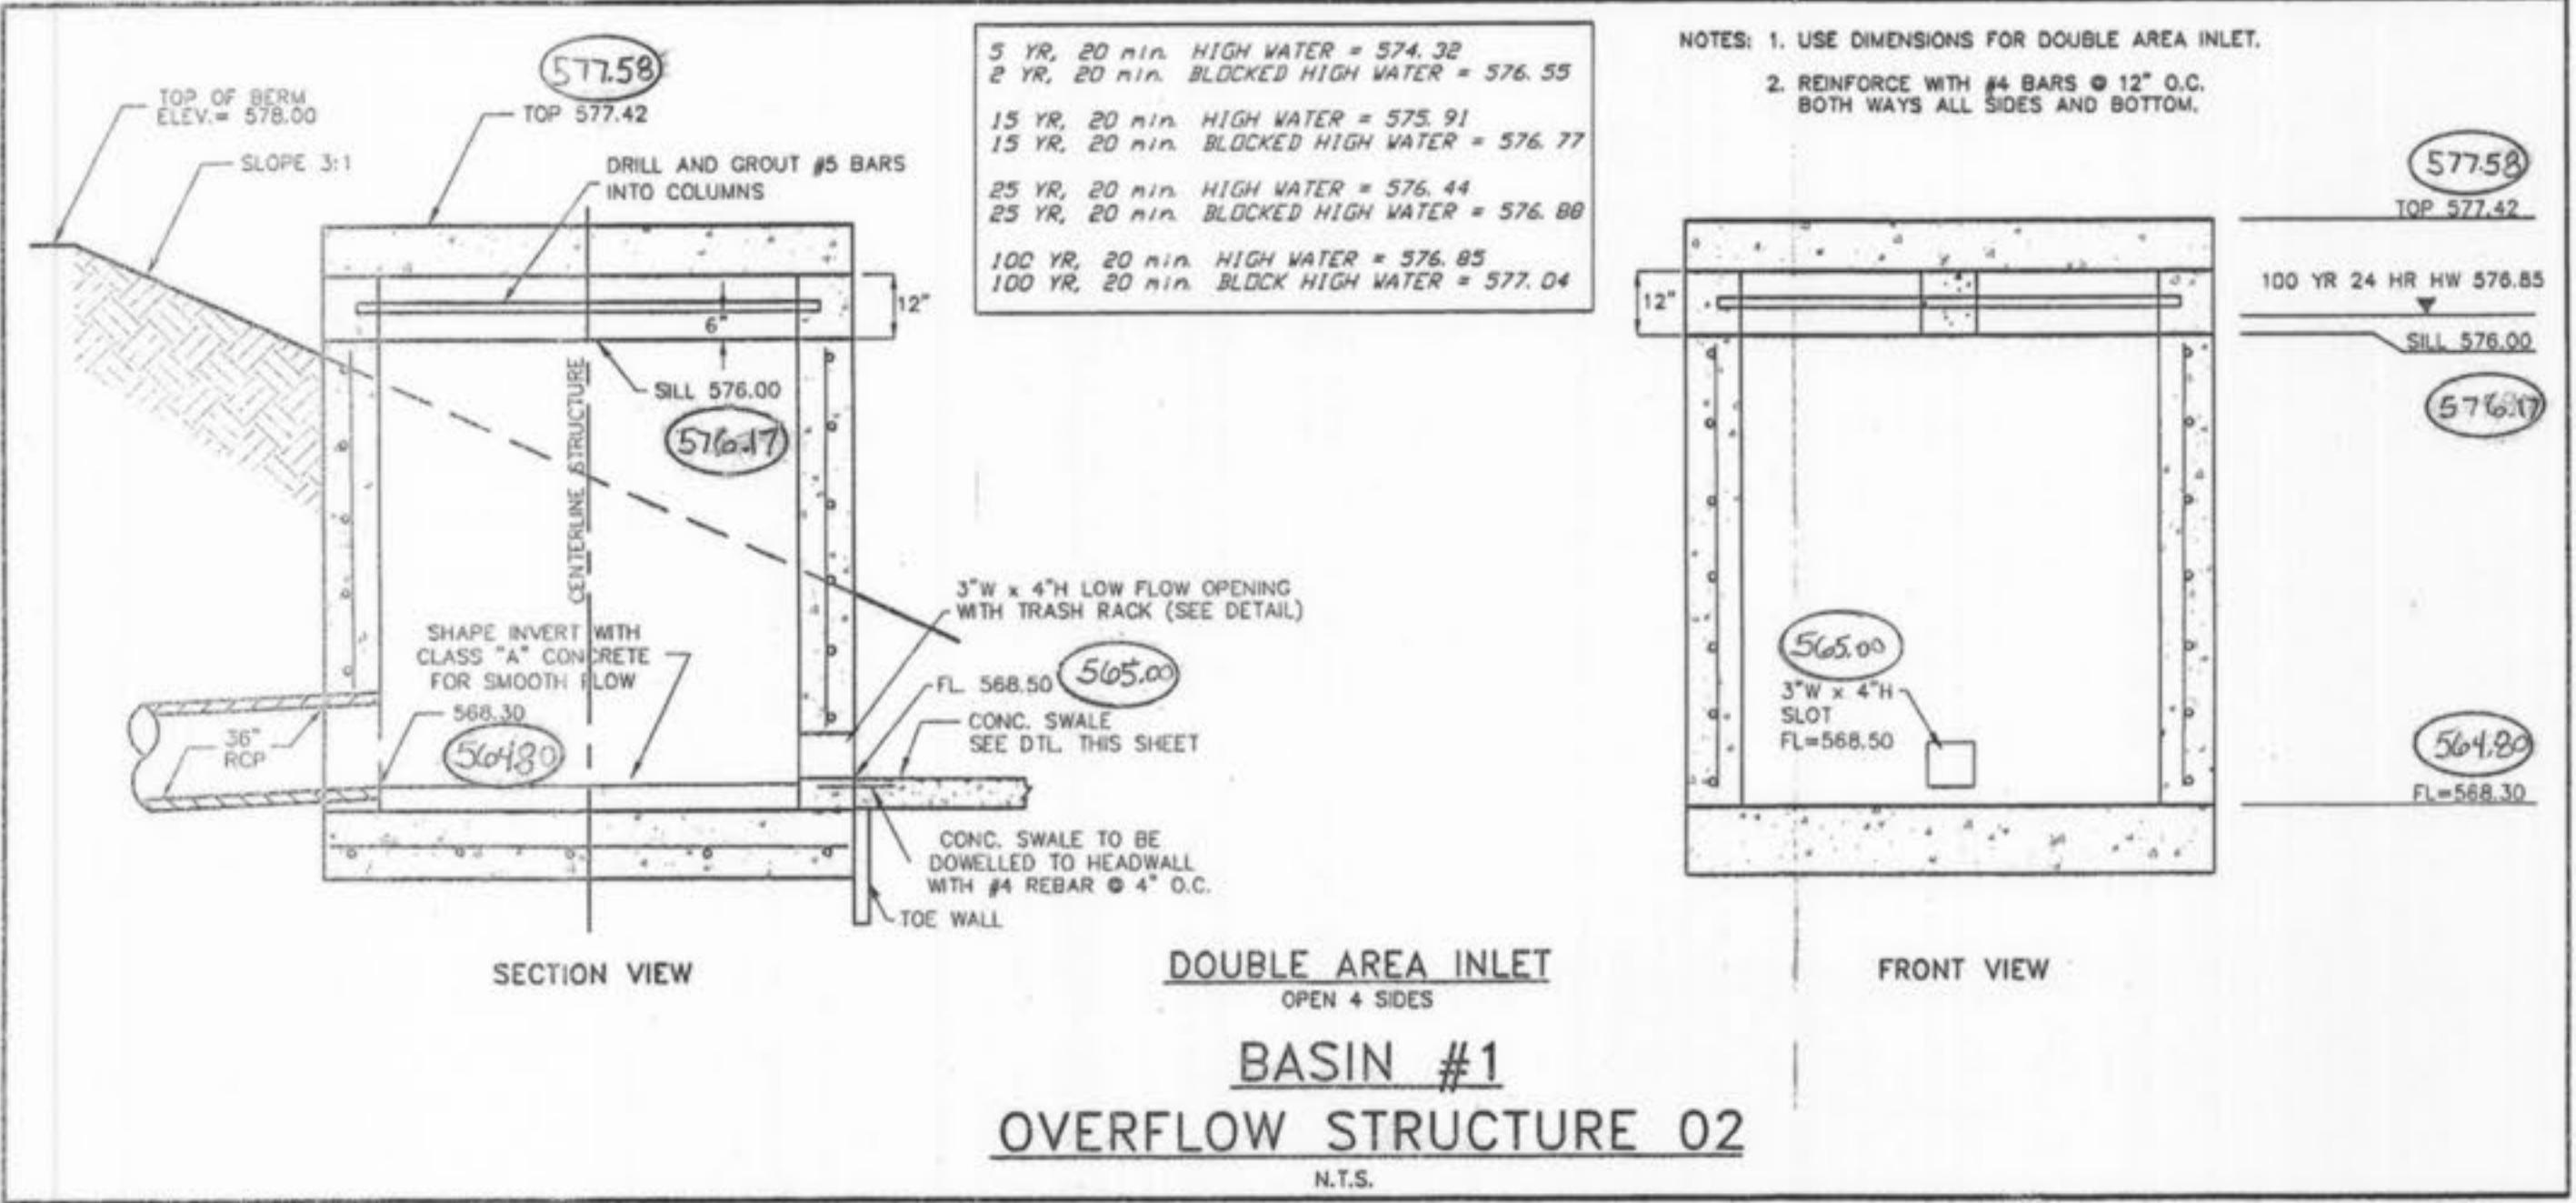

AS-BUILT
SANITARY AND STORM SEWER
FINAL MEASUREMENT PLAT

As of _____, I certify that the actual sewer lengths, sizes, flowlines, depths of structures and locations with respect to existing or proposed easements have been measured. The results of those measurements are shown on this set of Final Measurement Plans. Since the wye locations have been plotted from information provided by the sewer contractor or other sources, I disclaim any responsibility for that specific information.

All public sewers are located within the designated existing or proposed alignments, except as follows:

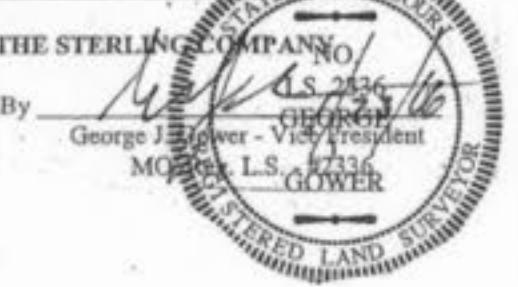

ISSUE/REMARKS/DATE
1 08-01-04 FIRST SUBMITTAL
2 08-15-04 REVISED FOR CITY & DCSD COMMENTS
3 07-20-04 REVISED FOR CITY COMMENTS







**McBride & Son Homes
Land Development, Inc.**
#1 McBride & Son Center Drive
Chesterfield, Missouri 63005
(636) 537-2000

PREPARED FOR:
Phil Mattox
CO. OF STERLING
ENGINEERS & SURVEYORS
5065 NEW BAUMGARTNER ROAD
ST. LOUIS, MISSOURI 63129
(314) 487-0440 FAX 487-5844
E-Mail: Sterling@sterling-eng-sur.com

DRAWN: THE STERLING COMPANY
DESIGNED: THE STERLING COMPANY
CHECKED: THE STERLING COMPANY
PROJECT: FOX HAVEN
SHEET TITLE: OUTFALL STRUCTURE DETAILS




NO. 03 06 147
M.S.D. SHEET
P# 27
DIGITAL FILE LOCATION: S:\G\STERLING\2
SHEET NUMBER: 27
OF 48

BASE MAP

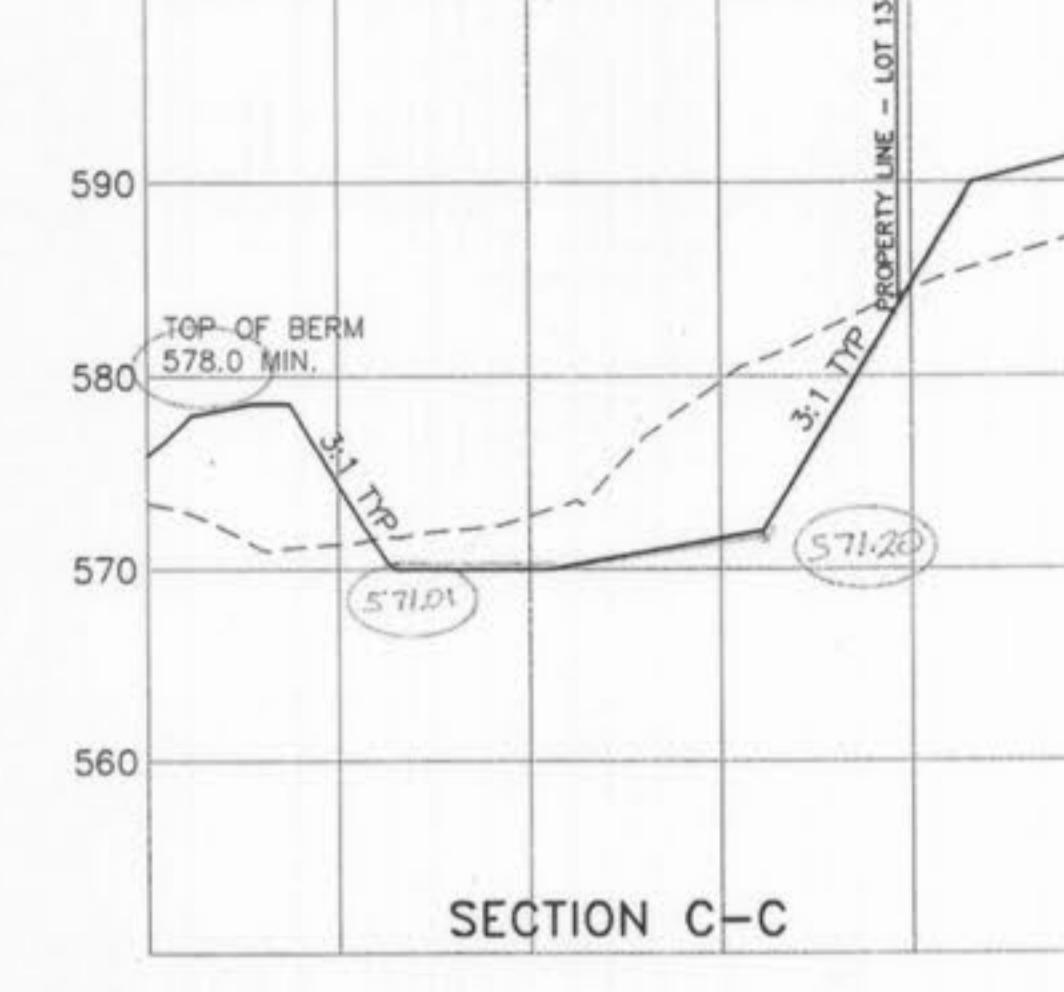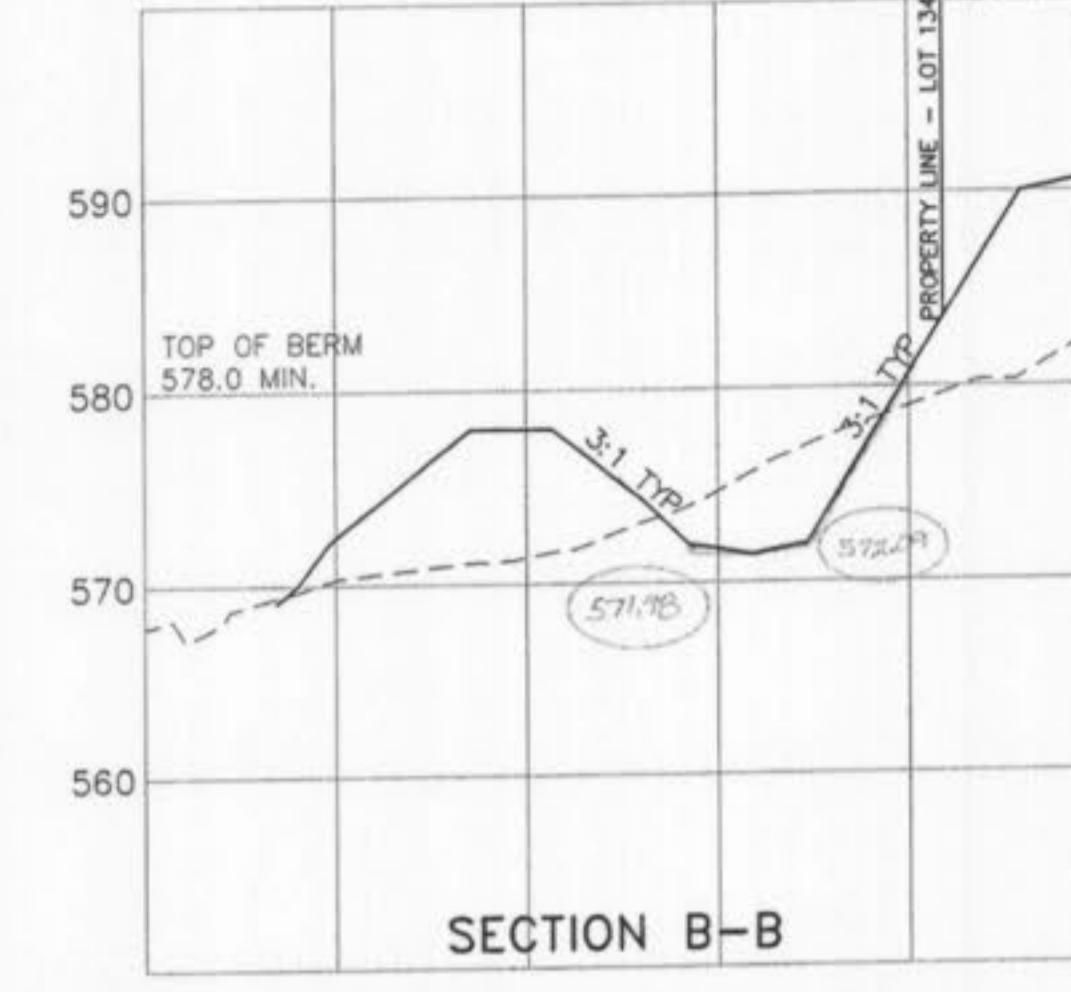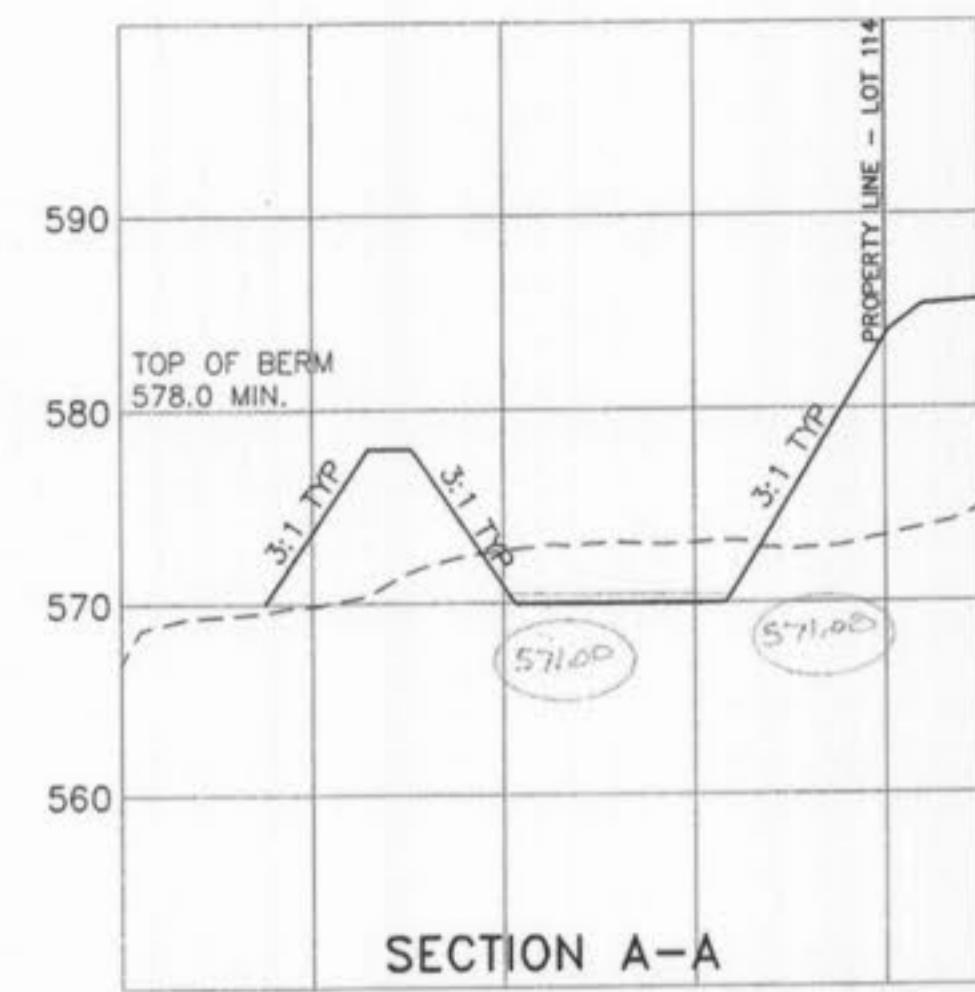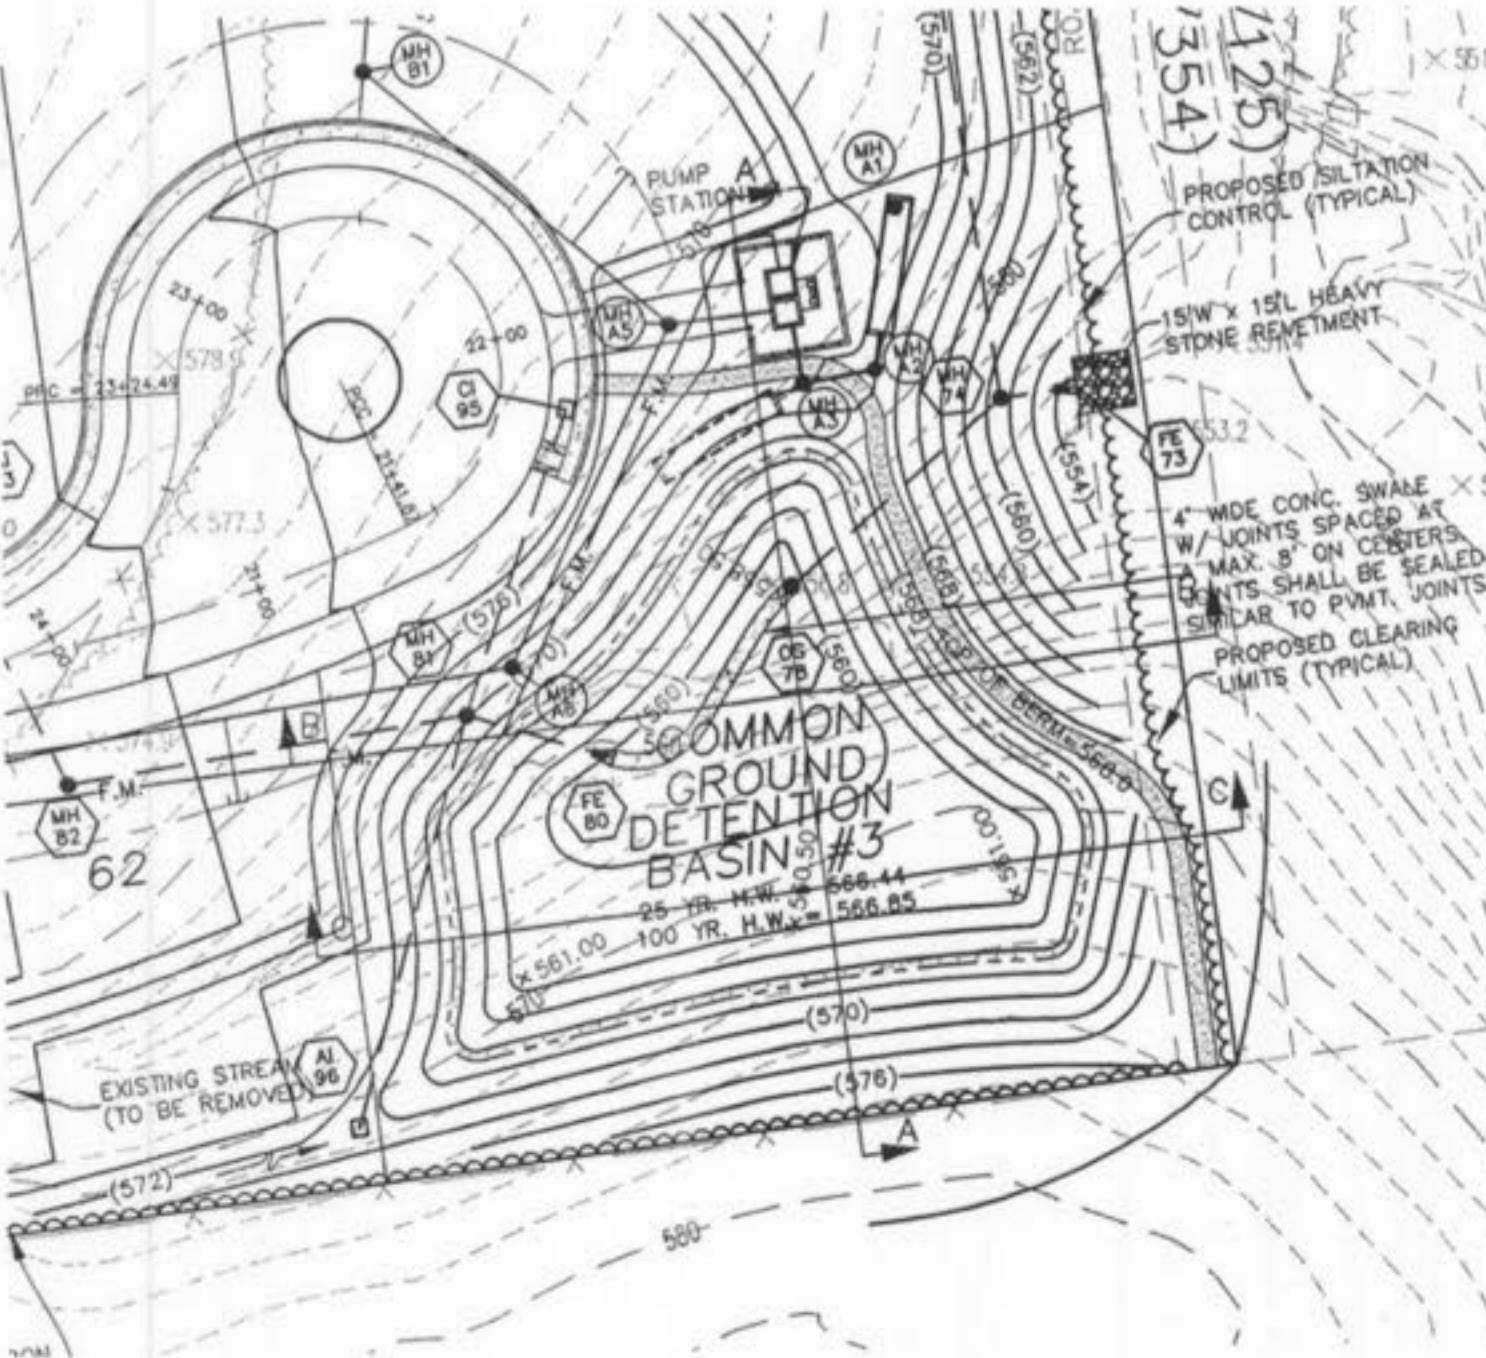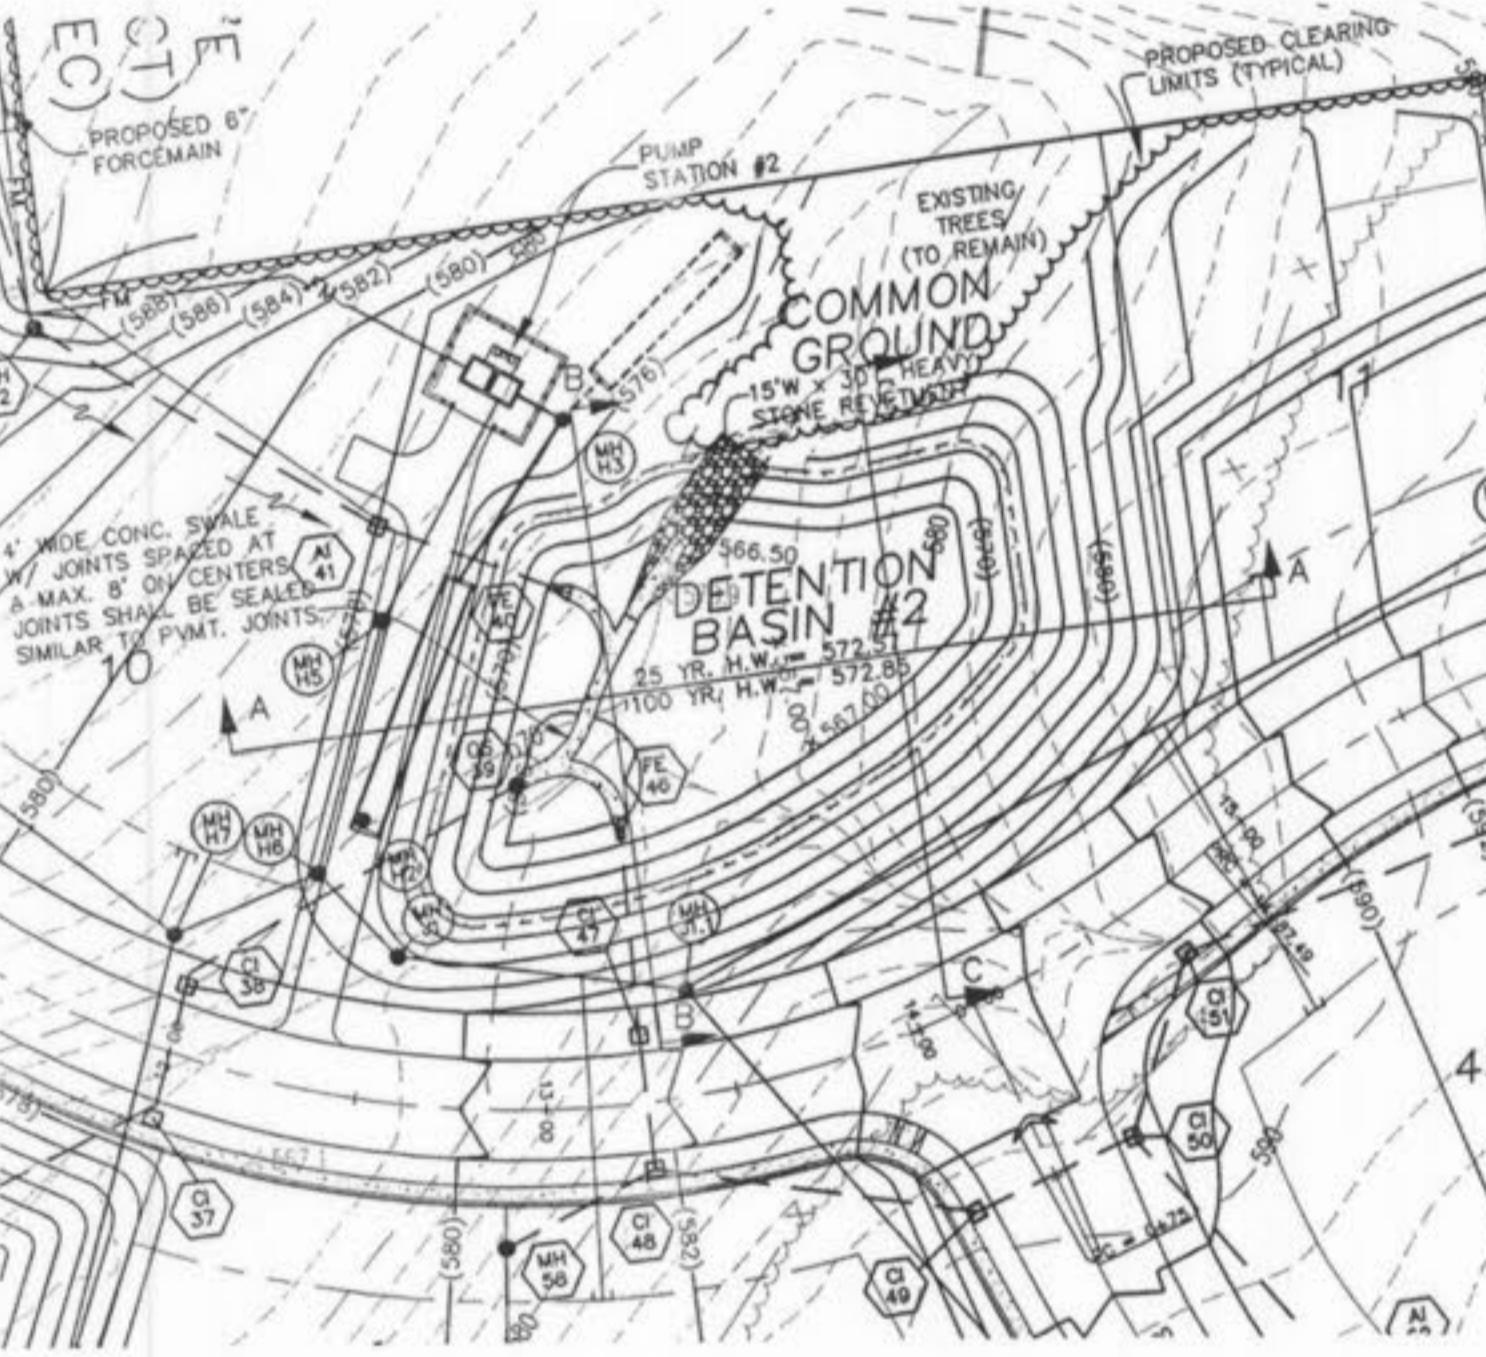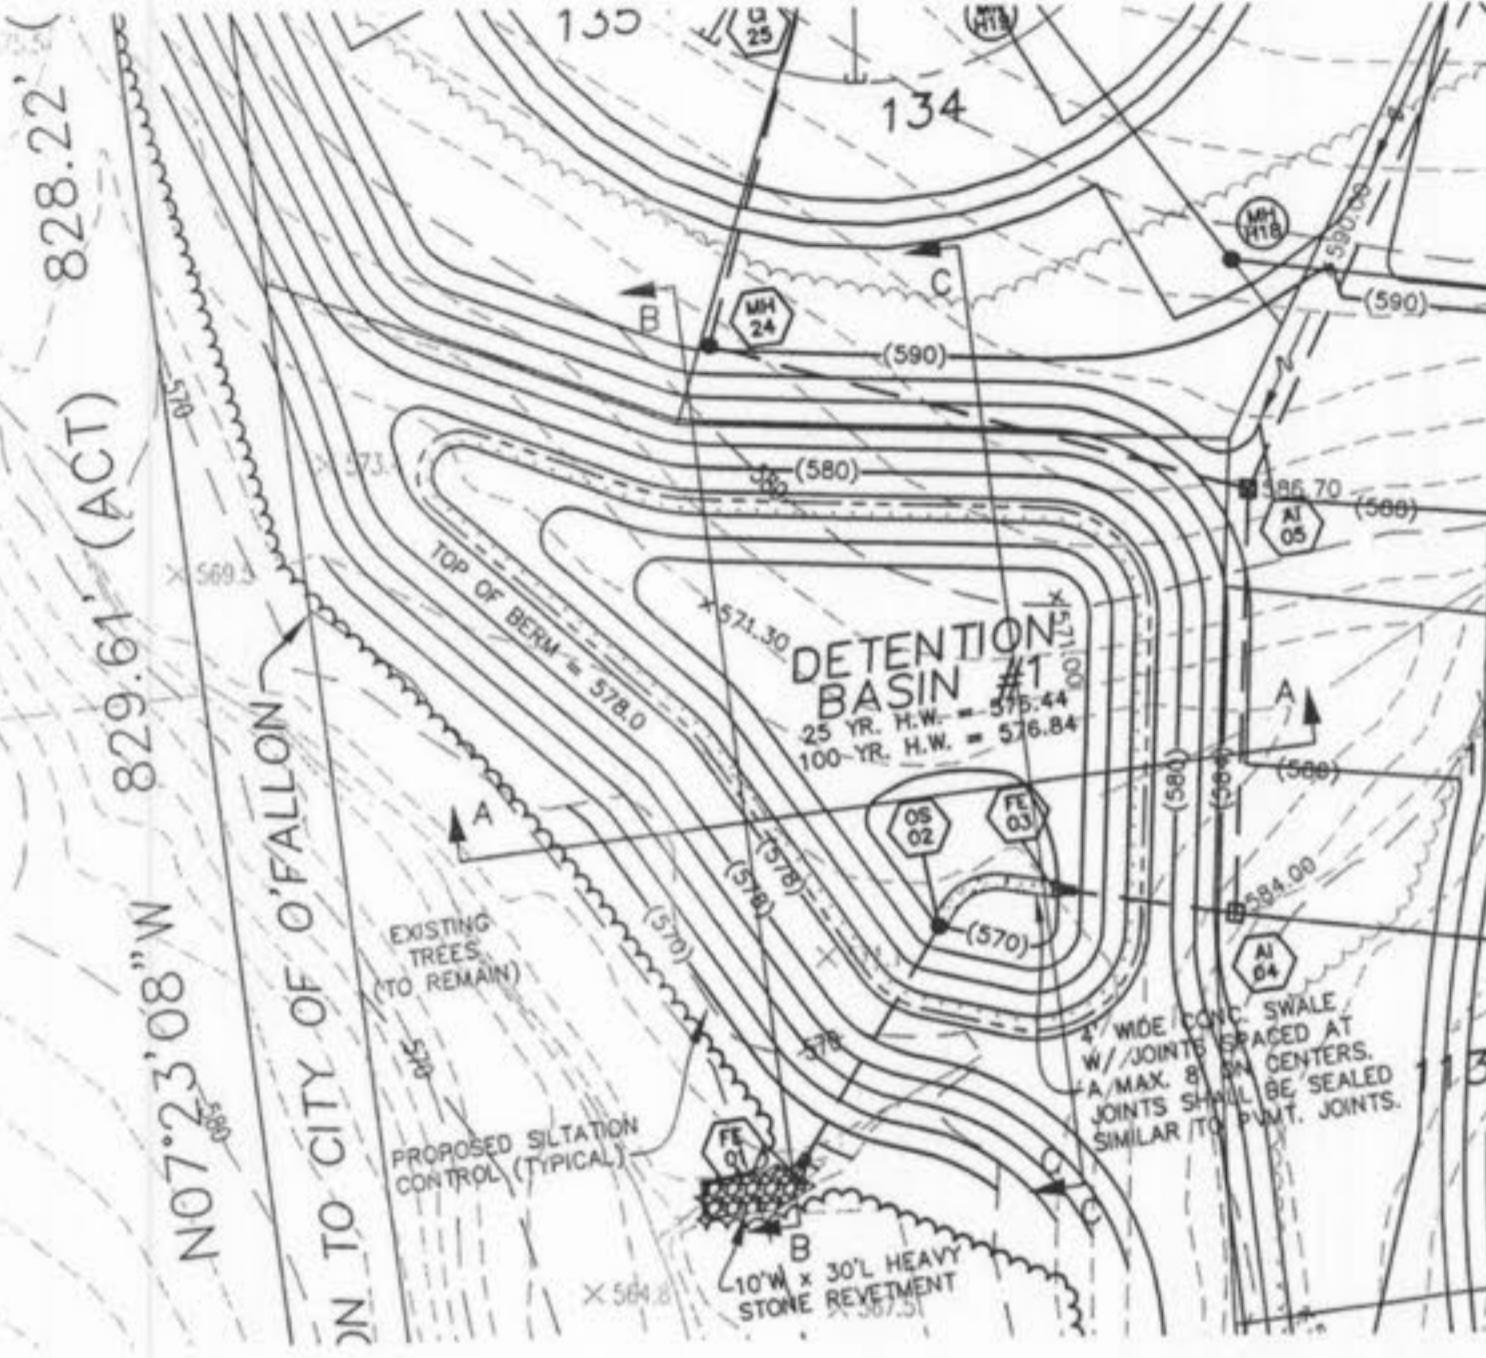



DETENTION BASIN #1

SCALE:
1" = 50' HOR.
1" = 10' VER.

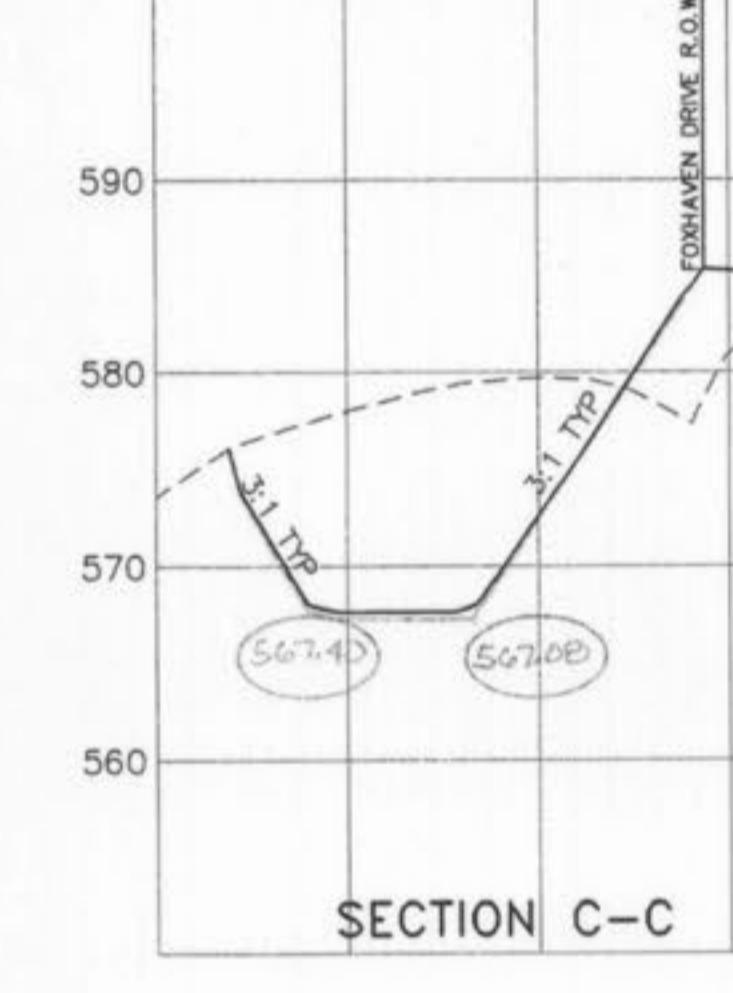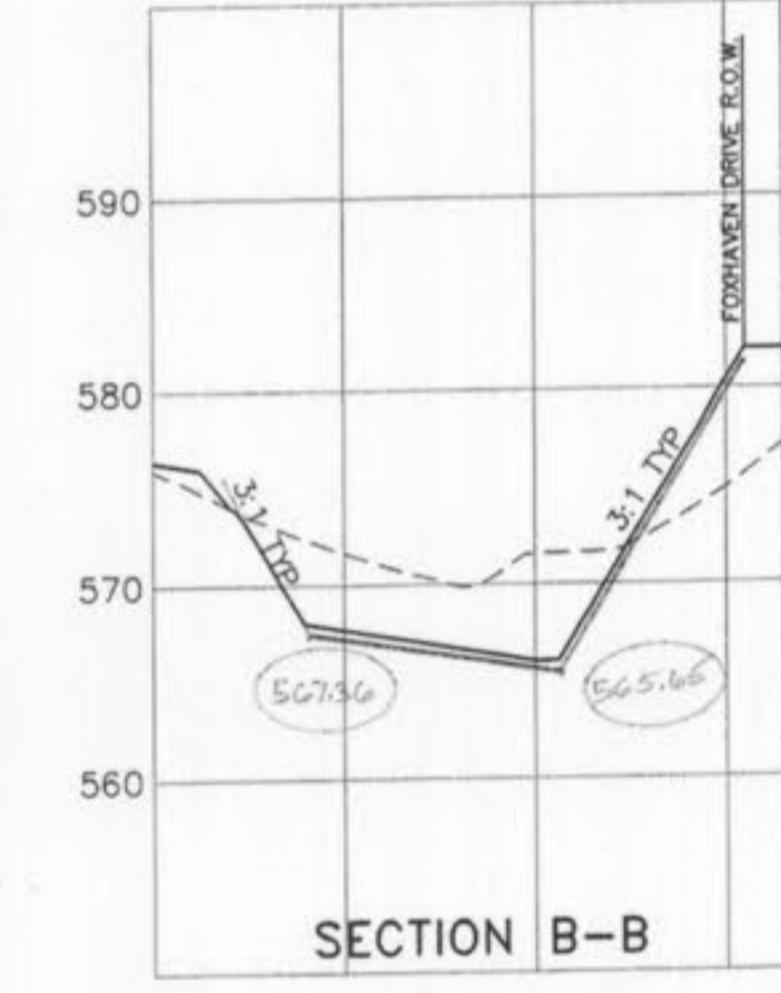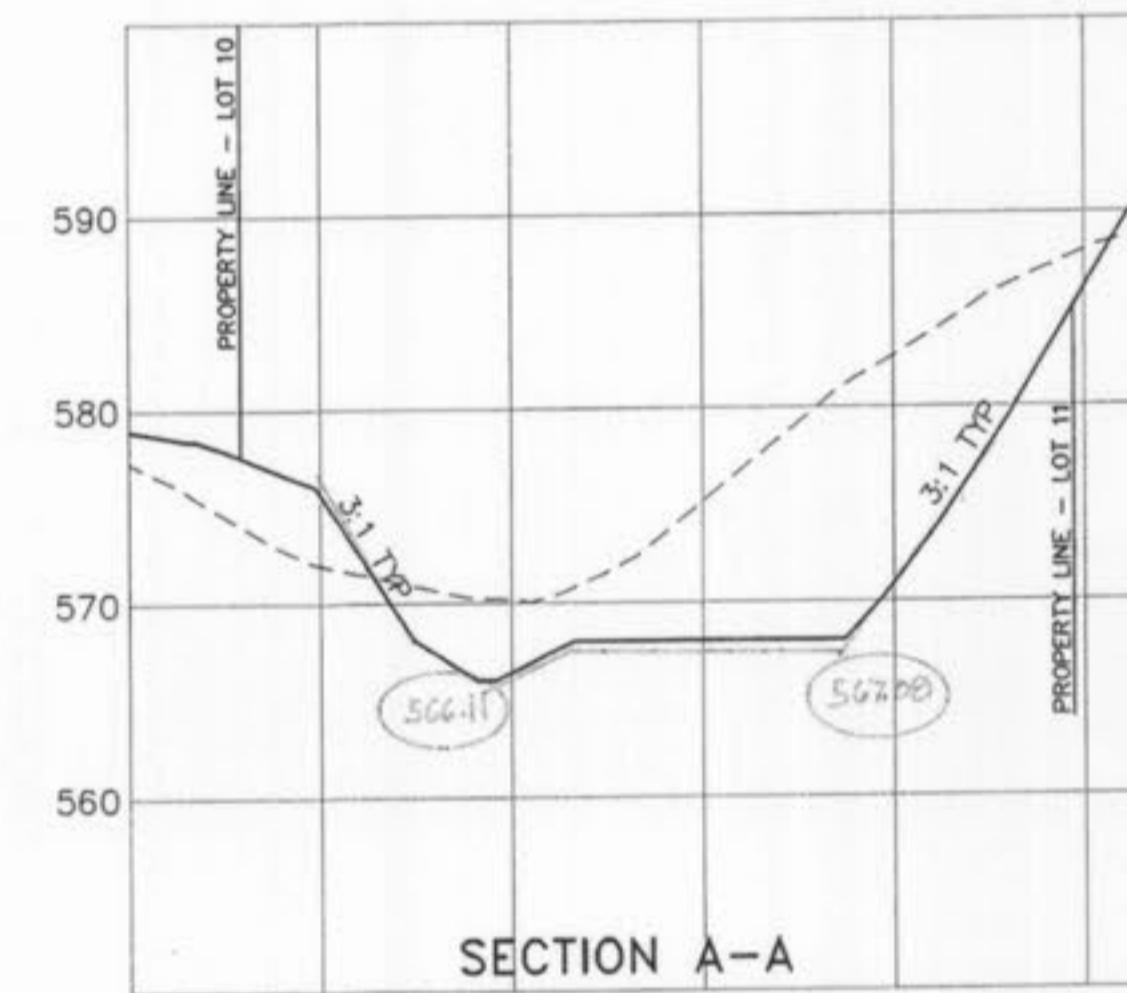

DETENTION BASIN #2

SCALE:
1" = 50' HOR.
1" = 10' VER.

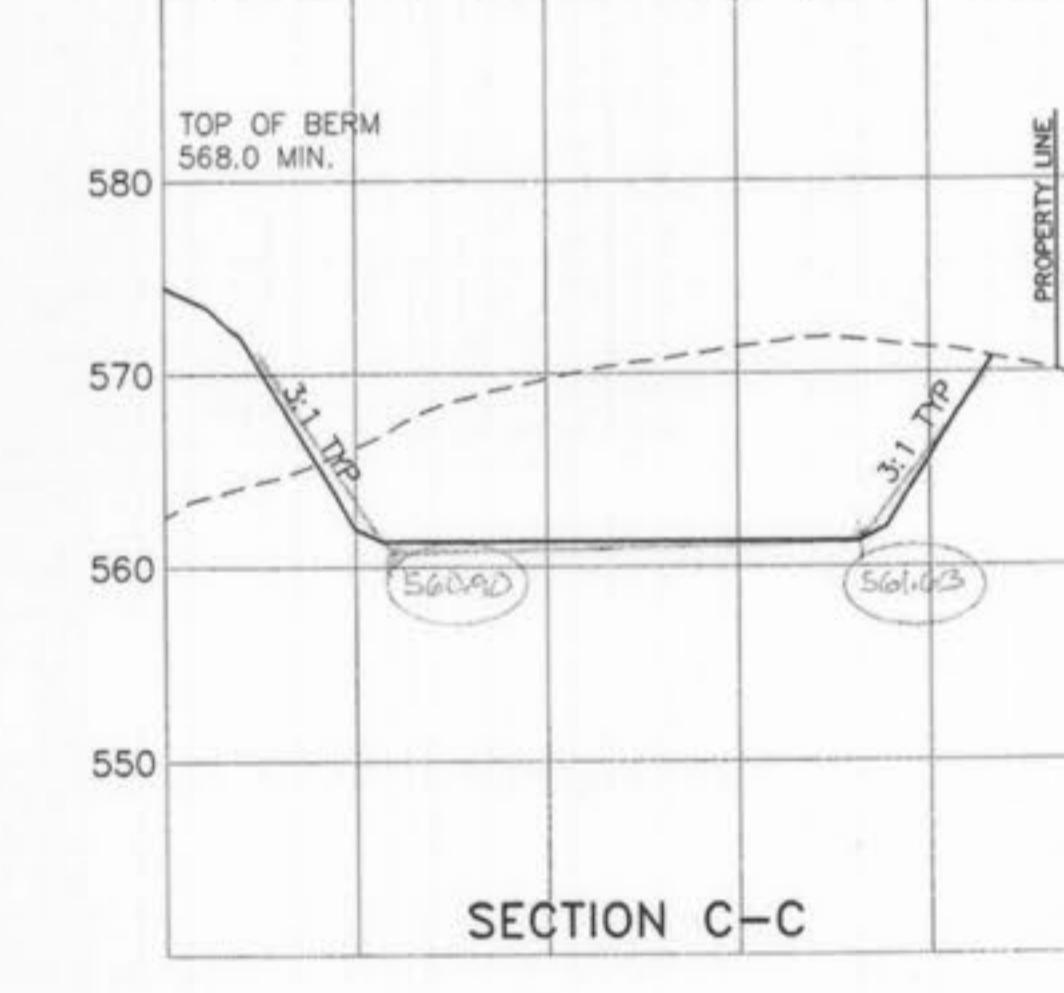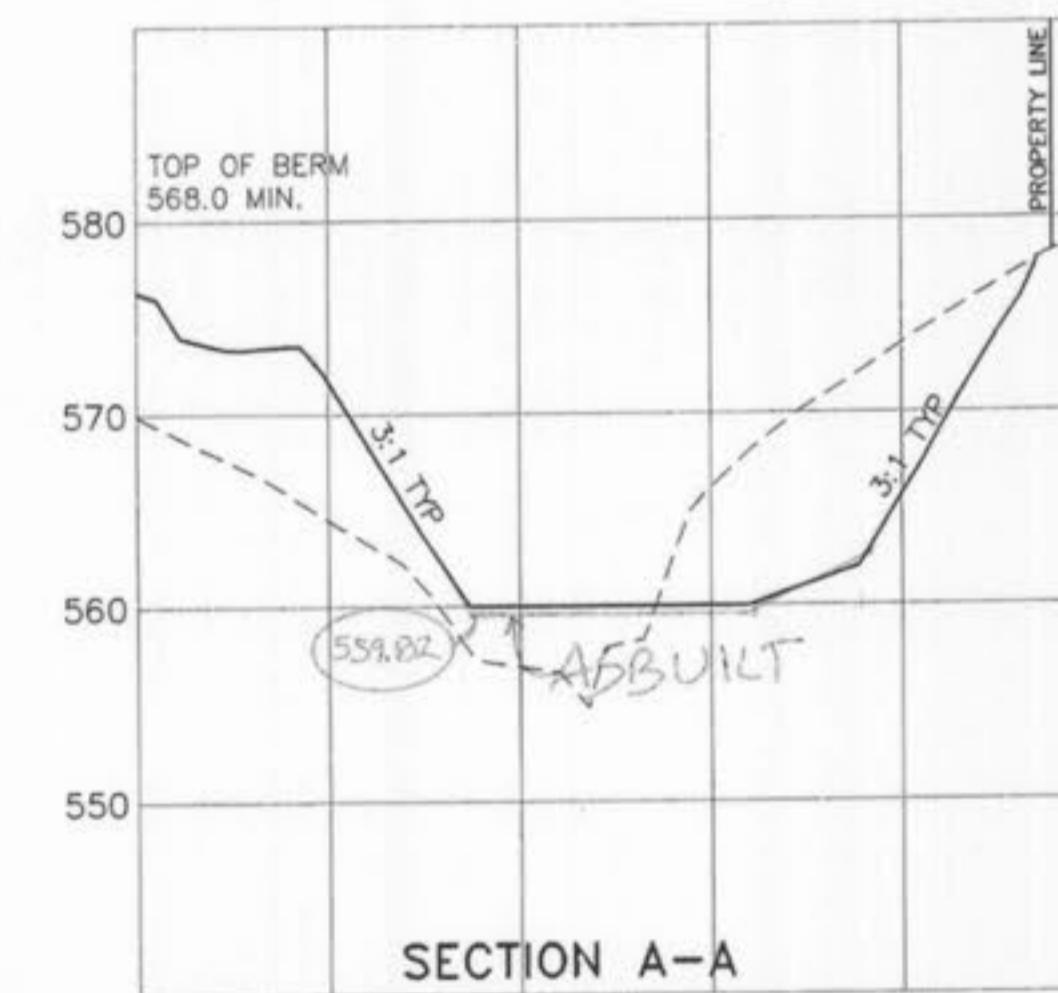

DETENTION BASIN #3

SCALE:
1" = 50' HOR.
1" = 10' VER.

ISSUE DATE	REMARKS/COMMENTS
1 03-01-04	FIRST SUBMITTAL
2 06-04-04	REVISED PER CITY & DOCS COMMENTS
3 07-20-04	REVISED PER CITY COMMENTS
4 08-04-04	REVISED PER CITY COMMENTS
5 08-12-04	REVISED PER PWSDP2 COMMENTS
6 10-18-04	REVISED PER DEVELOPER COMMENTS
7 04-21-05	REVISED OUTFALL STRUCTURE 02
8 06-14-05	GRADING COMMENTS PER DEVELOPER

McBride & Son Homes Land Development, Inc.
#1 McBride & Son Center Drive
Chesterfield, Missouri 63005
(636) 537-2000



THE STERLING CO.
ENGINEERS & SURVEYORS
5035 NEW BAUM ROAD
ST. LOUIS, MISSOURI 63129
(314) 487-0440 FAX 487-6944
E-Mail: Sterling@sterling-eng-sur.com



AS-BUILT
SANITARY AND STORM SEWER
FINAL MEASUREMENT PLAT

As of _____, I certify that the actual sewer lengths, sizes, flowlines, depths of structures and locations with respect to existing or proposed easements have been measured. The results of those measurements are shown on this set of Final Measurement Plans. Since the wye locations have been plotted from information provided by the sewer contractor or other sources, I disclaim any responsibility for that specific information.


All public sewers are located within the designated existing or proposed alignments except as follows:

DRAWN:	GEORGE GOWER - Vice President
DESIGNED:	GEORGE GOWER - Vice President
CHECKED:	Reg. GOWER '96
PROJECT:	FOX HAVEN
SHEET TITLE:	DETENTION BASIN SECTIONS

NO. 03 06 147
M.S.D. 28
P# 48
DIGITAL FILE LOCATION:
STERLING-2
GOWER-147
MAP.dwg

BASE MAP

Foxhaven As Built 16/22

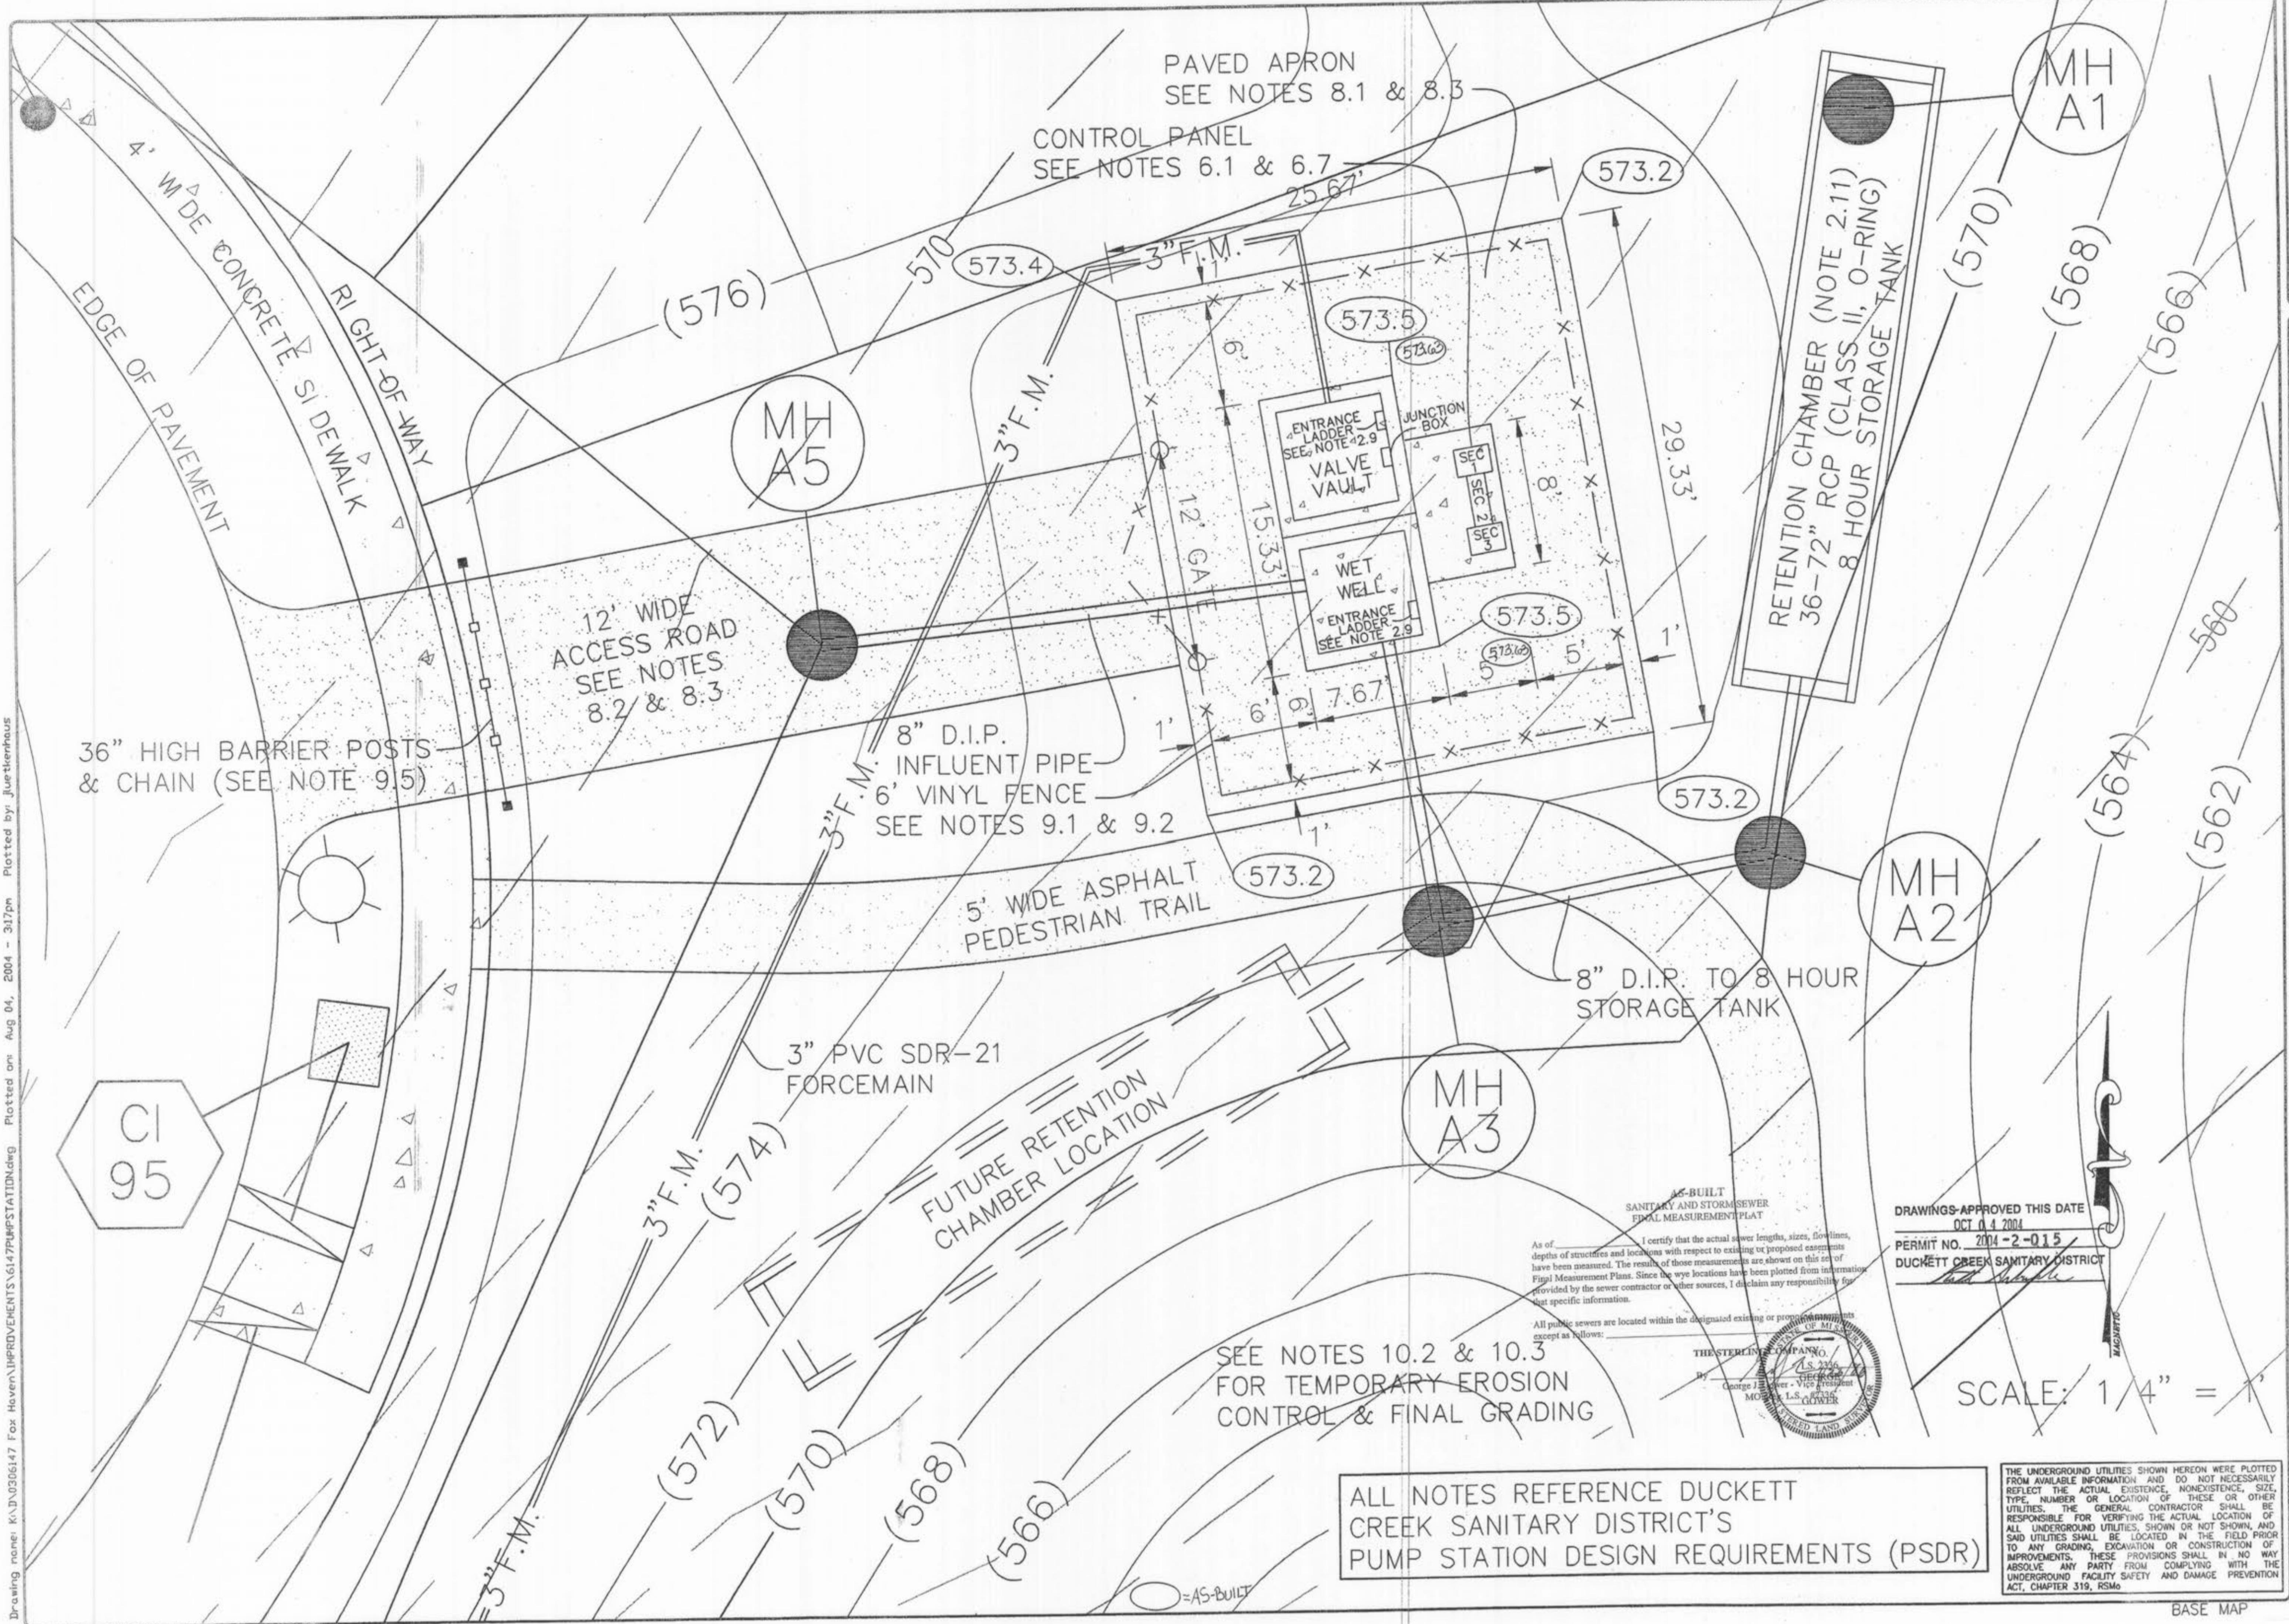

THE UNDERGROUND UTILITIES SHOWN HEREON WERE PLOTTED FROM AVAILABLE INFORMATION AND DO NOT NECESSARILY REFLECT THE ACTUAL EXISTENCE, NONEXISTENCE, SIZE, TYPE, NUMBER OR LOCATION OF THESE OR OTHER UTILITIES. THE GENERAL CONTRACTOR SHALL BE RESPONSIBLE FOR VERIFYING THE ACTUAL LOCATION OF ALL UNDERGROUND UTILITIES SHOWN OR NOT SHOWN, AND SAID UTILITIES SHALL BE LOCATED IN THE FIELD PRIOR TO ANY GRADING, EXCAVATION OR CONSTRUCTION OF IMPROVEMENTS. THESE PROVISIONS SHALL IN NO WAY ABSOLVE ANY PERSON FROM COMPLYING WITH THE UNDERGROUND FACILITY SAFETY AND DAMAGE PREVENTION ACT, CHAPTER 319, RSMo

PROJECT: FOX HAVEN
SHEET TITLE: PUMP STATION #1 PLAN

NO. 03 06 147
M.S.D.
P#
DIGITAL FILE LOCATION
E:\McBride-Sterling-2
SHP\PUMPSTATION.dwg
SHEET
35
48


PREPARED BY: THE STERLING CO.
ENGINEERS & SURVEYORS
5005 NEW BAUMGARTNER ROAD
ST. LOUIS, MISSOURI 63129
(314) 487-7440 FAX 487-8944
E-Mail: Sterling@sterling-eng-sur.com

ISSUE/REMARKS/DATE
1 03-01-04 FIRST SUBMITTAL
2 06-15-04 REVISED PER CITY & DCSD COMMENTS
3 07-20-04 REVISED PER CITY COMMENTS
4 08-04-04 REVISED PER DCSD COMMENTS

McBride & Son Homes
Land Development, Inc.
#1 McBride & Son Center Drive
Chesterfield, Missouri 63005
(636) 537-2000

BASE MAP

Foxhaven As Built 17/22

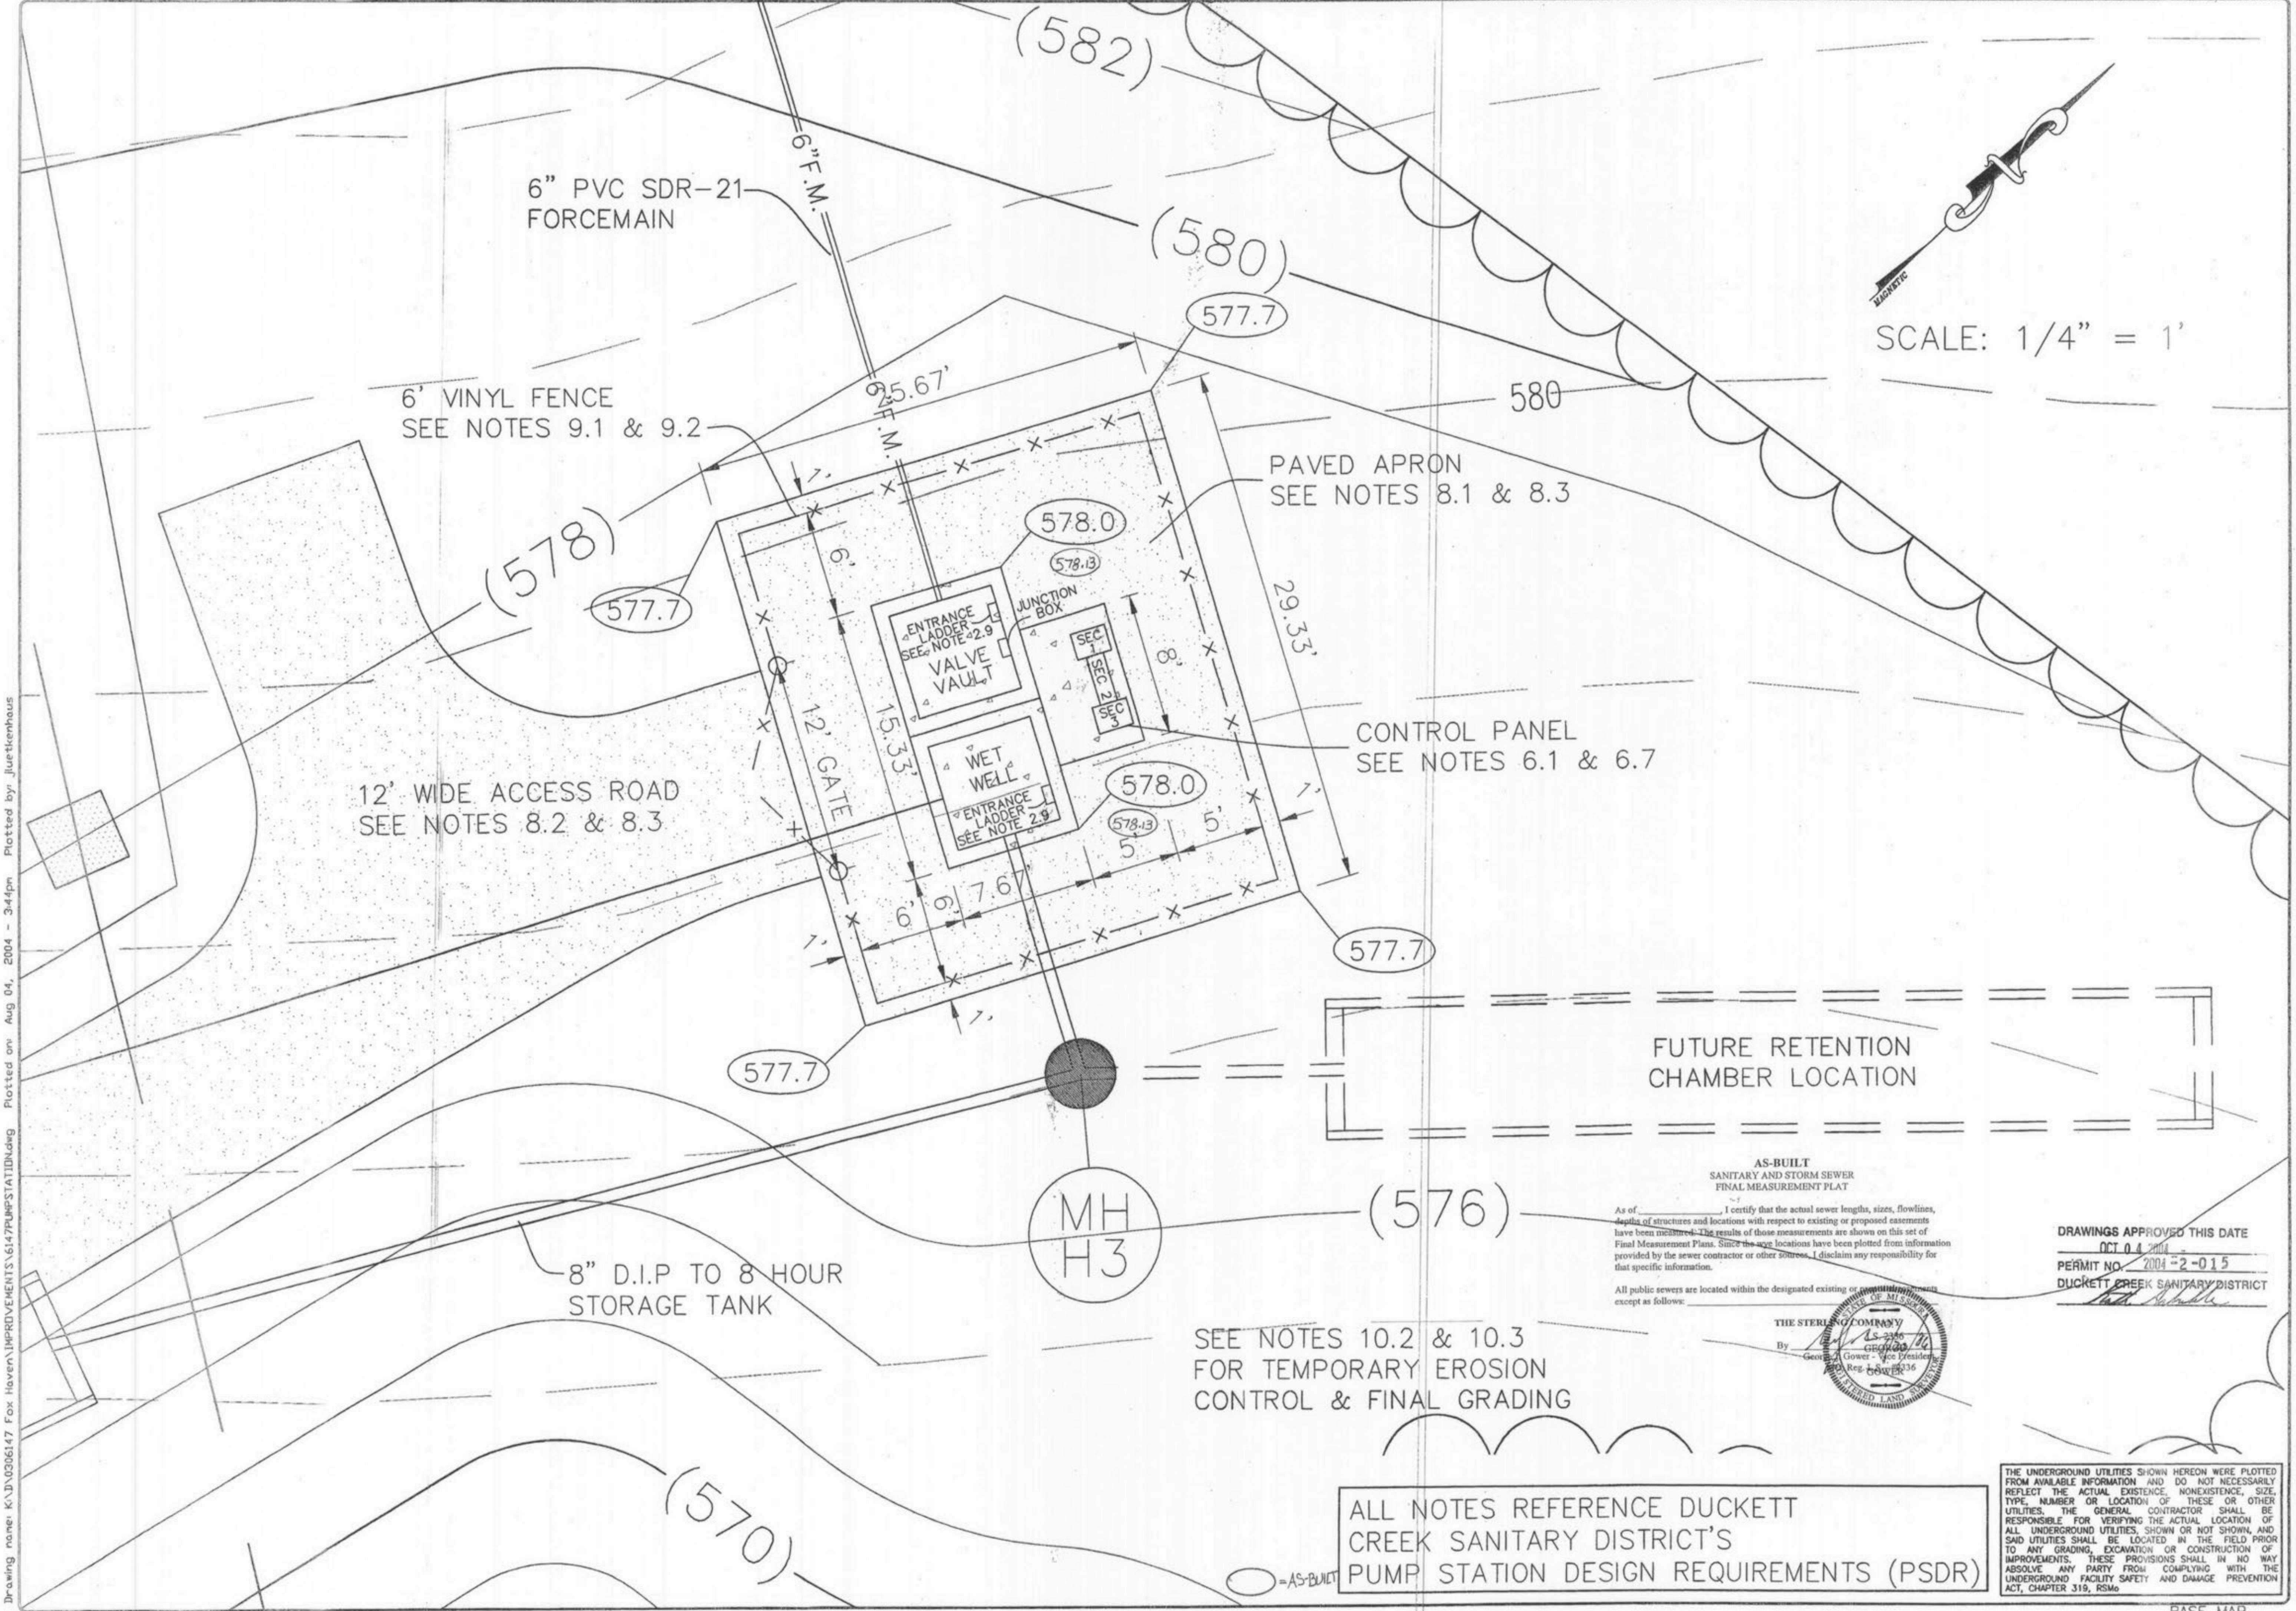

ISSUE	REMARKS/DATE
1	03-01-04 FIRST SUBMITIAL
2	08-15-04 REVISED PER CITY & DCSD COMMENTS
3	07-20-04 REVISED PER CITY COMMENTS
4	08-04-04 REVISED PER DCSD COMMENTS

McBride & Son Homes
Land Development, Inc.
#1 McBride & Son Center Drive
Chesterfield, Missouri 63005
(636) 537-2000




THE STERLING CO.
ENGINEERS & SURVEYORS
5055 NEW BALINGARTHER ROAD
ST. LOUIS, MISSOURI 63120
(314) 467-0440 FAX 467-8944
E-Mail: Sterling@sterling-eng.com

DRAWN:	
DESIGNED:	
CHECKED:	

FOX HAVEN
PUMP STATION #2 PLAN


NO.	03 06 147
M.S.D.	40
P#	48

BASE MAP
Foxhaven As Built 20/22

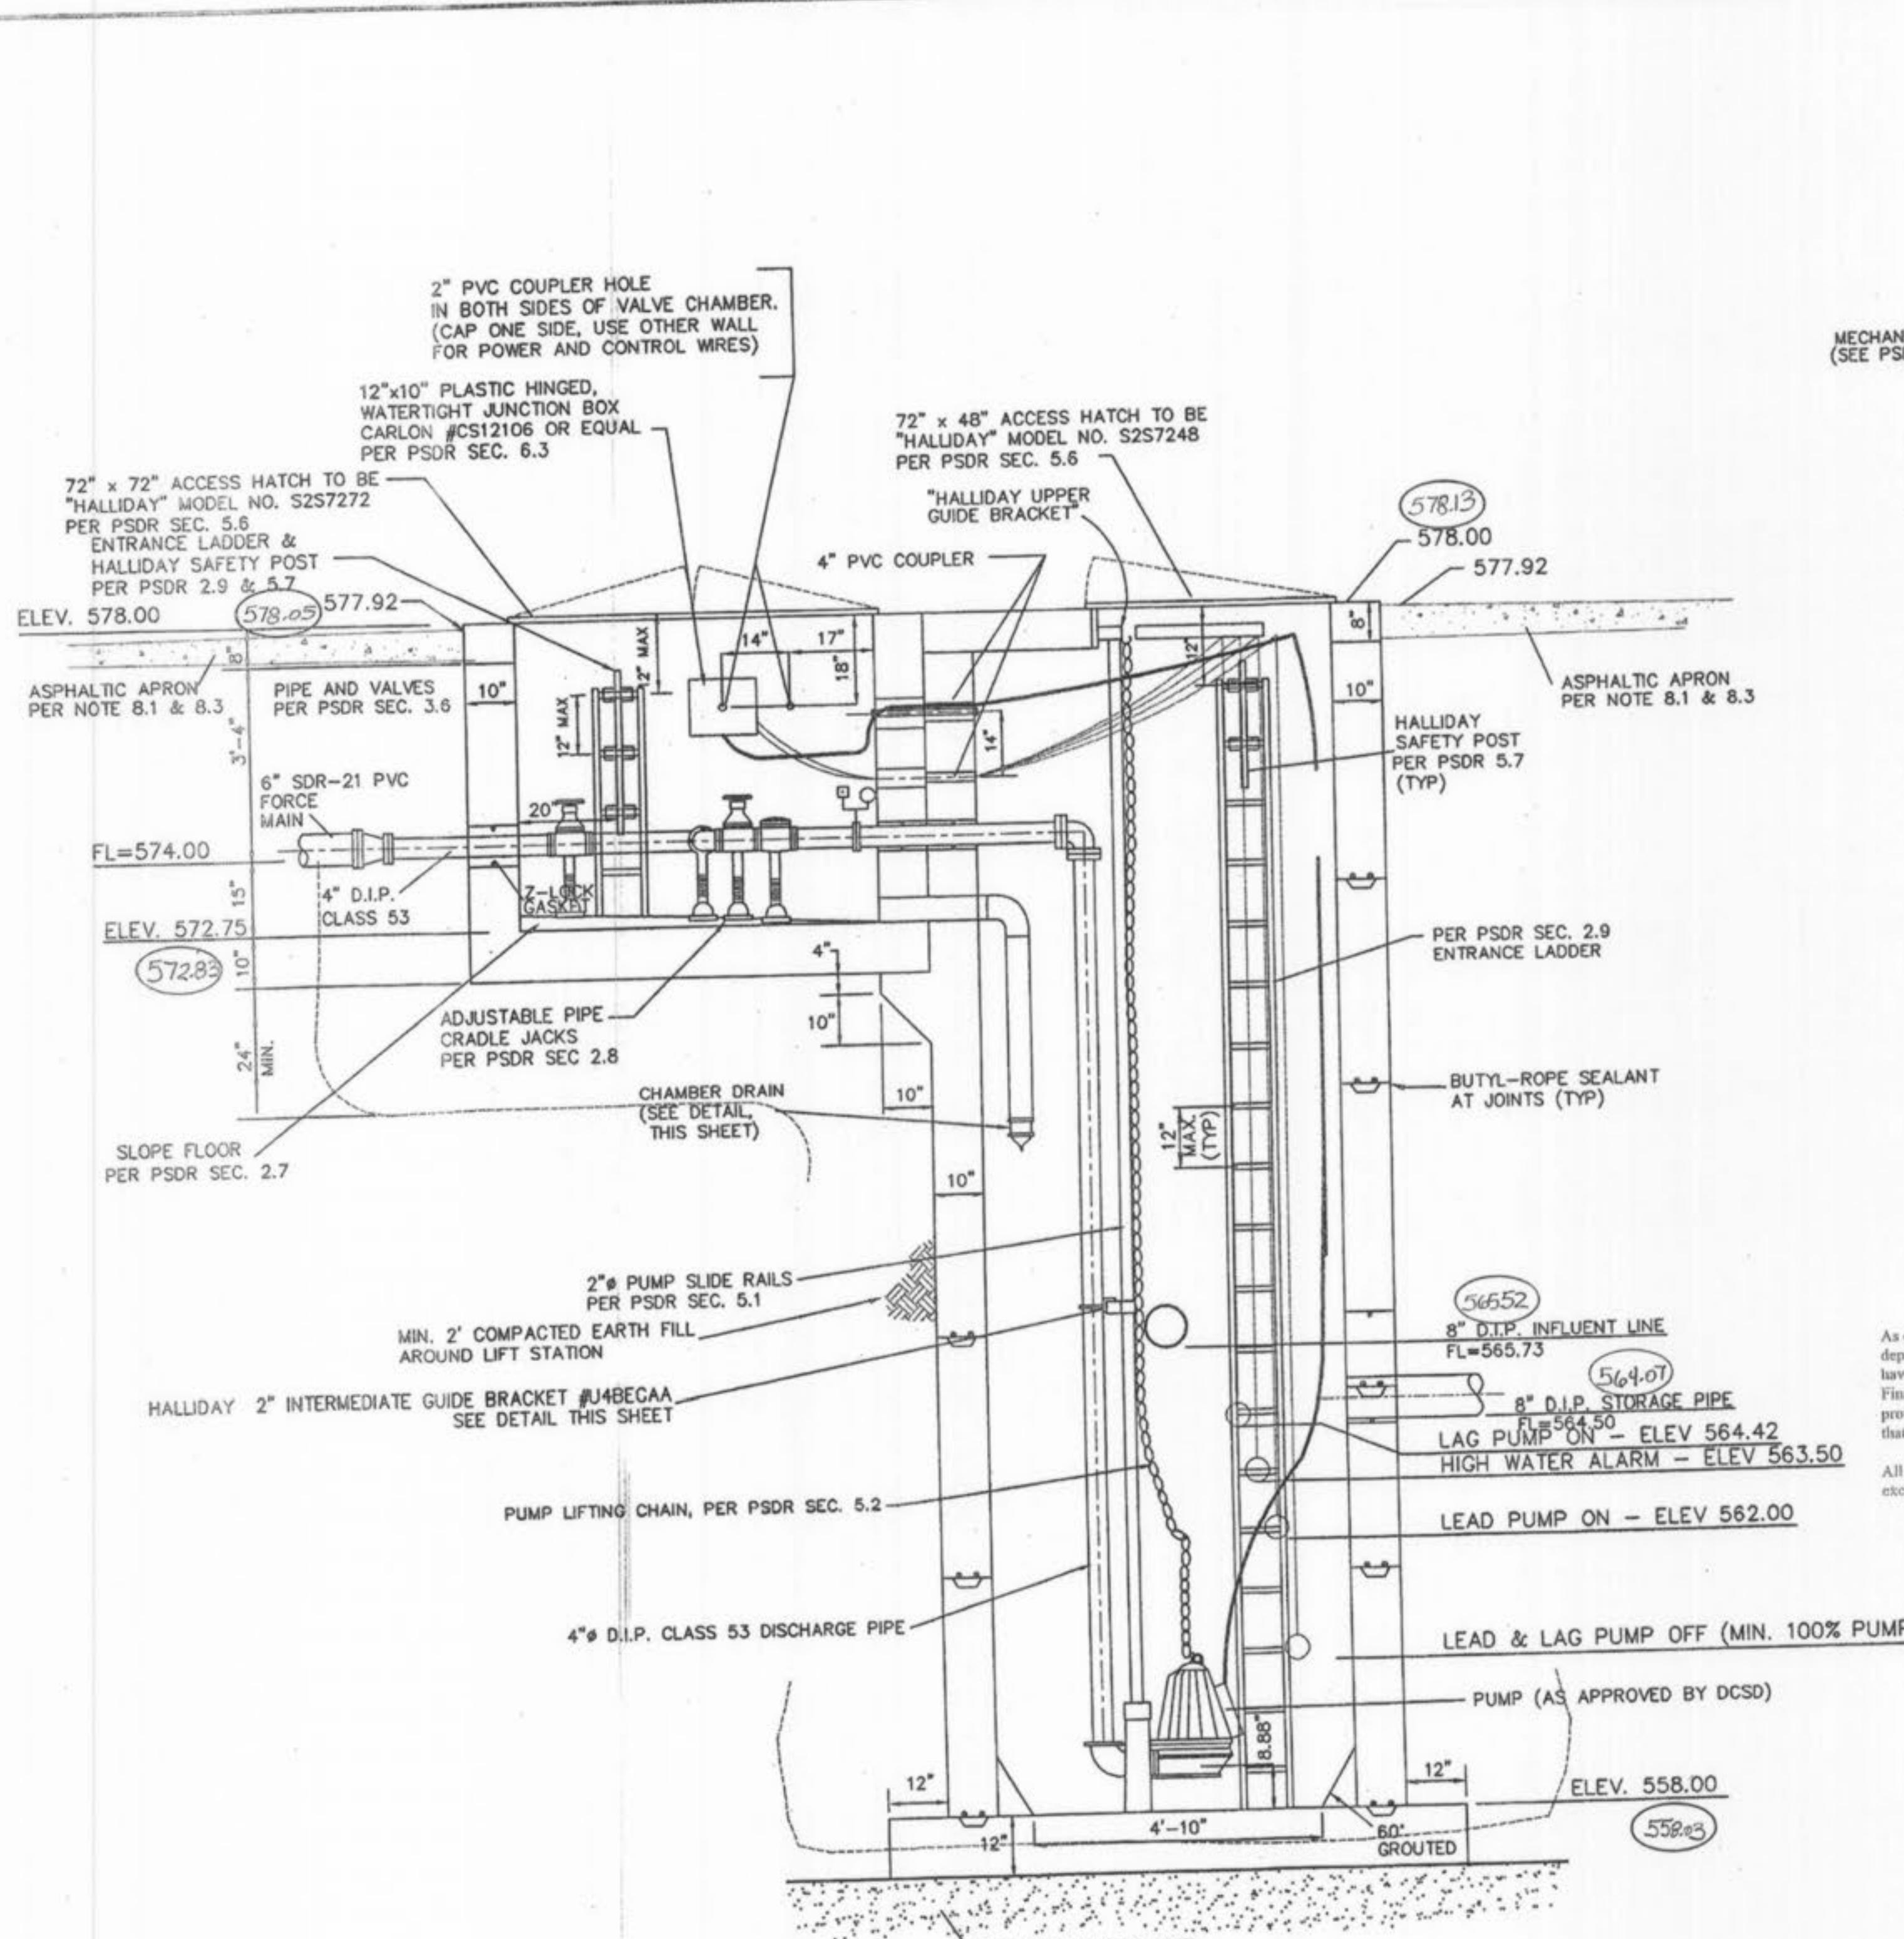


SECTION "A-A"
WET WELL AND VALVE CHAMBER

SCALE: 1/2" = 1'-0"

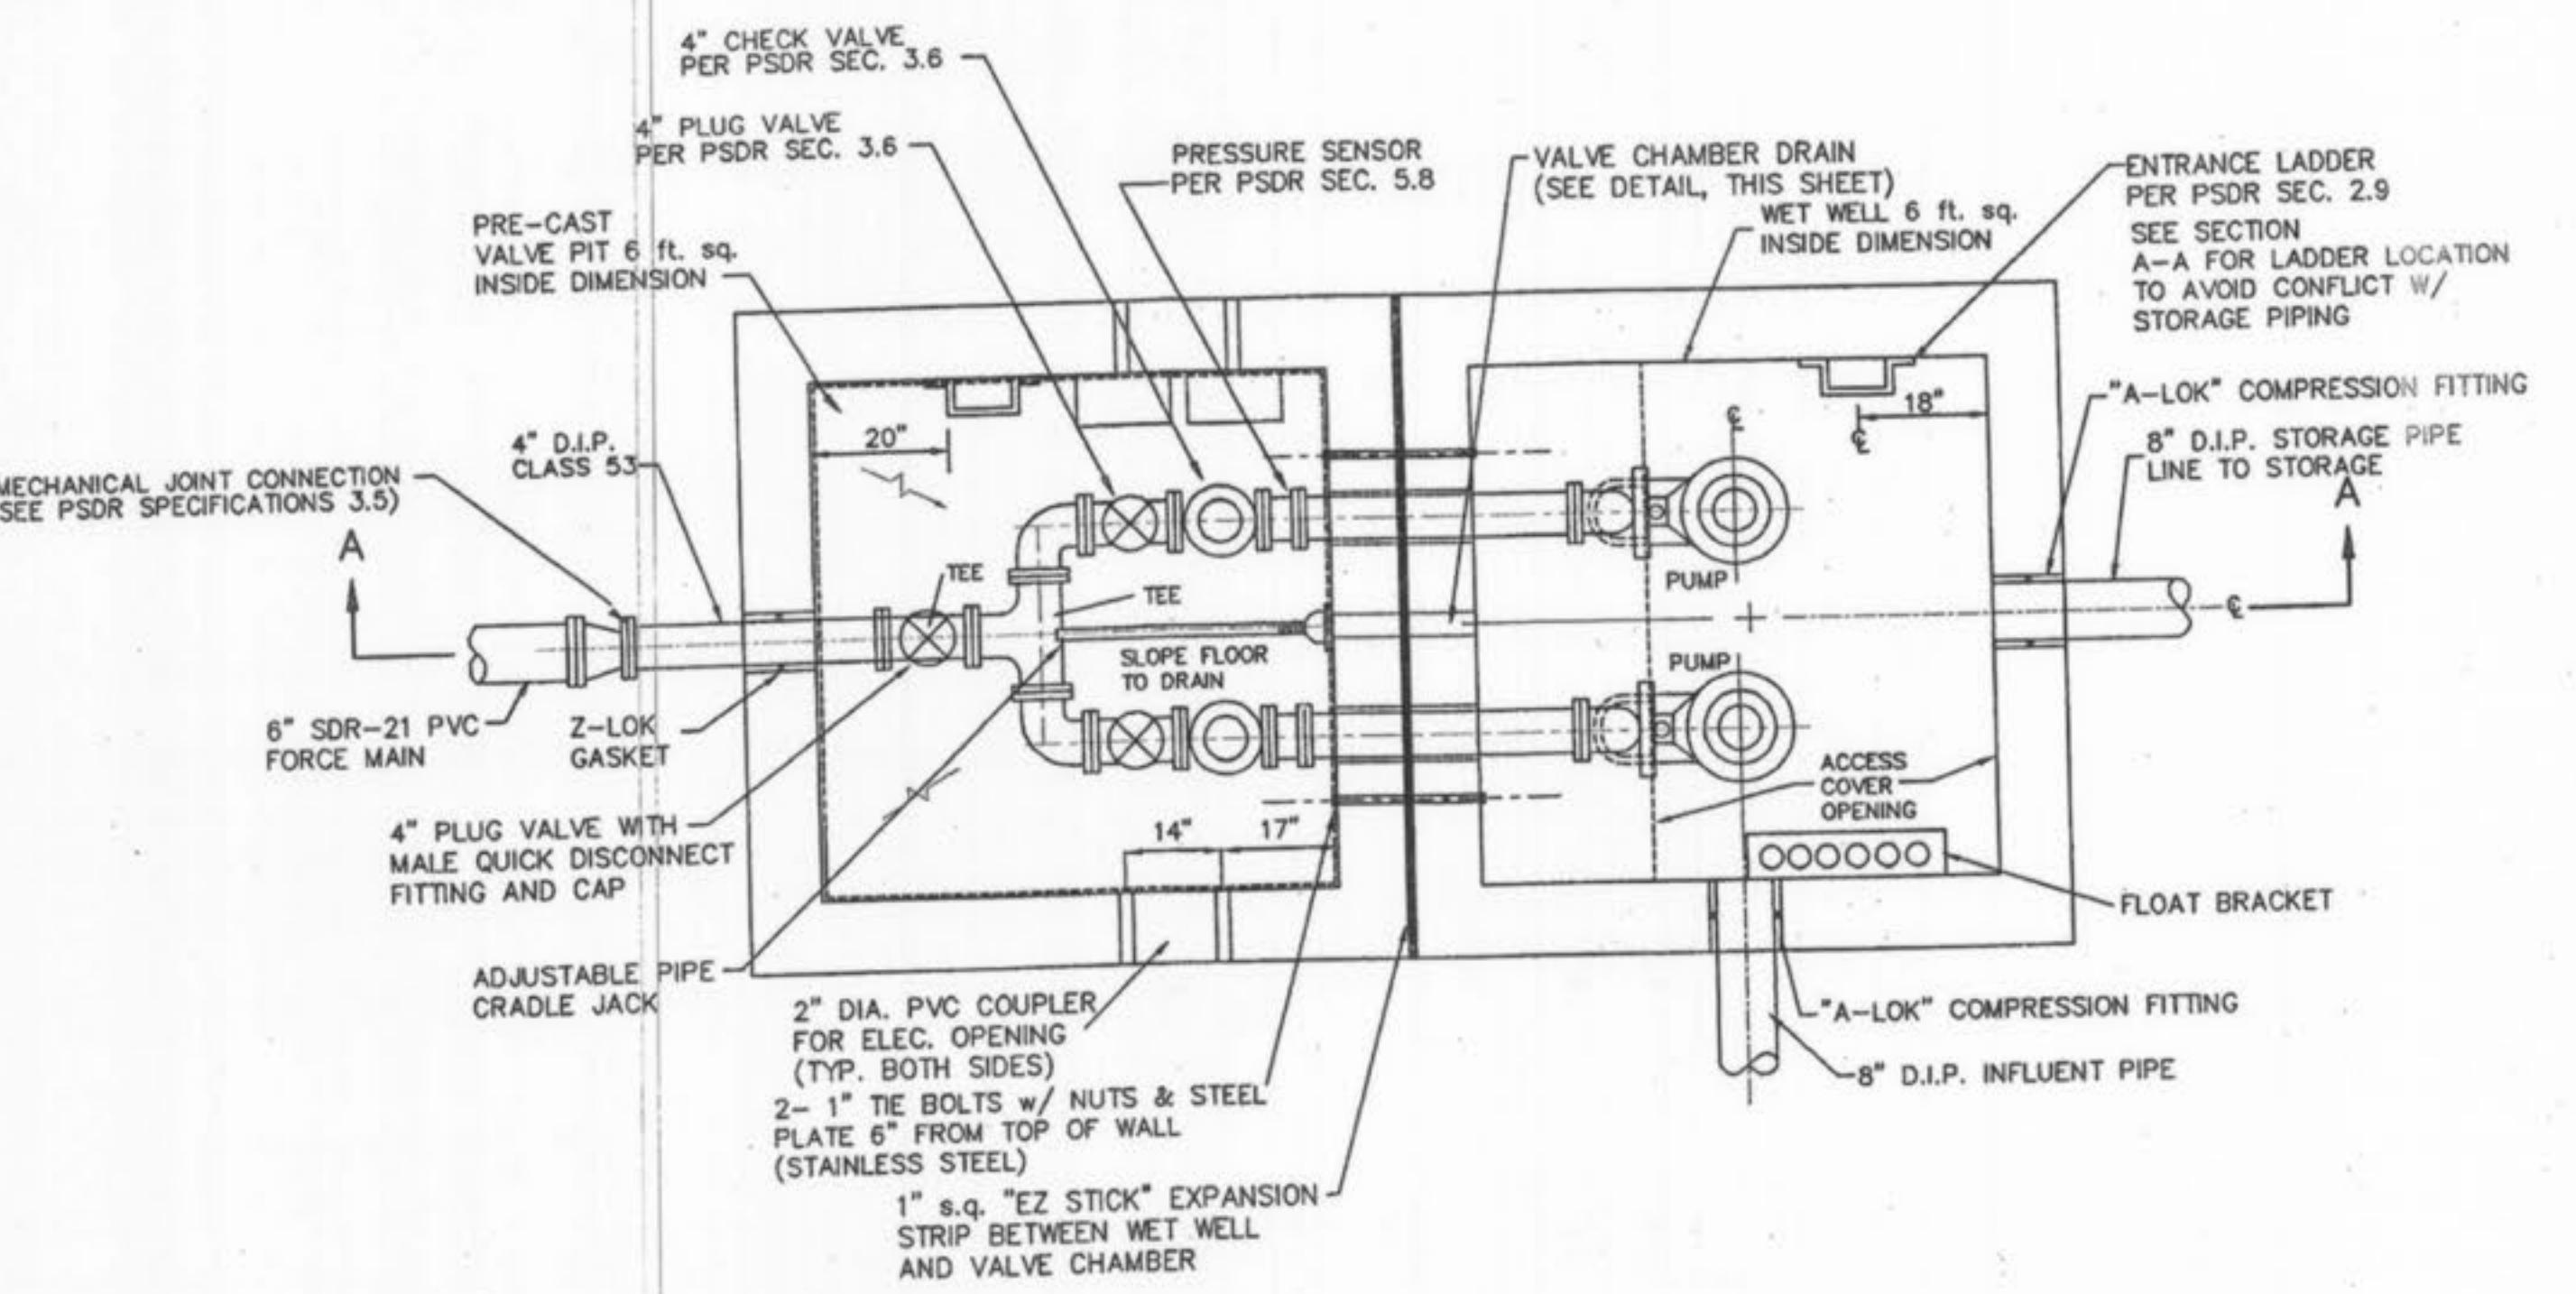


WET WELL AND VALVE CHAMBER

SCALE: 1/2" = 1'-0"

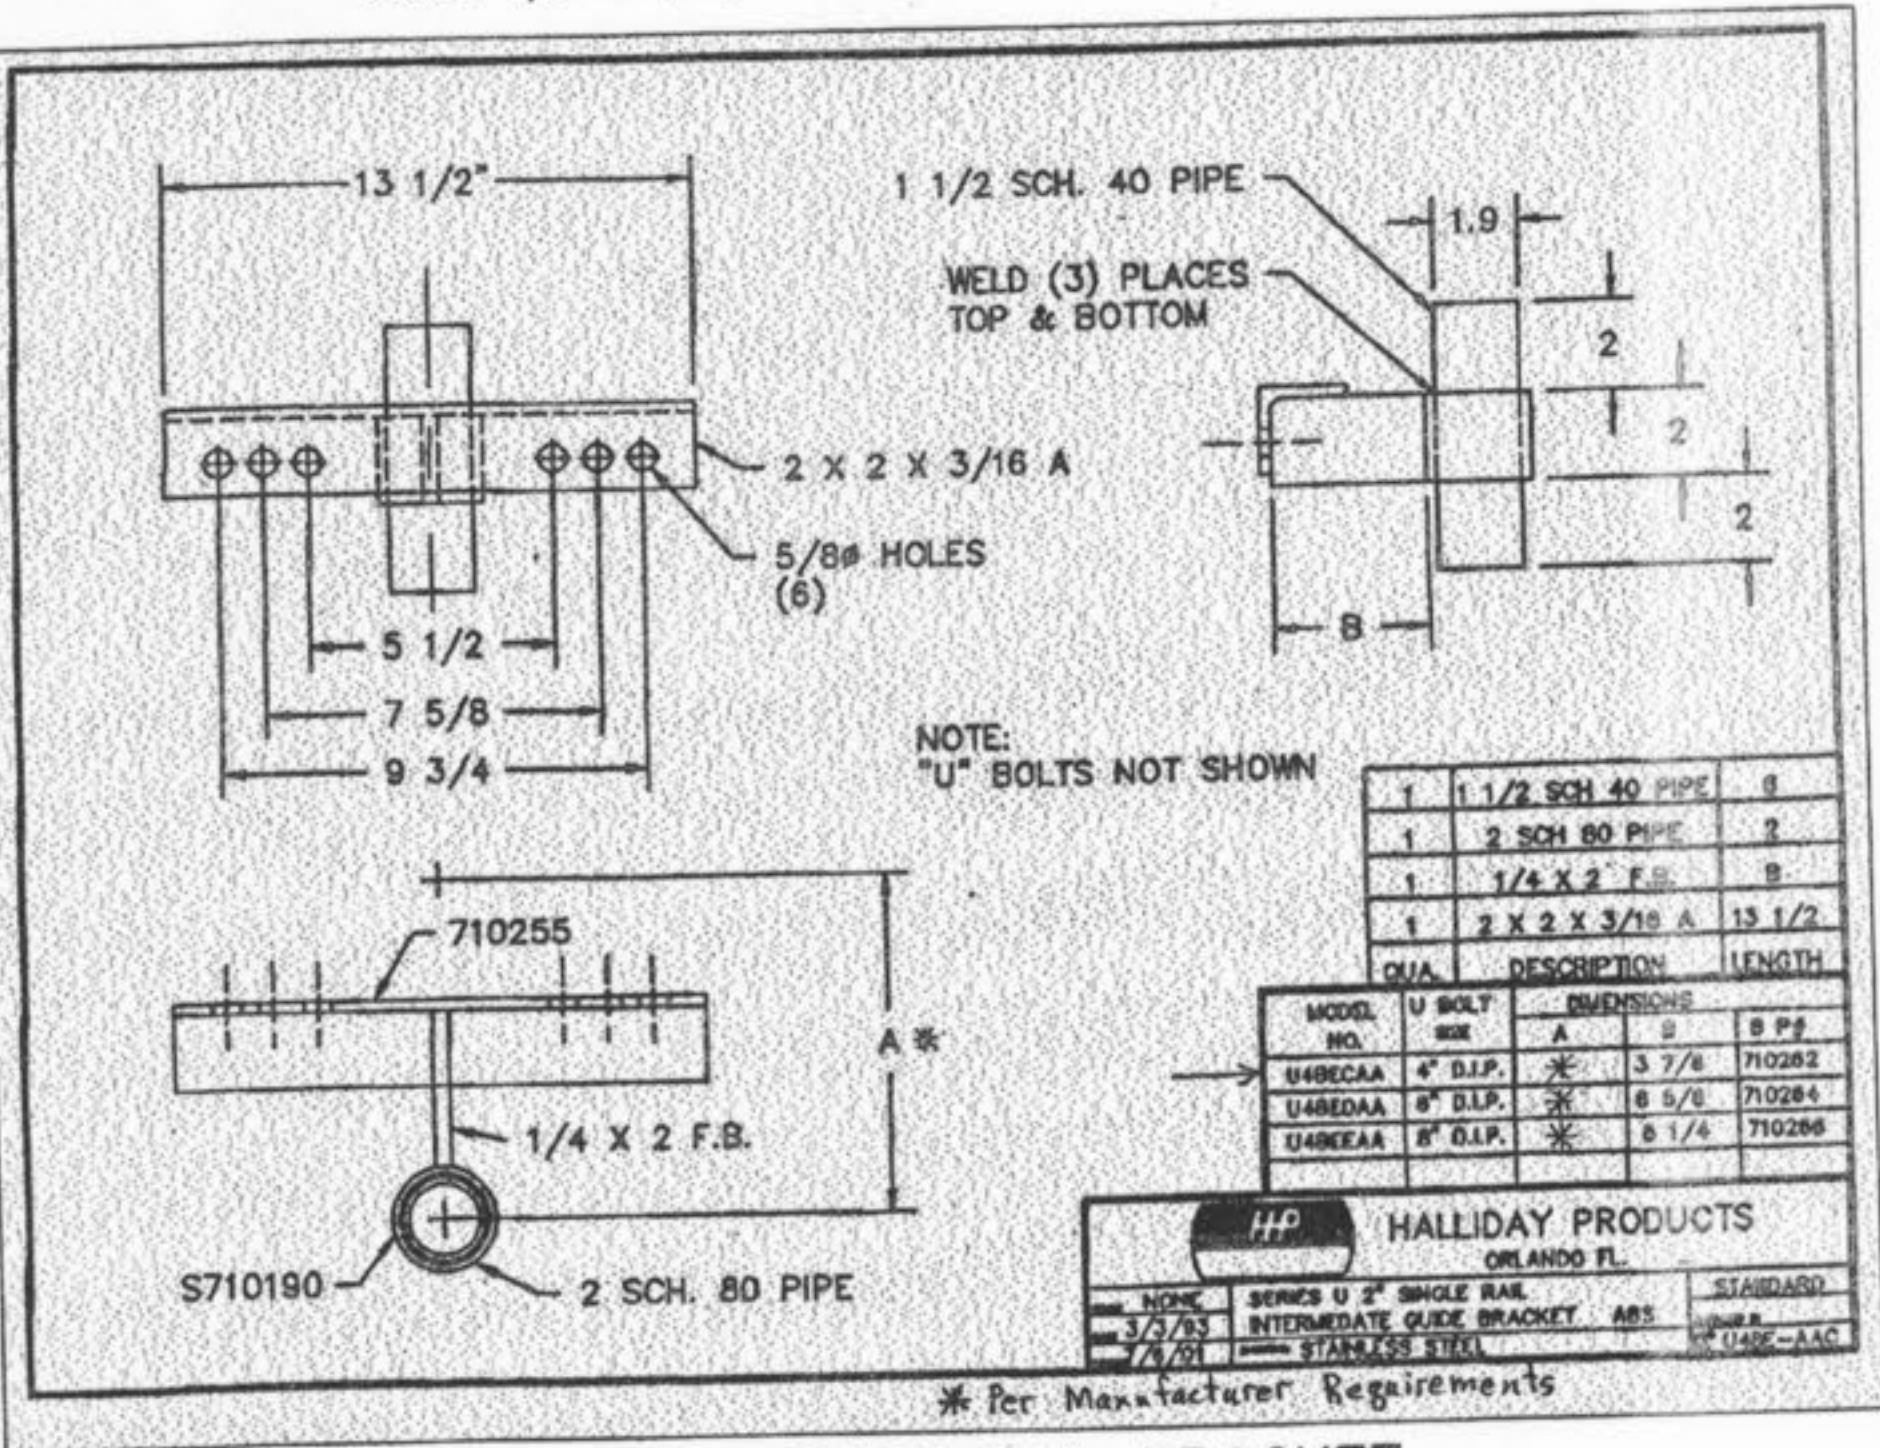

GUIDE RAIL BRACKET
N.T.S.

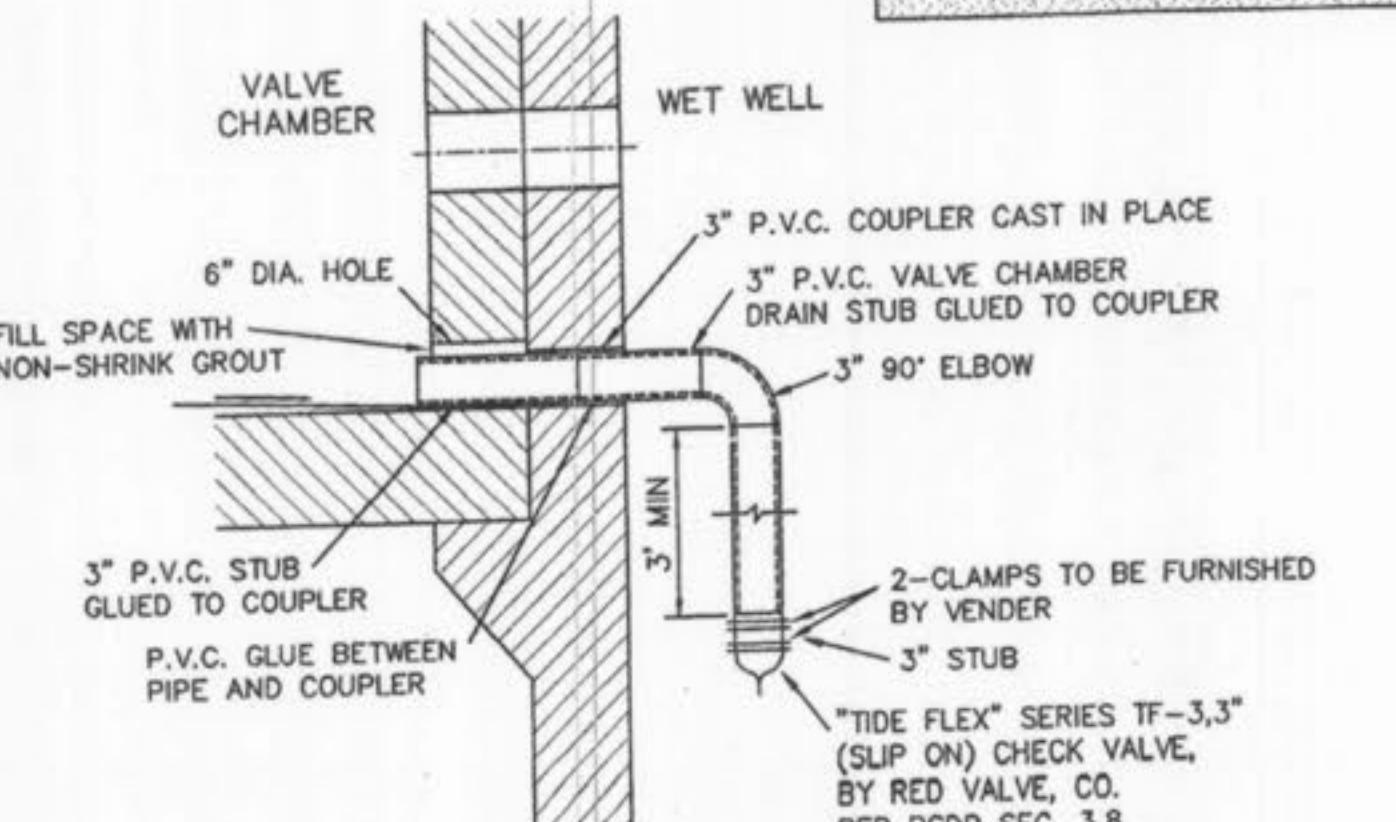

VALVE CHAMBER DRAIN DETAIL

N.T.S.

- NOTE:
- DEWATERING WILL BE REQUIRED FOR CONSTRUCTION OF THIS PUMP STATION & SEWERS
 - ALL PIPING INSIDE LIFT STATION WILL BE 4" D.I.P. CLASS 53
 - SEE NEXT SHEET FOR PUMP STATION STRUCTURAL DETAILS

DRAWINGS APPROVED THIS DATE
OCT 04 2004
PERMIT NO. 2004-2-015
DUCKETT CREEK SANITARY DISTRICT

FOX HAVEN
PROJECT: FOX HAVEN
DESIGNED: THE STERLING CO.
CHECKED: THE STERLING CO.

SHEET TITLE: PUMP STATION #2 DETAILS
SHEET NUMBER: 03 06 147

ISSUE/REMARKS/DATE	1 08-01-04 FIRST SUBMITTAL
2 08-15-04 REVISED PER CITY & DCSD COMMENTS	
3 08-20-04 REVISED PER CITY COMMENTS	
4 08-04-04 REVISED PER DCSD COMMENTS	

PREPARED FOR:
McBride & Son Homes Land Development, Inc.
#1 McBride & Son Center Drive
Chesterfield, Missouri 63005
(636) 537-2000




PREPARED BY:
THE STERLING CO.
ENGINEERS & SURVEYORS
5055 NEW BAUMGARTNER ROAD
ST. LOUIS, MISSOURI 63129
(314) 487-0440 FAX 487-8944
E-Mail: Sterling@sterling-eng-sur.com

DRAWN: DESIGNED: CHECKED:
BY: THE STERLING CO.

NO. 03 06 147
M.S.D. 46
P# 48
DIGITAL FILE LOCATION:
E:\DRAWINGS\STERLING-2
FILE NAME: 0306147.DWG


BASE MAP
Foxhaven Job
32133

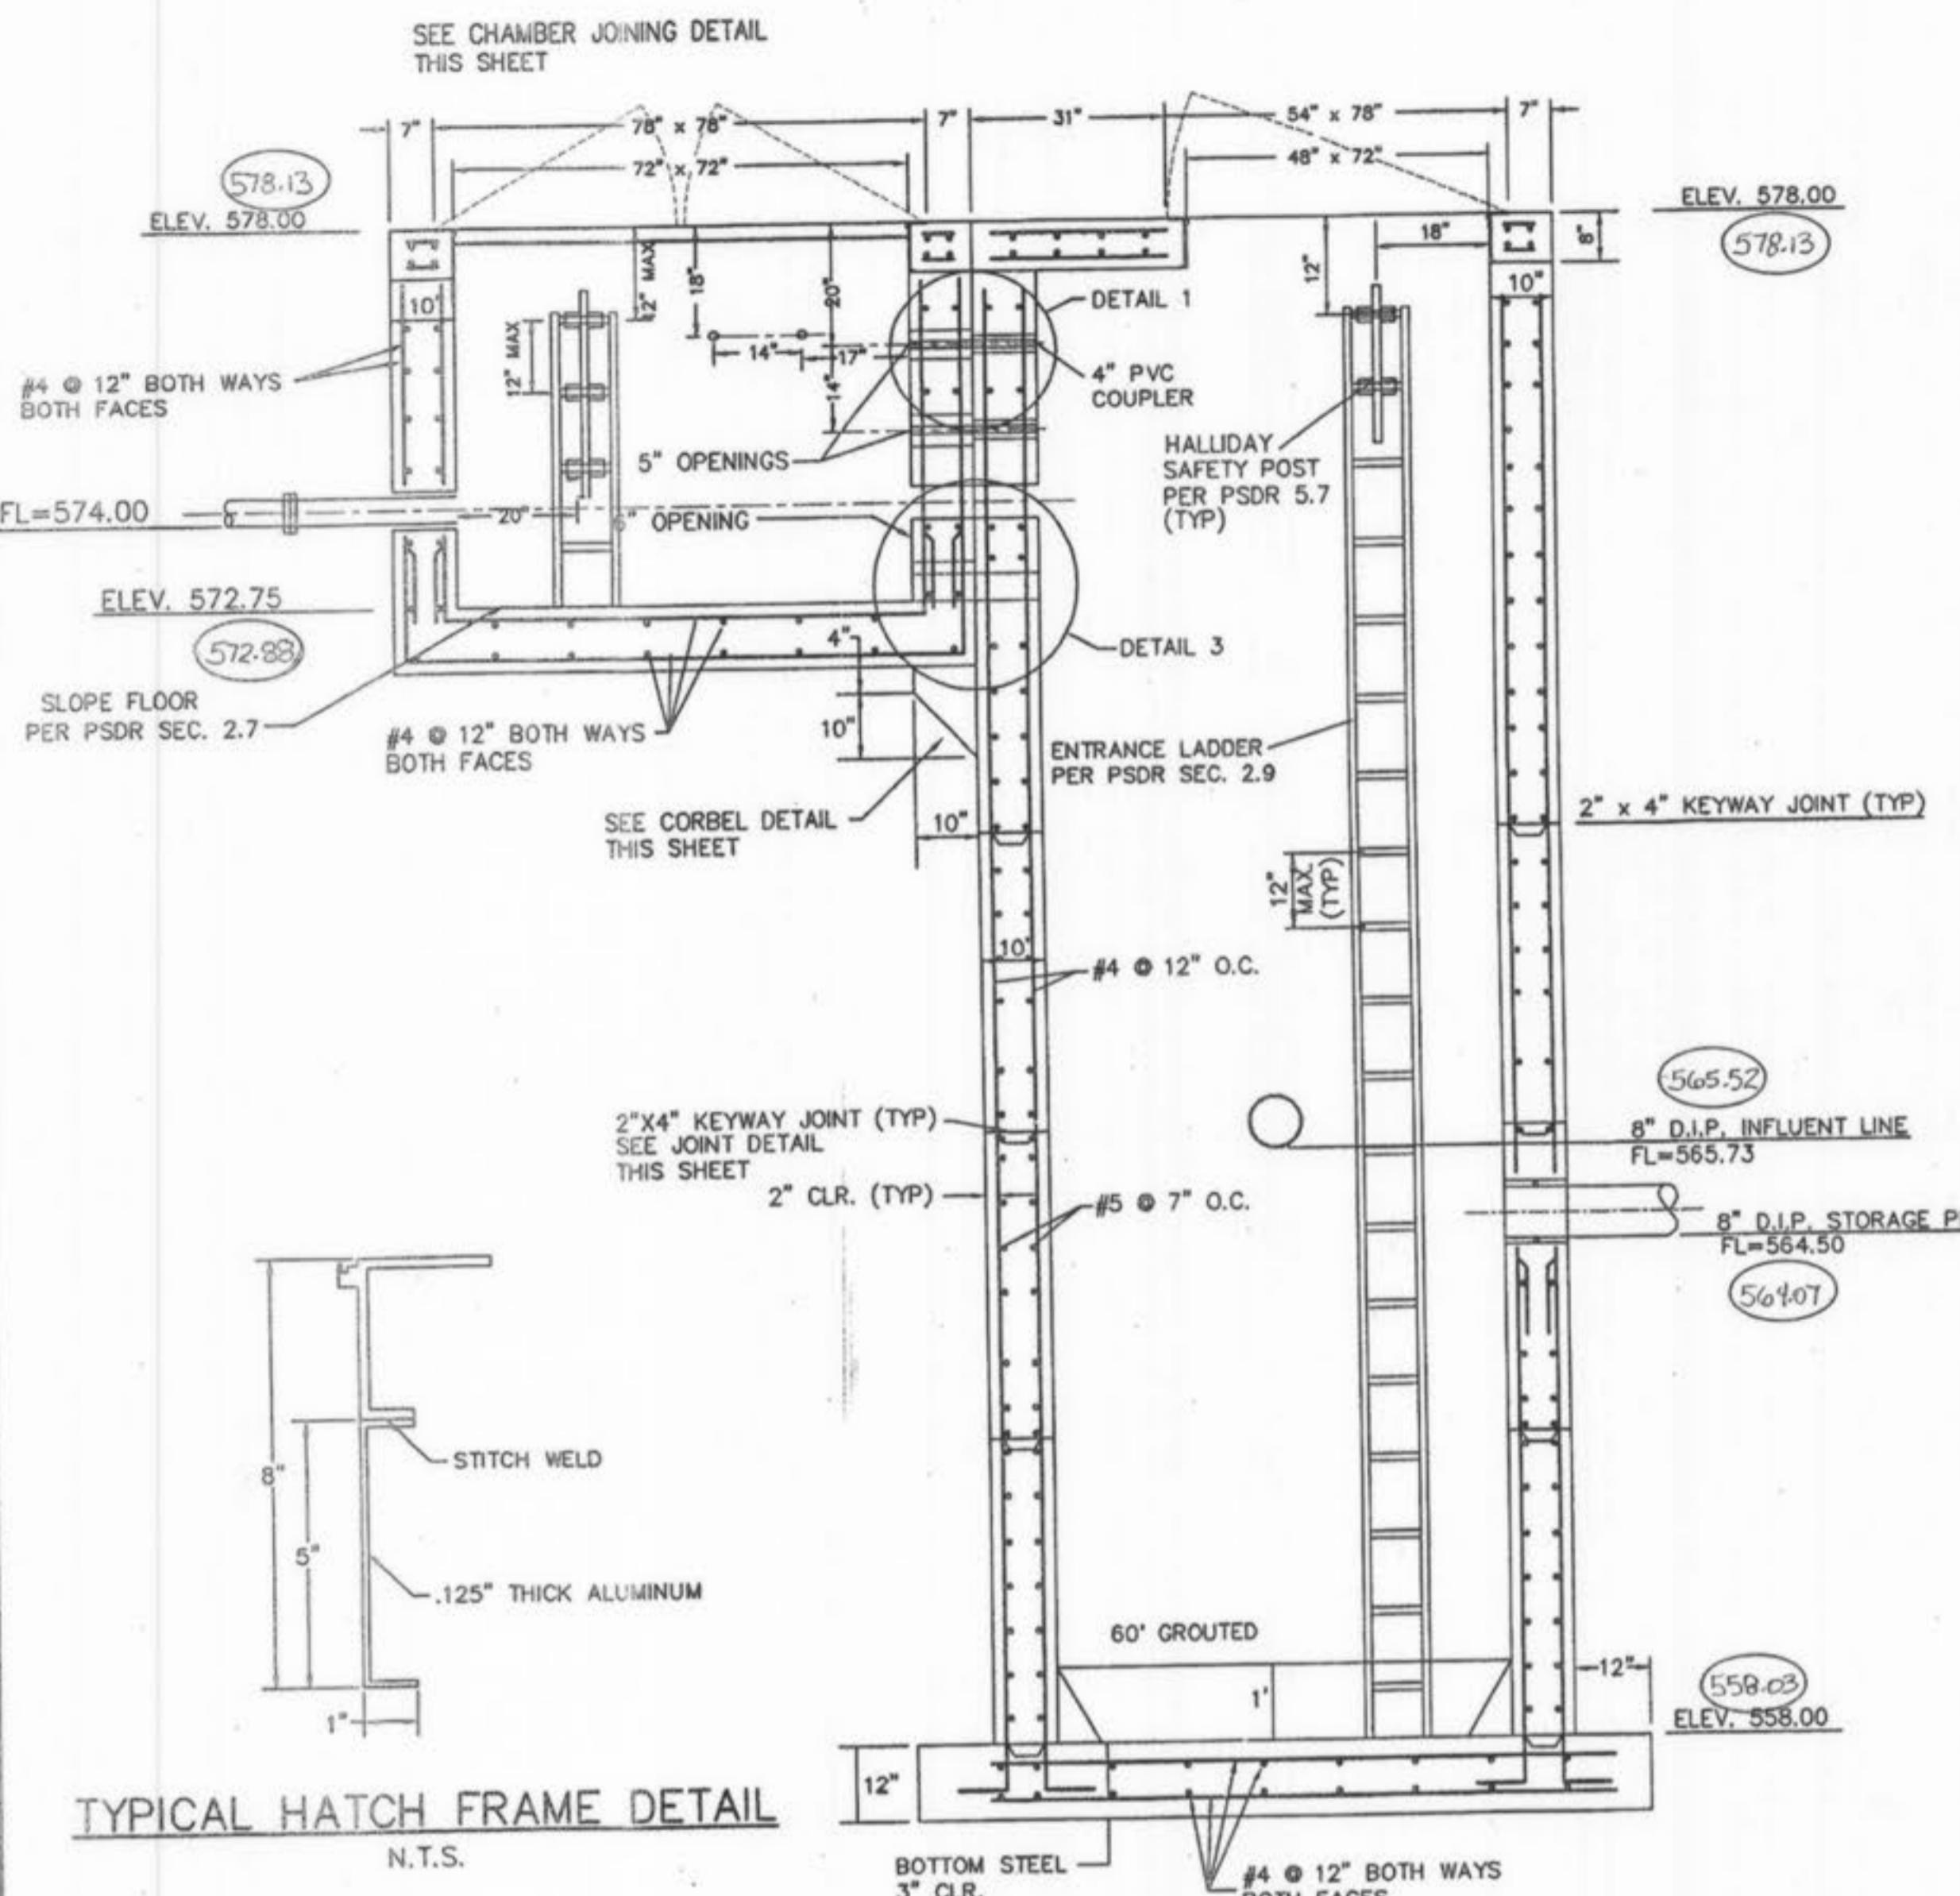

TYPICAL HATCH FRAME DETAIL


N.T.S.

SECTION A-A
SCALE: 1/2" = 1'-0"

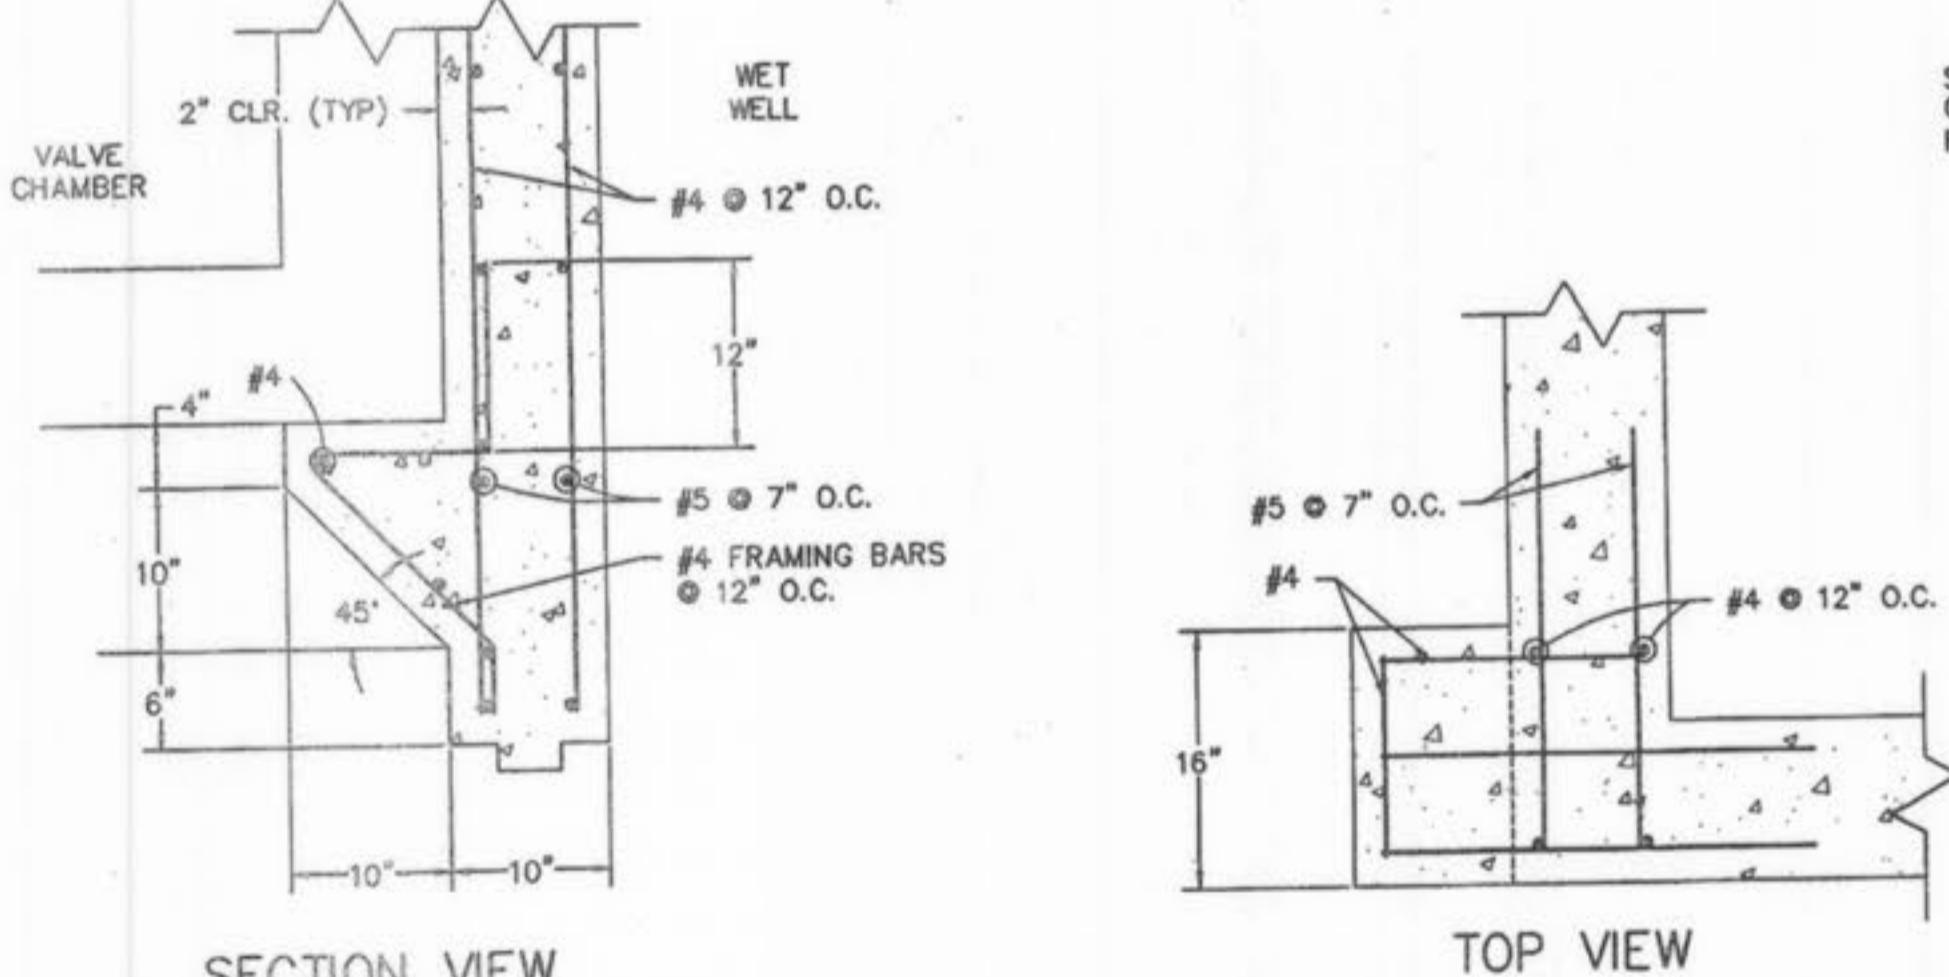

CORBEL DETAIL
SCALE: 1" = 1'-0"

NOTE: 4" DIA. OPENINGS TO BE PLACED IN SAME LOCATION ON COMMON WALL OF WET WELL

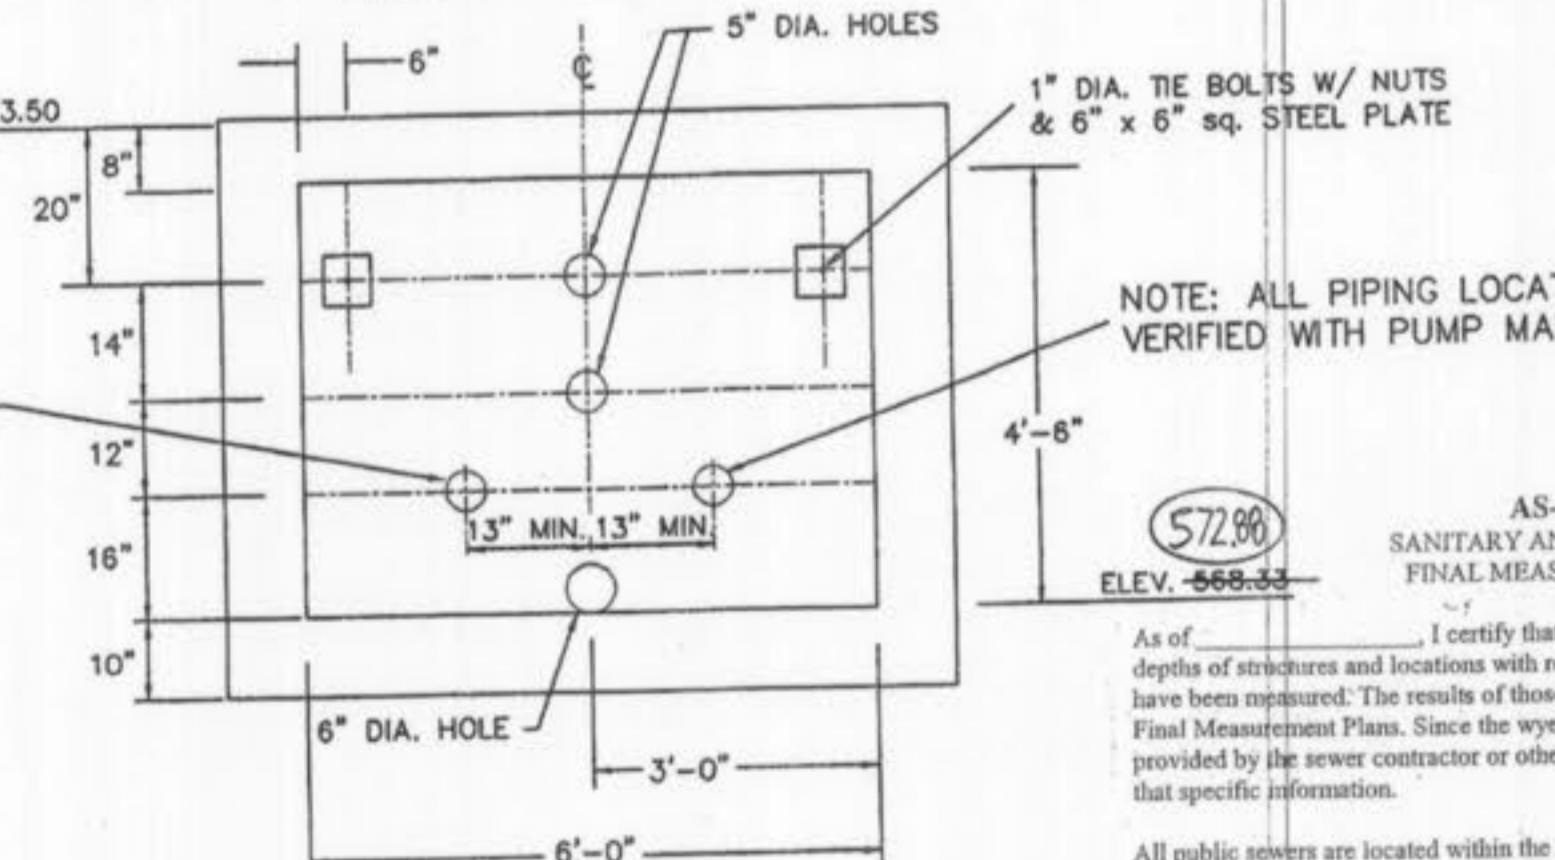


SECTION "B-B"
VALVE CHAMBER
WALL OPENING DETAIL

SCALE: 1/2" = 1'-0"


=AS-BUILT

THE PROFESSIONAL WHOSE SIGNATURE AND PERSONAL SEAL APPEAR HEREON, ASSUMES RESPONSIBILITY ONLY FOR WHAT APPEARS ON THIS PAGE, AND DISCLAIMS (PURSUANT TO SECTION 327.411 RSMO) ANY RESPONSIBILITY FOR ALL OTHER PLANS, SPECIFICATIONS, ESTIMATES, REPORTS, OR OTHER DOCUMENTS OR INSTRUMENTS NOT SEALED BY THE UNDERSIGNED PROFESSIONAL RELATING TO OR INTENDED TO BE USED FOR ANY PART OR PARTS OF THE PROJECT TO WHICH THIS PAGE REFERS.

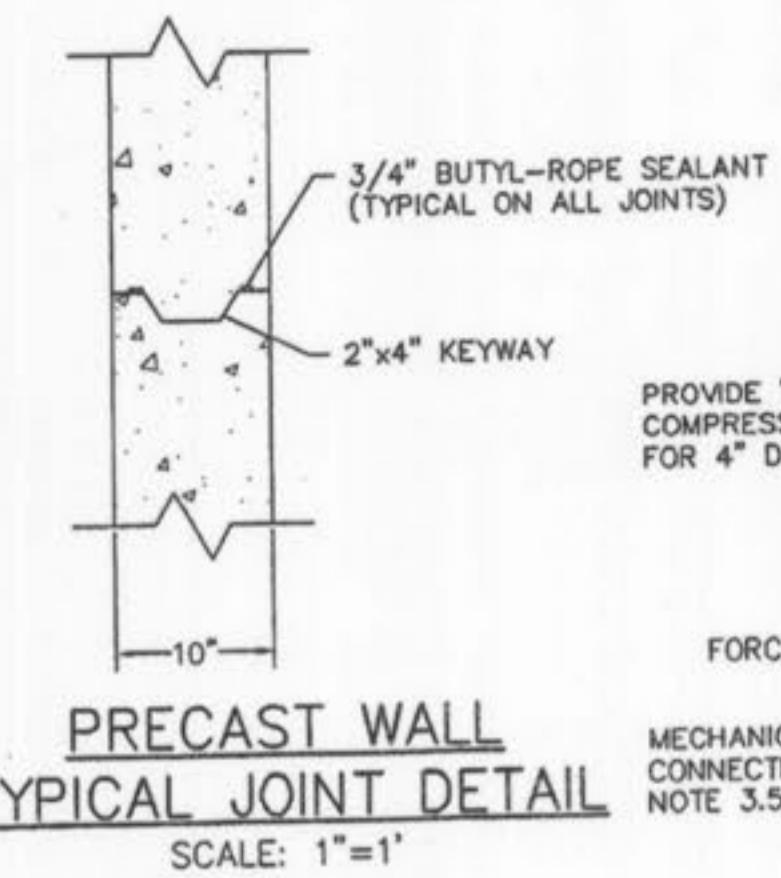


PRECAST WALL
TYPICAL JOINT DETAIL

SCALE: 1" = 1'

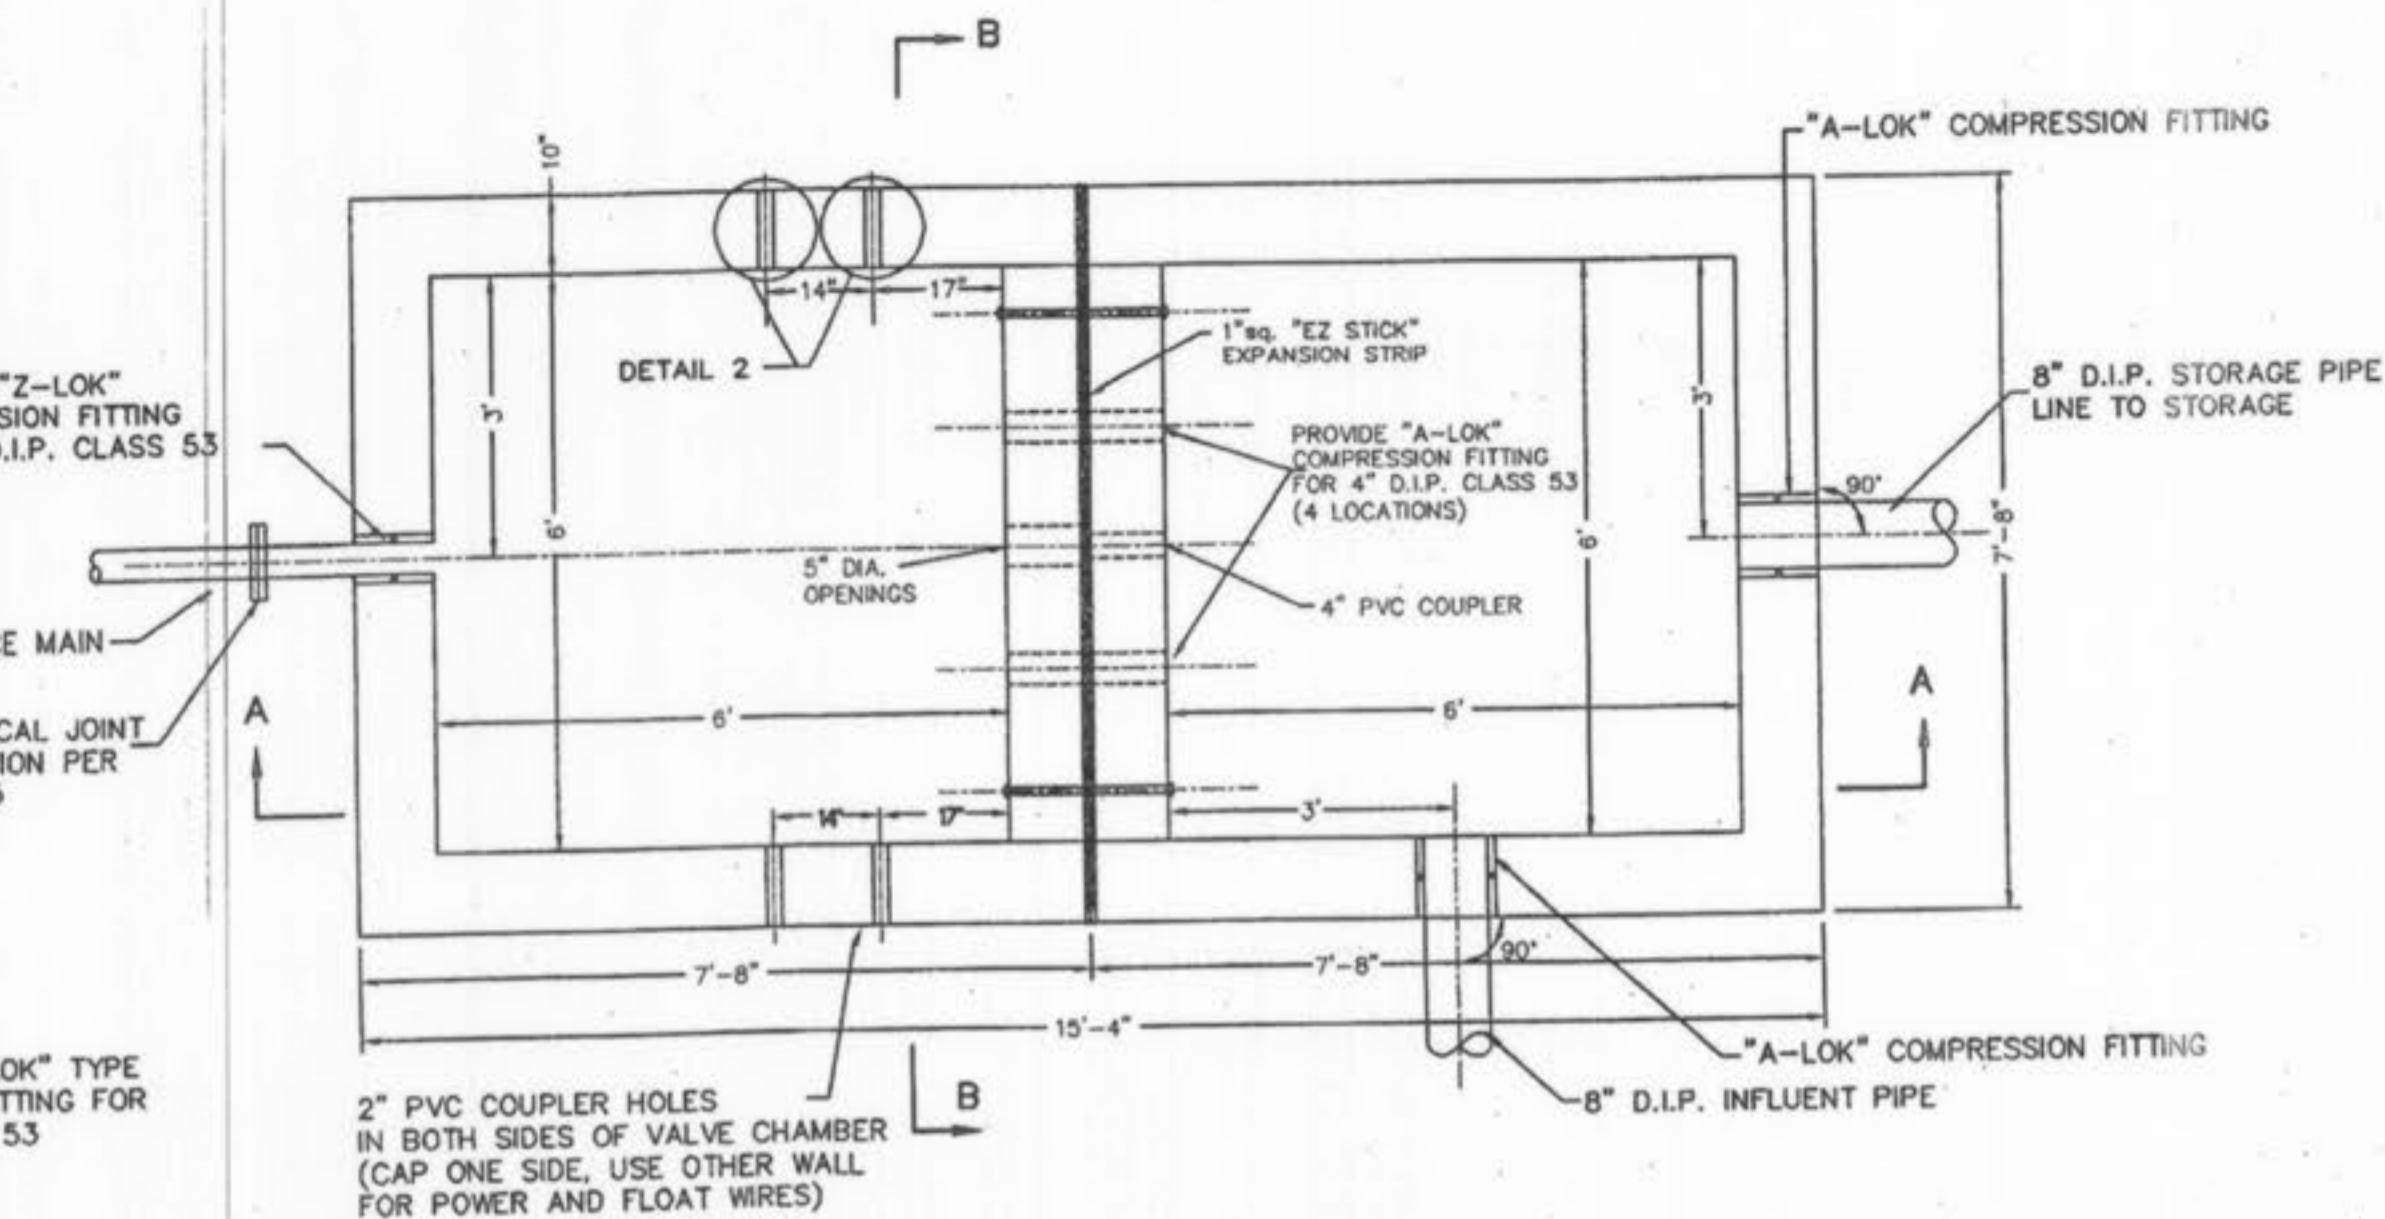


WET WELL & VALVE CHAMBER

SCALE: 1/2" = 1'-0"

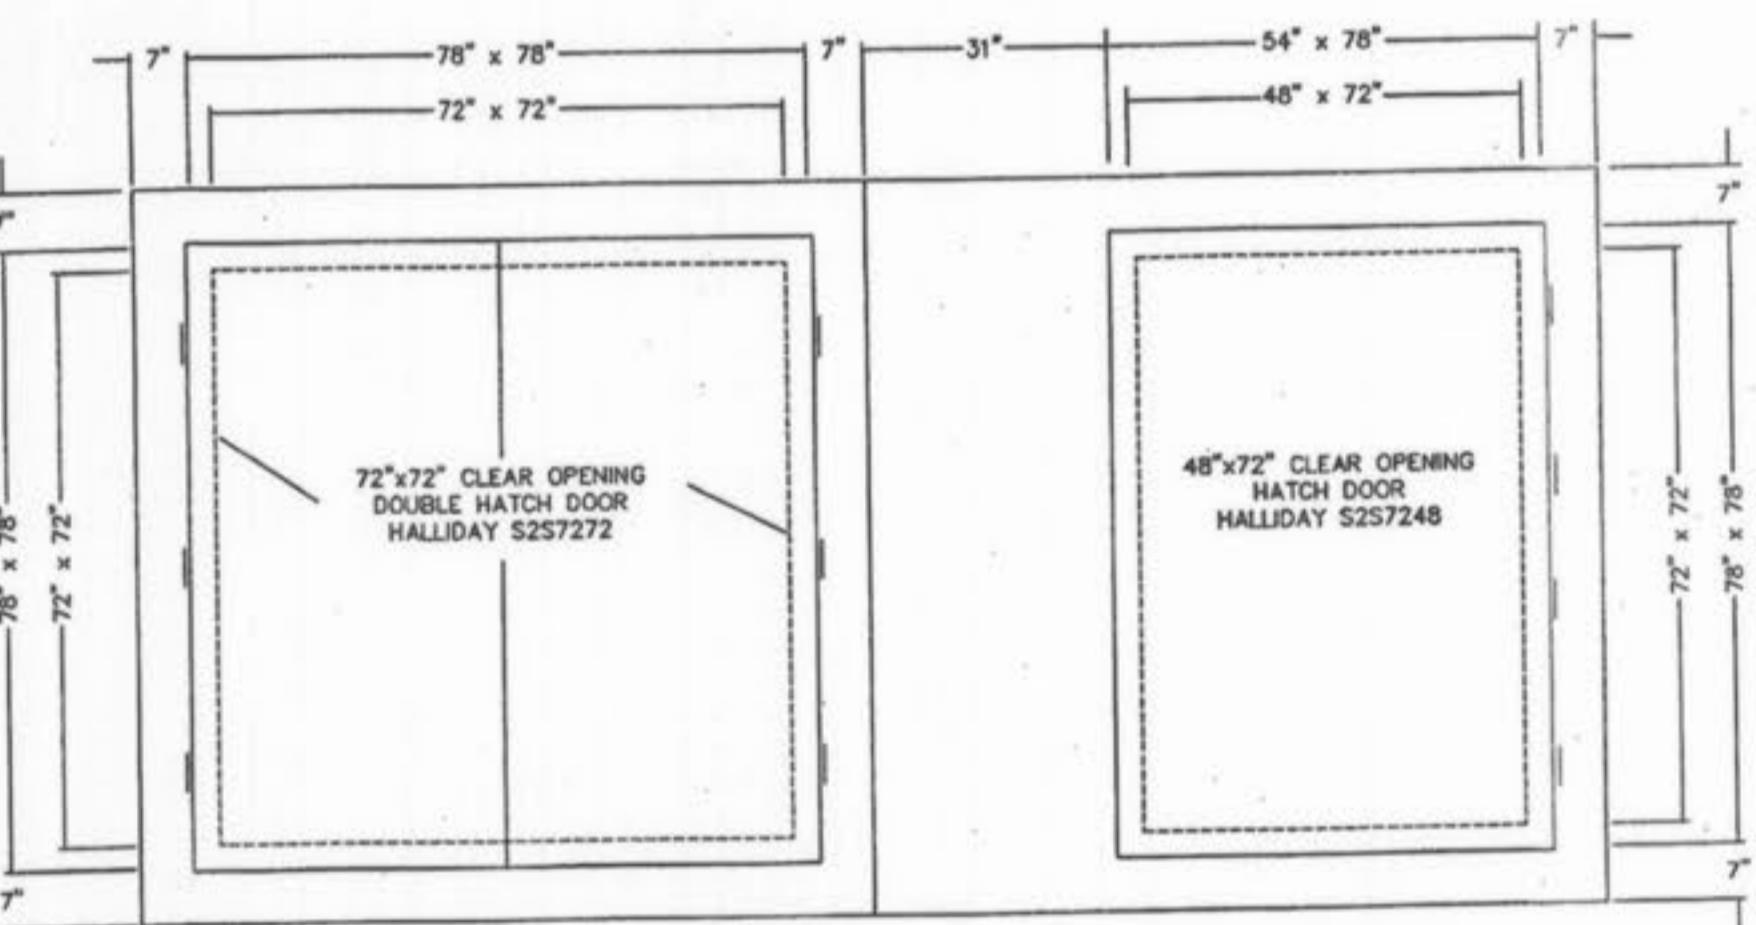


HATCH LOCATION DETAIL
PLAN

SCALE: 1/2" = 1'-0"

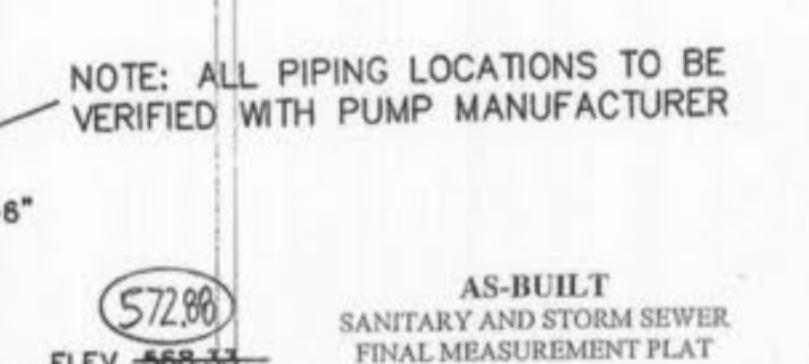

DETAIL 1
SCALE: 1/2" = 1'-0"

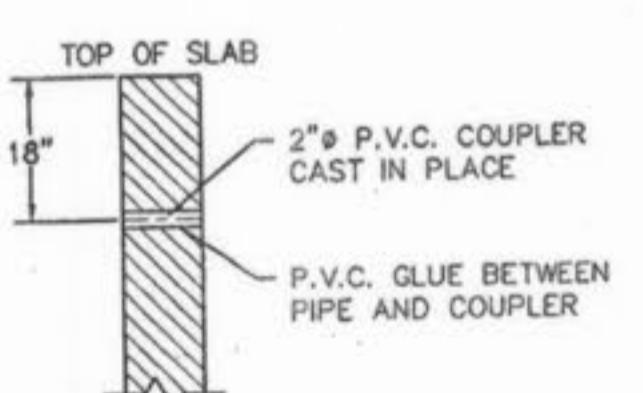

DETAIL 2

SCALE: 1/2" = 1'-0"

DRAWINGS APPROVED THIS DATE:
OCT 04 2004
PERMIT NO.: 2004-2-015
DUCKETT CREEK SANITARY DISTRICT

NO. 03 06 147
M.S.D.
P# 47
DIGITAL FILE LOCATION
SERIAL=STERLING-2
DA 01147PIMPROV.dwg

SHEET 48

48

PREPARED BY: THE **STERLING** CO.
ENGINEERS & SURVEYORS
5035 NEW BADINGARTNER ROAD
ST. LOUIS, MISSOURI 63129
(314)-457-0440 FAX 467-6944
E-Mail: Sterling@sterling-ang-sur.com

PROJECT: **FOX HAVEN**
DRAWN: _____
DESIGNED: _____
CHECKED: _____

BASE MAP

Foxhaven As Built 22/23

ISSUE / REMARKS/DATE
1 03-01-04 FIRST SUBMITTAL
1 06-15-04 REVISED PER CITY & DCSD COMMENTS
3 07-20-04 REVISED PER CITY COMMENTS
4 08-04-04 REVISED PER DCSD COMMENTS

PREPARED FOR:
McBride & Son Homes
Land Development, Inc.
#1 McBride & Son Center Drive
Chesterfield, Missouri 63005
(636) 537-2000

