



BAX PROJECT NAME : Frontier Middle School Athletic Fields
 BAX PROJECT NO. : 03-12495
 DESIGN DATE : 3/29/2011
 DESIGNED BY : TCF
 FILENAME: 12495aab

UPP STR	LOW STR	L	DIA	FL LN	FL LN	PS	ST EL	HY GR	UPPER HY EL	LOWER HY EL	HYDR GRADE	FR HEAD	VEL	VEL HEAD	JUNC LOSS	TURN LOSS	CURVE LOSS	STR LOSS	INL CAP	DR ARRA	PI	Q	TQ	PIPE CAP	LINE NUMBER	REMARKS
GI5	GI3	102	12	587.85	586.58	1.24	592.46	3.70	588.76	588.52	.00170	0.18	1.90	0.06	0.06	0.00	0.00	LOW	0.00	0.75	2.58	1.49	1.49	3.97	1	
GI4	GI3	146	12	587.98	586.58	0.96	591.51	1.22	590.29	588.52	.00990	1.45	4.52	0.32	0.00	0.00	LOW	0.00	1.83	2.58	3.55	3.55	3.48	2		
GI3	AI2	195	18	586.38	584.63	0.90	592.38	3.86	588.52	587.65	.00420	0.82	3.84	0.23	0.05	0.00	LOW	0.00	0.88	2.58	1.75	6.79	9.94	3		
AI2	FE1	32	18	584.43	583.78	2.00	591.39	3.74	587.65	587.37	.00550	0.18	4.39	0.30	0.10	0.00	LOW	0.00	0.44	2.58	0.97	7.76	14.87	4	15YR HM=587.37	


* INDICATES CRITICAL DEPTH

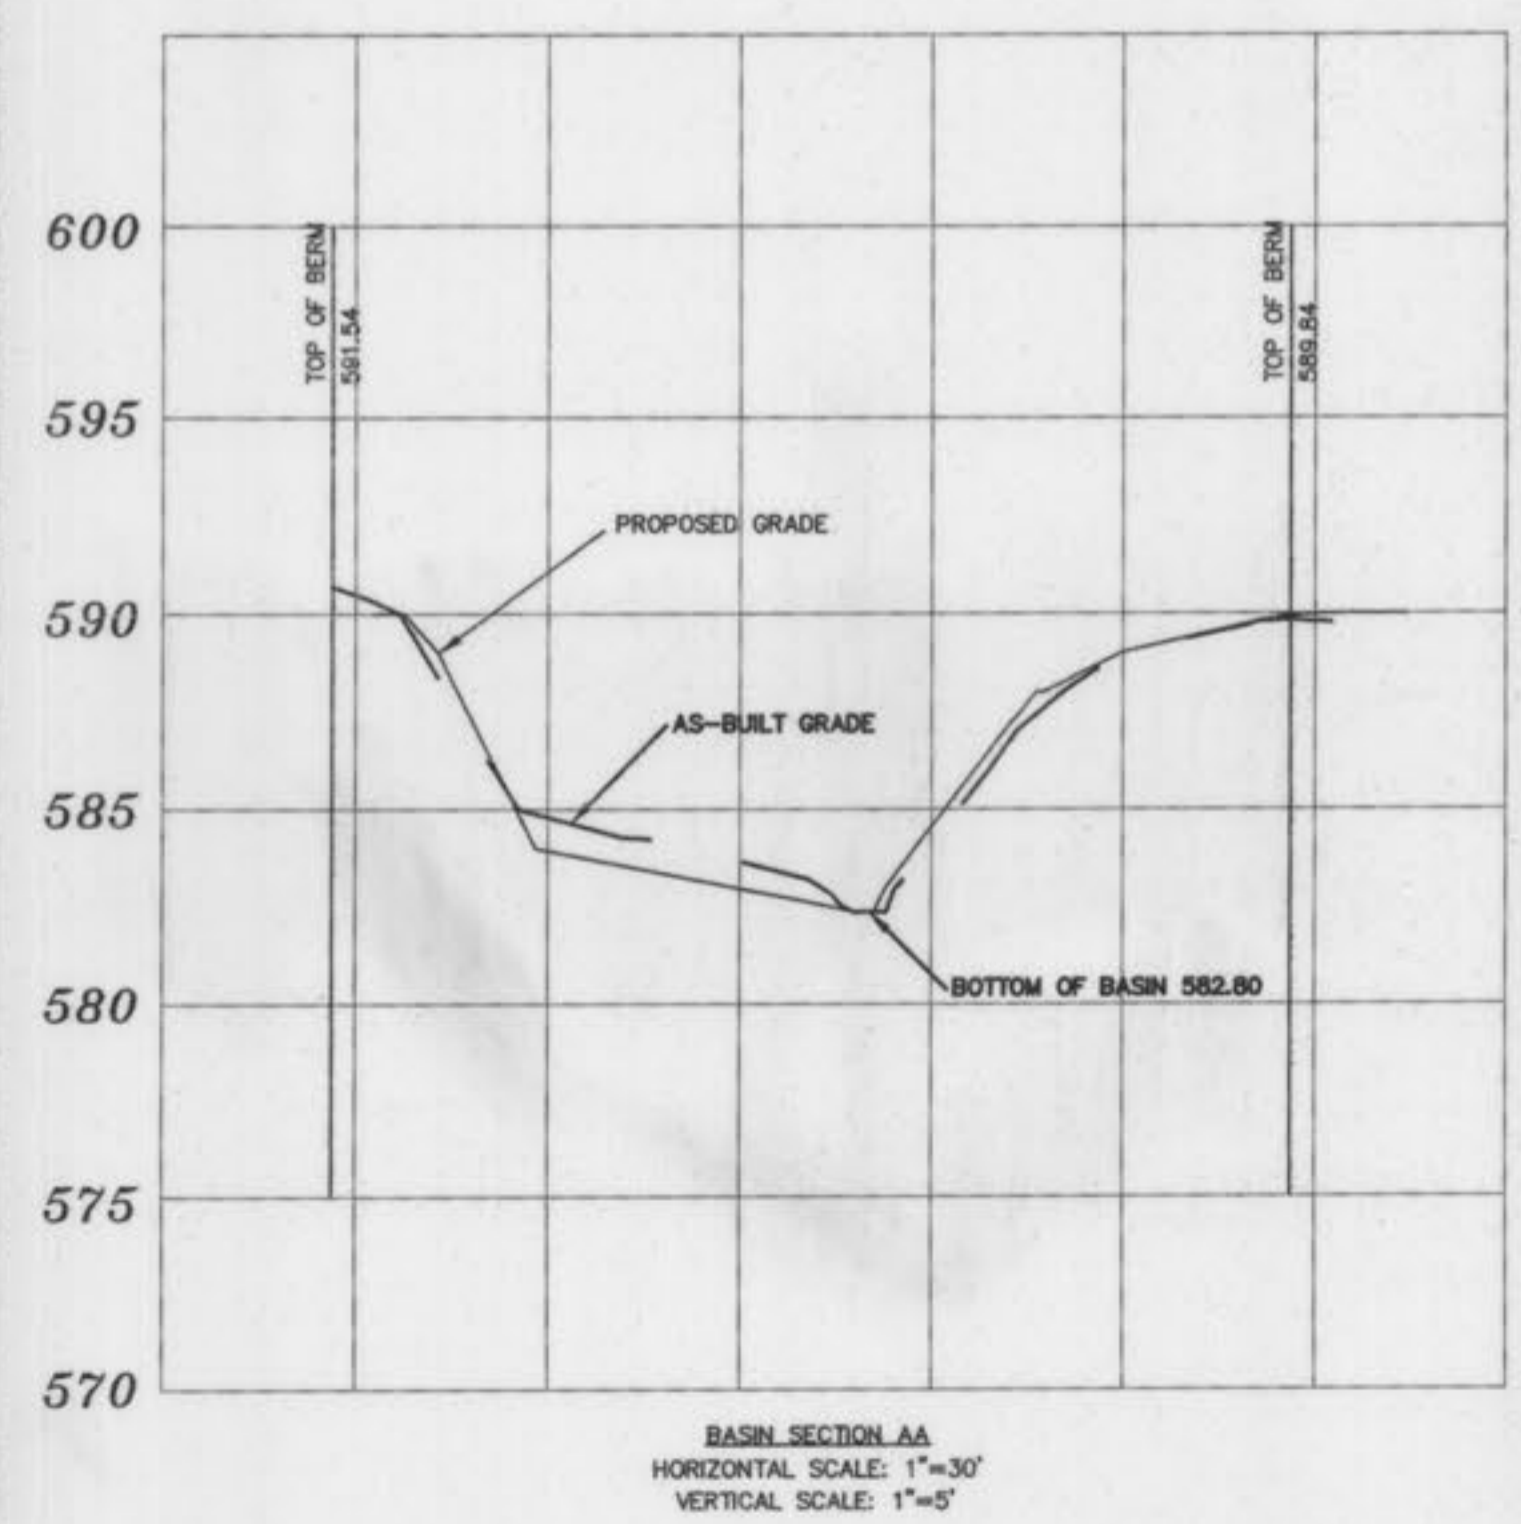


BASIN SECTION AA
 HORIZONTAL SCALE: 1"=30'
 VERTICAL SCALE: 1"=5'

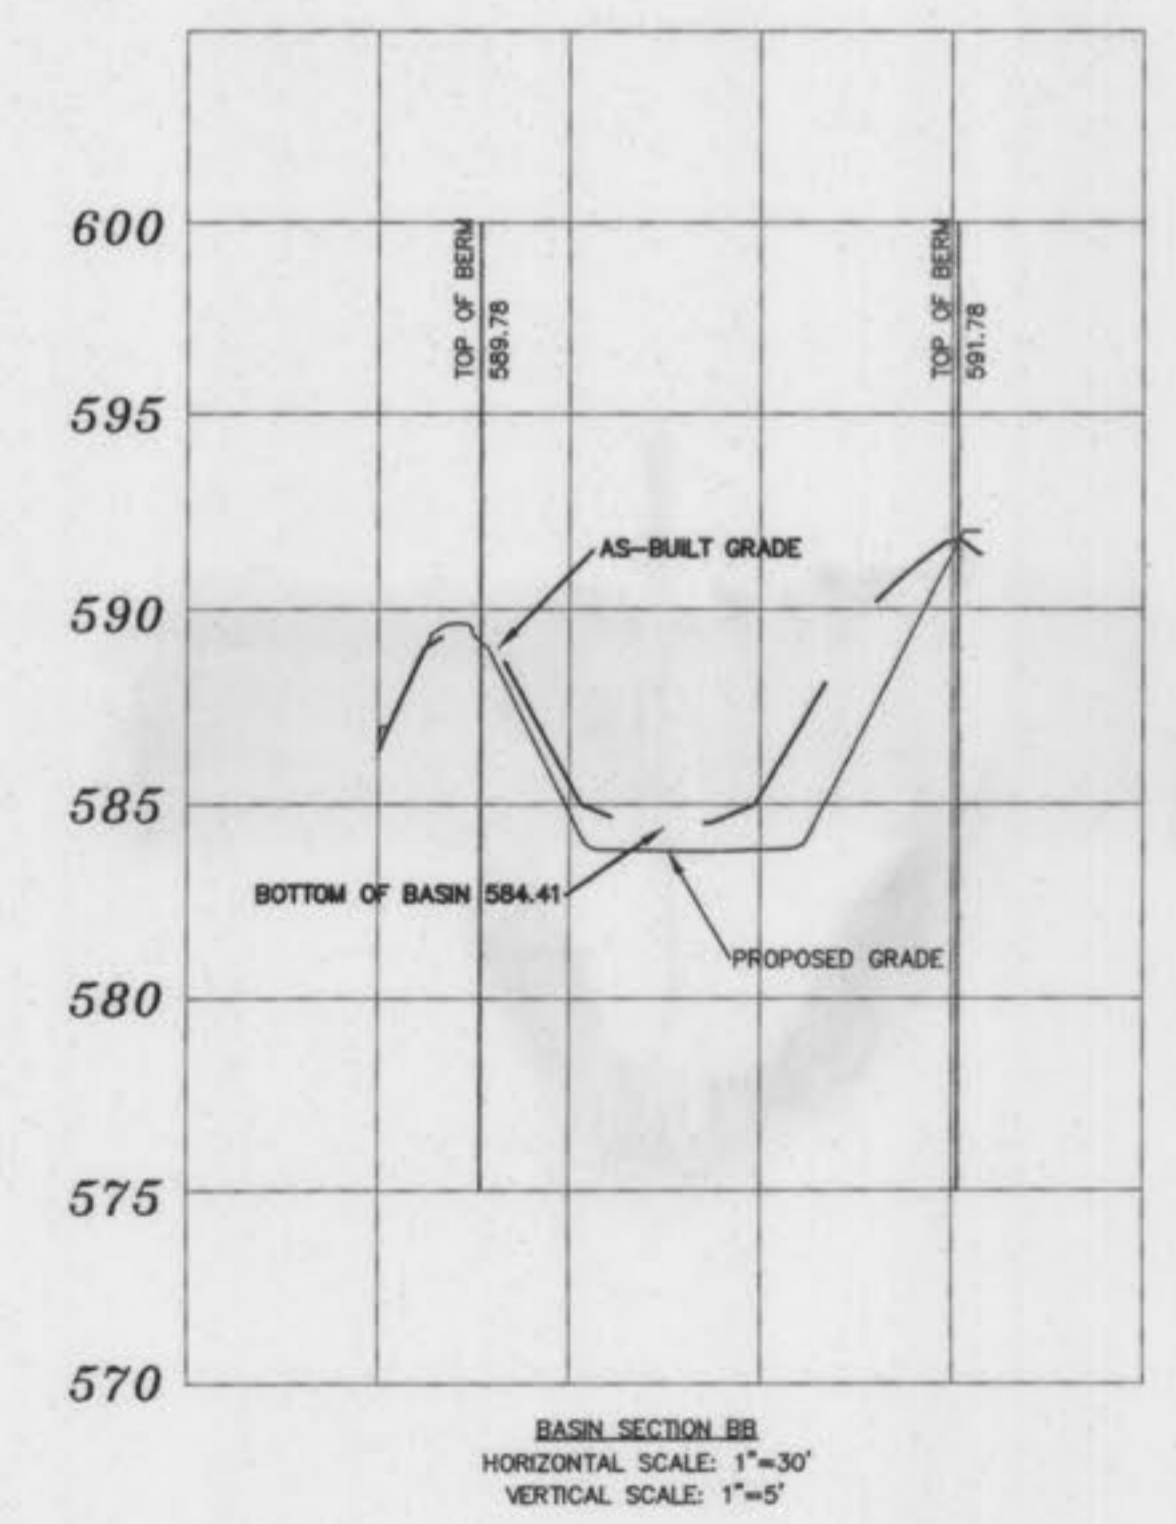


BASIN SECTION BB
 HORIZONTAL SCALE: 1"=30'
 VERTICAL SCALE: 1"=5'

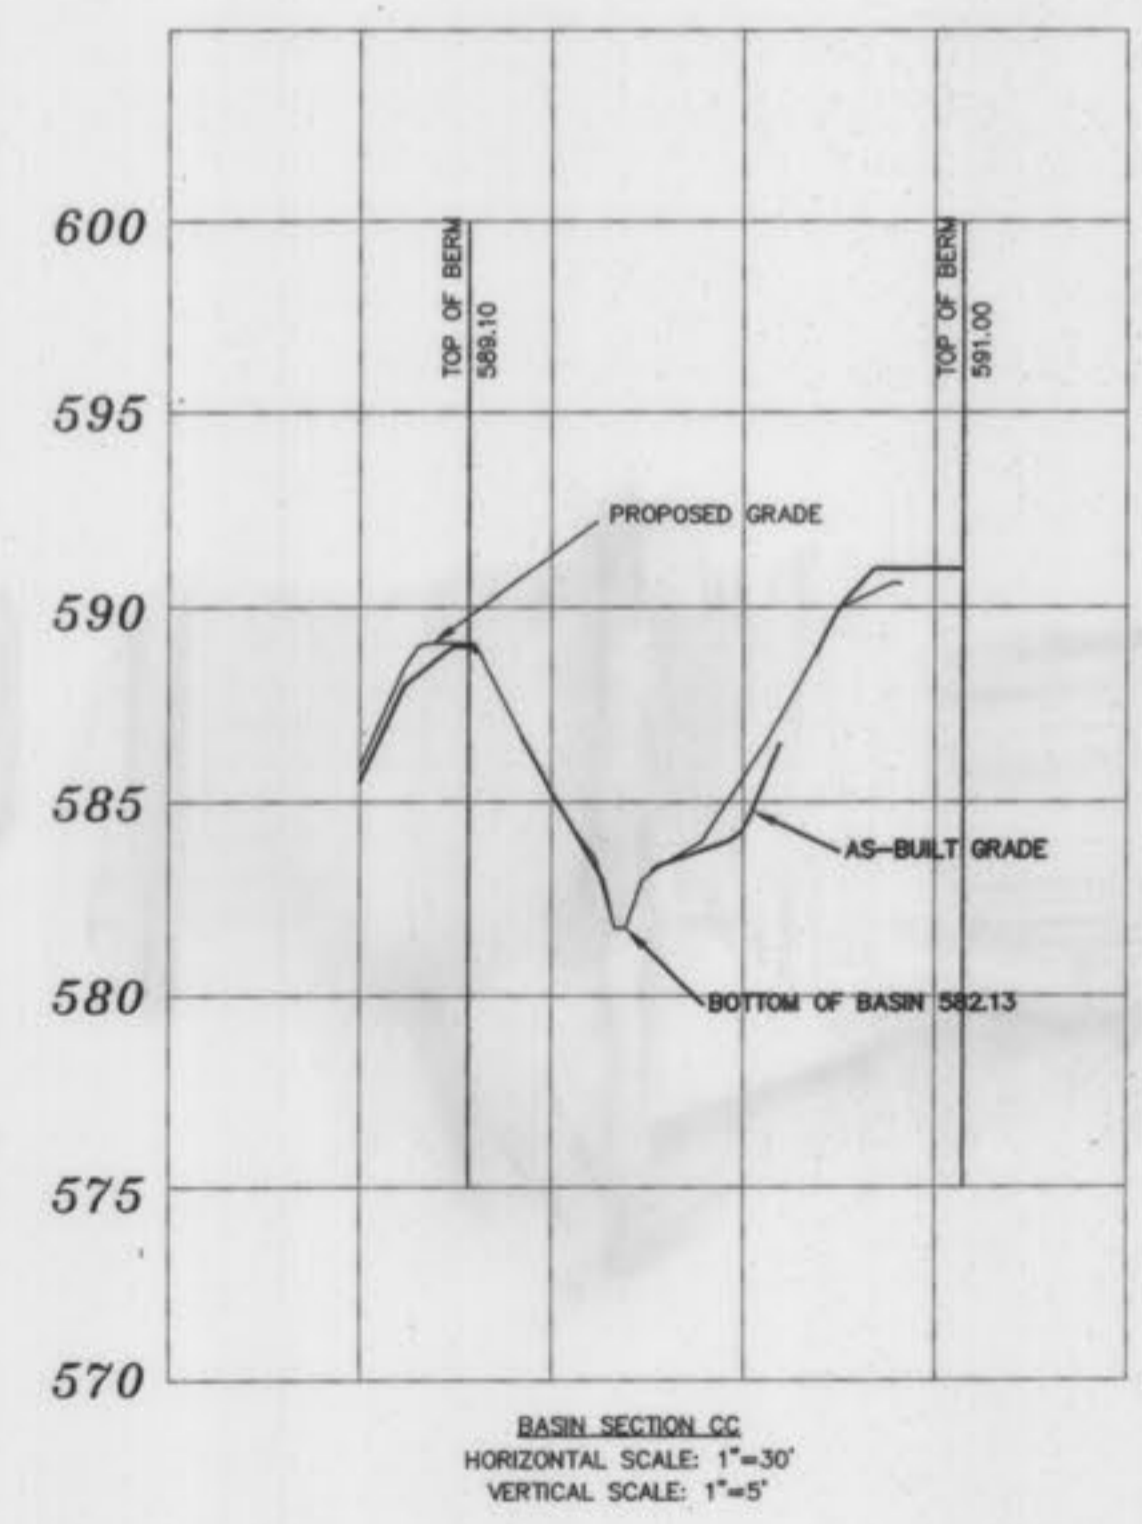

BASIN SECTION CC
 HORIZONTAL SCALE: 1"=30'
 VERTICAL SCALE: 1"=5'

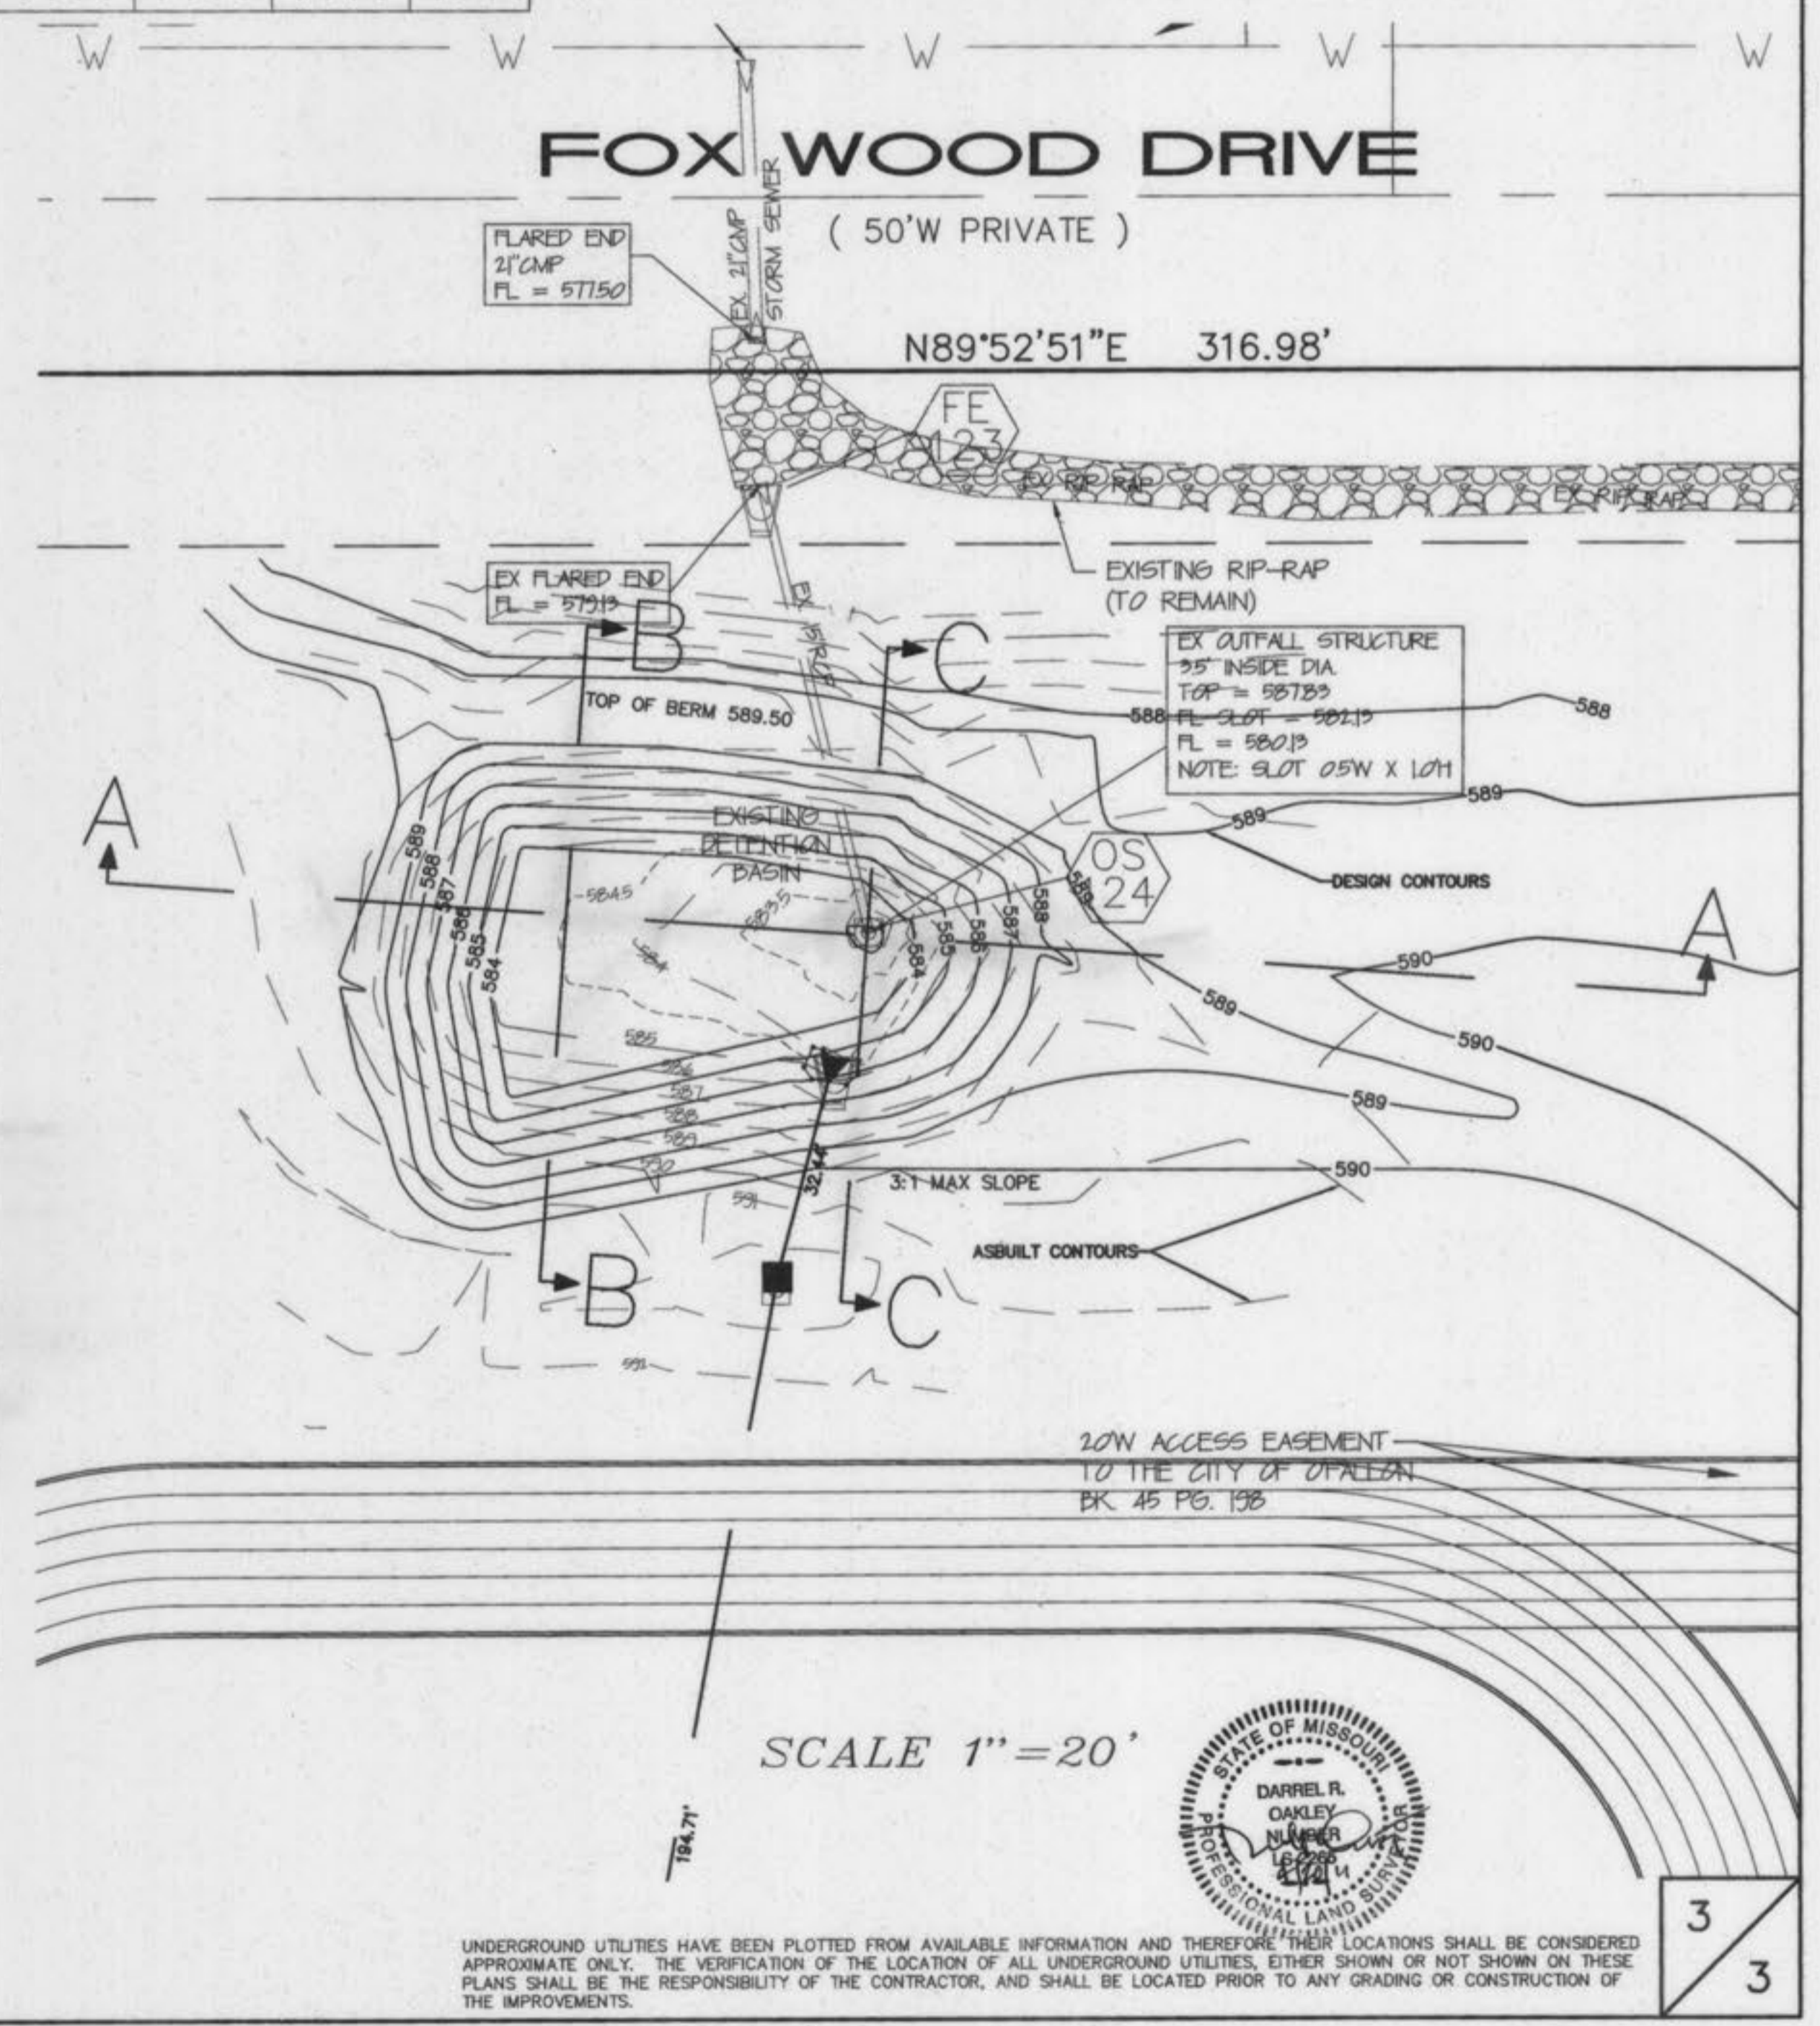

SCALE 1"=20'

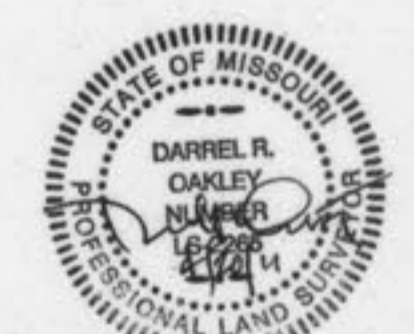

UNDERGROUND UTILITIES HAVE BEEN PLOTTED FROM AVAILABLE INFORMATION AND THEREFORE LOCATIONS SHALL BE CONSIDERED APPROXIMATE ONLY. THE VERIFICATION OF ALL UNDERGROUND UTILITIES, EITHER SHOWN OR NOT SHOWN ON THESE PLANS SHALL BE THE RESPONSIBILITY OF THE CONTRACTOR, AND SHALL BE LOCATED PRIOR TO ANY GRADING OR CONSTRUCTION OF THE IMPROVEMENTS.