


A SET OF AS-BUILT PLANS FOR FRONTIER MIDDLE SCHOOL ADDITION

A TRACT OF LAND BEING PART OF FRACTIONAL SECTION 15, TOWNSHIP 46 NORTH, RANGE 2 EAST OF THE FIFTH PRINCIPAL MERIDIAN ST. CHARLES COUNTY, MISSOURI

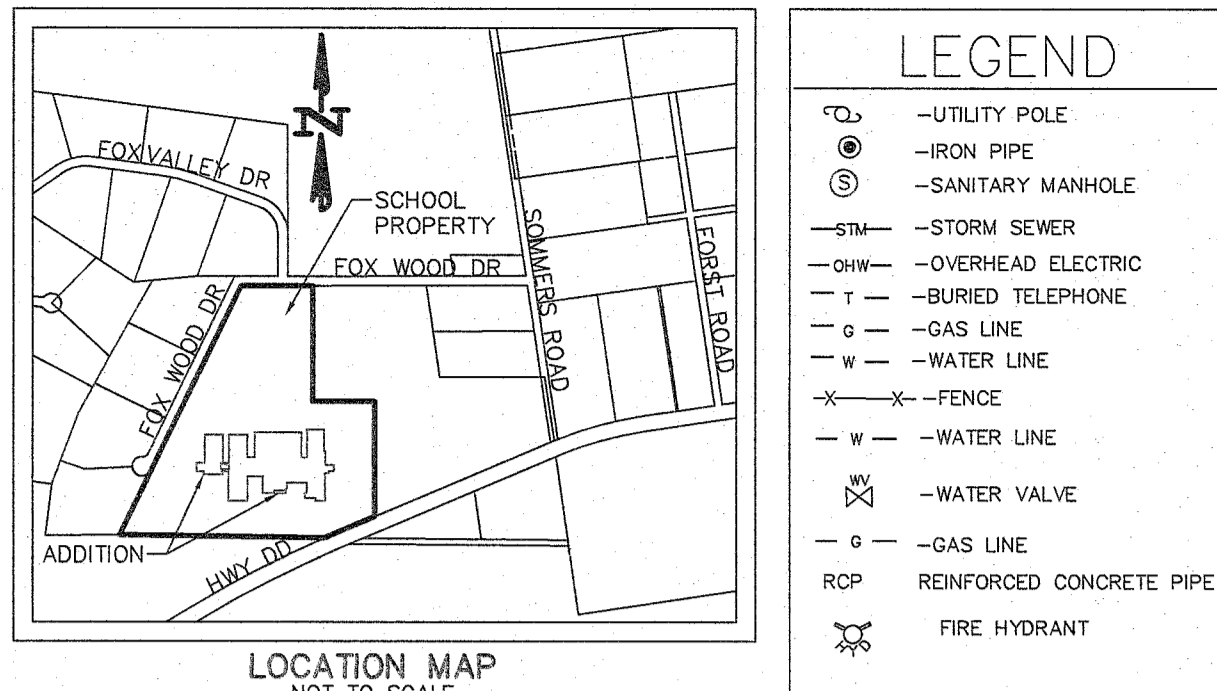

LEGEND	
⊕	UTILITY POLE
⊙	IRON PIPE
⊗	SANITARY MANHOLE
—S—	STORM SEWER
—O—	OVERHEAD ELECTRIC
—T—	BURIED TELEPHONE
—G—	GAS LINE
—W—	WATER LINE
—X—	FENCE
—V—	WATER VALVE
—A—	GAS VALVE
⊕	REINFORCED CONCRETE PIPE
⊕	FIRE HYDRANT

Drawing Index

- 1 COVER SHEET
- 2 NOTES
- 3 SITE PLAN
- 4 LANDSCAPE PLAN
- 5 GRADING PLAN
- 6.1 STORM WATER POLLUTION PREVENTION PLAN
- 7 PRE-DRAINAGE AREA MAP
- 8 PROPOSED DRAINAGE AREA MAP
- 9 SEWER PROFILES & OUTFALL DETAILS
- 10 CONSTRUCTION DETAILS
- 11 STORM WATER POLLUTION PREVENTION DETAILS
- 12 SEWER DETAILS

Planning and Zoning conditions:

On January 2, 2020, the Planning and Zoning Commission approved the Site Plan for 9233 Highway DD (Frontier Middle School) (19-01147).

- The approval is conditional upon the following Staff recommendations being met:
1. A photometric lighting plan shall be required.
 2. Additional landscaping details shall be provided, including the tree preservation calculations.
 3. The wall along Highway DD shall be extended to the property line, and an alternate grading easement shall be provided for a future connection if needed.

Please Note:

- The Site Plan Approval shall expire, and be of no effect, one (1) year after the date of issuance thereof, unless within such time Construction Plans or Building Permits for any proposed work authorized under the said site plan approval has been issued.
- Prior to approval of a Building Permit, a Construction Site Plan must be reviewed and approved by City Staff. The application is available on the City's website via www.ofallon.mo.us (City Departments: Public Works, Engineering) through the Ofallon Permitting, Licensing, and Enforcement (OPLE) system.
- The appropriate Fire District will need to review and approve the development.
- Any signage to be placed on the subject property requires a separate Sign Permit.
- Any business occupying the site requires approval of a Business License.
- All Conditions of Approval shall be noted on the Construction Site Plans.

VEGETATION ESTABLISHMENT For Urban Development Sites APPENDIX A	
SEEDING RATES:	
PERMANENT:	Soil Fescue - 150 lbs./ac. Smooth Bromes - 100 lbs./ac. Continued - Fescue @ 50 lbs./ac. AND Bromes @ 50 lbs./ac.
TEMPORARY:	Wheat or Rye - 150 lbs./ac. (3.5 lbs. per 1,000 s.f.) Oats - 120 lbs./ac. (2.75 lbs. per 1,000 s.f.)
SEEDING PERIODS:	
Fescue or Bromes -	March 1 to June 1 August 1 to October 1
Wheat or Rye -	March 15 to November 1 March 15 to September 15
MULCH RATES:	
100 lbs. per 1000 sq. ft. (4,356 lbs. per ac.)	
FERTILIZER RATES:	
Nitrogen	30 lbs./ac.
Phosphate	30 lbs./ac.
Potassium	30 lbs./ac.
Lime	600 lbs./ac. ENM*
* ENM = effective neutralizing material as per State evaluation of quarried rock.	

* City of O'Fallon Construction work hours per City Ordinance 3429 as shown in section 500.420 of the Municipal Code of the City of O'Fallon are as follows:

October 1 through May 31
7:00 A.M. To 7:00 P.M. Monday Through Sunday
June 1 Through September 30
6:00 A.M. To 8:00 P.M. Monday Through Friday
7:00 A.M. To 8:00 P.M. Saturday and Sunday

* The area of this phase of development is 5.8 Ac.


The area of land disturbance is 5.8 Ac.

Building setback information. Front 25'

Side 6'

Rear 25'

* The estimated sanitary flow in gallons per day is 4,170

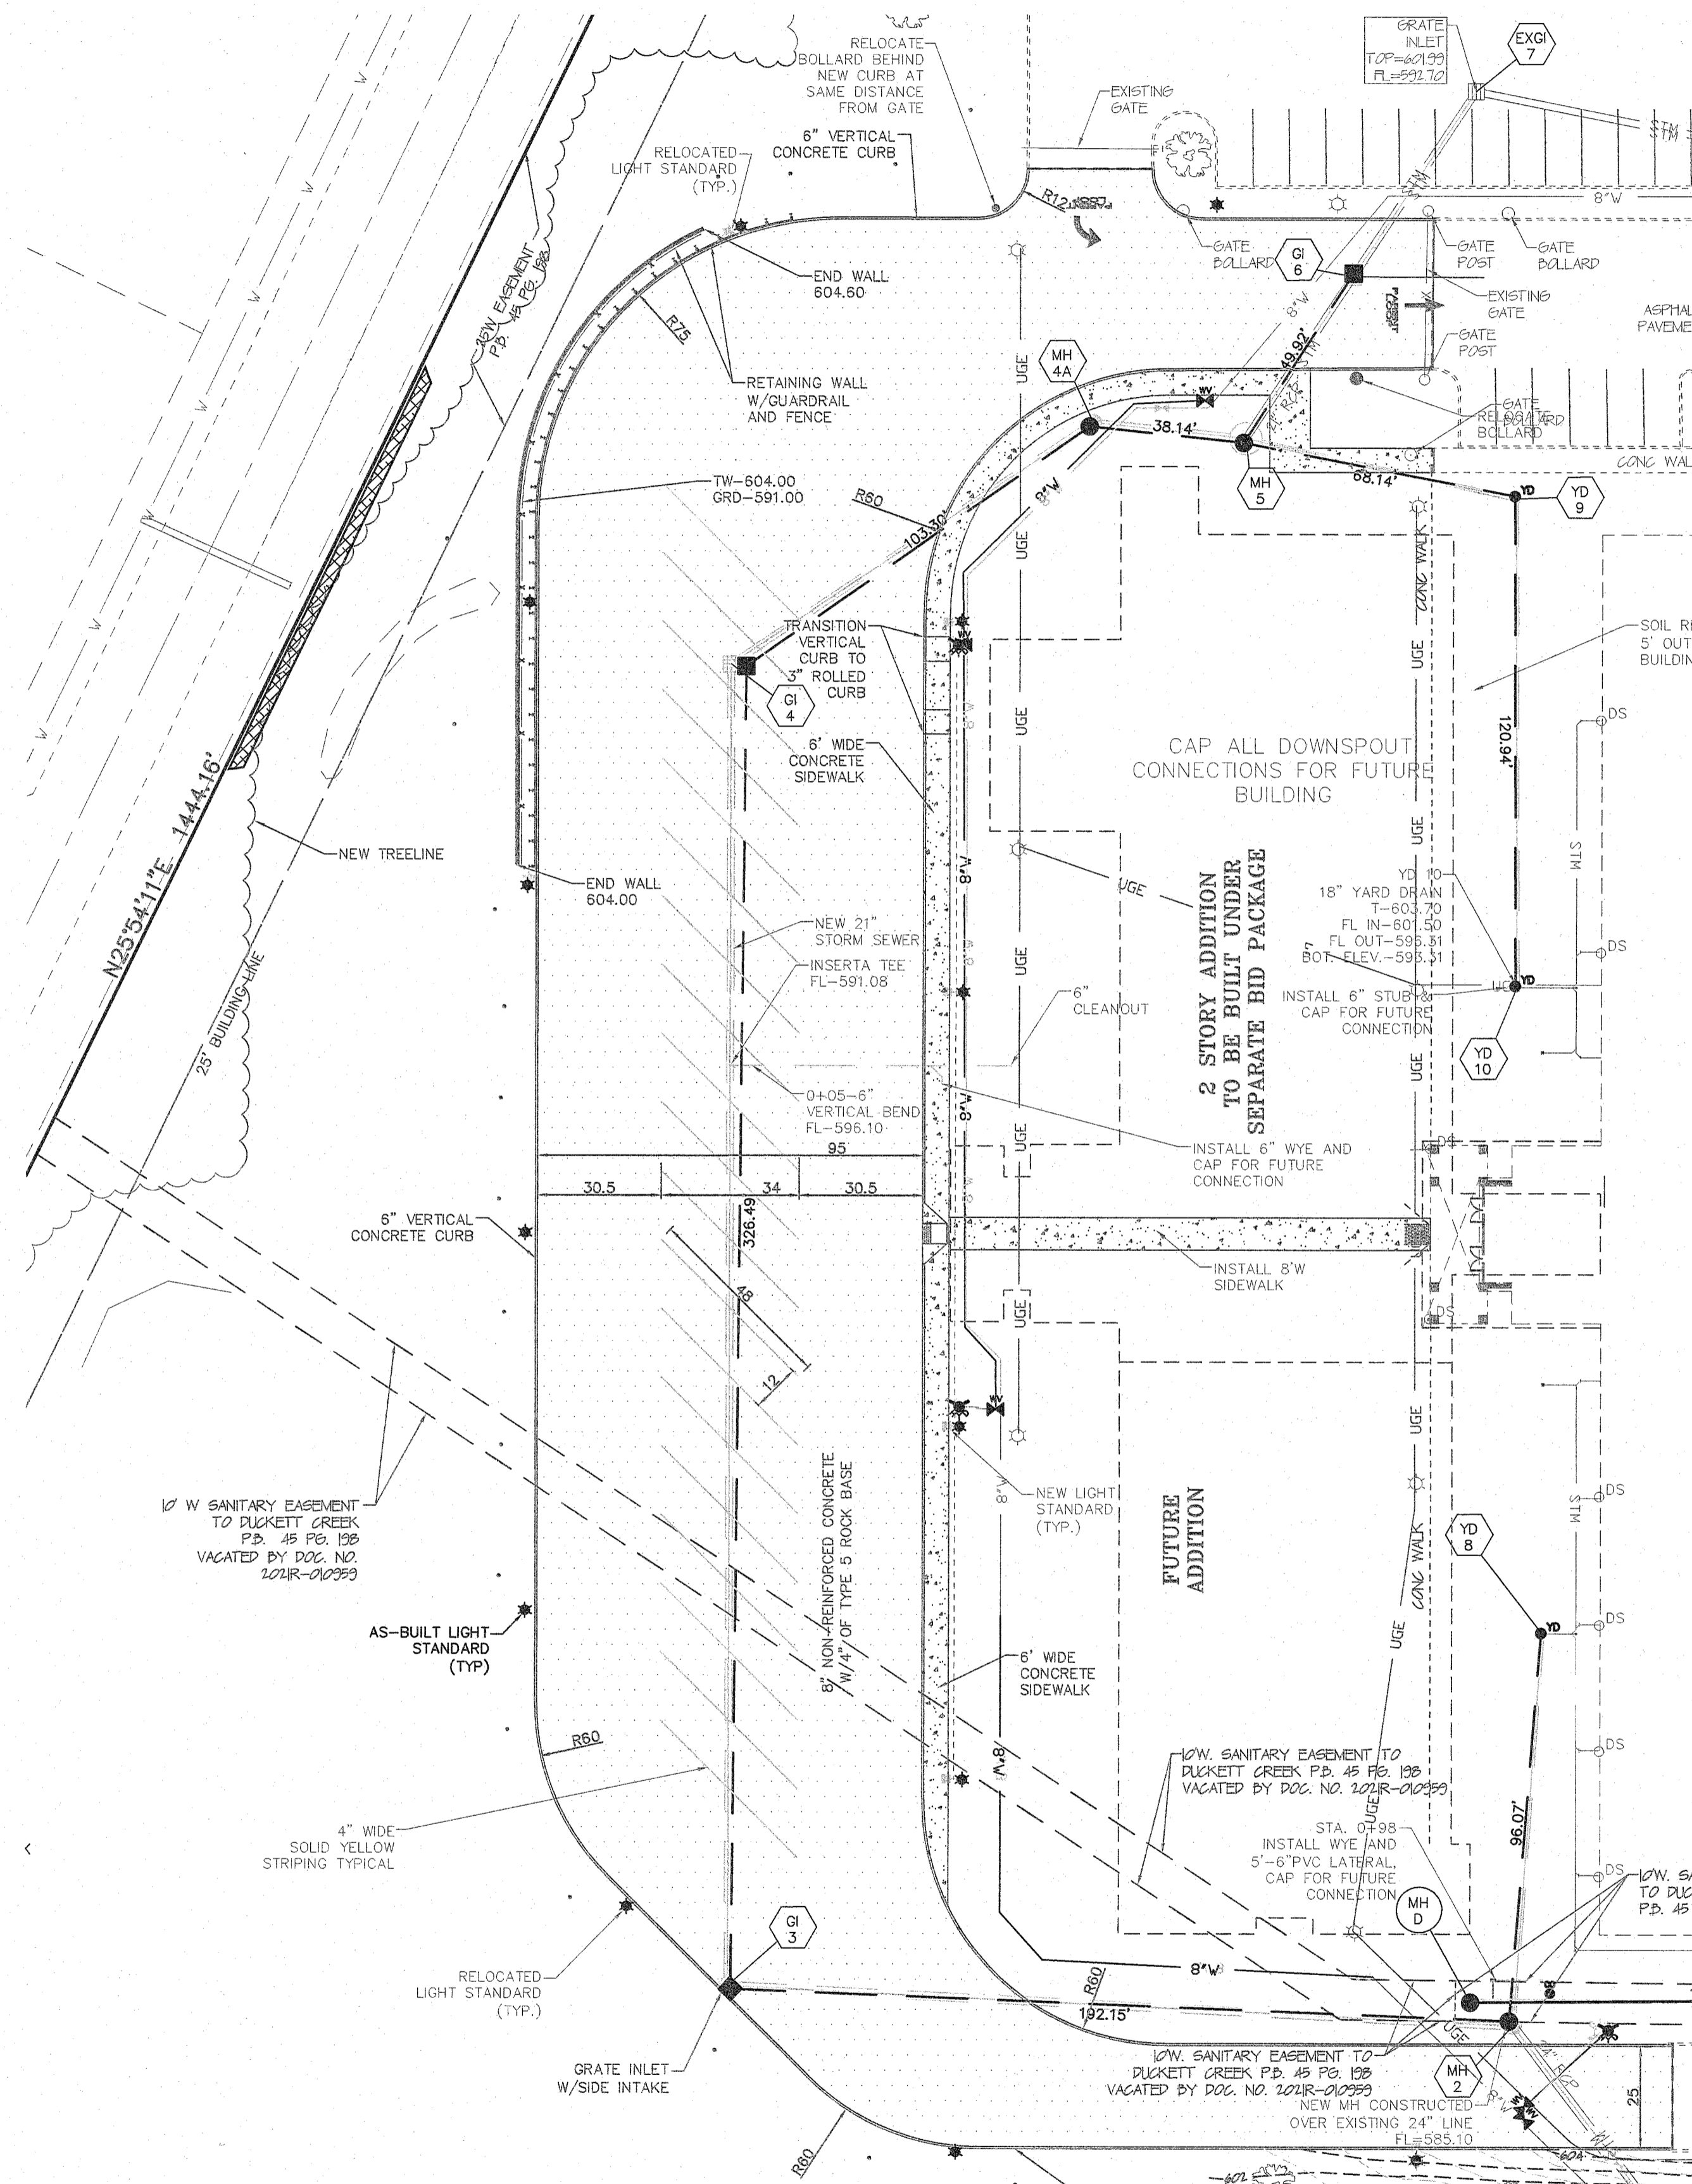

SITE MAP

CITY OF O'FALLON
COMMUNITY DEVELOPMENT DEPARTMENT
ACCEPTED FOR CONSTRUCTION

BY: *[Signature]* DATE: **02/16/2021**

PROFESSIONAL ENGINEER'S SEAL
INDICATES RESPONSIBILITY FOR DESIGN

City approval of any construction site plans does not mean that any building can be constructed on the lots without meeting the building setbacks as required by the zoning codes. All installations and construction shall conform to the approved engineering drawings. However, if the developer chooses to make minor modifications in design and/or specifications during construction, they shall make such changes at their own risk, without any assurance that the City Engineer will approve the completed installation or construction. It shall be the responsibility of the developer to notify the City Engineer of any changes from the approved drawings. The developer may be required to correct the installed improvement so as to conform to the approved engineering drawings. The developer may request a letter from the Construction Inspection Division regarding any field changes approved by the City Inspector. Lighting values will be reviewed on site prior to the final occupancy inspection.


AS-BUILT PUBLIC UTILITY FINAL MEASUREMENTS

THE FOLLOWING UTILITIES HAVE BEEN LOCATED AND MEASURED AND THE RESULTS OF THOSE MEASUREMENTS ARE SHOWN ON THIS SET OF FINAL MEASUREMENT PLANS:

- STORM SEWERS, STORM SEWER LENGTHS, STORM SEWER PIPE SIZES, STORM SEWER FLOWLINES, DEPTHS OF STORM SEWER STRUCTURES AND TOPOGRAPHY OF MODIFIED DETENTION BASIN.
- SANITARY SEWERS, SANITARY SEWER LENGTHS, SANITARY SEWER PIPE SIZES, SANITARY SEWER FLOWLINES AND DEPTHS OF SANITARY SEWER STRUCTURES.
- FIRE HYDRANTS
- WATER VALVES
- LIGHT STANDARDS

ALL PUBLIC UTILITIES SHOWN HEREON AS BEING AS-BUILT ARE LOCATED WITHIN DESIGNATED EXISTING OR PROPOSED EASEMENTS.

BAX ENGINEERING COMPANY, INC.
MARK E. COLLINS
MISSOURI PROFESSIONAL LAND SURVEYOR #2006000173

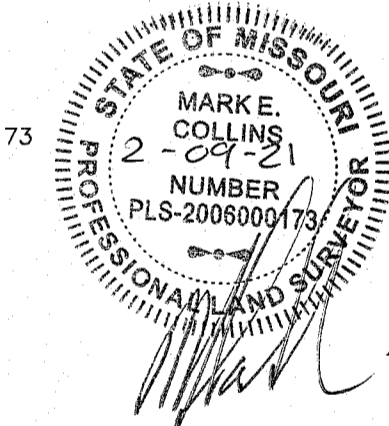

GRADING QUANTITY

20,981 cu.yds. cut
19,322 cu.yds. fill
(INCLUDES 8% SHRINKAGE AND BUILDING OVERDIG)

THE ABOVE YARDAGE IS AN APPROXIMATION ONLY, NOT FOR BIDDING PURPOSES. CONTRACTORS SHALL VERIFY QUANTITIES PRIOR TO CONSTRUCTION.

IT IS THE INTENTION OF THE ENGINEERING FOR THE EARTHWORK TO BALANCE ON-SITE. THE ENGINEER SHALL BE NOTIFIED IF ANY DIFFICULTIES ARISE IN ACHIEVING THE BALANCE. CONTRACTOR SHALL REDUCE CUT IN FIELD AREA AS NEEDED FOR BALANCED SITE.

GRADING PACKAGE - MINIMUM CONTRACT REQUIREMENTS

1. The Contractor shall complete grading and utility work in accordance with notes and details as shown on plans.
2. At the completion of the project and prior to acceptance by the owner, the Contractor shall have a grade check survey completed. The survey shall be signed by a licensed surveyor to verify final ground elevations. All grades shall be in accordance with tolerances as indicated on plans. Grade check survey shall be supplied to owner in Auto CAD format as well as hard copy drawings.
3. At the completion of the project and prior to acceptance by the owner, the Contractor shall have a storm sewer or-built survey completed. The survey shall be signed by a licensed surveyor to verify the storm sewers have been installed in accordance with the plans. As-built drawings shall include flowlines of all sewer lines, top elevations of all structures and location of lines stubbed for future connection to building. Survey shall be supplied to owner in Auto CAD format as well as hard copy drawings.
4. The Contractor shall clean out all silt from the sediment basins and grades shall be in accordance with plans prior to acceptance by the owner. Basin elevations shall be included in the grade check performed by the Contractor and provided to the owner.
5. The Contractor shall maintain all erosion control measures during the length of the contract. Prior to completion of the project the Contractor shall restore all erosion control measures and shall turn them over to the owner in working condition. The owner's representative shall inspect the erosion control measures with the Contractor prior to acceptance.
6. The Contractor shall provide copies of any SWPPP logs and plans that were generated during the duration of the grading contract.

Development Notes:

1. THIS PROPERTY IS A PART OF THE PROPERTY REFERENCED AS PARCEL I.D. NUMBER 4-0046-5013-00-0004.5000000 OF THE ST. CHARLES COUNTY ASSESSOR'S OFFICE.
2. AREA OF TRACT: 25.359 ACRES TOTAL
3. EXISTING ZONING: R-1 SINGLE FAMILY RESIDENCE, CITY OF O'FALLON
4. SITE ADDRESS: 9233 HIGHWAY DD, O'FALLON, MO 63368
5. PROPOSED USE: MIDDLE SCHOOL ADDITION
- OWNER: WENTZVILLE R-IV SCHOOL DISTRICT
280 INTERSTATE DRIVE
WENTZVILLE, MO 63385
6. SITE UTILITIES:
 - SRIPE 636-441-1244
 - SRIPE 314-522-2287
 - CLUIRE RIVER 636-895-4741
 - CENTURLINK 636-332-7261
 - SPECTRUM 888-436-2427
 - PUBLIC WATER DISTRICT#2 636-561-3737
7. BUILDING SETBACKS:
 - FRONT YARD = 25 FEET
 - SIDE YARD = 6 FEET
 - REAR YARD = 25 FEET
8. PARKING REQUIREMENTS:
 - MIDDLE SCHOOLS
 - TWO (2) SPACES PER CLASSROOM OR ONE (1) SPACE PER FIVE (5) SEATS OR EIGHT (8) FEET OF BENCH LENGTH IN AUDITORIUM, WHICHEVER IS GREATER, PLUS ONE (1) SPACE PER TWO (2) FACULTY AND STAFF

EXISTING CONDITIONS:
2 SPACES PER CLASSROOM = 59 CLASSROOMS X 2 = 118 SPACES
1 SPACE PER 2 FACULTY/STAFF = 100 MEMBERS = 50 SPACES
GYM/AUDITORIUM = 1 SPACE PER 5 SEATS (474 SEATS) = 95 SPACES REQUIRED

EXISTING PARKING REQUIRED = 168 REQUIRED (118 SPACES FROM CLASSROOMS (GREATER THAN GYM TOTAL) PLUS 50 SPACES FOR STAFF MEMBERS MINIMUM)
EXISTING ON-SITE TOTAL PARKING = 280 SPACES INCLUDING 17 ADA SPACES

PROPOSED:
2 SPACES PER CLASSROOM = 16 CLASSROOMS X 2 = 32 SPACES
1 SPACE PER 2 FACULTY/STAFF = 17 MEMBERS = 8.5 = 9 SPACES
PROPOSED PARKING REQUIRED = 41

TOTAL SITE PARKING REQUIRED = 209 SPACES
TOTAL EXISTING PARKING PROVIDED = 280 SPACES INCLUDING 17 ADA SPACES
NO ADDITIONAL PARKING REQUIRED ON THIS SITE

9. LANDSCAPING REQUIREMENTS:
18 EXISTING TREES TO BE AFFECTED BY NEW CONSTRUCTION AND WILL BE REPLACED.
PRIOR PHASES 1 THRU 5 OF THE BUILDING CONSTRUCTION PROVIDED LANDSCAPING ALONG HIGHWAY DD AND ALL SURROUNDING PROPERTIES AS REQUIRED.

10. TREE PRESERVATION CALCULATIONS:
TOTAL EXISTING TREES ON-SITE = 1.85 ACRES
1.35 ACRES TO BE PRESERVED = 1.08 ACRES PRESERVED, 0.27 ACRES ALLOWED TO BE REMOVED
TOTAL TREES BEING REMOVED = 0.37 ACRES, 0.10 ACRES TO BE REPLACED
0.10 ACRES X 15 TREES PER ACRE = 2 TREES TO BE REPLACED

11. BUFFER YARD REQUIREMENTS:
25 FT. LANDSCAPED BUFFER STRIP WITH ONE TREE PER FIFTY FEET OF STREET FRONTAGE. NO ADDITIONAL PLANTINGS ARE REQUIRED OTHER THAN NOTED ABOVE THAT WILL BE PLACED AROUND THE NEW BUS PARKING LOT WHERE SHOWN. FOXWOOD DRIVE ALREADY HAS TREE MASSES ALONG THE ROADSIDE AS BUFFER YARD TO THE SCHOOL SITE.

12. SITE COVERAGE CALCULATIONS:
EXISTING:
TOTAL SITE: 25,359 ACRES = 1,104,638 SQ.FT.
EXIST BUILDINGS: 142,442 SQ.FT. (12.85%)
EXIST GREENSPACE: 725,128 SQ.FT. (65.84%)
EXIST PAVEMENT: 237,068 SQ.FT. (21.47%)

PROPOSED:
BUILDINGS: 20,379 SQ.FT.
PAVEMENT: 8,229 SQ.FT.

TOTAL:
BUILDINGS: 162,821 SQ.FT. (14.74%)
LANDSCAPING: 696,520 SQ.FT. (63.05%)
PAVEMENT: 245,297 SQ.FT. (22.21%)

13. BASIS OF BEARING:
SURVEY ADOPTED FROM THE RECORD PLAT OF "MELDON SPRINGS GARDENS" AS RECORDED IN PLAT BOOK 4 PAGE 179 OF THE ST. CHARLES COUNTY RECORDS.

14. FLOOD NOTE:
TO DETERMINE THE LOCATION OF FLOOD DESIGNATIONS AND BOUNDARIES, WE DETERMINED THE HORIZONTAL LOCATION OF THIS TRACT OF LAND BY SCALING THE FOLLOWING FLOOD INSURANCE RATE MAP (FIRM): ST. CHARLES COUNTY, MISSOURI AND INCORPORATED AREAS, MAP NUMBER 291830C410G, WITH AN EFFECTIVE DATE OF JANUARY 20, 2019.

COMMUNITY: CITY OF O'FALLON
NUMBER: 290316
PANEL: 0410
SUFFIX: 9

BY EXPRESS REFERENCE TO THIS MAP AND ITS LEGEND, THIS TRACT OF LAND IS INDICATED TO BE WITHIN ZONE X - AREAS DETERMINED TO BE OUTSIDE THE 0.2% ANNUAL CHANCE FLOODPLAIN.

THE EVALUATION PROVIDED IN THIS NOTE IS RESTRICTED TO SIMPLY INDICATING THE APPARENT HORIZONTAL LOCATION OF THE PROPERTY WITH RESPECT TO THE FEATURES DISPLAYED ON THE MAP. NO FIELD STUDY OF THE DRAINAGE CHARACTERISTICS TO WHICH THIS PROPERTY MAY BE SUBJECT TO HAS BEEN CONDUCTED AND NO REPRESENTATION CONCERNING THE INSURABILITY OF THIS PROPERTY OR THE POTENTIAL SUSCEPTIBILITY OF THIS PROPERTY TO FLOODING HAS BEEN MADE. BAX ENGINEERING MAKES NO REPRESENTATION CONCERNING THE ACCURACY OF THE ABOVE REFERENCED FIRM MAP WHICH INCLUDES A NOTE THAT "THIS MAP IS FOR USE IN ADMINISTERING THE NATIONAL FLOOD INSURANCE PROGRAM. IT DOES NOT NECESSARILY IDENTIFY ALL AREA SUBJECT TO FLOODING, PARTICULARLY FROM LOCAL DRAINAGE SOURCES OF SMALL SIZE."

THIS FLOOD ZONE DETERMINATION AND THE FLOOD ZONE LIMITS SHOWN HEREON, IF ANY, WERE MADE USING FEMA INFORMATION WHICH WAS AVAILABLE ON THE DATE THIS SURVEY WAS SIGNED AND SEALED.

14. REFERENCE BRIDGE/RAMP R#19 - ELEVATION 536.06 NAVD83 (USGS) DATUM
CHECKED SQUARE ON MINORWALL AT THE NORTHWEST CORNER OF COUNTY HIGHWAY DD BRIDGE OVER THE DARDEME CREEK

15. SITE BENCHMARK: ELEVATION 583.97
OLD CROSS ON CURB 422' NORTH OF AND 235.4' EAST OF THE NORTHWEST PROPERTY CORNER OF SUBJECT PROPERTY, AT THE NORTHEAST CORNER OF THE INTERSECTION OF FOX WOOD DRIVE AND FOX VALLEY DRIVE.

16. MISSOURI STATE HIGHWAY DD ESTABLISHED USING PLANS OBTAINED FROM MISSOURI DEPARTMENT OF TRANSPORTATION PROJECT NO. A-1-FAS-105-(A).

17. ALL NEW LIGHTING SHALL BE DOWNCAST LIGHTS CONSISTENT WITH CITY OF O'FALLON STANDARDS AND SPECIFICATIONS.

18. PER STATE STATUTES A SCHOOL DISTRICT IS ONLY OBLIGATED TO MEET LIFE SAFETY REGULATIONS, NOT LOCAL AESTHETIC ZONING REQUIREMENTS.

19. UNDERGROUND UTILITIES HAVE BEEN PLOTTED FROM AVAILABLE INFORMATION AND THEREFORE THEIR LOCATIONS SHALL BE CONSIDERED APPROXIMATE ONLY. THE VERIFICATION OF THE LOCATION OF ALL UNDERGROUND UTILITIES, EITHER SHOWN OR NOT SHOWN ON THESE PLANS SHALL BE THE RESPONSIBILITY OF THE CONTRACTOR, AND SHALL BE LOCATED PRIOR TO ANY GRADING OR CONSTRUCTION OF THE IMPROVEMENTS.

20. ALL NEW UTILITIES ARE TO BE LOCATED UNDERGROUND.

21. ANY OFFSITE GRADING OR UTILITY CONSTRUCTION WILL REQUIRE AN EASEMENT BEFORE CONSTRUCTION.

22. ALL SITE CONSTRUCTION SHALL COMPLY WITH CITY OF O'FALLON STANDARDS. ALL CONSTRUCTION WITHIN STATE RIGHT OF WAY SHALL COMPLY WITH MDDOT STANDARDS.

23. ALL NEW SIGNAGE FOR THIS FACILITY SHALL REQUIRE SEPARATE PERMIT APPROVAL.

24. NEW EASEMENTS WILL BE PROVIDED TO ALLOW FOR FUTURE EXTENSIONS OF THE MULTI-PURPOSE TRAIL BY ADJACENT LAND OWNERS.


25. PRIOR TO CONSTRUCTION PLAN APPROVAL, A PHOTOMETRIC LIGHTING PLAN IN ACCORDANCE WITH THE CITY'S LIGHTING STANDARDS SHALL BE SUBMITTED FOR REVIEW AND APPROVAL FOR ALL PROPOSED EXTERIOR LIGHTING.

26. PROPOSED RETAINING WALL WILL REQUIRE SEPARATE PERMIT. CONTRACTOR WHO IS AWARDED THE PROJECT SHALL SUBMIT WALL PLANS AND CALCULATIONS PER CITY CODES SIGNED AND SEALED BY MISSOURI REGISTERED PROFESSIONAL ENGINEER.

27. WATER DISTRICT WILL REQUIRE THAT ALL THE RELOCATED FACILITIES BE TESTED PER THE DISTRICT REQUIREMENTS BEFORE THEY ARE PUT BACK INTO SERVICE.

28. THE WATER DISTRICT REQUIRES ONE WEEK NOTICE BEFORE START OF CONSTRUCTION AND 48 HOURS NOTICE BEFORE THE TESTING IS PERFORMED.

29. THE INSPECTOR FOR THIS PROJECT WILL BE TERRY KOLAN AND HE CAN BE REACHED AT 314-575-2397.

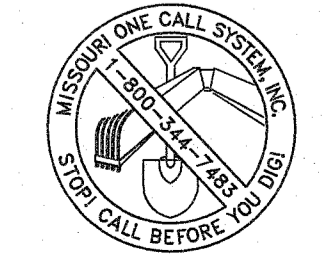

CALL BEFORE YOU DIG!
1-800-DIG-RITE

Bax Engineering Company, Inc.
Missouri State Certificate of Authority
Engineering #000605
Missouri State Certificate of Authority
Surveying #000144

WENTZVILLE, MISSOURI
GEOTECHNICAL

PSI, INC.
STRUCTURAL
MECH/ELEC/PLUMB
CIVIL/SURVEY

ADDITIONS AND RENOVATIONS AT
FRONTIER MIDDLE SCHOOL
AS-BUILT PLANS

CONSULTING ENGINEERS:
MCCLURE ENGINEERING
BAX ENGINEERING

WENTZVILLE R-IV SCHOOL DISTRICT
HOENER ASSOCIATES, INC. - ARCHITECTS
6707 PLANNING AVENUE
ST. LOUIS, MISSOURI 63109
Ph. (314) 781-9855 Fax (314) 781-0163




ALL DIMENSIONS MUST BE VERIFIED AT BUILDING BEFORE WORK IS EXECUTED. THIS DRAWING IS THE PROPERTY OF THE ARCHITECTS AND SHALL NOT BE COPIED OR DUPLICATED WITHOUT THEIR CONSENT.

proj. no. 19-06C
date issued
01/31/20
date revised
02/08/21
CITY COMMENT REVISIONS


drawn by GAW
checked by JNW
sheet no.

C-1

COVER
BAX PROJECT NO. 124591A

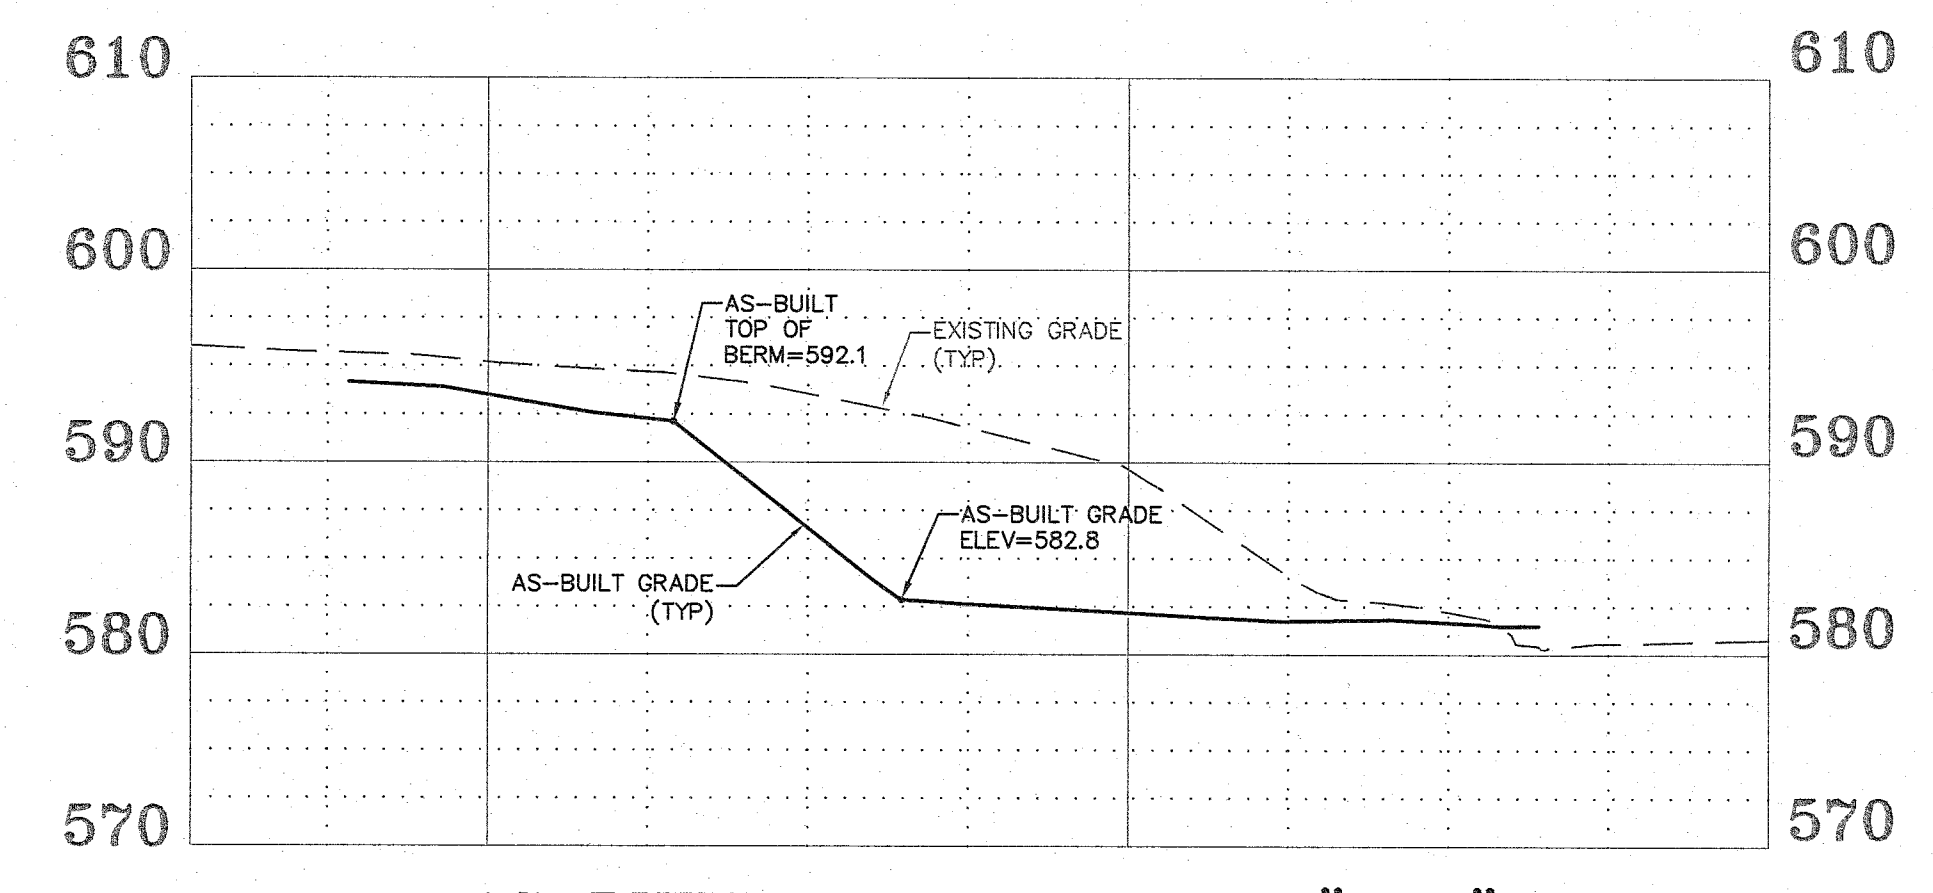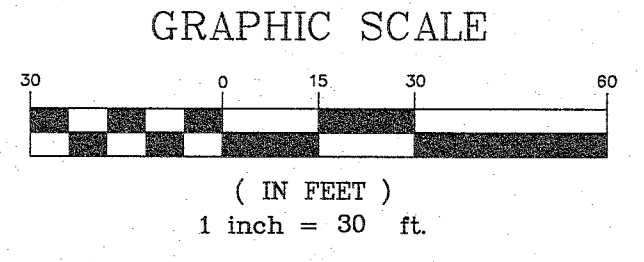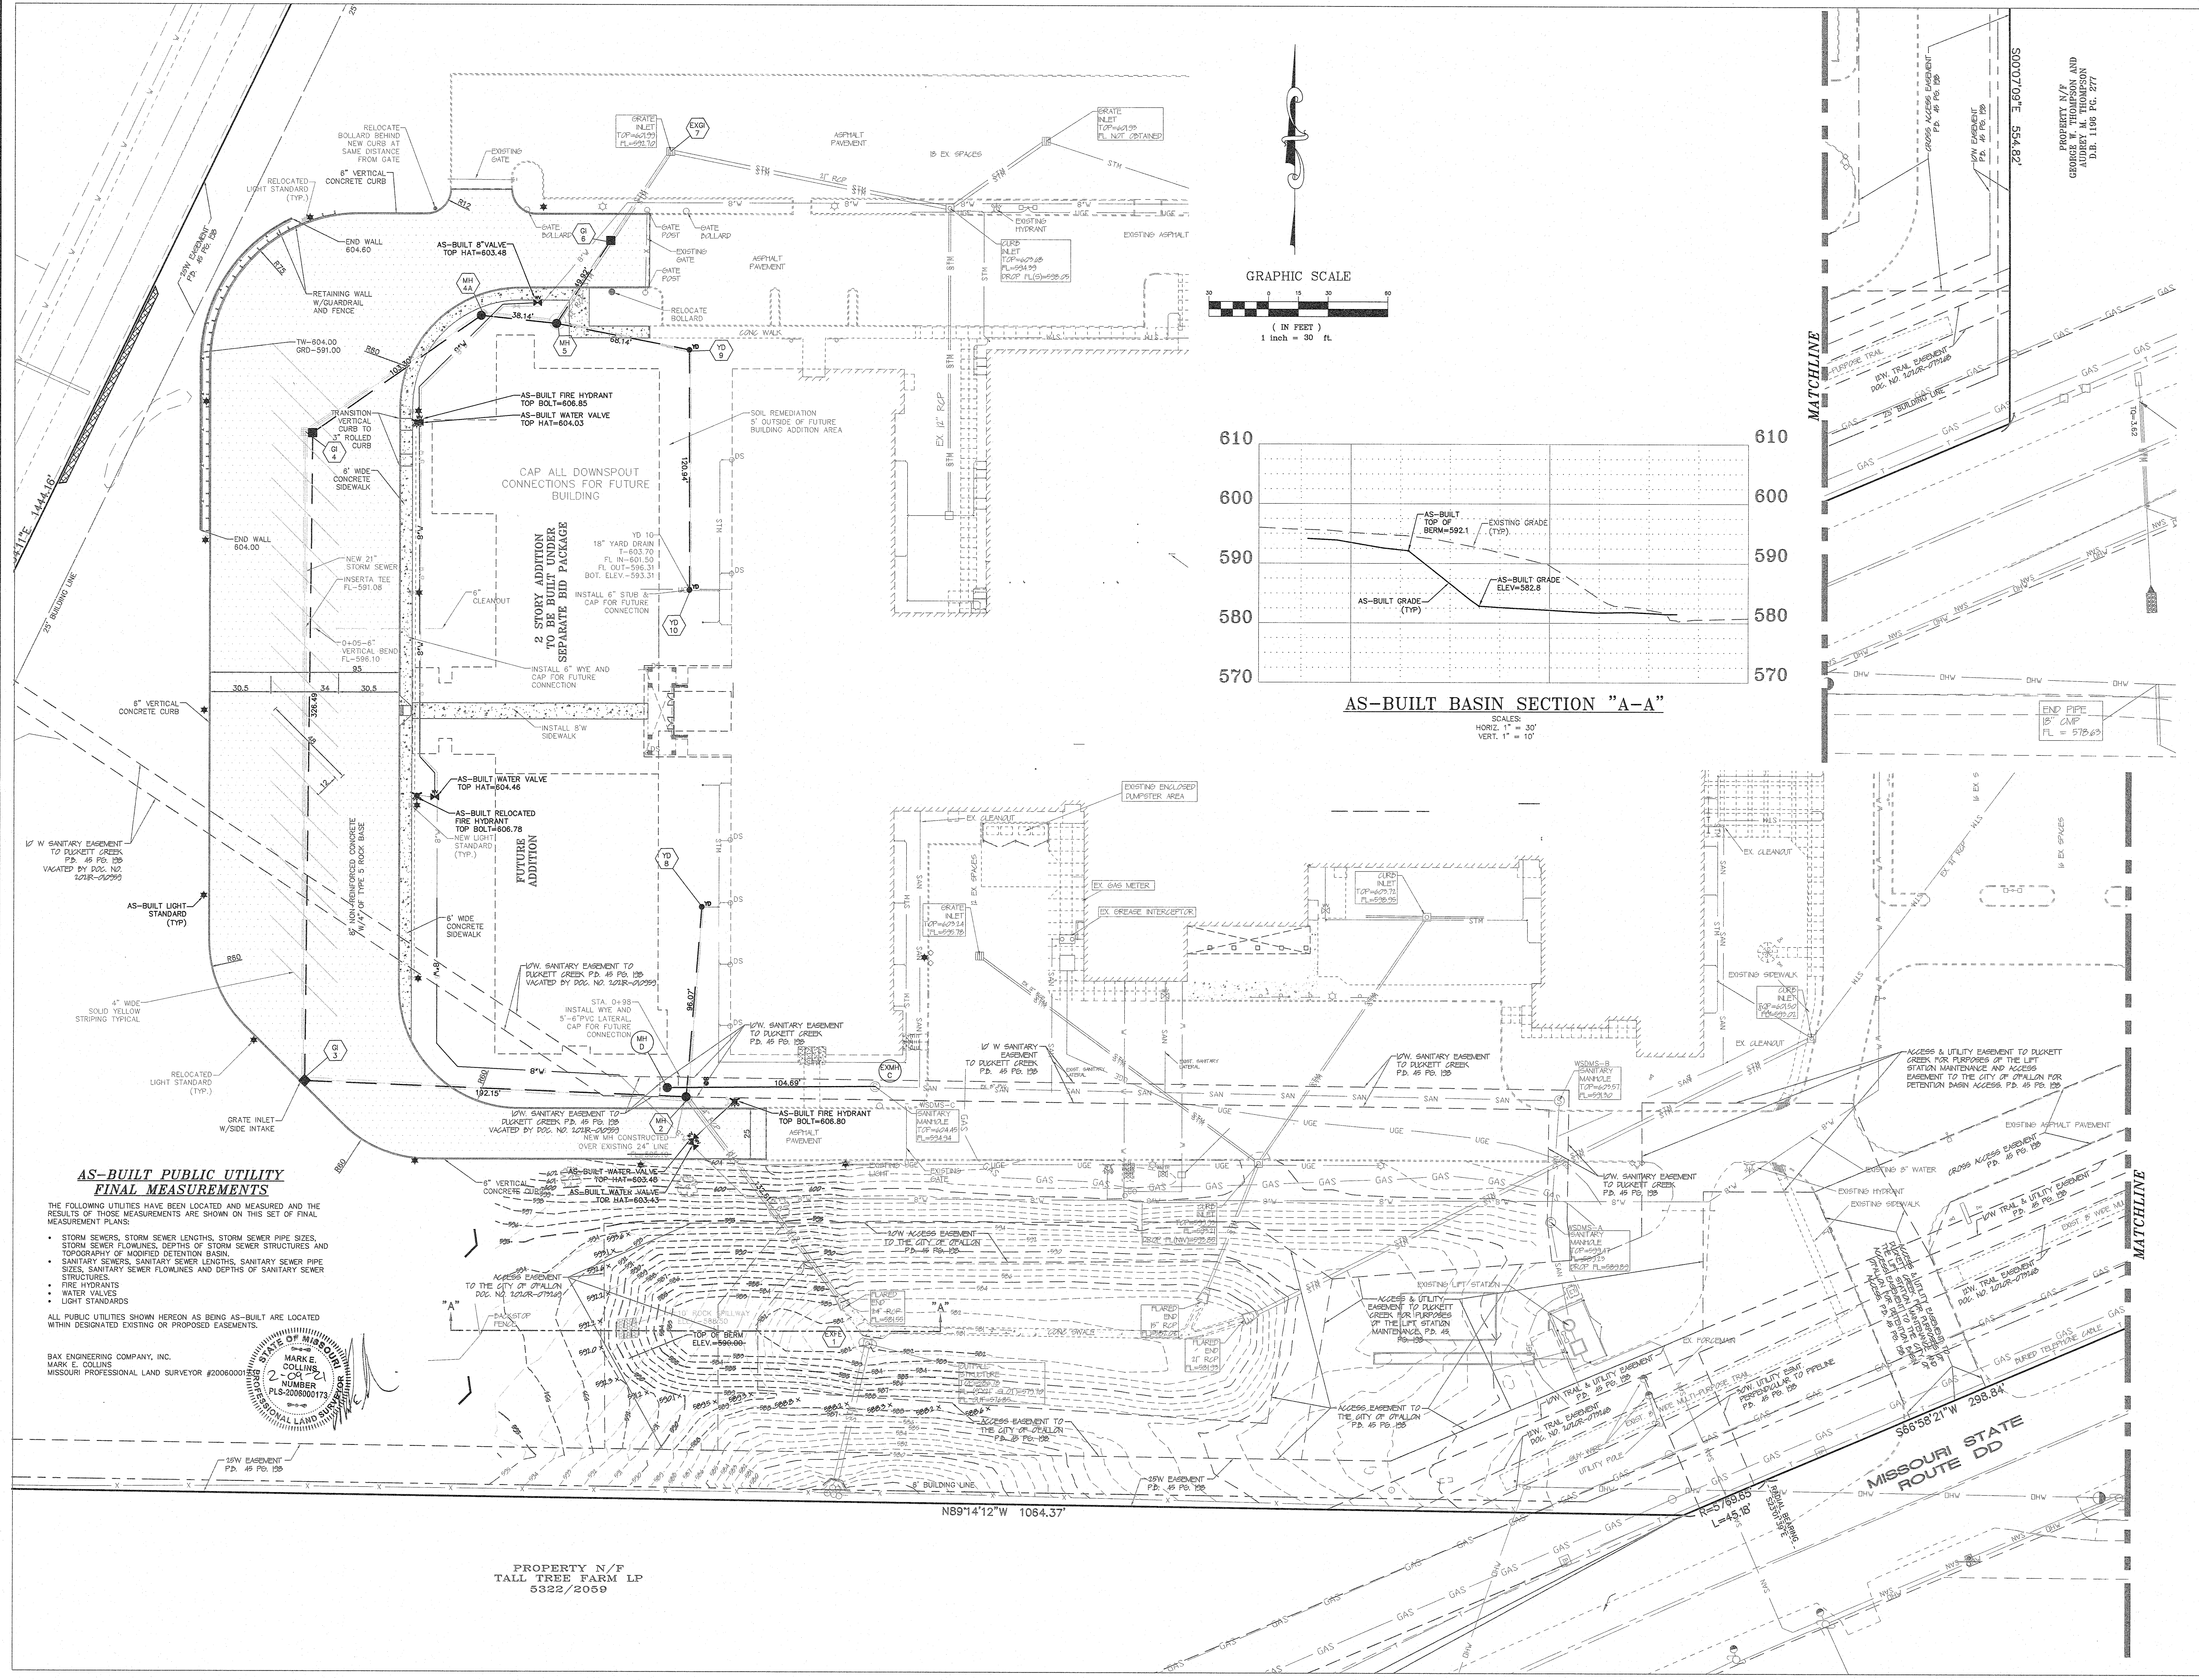

AS-BUILT BASIN SECTION "A-A"
 SCALES:
 HORIZ. 1" = 30'
 VERT. 1" = 10'

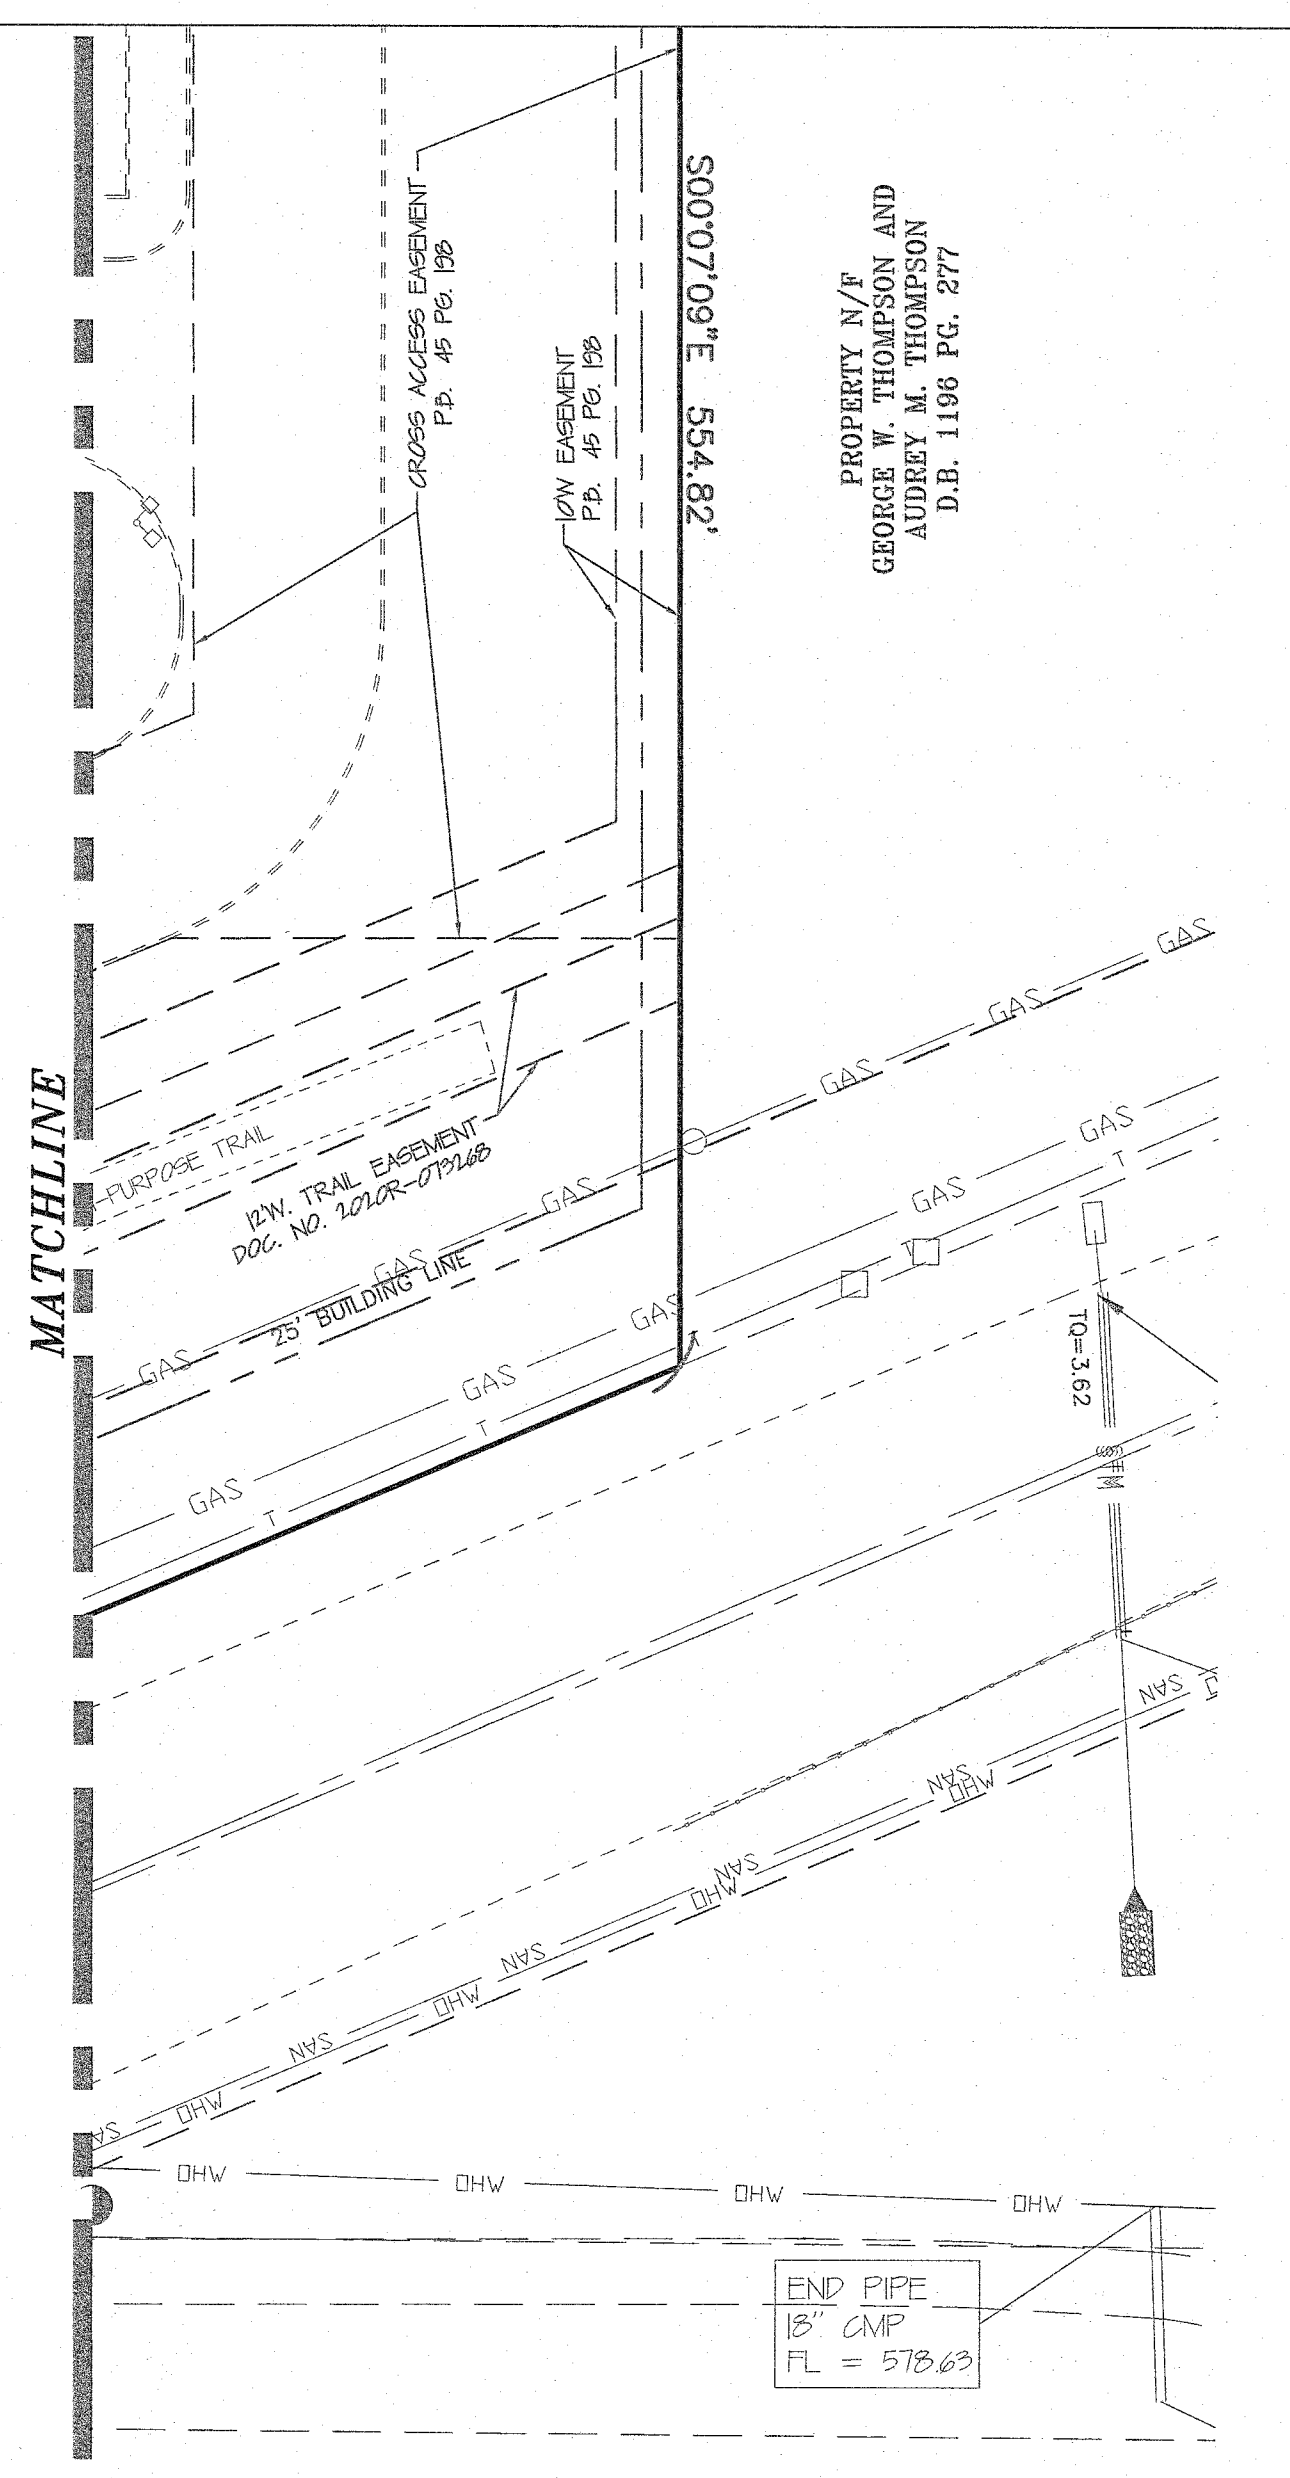


AS-BUILT PUBLIC UTILITY FINAL MEASUREMENTS

THE FOLLOWING UTILITIES HAVE BEEN LOCATED AND MEASURED AND THE RESULTS OF THOSE MEASUREMENTS ARE SHOWN ON THIS SET OF FINAL MEASUREMENT PLANS.

- STORM SEWERS, STORM SEWER LENGTHS, STORM SEWER PIPE SIZES, STORM SEWER FLOWLINES, DEPTHS OF STORM SEWER STRUCTURES AND TOPOGRAPHY OF MODIFIED DETENTION BASIN.
- SANITARY SEWERS, SANITARY SEWER LENGTHS, SANITARY SEWER PIPE SIZES, SANITARY SEWER FLOWLINES AND DEPTHS OF SANITARY SEWER STRUCTURES.
- FIRE HYDRANTS
- WATER VALVES
- LIGHT STANDARDS

ALL PUBLIC UTILITIES SHOWN HEREON AS BEING AS-BUILT ARE LOCATED WITHIN DESIGNATED EXISTING OR PROPOSED EASEMENTS.

BAX ENGINEERING COMPANY, INC.
 MARK E. COLLINS
 MISSOURI PROFESSIONAL LAND SURVEYOR #20060001

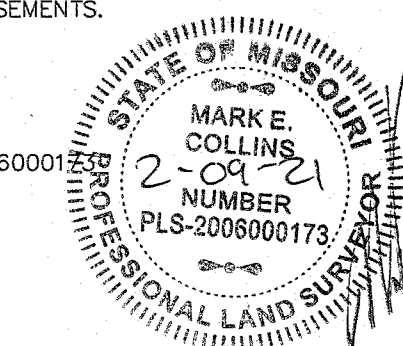

Box Engineering Company, Inc.
 Missouri State Certificate of Authority
 Engineering #00020
 Missouri State Certificate of Authority
 Surveying #00144

WENTZVILLE, MISSOURI

PSI, INC.
 STRUCTURAL
 MECH/ELEC/PLUMB
 CIVIL/SURVEY

ADDITIONS AND RENOVATIONS AT
FRONTIER MIDDLE SCHOOL
AS-BUILT PLANS

CONSULTING ENGINEERS:
 ASDG, LLC
 MCCLURE ENGINEERING
 BAX ENGINEERING

HOENER ASSOCIATES, INC. - ARCHITECTS
 6707 PLAINVIEW AVENUE
 ST. LOUIS, MISSOURI 63109
 Ph. (314) 781-9855 Fax (314) 781-0163

WENTZVILLE R-IV SCHOOL DISTRICT


ALL DIMENSIONS MUST BE VERIFIED AT BUILDING BEFORE WORK IS EXECUTED. THIS DRAWING IS THE PROPERTY OF THE ARCHITECTS AND SHALL NOT BE COPIED OR DUPLICATED WITHOUT THEIR CONSENT.

proj. no. 19-06C
 date issued
 01/31/20
 date revised
 02/08/21
 CITY COMMENT REVISIONS


drawn by GAW
 checked by JNW
 sheet no.

C4.0


SITE PLAN
 BAX PROJECT NO. 124951A

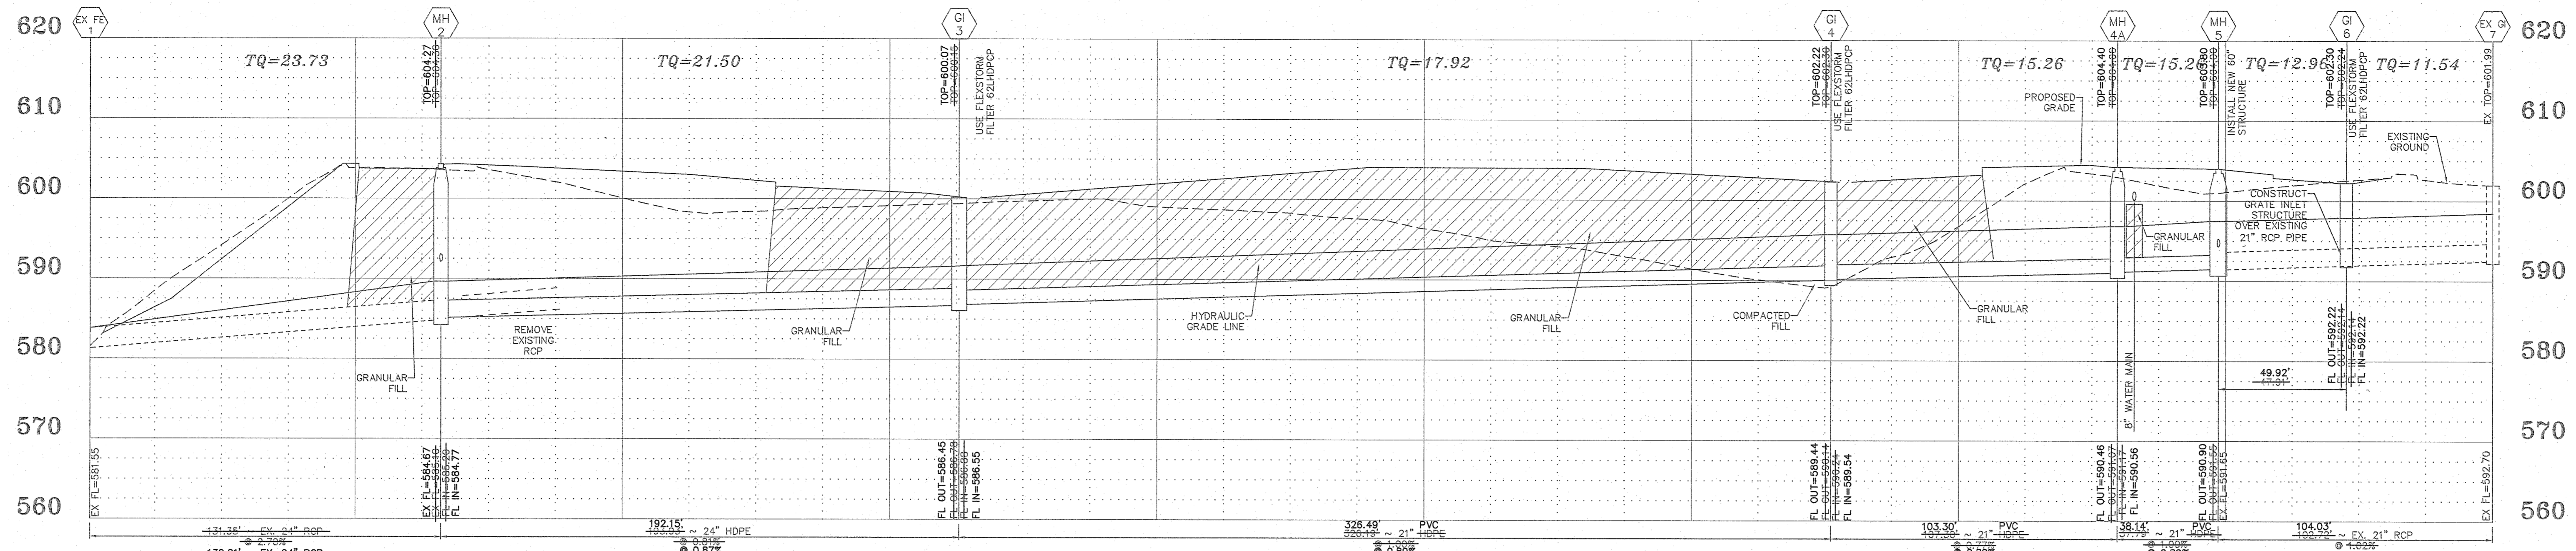


STORM SEWER PROFILE
 SCALES:
 HORIZ. 1" = 30'
 VERT. 1" = 10'

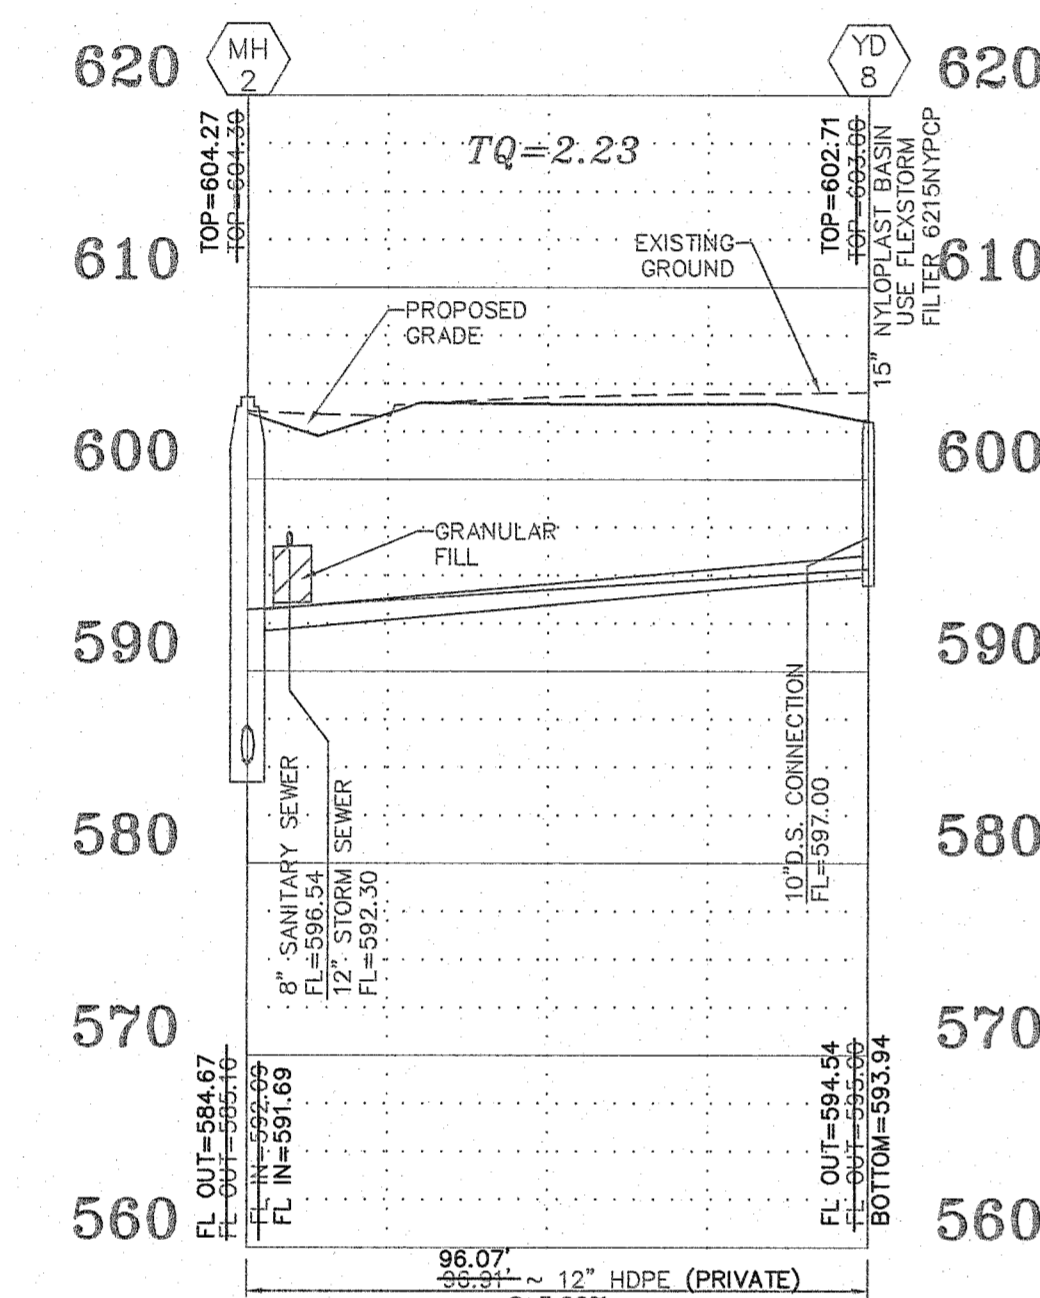

STORM SEWER PROFILE
 SCALES:
 HORIZ. 1" = 30'
 VERT. 1" = 10'

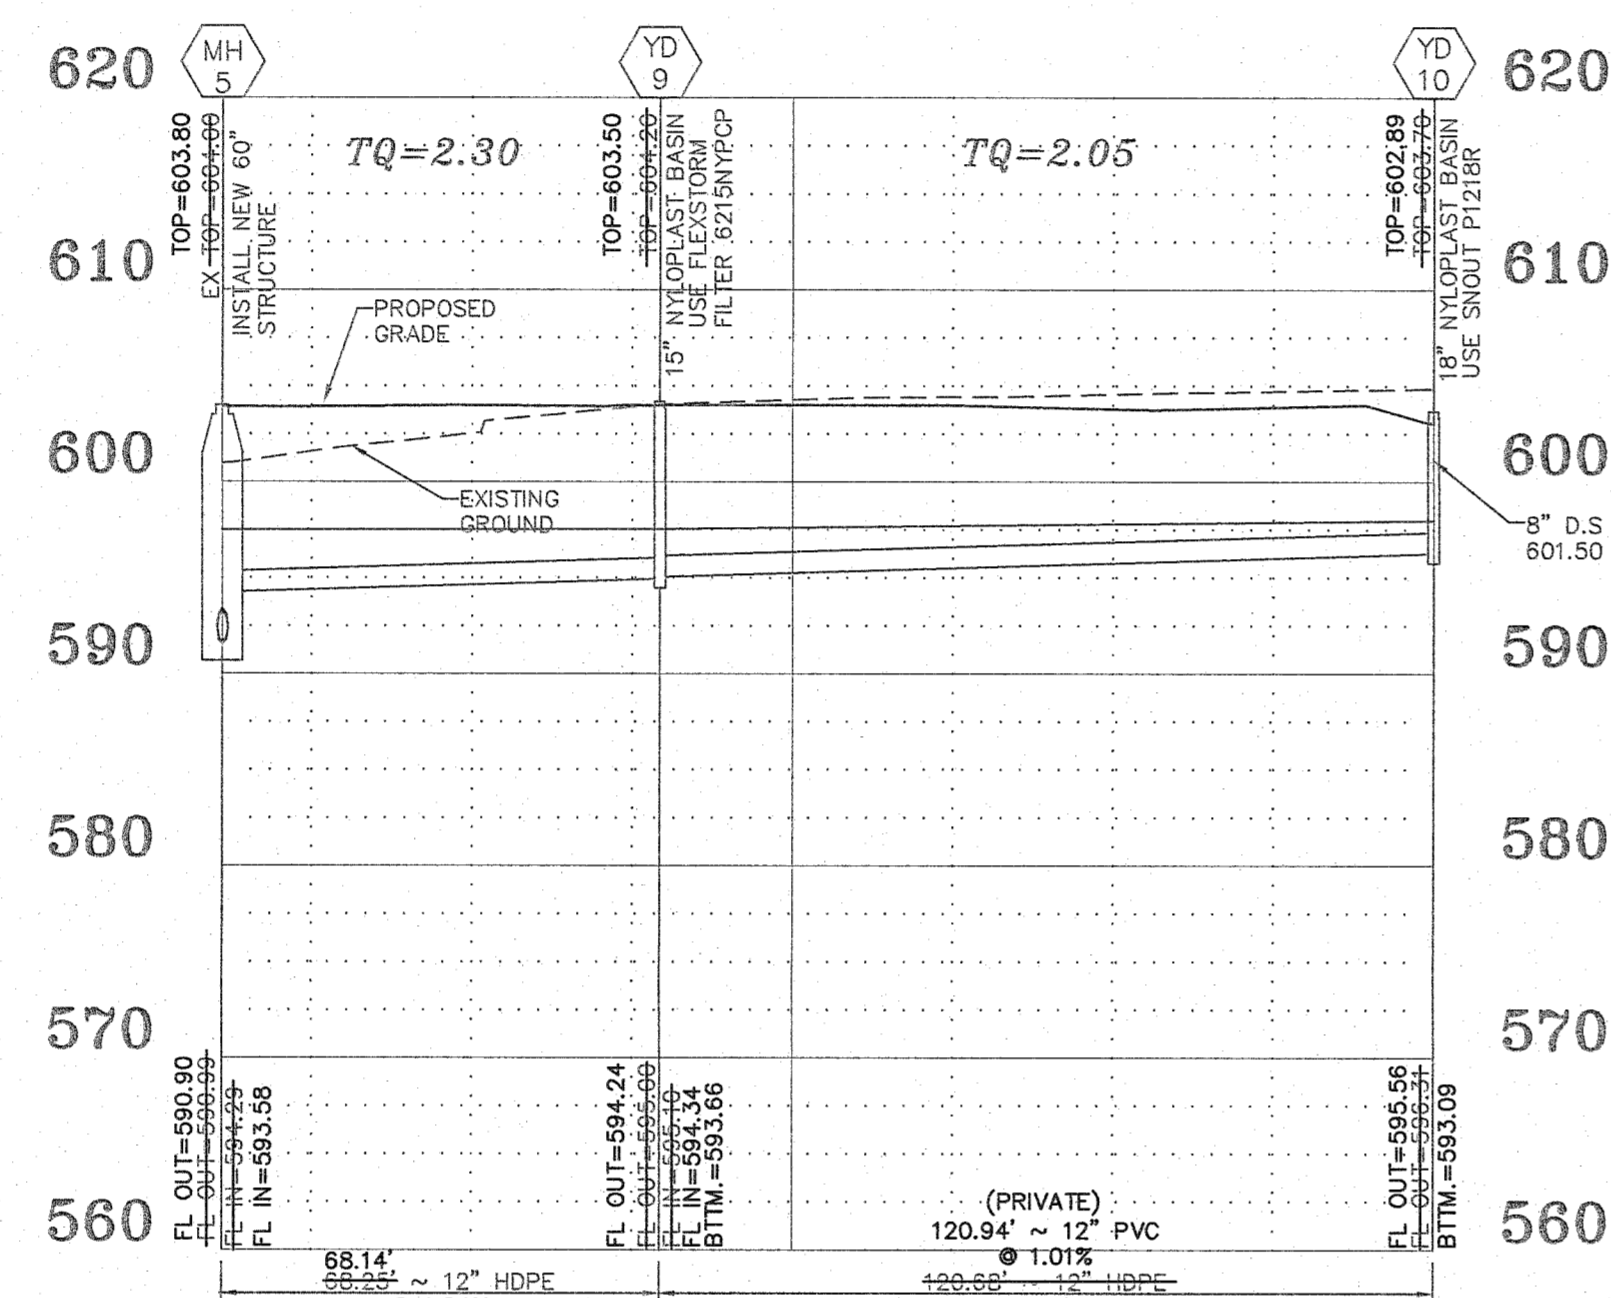

STORM SEWER PROFILE
 SCALES:
 HORIZ. 1" = 30'
 VERT. 1" = 10'

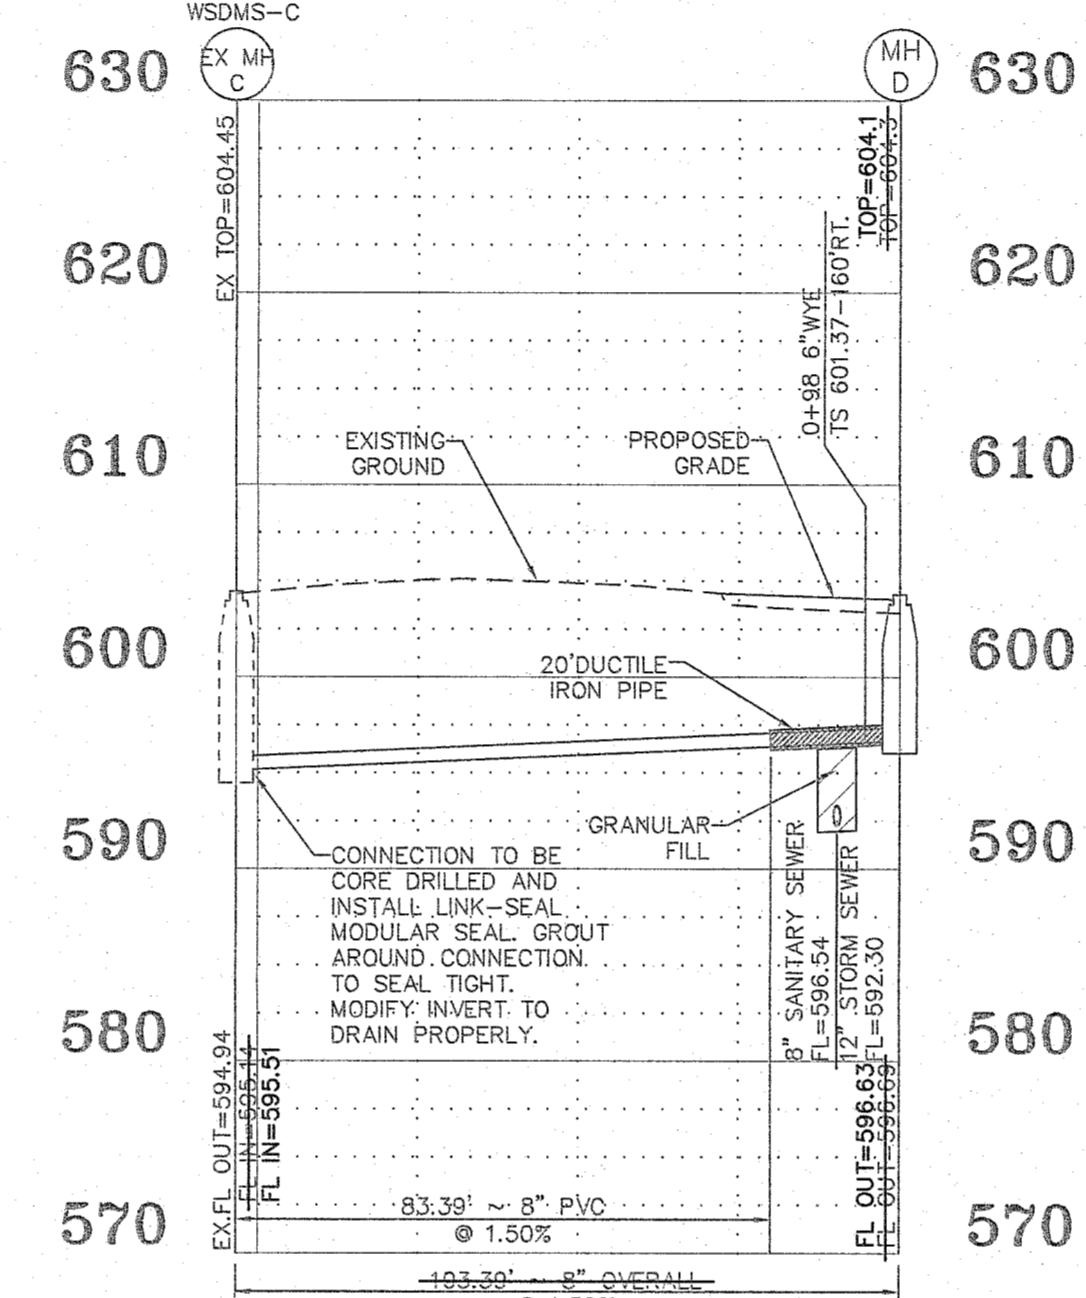


SANITARY SEWER PROFILE
 SCALES:
 HORIZ. 1" = 30'
 VERT. 1" = 10'


DUCKETT CREEK SANITARY DISTRICT NOTES:
 1. EXISTING SANITARY SEWER SERVICE SHALL NOT BE INTERRUPTED.
 2. CONSTRUCTION OF SANITARY MAINS TO BE DEDICATED TO DCSD REQUIRE DCSD INSPECTION. CONTACT THE DCSD INSPECTION DEPARTMENT AT 636-441-1244 TO SCHEDULE INSPECTION. 48 HOUR ADVANCE NOTICE IS REQUIRED.

NOTE:
 1. FOR SEWERS WITH A DESIGN GRADE OF LESS THAN ONE(1) PERCENT, FIELD VERIFICATION OF THE SEWER GRADE WILL BE REQUIRED FOR EACH INSTALLED REACH PRIOR TO ANY SURFACE RESTORATION OR INSTALLATION OF ANY SURFACE IMPROVEMENTS.
 2. ALL STORM SEWERS TO BE PRIVATE.


The Existing Overflow Structure is a Standard Double Untrapped Street Inlet Precast Concrete (without top). See U.S.D. Detail 37. Existing 9" x 21" H Low Flow Orifice to be modified to 9" x 22" H Low Flow Orifice with a flowline of 579.70'. An Upper Flow Orifice of 16" W x 15" H with a flowline of 584.50' will also be implemented. The top of the structure will have an elevation of 586.78'. (See Detention Calculations)

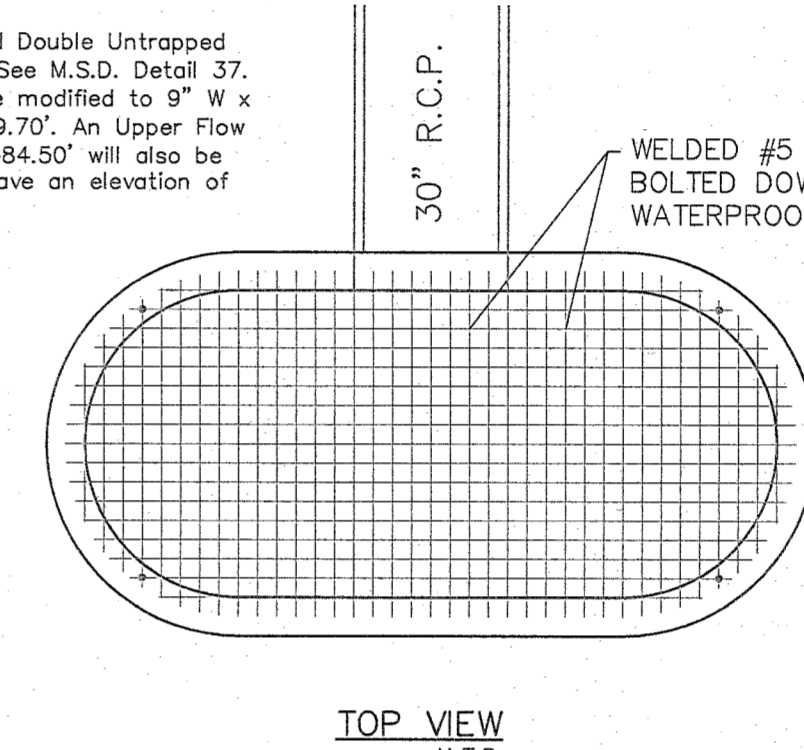

TOP VIEW
N.T.S.

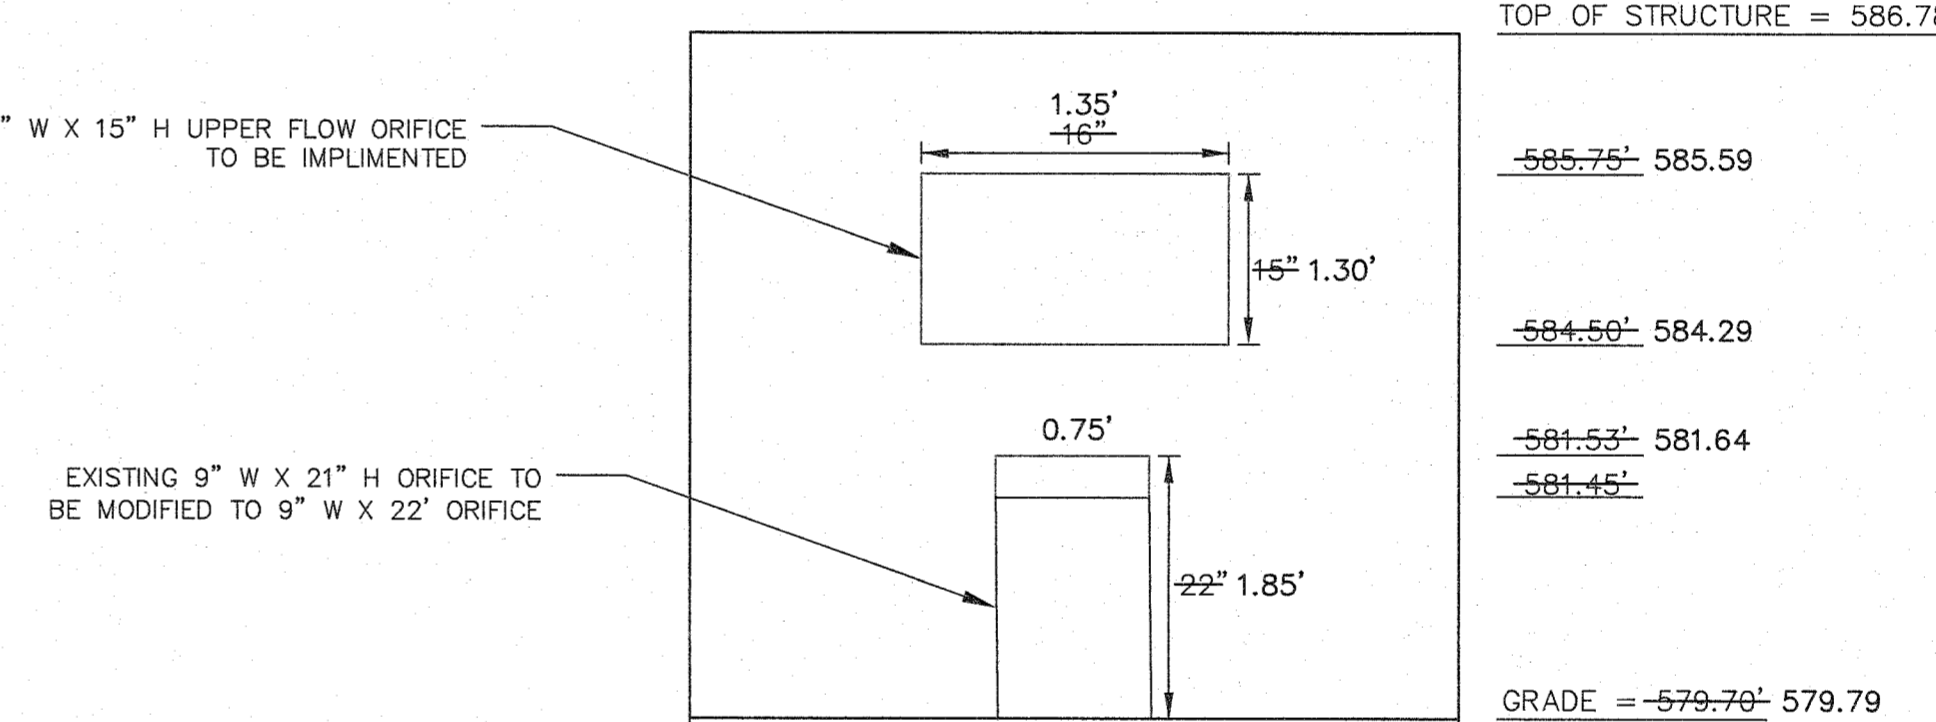

EXISTING DRY DETENTION BASIN OVERFLOW STRUCTURE
N.T.S.

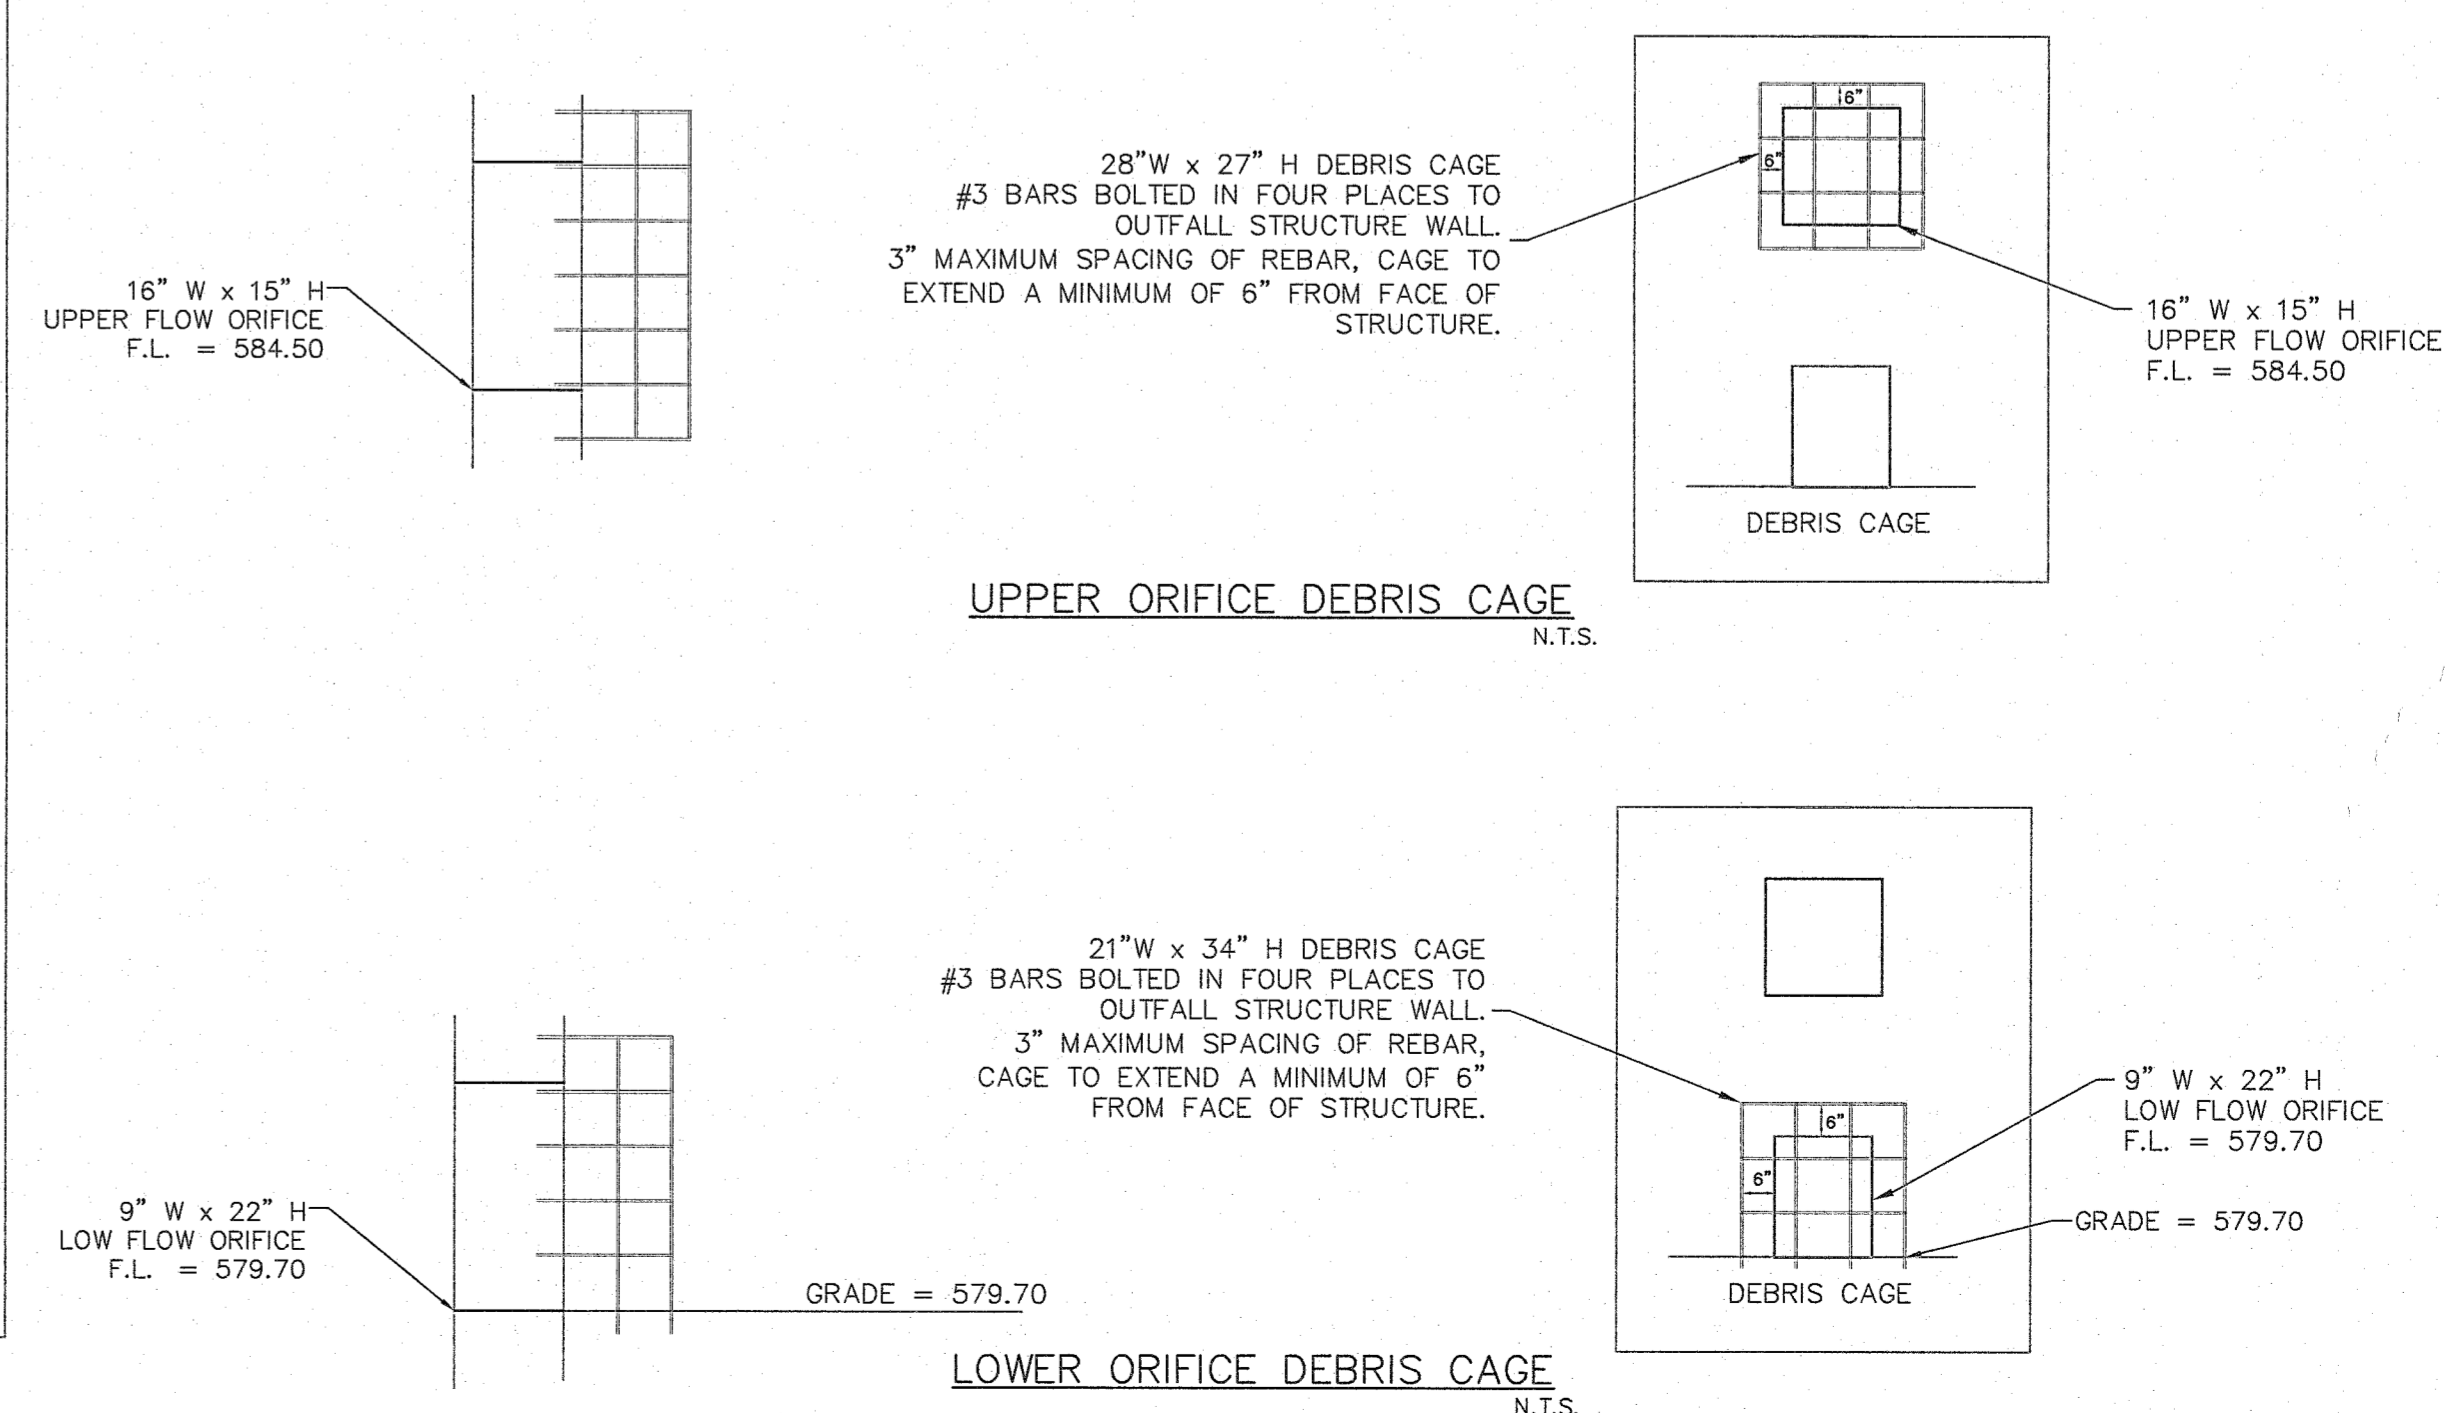



UPPER ORIFICE DEBRIS CAGE
N.T.S.

LOWER ORIFICE DEBRIS CAGE
N.T.S.

AS-BUILT PUBLIC UTILITY FINAL MEASUREMENTS


THE FOLLOWING UTILITIES HAVE BEEN LOCATED AND MEASURED AND THE RESULTS OF THOSE MEASUREMENTS ARE SHOWN ON THIS SET OF FINAL MEASUREMENT PLANS:
 • STORM SEWERS, STORM SEWER LENGTHS, STORM SEWER PIPE SIZES, STORM SEWER FLOWLINES, DEPTHS OF STORM SEWER STRUCTURES AND TOPOGRAPHY OF MODIFIED DETENTION BASIN.
 • SANITARY SEWERS, SANITARY SEWER LENGTHS, SANITARY SEWER PIPE SIZES, SANITARY SEWER FLOWLINES AND DEPTHS OF SANITARY SEWER STRUCTURES.
 • FIRE HYDRANTS
 • WATER VALVES
 • LIGHT STANDARDS
 ALL PUBLIC UTILITIES SHOWN HEREON AS BEING AS-BUILT ARE LOCATED WITHIN DESIGNATED EXISTING OR PROPOSED EASEMENTS.

BAX ENGINEERING COMPANY, INC.
 MARK E. COLLINS
 MISSOURI PROFESSIONAL LAND SURVEYOR #2008000173

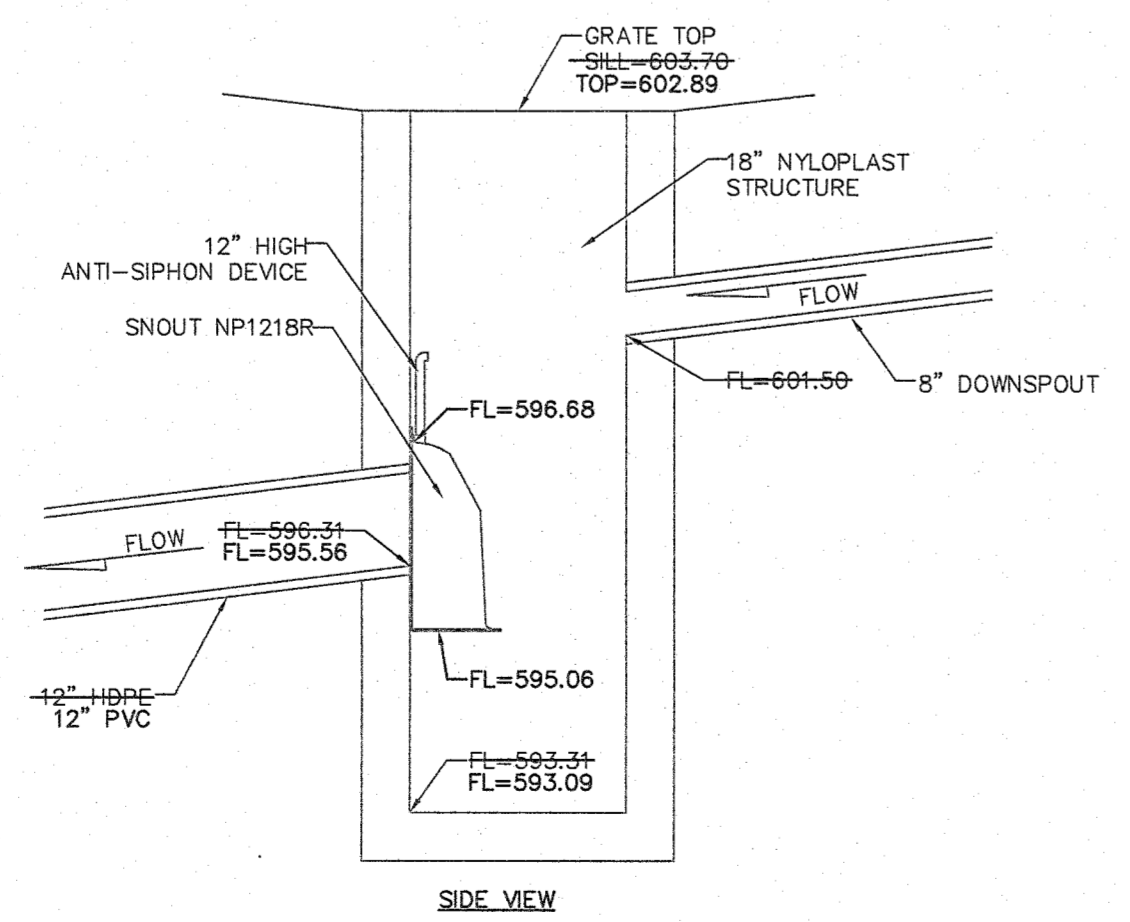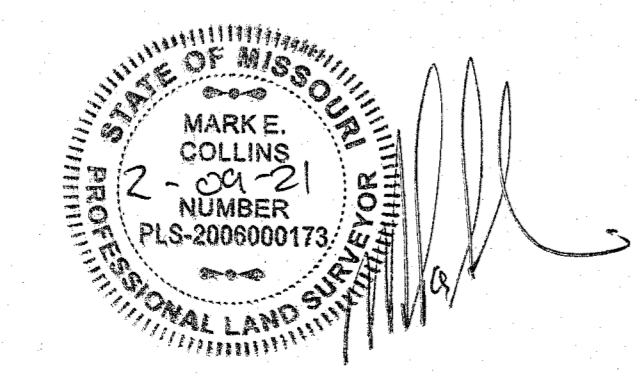

SNOUT DETAIL YD 10
NOT TO SCALE

Snout Maintenance Recommendations:
 1) Monthly monitoring for the first year of a new installation after the site has been stabilized is a recommended practice.
 2) Measurements should be taken after each rain event of 0.5 inches or more, or monthly, as determined by local weather conditions.
 3) Checking sediment depth and noting the surface pollutants in the structure will be helpful in planning maintenance.
 4) The pollutants collected in SNOUT equipped structures will consist of floatable debris and oils on the surface of the captured water, and grit and sediment on the bottom of the structure.
 5) It is best to schedule maintenance based on the solids collected in the sump.
 6) Optimally, the structure should be cleaned when the sump is half full (e.g. when 2 feet of material collects in a 4 foot sump, clean it out).
 7) Structures should also be cleaned if a spill or other incident causes a larger than normal accumulation of pollutants in a structure.
 8) Maintenance is best done with a vacuum truck.
 9) If Bio-Skirts are being used in the structure to enhance hydrocarbon capture, they should be checked on a monthly basis for the first year, and serviced or replaced when more than 2/3 of the boom is submerged, indicating a nearly saturated state. Assuming a typical pollutant-loading environment exists, Bio-Skirts should be serviced annually or replaced as necessary.
 10) In the case of an oil spill, the structure should be checked and serviced and Bio-Skirts (if present) replaced or serviced immediately.
 11) All collected wastes must be handled and disposed of according to local environmental requirements.
 12) To maintain the SNOUT hoods, an annual inspection of the anti-siphon vent and access hatch are recommended. A simple flushing of the vent, or a gentle rodding with a flexible wire are all that's typically needed to maintain the anti-siphon properties. Opening and closing the access hatch once a year ensures a lifetime of trouble-free service.

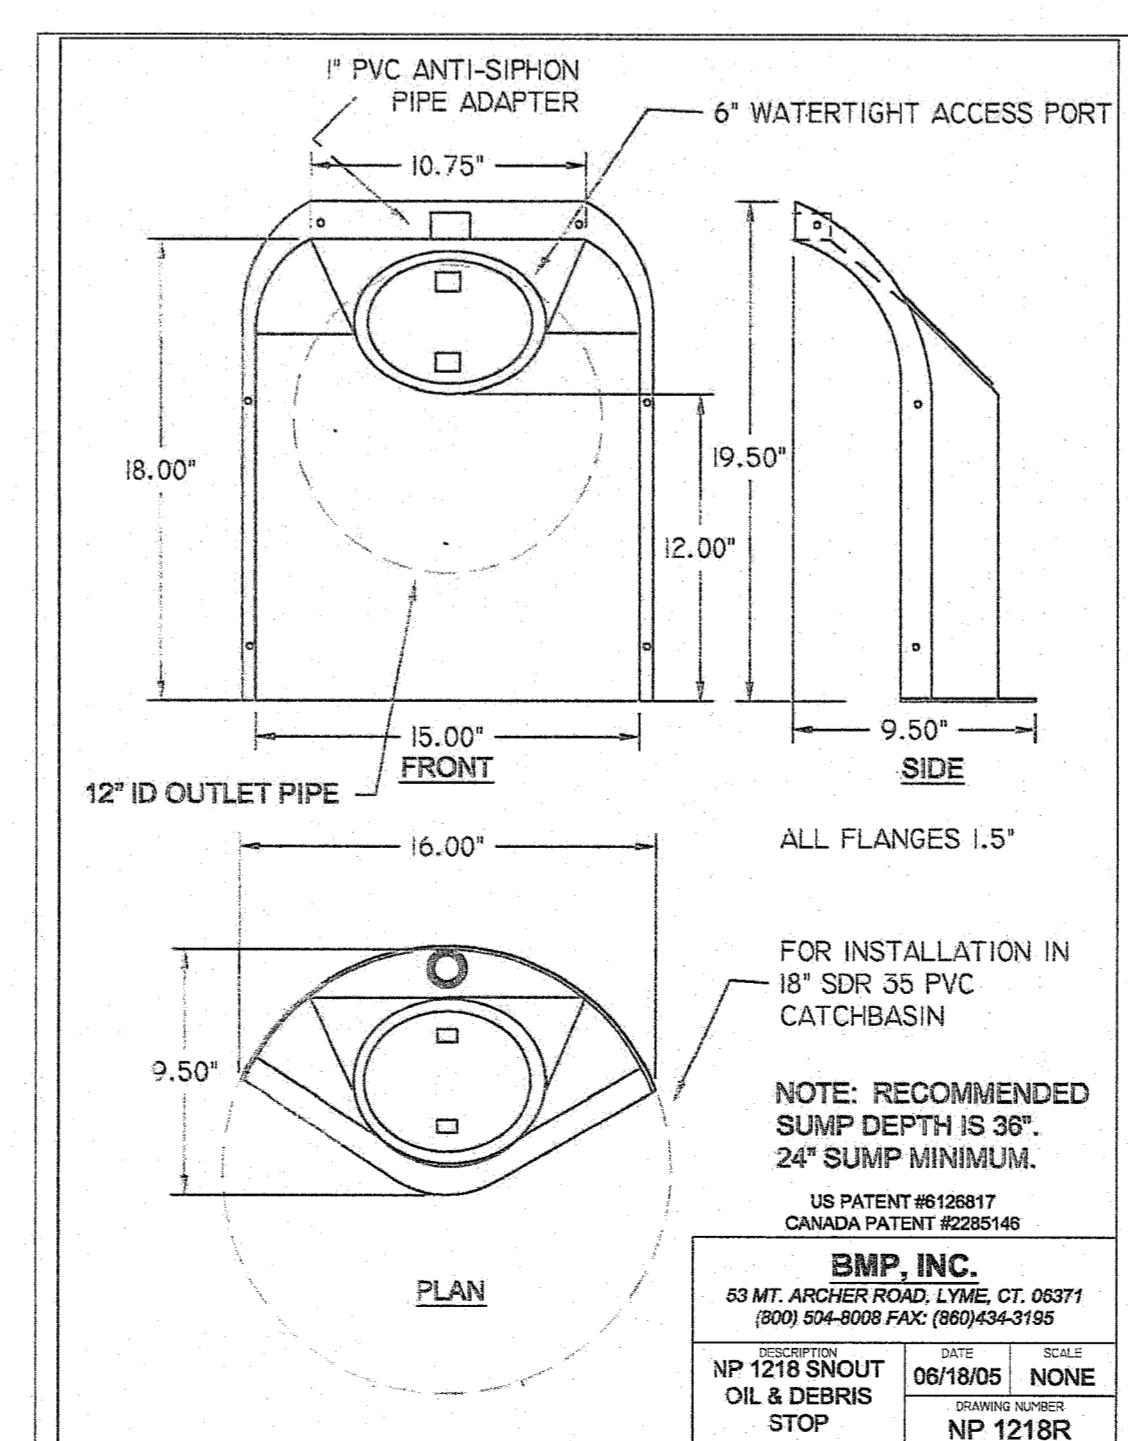

BMP, INC.
 63 MT. ANCHER ROAD, LYMAE, CT. 06277
 203-584-6000 FAX: 203-584-6100
 NP 1218 SNOUT OIL & DEBRIS STOP
 DATE: 08/18/05
 DRAWN BY: NONE
 CHECKED BY: NP 1218R

Bax Engineering Company, Inc.
 Missouri State Certificate of Authority
 Engineering #000655
 Missouri State Certificate of Authority
 Surveying #00144

WENTZVILLE, MISSOURI
 GEOTECHNICAL

PSI, INC.

ADDITIONS AND RENOVATIONS AT
FRONTIER MIDDLE SCHOOL
 AS-BUILT PLANS
 CONSULTING ENGINEERS:
 STRUCTURAL
 MECH/ELEC/PLUMB
 CIVIL/SURVEY

WENTZVILLE R-V SCHOOL DISTRICT
HOENER ASSOCIATES, INC. - ARCHITECTS
 6707 PLAINVIEW AVENUE
 ST. LOUIS, MISSOURI 63109
 Ph. (314) 781-9855 Fax. (314) 781-0163


ALL DIMENSIONS MUST BE VERIFIED AT BUILDING BEFORE WORK IS EXECUTED. THIS DRAWING IS THE PROPERTY OF THE ARCHITECTS AND SHALL NOT BE COPIED OR DUPLICATED WITHOUT THEIR CONSENT.

proj. no. 19-06C
 date issued
 01/31/20


date revised
 02/08/21
 CITY COMMENT REVISIONS

drawn by GAW
 checked by JNW
 sheet no.


C9.0

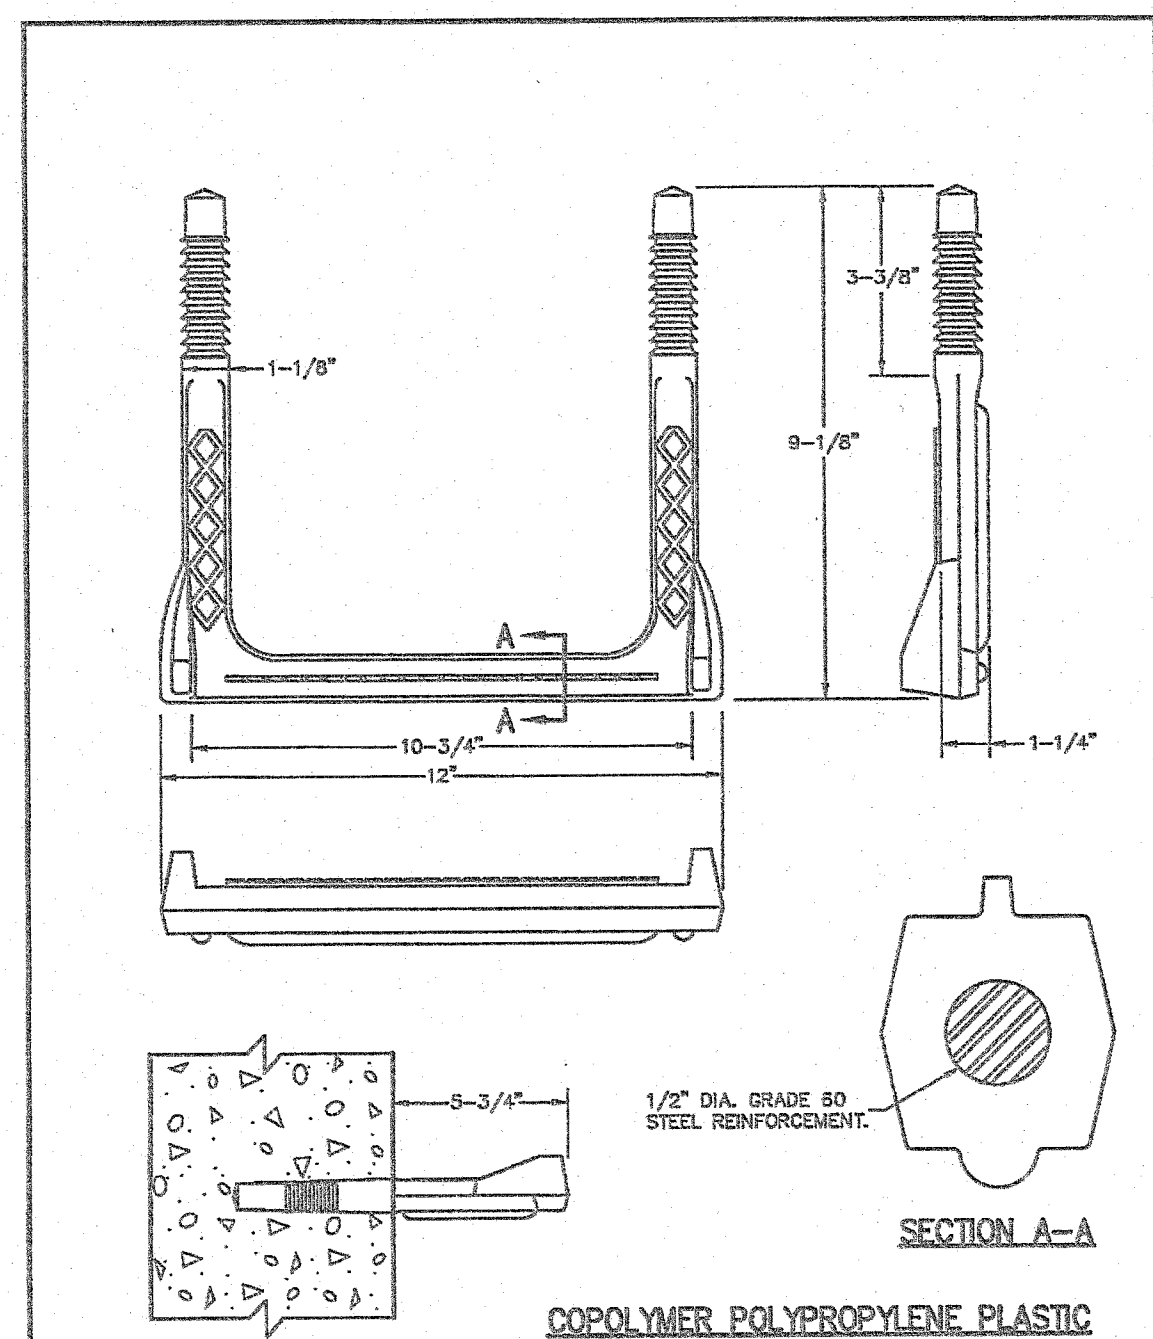


MANHOLE STEP FOR PRECAST & CAST-IN-PLACE MANHOLE
 METROPOLITAN ST. LOUIS SEWER DISTRICT
 Standard Details of Sewer Construction
 Dr. D.A.B. Ch. J.C.K. 2009 SHEET 58

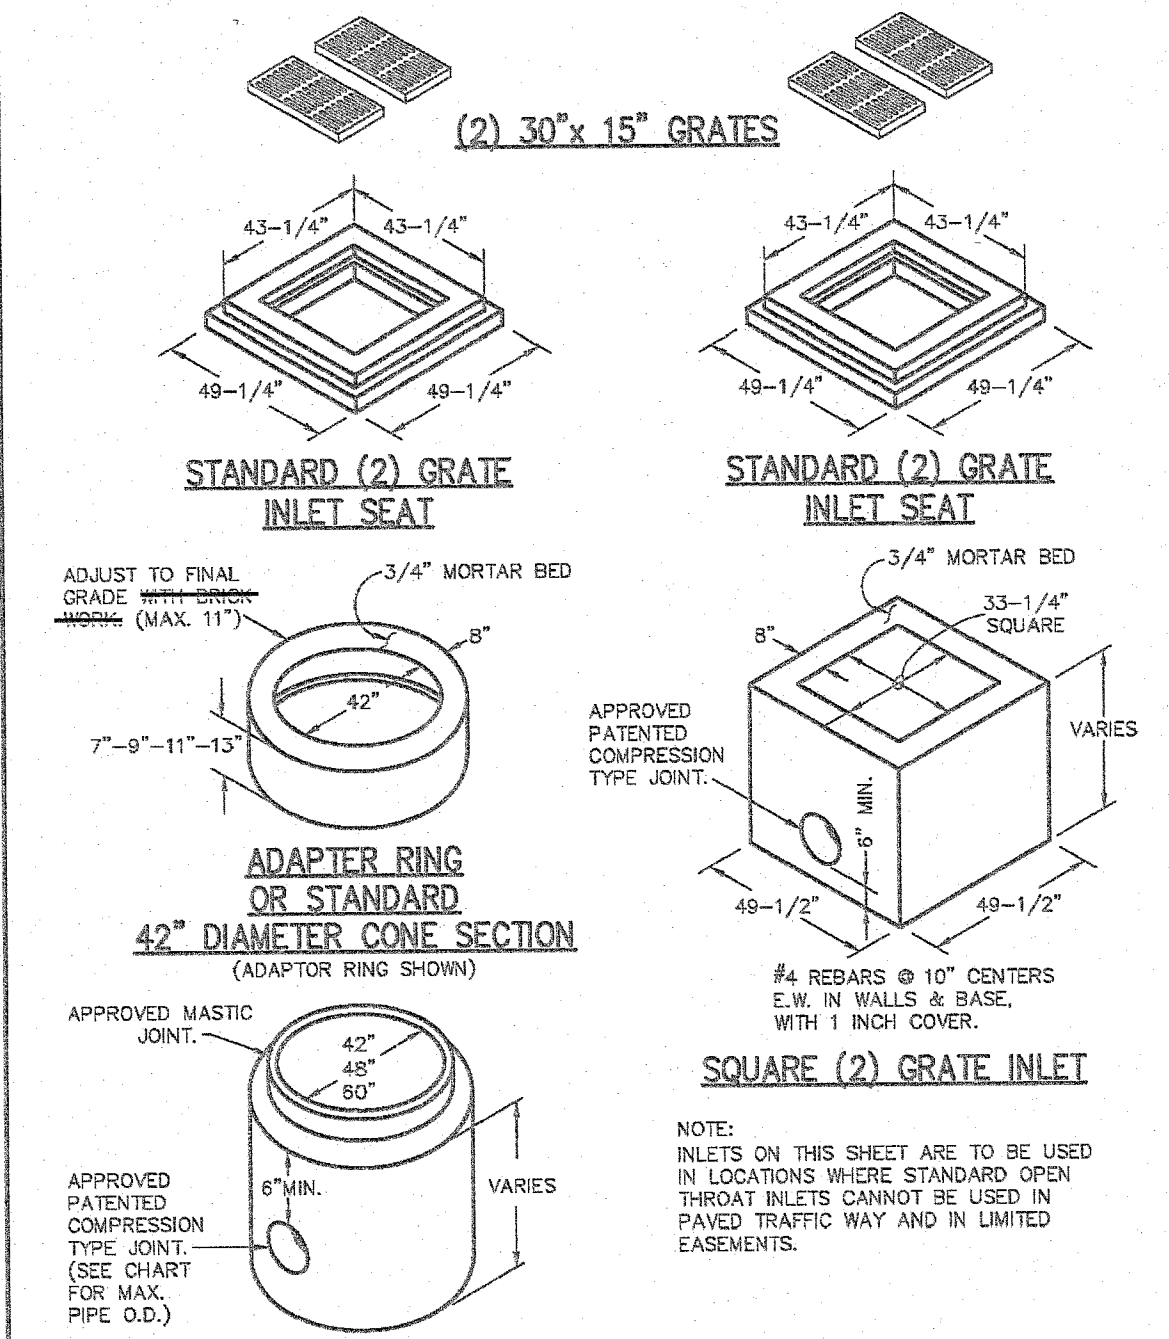


(2) 30" x 15" GRATES
 STANDARD (2) GRATE INLET SEAT
 ADAPTER RING OR STANDARD 42" DIAMETER CONCRETE SECTION
 SQUARE (2) GRATE INLET
 METROPOLITAN ST. LOUIS SEWER DISTRICT
 Standard Details of Sewer Construction
 Dr. J.S./SAM Ch. J.C.K. 2009 SHEET 35

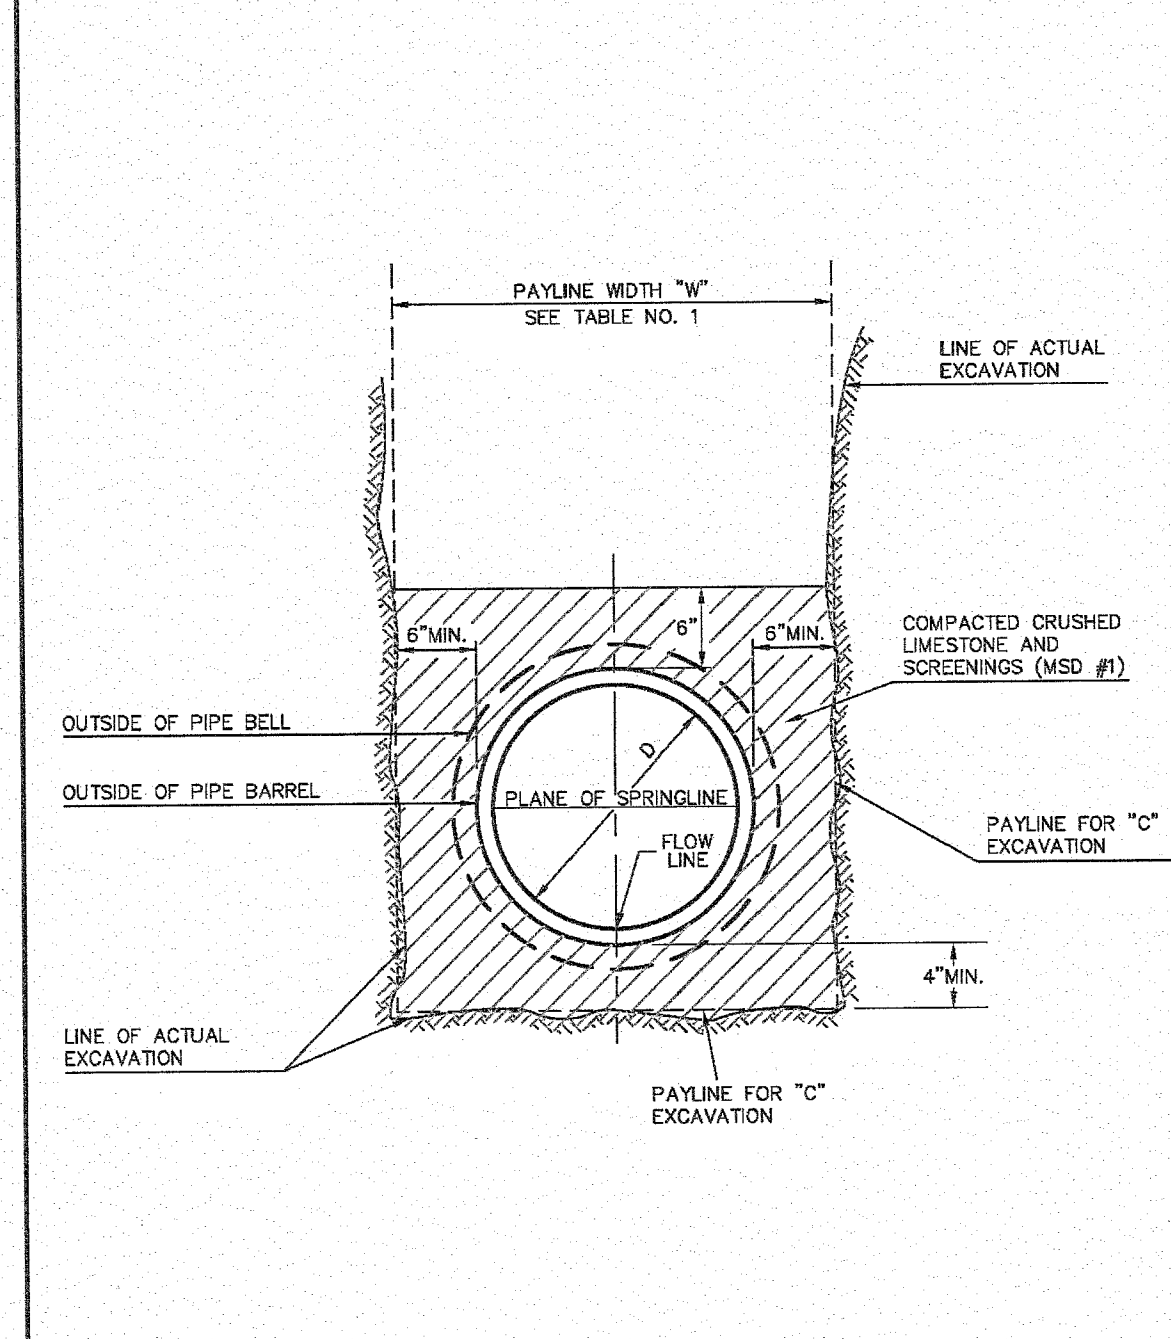

PIPE BEDDING CLASS "C" (FOR ALL 6" TO 18" PIPE EXCEPT REINFORCED CONCRETE PIPE)
 METROPOLITAN ST. LOUIS SEWER DISTRICT
 Standard Details of Sewer Construction
 Dr. W.S.H. Ch. J.C.K. 2009 SHEET 4

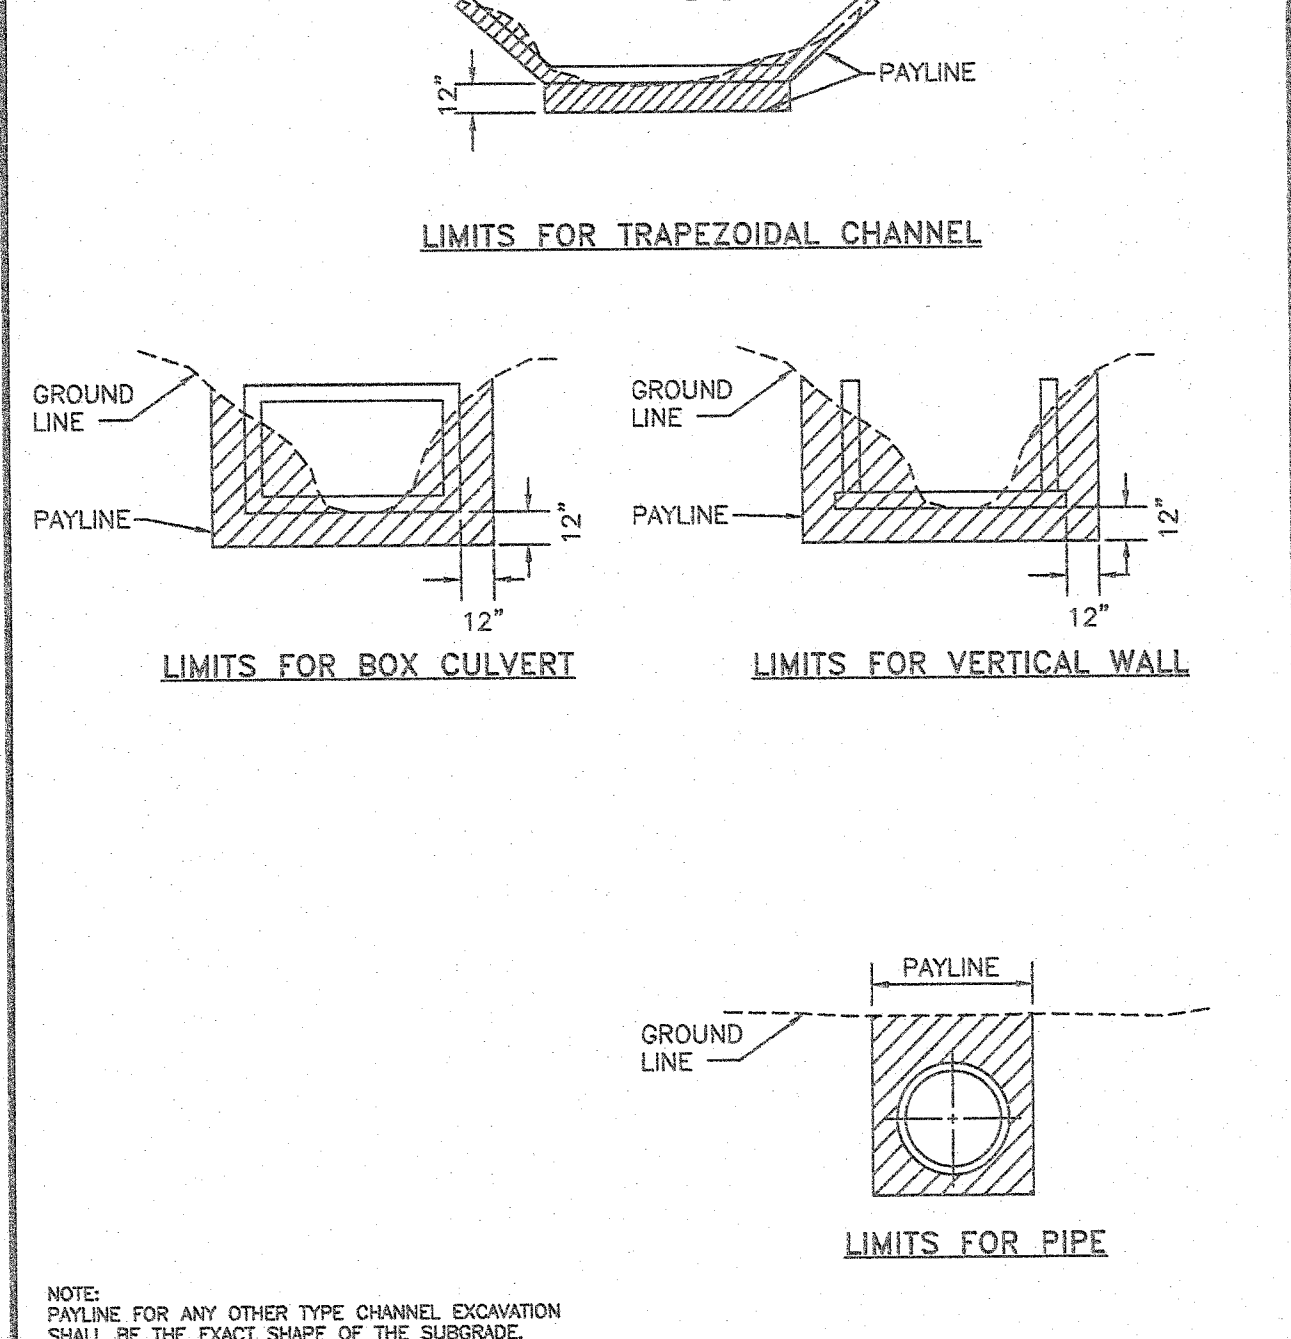

Duckett Creek Sanitary District
 PAYLINE LIMITS FOR EXCAVATION
 Dr. BSM App By: KLA
 Date: MBOB Date: DEC. 2015
 SHEET NO. 2

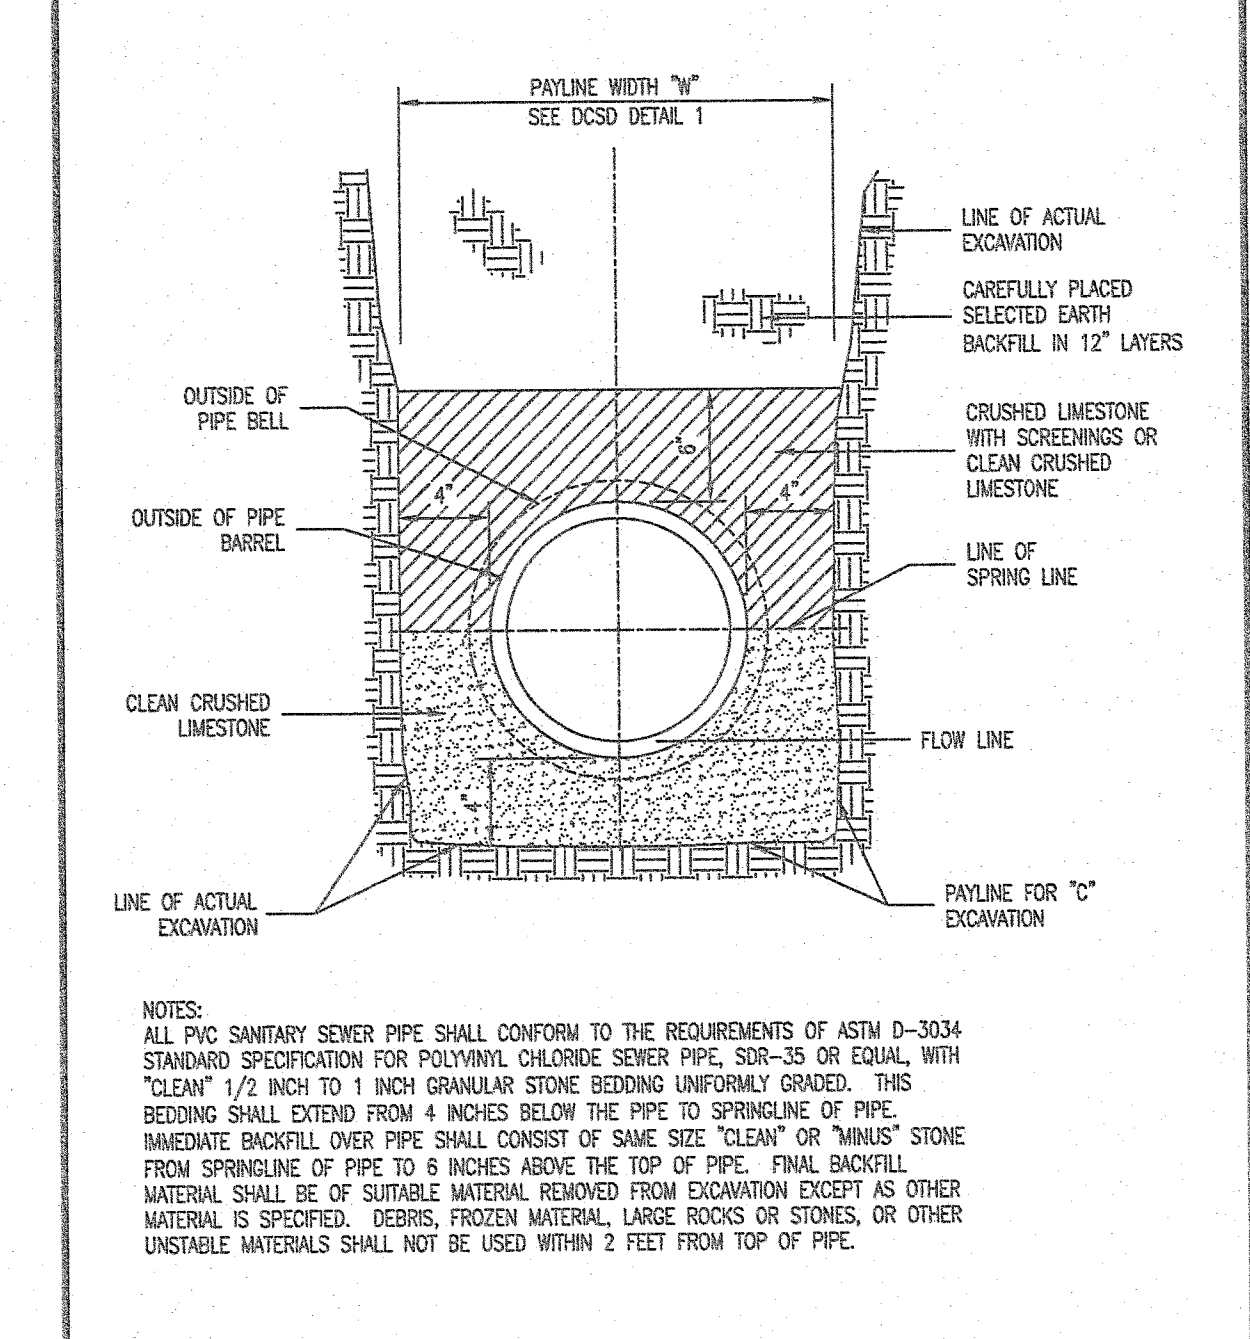

Duckett Creek Sanitary District
 PIPE BEDDING CLASS "C" FOR EXCAVATION
 Dr. BSM App By: KLA
 Date: MBOB Date: DEC. 2015
 SHEET NO. 3

Installation Techniques - Link-Seal® Modular Seals
 Online Installation Video Visit www.linkseal.com

1. Center the pipe, cable or conduit in well opening or manhole. Make sure the pipe will be adequately supported on both ends. Link-Seal® modular seals are designed to support the weight of the pipe.

2. Loosen rear pressure plates with nut just enough so Link-Seal® seals can be inserted. Make sure the pipe will be adequately supported on both ends. Link-Seal® modular seals are designed to support the weight of the pipe.

3. Check to be sure all bolt heads are facing the installer. Extra slack or sag in cables must be removed. Link-Seal® modular seals are designed to support the weight of the pipe.

4. Slide bolt assembly into annular opening. For larger size bolts, start inserting head or offset wrench ONLY at 12 O'Clock. Do not tighten any bolt more than 4 turns at a time. Continue in a clockwise manner until bolts have been uniformly compressed. (Approx. 2 or 3 rotations)

5. LS-200 thru LS-650 Using a hand socket or offset wrench ONLY start at 12 O'Clock. Do not tighten any bolt more than 4 turns at a time. Continue in a clockwise manner until bolts have been uniformly compressed. (Approx. 2 or 3 rotations)

6. Make 2 or 3 more passes at 4 turns per bolt MAXIMUM. Tightening all bolts clockwise until all sealing elements "bump" against all pressure plates. On type 310 stainless steel bolts, hand tighten ONLY without power tool.

7. If the seal doesn't appear to be correct using the instructions provided, call PSI at 800-423-2416.

Installation Notes: The Link-Seal® modular seal bolt heads are usually recessed below the well opening or the edge of casting pipe and therefore a socket or offset wrench must be used. Hand Tools: Reverser provided (tools not provided). Tools can be purchased from hardware stores, auto parts stores, or home improvement stores.

Link-Seal® Model
 LS-200, LS-275 4mm, Allen
 LS-300, LS-315 6mm, Allen
 LS-325, LS-340, LS-360 13mm, Hex
 LS-400, LS-410, LS-425, LS-475 17mm, Hex
 LS-500, LS-525, LS-575 19mm, Hex
 LS-600 30mm, Hex
 LS-650 19mm, Hex

Tool Size/Type Req'd.
 4mm, Allen
 6mm, Allen
 13mm, Hex
 17mm, Hex
 19mm, Hex
 30mm, Hex
 19mm, Hex

Always Wear Safety Equipment When Using Link-Seal® Modular Seals!

1. Make sure pipe is centered.

2. Install the belt with the pressure plates evenly spaced.

3. Install the exact number of links indicated inacing charts.

4. Check to make sure pipe is supported properly (no sag) in both directions.

5. Note: Link-Seal® modular seals are designed to support the weight of the pipe.

6. Make sure seal assembly and pipe supports are free from dirt.

7. For tight fits, use non-slip rubber feet designed to assist installation.

8. Don't install the Link-Seal® modular seal without consideration of the sealing requirements.

9. Don't torque each bolt completely before moving on to the next.

10. Do not use high speed power tools (4500 rpm or more).



11. Do not use power tools in irregular directions.

12. Do not use grease. Installing Link-Seal® modular seals.

If the seal doesn't appear to be correct using the techniques provided, call PSI at 715-747-8243 or 800-423-2416.

ROUND PIPE				HORIZONTAL ELLIPTICAL PIPE			
INSIDE DIAMETER OF PIPE (INCHES)	"N" PAYLINE WIDTH OF TRENCH (INCHES)	"W" PAYLINE WIDTH OF TRENCH (FEET)	PAY-VOLUMES CONCRETE ENCASMENT (CU. FT. PER FT.)	INSIDE DIMENSIONS OF PIPE (INCHES)	"N" PAYLINE WIDTH OF TRENCH (INCHES)	"W" PAYLINE WIDTH OF TRENCH (FEET)	PAY-VOLUMES CONCRETE ENCASMENT (CU. FT. PER FT.)
4	30	2.50	3.28				
6	30	2.50	3.59				
8	30	2.50	3.87				
10	30	2.50	4.25				
12	30	2.50	4.59				
15	36	3.00	5.55				
18	36	3.00	5.77	14 x 23	41	3.42	5.94
21	39	3.25	6.41				
24	42	3.50	7.39	19 x 30	49	4.08	7.88
27	45	3.75	8.16	22 x 34	53	4.42	8.81
30	48	4.00	9.30	24 x 38	58	4.83	9.70
33	51	4.25	10.33	27 x 42	62	5.17	10.71
36	54	4.50	11.43	29 x 45	68	5.50	11.72
DISCONTINUED							
39	57	4.75	12.49	32 x 49	71	5.92	12.74
42	60	5.00	13.58	34 x 53	75	6.25	14.03
48	70	5.83	15.67	38 x 60	83	6.92	15.18
54	77	6.42	18.15	43 x 66	92	7.67	18.81
60	84	7.00	20.73	48 x 76	101	8.42	21.59
66	91	7.58	23.45	53 x 83	109	9.28	24.35
72	98	8.17	26.37	58 x 91	118	9.83	27.45
78	105	8.75	29.39	63 x 98	128	10.50	30.50
84	112	9.33	32.57	68 x 106	135	11.25	33.91
90	119	9.92	35.90	72 x 113	143	11.92	36.99
96	126	10.50	39.37	77 x 121	152	12.67	40.89
102	133	11.08	42.99	82 x 128	160	13.33	44.48
108	140	11.67	46.75	87 x 136	168	14.00	47.79
114	147	12.25	50.65	92 x 143	176	14.67	51.70
120	154	12.83	54.72	97 x 151	185	15.42	56.01
126	161	13.42	58.92				
132	168	14.00	63.27	108 x 168	202	16.83	64.48
144	182	15.17	72.40	116 x 180	218	18.17	73.59

TABLE 1 PAYLINE WIDTHS OF TRENCH AND PAY-QUANTITIES OF CONCRETE
 METROPOLITAN ST. LOUIS SEWER DISTRICT
 Standard Details of Sewer Construction
 Dr. B.E.B. Ch. J.C.K. 2009 SHEET 1

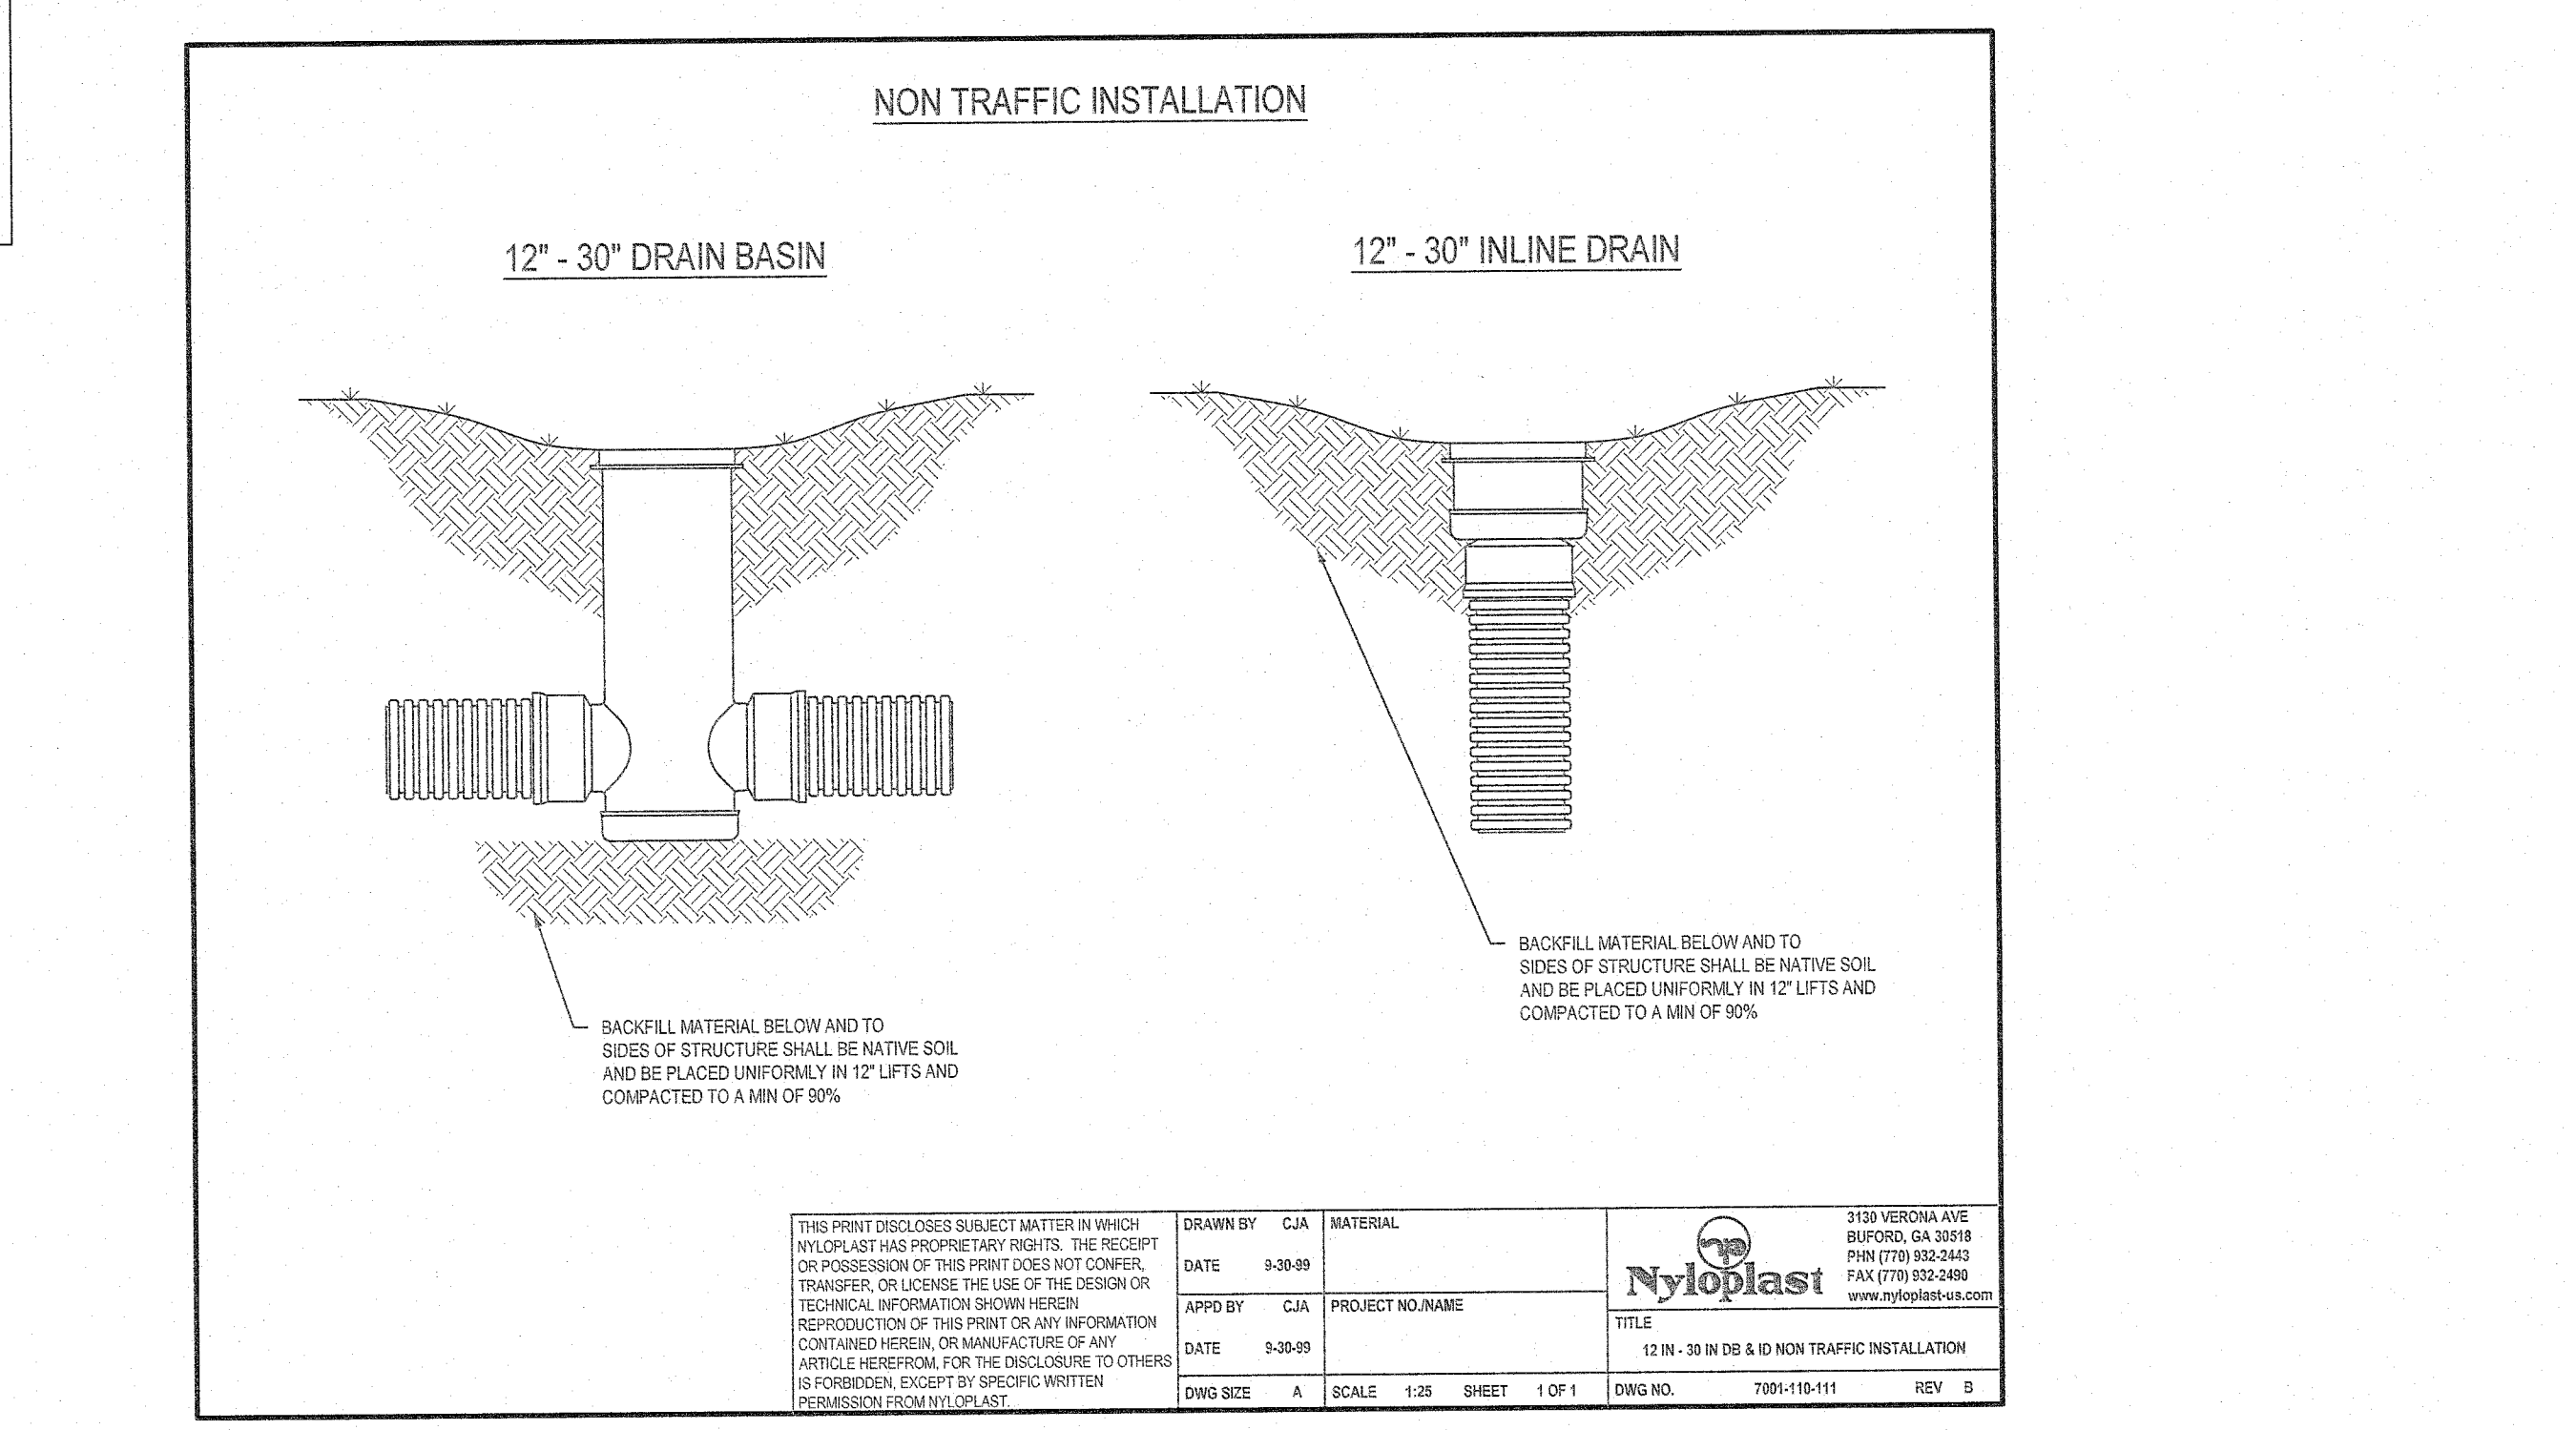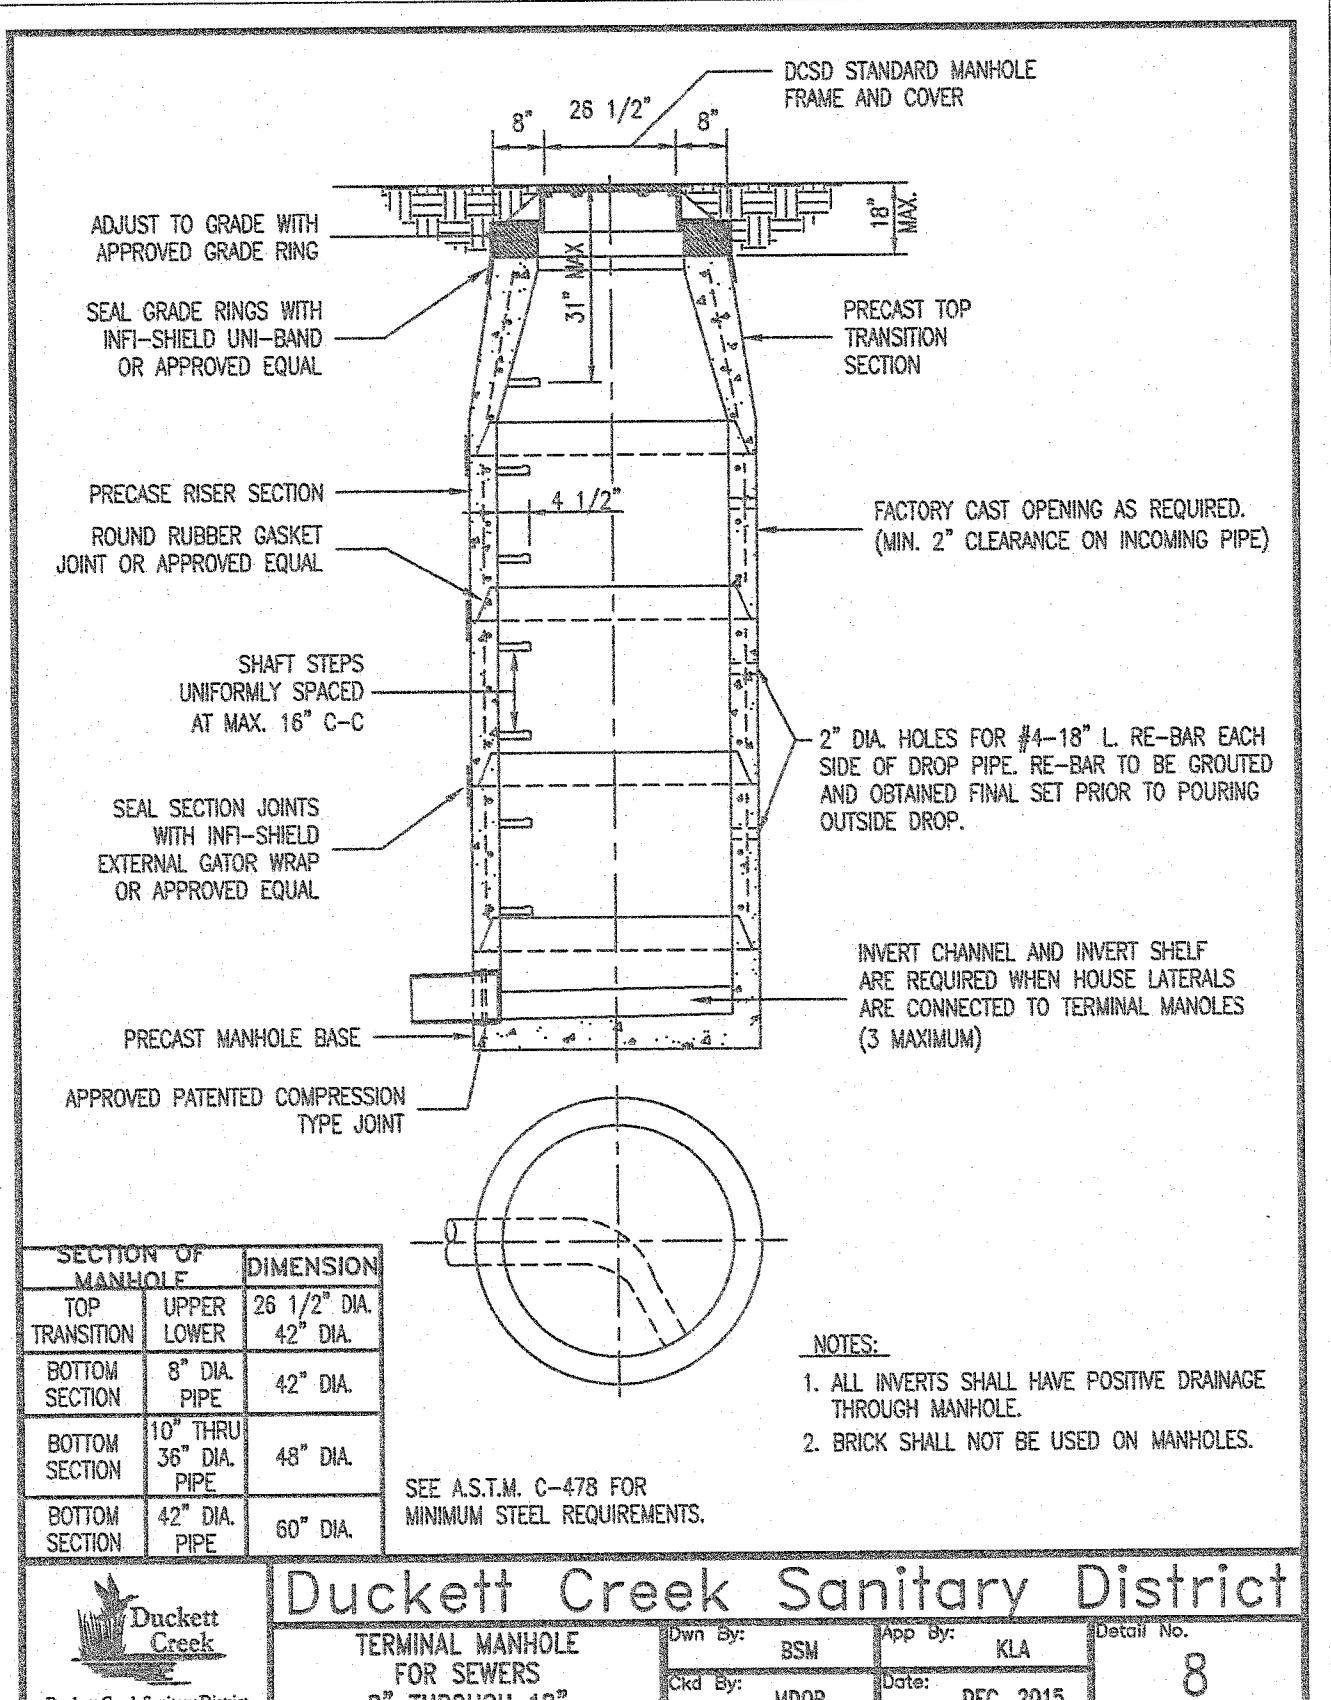


AS-BUILT PUBLIC UTILITY FINAL MEASUREMENTS

THE FOLLOWING UTILITIES HAVE BEEN LOCATED AND MEASURED AND THE RESULTS OF THOSE MEASUREMENTS ARE SHOWN ON THIS SET OF FINAL MEASUREMENT PLANS.

- STORM SEWERS, STORM SEWER LENGTHS, STORM SEWER PIPE SIZES, STORM SEWER FLOWLINES,
- DEPTHS OF STORM SEWER STRUCTURES AND TOPOGRAPHY OF MODIFIED DETENTION BASIN,
- SANITARY SEWERS, SANITARY SEWER LENGTHS, SANITARY SEWER PIPE SIZES, SANITARY SEWER FLOWLINES AND DEPTHS OF SANITARY SEWER STRUCTURES,
- PIPE HYDRANTS,
- WATER VALVES,
- LIGHT STANDARDS

ALL PUBLIC UTILITIES SHOWN HEREON AS BEING AS-BUILT ARE LOCATED WITHIN DESIGNATED EXISTING OR PROPOSED EASEMENTS.

BAX ENGINEERING COMPANY, INC.
 MARK E. COLLINS
 MISSOURI PROFESSIONAL LAND SURVEYOR #2006000173

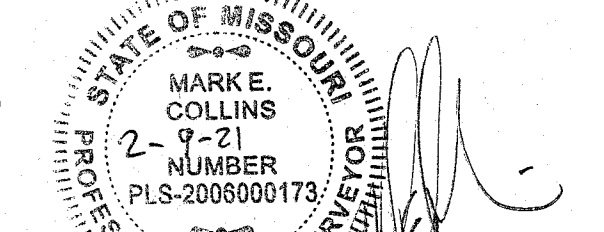

DUCKETT CREEK SANITARY DISTRICT CONSTRUCTION NOTES

- Underground utilities have been plotted from available information and therefore location shall be considered approximate only. The verification of the location of all underground utilities, either shown or not shown on these plans, shall be the responsibility of the contractor and shall be located prior to any grading or construction of improvements.
- Gas, water and other underground utilities shall not conflict with the depth or horizontal location of existing or proposed sanitary and storm sewers, including house laterals.
- All existing site improvements disturbed, damaged or destroyed shall be repaired or replaced to closely match preconstruction conditions.
- All fill including places under proposed storm and sanitary sewer lines and paved areas including trench backfills within and off the road right-of-way shall be compacted to 90 percent of maximum density as determined by the Modified AASHTO T-160 Compaction Test (ASTM D1557). All tests shall be verified by a Soils Engineer concurrent with grading and backfilling operations. The compacted fill shall be free of rutting and shall be non-yielding and non-pumping during proofrolling and compaction.
- The contractor shall prevent all storm, surface water, mud and construction debris from entering the existing sanitary sewer system. The contractor will be required to install a brick bulkhead on the downstream side of the first new manhole constructed when connecting into existing sewers.
- All sanitary sewer flowlines and tops built without elevations furnished by the engineer will be the responsibility of the sewer contractor.
- It is the responsibility of the contractor to adjust all sanitary manholes (that are affected by the development) to finish grade.
- Easements shall be provided for all sanitary sewers, storm sewers and all utilities on the record plat.
- All sanitary sewer construction and materials shall conform to the current construction standards of the Duckett Creek Sanitary District.
- The Duckett Creek Sanitary District shall be notified at least 48 hours prior to construction for coordination of inspection.
- All sanitary sewer building connections shall be designed so that the minimum vertical distance from the low point of the basement to the flowline of a sanitary sewer at the corresponding building connection shall not be less than the diameter of the pipe plus the vertical distance of 2 1/2 feet.
- All sanitary sewer manholes shall be watertight in accordance with Missouri Dept. of Natural Resources specification 10 CSR 20-8.120(6)(F) 1.
- All PVC sanitary sewer pipe shall conform to the requirements of ASTM D-3034 Standard Specification for PSM Polyvinyl Chloride Sewer Pipe, SDR-35 or equal, with "clean" 1/2 inch to 1 inch granular stone bedding uniformly graded. This bedding shall extend from 4 inches below the pipe to springline of pipe. Immediate backfill over pipe shall consist of same size "clean" or "minus" stone from springline of pipe to 6 inches above the top of pipe. Final backfill material shall be of suitable material removed from excavation except as other material is specified. Debris, frozen material, large rocks or stones, or other unstable materials shall not be used within 2 feet from top of pipe.
- All sanitary and storm sewer trench backfills shall be water jetted. Granular backfill will be used under pavement areas.
- All pipes shall have positive drainage through manholes. Flat invert structures not allowed.
- Epoxy Coating shall be used on all sanitary sewer manholes that receive pressurized mains.
- All creek crossings shall be lined with rip-rap as directed by District inspectors.
- Brick shall not be used on sanitary sewer manholes.
- Existing sanitary sewer service shall not be interrupted.
- Maintain access to existing residential driveways and streets.
- Pre-manufactured adapters shall be used at all PVC to DIP connections. Rubber boot / Mission-type couplings will not be allowed.
- Any permits, licenses, easements, or approvals required to work on public or private properties or roadways are the responsibility of the developer.
- Type N' Lock-Type Cover and Locking Device (Lock-Lug) shall be used where lock-type covers are required.
- All sanitary sewer system work shall be conducted under the inspection of a representative of the District. All work may not require inspection but the District's representative may designate specific areas that must be inspected before the work is backfilled. All testing must be witnessed by the District's Inspector and the Contractor shall furnish all testing equipment as approved by the District. Testing shall include:
 - A mandrel test of all gravity sewers using a mandrel with a diameter that has a diameter 95% of the inside pipe diameter. If the mandrel test fails on any section of pipe, that section of pipe shall be uncovered and replaced. No expansion devices will be allowed to be used to "force" the pipe that is deformed back to round. Any string lines used in mandrel testing shall be removed after testing is completed. Deflection testing cannot be conducted prior to 30 days after final backfill.
 - An air pressure test of all gravity sewers to a pressure of 5 PSI with no observed drop in pressure during a test period of 5 minutes.
 - A vacuum test of all manholes for a period of 1 minute and the vacuum shall be 10" of mercury and may not drop below 9" of mercury at the end of the 1 minute test.

Revised October 2016

Duckett Creek Sanitary District
 Dr. BSM App By: KLA
 Date: MBOB Date: DEC. 2015
 SHEET NO. 8

LAND SURVEYOR'S SEAL DOES NOT APPLY TO REFERENCE DETAILS ON THIS SHEET.

Box Engineering Company, Inc.
 Missouri State Certificate of Authority
 Engineering #00053
 Missouri State Certificate of Authority
 Surveying #00044

WENTZVILLE, MISSOURI
 GEOTECHNICAL
 PSI, INC.

STRUCTURAL
 MECH/ELEC/PLUMB
 CIVIL/SURVEY
 HOENER ASSOCIATES, INC. - ARCHITECTS
 6707 PLANNING AVENUE
 ST. LOUIS, MISSOURI 63109
 Ph. (314) 781-9955 Fax (314) 781-0163

ADDITIONS AND RENOVATIONS AT
**FRONTIER MIDDLE SCHOOL
 AS-BUILT PLANS**

WENTZVILLE R-IV SCHOOL DISTRICT
 HOENER ASSOCIATES, INC. - ARCHITECTS
 6707 PLANNING AVENUE
 ST. LOUIS, MISSOURI 63109
 Ph. (314) 781-9955 Fax (314) 781-0163

ALL DIMENSIONS MUST BE VERIFIED AT BUILDING BEFORE WORK IS EXECUTED. THIS DRAWING IS THE PROPERTY OF THE ARCHITECTS AND SHALL NOT BE COPIED OR DUPLICATED WITHOUT THEIR CONSENT.

proj. no. **19-06C**
 date issued
 01/31/20
 date revised

02/08/21
 CITY COMMENT REVISIONS

drawn by GAW
 checked by JNW
 sheet no.

C12.0

SEWER DETAILS
 BAX PROJECT NO. 12495HA