



A SET OF AS-BUILT PLANS FOR FORT ZUMWALT PROFESSIONAL DEVELOPMENT CENTER

A TRACT OF LAND BEING PART OF THE NORTH HALF OF THE SOUTHWEST QUARTER OF SECTION 24, TOWNSHIP 47 NORTH, RANGE 2 EAST OF THE FIFTH PRINCIPAL MERIDIAN CITY OF O'FALLON ST. CHARLES COUNTY, MISSOURI

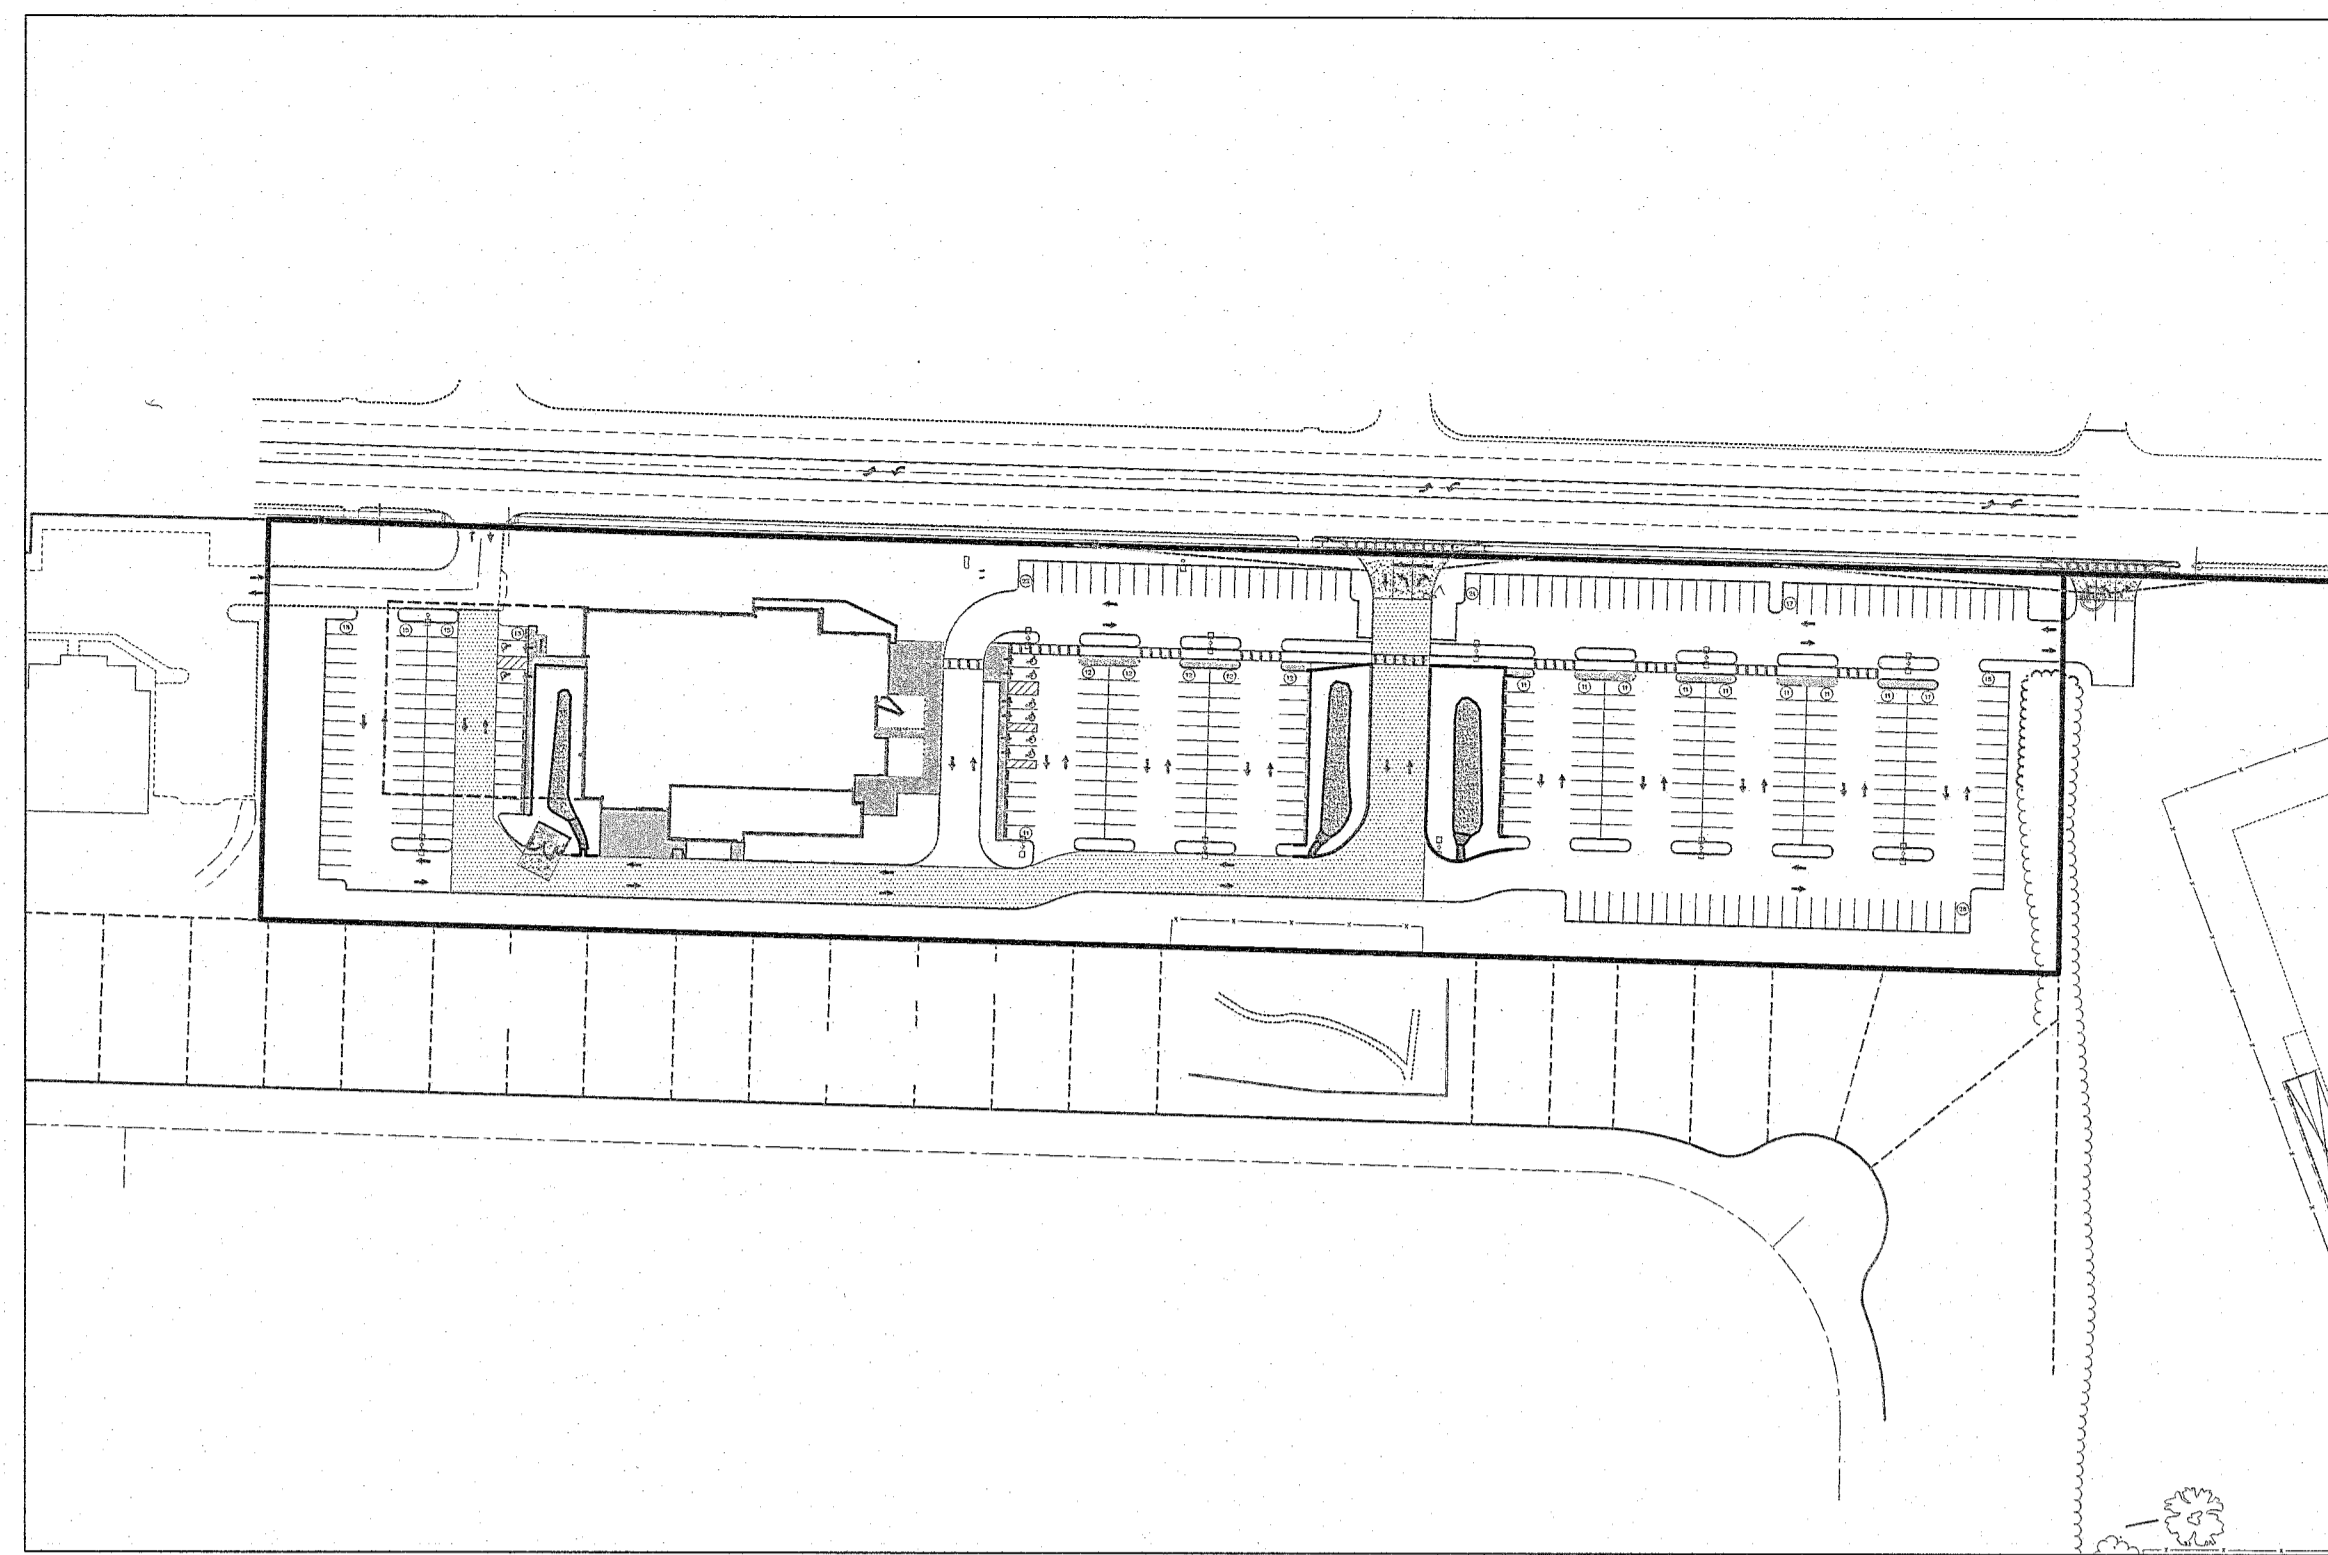

Plan View

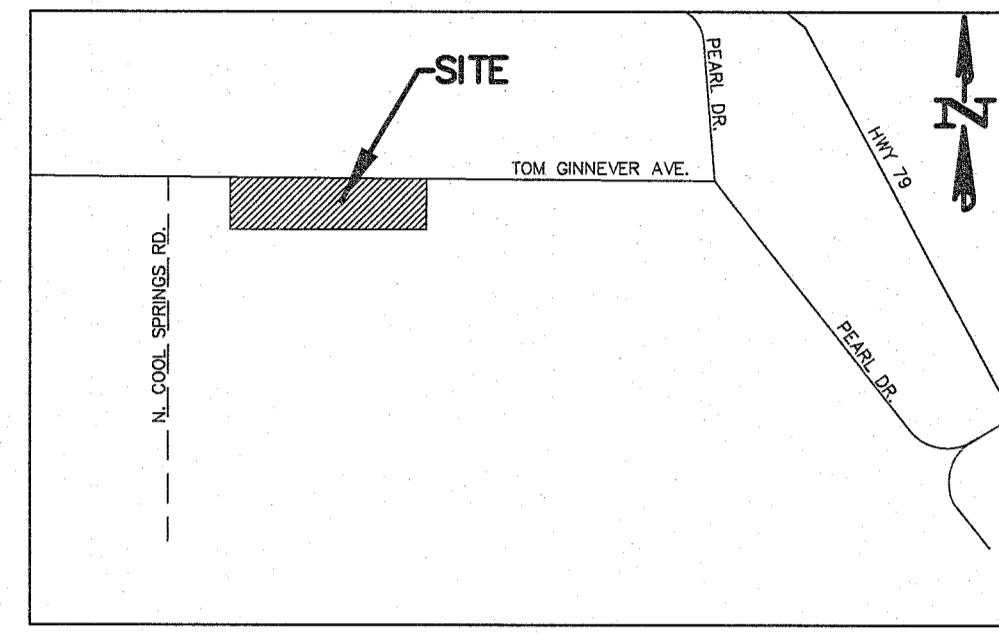

Locator Map
(NOT TO SCALE)

Legend

600.00 EXISTING LABELS	EXIST. SINGLE CURB INLET
800.00 PROPOSED LABELS	EXIST. AREA INLET
CI SINGLE CURB INLET	PROPOSED SINGLE CURB INLET
DCI DOUBLE CURB INLET	PROPOSED AREA INLET
AI AREA INLET	PROPOSED GRATE INLET
DAI DOUBLE AREA INLET	EXIST. SANITARY MANHOLE
G GRATE INLET	EXIST. STORM MANHOLE
DGI DOUBLE GRATE INLET	PROPOSED MANHOLE
MH MANHOLE	POWER POLE
FE FLARED END SECTION	GUY WIRE
EP END PIPE	LIGHT STANDARD
CP CONCRETE PIPE	FIRE HYDRANT
RCP REINFORCED CONCRETE PIPE	WATER METER
CMP CORRUGATED METAL PIPE	WATER VALVE
CPP CORRUGATED PLASTIC PIPE	GAS VALVE
PVC POLY VINYL CHLORIDE (PLASTIC)	TELEPHONE PEDESTAL
CO CLEAN OUT	SIGN
..... SLOPE LIMITS	TREE
--- DRAINAGE SWALE	
--- STM EXISTING STORM SEWER	
--- SM EXISTING SANITARY SEWER	
--- W EXISTING WATER LINE	
--- FO EXISTING FIBER OPTIC LINE	
--- GAS EXISTING GAS LINE	
--- UGE EXISTING UNDERGROUND ELECTRIC	
--- OHW EXISTING OVERHEAD ELECTRIC	
--- CTV EXISTING CABLE TV LINE	
--- T EXISTING TELEPHONE LINE	
--- PROPOSED STORM SEWER	
--- PROPOSED SANITARY SEWER	
--- FENCE LINE	
--- SAWCUT LINE	

Conditions of Approval From Planning and Zoning

- The Construction Plans shall address the Municipal Code Requirements listed.
 - Per note 4 in the development notes, any further additions will require a separate site plan.
 - The passive trash enclosure is a requirement per Code Section 400.278 and the door may be locked.
 - Provide ten (10) bicycle parking spaces and provide a bike rack detail on the Construction Site Plans.
- All mechanical units shall be screened according to Code Section 400.278.
 - A photometric lightin plan shall be provided before construction plan approval.

AS-BUILT LEGEND

A.B. AS-BUILT	AS-BUILT STORM MANHOLE
AS-BUILT CURB INLET	AS-BUILT STORM FLARED END
AS-BUILT SANITARY MANHOLE	AS-BUILT FIRE HYDRANT
AS-BUILT WATER VALVE	AS-BUILT WATER METER
AS-BUILT FIRE HOSE CONNECTION	AS-BUILT LIGHT STANDARD
AS-BUILT CLEANOUT	AS-BUILT ELECTRIC TRANSFORMER

GRADING QUANTITY

7,700 cu.yds.
(INCLUDES 8% SHRINKAGE)

THE ABOVE YARDAGE IS AN APPROXIMATION ONLY, NOT FOR BIDDING PURPOSES, CONTRACTORS SHALL VERIFY QUANTITIES PRIOR TO CONSTRUCTION.

IT HAS BEEN ESTIMATED THAT 1,500 C.Y. OF HAUL IS REQUIRED. CONTRACTOR SHALL PROVIDE CITY WITH HAUL ROUTE.

VEGETATION ESTABLISHMENT For Urban Development Sites APPENDIX A	
SEEDING RATES:	
PERMANENT:	
Grass - 150 lbs./ac.	
Smooth Brome - 100 lbs./ac.	
Combined - 50 lbs./ac. AND 50 lbs./ac.	
TEMPORARY:	
Wheat or Rye - 150 lbs./ac. (3.5 lbs. per 1,000 s.f.)	
Oats - 120 lbs./ac. (2.75 lbs. per 1,000 s.f.)	
SEEDING PERIODS:	
Fescue or Brome - March 1 to June 1	
Wheat or Rye - March 15 to October 1	
Oats - March 15 to September 15	
MULCH RATES:	
100 lbs. per 1000 sq. ft. (4,356 lbs. per ac.)	
FERTILIZER RATES:	
Nitrogen 30 lbs./ac.	
Phosphate 30 lbs./ac.	
Potassium 30 lbs./ac.	
Lime 600 lbs./ac. ENM*	
* ENM = effective neutralizing material as per State evaluation of quarried rock.	

REFERENCE BENCHMARKS:

ALL AS-BUILT ITEMS HAVE BEEN LOCATED AND TIED TO THE MISSOURI COORDINATE SYSTEM OF 1983, EAST ZONE, (GRID NORTH), NAD83 FOR HORIZONTAL DATUM AND NAVD88 FOR VERTICAL DATUM.

REFERENCE BENCHMARK: THE OBSERVED VERTICAL CHECK STATION UTILIZED IS LISTED ON www.mgs.moon.gov AS DESIGNATION "SC 05" WITH A PIP OF A45597 AND A PUBLISHED ELEVATION OF 529.0 (NAV88).

DESCRIPTION BY MISSOURI DEPARTMENT OF NATURAL RESOURCES 1990 STATION, AZIMUTH MARKS AND REFERENCE TIES THE STATION IS LOCATED ON THE EAST SHOULDER OF THE NORTH BOUND LANE OF MISSOURI HIGHWAY 79 ABOUT 1/2 MILE NORTH OF I-70 IN ST CHARLES COUNTY. IT IS 280 FT NORTH OF THE NORTH END OF THE RAILROAD OVERPASS AT APPROXIMATE HIGHWAY 79 STATION 53762 AND ON A LINE EXTENDED FROM THE NORTHERLY FENCE ENCLOSED THE LOADING DOCKS OF WAINWRIGHT INDUSTRIES, INC., 14.82 FT (4.52 M) SE OF A COTTON PICKER SPINDLE IN THE JOINT OF THE PAVEMENT AND SHOULDER, 14.72 FT (4.49 M) NE OF ANOTHER, 12.45 FT (3.78 M) EASTERLY OF THE JOINT BETWEEN THE PAVEMENT AND SHOULDER AND 2.06 FT (0.63 M) SOUTH OF A CARSONITE WITNESS POST THE AZIMUTH MARK SC-06 A 2, 1994 IS ABOUT 0.3 MILE (0.5 KM) SE OF THE STATION AND ON THE WEST RIGHT-OF-WAY FOR THE I-70 NORTH OUTER ROAD EAST IT IS 57.6 FT (17.6 M) WEST OF A TRAFFIC SIGN NEAR THE END OF THE CONCRETE MEDIAN, 41.6 FT (12.7 M) WEST OF THE WEST EDGE OF PAVEMENT, 1.6 FT (0.5 M) EAST OF A RIGHT-OF-WAY MARKER, AND 2 FT (0.6 M) NORTH OF A CARSONITE WITNESS POST STATION AND AZIMUTH MARK TO REACH TO REACH THE STATION FROM THE CENTER OF I-70 EXIT 220 (MISSOURI HWY 79 AND SALT LICK RD.) GO NORTH ON HWY 79 FOR 0.5 MILES (0.8 KM) TO THE STATION SITE ON RIGHT (EAST) AS DESCRIBED. TO REACH THE AZIMUTH MARK FROM THE CENTER OF I-70 EXIT 220, GO NORTH ON HWY 79 FOR 0.25 MILES (0.40 KM) TO THE I-70 NORTH OUTER ROAD EAST (TURNER AVE), TURN RIGHT AND GO EAST FOR 0.05 MILES (0.08 KM) TO POINT WHERE OUTER ROAD EAST TURNS SOUTH, TURN RIGHT AND GO SOUTH ON NORTH OUTER ROAD EAST FOR 0.05 MILES (0.08 KM) TO POINT WHERE ROAD MAINTENANCE CHANGES FROM STATE TO COUNTY AND AZIMUTH MARK ON RIGHT AS DESCRIBED. THE 1990 AZIMUTH IS STILL IN PLACE, BUT THE LINE OF SIGHT TO THE STATION IS BLOCKED BY A BUILDING. DATE OF REPORT 6-06-1995.

SITE BENCHMARK - ELEVATION=496.70 (NAVD 88)- CHISELED "U" ON LIGHT STANDARD BASE LOCATED NEAR SOUTHWEST SIDE OF SUBJECT PROPERTY AND IS LOCATED AS SHOWN HEREON.

AS-BUILT PUBLIC UTILITY FINAL MEASUREMENTS

THE FOLLOWING UTILITIES HAVE BEEN LOCATED AND MEASURED AND THE RESULTS OF THOSE MEASUREMENTS ARE SHOWN ON THIS SET OF FINAL MEASUREMENT PLANS:

- STORM SEWERS, STORM SEWER LENGTHS, STORM SEWER PIPE SIZES, STORM SEWER FLOWLINES AND DEPTHS OF STORM SEWER STRUCTURES.
- SANITARY SEWERS, SANITARY SEWER LENGTHS, SANITARY SEWER PIPE SIZES, SANITARY SEWER FLOWLINES AND DEPTHS OF SANITARY SEWER STRUCTURES.
- FIRE HYDRANTS
- WATER VALVES
- LIGHT STANDARDS
- TOPOGRAPHY OF WATER QUALITY AREAS

ALL PUBLIC UTILITIES SHOWN HEREON AS BEING AS-BUILT ARE LOCATED WITHIN DESIGNATED EXISTING OR PROPOSED EASEMENTS.

BAX ENGINEERING COMPANY, INC.
MARK E. COLLINS
MISSOURI PROFESSIONAL LAND SURVEYOR #2006000173



CITY OF O'FALLON
COMMUNITY DEVELOPMENT DEPARTMENT
ACCEPTED FOR CONSTRUCTION
BY: Jeanne Greenlee DATE: 02/01/2022
PROFESSIONAL ENGINEER'S SEAL
INDICATES RESPONSIBILITY FOR DESIGN

City approval of any construction site plans does not mean that any building can be constructed on the lots without meeting the building setbacks as required by the zoning codes. All installations and construction shall conform to the approved engineering drawings. However, if the developer chooses to make minor modifications in design and/or specifications during construction, they shall make such changes at their own risk, without any assurance that the City Engineer will approve the completed installation or construction. It shall be the responsibility of the developer to notify the City Engineer of any changes from the approved drawings. The developer may be required to correct the installed improvement so as to conform to the approved engineering drawings. The developer may request a letter from the Construction Inspection Division regarding any field changes approved by the City Inspector.

Lighting values will be reviewed on site prior to the final occupancy inspection.

* City of O'Fallon Construction work hours per City Ordinance 3429 as shown in section 500.420 of the Municipal Code of the City of O'Fallon are as follows:

October 1 through May 31
7:00 A.M. To 7:00 P.M. Monday Through Sunday
June 1 Through September 30
6:00 A.M. To 8:00 P.M. Monday Through Friday
7:00 A.M. To 8:00 P.M. Saturday and Sunday

- The area of this phase of development is 6.43ac.
- The area of land disturbance is 5.57Ac.
- Number of proposed lots is 1
- Building setback information, Front 25'
Side 0'
Rear 10'
- The estimated sanitary flow in gallons per day is 2,800

Drawing Index

1	COVER SHEET
2	NOTES
3	DEMO PLAN
4-5	SITE PLAN
6-7	GRADING PLAN
8-9	SWPP PLAN
10-11	LANDSCAPE PLAN
12	PRE-DRAINAGE AREA MAP
13-14	PROPOSED DRAINAGE AREA MAP
15	STORM PROFILES
16-17	CONSTRUCTION DETAILS
18	CONSTRUCTION DETAILS

DEVELOPMENT NOTES

- Area of Tract: 6.431 Acres
- Existing Zoning: C-2(PUD) General Business
- Proposed Use: Professional Development Center (City of O'Fallon)
- Area of Proposed Buildings: 24,734 sq.ft. (Includes 4,165 sq.ft. future addition)
- The required height and building setbacks are as follows:
Minimum Front Yard: 25 feet
Minimum Side Yard: 0 feet
Minimum Rear Yard: 10 feet
Maximum Height of Building: 50 feet
- Site is served by:
City of O'Fallon Sewer: 636-281-2858
AmerenUE Company: 636-839-8312
Laclede Gas Company: 636-946-8937
City of O'Fallon Water: 636-281-2858
Century Tel: 636-332-3011
O'Fallon Fire Protection District: 636-272-3493
Fort Zumwalt School District: 636-272-6620
- According to the Flood Insurance Rate Map of St. Charles County, (Community Panel number 29183002350 dated January 20, 2016) this property lies within zone X and zone AE. Zone X is defined as an area outside the 500 year Flood Plain Limits. Zone AE is defined as area subject to inundation by the 1% annual chance flood.
- Parking Required:
Meeting Room: Per IRC required parking is 1 space per 3 seats
7sq.ft. per seat
4,712 / 7 = 673 seats
673 seats / 3 = 225 spaces
- Office: 1 space per 300 sq.ft.
15,857sq.ft./300 = 53 spaces
Alternate Office area:
4,165sq.ft./300 = 14 spaces
Total Parking Required: 292 spaces
Total Parking Provided: 344 total(including 8 ADA spaces w/1 van accessible)
- Landscape Requirements:
Street Tree Requirements:
1 tree for every 40' of frontage = 1,100/40 = 28 Trees Required
32 Trees Provided
Open Spaces:
1 tree for every 4,000 s.f. landscaped area.
28,840 s.f. / 4,000 s.f. = 8 Trees Required
15 Trees Provided
Total trees provided = 47
For 20' buffer yard a 6' fence plus 2 plant units per 100' is required.
1,123 / 100 = 22 plant units required.
(See Buffer Detail)
- Interior Landscaping Required:
Not less than 6% of interior parking lot shall be landscaped.
345 spaces x 270 = 93,150 s.f. = 5,389 sq.ft. landscaping required
Total 8,720 sq.ft landscaping provided
- Site Coverage Calculations:

TOTAL LOT SQ. FT.	BUILDING SQ. FT.	% OF LOT	PAVEMENT SQ. FT.	% OF LOT	GREENSPACE SQ. FT.	% OF LOT
280,134	24,734	8.8%	165,528	59.10%	89,872	32.10%

- Estimated sanitary flow contributed by this site is 2,800 g.p.d.
- Property Owner: Fort Zumwalt School District
555 E. Terra Lane
O'Fallon, MO 63367
- All HVAC and mechanical units on site shall be properly screened as required by City Code. Rooftop units shall be screened by a parapet wall that extends around the entire perimeter of the building; the parapet shall have a minimum height that is at least as tall as the tallest unit mounted on the roof; ground mounted HVAC and mechanical units shall be screened by fencing, vegetation or some other means (approved by the Planning and Zoning Commission) that has a minimum height that is at least as tall as the tallest unit being screened.
- Maximum slopes allowed are 3:1.
- All utilities will be located underground.
- All proposed fencing requires a separate permit through the Planning Department.
- All sign locations and sizes must be approved separately through the Planning Dept.
- All paving to be in accordance with St. Louis County standards and specifications except as modified by the City of O'Fallon ordinances.
- All sidewalks, curb ramps, ramp and accessible parking spaces shall be constructed in accordance with the current approved "American with Disabilities Act Accessibility Guidelines" (ADAAG) along with the required grades, construction materials, specifications and signage.
- Detention for this site will be for the 100 year storm and will be provided with the existing detention basin.
- This site will be in compliance with Phase 2 Illicit Stormwater Discharge Guidelines per Ordinance 5082.
- Per City Municipal Code Section 400.510, Item 3. The developer is requesting P&Z Approval for limited street or parking lot curbing to meet stormwater quality guidelines.
- Prior to Construction Plan approval, a photometric lighting plan in accordance with the City's Exterior Lighting Standards shall be submitted for review and approval for all proposed exterior lighting.
- The drainage to adjacent residential lots shall not be increased above the current existing conditions.
- All construction methods and practices to conform with OSHA Standards.

Utility Contacts

Sanitary Sewer
City of O'Fallon
100 N. Main St.
O'Fallon, MO 63366
Contact: 636-281-2858

Water
City of O'Fallon
100 N. Main St.
O'Fallon, MO 63366
Contact: 636-281-2858

Storm Sewer
City of O'Fallon
100 N. Main St.
O'Fallon, MO 63366
636-281-2858

Ameren UE
200 Callahan Road
Wentzville, MO 63385
636-639-8312

Gas
Spire Energy
1909 Trade Center Drive
St. Peters, MO 63376
314-575-4831


Telephone
Century Link
2342 Technology Drive
O'Fallon, MO 63368
636-200-5726

Charter Communications
941 Charter Commons
Town & Country, MO 63017
1-888-438-2427

Fire Department
O'Fallon Fire Protection District
119 E. Elm St.
O'Fallon, MO 63366
636-272-3493

PROJECT TITLE:
As-Built Plans for
Fort Zumwalt School District
Professional Development Center

ENGINEERING
PLANNING
SURVEYING
221 Point West Blvd.
St. Charles, MO 63301
636-828-5662
FAX 636-828-1718

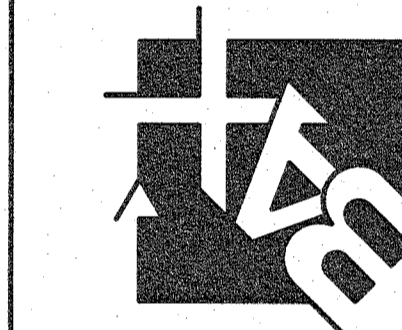

DISCLAIMER OF RESPONSIBILITY
I hereby certify that the documents intended to be submitted by my firm are limited to this project, and I hereby disclaim any responsibility for all other drawings, specifications, estimates, reports or other documents or instruments relating to or intended to be used for any part or parts of the architectural or engineering project or survey.

Bax Engineering Company, Inc.
Missouri State Certificate of Authority
Engineering #000655
Missouri State Certificate of Authority
Surveying #000144

REVISIONS	
NO.	DESCRIPTION

Storm Sewer
City of O'Fallon
100 N. Main St.
O'Fallon, MO 63366
636-281-2858

Ameren UE
200 Callahan Road
Wentzville, MO 63385
636-639-8312

Gas
Spire Energy
1909 Trade Center Drive
St. Peters, MO 63376
314-575-4831

Telephone
Century Link
2342 Technology Drive
O'Fallon, MO 63368
636-200-5726

Charter Communications
941 Charter Commons
Town & Country, MO 63017
1-888-438-2427

Fire Department
O'Fallon Fire Protection District
119 E. Elm St.
O'Fallon, MO 63366
636-272-3493

P&Z No. 19-009658
Approval Date: 11/07/19

City No. #

Page No. C1



CALL BEFORE
YOU DIG!
1-800-DIG-RITE

Bax Project # 19-1754 Issue Date: 12/30/2021

Developer / Owner:
Fort Zumwalt School District
555 E. Terra Lane
O'Fallon, MO 63367

COVER SHEET

COMMERCIAL

GN # 1 Driveway locations shall not interfere with the sidewalk handicap ramps, or curb inlet ramps... GN # 2 Sidewalks, curb ramps, ramps and accessible parking spaces shall be constructed in accordance with the current approved "American with Disabilities Act Accessibility Guidelines" (ADAAG) along with the required grades, construction materials, specifications and signage...

Erosion Control Notes

EN # 1 The Permittee shall assume complete responsibility for controlling all siltation and erosion of the project area. The Permittee shall use whatever means necessary to control erosion and siltation including, but not limited to, silted straw bales and/or siltation fabric fences... EN # 2 All erosion control systems are to be inspected and corrected weekly, especially within 48 hours of any rain storm resulting in one-quarter inch of rain or more...

Grading Notes

GN # 1 Developer must supply City construction inspectors with soil reports prior to and during site grading. The soil report will be required to contain the following information on soil test curves (Proctor reports) for projects within the City: 1. Maximum dry density... GN # 2 All fill placed in areas other than proposed storm sewers, sanitary sewers, proposed roads, and paved areas shall be compacted from the bottom of the fill up in 8" lifts and compacted to 90% maximum density as determined by Modified AASHTO T-180 compaction test...

Grading Notes Continued

GN #10 All trench back fills under paved areas shall be granular back fill, and compacted mechanically. All other trench back fills may be earth material (free of large clods, or stones) and compacted using either mechanical or water jetting. Granular material and earth material associated with new construction outside of pavements may be jetted, taking care to avoid damage to newly laid sewers... GN #11 Site grading: a. Within City right-of-way. Material is to be placed in eight (8) inch to twelve (12) inch loose lifts and compacted per the approved compaction requirements...

Sanitary Sewer Notes

SAN # 1 All sanitary sewer installation is to be in accordance with current M.S.D. standards and specifications except as modified by the City of O'Fallon Ordinances. SAN # 2 Brick shall not be used in the construction of sanitary sewer structures. Pre cast concrete structures are to be used unless otherwise approved by the City of O'Fallon. SAN # 3 Connections at all sanitary structures are to be made with A-Lock joint or equal... SAN # 7 All sanitary sewer mains shall have a minimum of 42" cover. SAN # 8 HDPE pipe is to be N-12WT or equal and to meet ASTM F1417 water tight field test.

Storm Sewer Notes

STM # 1 All Storm Sewer installation is to be in accordance with current M.S.D. standards and specifications except as modified by the City of O'Fallon Ordinances. STM # 2 Brick shall not be used in the construction of storm sewer structures. Pre cast concrete structures are to be used unless otherwise approved by the City of O'Fallon. STM # 3 A 5/8" trash bar shall be installed horizontally in the center of the opening(s) in all curb inlets and area inlets. STM # 4 HDPE pipe is to be N-12WT or equal and to meet ASTM F1417 water tight field test.

Water Notes

WN # 1 Fire hydrants shall be a maximum of 600' apart. Local fire district approval is required. WN # 2 Coordinate with the water company on the location of water meters. WN # 3 All water main shall have a minimum of 42" of cover. (City water mains) WN # 4 Provide water valves to isolate the system. WN # 5 All water mains shall be class 200 SDR 21 or equal with locator/tracer wires. WN # 6 DISINFECTING: Disinfecting shall be accomplished by placing sufficient hypo chlorite granule (HTH) in each section of pipe to achieve a chlorine residual in the pipeline...

Water Notes

WN #10 BACTERIOLOGICAL TESTING: After satisfactory disinfection and pressure testing, a sample shall be taken by the contractor in the presence of a City representative and submitted to a laboratory approved by the Missouri Department of Natural Resources and the City for bacteriological analysis. After 24 hours, a second sample shall be taken in a like manner and submitted for analysis. The two samples taken on consecutive days, a minimum of 24 hours apart, must be found to be "safe" by the testing laboratory, and copies of the test results must be supplied to the City...

Roadway Notes


RN # 1 All paving (public and private) to be in accordance with current St. Louis County Standards and Specifications except as modified by the City of O'Fallon ordinances. RN # 2 If the intersecting road does not have a curb, then the curb on the new entrance shall begin 10' from the edge of the existing road. RN # 3 Provide 6" of concrete over 4" of MoDot type 1 or type 5 aggregate rock or asphalt equivalent for minor residential streets per City Code 405.370. RN # 4 Multi-use trail (when required) shall have a minimum of 3" Type "C" Asphalt over 4" aggregate base per City requirements. RN # 5 Type C (SP-1) Compaction requirements shall be 95% minimum density according to St. Charles Co. Standard Specifications. RN # 6 Provide pavement striping at any point where the multi-use trail crosses existing or proposed pavement. RN # 7 All street sub-ways over 250' in length will require a temporary turnaround. RN # 8 All sub grade in cut or fill will need to conform to the City of O'Fallon Compaction requirements. RN # 9 Material Testing And Frequency. Materials for construction shall be tested and inspected per the appropriate ASTM code or at the City Engineer's direction. The developer's engineer shall perform the following quality control guidelines: 1. Concrete: a. Cylinders/compressive strength. One (1) set of four (4) cylinders within the first fifty (50) cubic yards and one (1) set per one hundred (100) cubic yards thereafter...

Flood plain Information

FP # 1 A flood plain development application from the City is required for any work within the flood plain limits. Retaining Walls: Terraced and Vertical RN # 1 A permit is required for all retaining walls that are 48 inches or taller in height, measured from the top of the footing to the top of the wall or for walls that support a surcharge load or that alters the channelized drainage of any lot or drainage area. RN # 2 Retaining walls will not be allowed in public right-of-way without written approval from the City Engineer. RN # 3 Any retaining wall more than thirty (30) inches tall which supports a walking surface that is within two (2) feet of the wall will require a guard on the retaining wall. RN # 4 Retaining walls that alter the channelized drainage of any lot or drainage area shall not be constructed without prior approval and permitting from the City of O'Fallon Engineering Department regardless of the height of the wall. RN # 5 See section 405.275 of the City code for additional design requirements.

AS-BUILT PUBLIC UTILITY FINAL MEASUREMENTS

THE FOLLOWING UTILITIES HAVE BEEN LOCATED AND MEASURED AND THE RESULTS OF THOSE MEASUREMENTS ARE SHOWN ON THIS SET OF FINAL MEASUREMENT PLANS: STORM SEWERS, STORM SEWER LENGTHS, STORM SEWER PIPE SIZES, STORM SEWER FLOWLINES AND DEPTHS OF STORM SEWER STRUCTURES, SANITARY SEWERS, SANITARY SEWER LENGTHS, SANITARY SEWER PIPE SIZES, SANITARY SEWER FLOWLINES AND DEPTHS OF SANITARY SEWER STRUCTURES, FIRE HYDRANTS, WATER VALVES, LIGHT STANDARDS, TOPOGRAPHY OF WATER QUALITY AREAS. ALL PUBLIC UTILITIES SHOWN HEREON AS BEING AS-BUILT ARE LOCATED WITHIN DESIGNATED EXISTING OR PROPOSED EASEMENTS. BAX ENGINEERING COMPANY, INC. MARK E. COLLINS MISSOURI PROFESSIONAL LAND SURVEYOR #2006000173

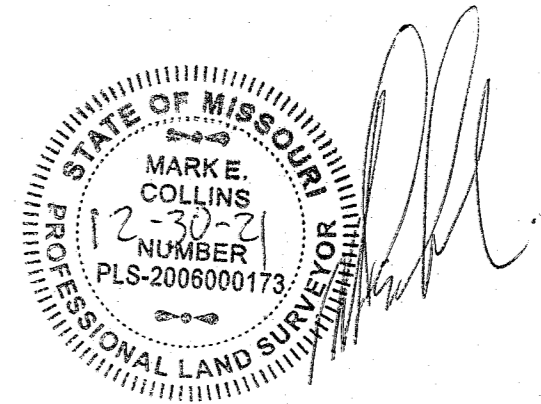

PROJECT TITLE: As-Built Plans for Fort Zumwalt School District Professional Development Center



ENGINEERING SURVEYING BAX ENGINEERING COMPANY, INC. 22 Point West Blvd., St. Charles, MO 63081 636-658-1016 FAX 636-1170

DECLARATION OF RESPONSIBILITY: I hereby certify that the documents intended to be authorized by my seal are limited to this sheet, and I hereby disclaim any responsibility for other drawings, specifications, estimates, reports or other documents or instruments relating to or intended to be used for any part or parts of the architectural or engineering project or survey.

Table with 2 columns: REVISIONS, and empty rows for recording changes.

Developer / Owner: Fort Zumwalt School District 555 E. Terra Lane O'Fallon, MO 63367

P+Z No. 19-009658 Approval Date: 11/07/19 City No. # Page No.

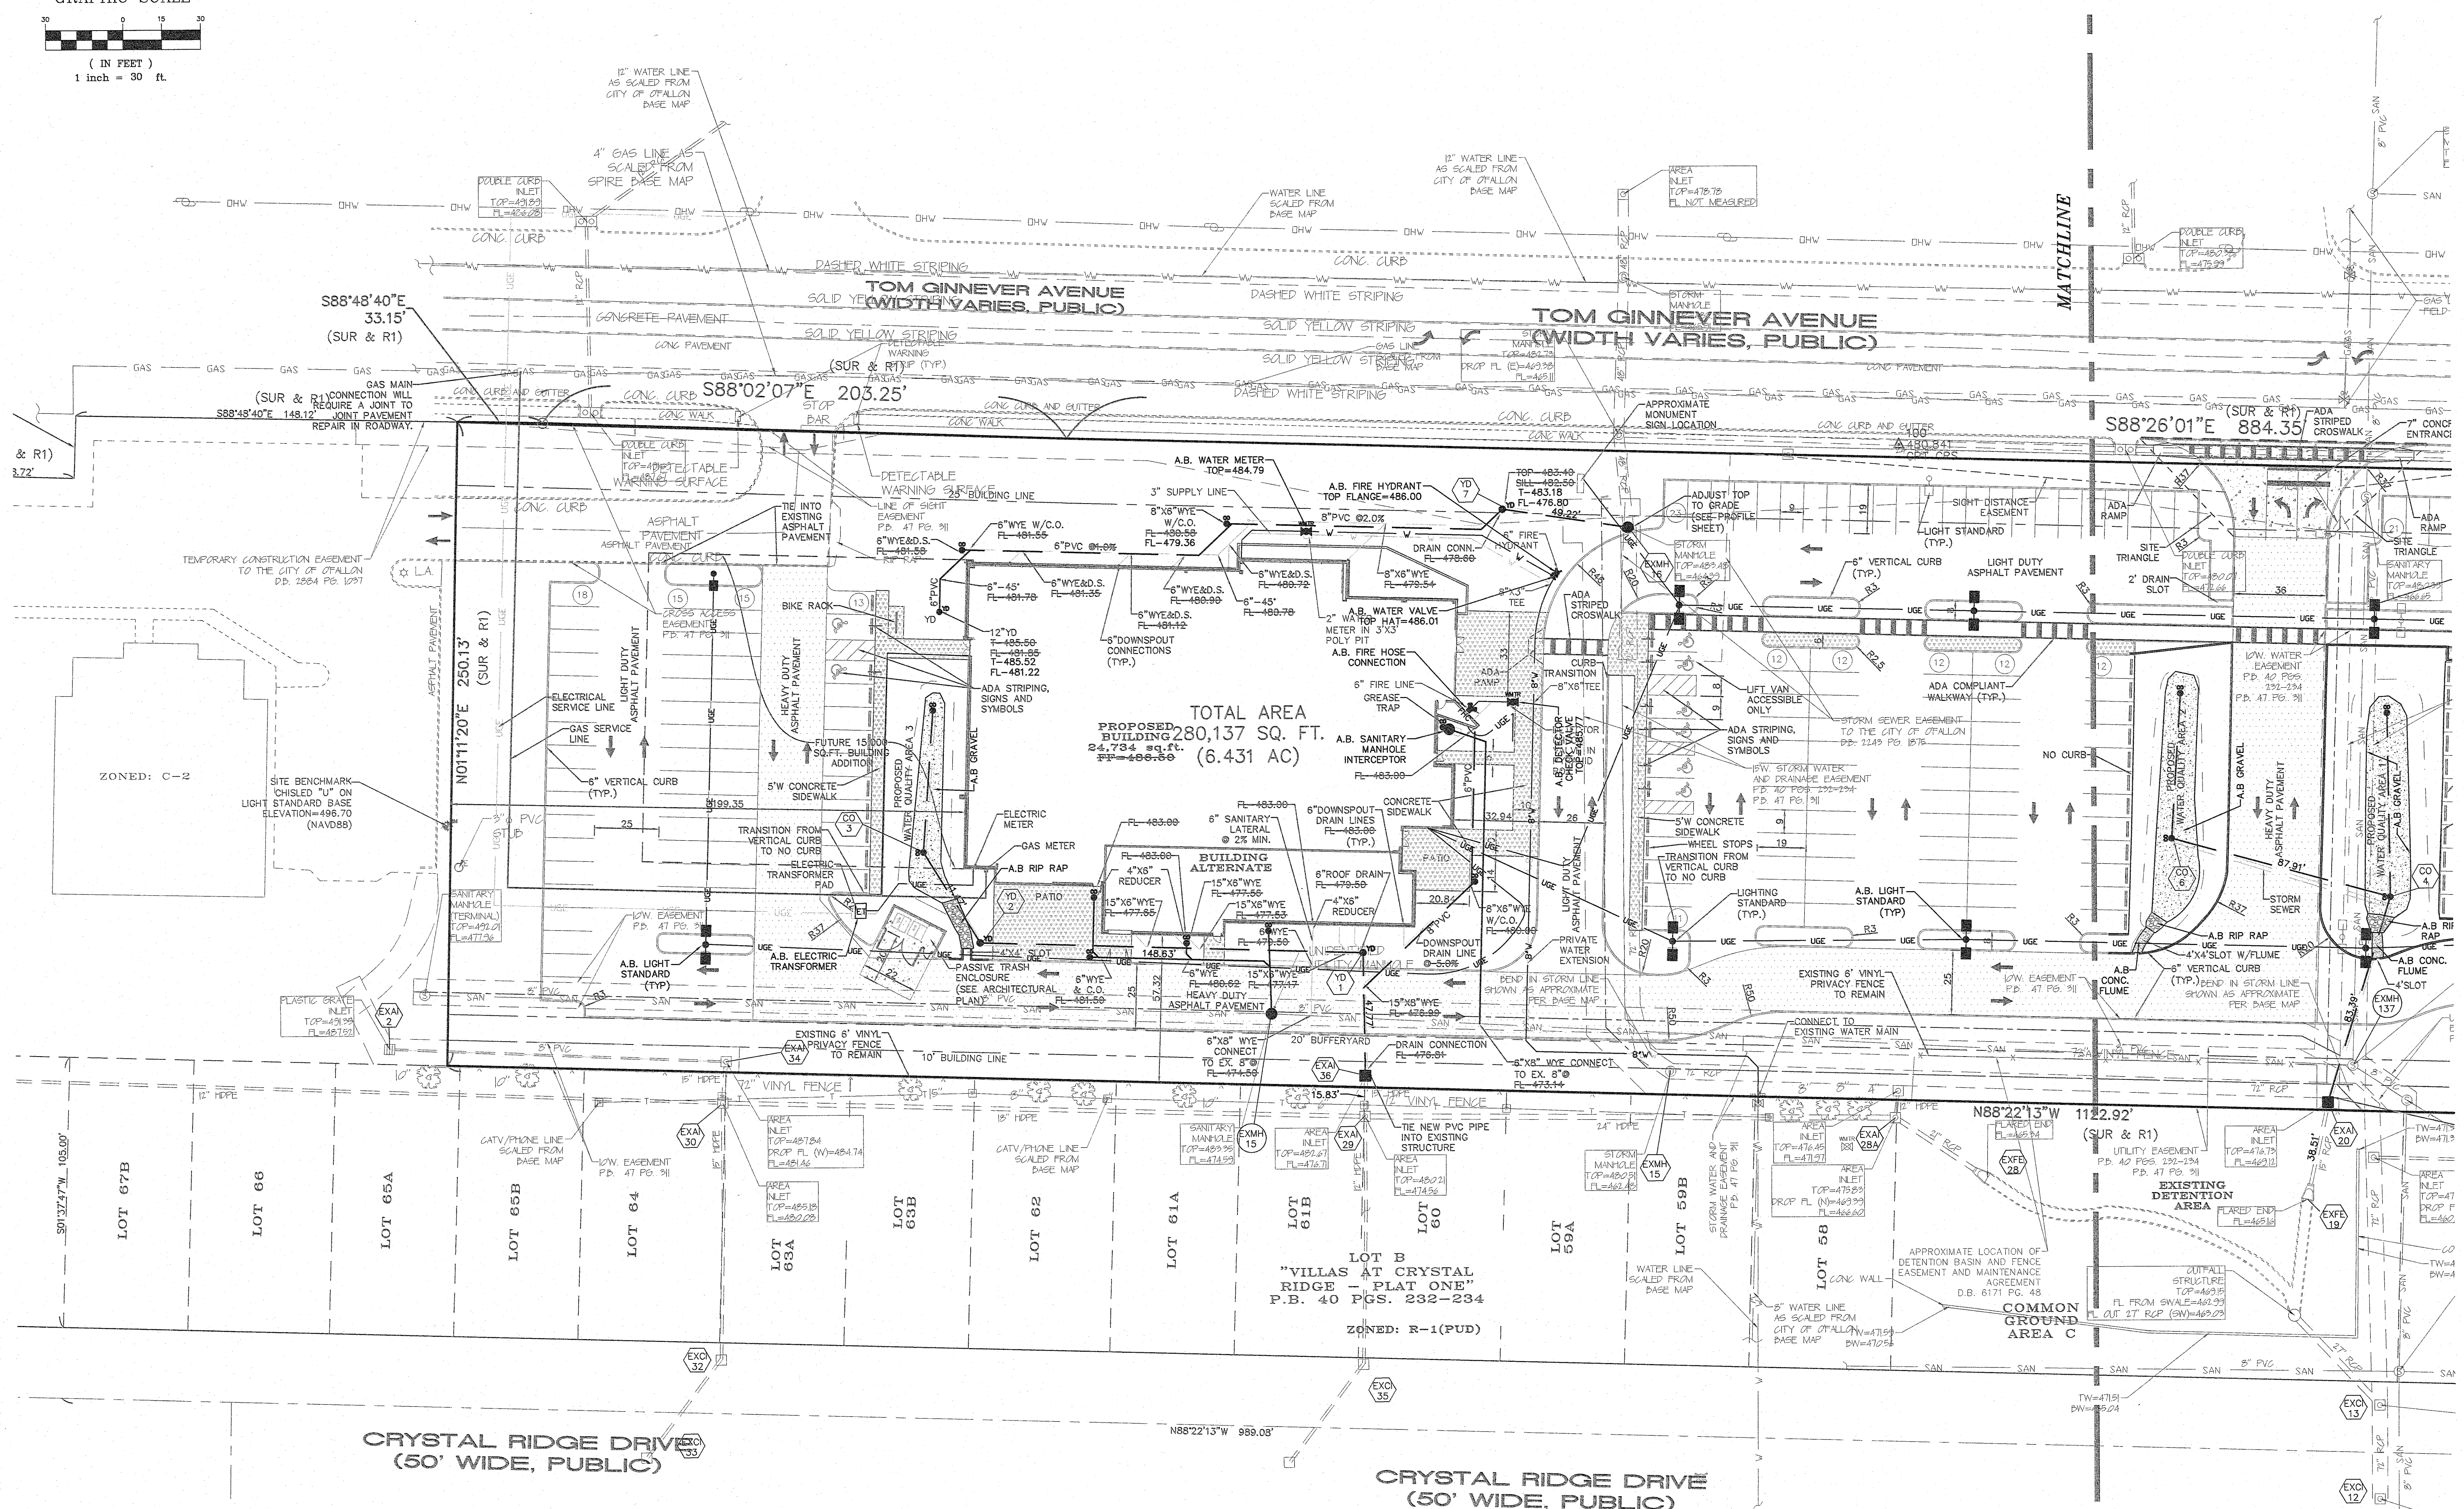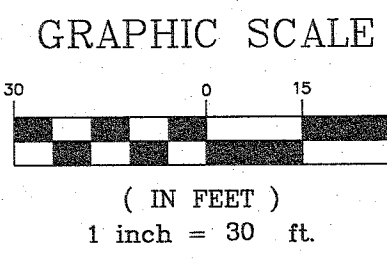


AS-BUILT PUBLIC UTILITY FINAL MEASUREMENTS

THE FOLLOWING UTILITIES HAVE BEEN LOCATED AND MEASURED AND THE RESULTS OF THOSE MEASUREMENTS ARE SHOWN ON THIS SET OF FINAL MEASUREMENT PLANS:


- STORM SEWERS, STORM SEWER LENGTHS, STORM SEWER PIPE SIZES, STORM SEWER FLOWLINES AND DEPTHS OF STORM SEWER STRUCTURES.
- SANITARY SEWERS, SANITARY SEWER LENGTHS, SANITARY SEWER PIPE SIZES, SANITARY SEWER FLOWLINES AND DEPTHS OF SANITARY SEWER STRUCTURES.
- FIRE HYDRANTS
- WATER VALVES
- LIGHT STANDARDS
- TOPOGRAPHY OF WATER QUALITY AREAS

ALL PUBLIC UTILITIES SHOWN HEREON AS BEING AS-BUILT ARE LOCATED WITHIN DESIGNATED EXISTING OR PROPOSED EASEMENTS.

BAX ENGINEERING COMPANY, INC.
 MARK E. COLLINS
 MISSOURI PROFESSIONAL LAND SURVEYOR #2006000173

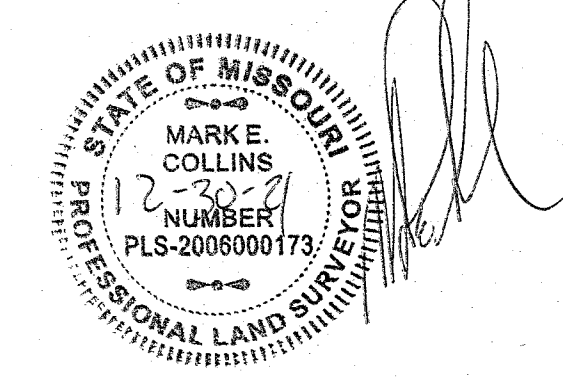

PROJECT TITLE:
 As-Built Plans for:
 Fort Zumwalt School District
 Professional Development Center

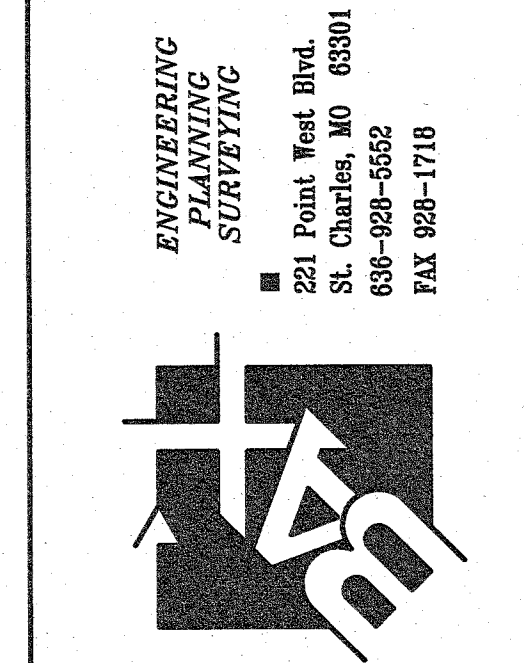

DISCLAIMER OF RESPONSIBILITY:
 I hereby certify that the documents intended to be disseminated by me and the related to this sheet, and I hereby disclaim any responsibility for all other drawings, specifications, estimates, reports or other documents or instruments relating to or intended to be used for any part or parts of the architectural or engineering project or survey.



REVISIONS

NO.	DESCRIPTION

Developer / Owner:
 Fort Zumwalt School District
 555 E. Terra Lane
 O'Fallon, MO 63367

P+Z No. 19-009658
Approval Date: 11/07/19
City No. #
Page No.

UNDERGROUND UTILITIES HAVE BEEN PLOTTED FROM AVAILABLE INFORMATION AND THEREFORE THEIR LOCATIONS SHALL BE CONSIDERED APPROXIMATE ONLY. THE VERIFICATION OF THE LOCATION OF ALL UNDERGROUND UTILITIES, EITHER SHOWN OR NOT SHOWN ON THESE PLANS SHALL BE THE RESPONSIBILITY OF THE CONTRACTOR, AND SHALL BE LOCATED PRIOR TO ANY GRADING OR CONSTRUCTION OF THE IMPROVEMENTS.

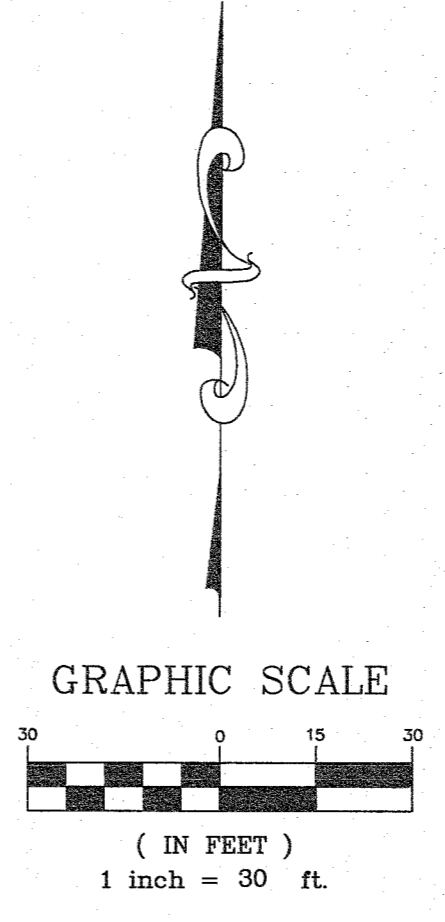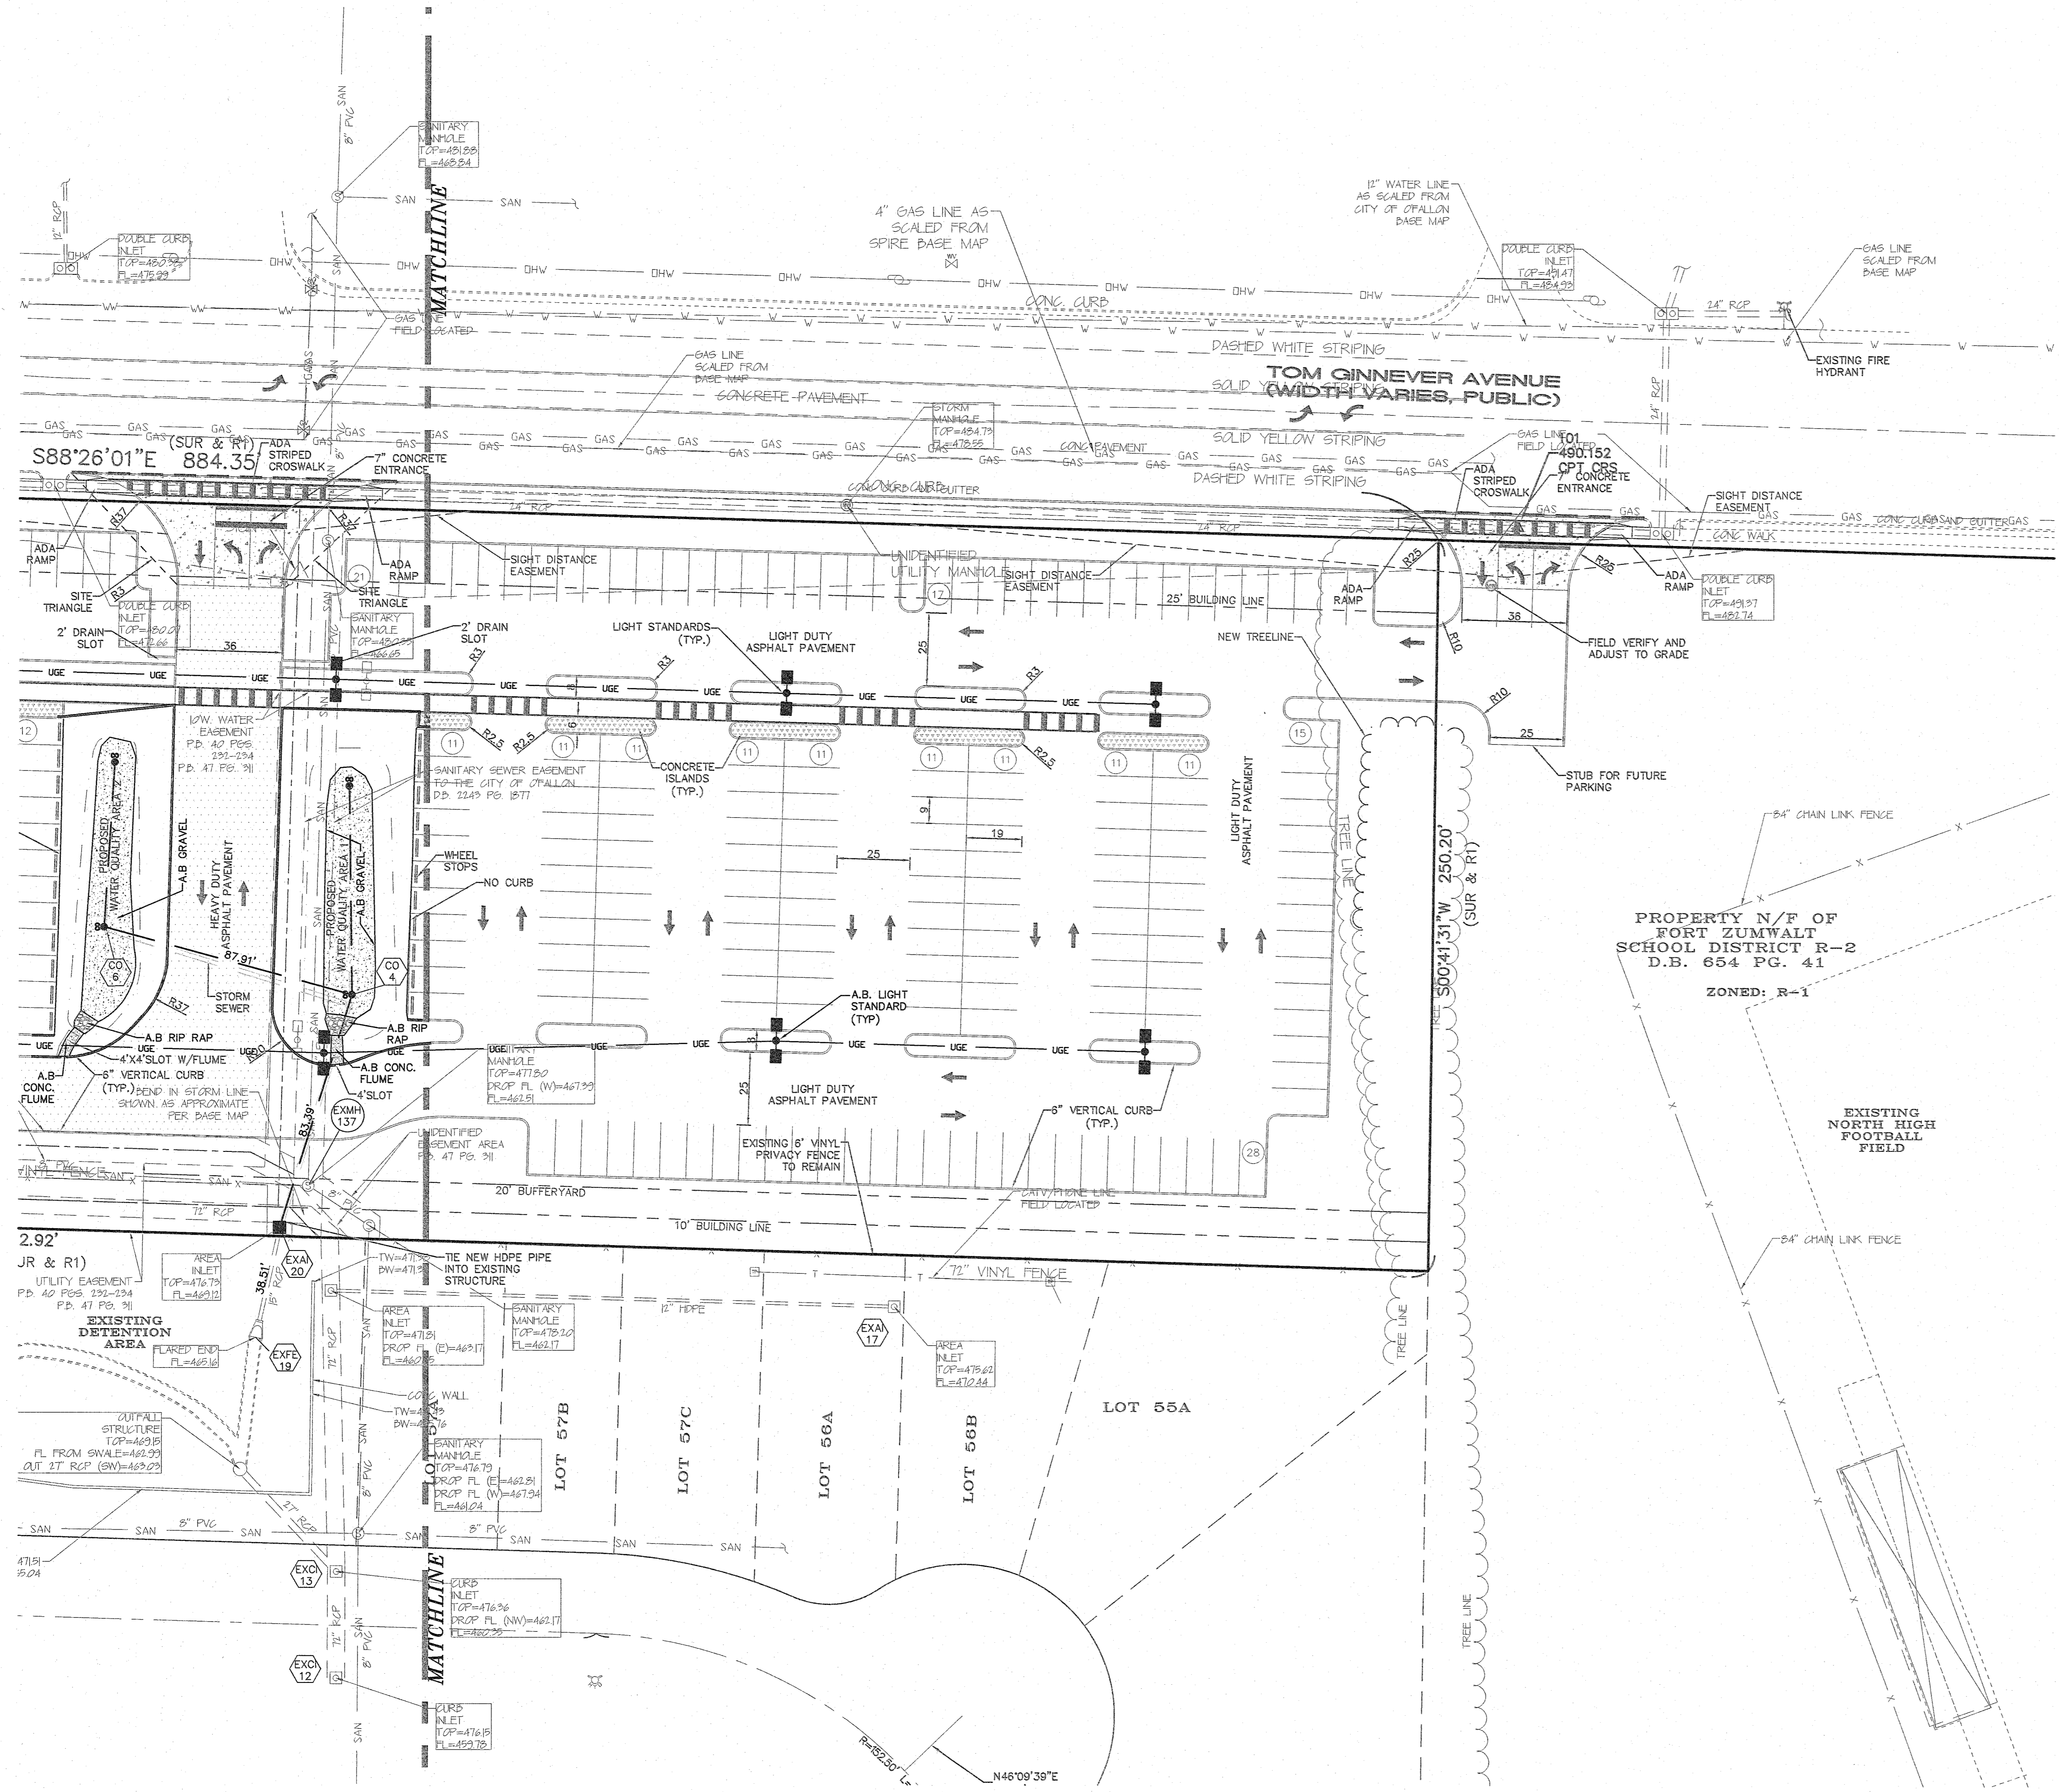


AS-BUILT PUBLIC UTILITY FINAL MEASUREMENTS

THE FOLLOWING UTILITIES HAVE BEEN LOCATED AND MEASURED AND THE RESULTS OF THOSE MEASUREMENTS ARE SHOWN ON THIS SET OF FINAL MEASUREMENT PLANS:

- STORM SEWERS, STORM SEWER LENGTHS, STORM SEWER PIPE SIZES, STORM SEWER FLOWLINES AND DEPTHS OF STORM SEWER STRUCTURES.
- SANITARY SEWERS, SANITARY SEWER LENGTHS, SANITARY SEWER PIPE SIZES, SANITARY SEWER FLOWLINES AND DEPTHS OF SANITARY SEWER STRUCTURES.
- FIRE HYDRANTS
- WATER VALVES
- LIGHT STANDARDS
- TOPOGRAPHY OF WATER QUALITY AREAS

ALL PUBLIC UTILITIES SHOWN HEREON AS BEING AS-BUILT ARE LOCATED WITHIN DESIGNATED EXISTING OR PROPOSED EASEMENTS.


BAX ENGINEERING COMPANY, INC.
 MARK E. COLLINS
 MISSOURI PROFESSIONAL LAND SURVEYOR #200600173

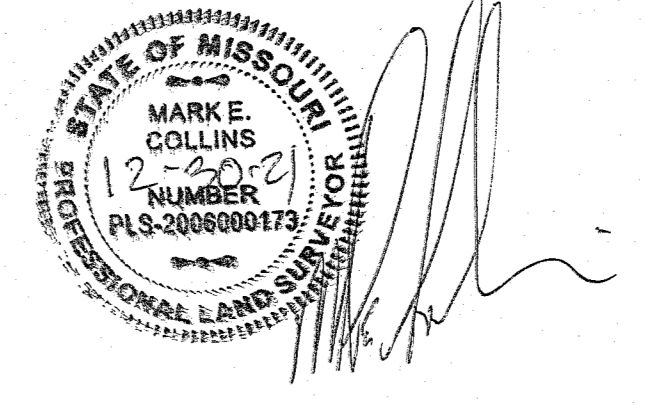

PROJECT TITLE:
 As-Built Plans for:
 Fort Zumwalt School District
 Professional Development Center

Box Project # 19-7754 Issue Date: 12/30/2021

ENGINEERING
 SURVEYING
 221 Park West Blvd.
 St. Charles, MO 63001
 636-929-5552
 FAX 636-929-1710

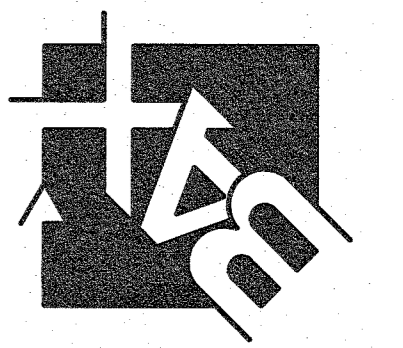

DISCLAIMER OF RESPONSIBILITY
 I hereby certify that the documents intended to be authorized by my seal are limited to this sheet, and I hereby disclaim any responsibility for other drawings, specifications, estimates, reports or other documents or instruments relating to or intended to be used for any part or parts of the architectural or engineering project or survey.

Bax Engineering Company, Inc.
 Missouri State Certificate of Authority
 Engineering #000655
 Missouri State Certificate of Authority
 Surveying #00144

REVISIONS

NO.	DATE	DESCRIPTION

Developer / Owner:
 Fort Zumwalt School District
 555 E. Terra Lane
 O'Fallon, MO 63367



SITE PLAN

P+Z No. 19-009658
 Approval Date: 11/07/19

City No. #

Page No. C5

UNDERGROUND UTILITIES HAVE BEEN PLOTTED FROM AVAILABLE INFORMATION AND THEREFORE THEIR LOCATIONS SHALL BE CONSIDERED APPROXIMATE ONLY. THE VERIFICATION OF THE LOCATION OF ALL UNDERGROUND UTILITIES, EITHER SHOWN OR NOT SHOWN ON THESE PLANS SHALL BE THE RESPONSIBILITY OF THE CONTRACTOR, AND SHALL BE LOCATED PRIOR TO ANY GRADING OR CONSTRUCTION OF THE IMPROVEMENTS.

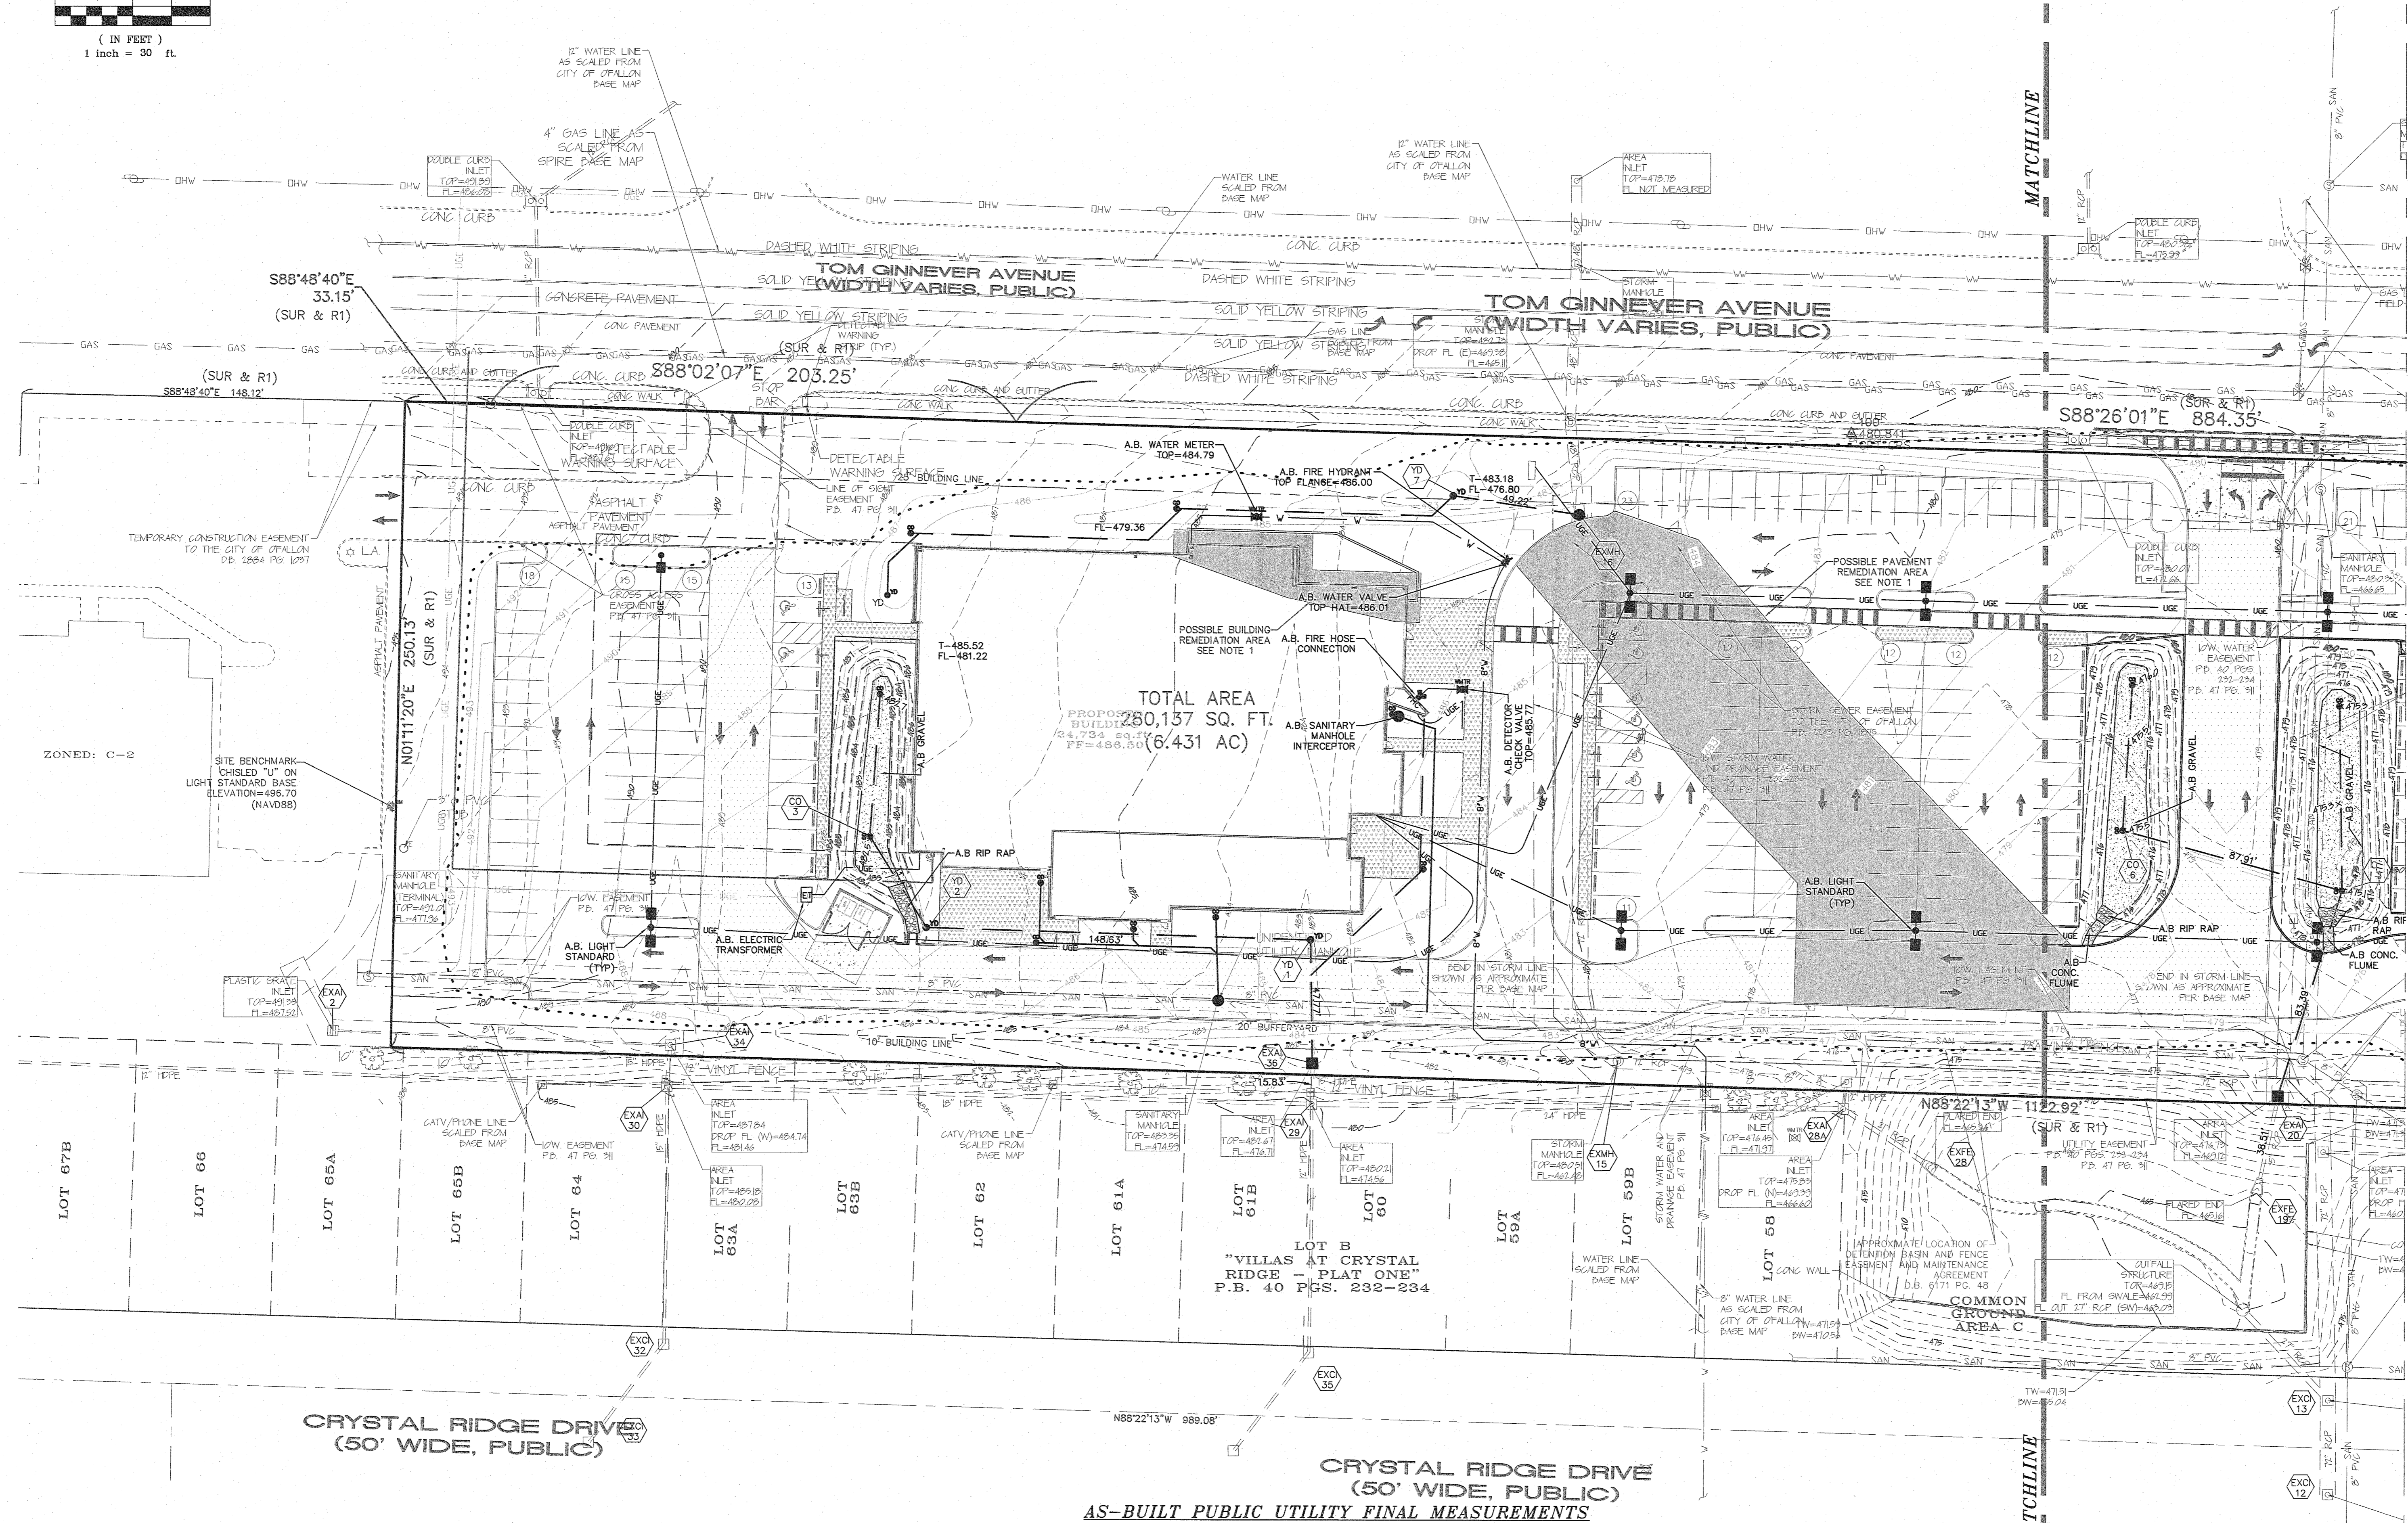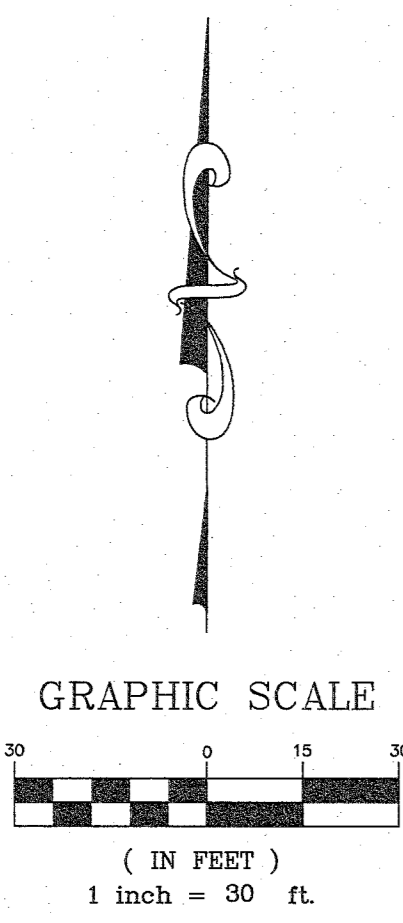


THE FOLLOWING UTILITIES HAVE BEEN LOCATED AND MEASURED AND THE RESULTS OF THOSE MEASUREMENTS ARE SHOWN ON THIS SET OF FINAL MEASUREMENT PLANS.

- STORM SEWERS, STORM SEWER LENGTHS, STORM SEWER PIPE SIZES, STORM SEWER FLOWLINES AND DEPTHS OF STORM SEWER STRUCTURES.
- SANITARY SEWERS, SANITARY SEWER LENGTHS, SANITARY SEWER PIPE SIZES, SANITARY SEWER FLOWLINES AND DEPTHS OF SANITARY SEWER STRUCTURES.
- FIRE HYDRANTS
- WATER VALVES
- LIGHT STANDARDS
- TOPOGRAPHY OF WATER QUALITY AREAS

ALL PUBLIC UTILITIES SHOWN HEREON AS BEING AS-BUILT ARE LOCATED WITHIN DESIGNATED EXISTING OR PROPOSED EASEMENTS.


BAX ENGINEERING COMPANY, INC.
 MARK E. COLLINS
 MISSOURI PROFESSIONAL LAND SURVEYOR #2006000173

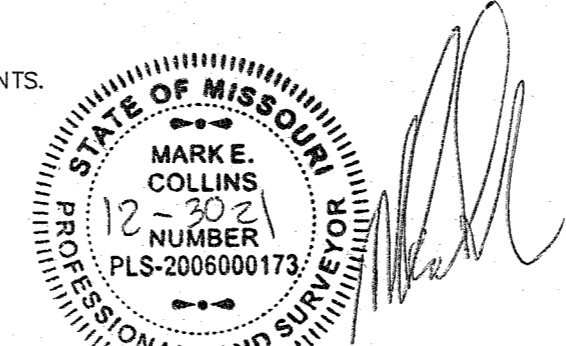

UNDERGROUND UTILITIES HAVE BEEN PLOTTED FROM AVAILABLE INFORMATION AND THEREFORE THEIR LOCATIONS SHALL BE CONSIDERED APPROXIMATE ONLY. THE VERIFICATION OF THE LOCATION OF ALL UNDERGROUND UTILITIES, EITHER SHOWN OR NOT SHOWN ON THESE PLANS SHALL BE THE RESPONSIBILITY OF THE CONTRACTOR, AND SHALL BE LOCATED PRIOR TO ANY GRADING OR CONSTRUCTION OF THE IMPROVEMENTS.

PROJECT TITLE:
 As-Built Plans for:
 Fort Zumwalt School District
 Professional Development Center

**ENGINEERING
 PLANNING
 SURVEYING**
 Bax Engineering Company, Inc.
 221 Point West Blvd.
 St. Charles, MO 63301
 636-629-0522
 FAX 636-629-1716

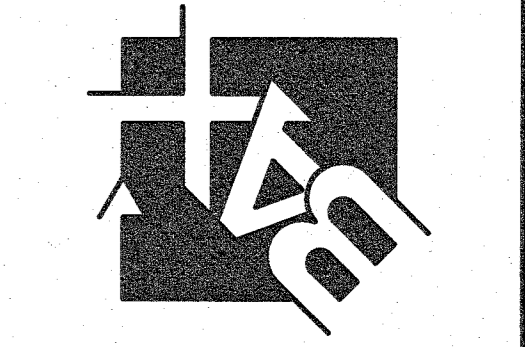

DISCLAIMER OF RESPONSIBILITY
 I hereby certify that the documents intended to be authorized by my seal are limited to the sheet, and I hereby disclaim any responsibility for all other documents or instruments relating to or intended to be used for any part or parts of the architectural or engineering project or survey.

Bax Engineering Company, Inc.
 Missouri State Certificate of Authority
 Engineering #000655
 Missouri State Certificate of Authority
 Surveying #000144

REVISIONS

NO.	DATE	DESCRIPTION

Developer / Owner:
 Fort Zumwalt School District
 555 E. Terra Lane
 O'Fallon, MO 63367


P+Z No. 19-009558
Approval Date: 11/07/19

City No. #

Page No. C6

GRADING PLAN

Box Project # 19-7514 Issue Date: 12/30/2021

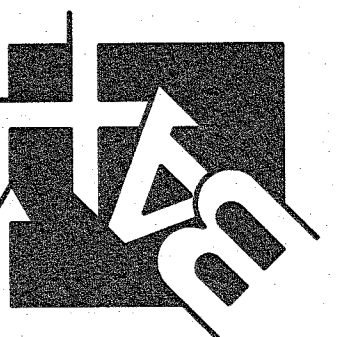

DISCLAIMER OF RESPONSIBILITY
I hereby certify that the documents intended to be authorized by my seal are limited to this sheet, and I hereby disclaim any responsibility for other drawings, specifications, estimates, reports or other documents or instruments relating to or intended to be used for any part or parts of the architectural or engineering project or survey.

Box Engineering Company, Inc.
Missouri State Certificate of Authority
Engineering #000655
Missouri State Certificate of Authority
Surveying #00144



REVISIONS

NO.	DESCRIPTION

Developer / Owner:
Fort Zumwalt School District
555 E. Terra Lane
O'Fallon, MO 63367

GRADING PLAN

P+Z No. 19-009658
Approval Date: 11/07/19
City No. #
Page No.

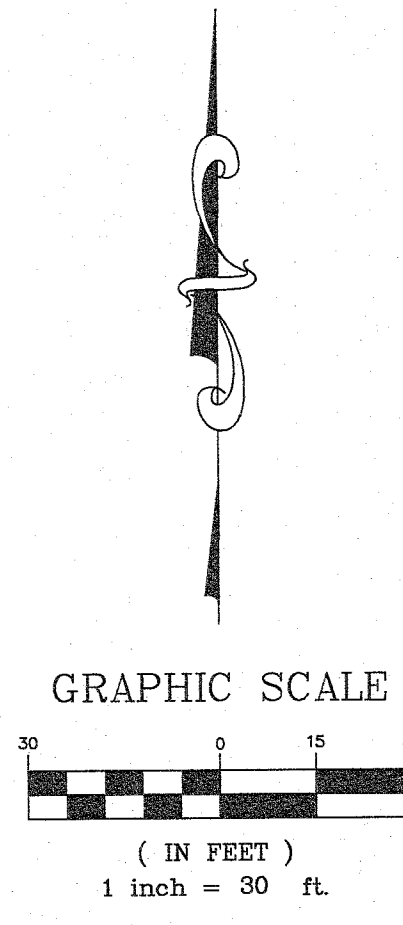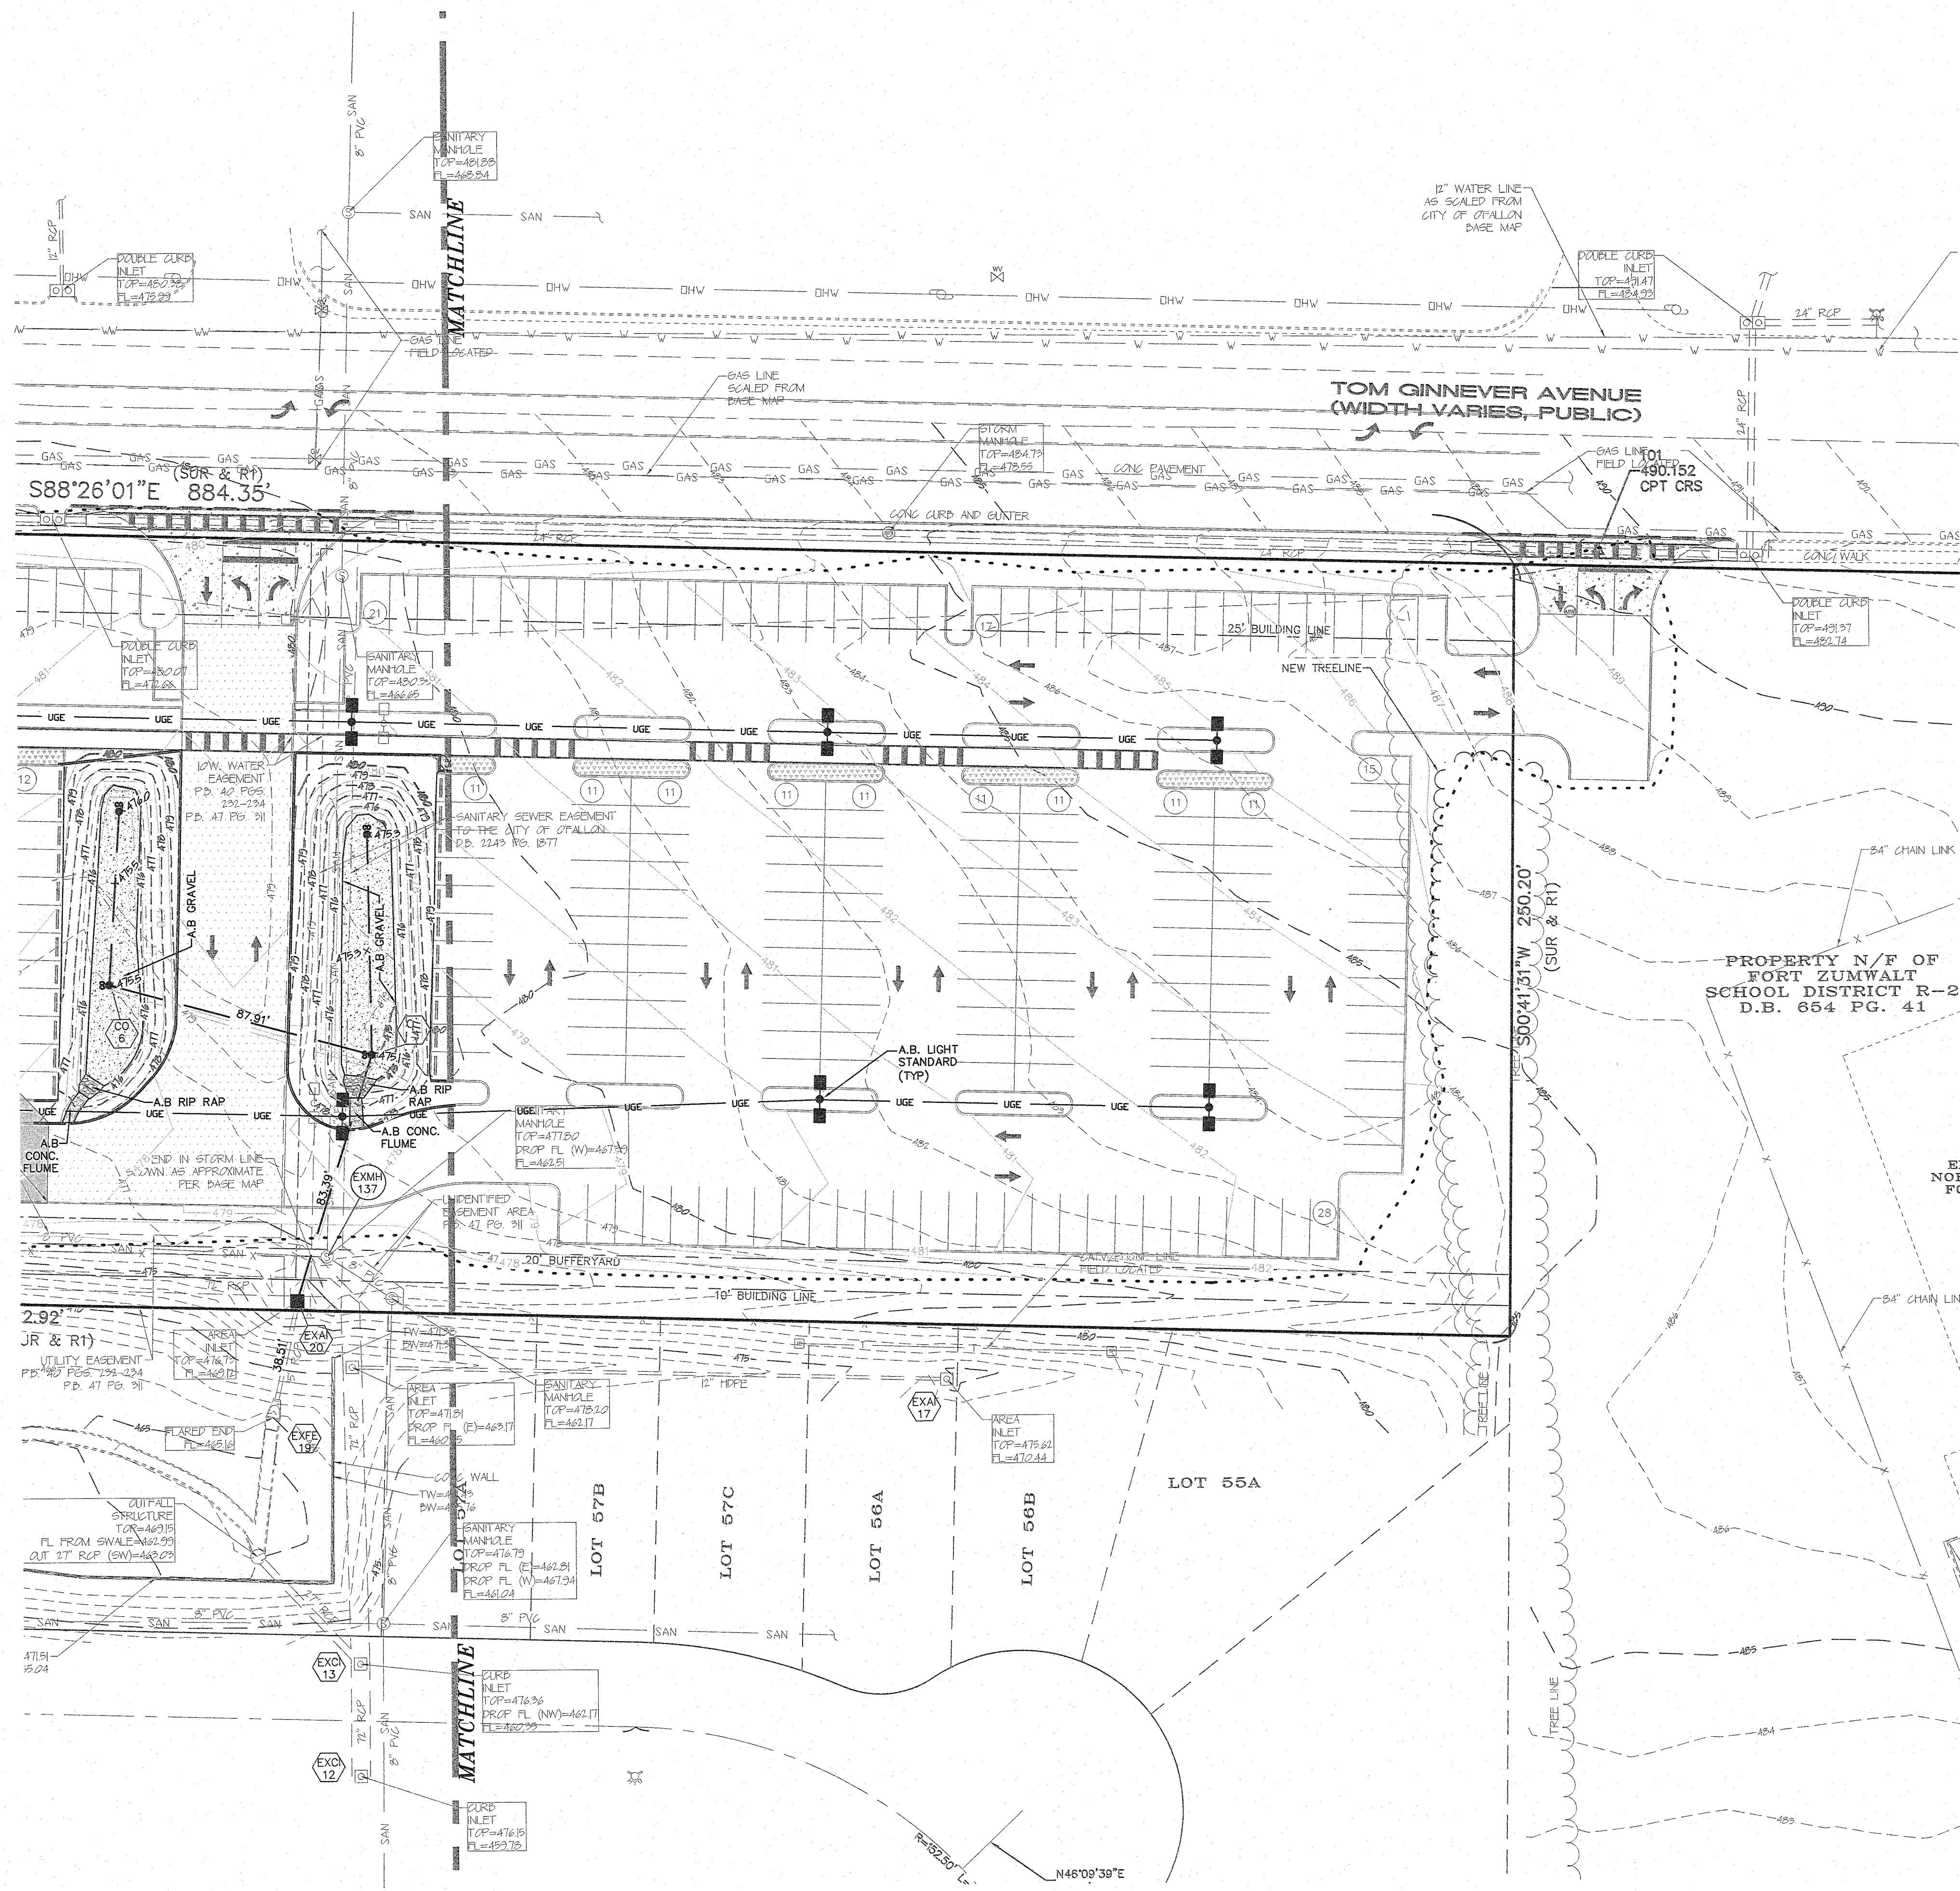


AS-BUILT PUBLIC UTILITY FINAL MEASUREMENTS

THE FOLLOWING UTILITIES HAVE BEEN LOCATED AND MEASURED AND THE RESULTS OF THOSE MEASUREMENTS ARE SHOWN ON THIS SET OF FINAL MEASUREMENT PLANS:





- STORM SEWERS, STORM SEWER LENGTHS, STORM SEWER PIPE SIZES, STORM SEWER FLOWLINES AND DEPTHS OF STORM SEWER STRUCTURES.
- SANITARY SEWERS, SANITARY SEWER LENGTHS, SANITARY SEWER PIPE SIZES, SANITARY SEWER FLOWLINES AND DEPTHS OF SANITARY SEWER STRUCTURES.
- FIRE HYDRANTS
- WATER VALVES
- LIGHT STANDARDS
- TOPOGRAPHY OF WATER QUALITY AREAS

ALL PUBLIC UTILITIES SHOWN HEREON AS BEING AS-BUILT ARE LOCATED WITHIN DESIGNATED EXISTING OR PROPOSED EASEMENTS.


BAX ENGINEERING COMPANY, INC.
MARK E. COLLINS
MISSOURI PROFESSIONAL LAND SURVEYOR #2006000173

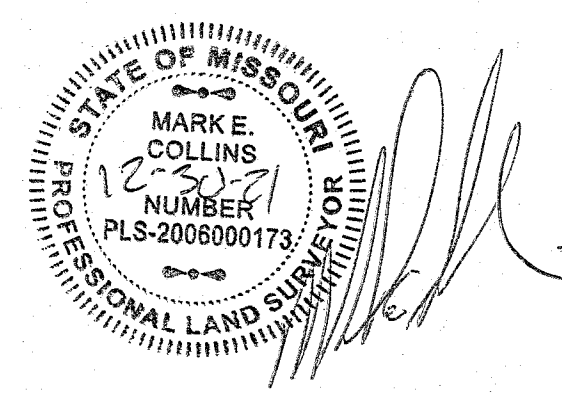


UNDERGROUND UTILITIES HAVE BEEN PLOTTED FROM AVAILABLE INFORMATION AND THEREFORE THEIR LOCATIONS SHALL BE CONSIDERED APPROXIMATE ONLY. THE VERIFICATION OF THE LOCATION OF ALL UNDERGROUND UTILITIES, EITHER SHOWN OR NOT SHOWN ON THESE PLANS SHALL BE THE RESPONSIBILITY OF THE CONTRACTOR, AND SHALL BE LOCATED PRIOR TO ANY GRADING OR CONSTRUCTION OF THE IMPROVEMENTS.

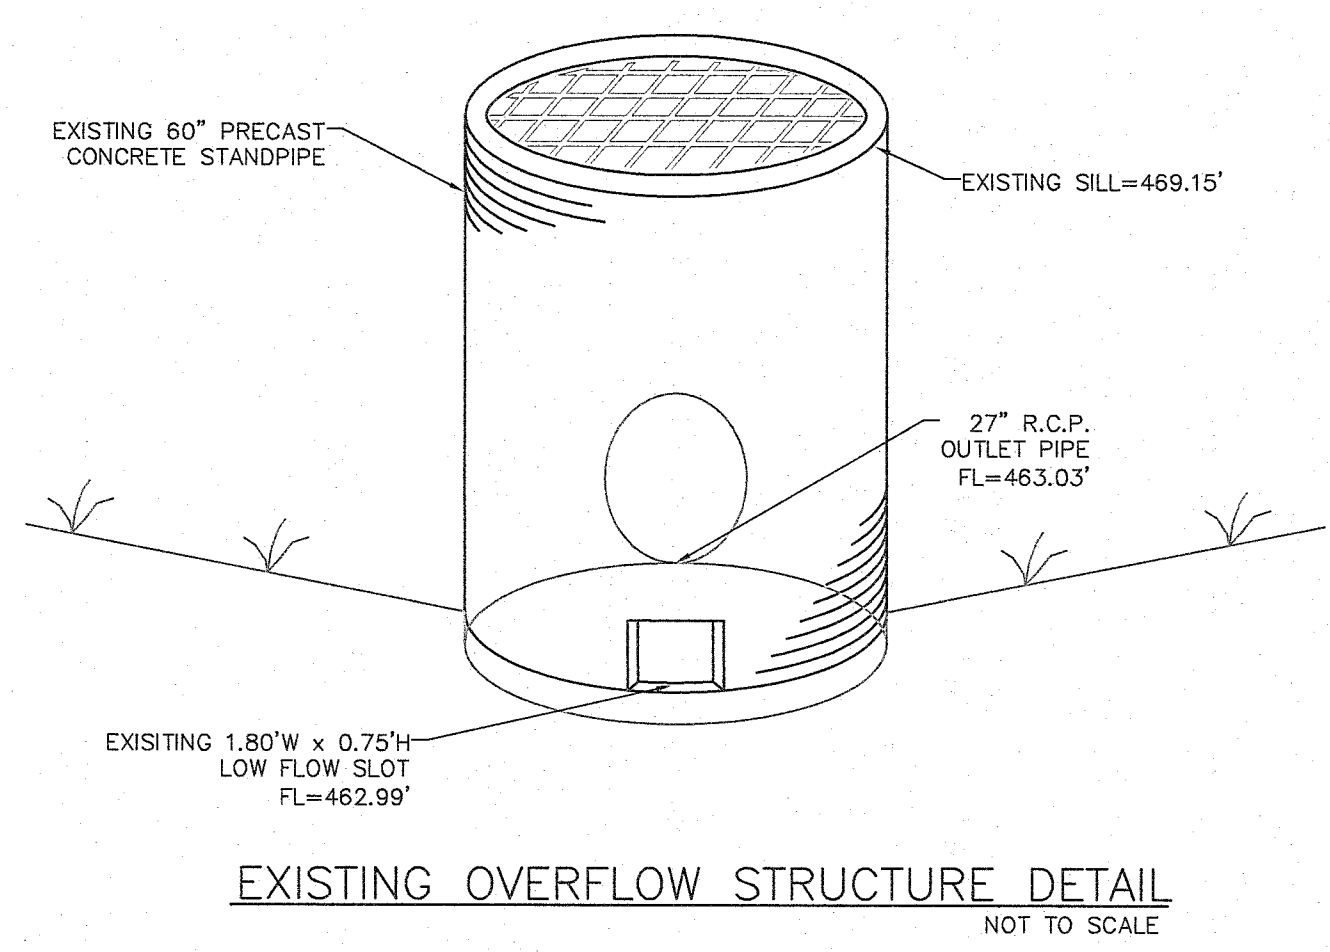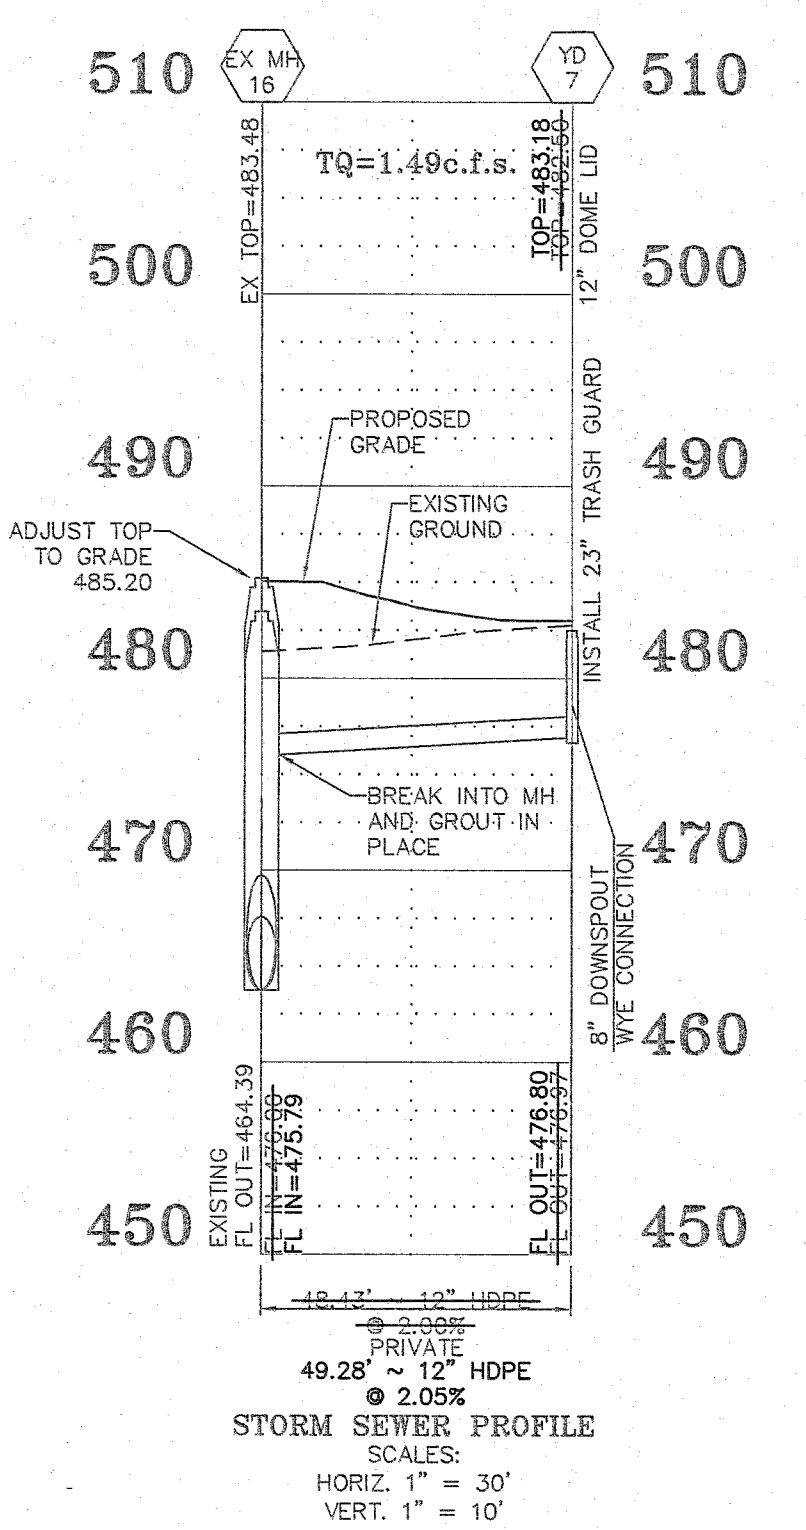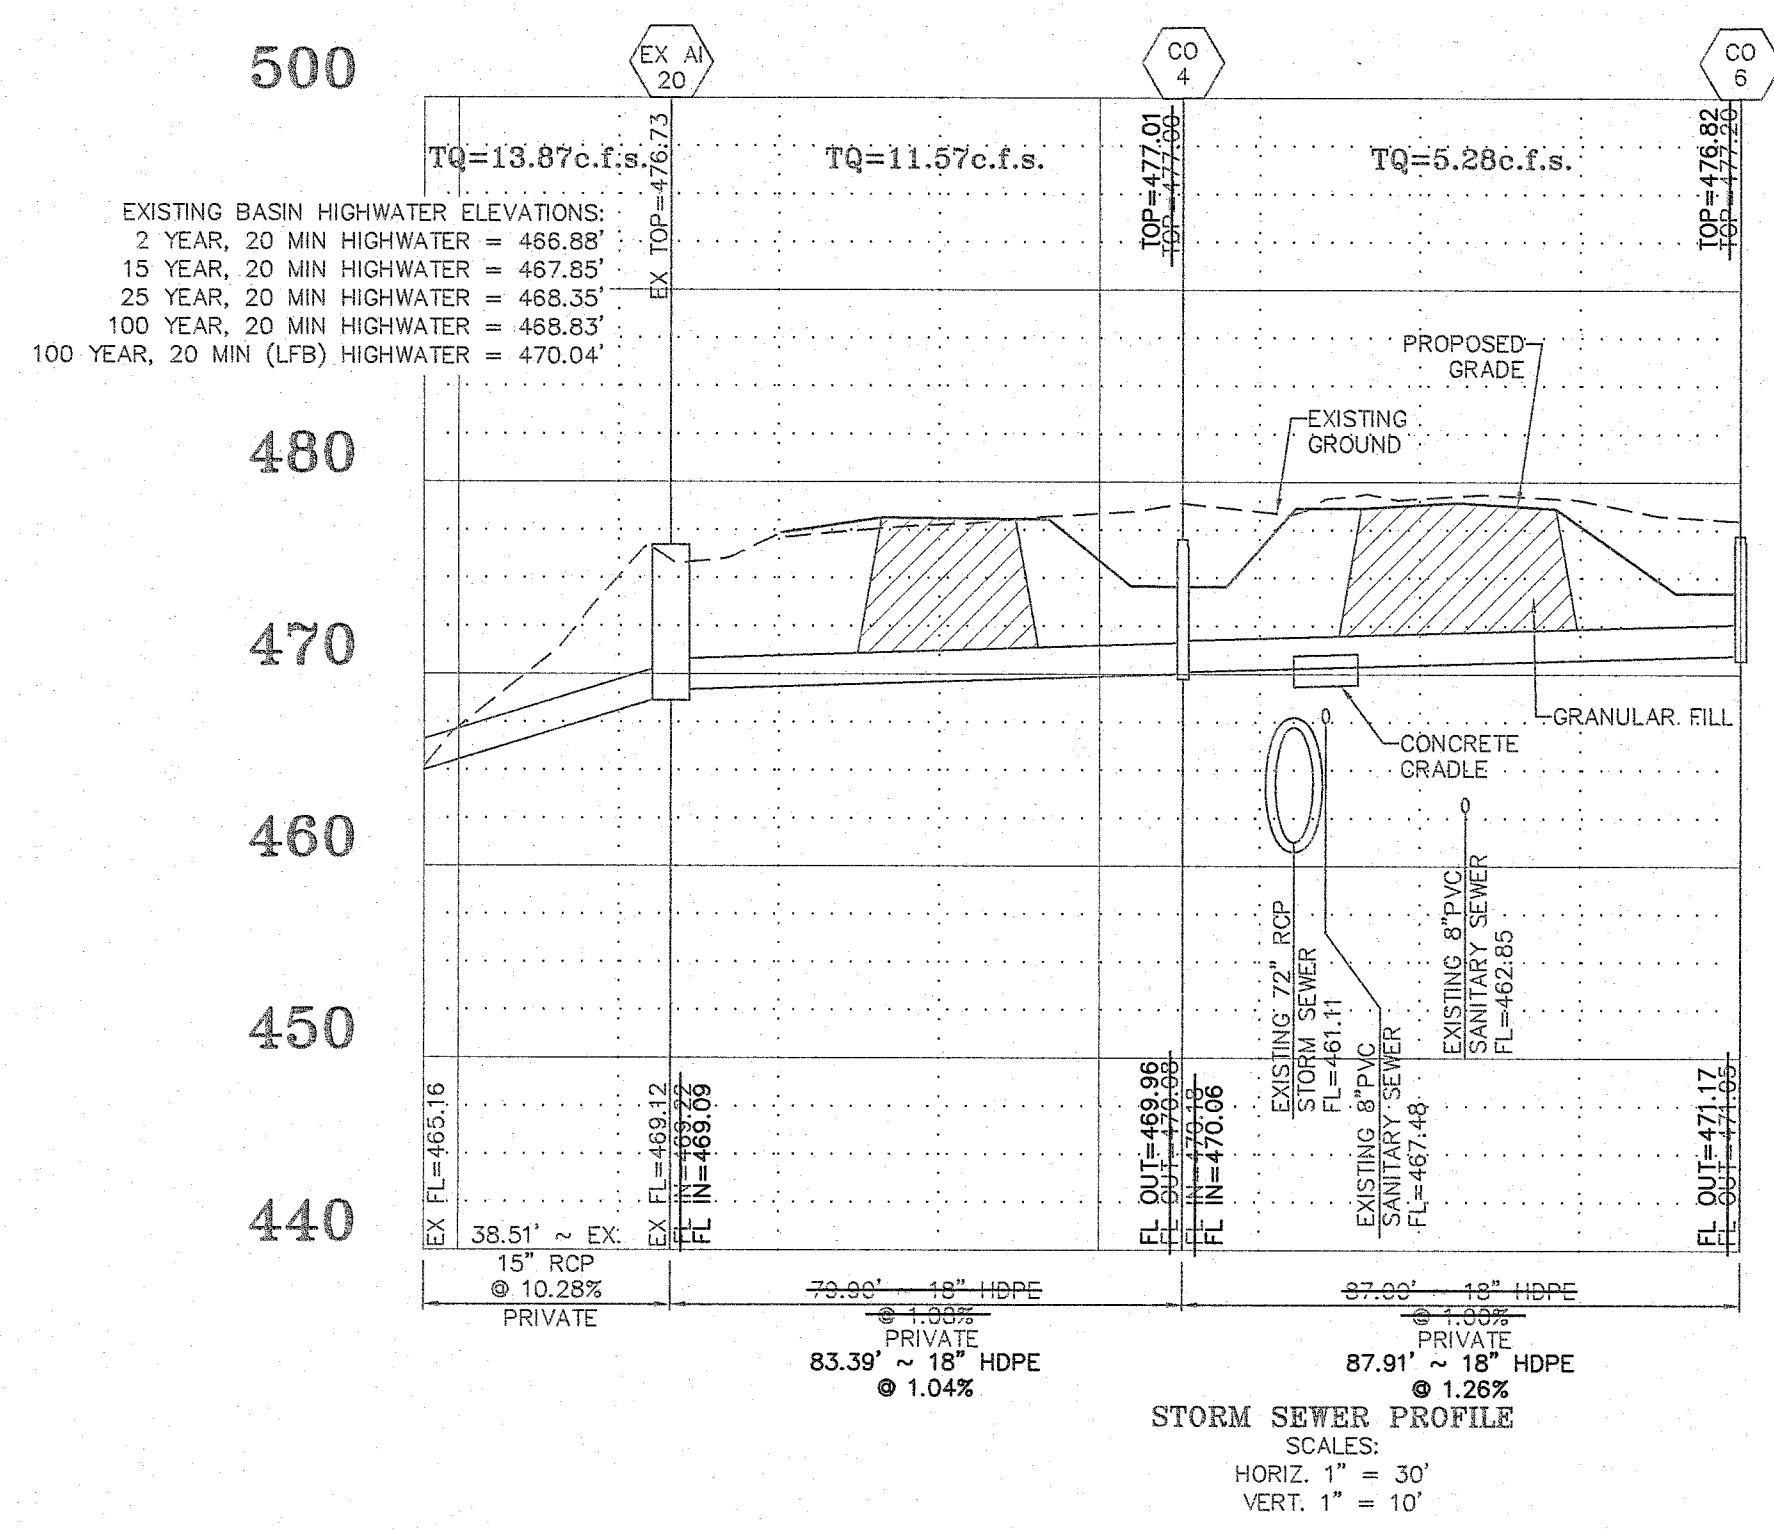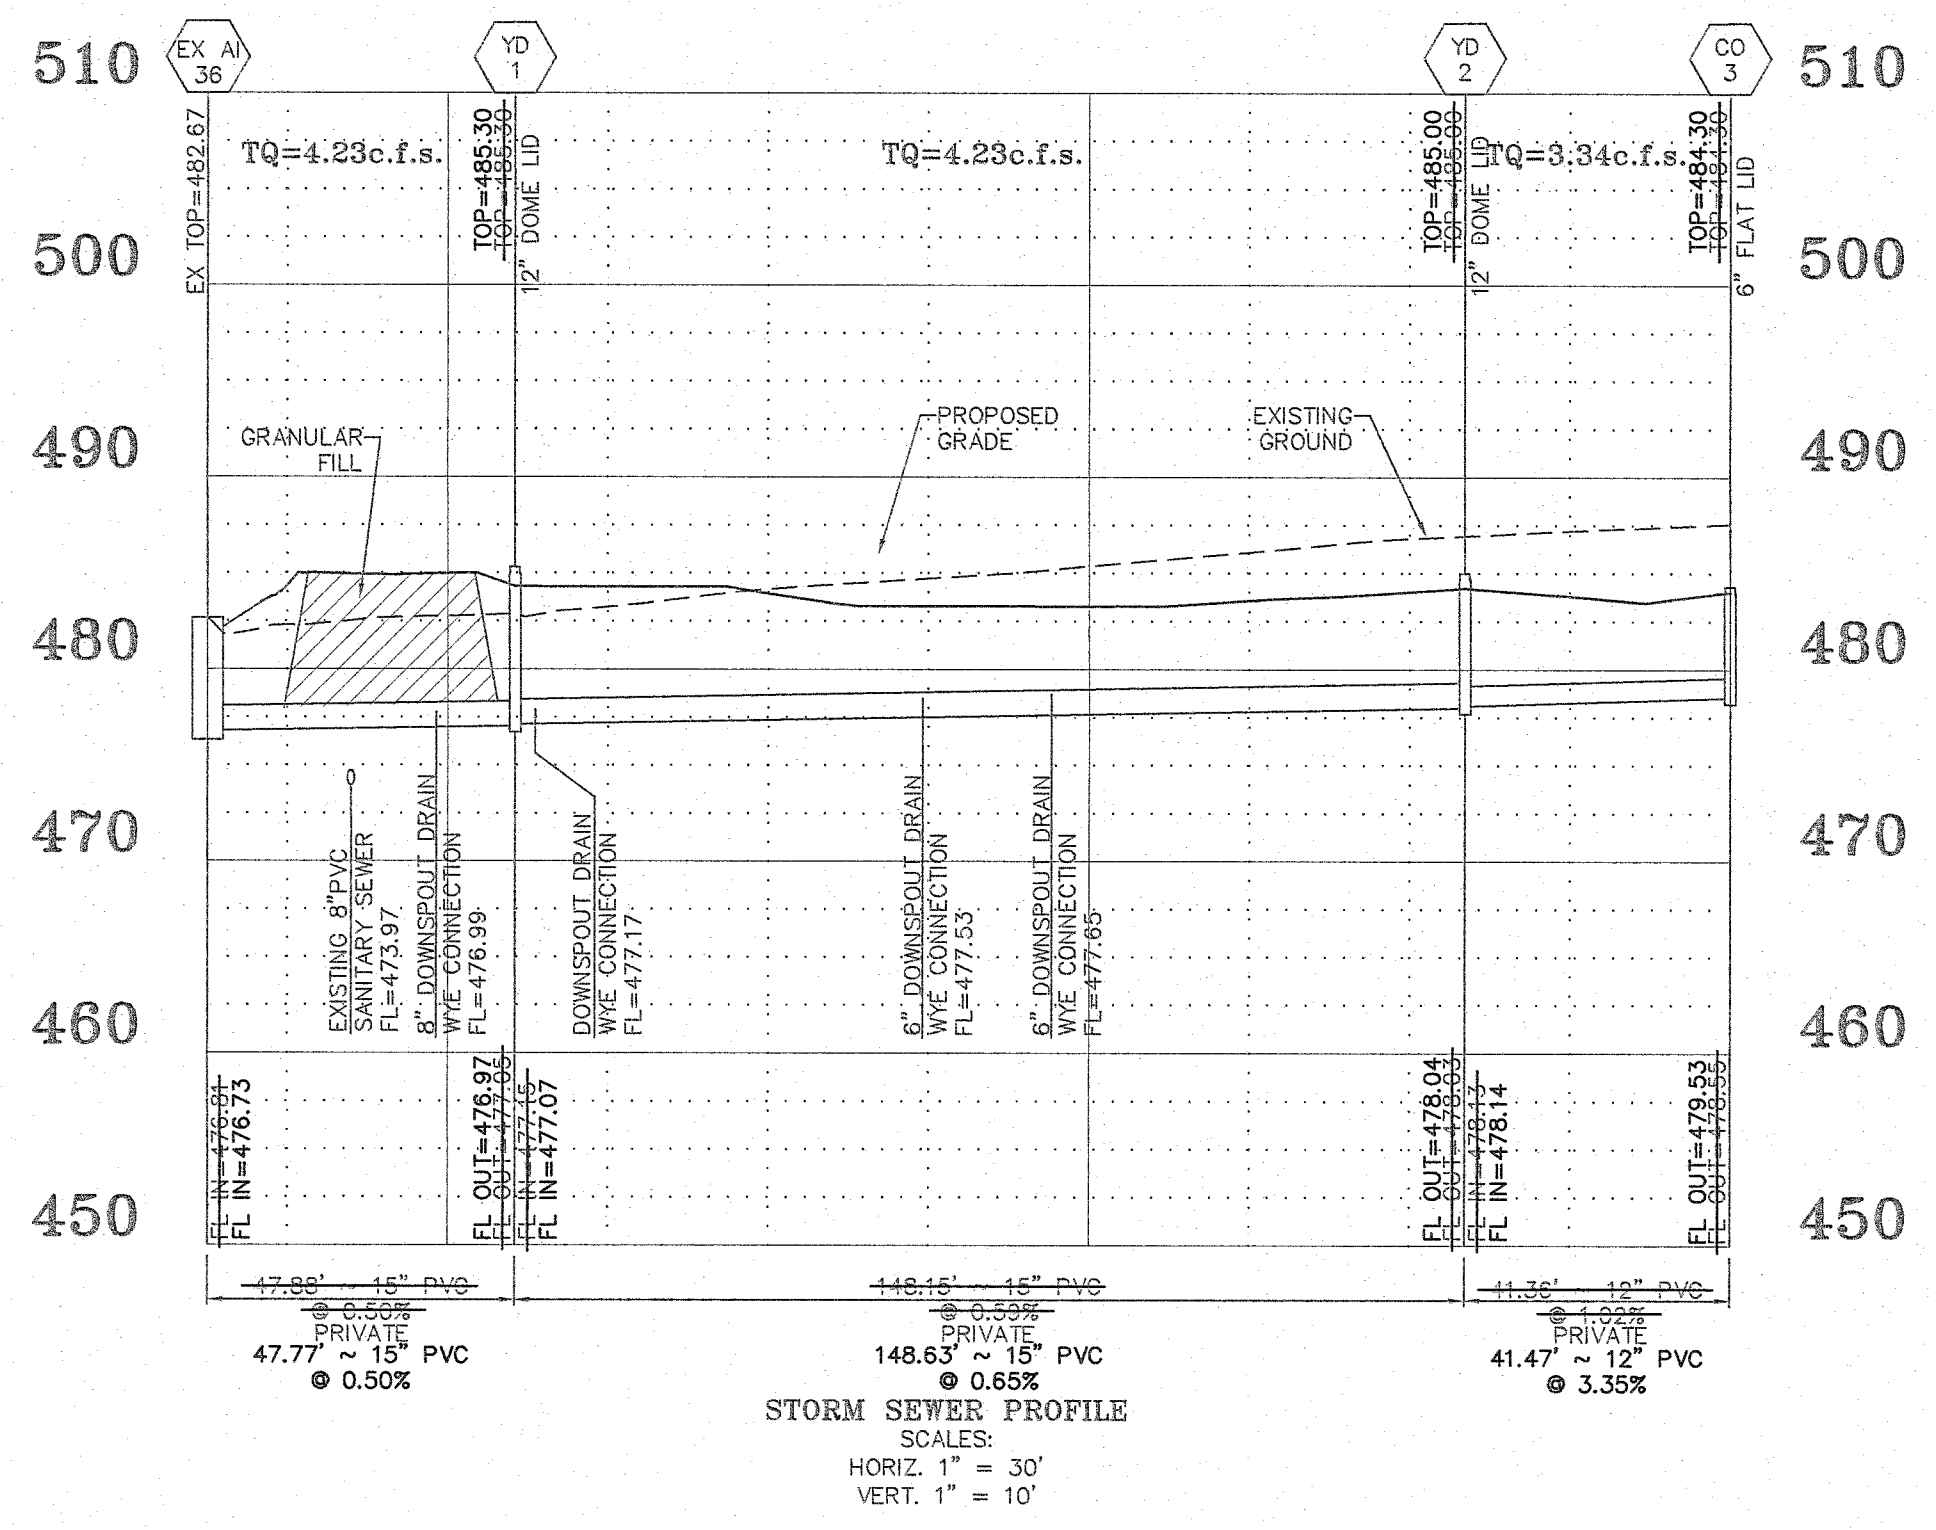

PLANT SPACING 'D'	ROW SPACING 'A'	NUMBER OF PLANTS/SQFT
60"	52.0"	0.045
48"	41.5"	0.062

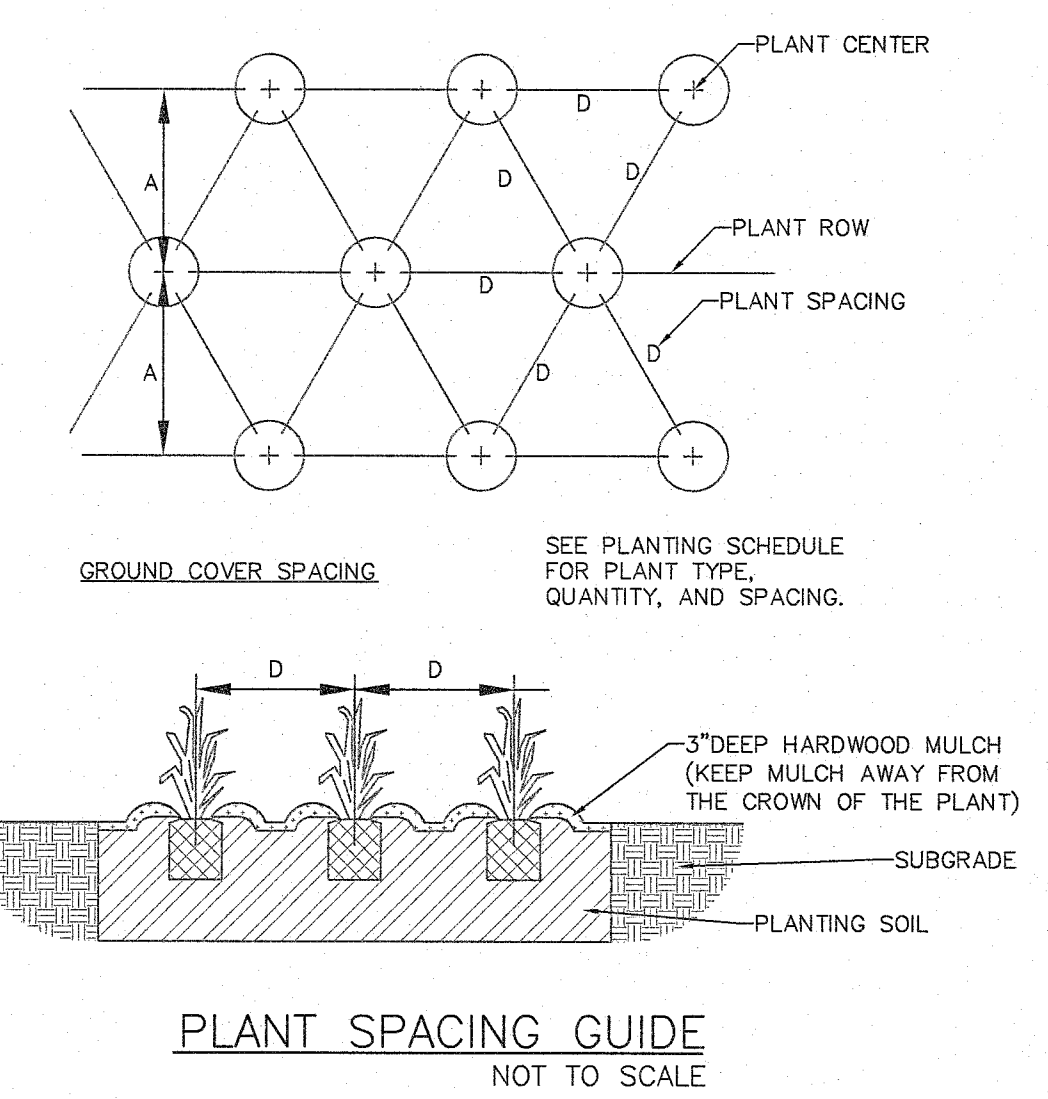

BASIN	GRADE	CLEANOUT	UNDERDRAIN
1	-475.50	475.3	-477.00 476.96
2	-475.30	476.0	-477.20 477.45
3	-482.80	472.7	-484.30 484.22

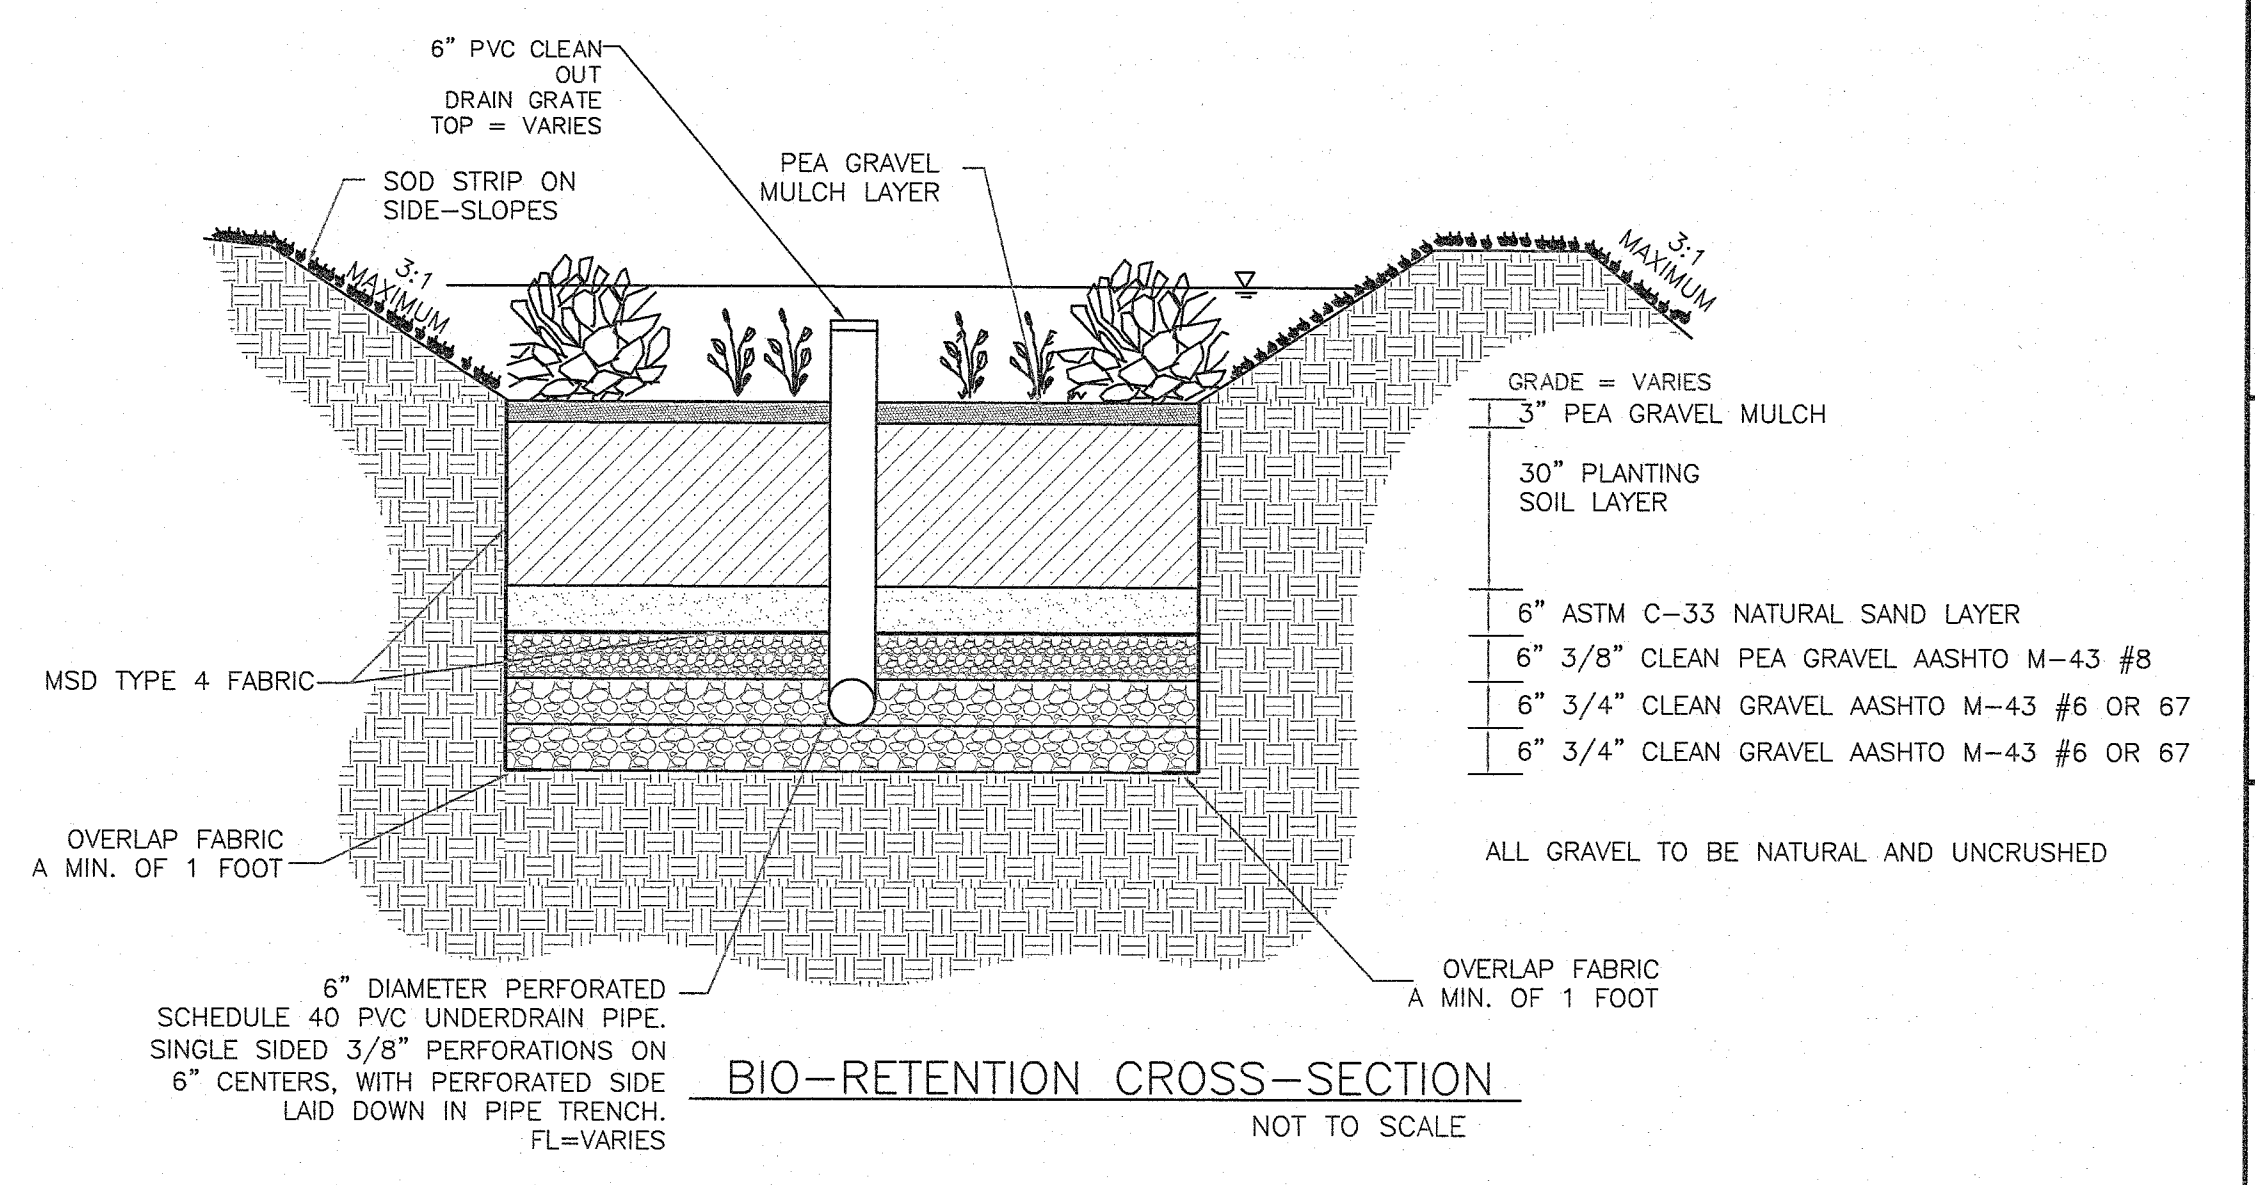

ITEM	LATIN NAME	COMMON NAME	BASIN 1	SPACING	BASIN 2	SPACING	BASIN 3	SPACING
A	Carex grayi	Bur sedge	18	60"	16	60"	20	48"
B	Carex vulpinoidea	Fox sedge	5	60"	18	60"	23	48"
C	Chosmanthium latifolium	River oats	4	60"	7	60"	6	48"

Water Availability	Required Planting Period	Minimum Container Size	Water Requirement First 3 Weeks*	Water Requirement After 3 Weeks*	Maximum Mulch Depth***
No ability to water after	Late Feb. - April only	2.25' x 3.75' or larger	Water each plug immediately	Water each plug immediately	1.5 for plugs
Manual watering with standard spritzler	Late Feb. - Early June Sept. - October	4.5' x 5' (quart) or larger in summer & fall	1" (60 min) every 4 days in spring and fall	1" (60 min) every 7 days until plants established***	1.5" for plugs
Automatic irrigation (set to water more frequently than normal during first two months after planting)	Late Feb. - Early Oct.	2.25' x 3.75' (plug) or larger in spring	1" (60 min) every 4 days in spring and fall	1" (60 min) every 7 days until plants established***	1.5" for plugs
		4.5' x 5' (quart) or larger in summer & fall	1" (60 min) every 3 days in summer	1" (60 min) every 7 days until plants established***	2.5" for quarts

*This water amount includes natural rainfall. If you get a 1/2 inch of natural rain then you will need to add a 1/2 inch of water to meet the 1 inch requirement.
 **Requires transport of water to the planting site in large containers and pouring enough water onto each plant (after planting) to moisten the entire planting plug.
 ***Plants are established when roots have grown out of the container soil and into the native soil and this normally takes 3-4 months for most perennials and grasses and up to 6-7 months for trees and shrubs.
 ****Shredded leaf compost is recommended for use with perennials and grasses. Shredded bark mulch is recommended for tree and shrub plantings at a depth of 3 inches.

PLANTING, WATER, AND MULCH REQUIREMENTS



AS-BUILT PUBLIC UTILITY FINAL MEASUREMENTS

THE FOLLOWING UTILITIES HAVE BEEN LOCATED AND MEASURED AND THE RESULTS OF THOSE MEASUREMENTS ARE SHOWN ON THIS SET OF FINAL MEASUREMENT PLANS:

- STORM SEWERS, STORM SEWER LENGTHS, STORM SEWER PIPE SIZES, STORM SEWER FLOWLINES AND DEPTHS OF STORM SEWER STRUCTURES.
- SANITARY SEWERS, SANITARY SEWER LENGTHS, SANITARY SEWER PIPE SIZES, SANITARY SEWER FLOWLINES AND DEPTHS OF SANITARY SEWER STRUCTURES.
- FIRE HYDRANTS
- WATER VALVES
- LIGHT STANDARDS
- TOPOGRAPHY OF WATER QUALITY AREAS

ALL PUBLIC UTILITIES SHOWN HEREON AS BEING AS-BUILT ARE LOCATED WITHIN DESIGNATED EXISTING OR PROPOSED EASEMENTS.

BAX ENGINEERING COMPANY, INC.
 MARK E. COLLINS
 MISSOURI PROFESSIONAL LAND SURVEYOR #2006000173

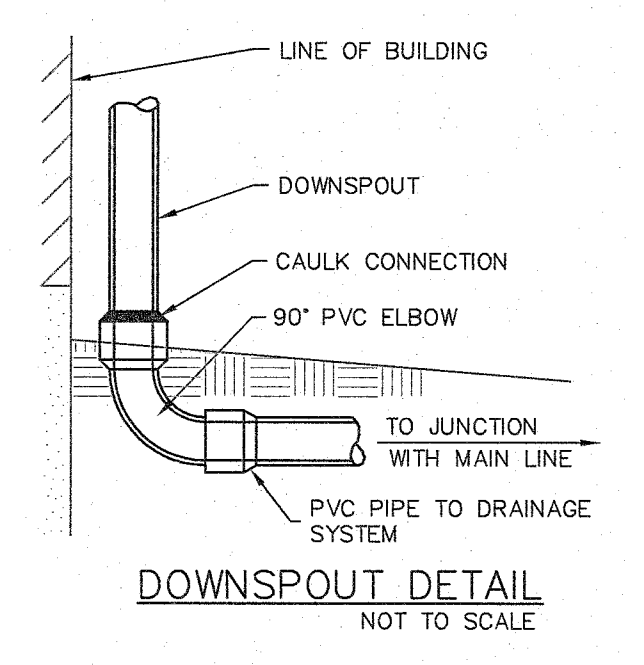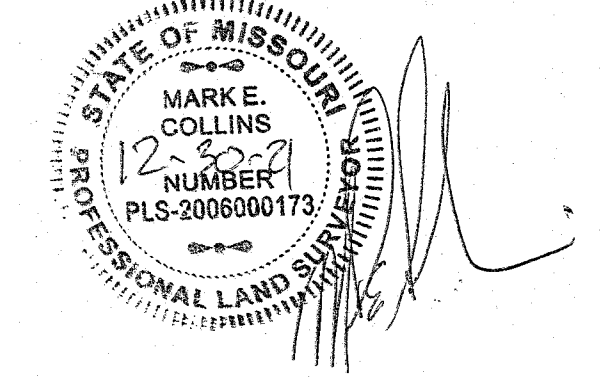


- CONTRACTOR INSTALLATION NOTES:**
- DURING CONSTRUCTION CONTRACTOR TO PROVIDE ANY TEMPORARY DITCHES OR PIPING IN AN EFFORT TO DIVERT UNWANTED WATERS TO ENTER BIOMASS DURING THE INSTALLATION. PROVIDE ANY ADDITIONAL SILTATION CONTROL AS REQUIRED BY CITY.
 - ONCE BASIN IS DUG OUT, TILL OR "RIP" BOTTOM OF BASIN, INSTALL FILTER FABRIC ON SLOPES OF TRENCH AND TACK IN PLACE.
 - BEGIN INSTALLING 6" OF 3/4" CLEAN GRAVEL IN LOOSE LIFT, DO NOT COMPACT.
 - LAY PERFORATED DRAINAGE PIPING AND OVERFLOW PIPING.
 - BEGIN PLACING 6" OF 3/4" CLEAN GRAVEL IN LOOSE LIFT, DO NOT COMPACT.
 - BEGIN PLACING 6" OF 3/8" CLEAN PEA GRAVEL IN LOOSE LIFT, DO NOT COMPACT.
 - BEGIN PLACING PLANTING SOIL AT THE REQUIRED DEPTHS FOR EACH BASIN IN LIFTS OF 12"-18" LOOSELY, DO NOT COMPACT.
 - FINISH GRADE BASIN SIDE SLOPES AND PLACE PLANTINGS.
 - BASIN PLANTINGS TO BE WATERED AND MAINTAINED FOR 60 DAYS BY CONTRACTOR.

Sieve Specifications	Percent Passing
9.5-mm (3/8-in.)	100
4.75-mm (No. 4)	95 to 100
2.36-mm (No. 6)	80 to 100
1.18-mm (No. 16)	60 to 85
600-um (No. 30)	25 to 60
300-um (No. 50)	5 to 30
150-um (No. 100)	0 to 10

- SAND SPECIFICATIONS:**
- Washed ASTM C33 Fine Aggregate Concrete Sand is utilized for stormwater management applications. In addition to the ASTM C-33 specification, sand must meet ALL of the following conditions:
- Sand must meet gradation requirements for ASTM C-33 Fine Aggregate Concrete Sand. AASHTO M-6 gradation is also applicable. (Known as Natural washed concrete sand)
 - Sand must be siliceous...no limestone based products may be used. If the material is white or gray in color it is probably not acceptable.
 - Sand must be clean. Natural, unwashed sand deposits may not be used. Likewise, sand that has been contaminated by improper storage or installation practices will be rejected.
 - Manufactured sand or stone dust is not acceptable under any circumstances.

Planting Soil Specifications:
 Sandy Loam or Loamy Sand should contain a minimum of 35 to 60 percent sand, by volume. The clay content for these soils should be less than 10 percent by volume. The soils shall be free of stones, stumps, roots, or other woody material over 1 inch in diameter. Placement of the planting soil should be in lifts of 12 to 18 inches and be placed loosely with no compaction.

- MAINTENANCE SCHEDULE:**
- THE PROPERTY OWNER WILL MAINTAIN THE BIORETENTION IN GOOD WORKING ORDER AND WILL BE INSPECTED EVERY 6 MONTHS FOR THE FOLLOWING:
 - SAID AREA SHALL BE CLEANED SHORTLY AFTER THE PROJECT IS COMPLETED AND EROSION CONTROL HAS BEEN REMOVED AND VEGETATION HAS BEEN ESTABLISHED.
 - AREA SHALL BE CLEANED OF ANY WEEDS, UNDERBRUSH, MILD GROWTH, DEBRIS OR LITTER.
 - PLANTINGS WILL BE EVALUATED AND ANY DEAD PLANT SHALL BE REPLACED.
 - IF ACCUMULATED SEDIMENT HAS CLOGGED THE SURFACE PORES OF THE RAIN GARDEN, THEN DRILLING OR PUNCHING SMALL HOLES INTO THE SURFACE LAYER SHALL BE DONE TO RESTORE INFILTRATION CAPACITY OF THE SOIL.

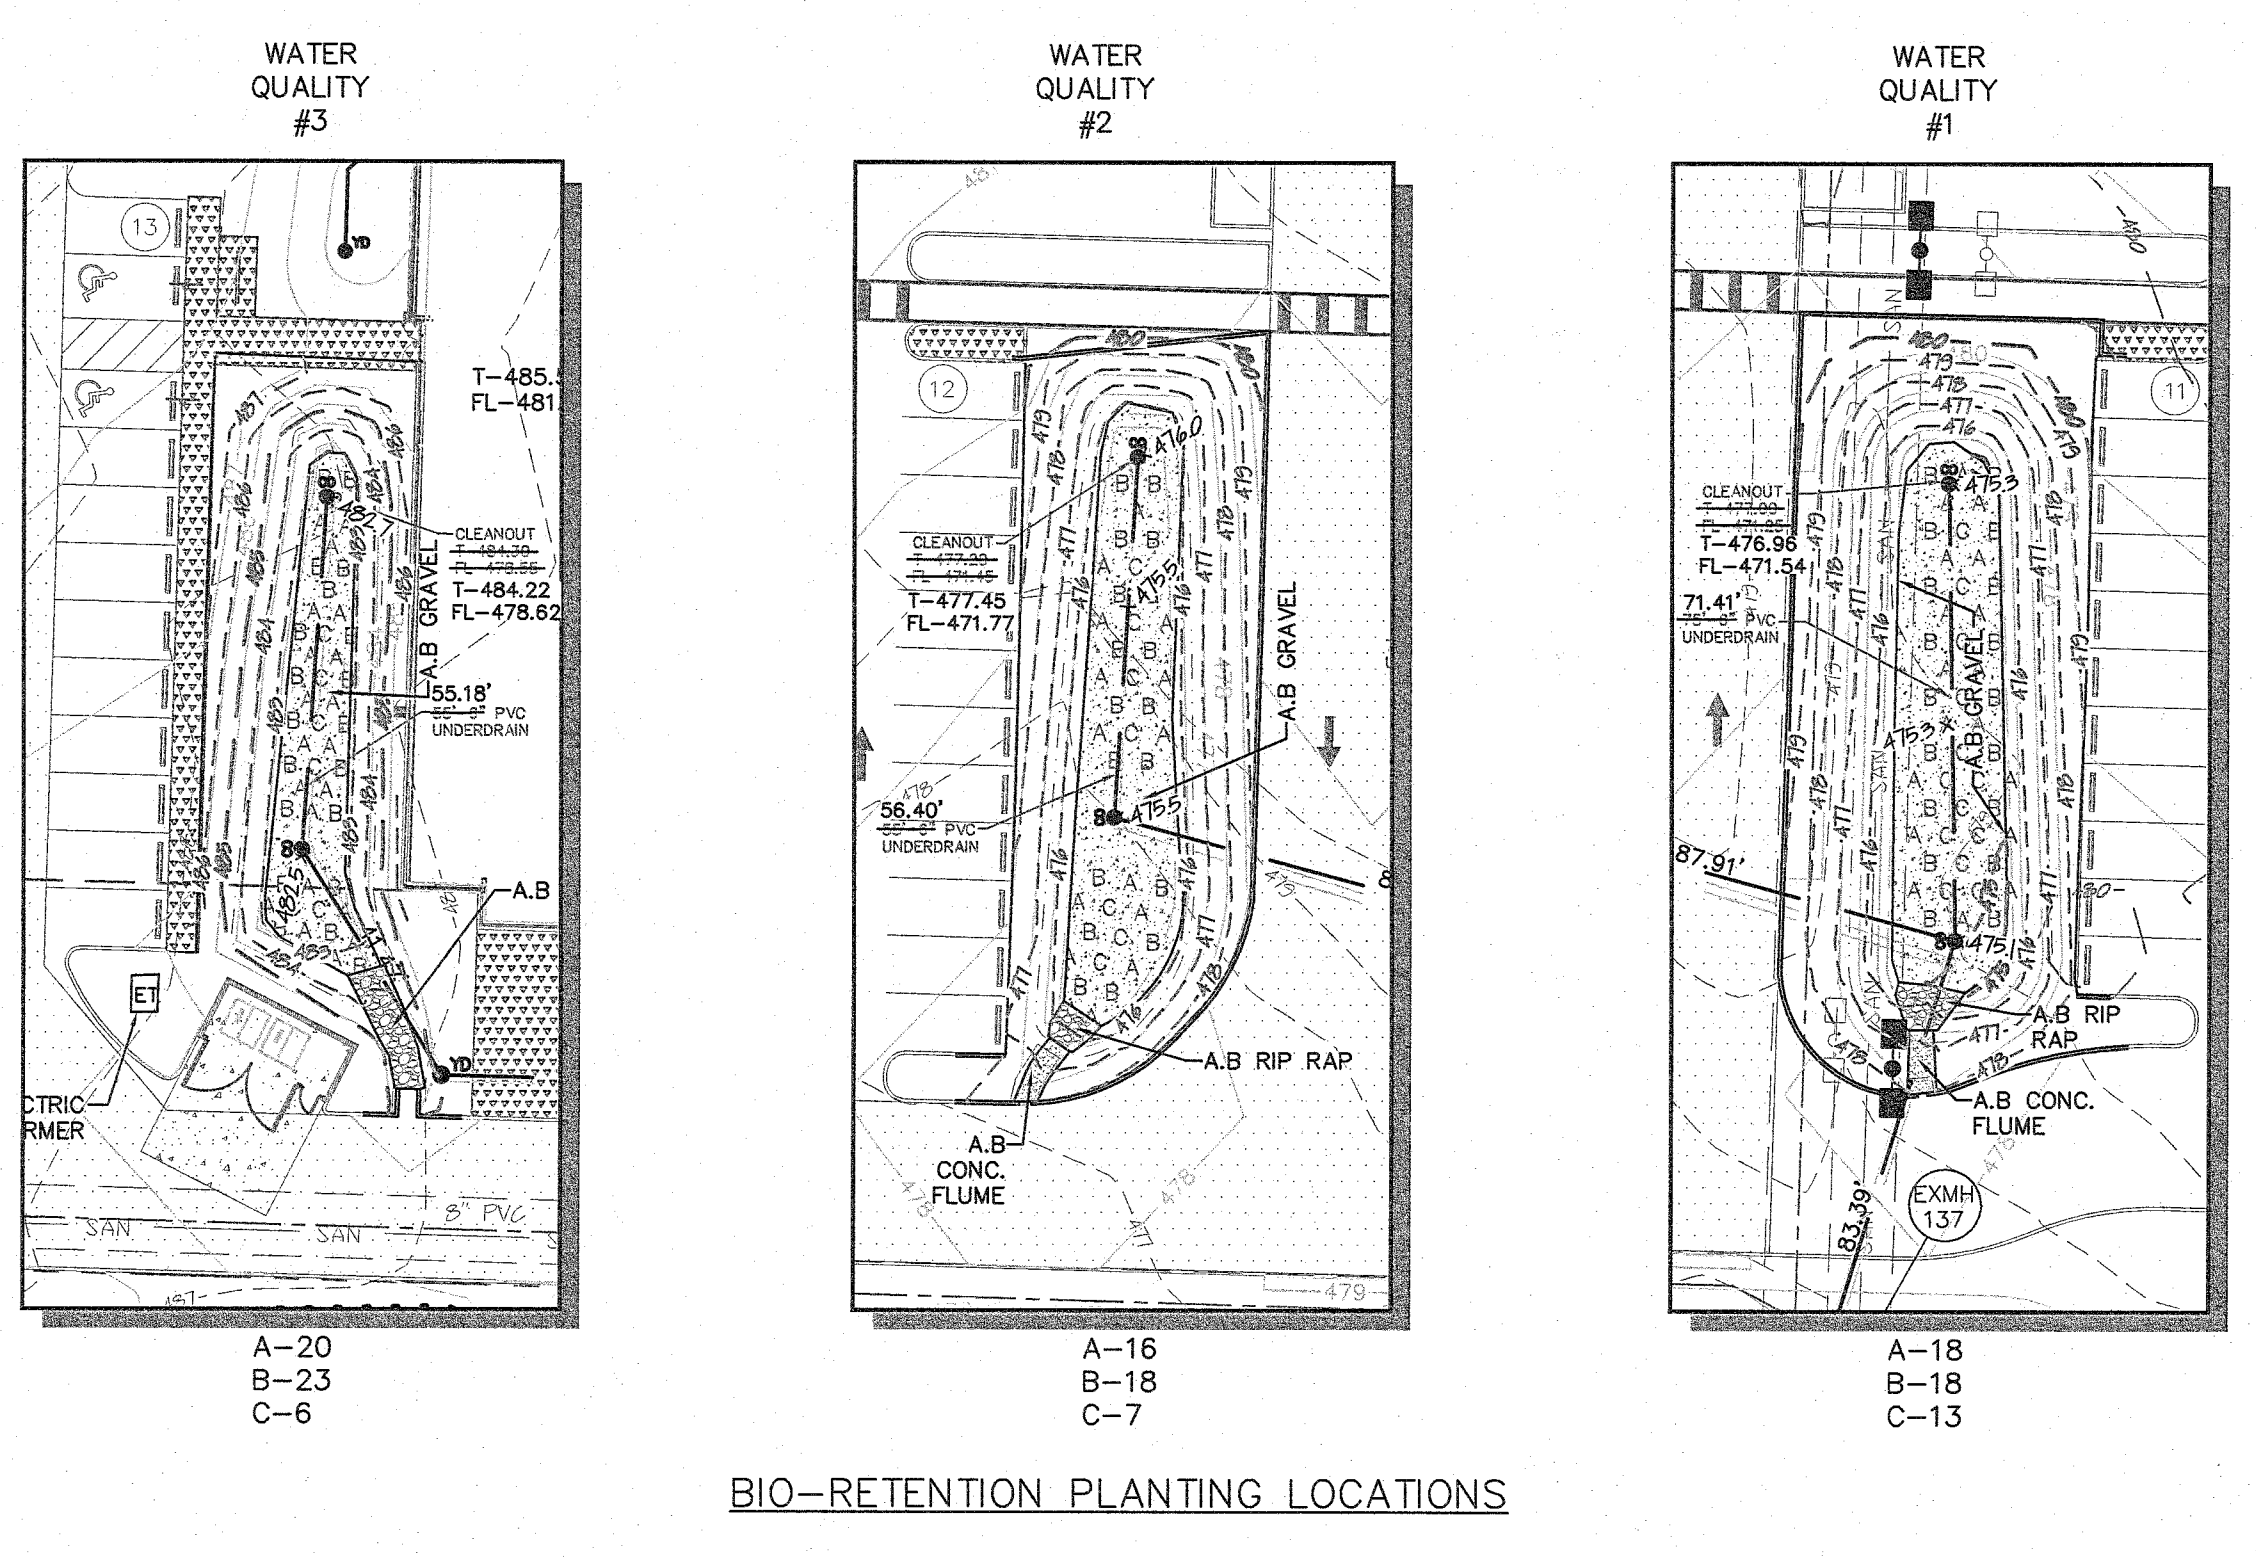

PROJECT TITLE:
 As-Built Plans for:
 Fort Zumwalt School District
 Professional Development Center

Box Project # 0-754 Issue Date: 12/30/2021

ENGINEERING SURVEYING
 221 Park West Blvd.
 St. Charles, MO 63001
 636-629-5552
 FAX 636-1710

DISCLAIMER OF RESPONSIBILITY:
 I hereby specify that the documents intended to be authorized by my seal are limited to this sheet, and I hereby disclaim any responsibility for all other drawings, specifications, estimates, reports or other documents or instruments existing or intended to be used for any part or parts of the architectural or engineering project or survey.




REVISIONS

NO.	DESCRIPTION
1	
2	
3	
4	
5	

Developer / Owner:
 Fort Zumwalt School District
 555 E. Terra Lane
 O'Fallon, MO 63367

Storm Sewer Profiles, Hydraulics and Details

P+Z No.: 19-009658
Approval Date: 11/07/19
City No.: #
Page No.: C15

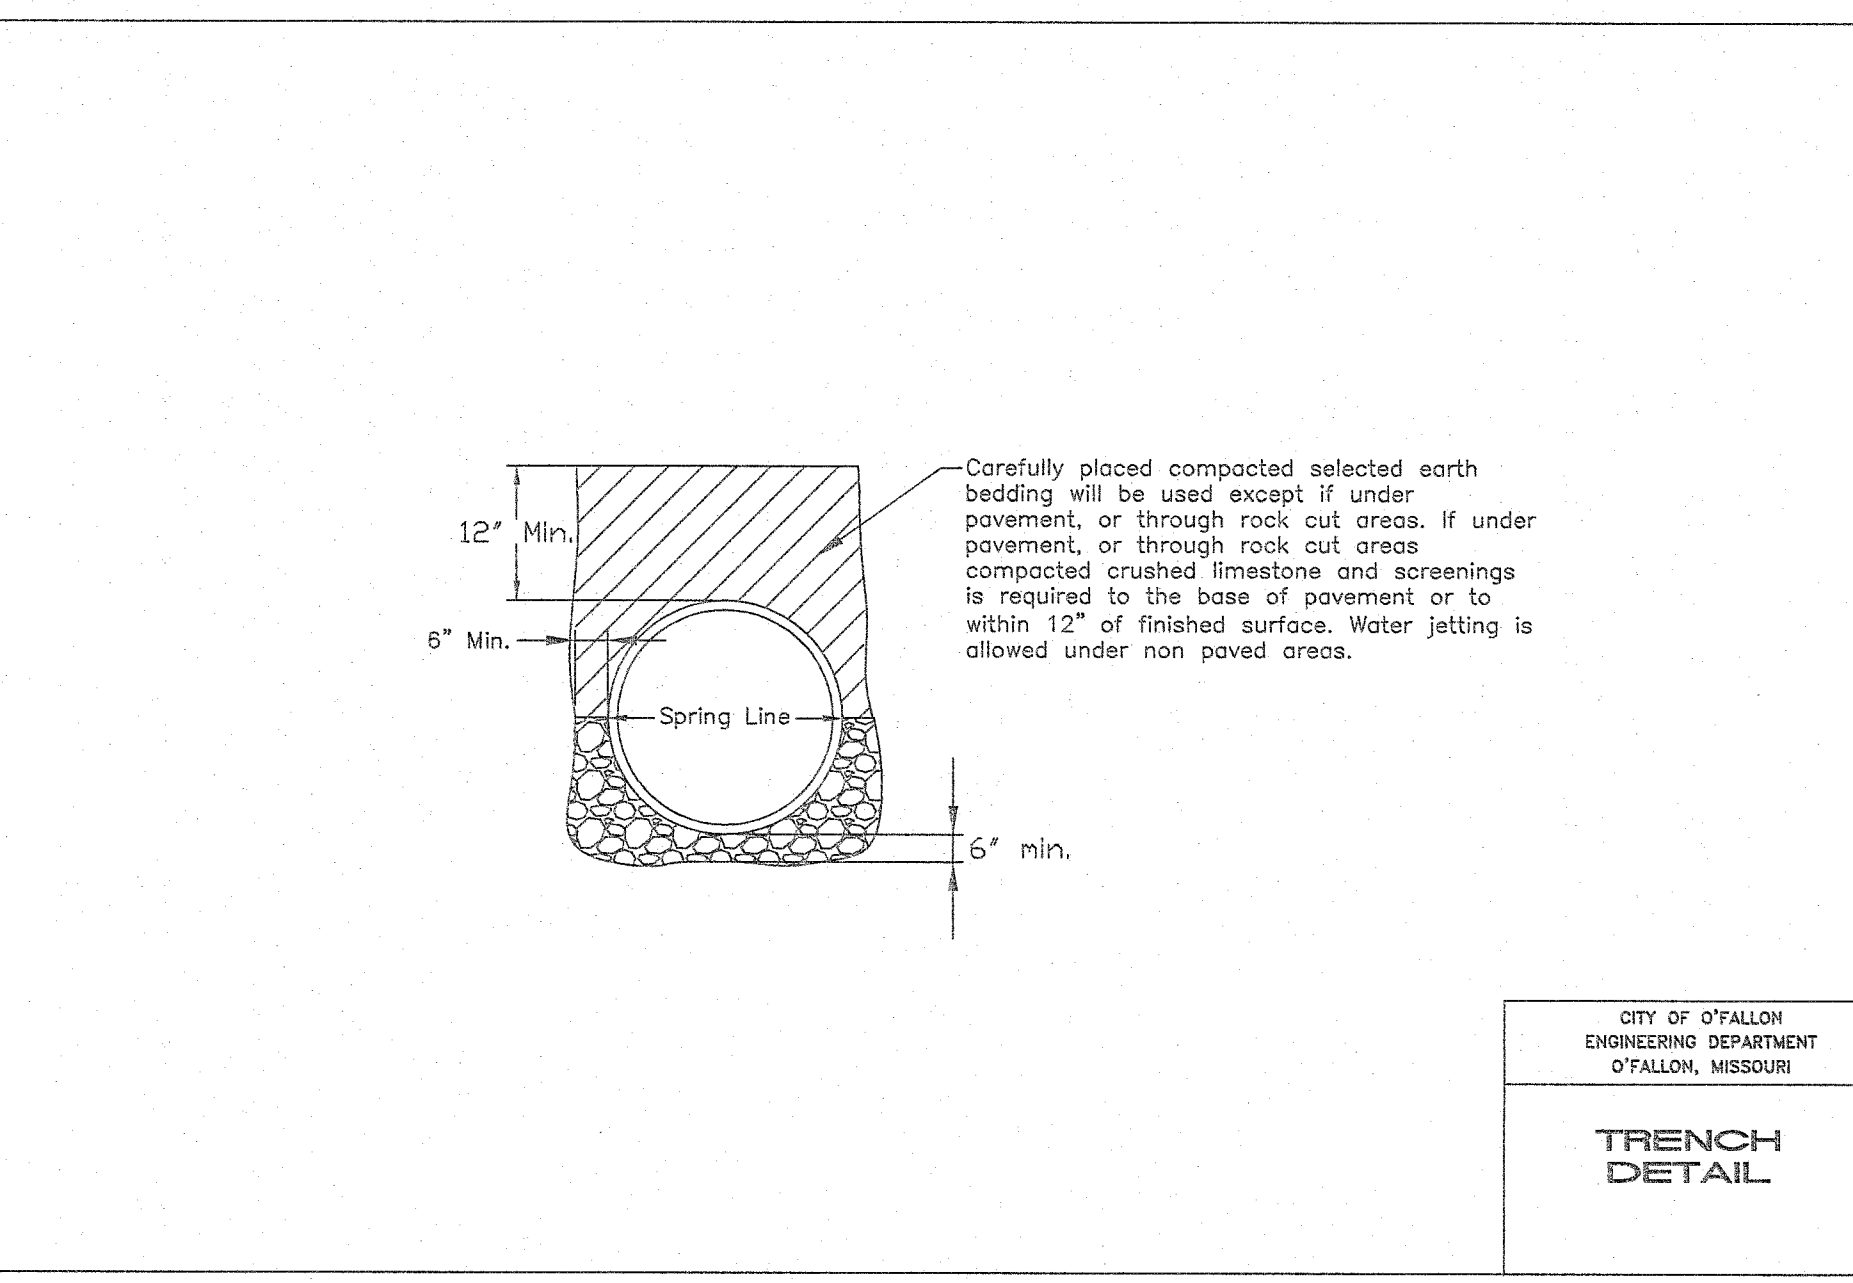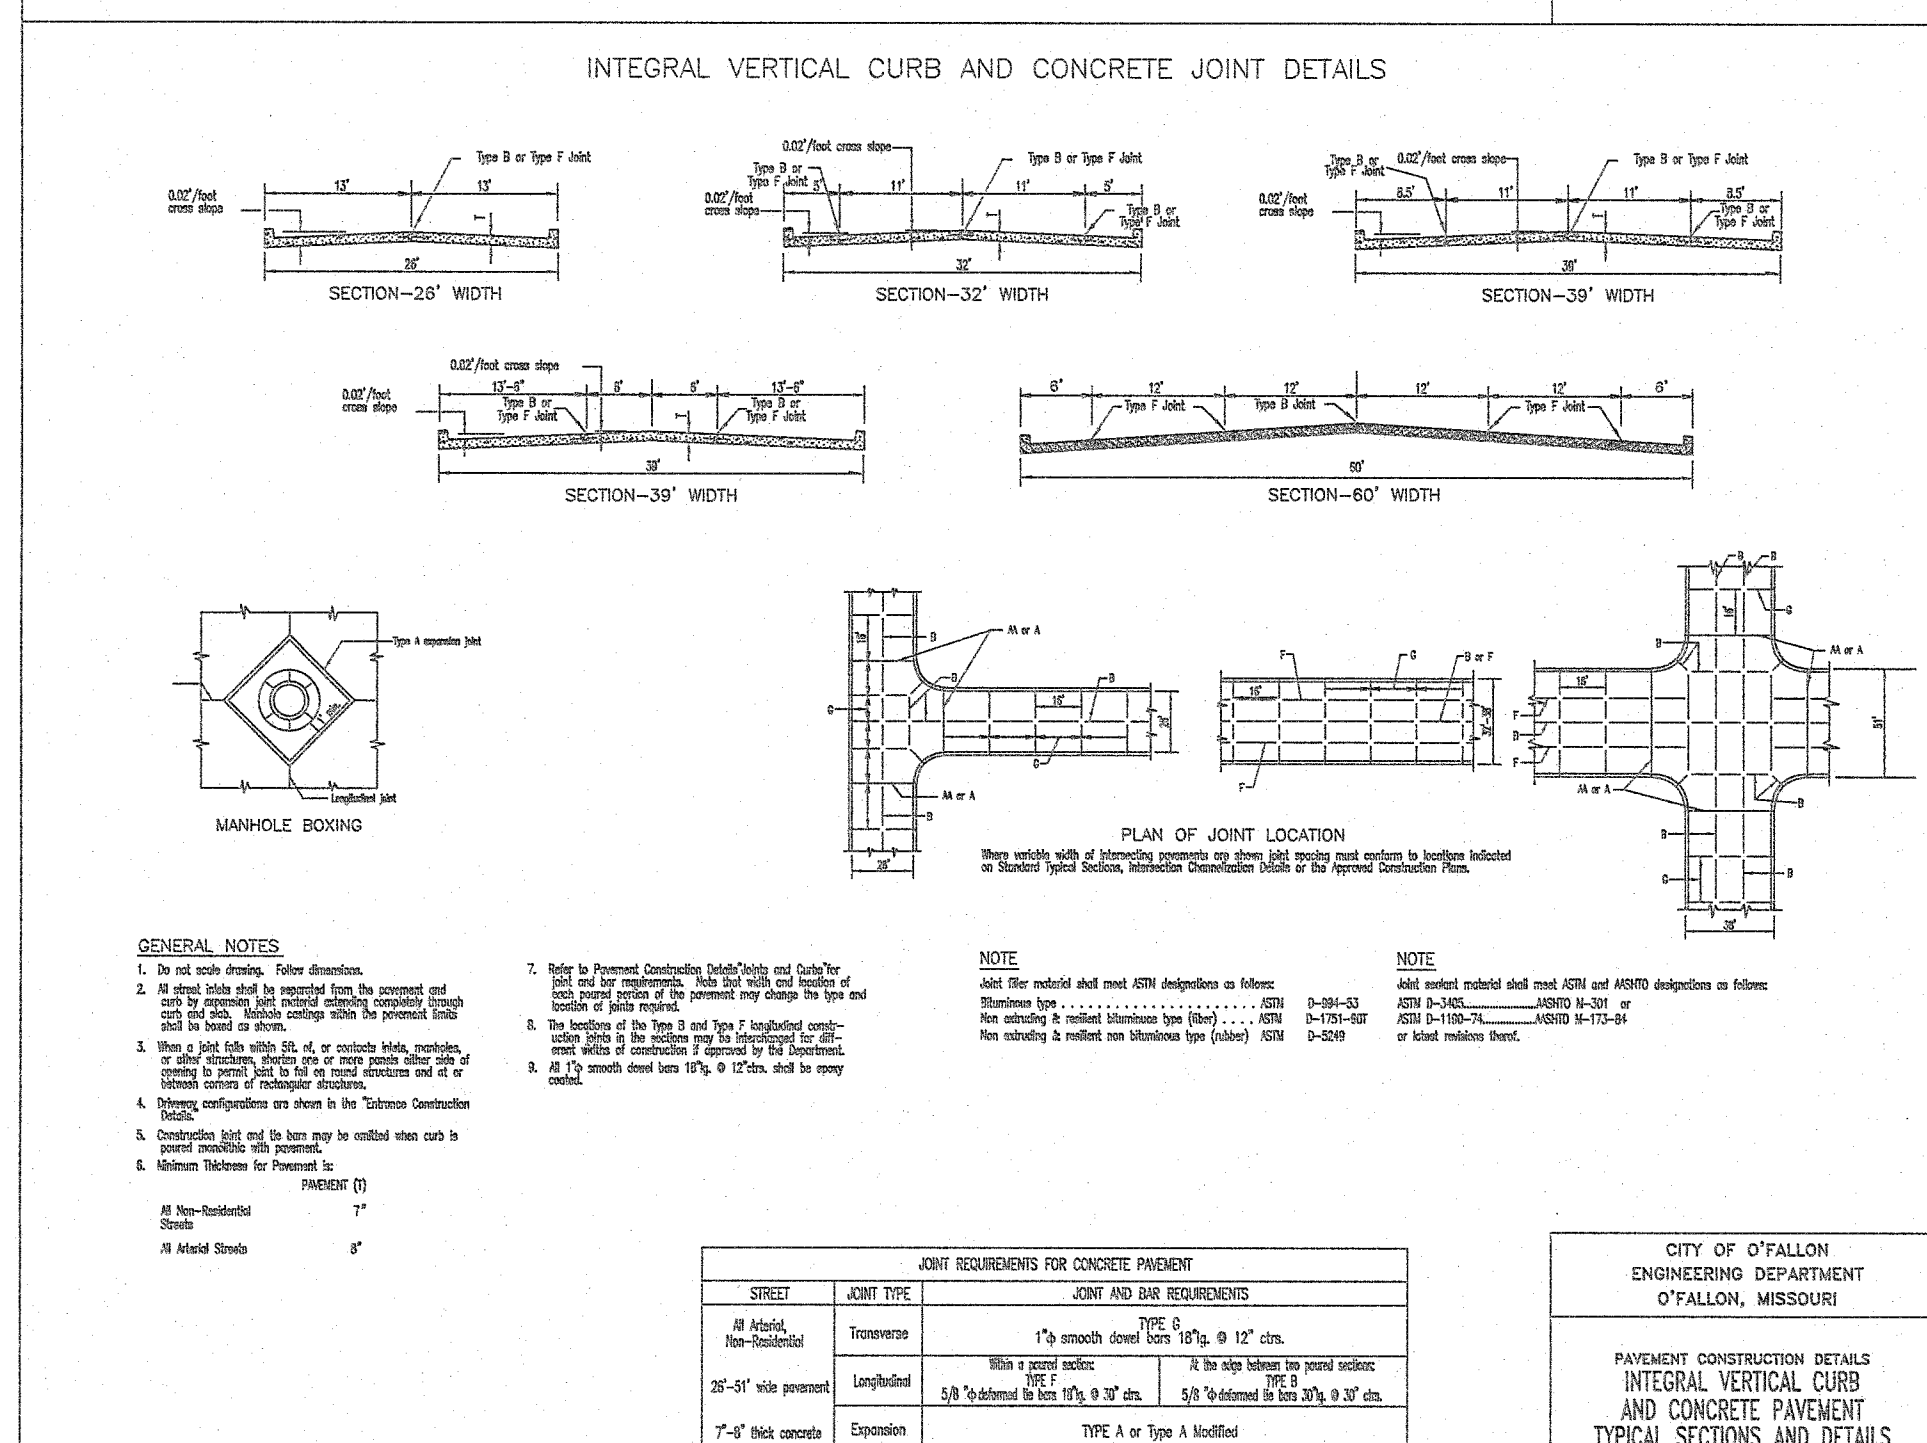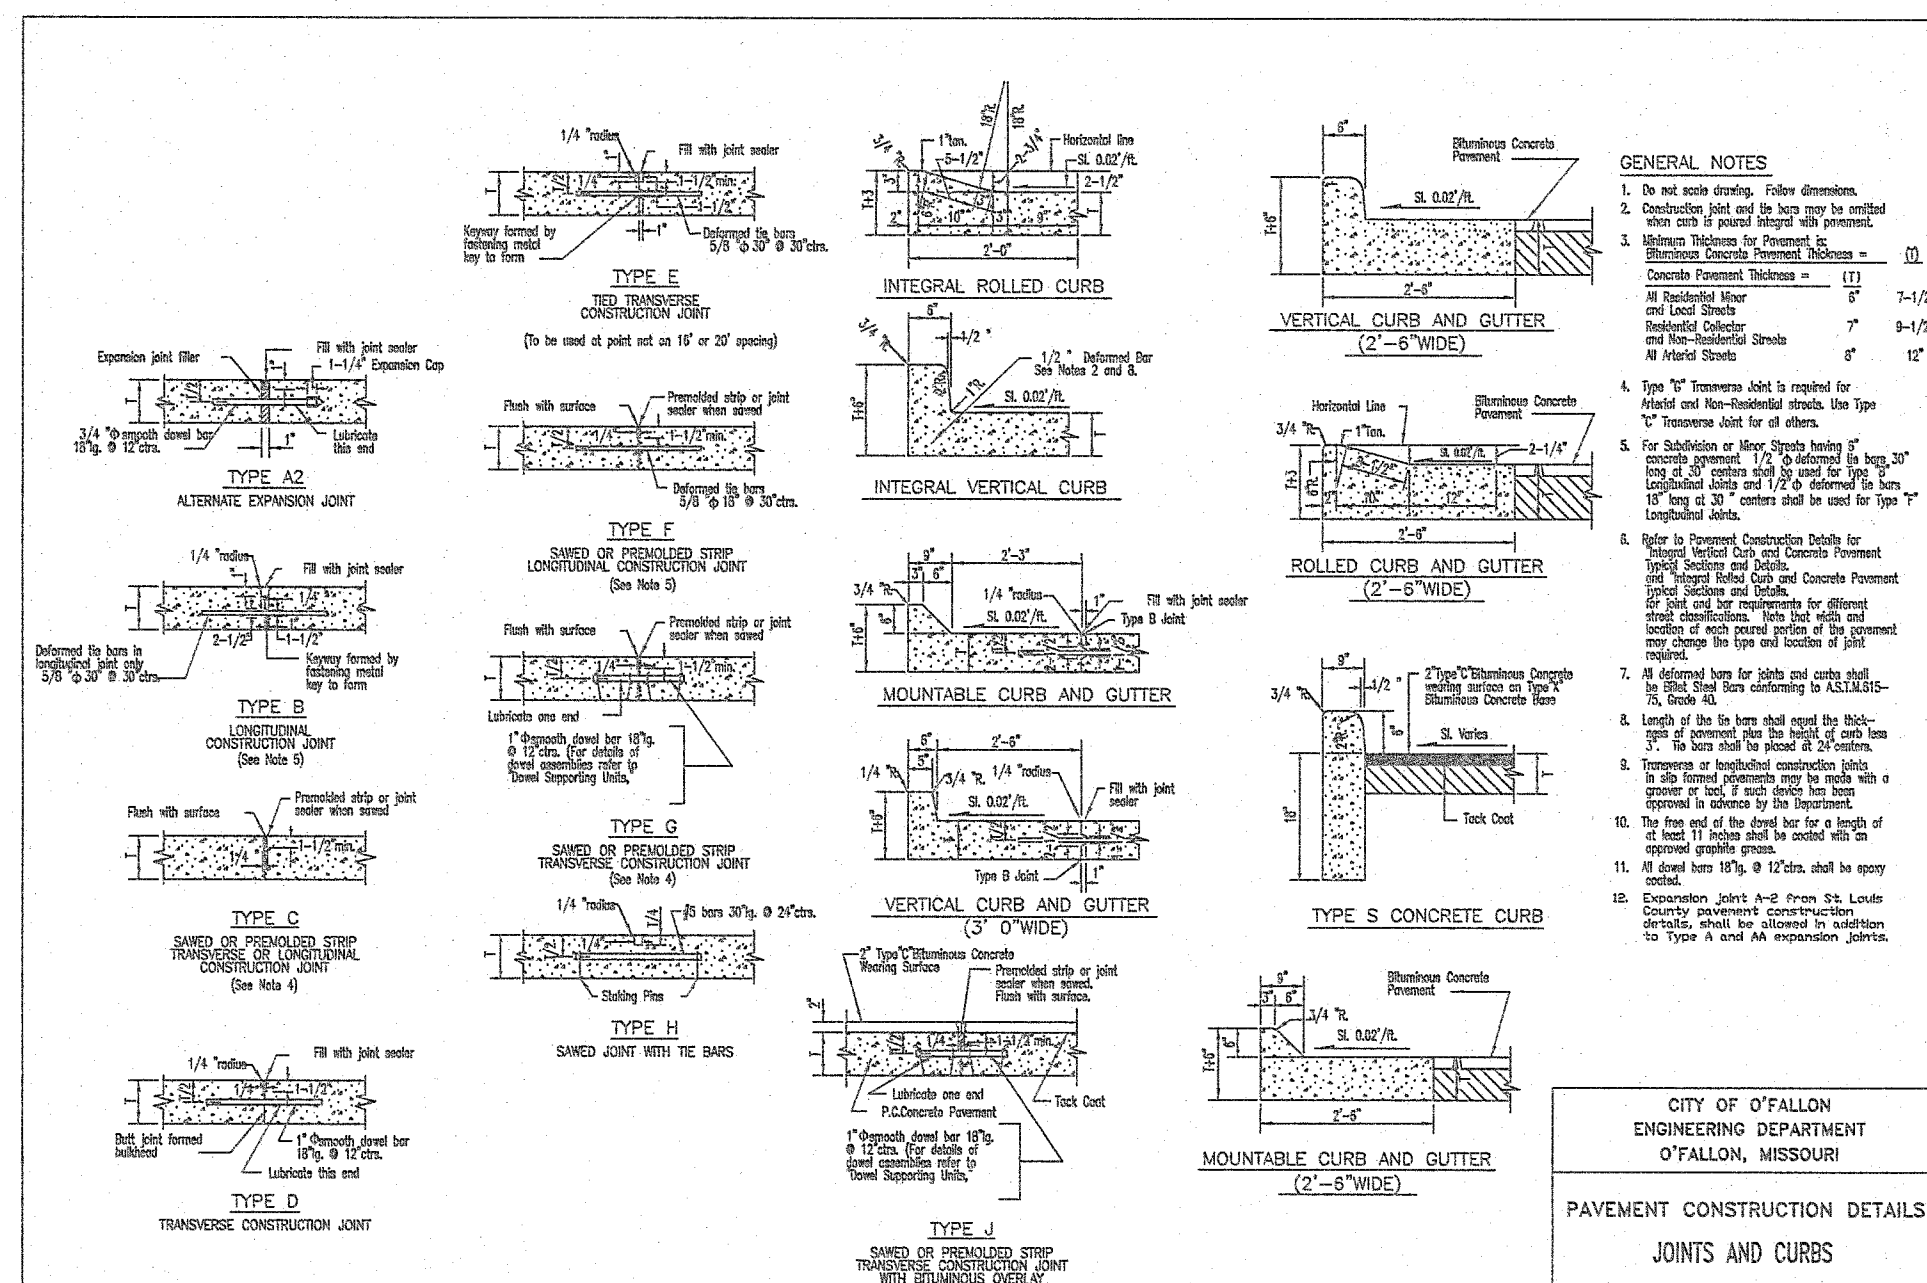

* All other Storm Details will be by M.S.D. 2007 Standards and Specifications.

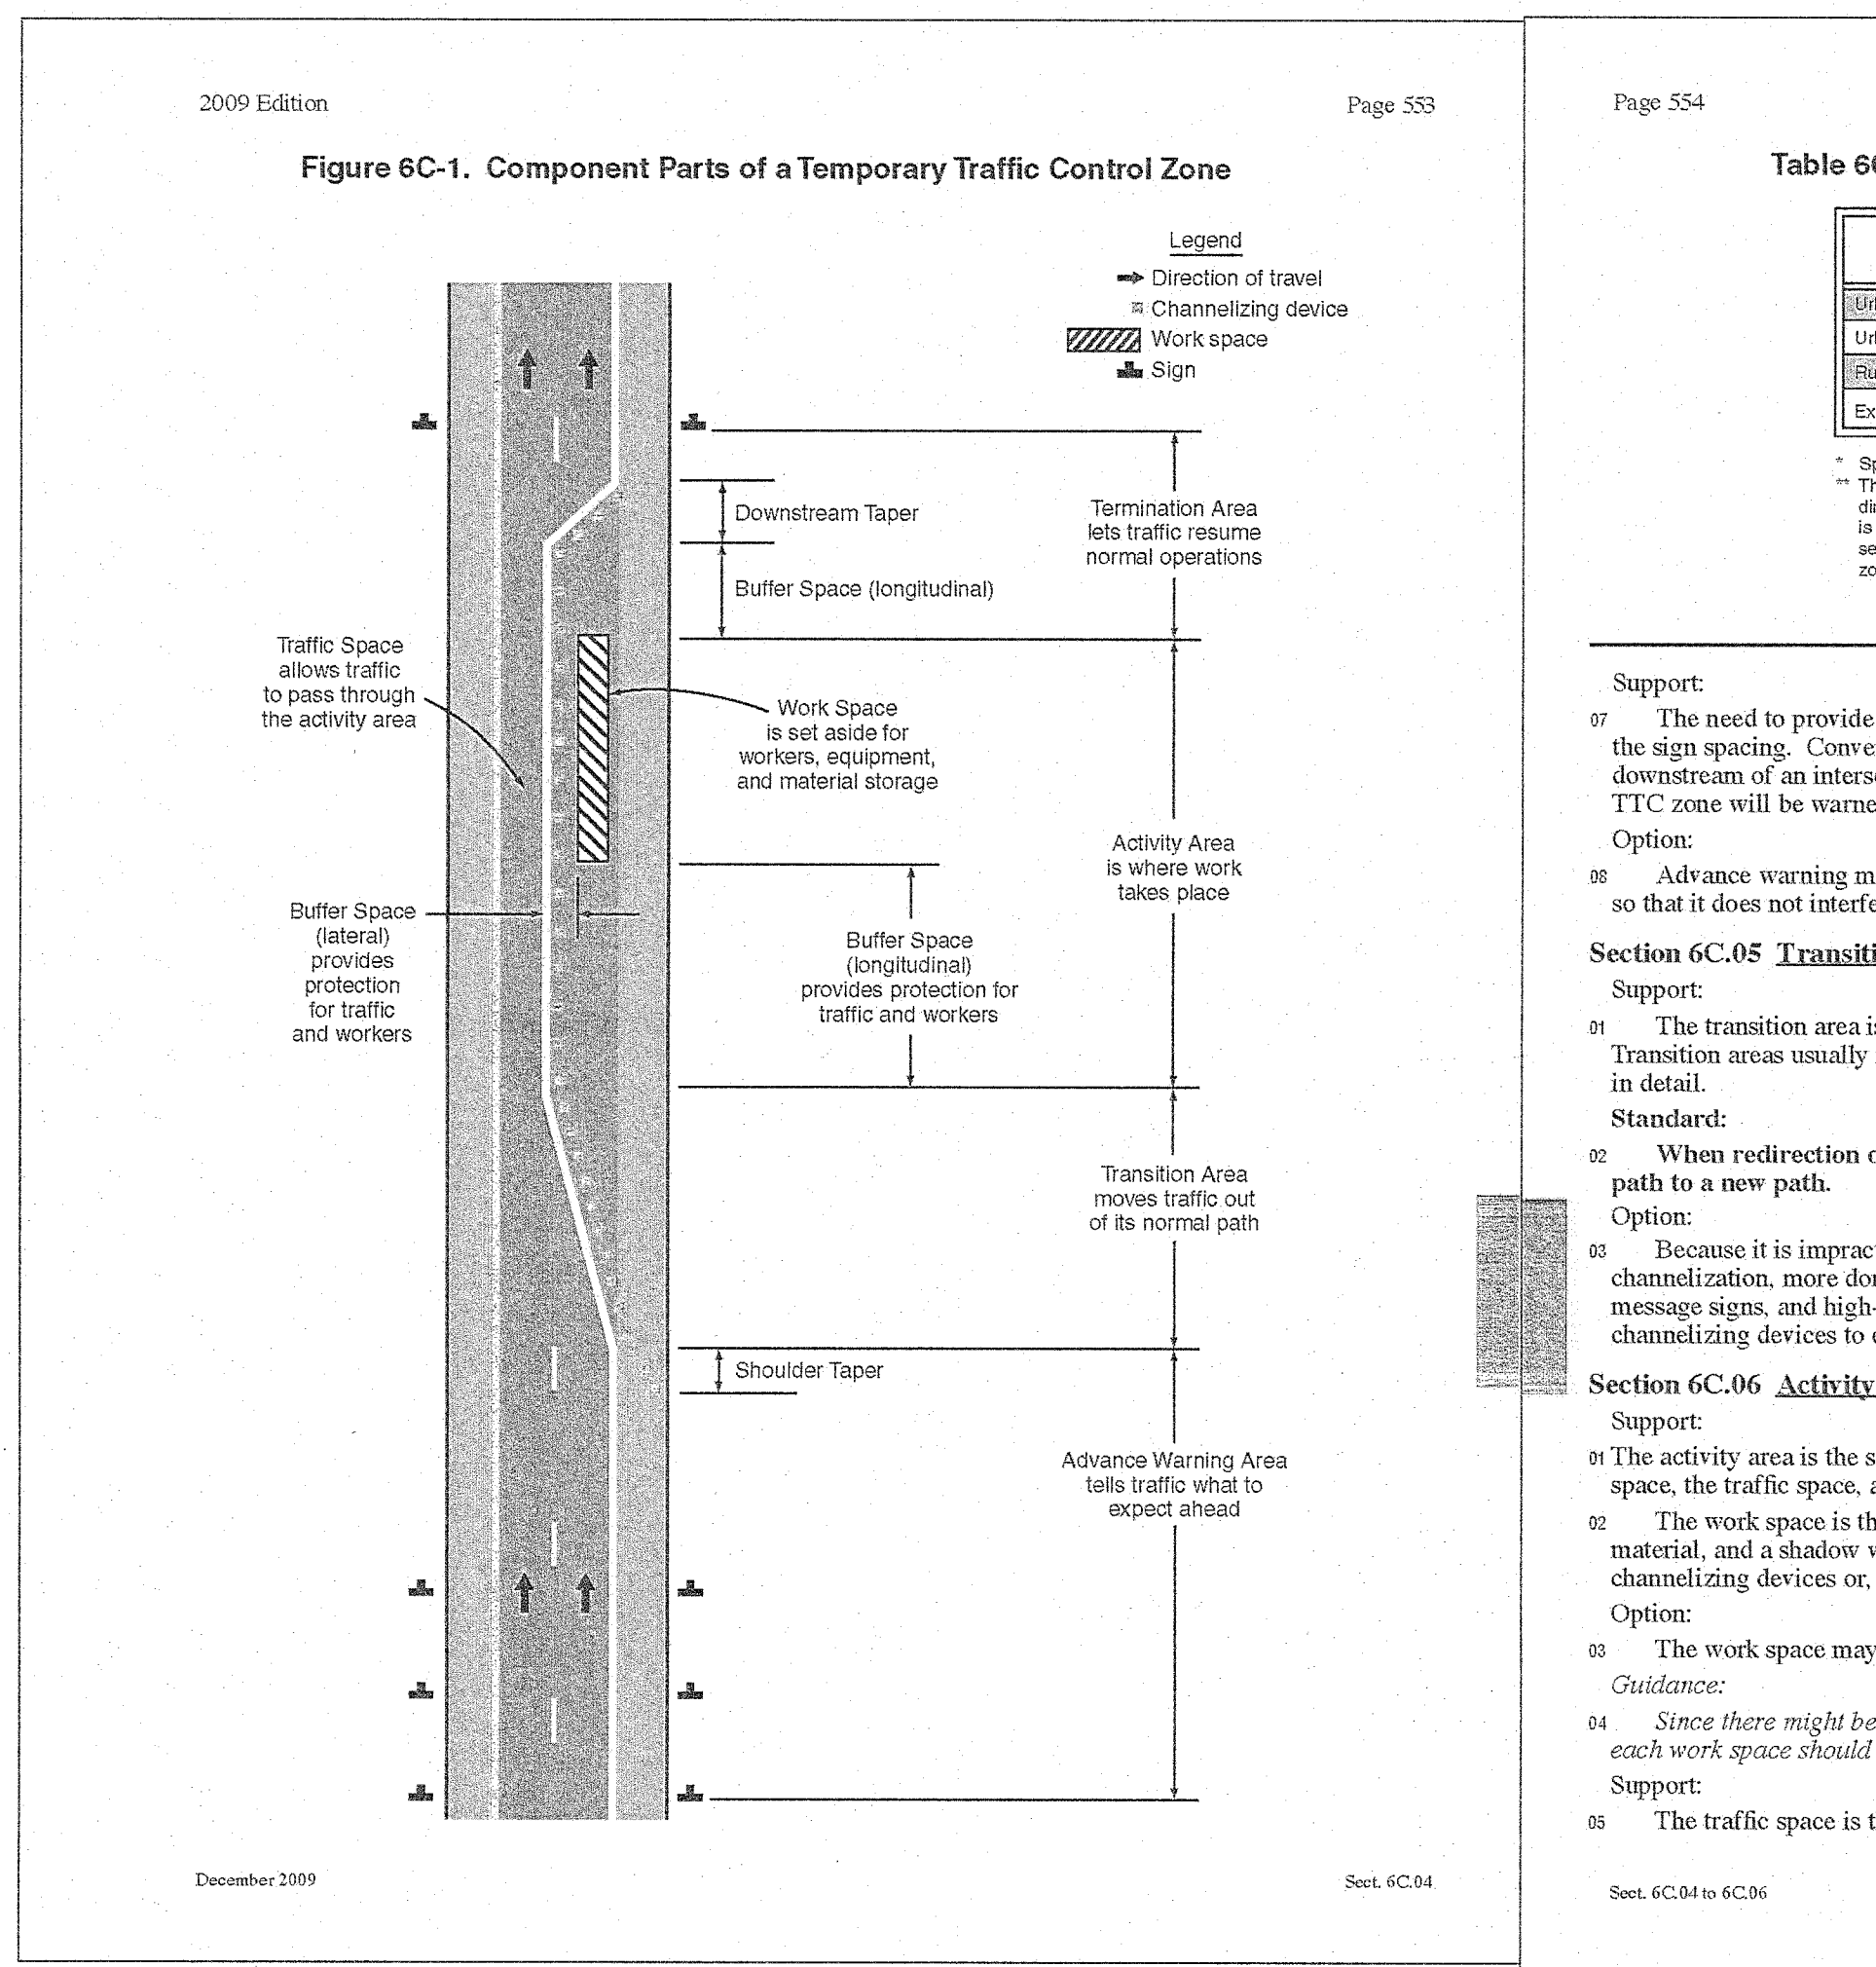
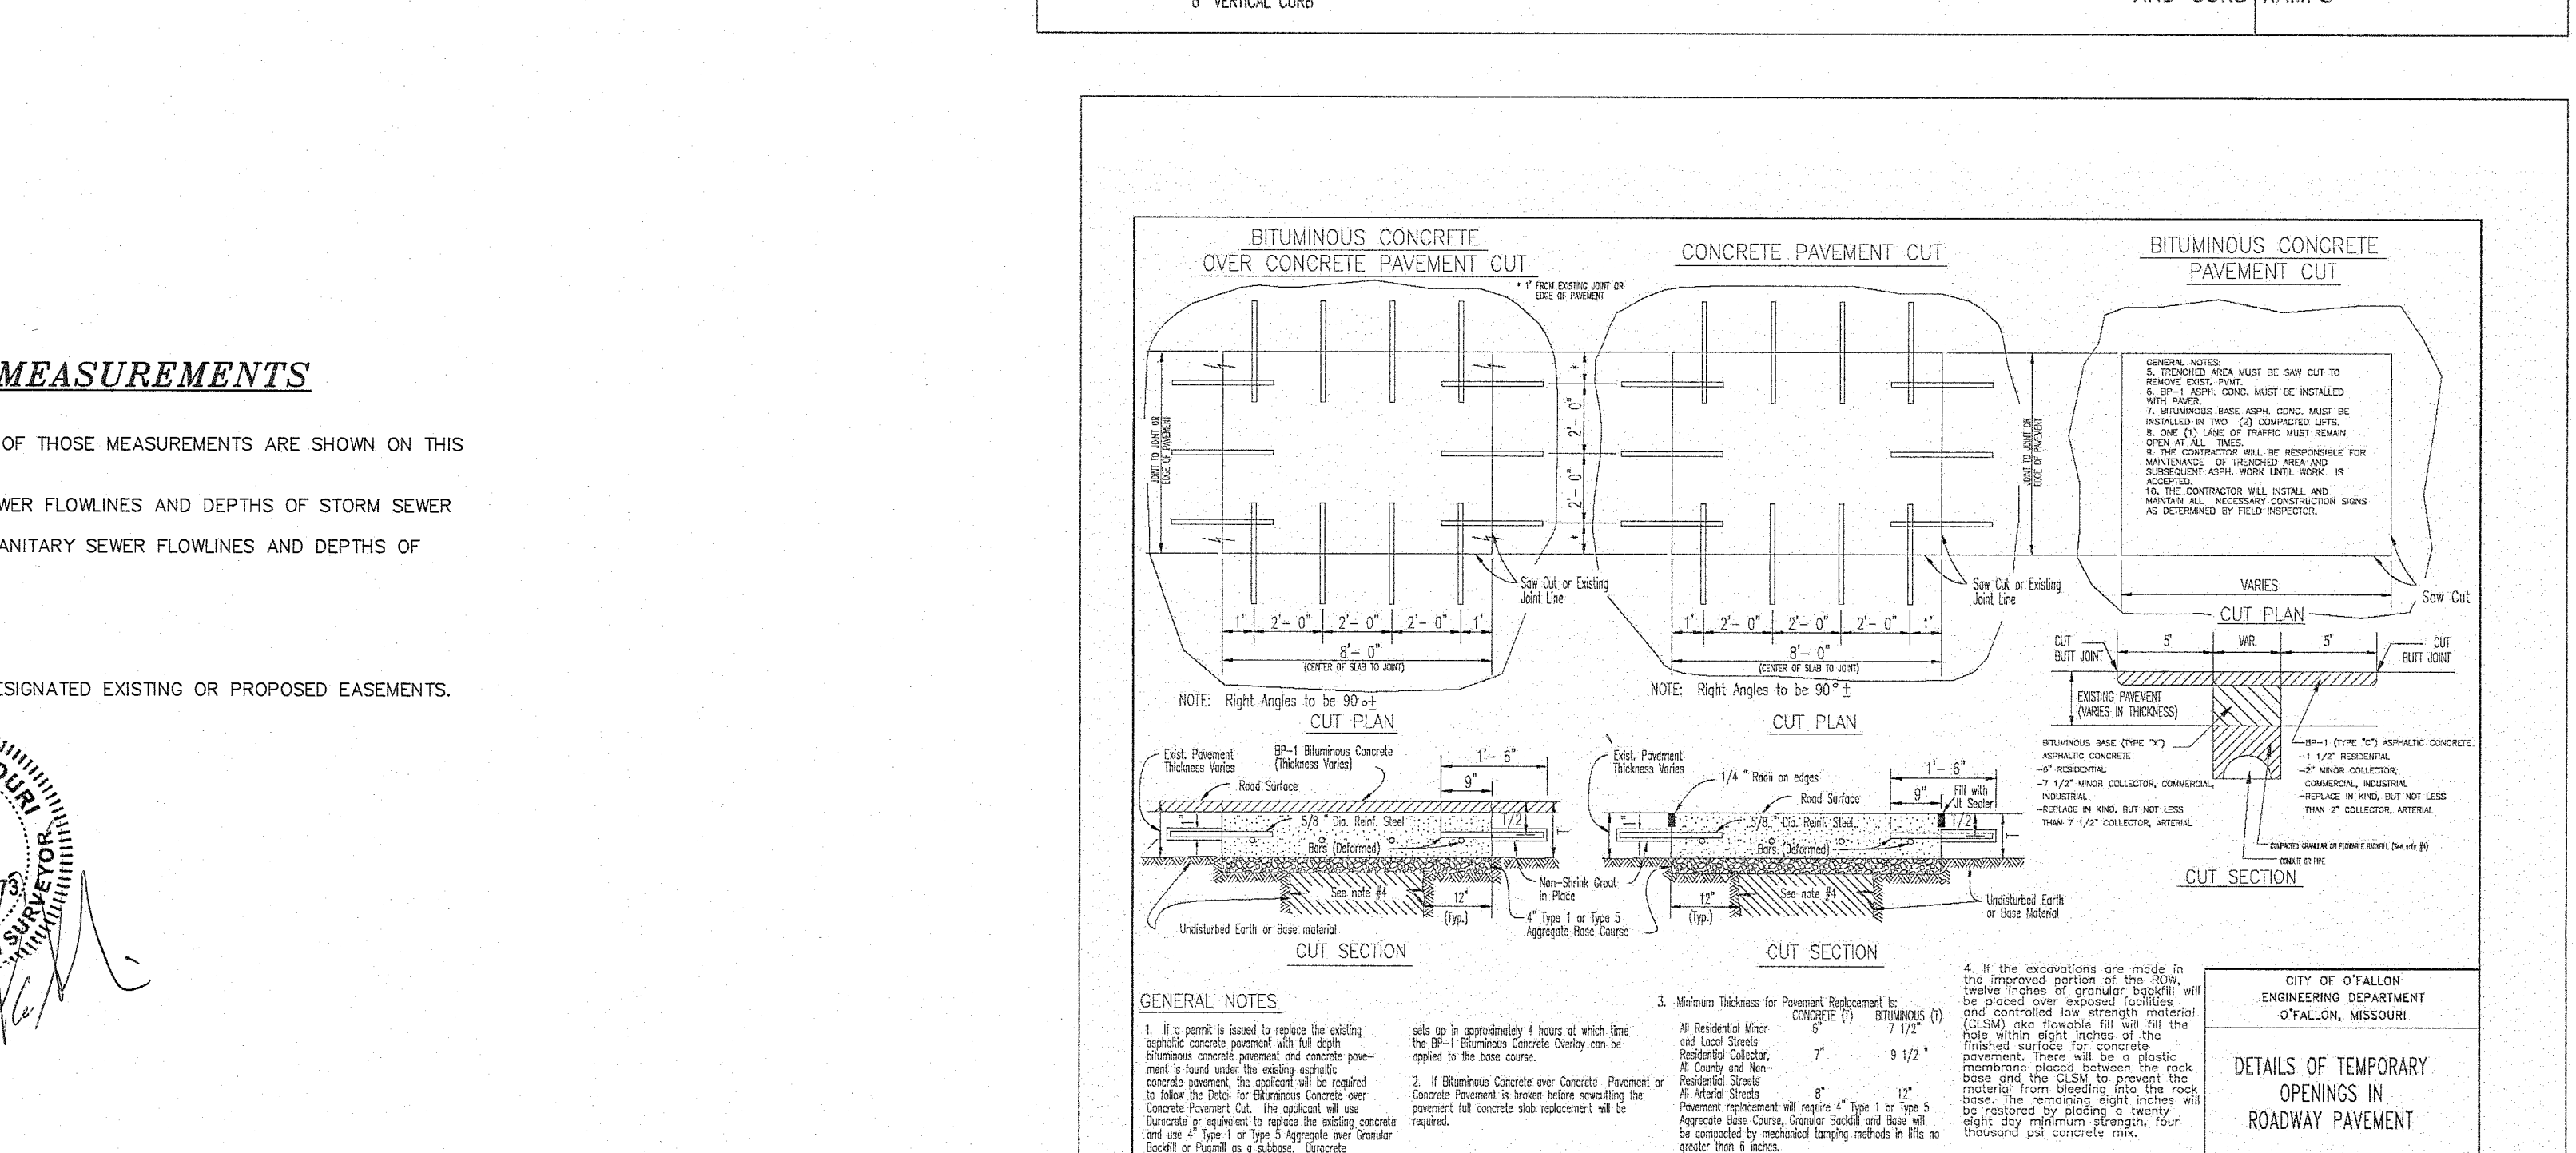
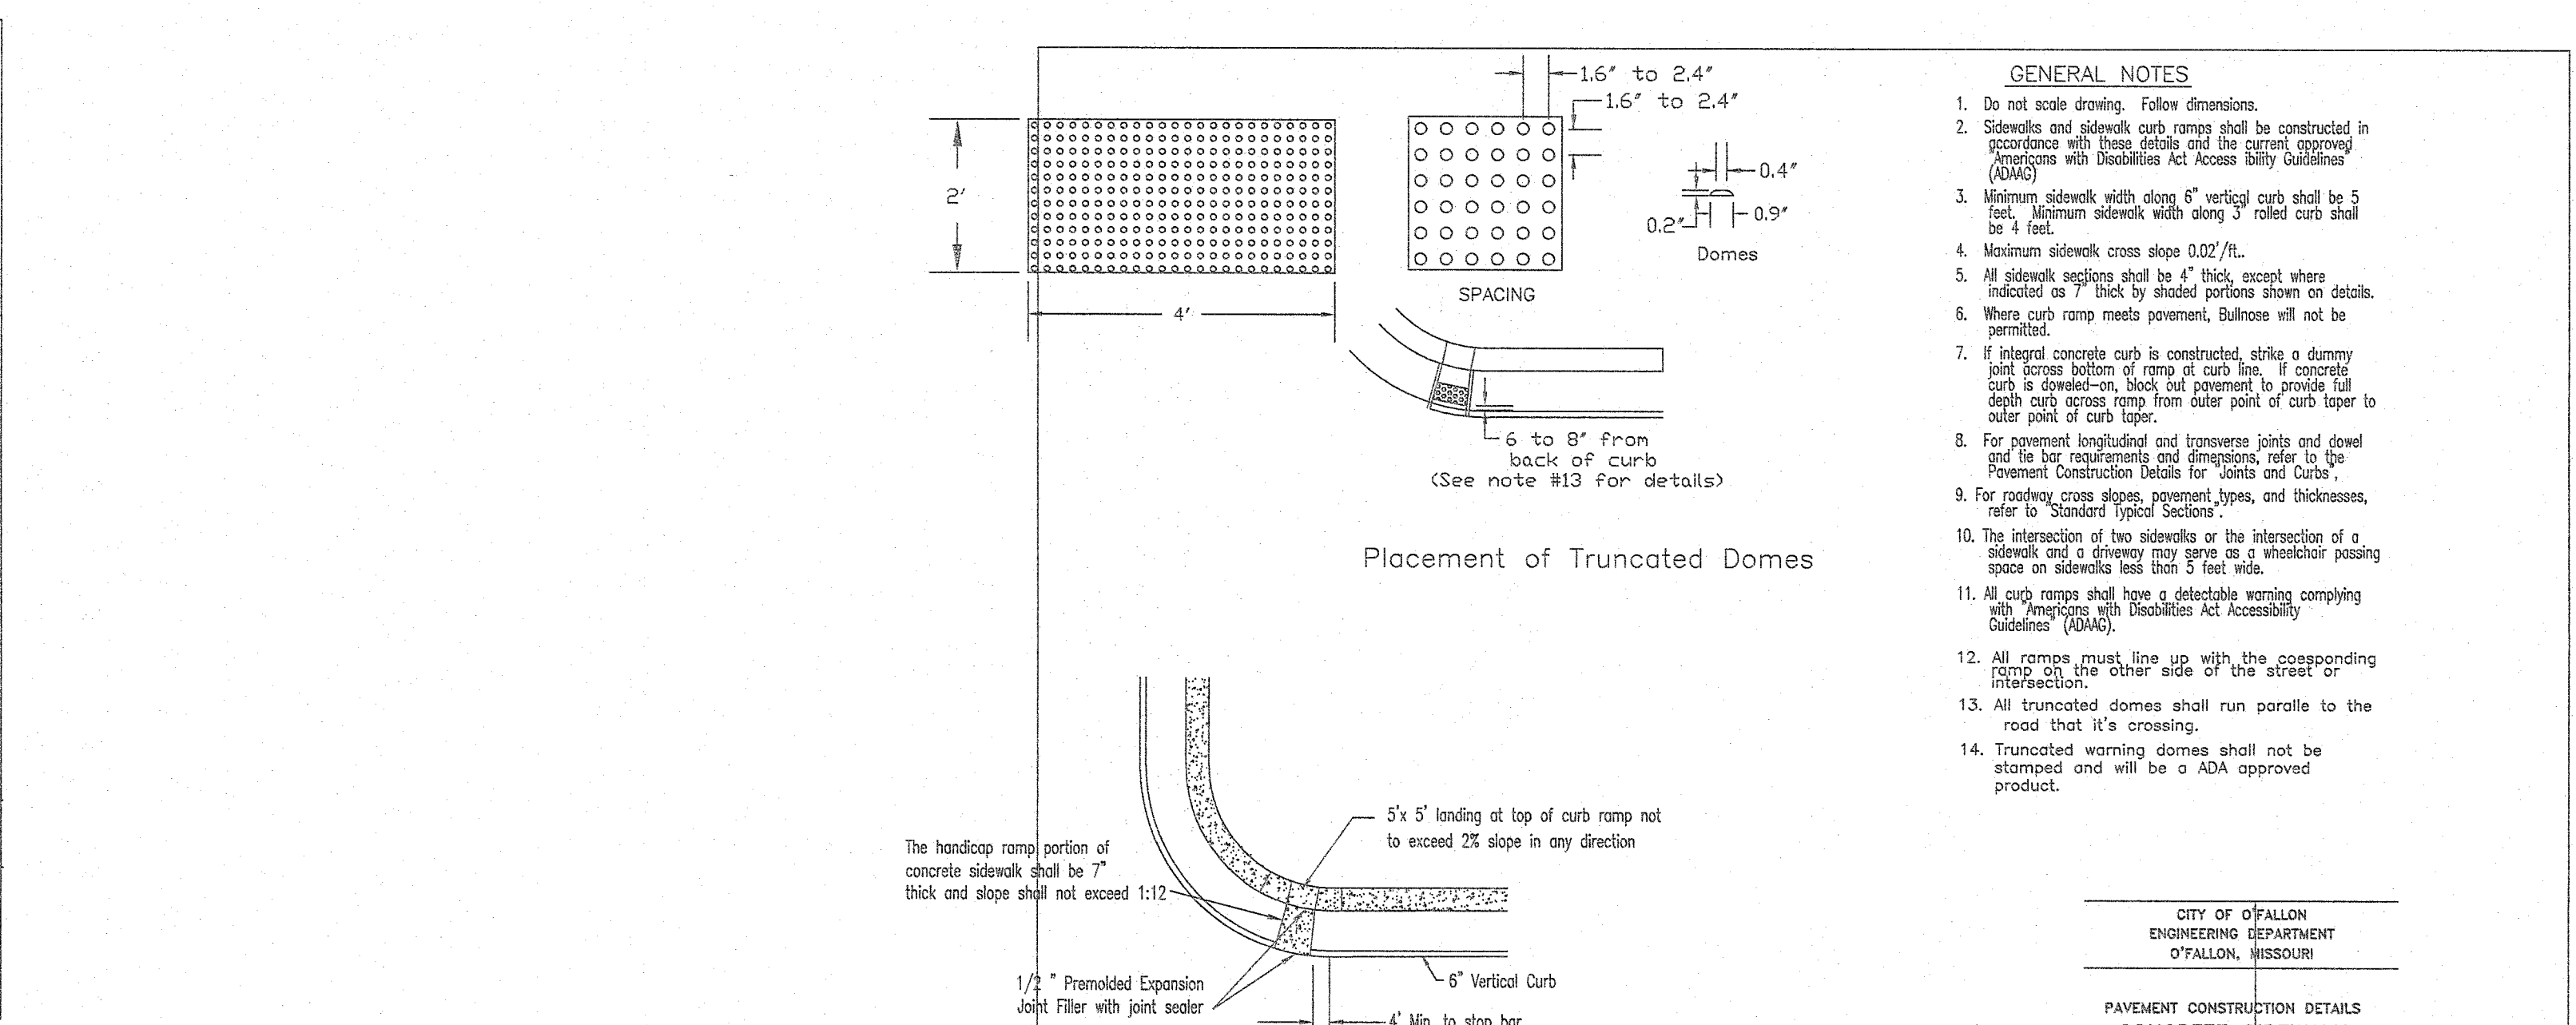
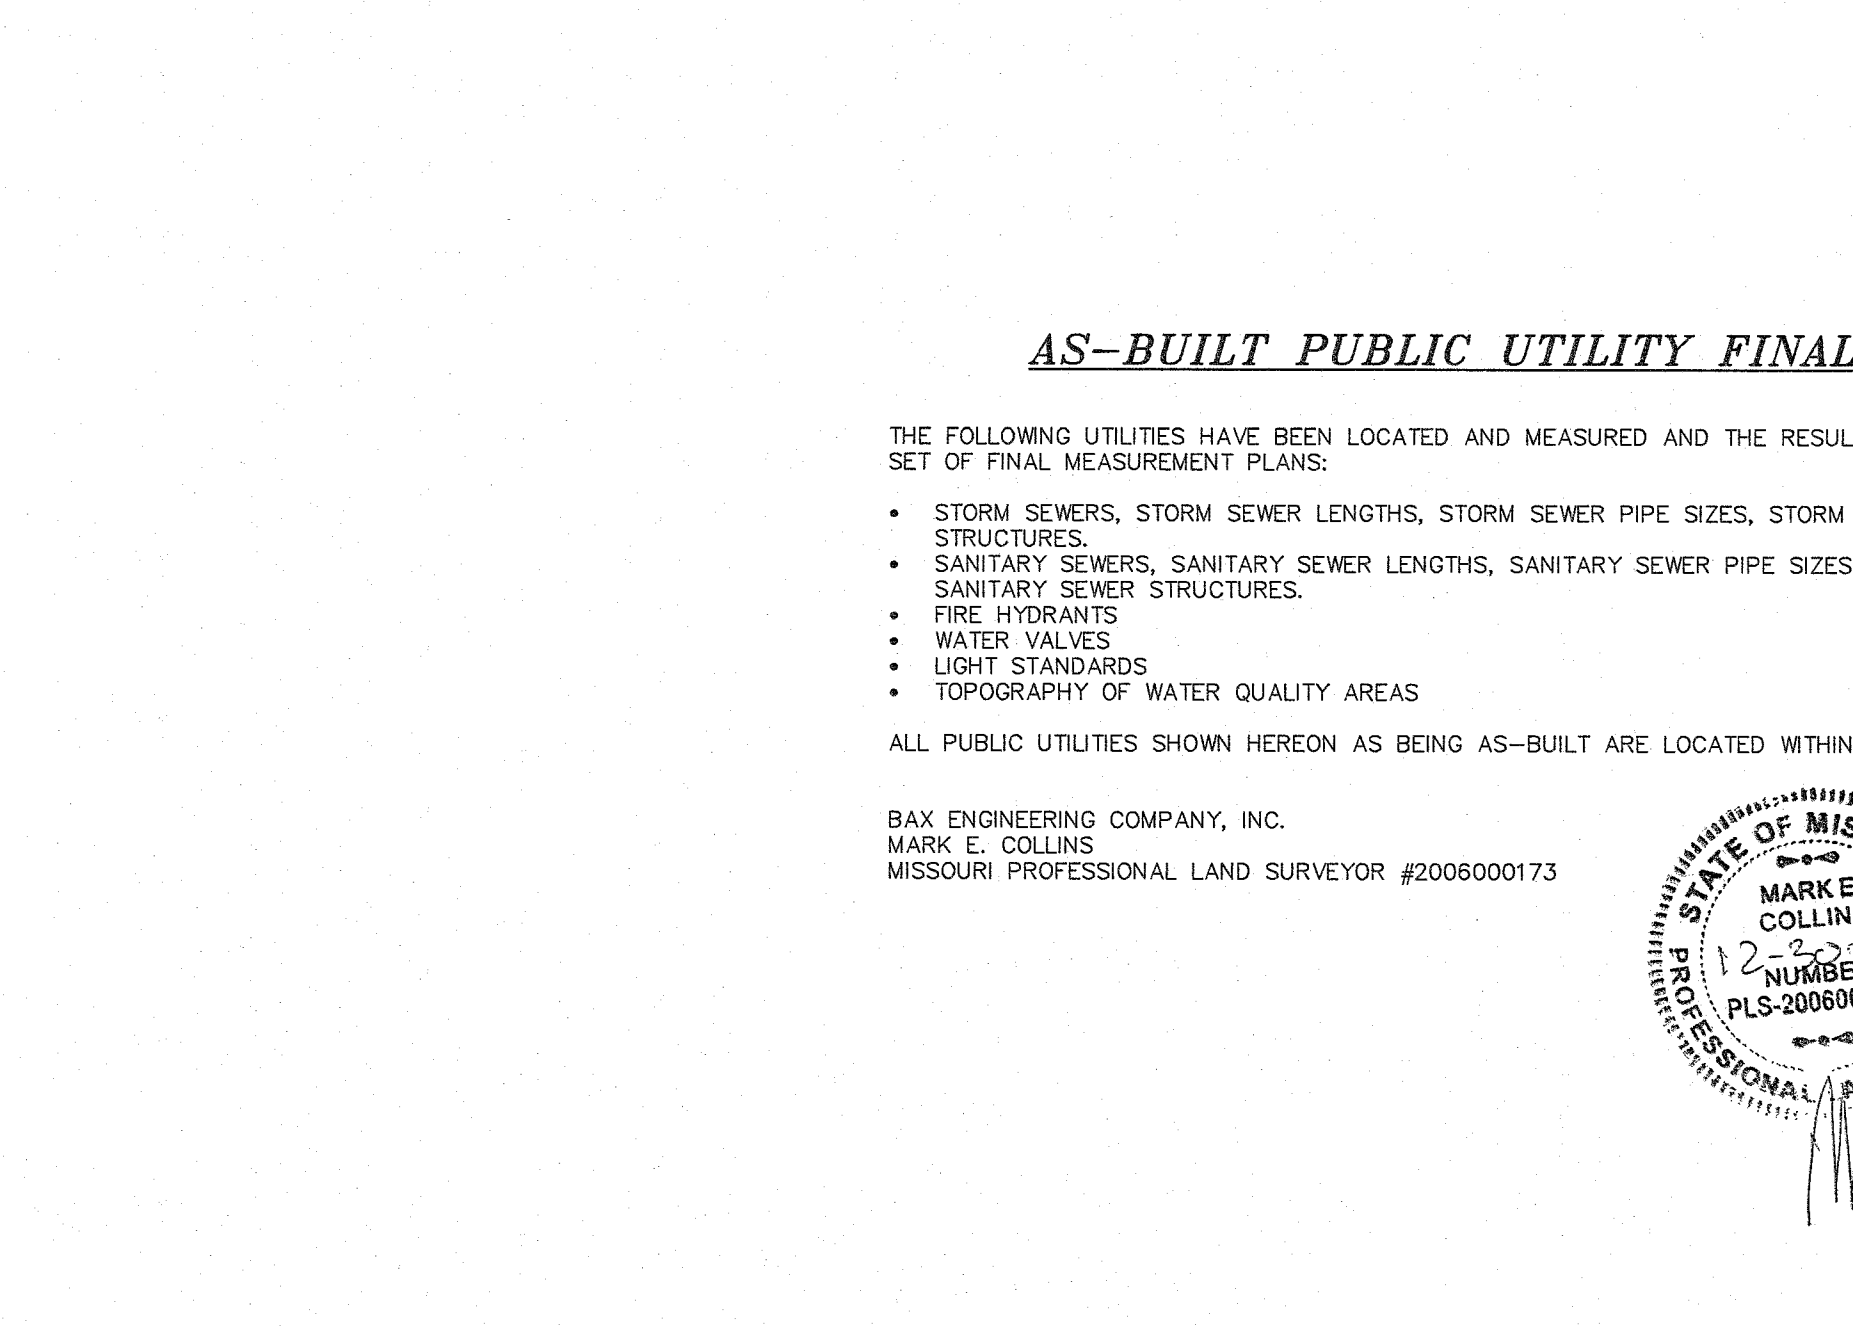


Table 6C-1. Recommended Advance Warning Sign Minimum Spacing

Road Type	Distance Between Signs*		
	A	B	C
Urban (low speed)	100 feet	100 feet	100 feet
Urban (high speed)	350 feet	350 feet	350 feet
Rural	500 feet	500 feet	500 feet
Expressway / Freeway	1,000 feet	1,500 feet	2,500 feet

* Speed category to be determined by the highway agency.

The column headings A, B, and C are the dimensions shown in Figures 6C-1 through 6C-5. The A dimension is the distance from the transition or point of restriction to the first sign. The B dimension is the distance between the first and second signs. The C dimension is the distance between the second and third signs. (*The "first sign" is the sign in a two-sign series that is closest to the TTC zone. The "third sign" is the sign that is furthest upstream from the TTC zone.)

Support:
 07 The need to provide additional reaction time for a condition is one example of justification for increasing the sign spacing. Conversely, decreasing the sign spacing might be justified in order to place a sign immediately downstream of an intersection or major driveway such that traffic turning onto the roadway in the direction of the TTC zone will be warned of the upcoming condition.
 08 Advance warning may be eliminated when the activity area is sufficiently removed from the road users' path so that it does not interfere with the normal flow.
 09 The transition area is that section of highway where road users are redirected out of their normal path. Transition areas usually involve strategic use of tapers, which because of their importance are discussed separately in detail.
 10 When redirection of the road users' normal path is required, they shall be directed from the normal path to a new path.
 11 Because it is impractical in mobile operations to redirect the road user's normal path with stationary channelization, more dominant vehicle-mounted traffic control devices, such as arrow boards, portable changeable message signs, and high-intensity rotating, flashing, oscillating, or strobe lights, may be used instead of channelizing devices to establish a transition area.
 12 The activity area is the section of the highway where the work activity takes place. It is comprised of the work space, the traffic space, and the buffer space.
 13 The work space is that portion of the highway closed to road users and used side for workers, equipment, and material, and a shadier vehicle if one is used upstream. Work spaces are usually delineated for road users by channelizing devices or, to exclude vehicles and pedestrians, by temporary barriers.
 14 The work space may be stationary or may move as work progresses.
 15 Since there might be several work spaces (some even separated by several miles) within the project limits, each work space should be adequately signed to inform road users and reduce confusion.
 16 The traffic space is the portion of the highway in which road users are routed through the activity area.

