




<b>PROJECT</b> GITTEMEIER SANITARY SEWER <b>PLAN &amp; PROFILE</b> PROJECT NO: 87-5031.01 REVISIONS: As-builts 6/88	SHEET NO.	TOTAL SHEETS
	1	2
	DATE: 11-87	

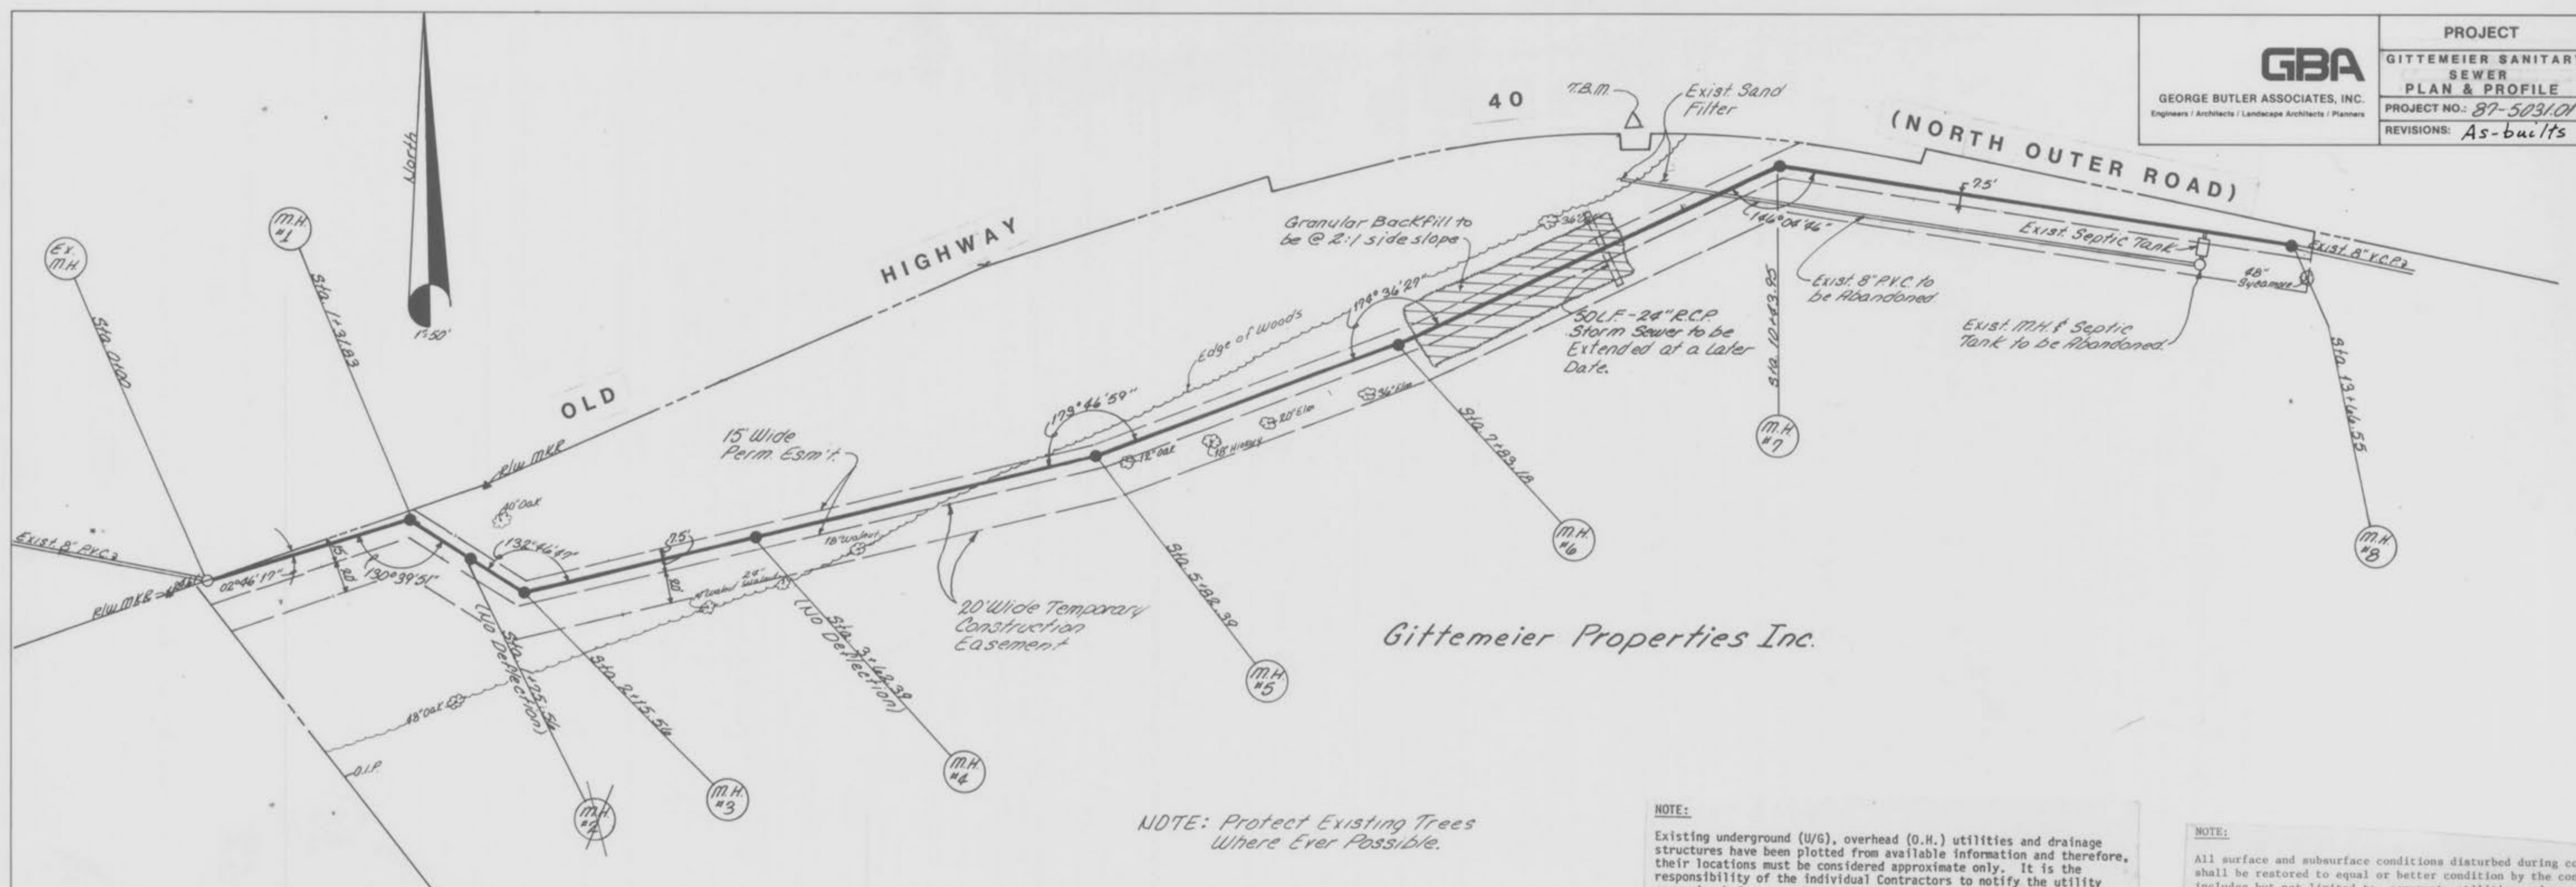


NOTE: Protect Existing Trees Where Ever Possible.


NOTE:  
Existing underground (U/G), overhead (O.H.) utilities and drainage structures have been plotted from available information and therefore, their locations must be considered approximate only. It is the responsibility of the individual Contractors to notify the utility companies before actual construction.

NOTE:  
All surface and subsurface conditions disturbed during construction shall be restored to equal or better condition by the contractor. This includes but not limited to, pavement, utilities and grass areas.


Note: If Rock is Not Encountered During Installation of M.H.#3, Eliminate the Drop and Install 146.83 L.F. - 8" PVC @ 4.36% Grade

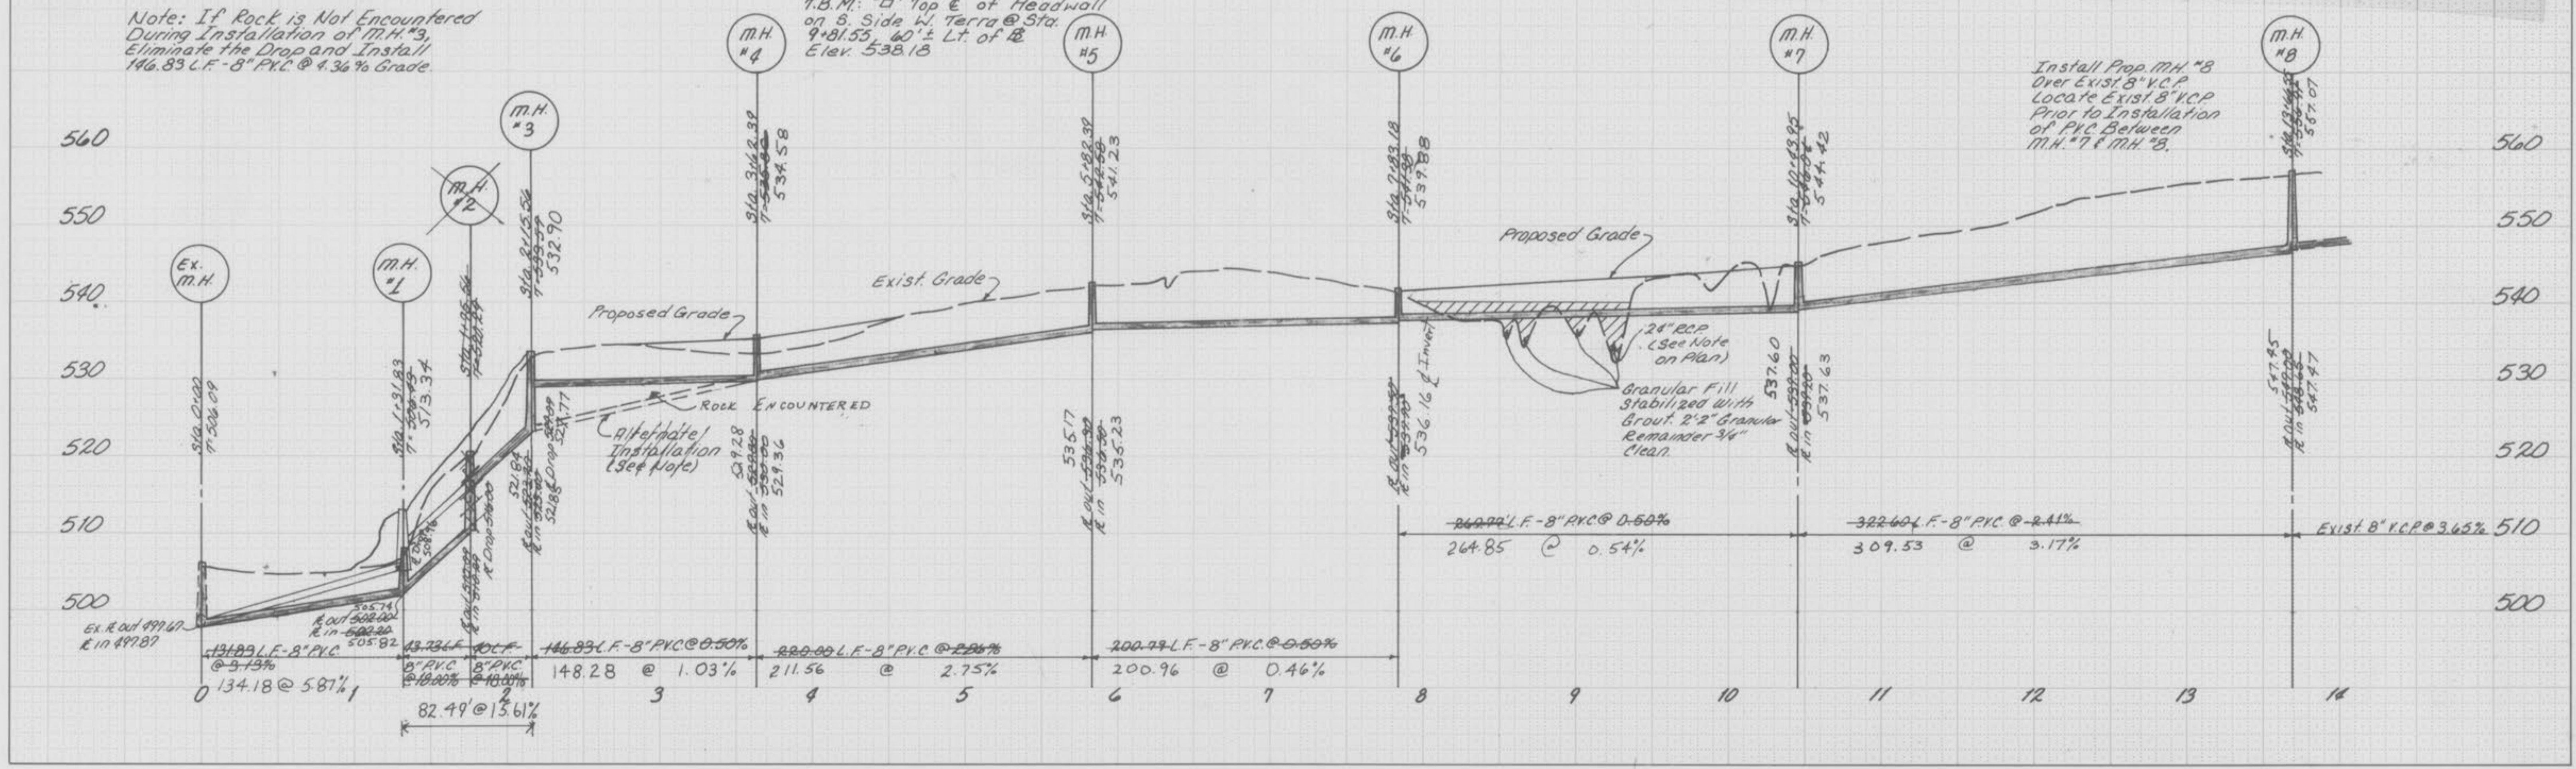

Install Prop M.H.#8 Over Exist 8" V.C.P. Locate Exist 8" V.C.P. Prior to Installation of PVC Between M.H.#7 & M.H.#8.

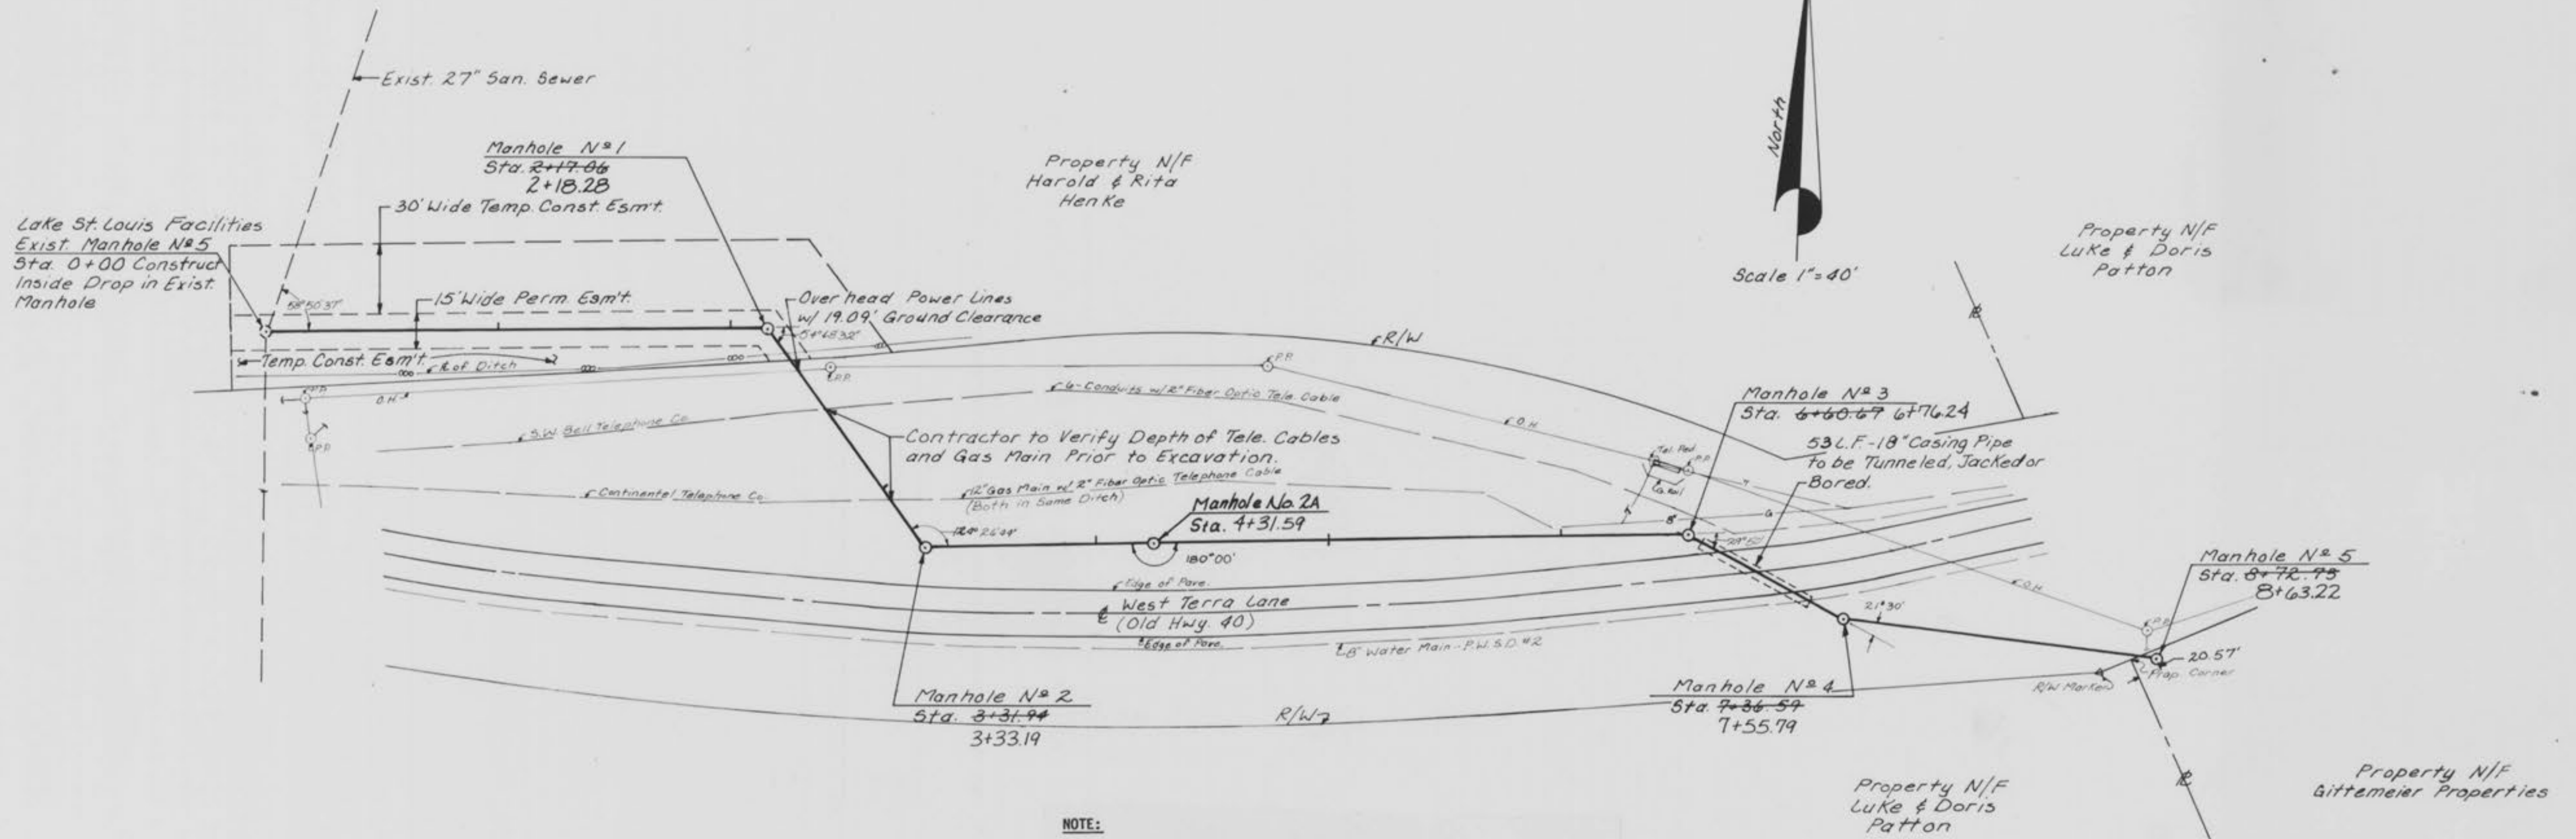

**NOTE:**  
 Existing underground (U/G), overhead (O.H.) utilities and drainage structures have been plotted from available information and therefore, their locations must be considered approximate only. It is the responsibility of the individual Contractors to notify the utility companies before actual construction.

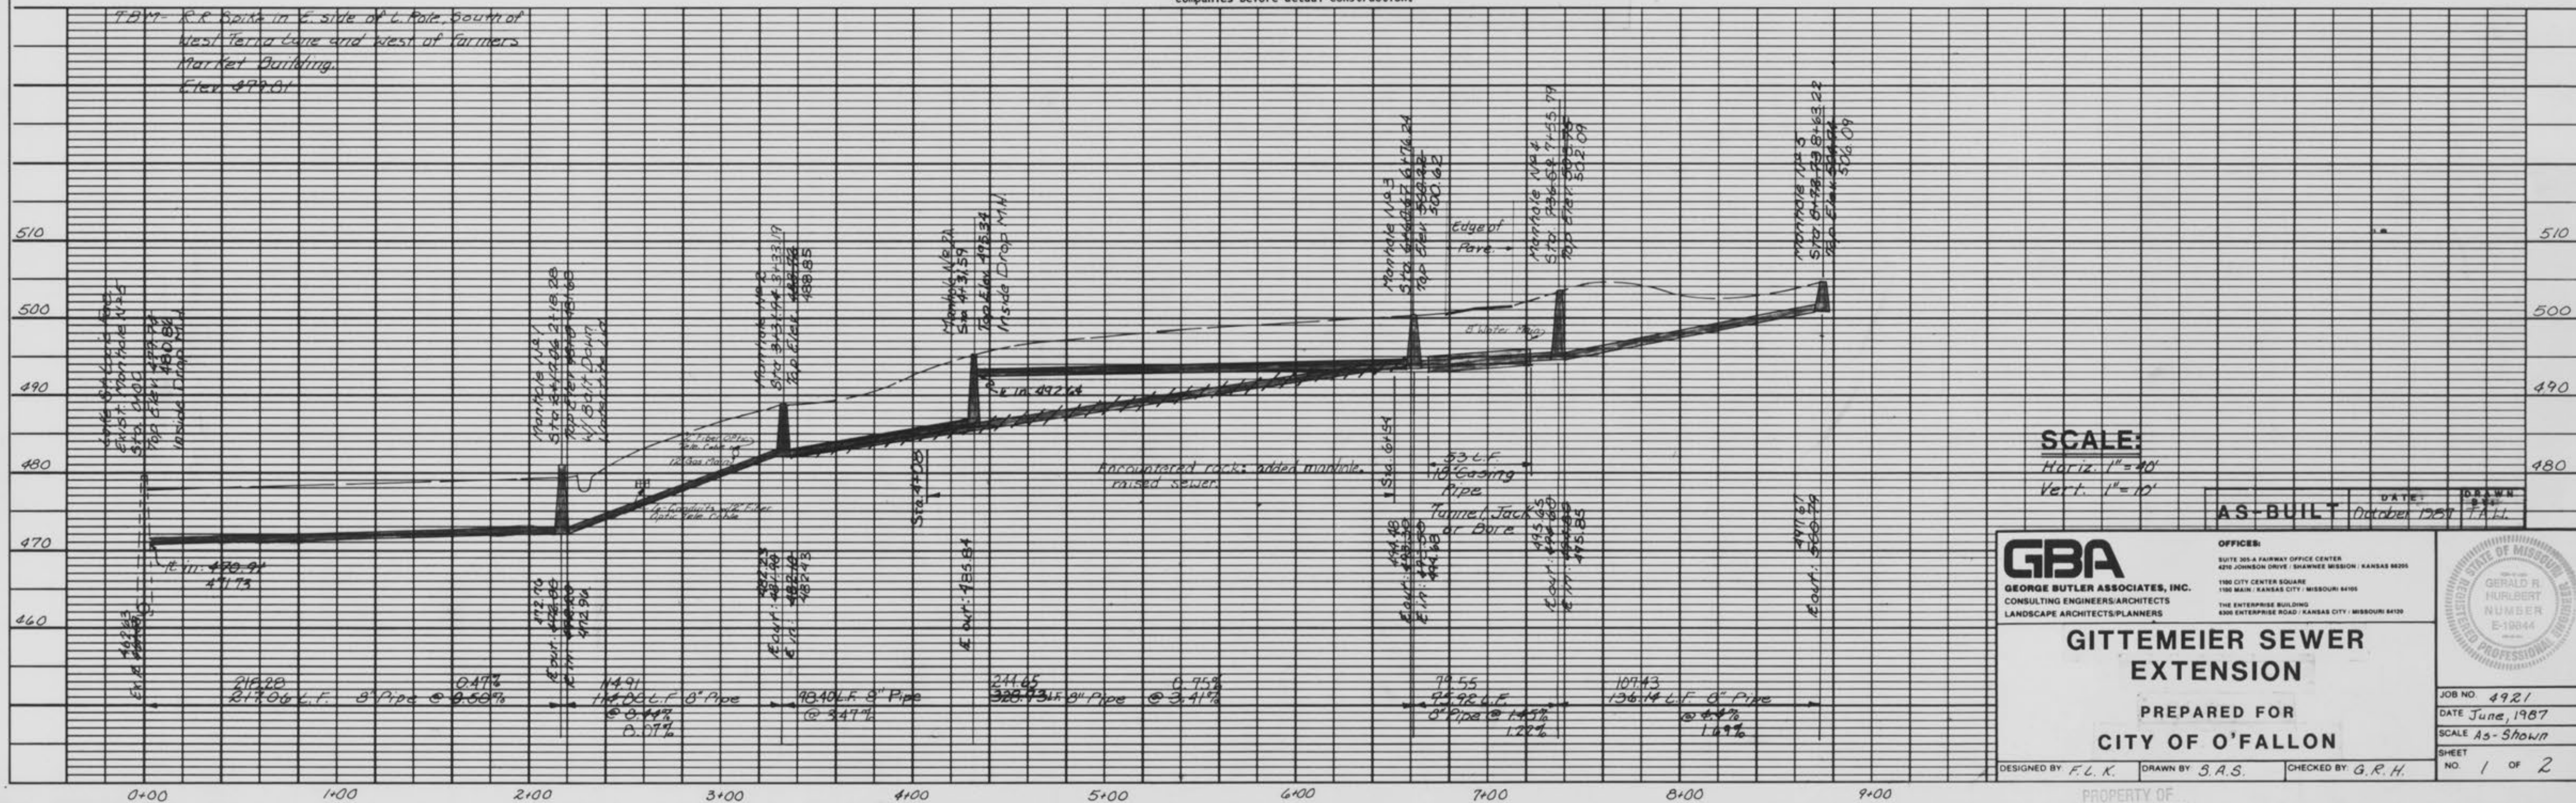

**SCALE:**  
 Horiz. 1"=40'  
 Vert. 1"=10'

**AS-BUILT** DATE: October 1987 DRAWN: T.A.H.

**GBA**  
 GEORGE BUTLER ASSOCIATES, INC.  
 CONSULTING ENGINEERS/ARCHITECTS  
 LANDSCAPE ARCHITECTS/PLANNERS

**OFFICES:**  
 SUITE 303-A FAIRWAY OFFICE CENTER  
 420 JOHNSON DRIVE, SACASSEE, MISSOURI, KANSAS 66088  
 100 CITY CENTER SQUARE  
 100 MAIN, KANSAS CITY, MISSOURI 64105  
 THE ENTERPRISE BUILDING  
 4300 ENTERPRISE ROAD, KANSAS CITY, MISSOURI 64109

**GITTEMEIER SEWER EXTENSION**

PREPARED FOR  
**CITY OF O'FALLON**

DESIGNED BY F.L.K. DRAWN BY S.A.S. CHECKED BY G.R.H.

PROPERTY OF  
 CITY OF O'FALLON  
 BUILDING DEPARTMENT

JOB NO. 4921  
 DATE June, 1987  
 SCALE As-Shown  
 SHEET NO. 1 OF 2