

FLAT PLAN
GLENWOOD

Sept. 1972 78-040
Rev. 10/1/77
Rev. 3/20/80 AS BUILTS storm & sanitary
sewers for Plots 1 & 2

N/F
STELLHORN, L.L. & E.
UNGERBOECK, D.K. & C.L.
7/22/42

N/F
LASK, CARL D. & K.
7/1/43

N/F
SCHRADER, OSCAR
8/1/76

Note:
All Fire Hydrants shall be
Miller Breakaway 2-2 1/2"
Open & 1-2 1/2" Stream Nozzle,
w/aux. Shut-off Valve.




NOTE:
Underground utilities and structures have
been plotted from available information and
therefore, their location must be considered
approximate only. It is the responsibility
of the individual contractors to notify the
utility companies before actual const. is
made.


Note:
Construct 1' Berm!!!

PROPERTY OF
CITY OF O'FALLON
BUILDING DEPARTMENT

2
25

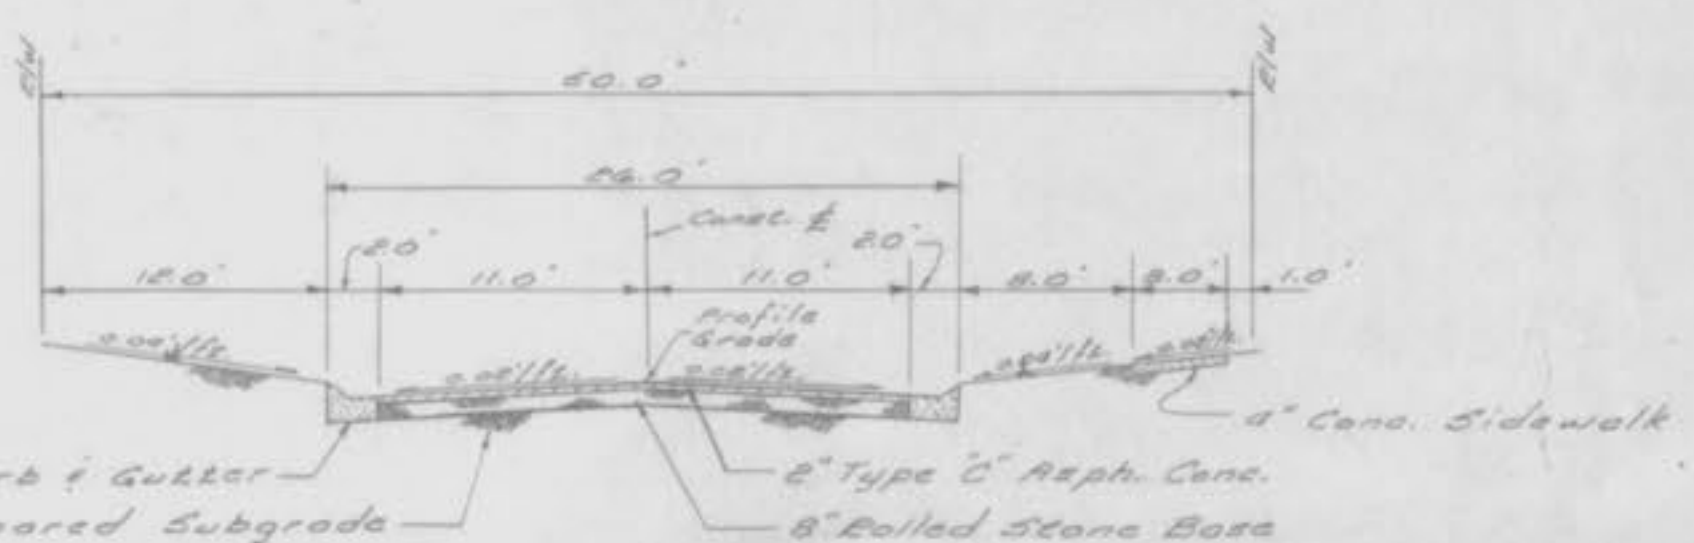

Typical Pavement Section
Minor Residential
(Not to Scale)

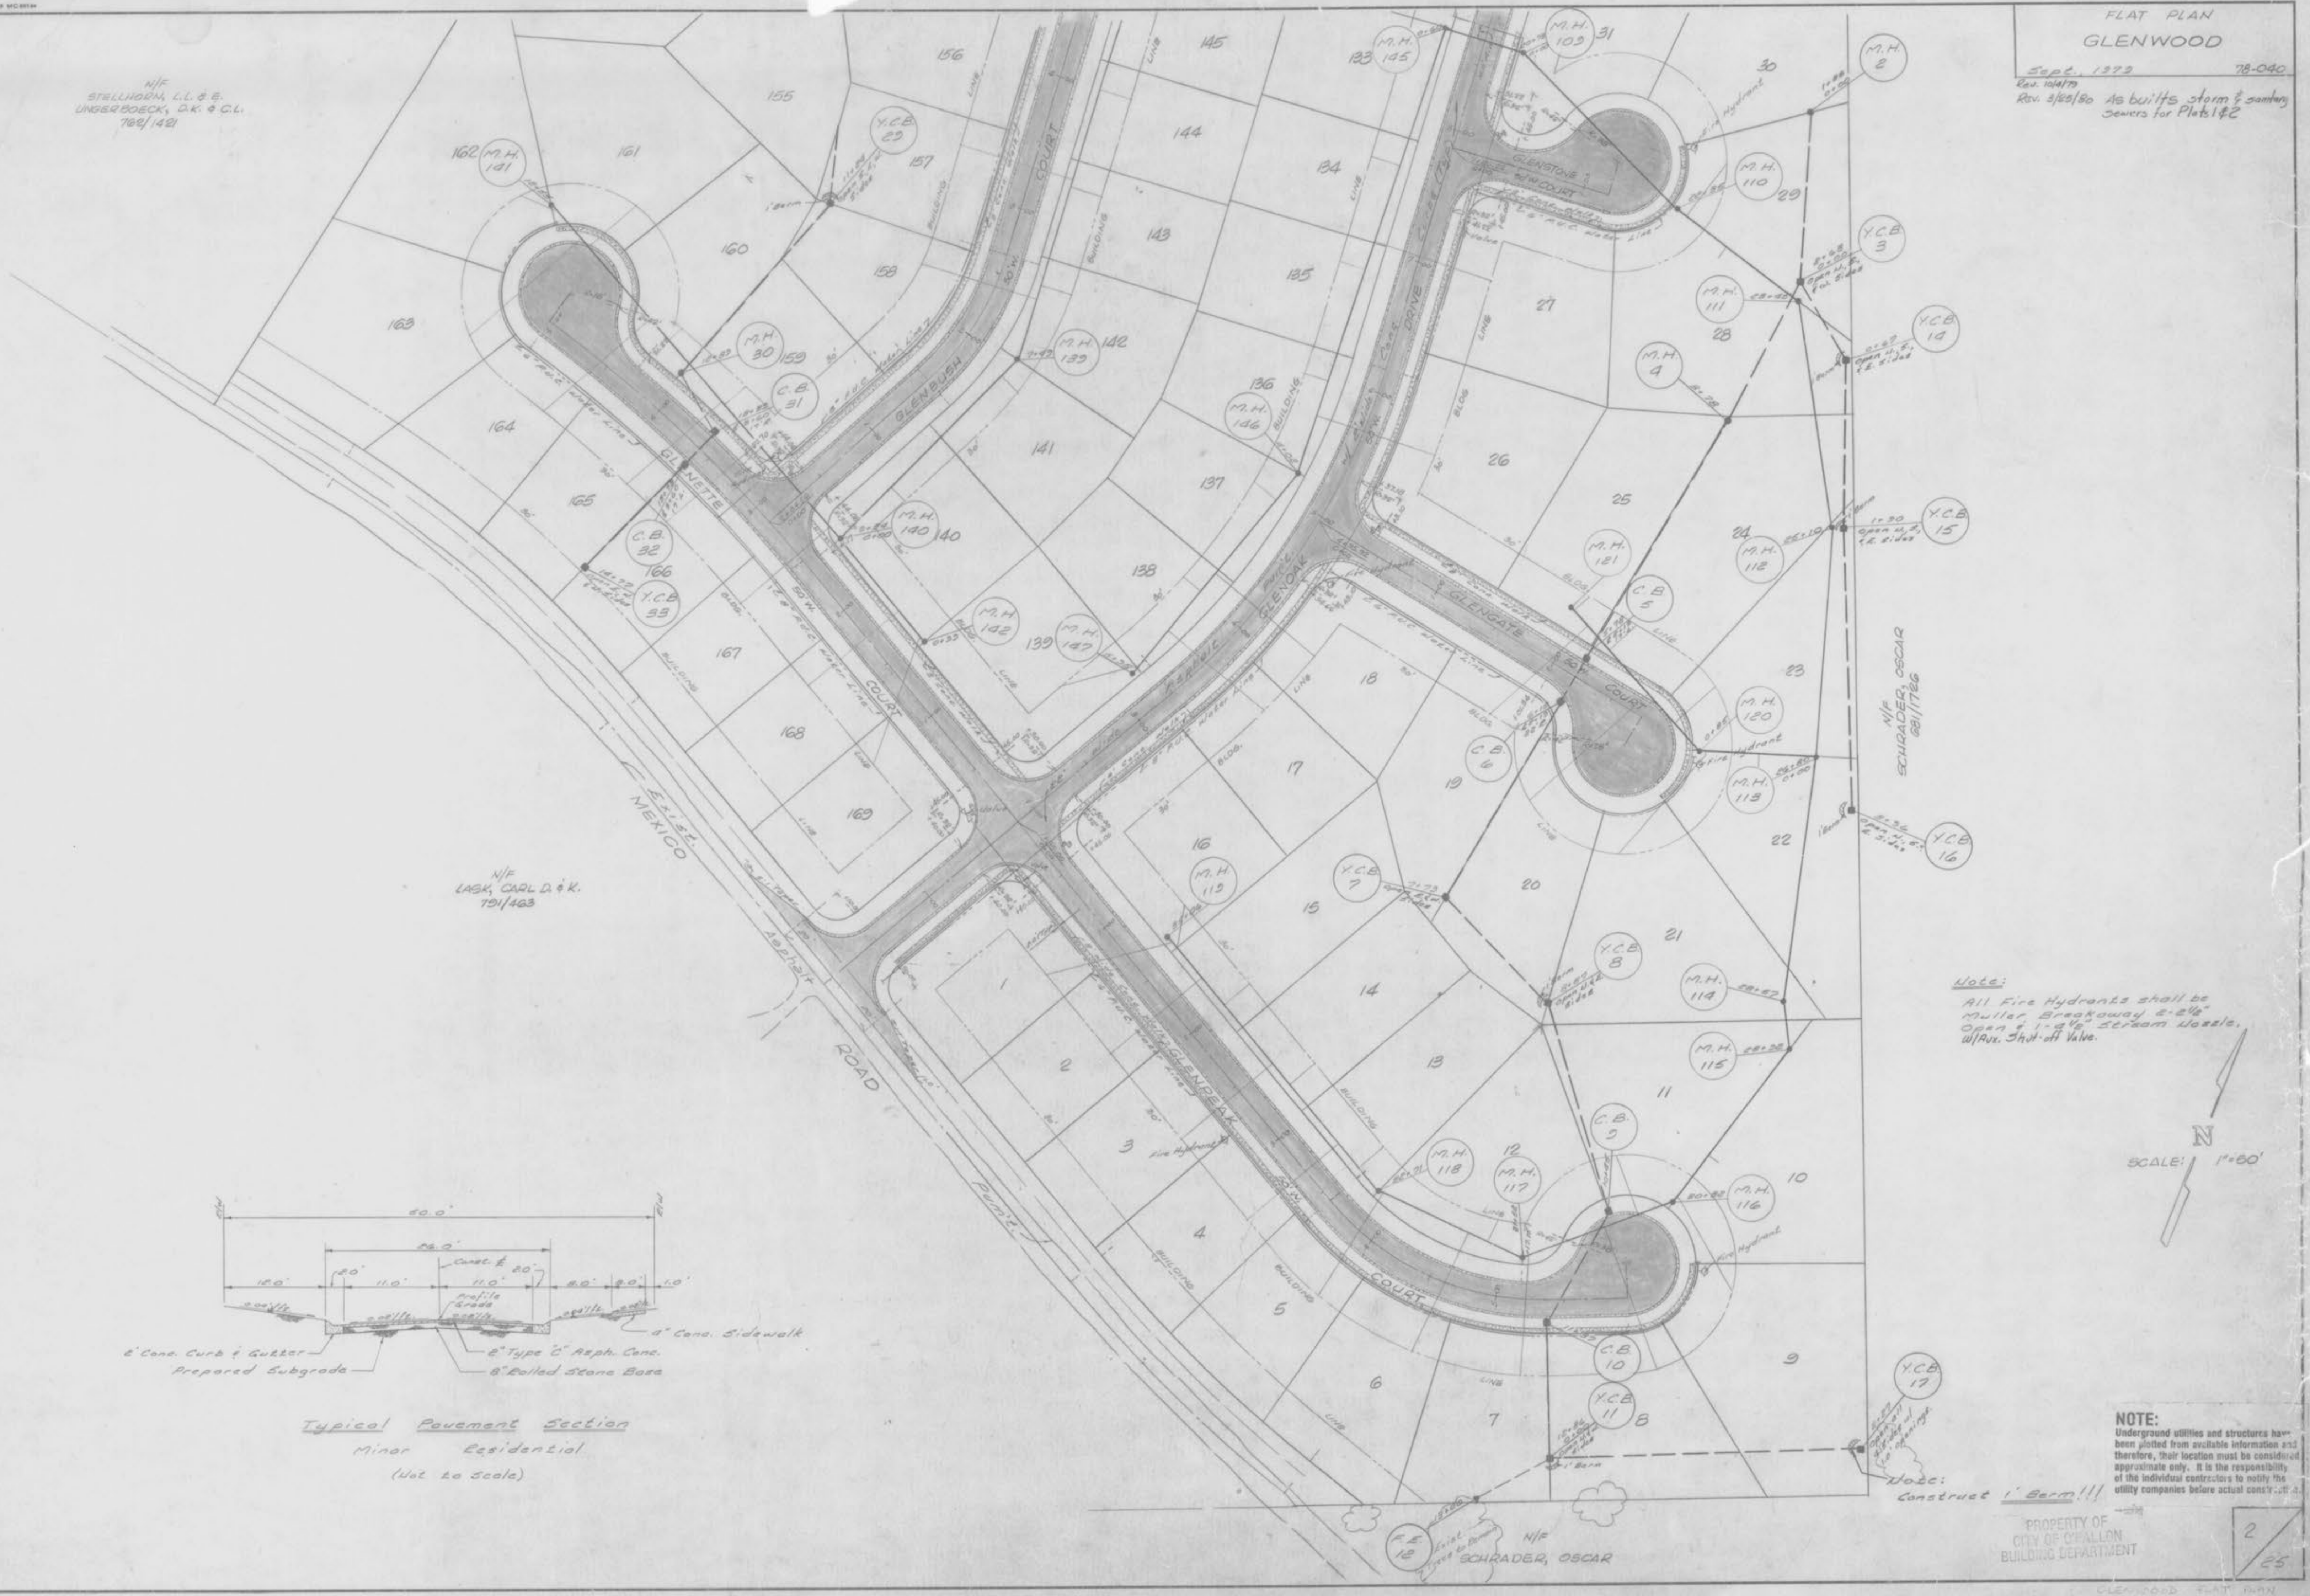

FLAT PLAN
GLENWOOD

Sept. 1973 78-040
Rev. 3/25/80 As built storm and
sanitary sewers Plots 1&2



N/F
HORVAT

N/F
CRANGLE, R.J. & J.E.
740/782

N/F
STELLHORN, L.L. & E.
UNGERBOECK, D.K. & C.L.
762/1421

N/F
SCHRAEDER, OSCAR
681/1726

PROPERTY OF
CITY OF O'FALLON
BUILDING DEPARTMENT


NOTE:
Underground utilities and structures have
been plotted from available information and
therefore, their location must be considered
approximate only. It is the responsibility
of the individual contractors to notify the
utility companies before actual construction.

N/F
HORVAT

BELLEAU LAKE ESTATES
448/78

N/F
SCHRADER, OSCAR
681/1766

SCALE: 1"=50'

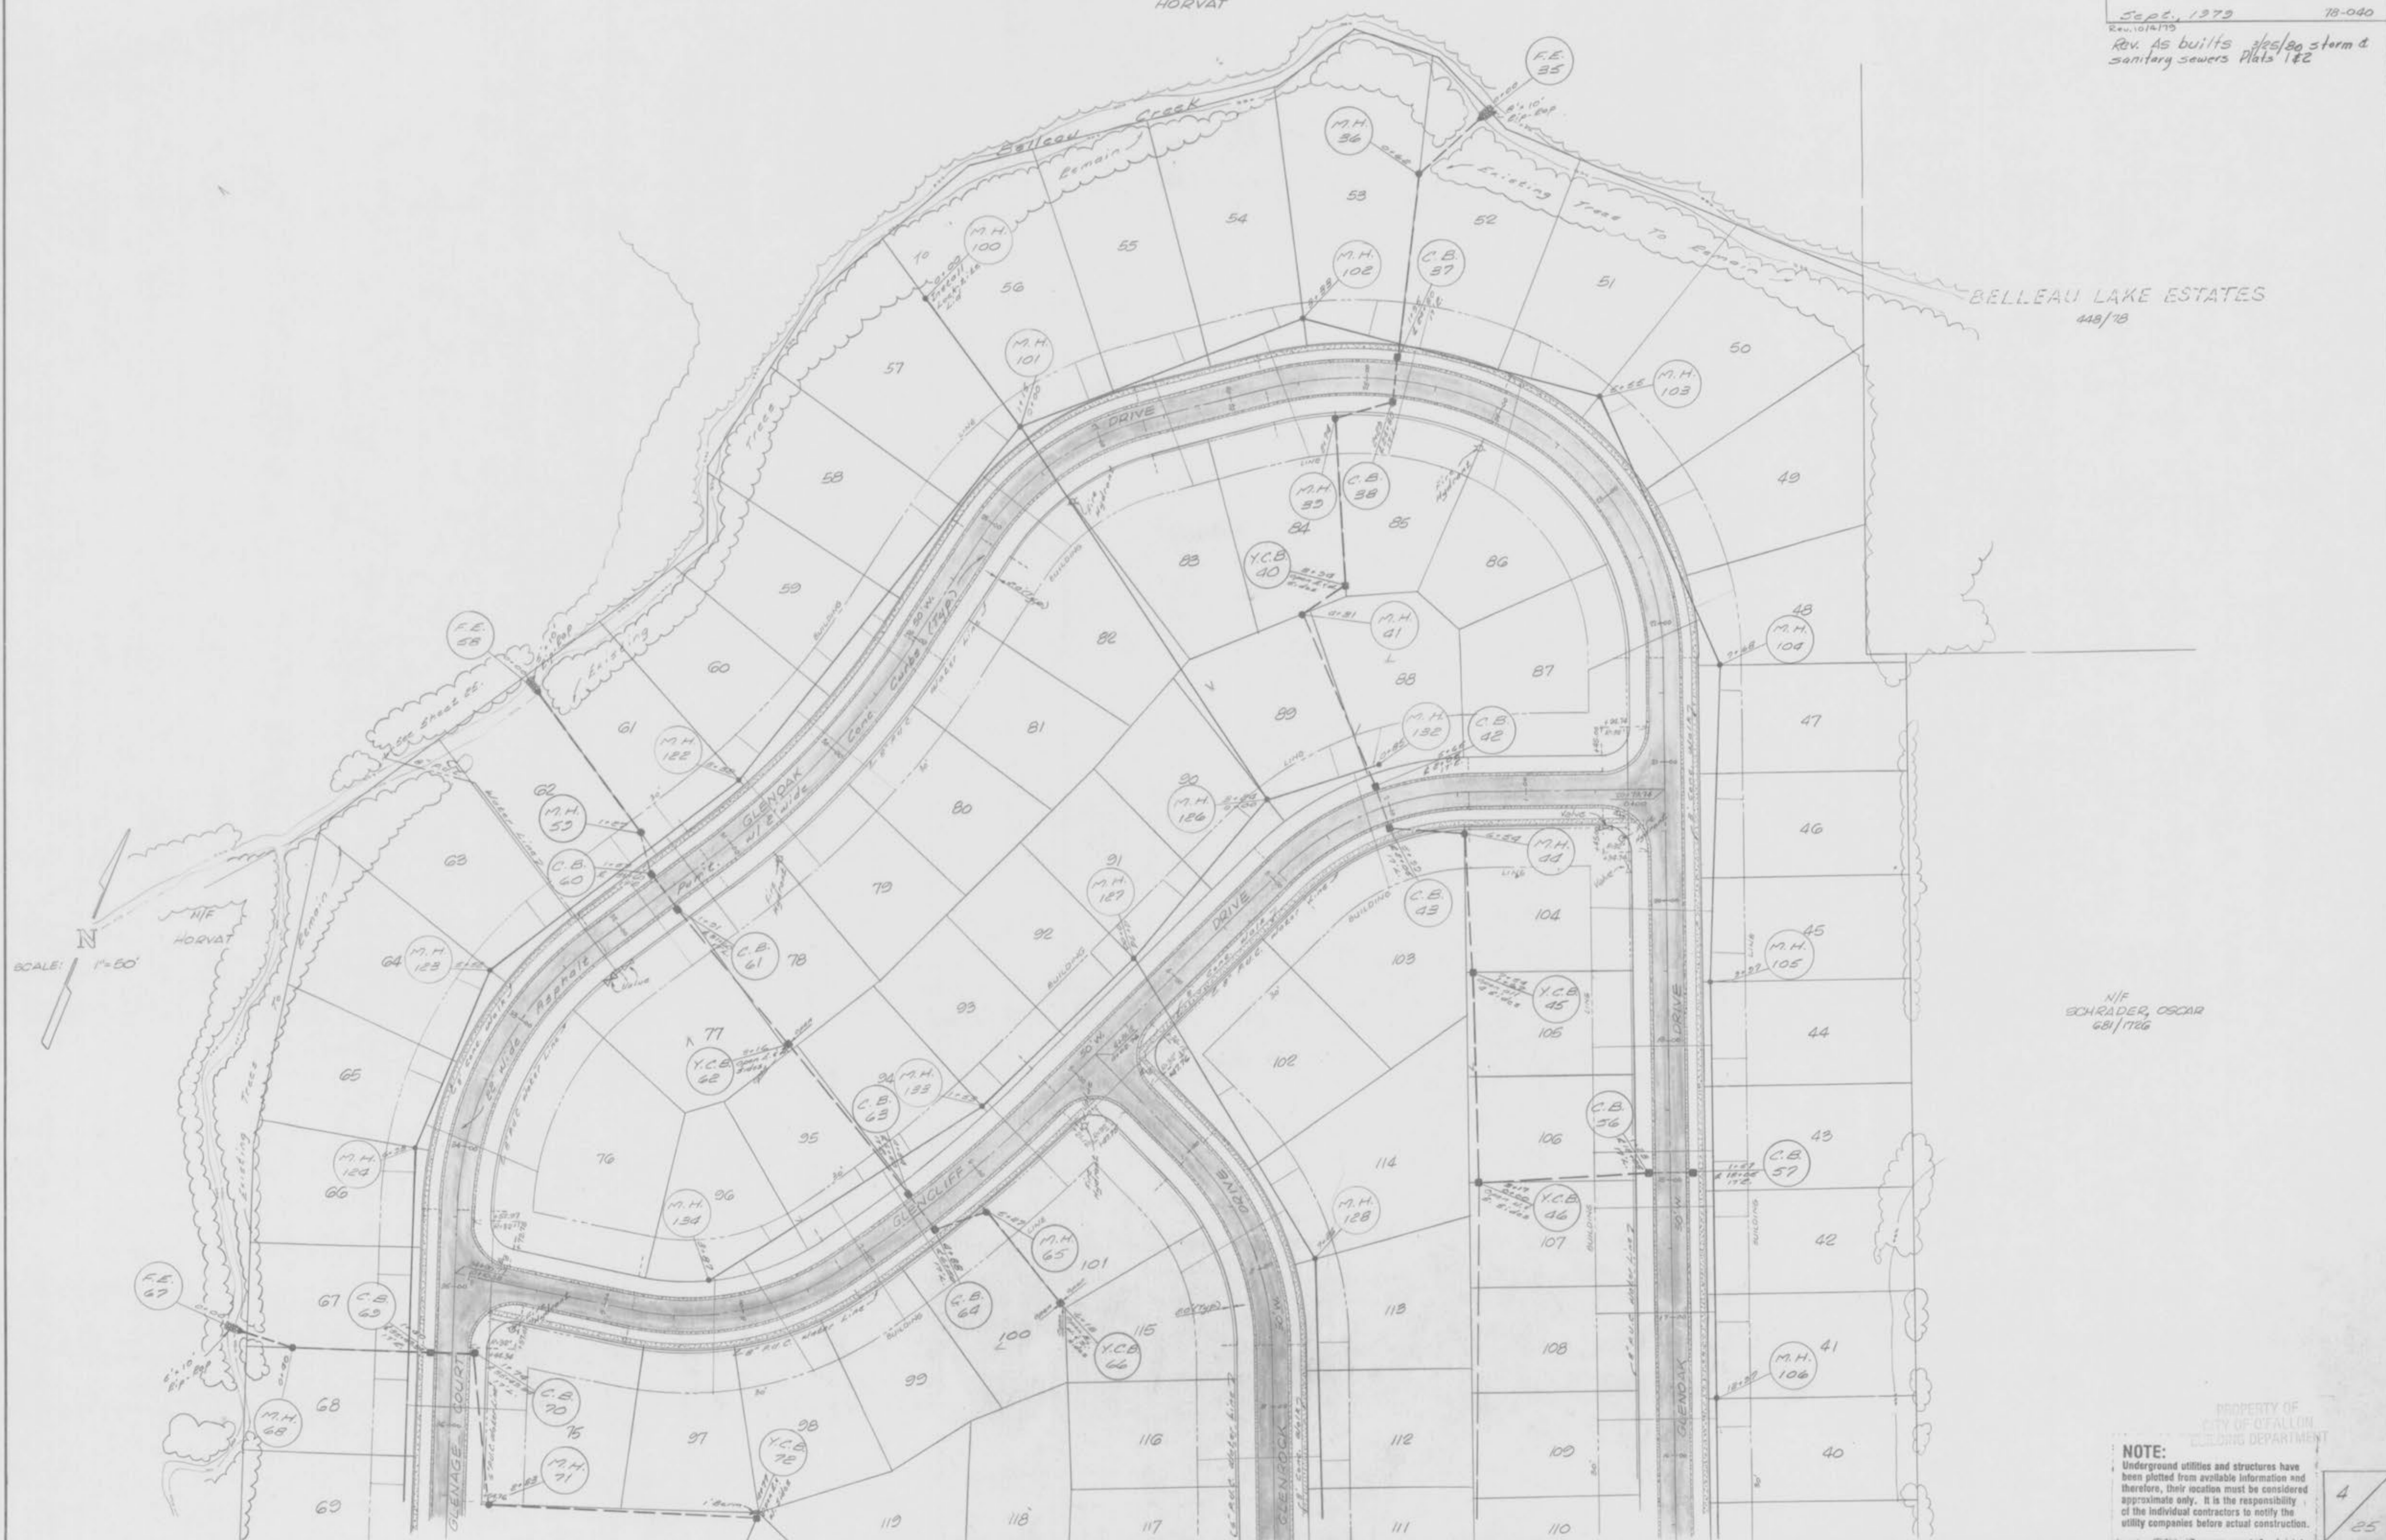


PROPERTY OF
CITY OF FALLON
BUILDING DEPARTMENT

NOTE:
Underground utilities and structures have been plotted from available information and therefore, their location must be considered approximate only. It is the responsibility of the individual contractors to notify the utility companies before actual construction.

Sanitary Sewer Profiles
 Glenwood
 Sept. 1973 78-040
 Rev. 10/20/78 - as built (S.M.)

DATE
 BY
 SURVEY
 PLOTTED
 TEMPLATE
 ANKAS CHECKED

DATE
 BY
 SURVEY
 PLOTTED
 TEMPLATE
 ANKAS CHECKED

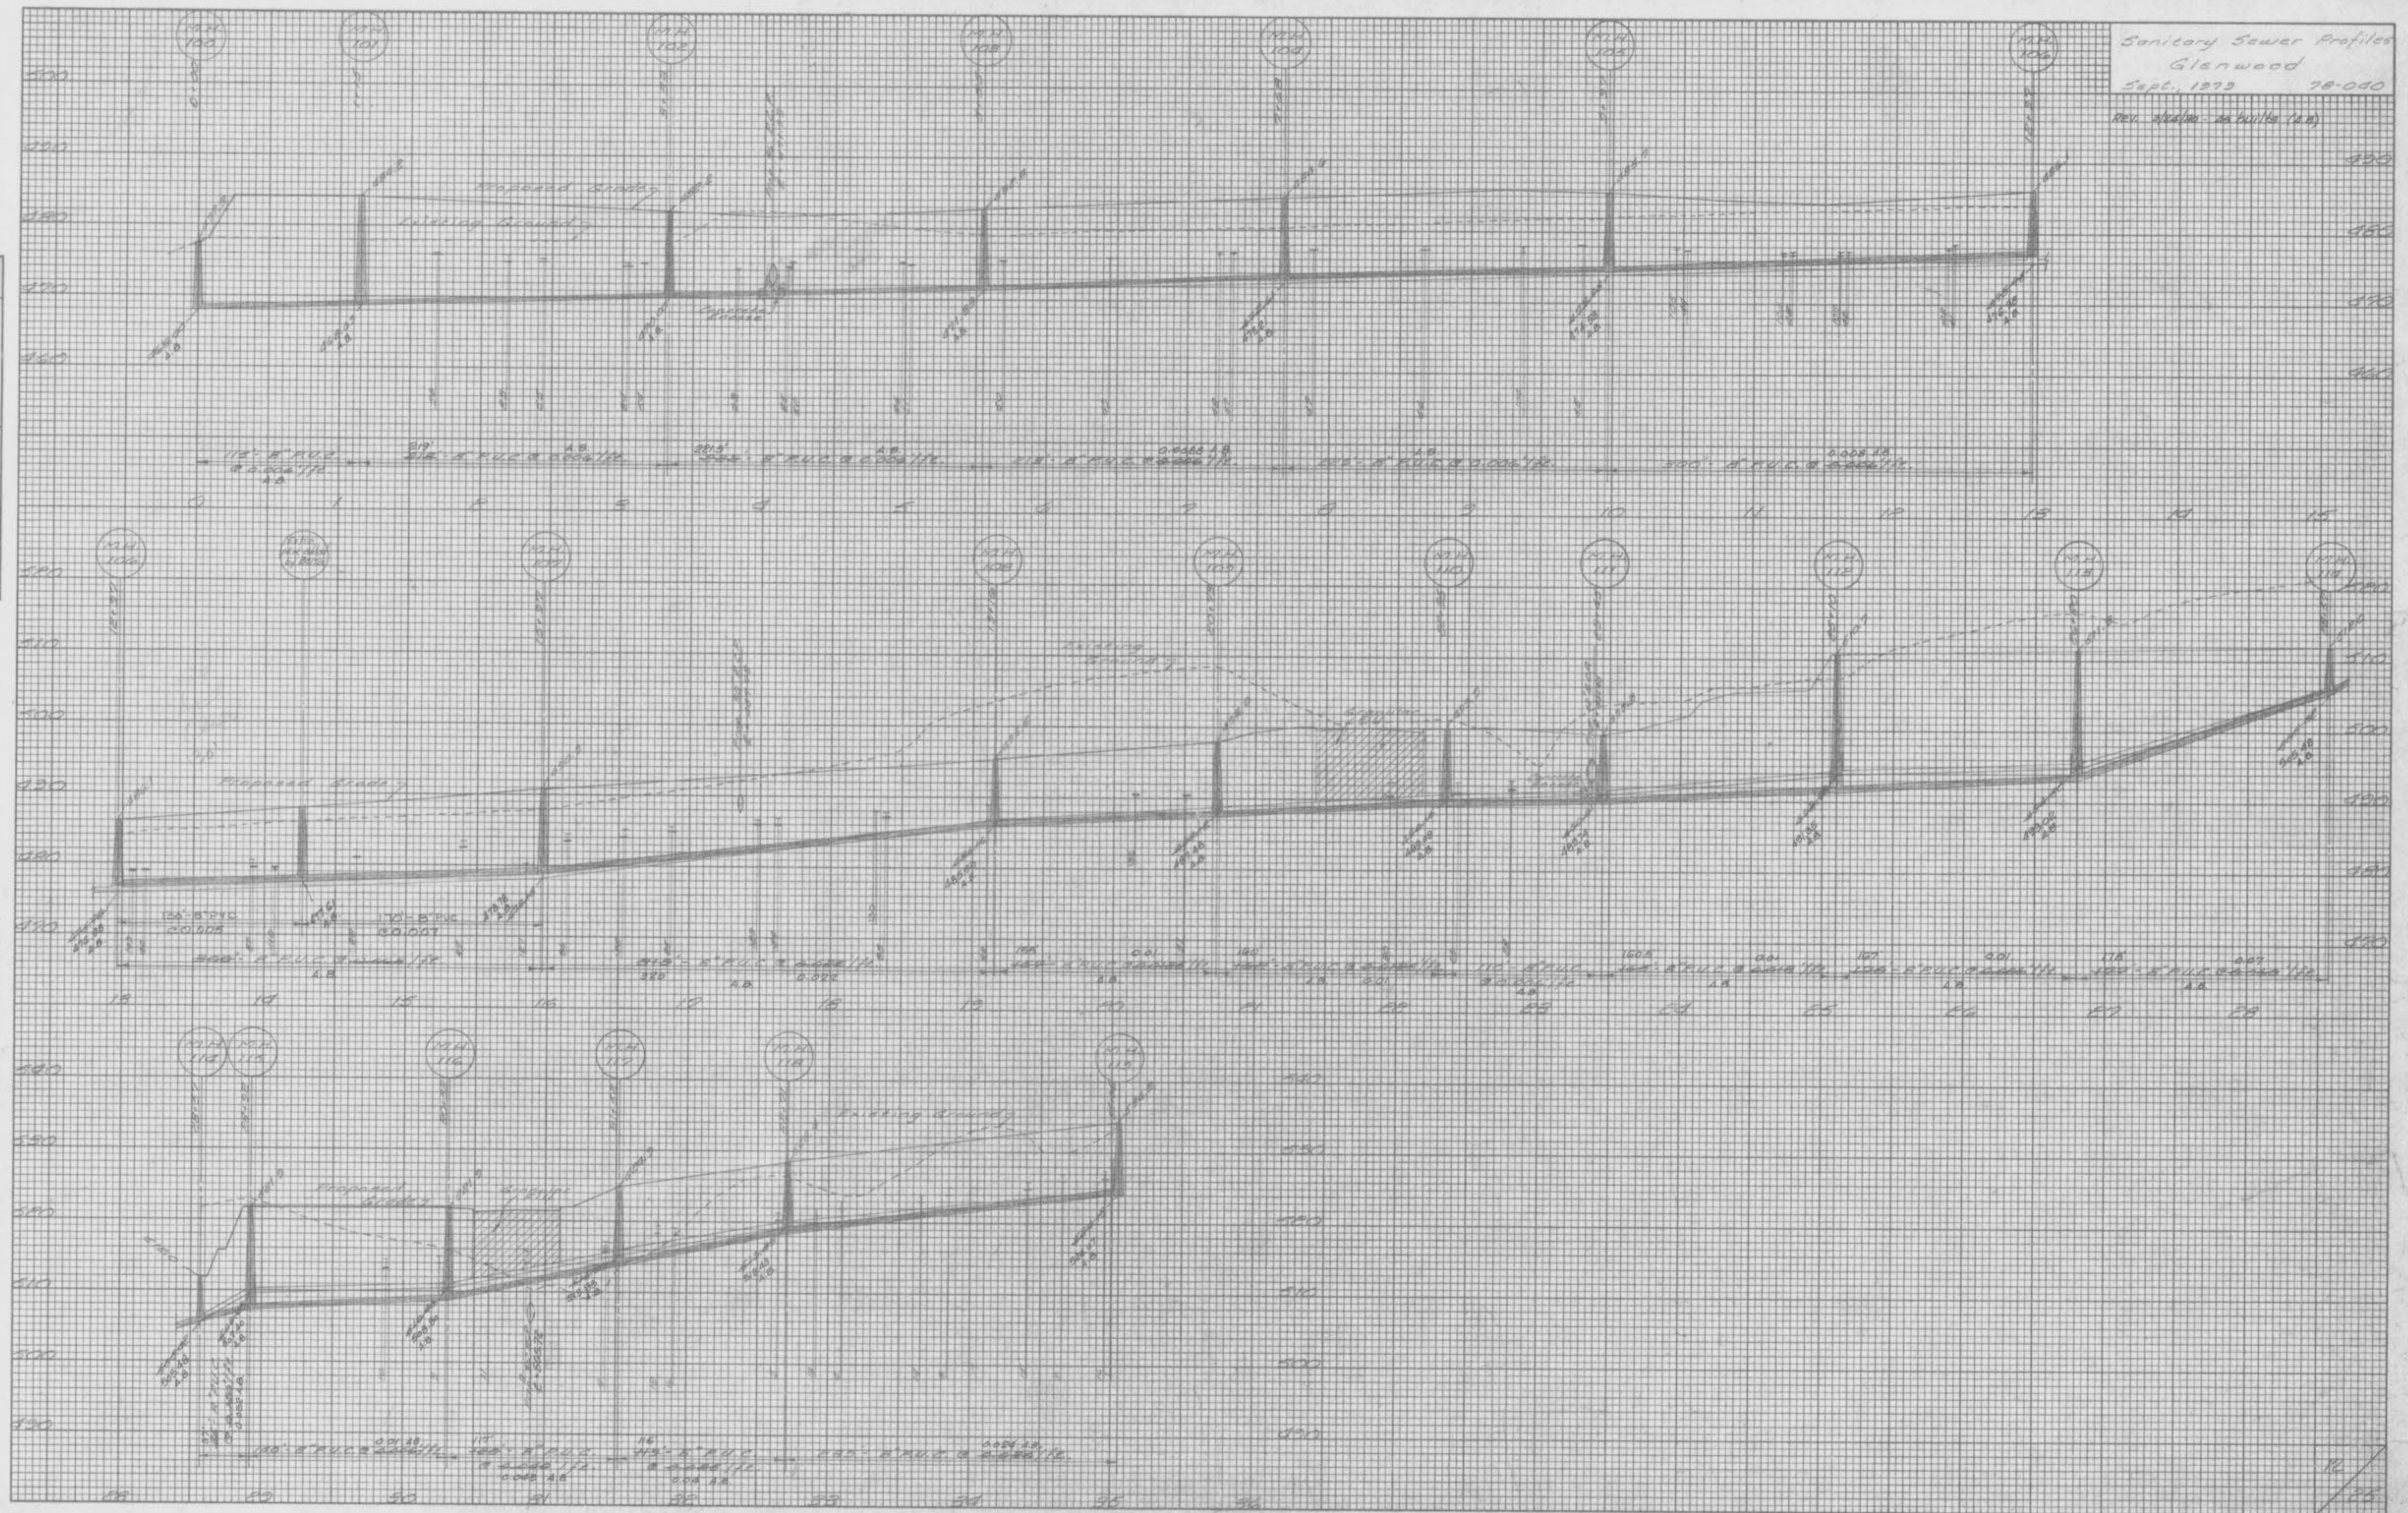


K-E PLATE 3, CROSS SECTION
 48 7050 MADE IN U.S.A.


PROPERTY OF
 CITY OF OMAHA
 BUILDING DEPARTMENT
 GLENWOOD
 SANITARY SEWER PROFILES
 78-040

Sanitary Sewer Profiles
 Glenwood
 Sept. 1979. 78-040
 Rev. 9/21/80 as built (A.B.)

DATE
 BY
 SURVEYED
 PLOTTED
 CHECKED
 ORIGINAL SURVEY
 NOTE BOOK
 AREAS CHECKED
 NO.

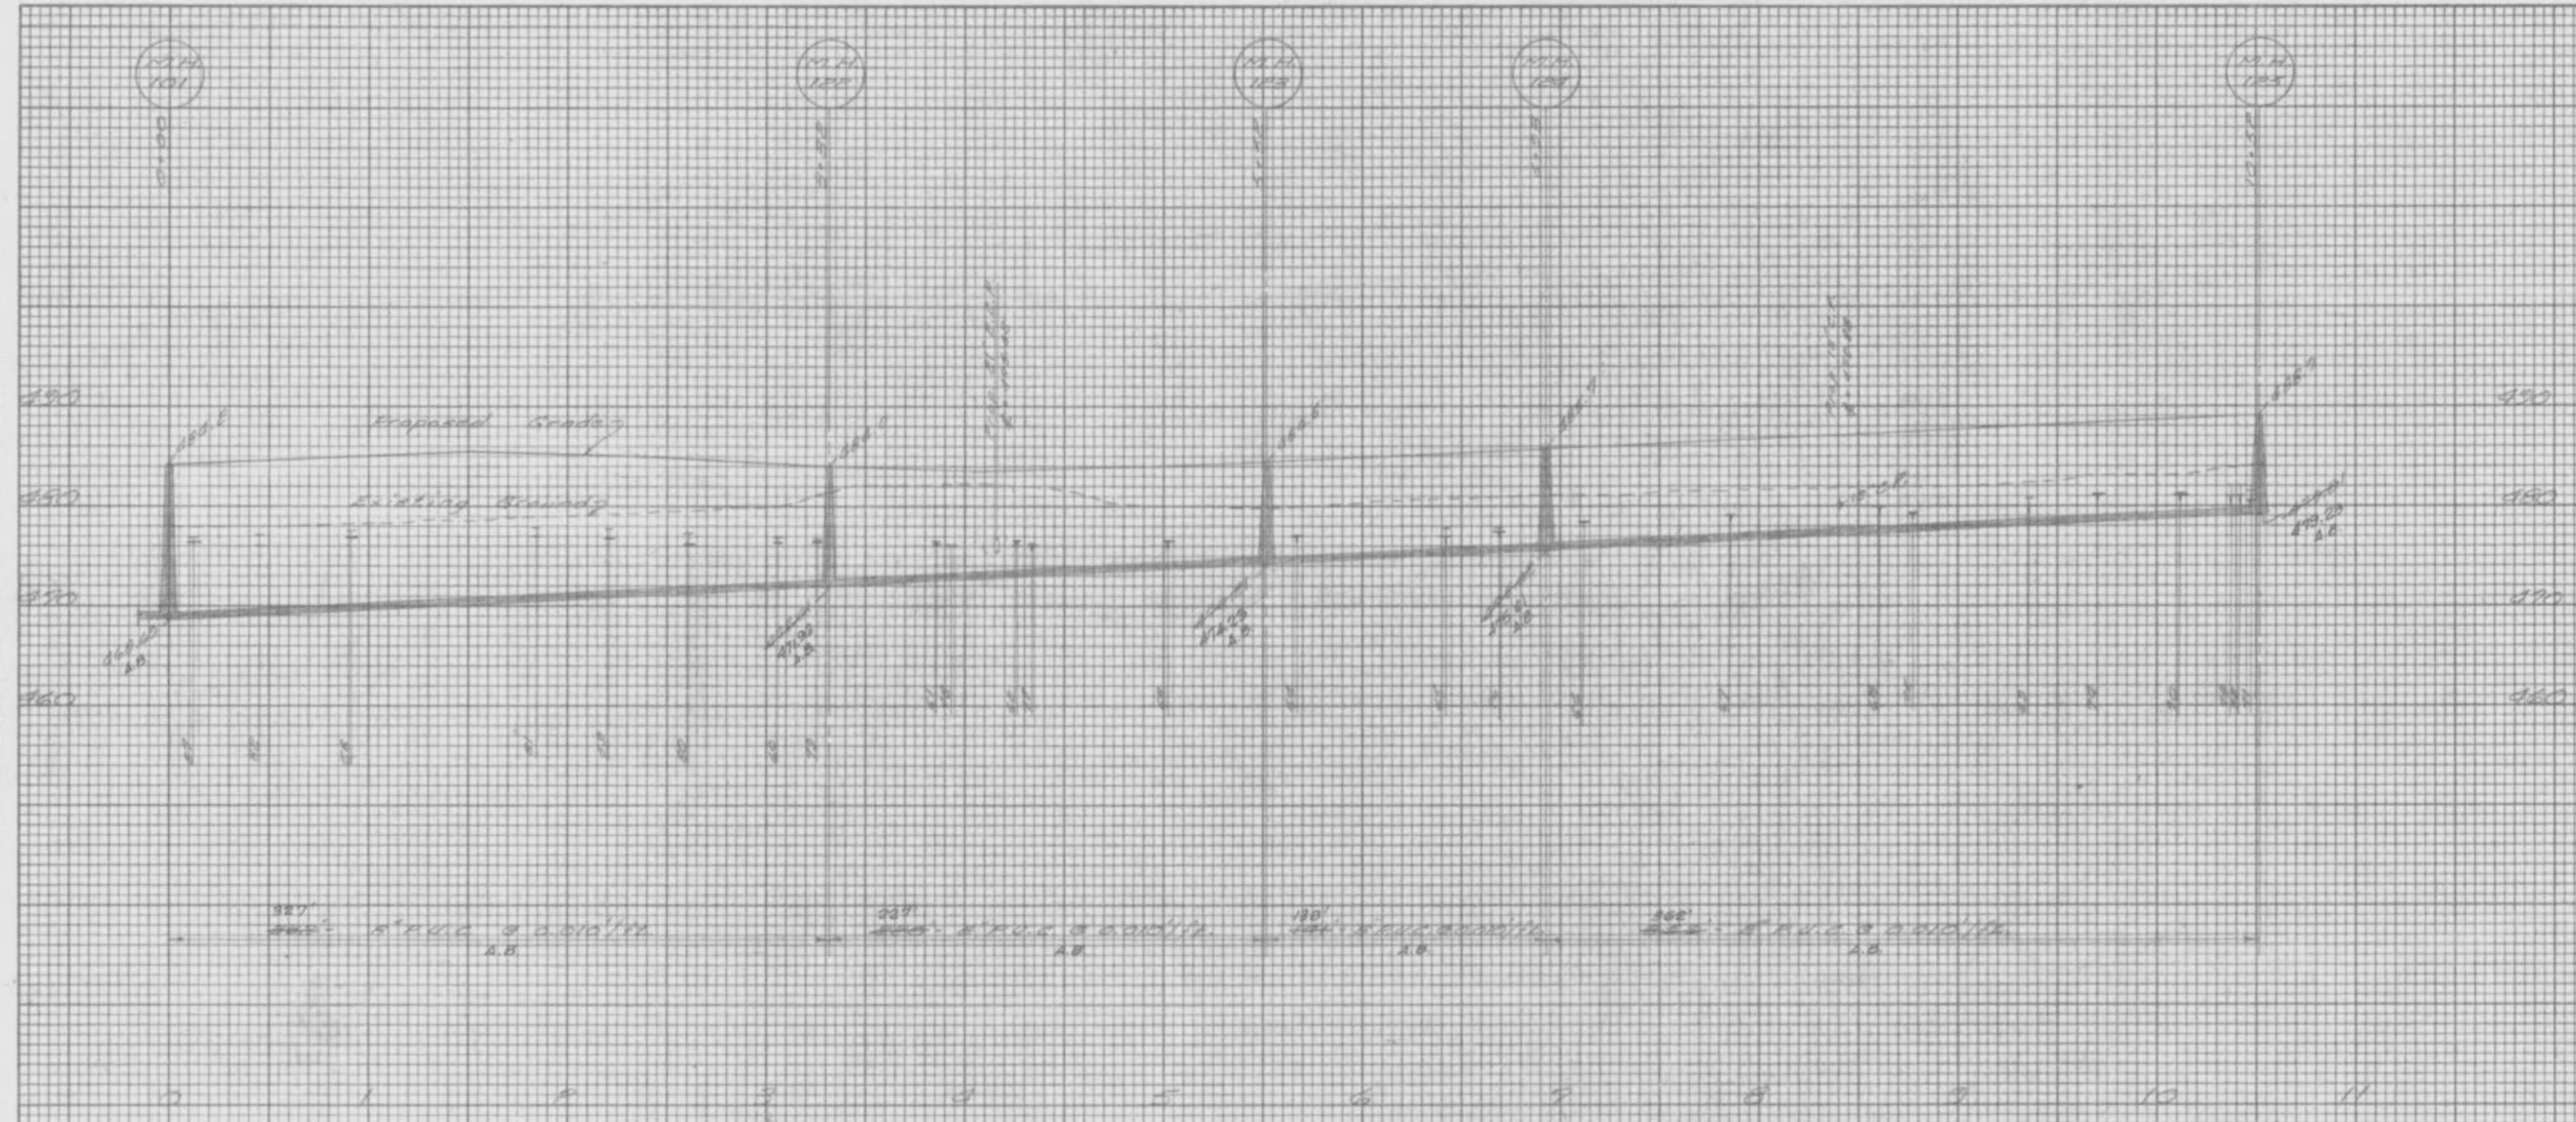


DATE
 BY
 SURVEYED
 PLOTTED
 CHECKED
 ORIGINAL SURVEY
 NOTE BOOK
 AREAS CHECKED
 NO.

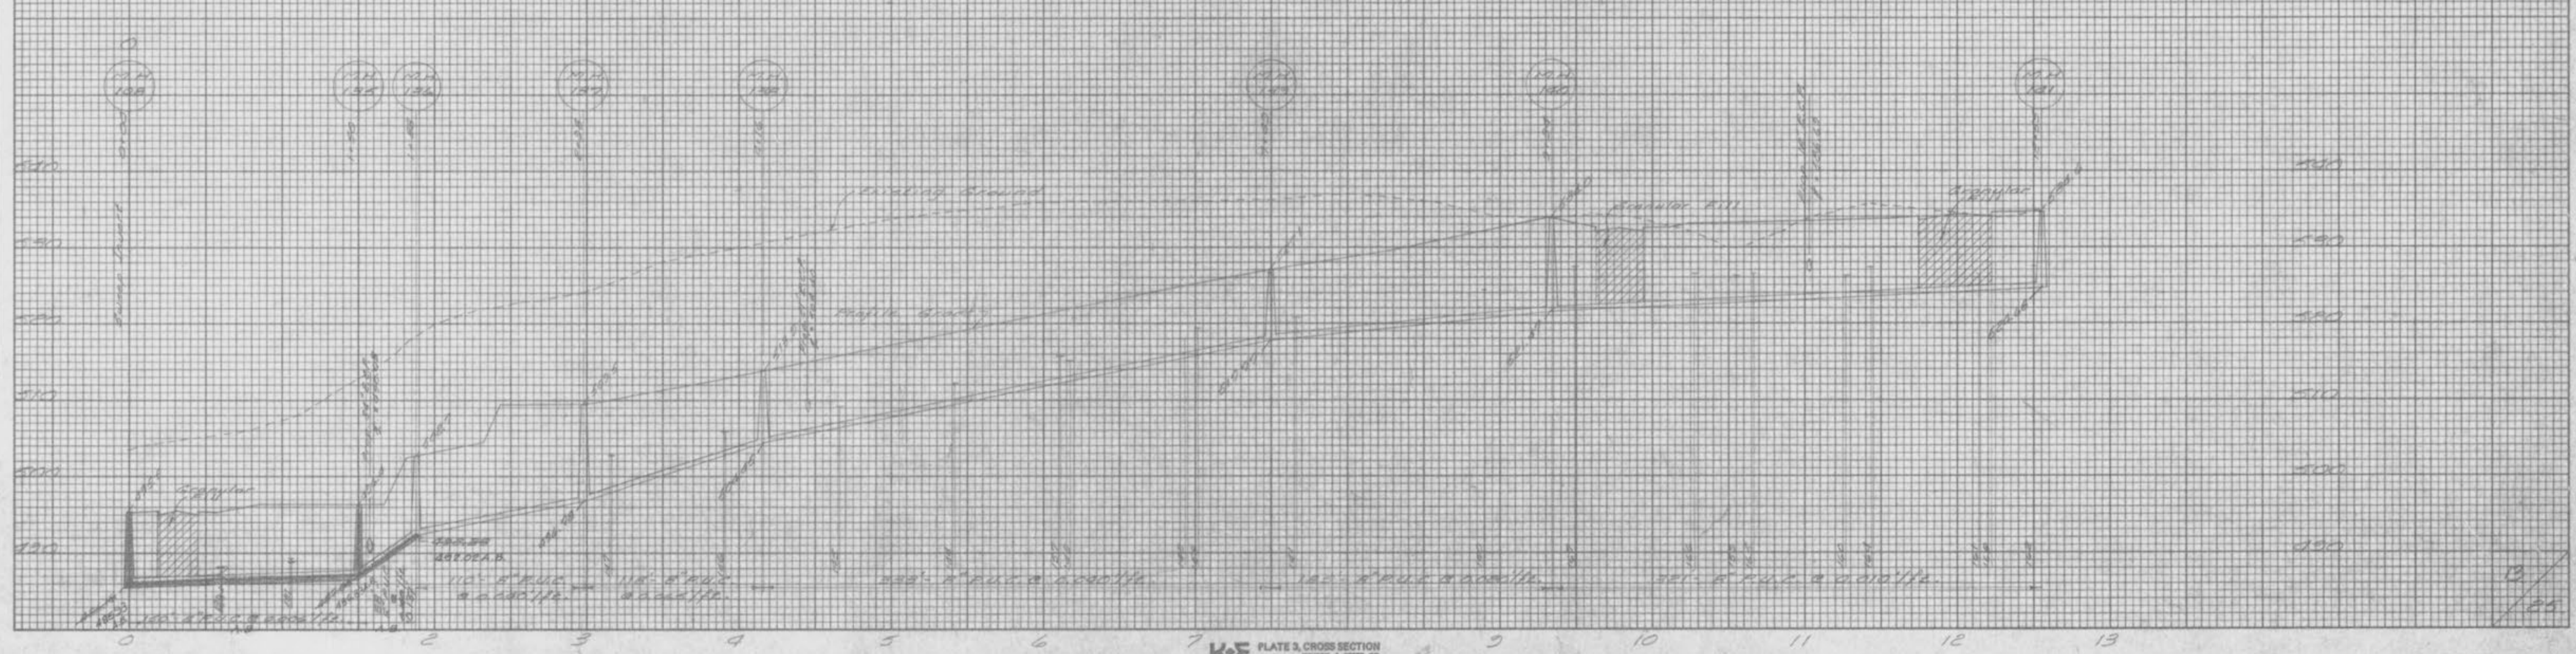

K-E PLATE 3, CROSS SECTION
 EAGLE & KERR CO.
 46 7050 MADE IN U.S.A.

PROPERTY OF
 CITY OF GLENWOOD
 BUILDING DEPARTMENT
 GLENWOOD
 SANITARY SEWER PROFILES
 AS BUILT

Sanitary Sewer Profiles
 Glenwood
 Sept. 1939 28-050

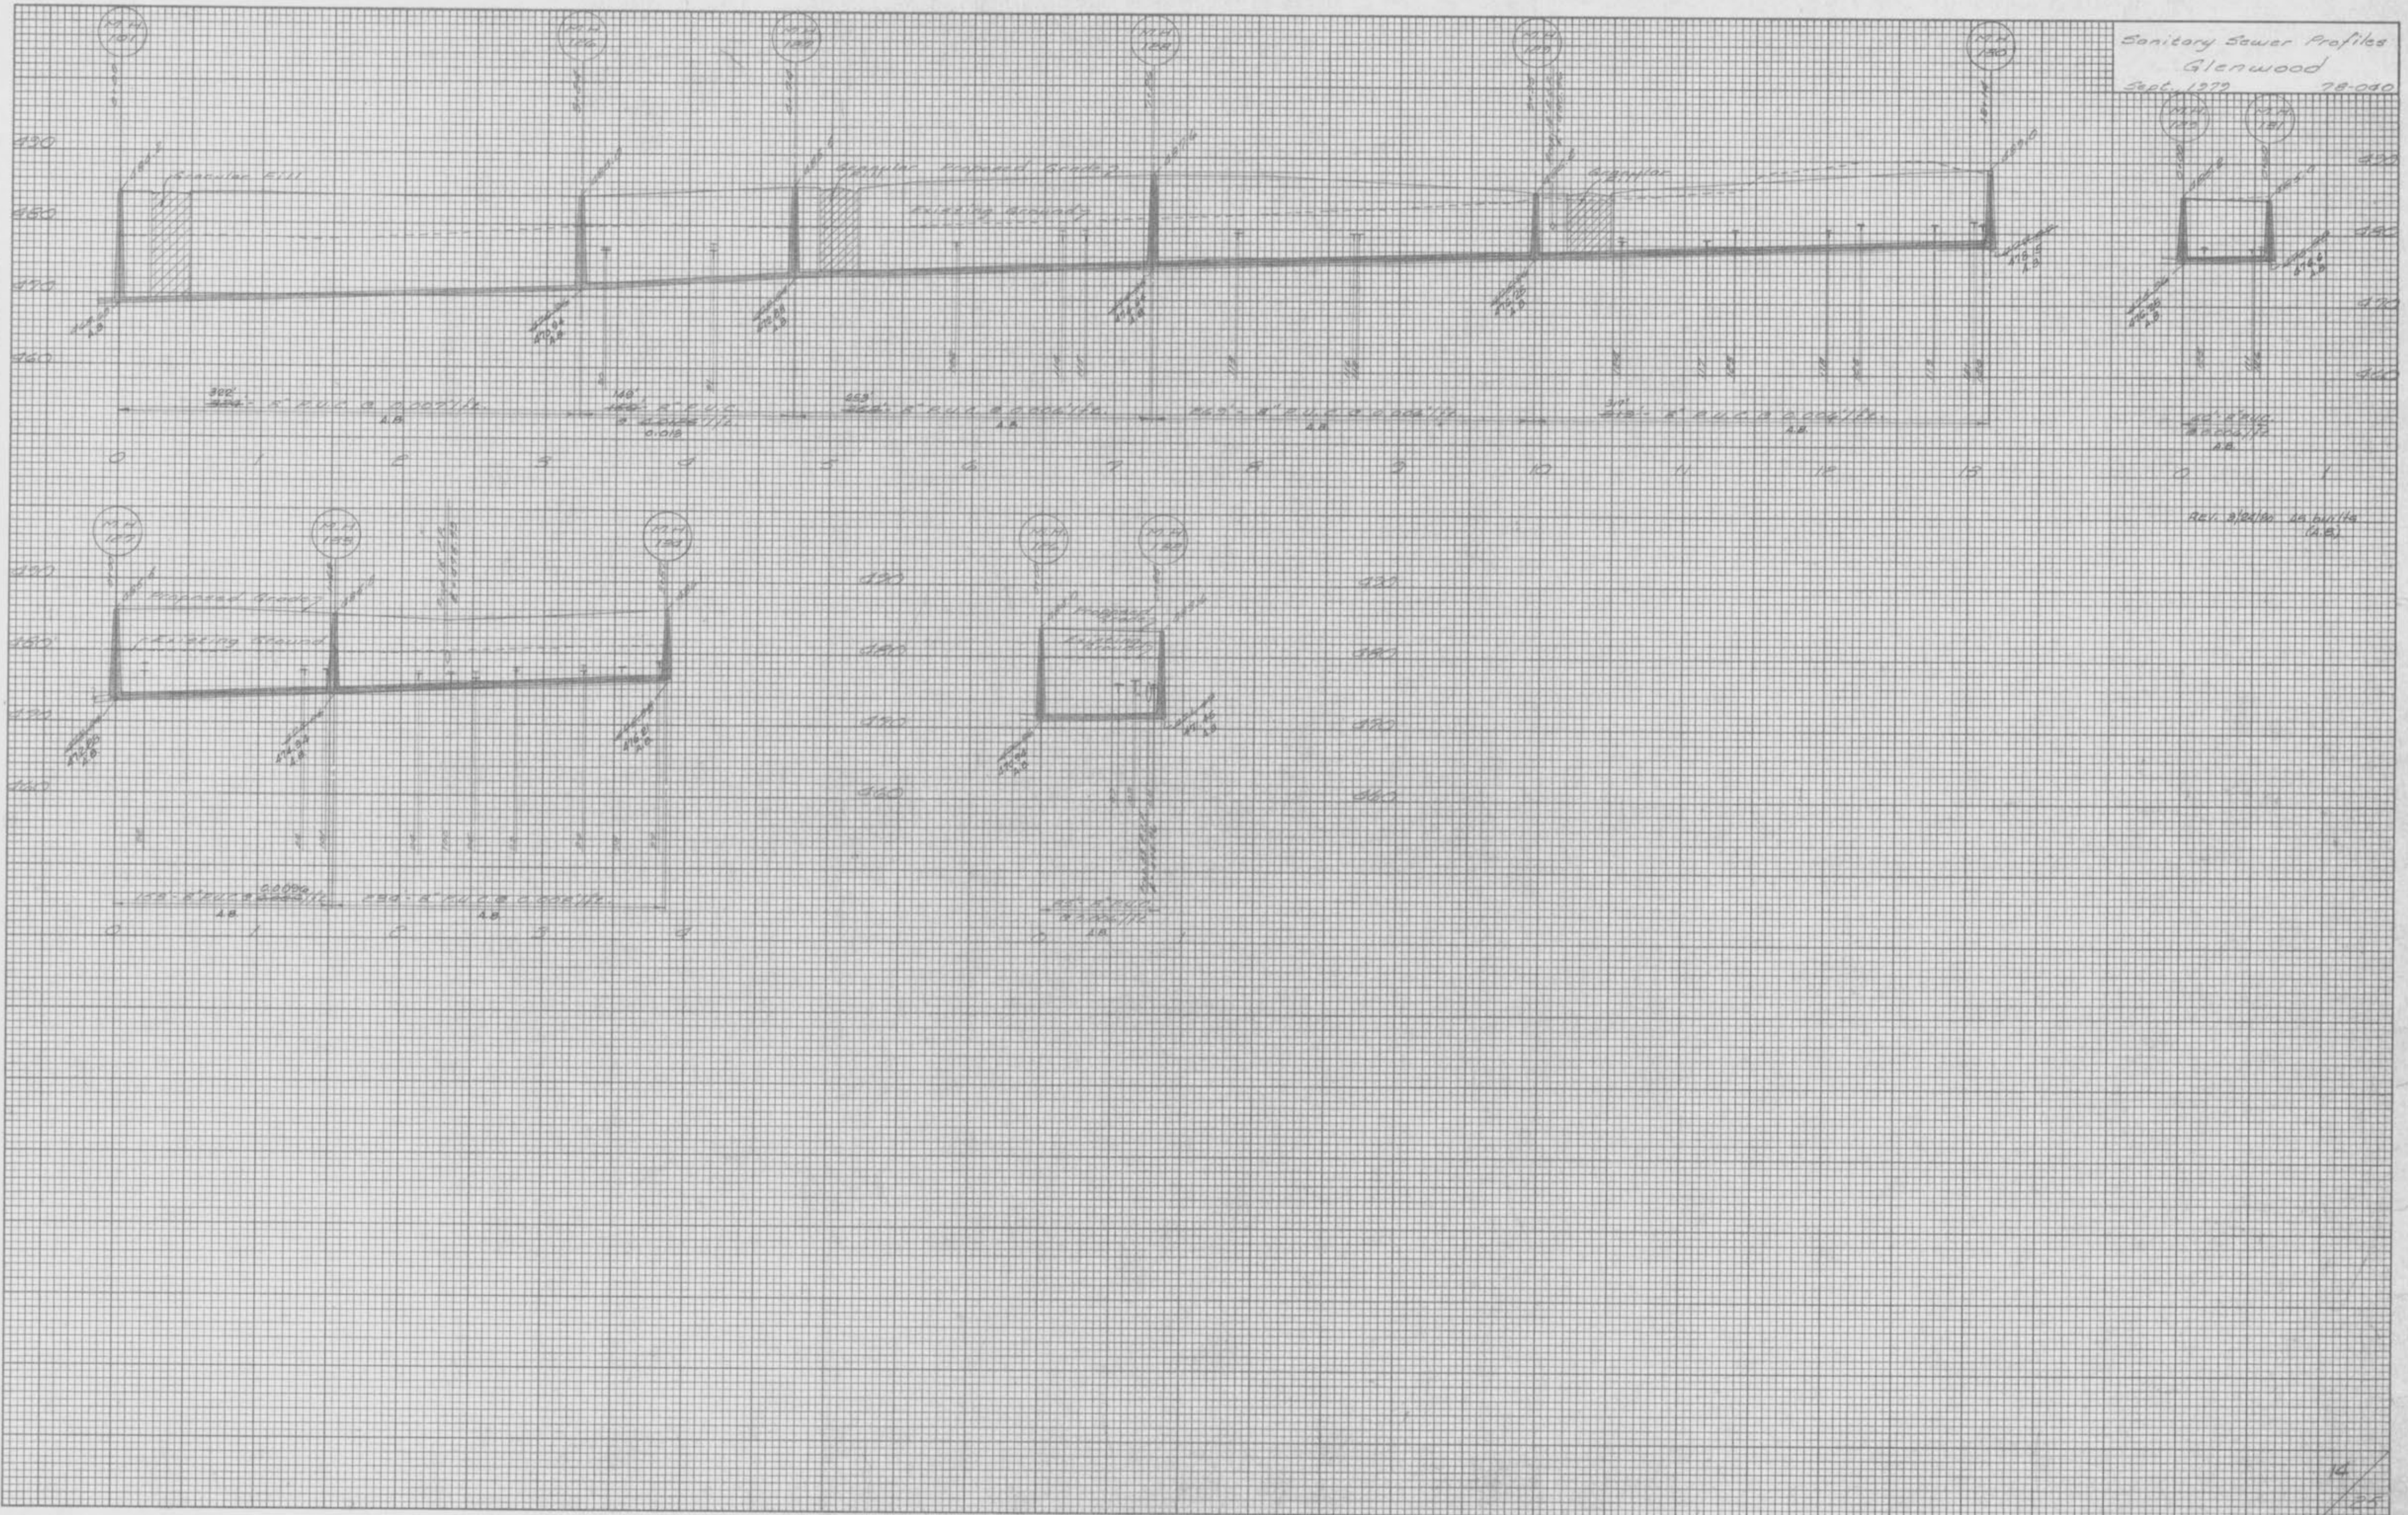


DATE
 BY
 SURVEYED
 PLOTTED
 TEMPLATE
 NOTE BOOK
 AREA CHECKED
 NO.

DATE
 BY
 SURVEYED
 PLOTTED
 TEMPLATE
 NOTE BOOK
 AREA CHECKED
 NO.

Rev. 9/20/39 as built (A.B.)

DATE
BY
SURVEYED
CHECKED
TEMPLATE
AREAS
FINAL SURVEY
NOTE BOOK
AREAS CHECKED


DATE
BY
SURVEYED
CHECKED
TEMPLATE
AREAS
ORIGINAL SURVEY
NOTE BOOK
AREAS CHECKED

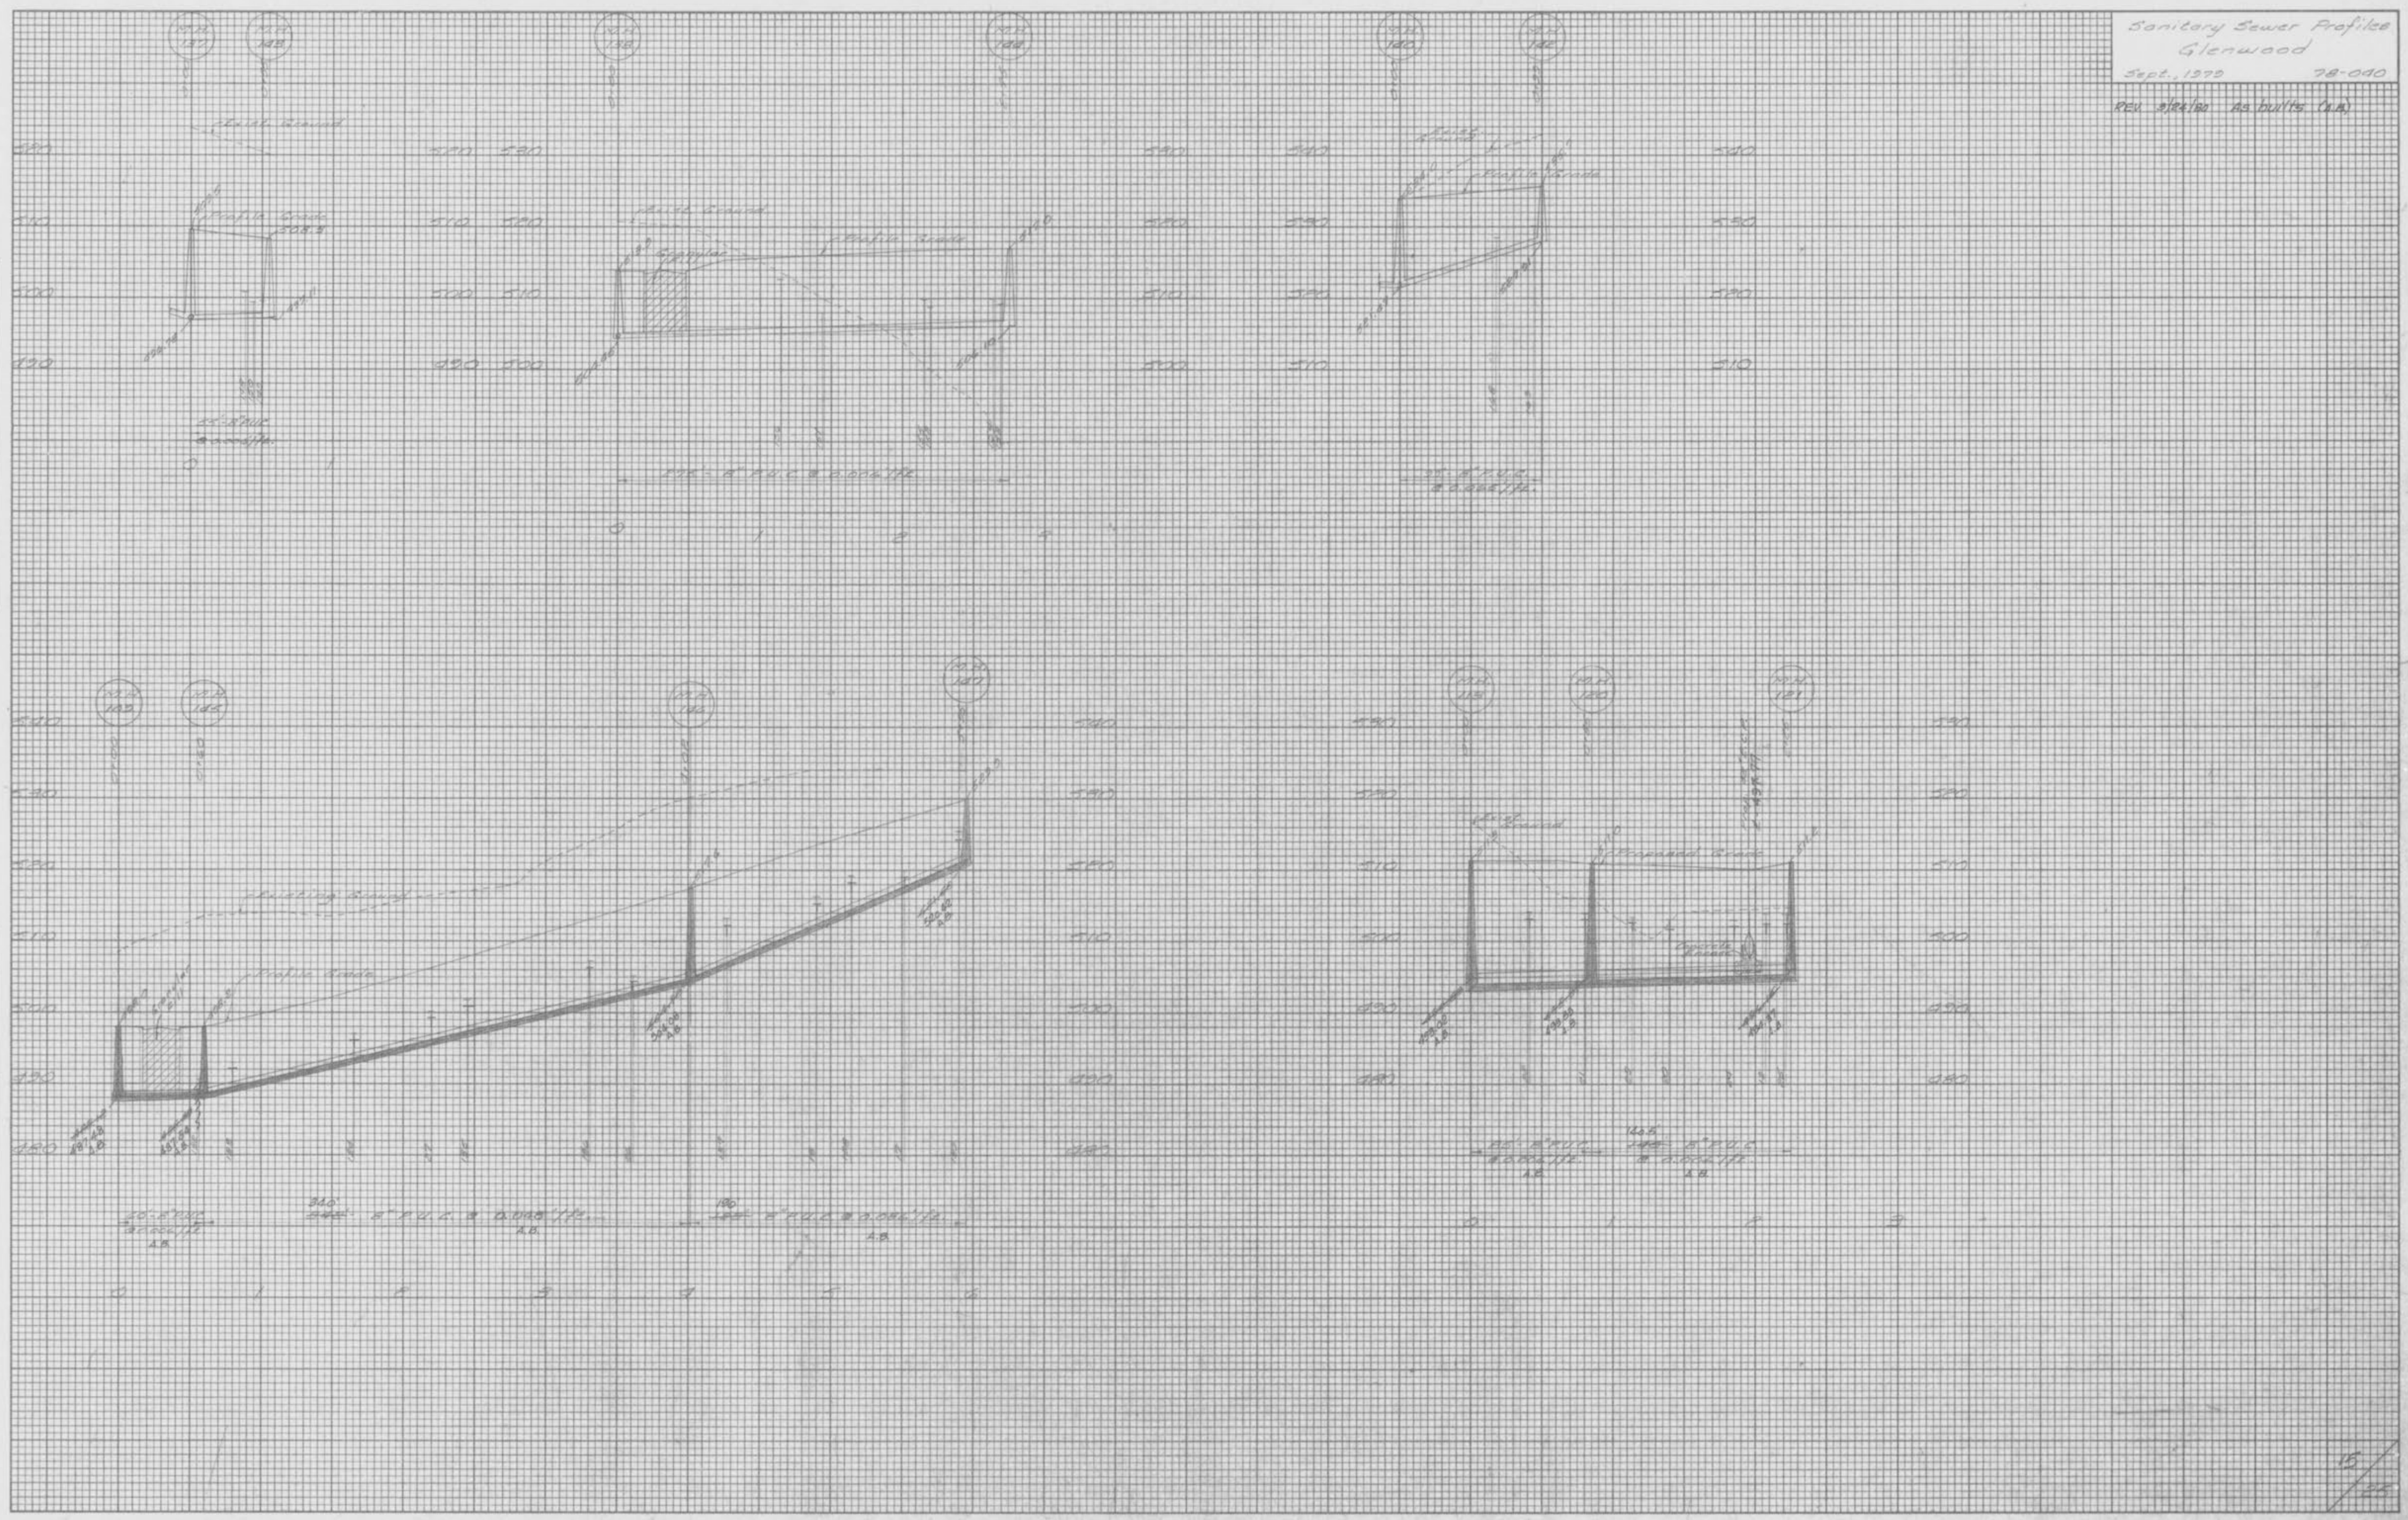

STORM SEWER PROFILES
 GLENWOOD
 Sept., 1972 78-040
 REV. 9/25/80 As built (A.B.)

DATE
 BY
 CHECKED
 PLANNED
 PLOTTED
 TEMPLATE
 AREAS
 AREAS CHECKED

DATE
 BY
 CHECKED
 PLANNED
 PLOTTED
 TEMPLATE
 AREAS
 AREAS CHECKED

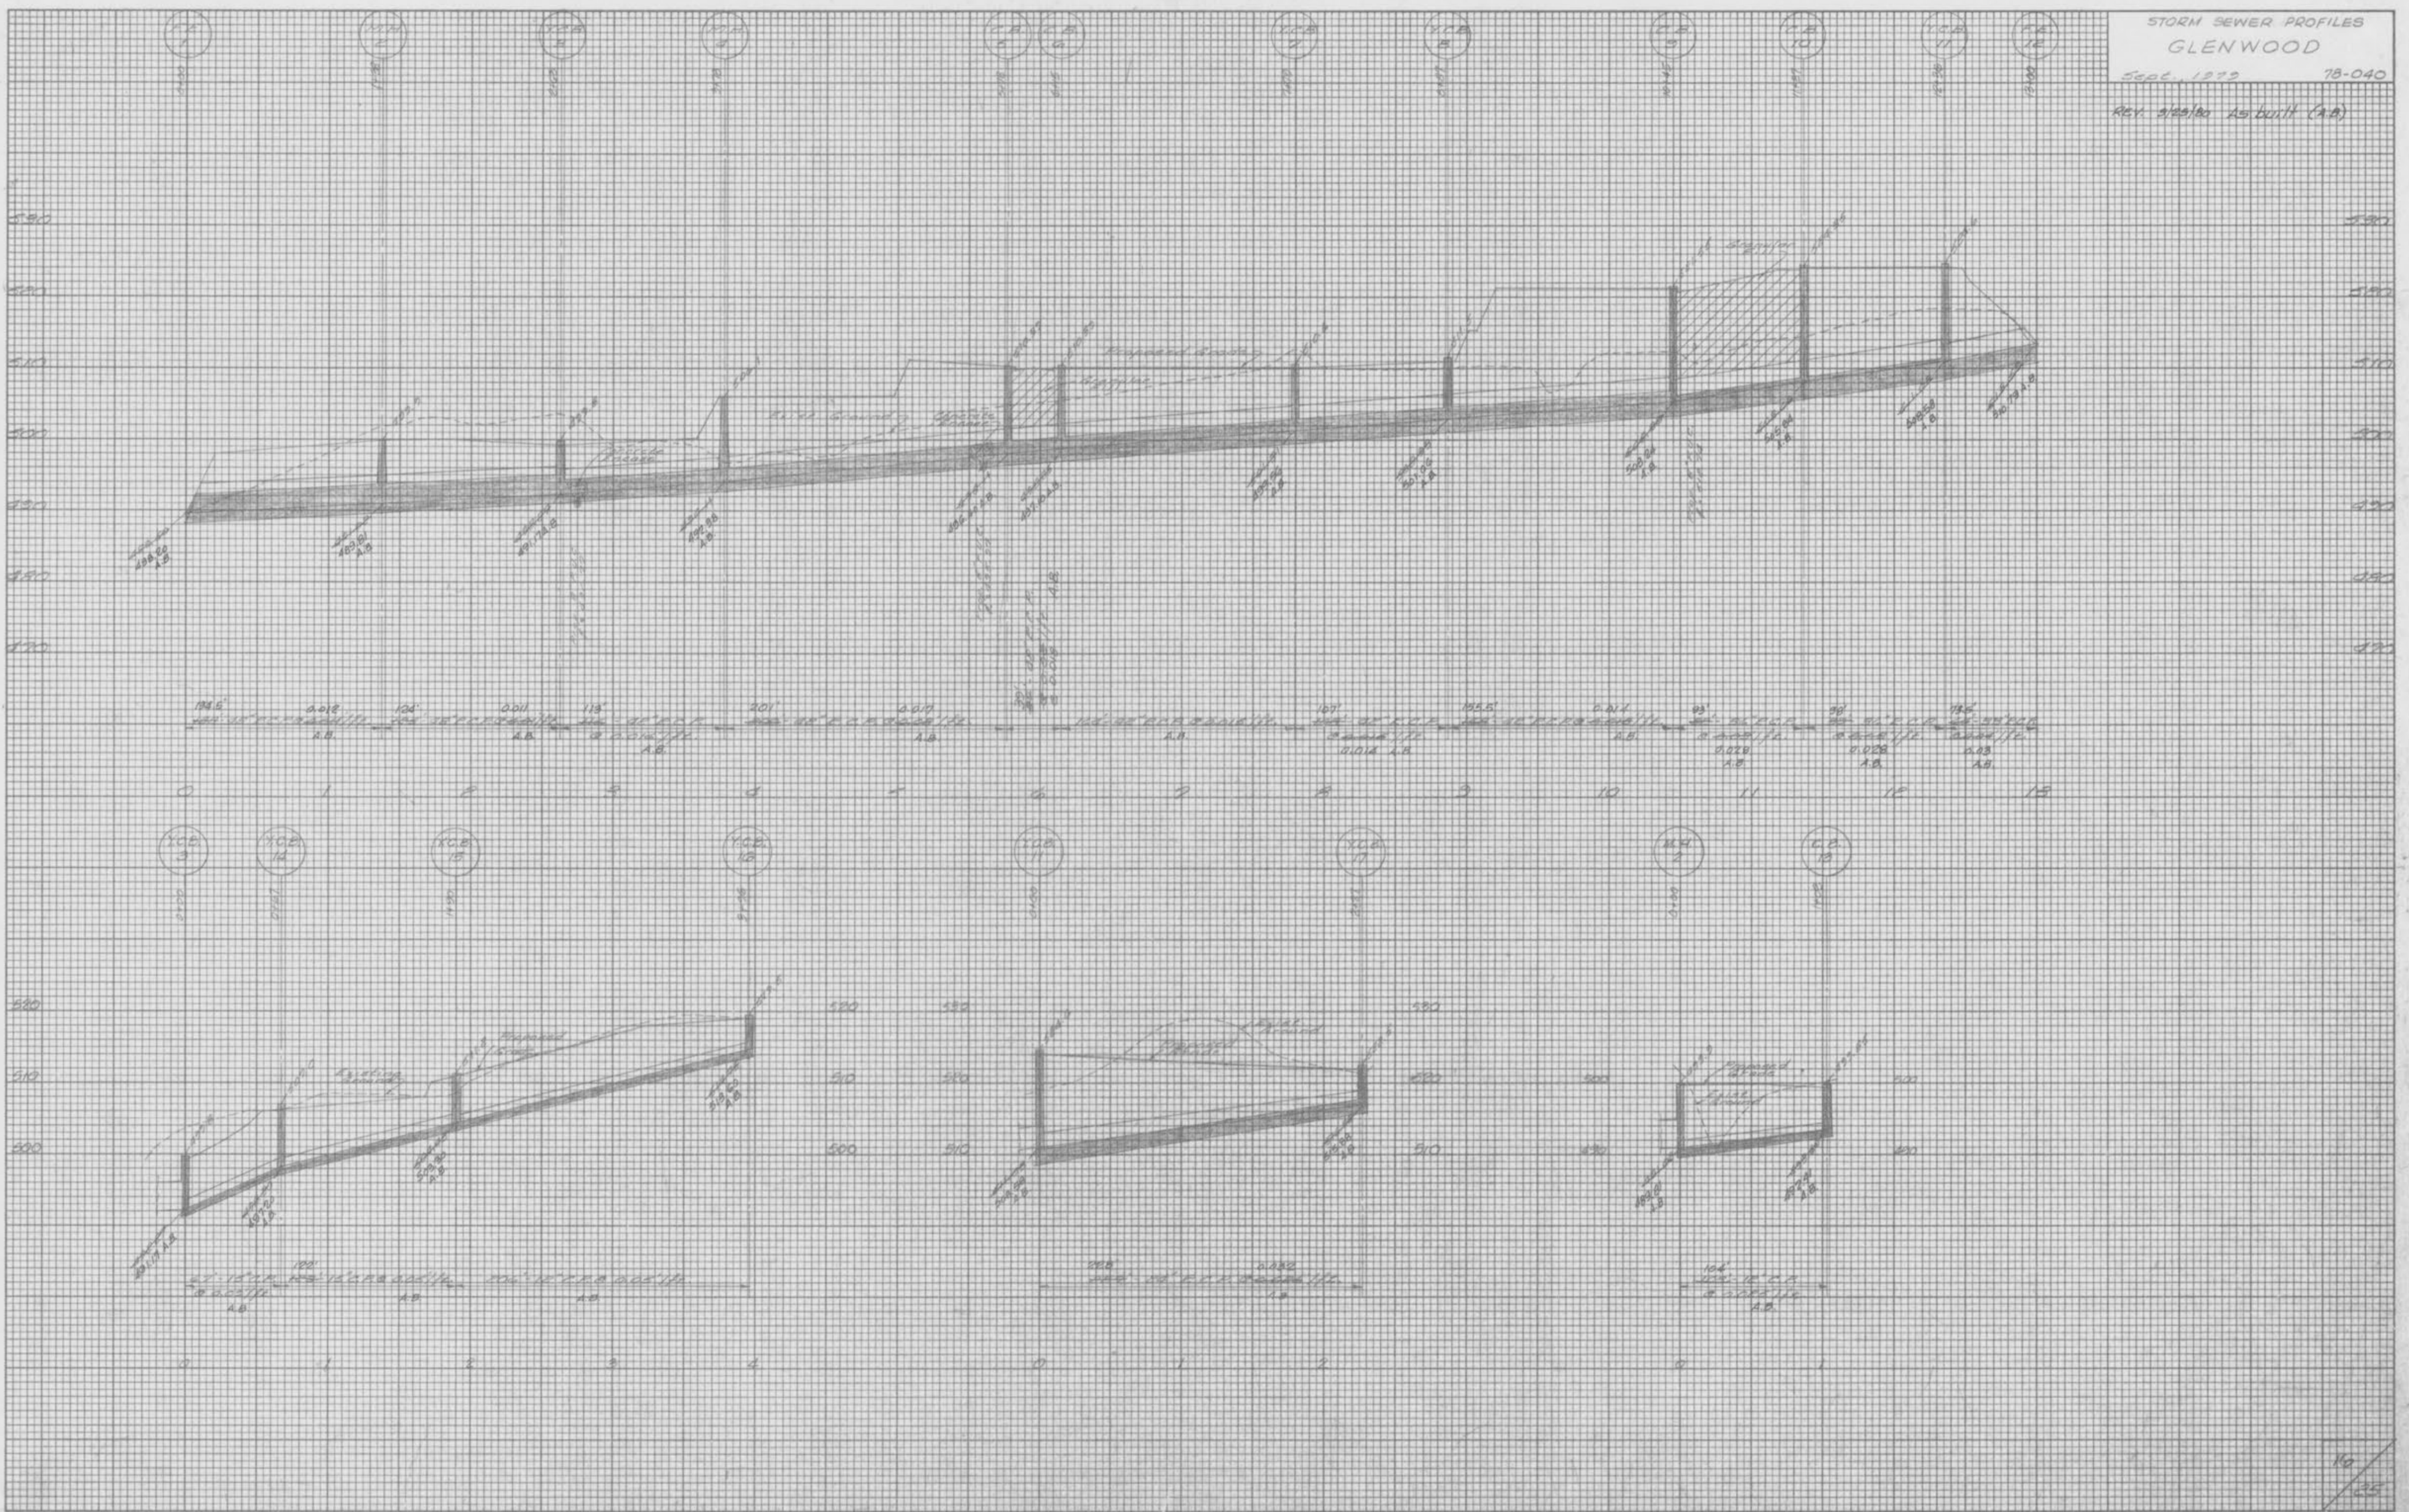

K&E PLATE 3, CROSS SECTION
 48 7055 MADE IN U.S.A.

PROPERTY OF
 BUILDING DEPARTMENT
 10/25


STORM SEWER PROFILES
GLENWOOD

Sept. 1978 78-040

REV 3/28/80
As built (A.B.)

DATE	
BY	
DESIGNED	
PLOTTED	
TEMPLATE	
WRITE BOOK	
AREAS CHECKED	

DATE	
BY	
DESIGNED	
PLOTTED	
TEMPLATE	
WRITE BOOK	
AREAS CHECKED	

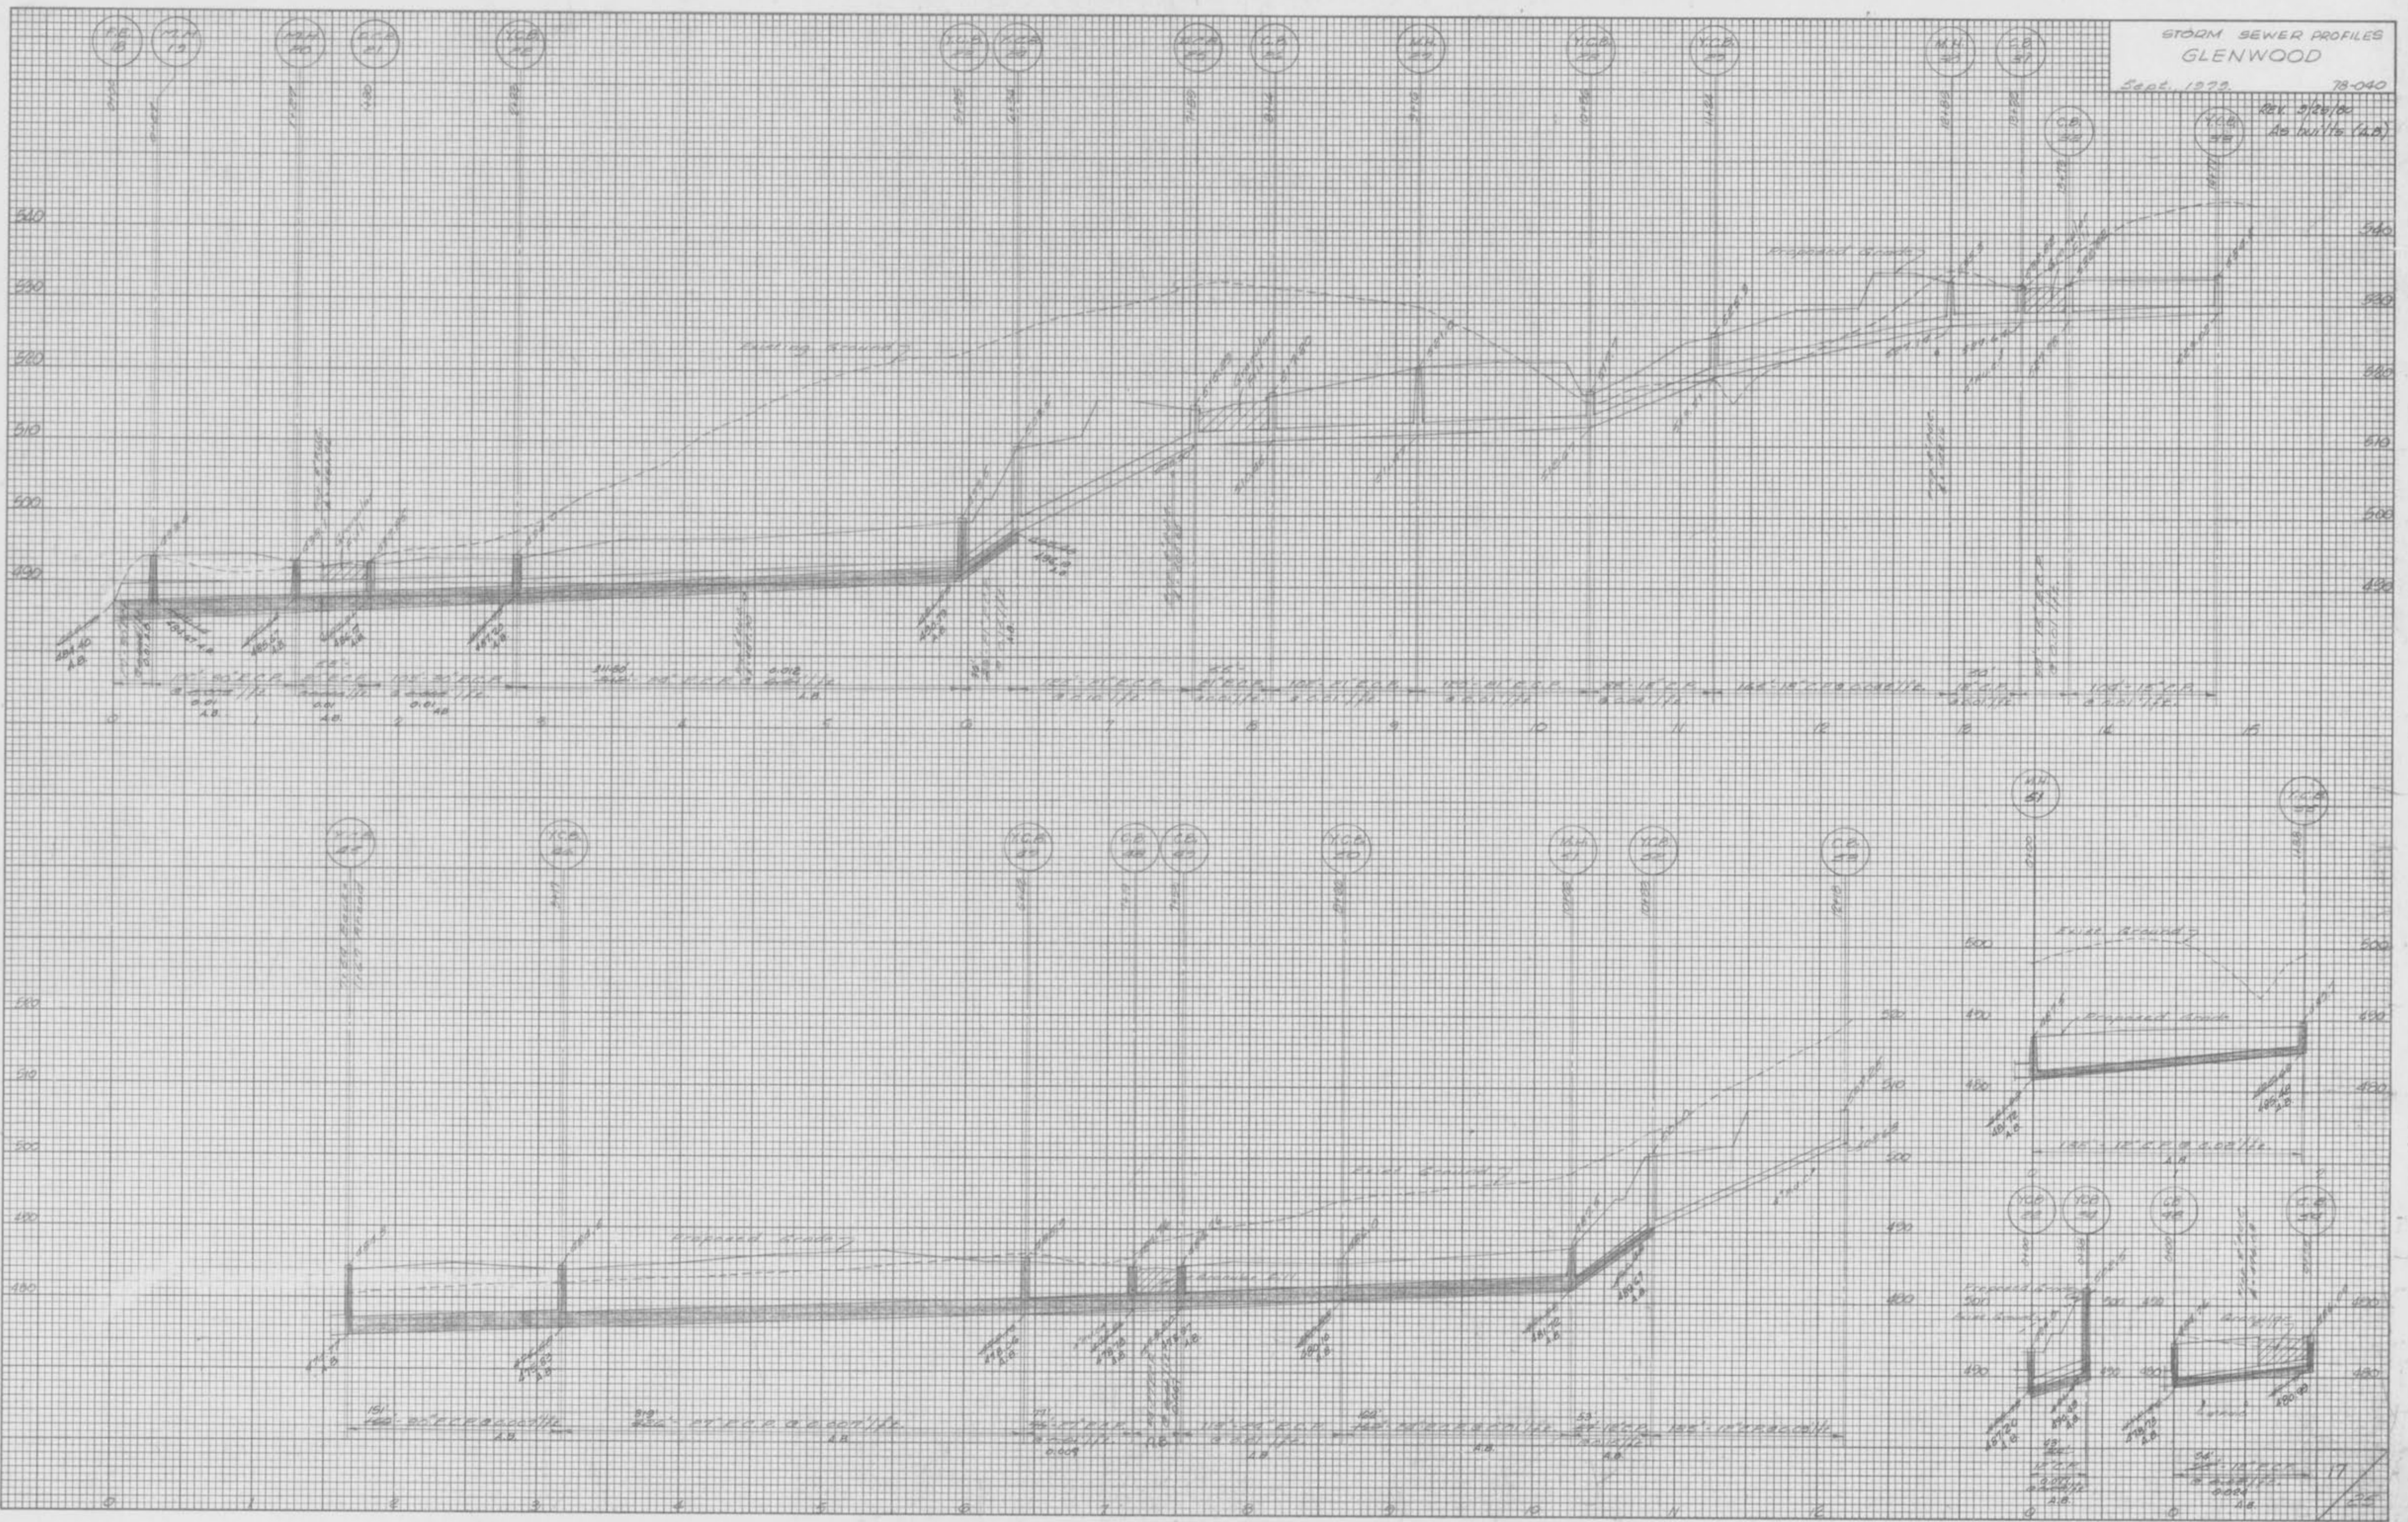

K-E PLATE 3, CROSS SECTION
KENTON & SONS CO.
48 7056 MADE IN U.S.A.

PROPERTY OF
CITY OF O'FALLON
ENGINEERING DEPARTMENT

GLENWOOD
STORM SEWER PROFILE
AS BUILT


STORM SEWER PROFILES
 GLENWOOD
 Sept. 1928 78-040
 Rev. drawn in 1928 (S.A.)

DATE
 BY
 SURVEYED
 DRAWN
 TEMPLATE
 AREAS
 CHECKED

FINAL
 SURVEY
 NOTE BOOK
 NO.

DATE
 BY
 SURVEYED
 DRAWN
 TEMPLATE
 AREAS
 CHECKED

ORIGINAL
 SURVEY
 NOTE BOOK
 NO.

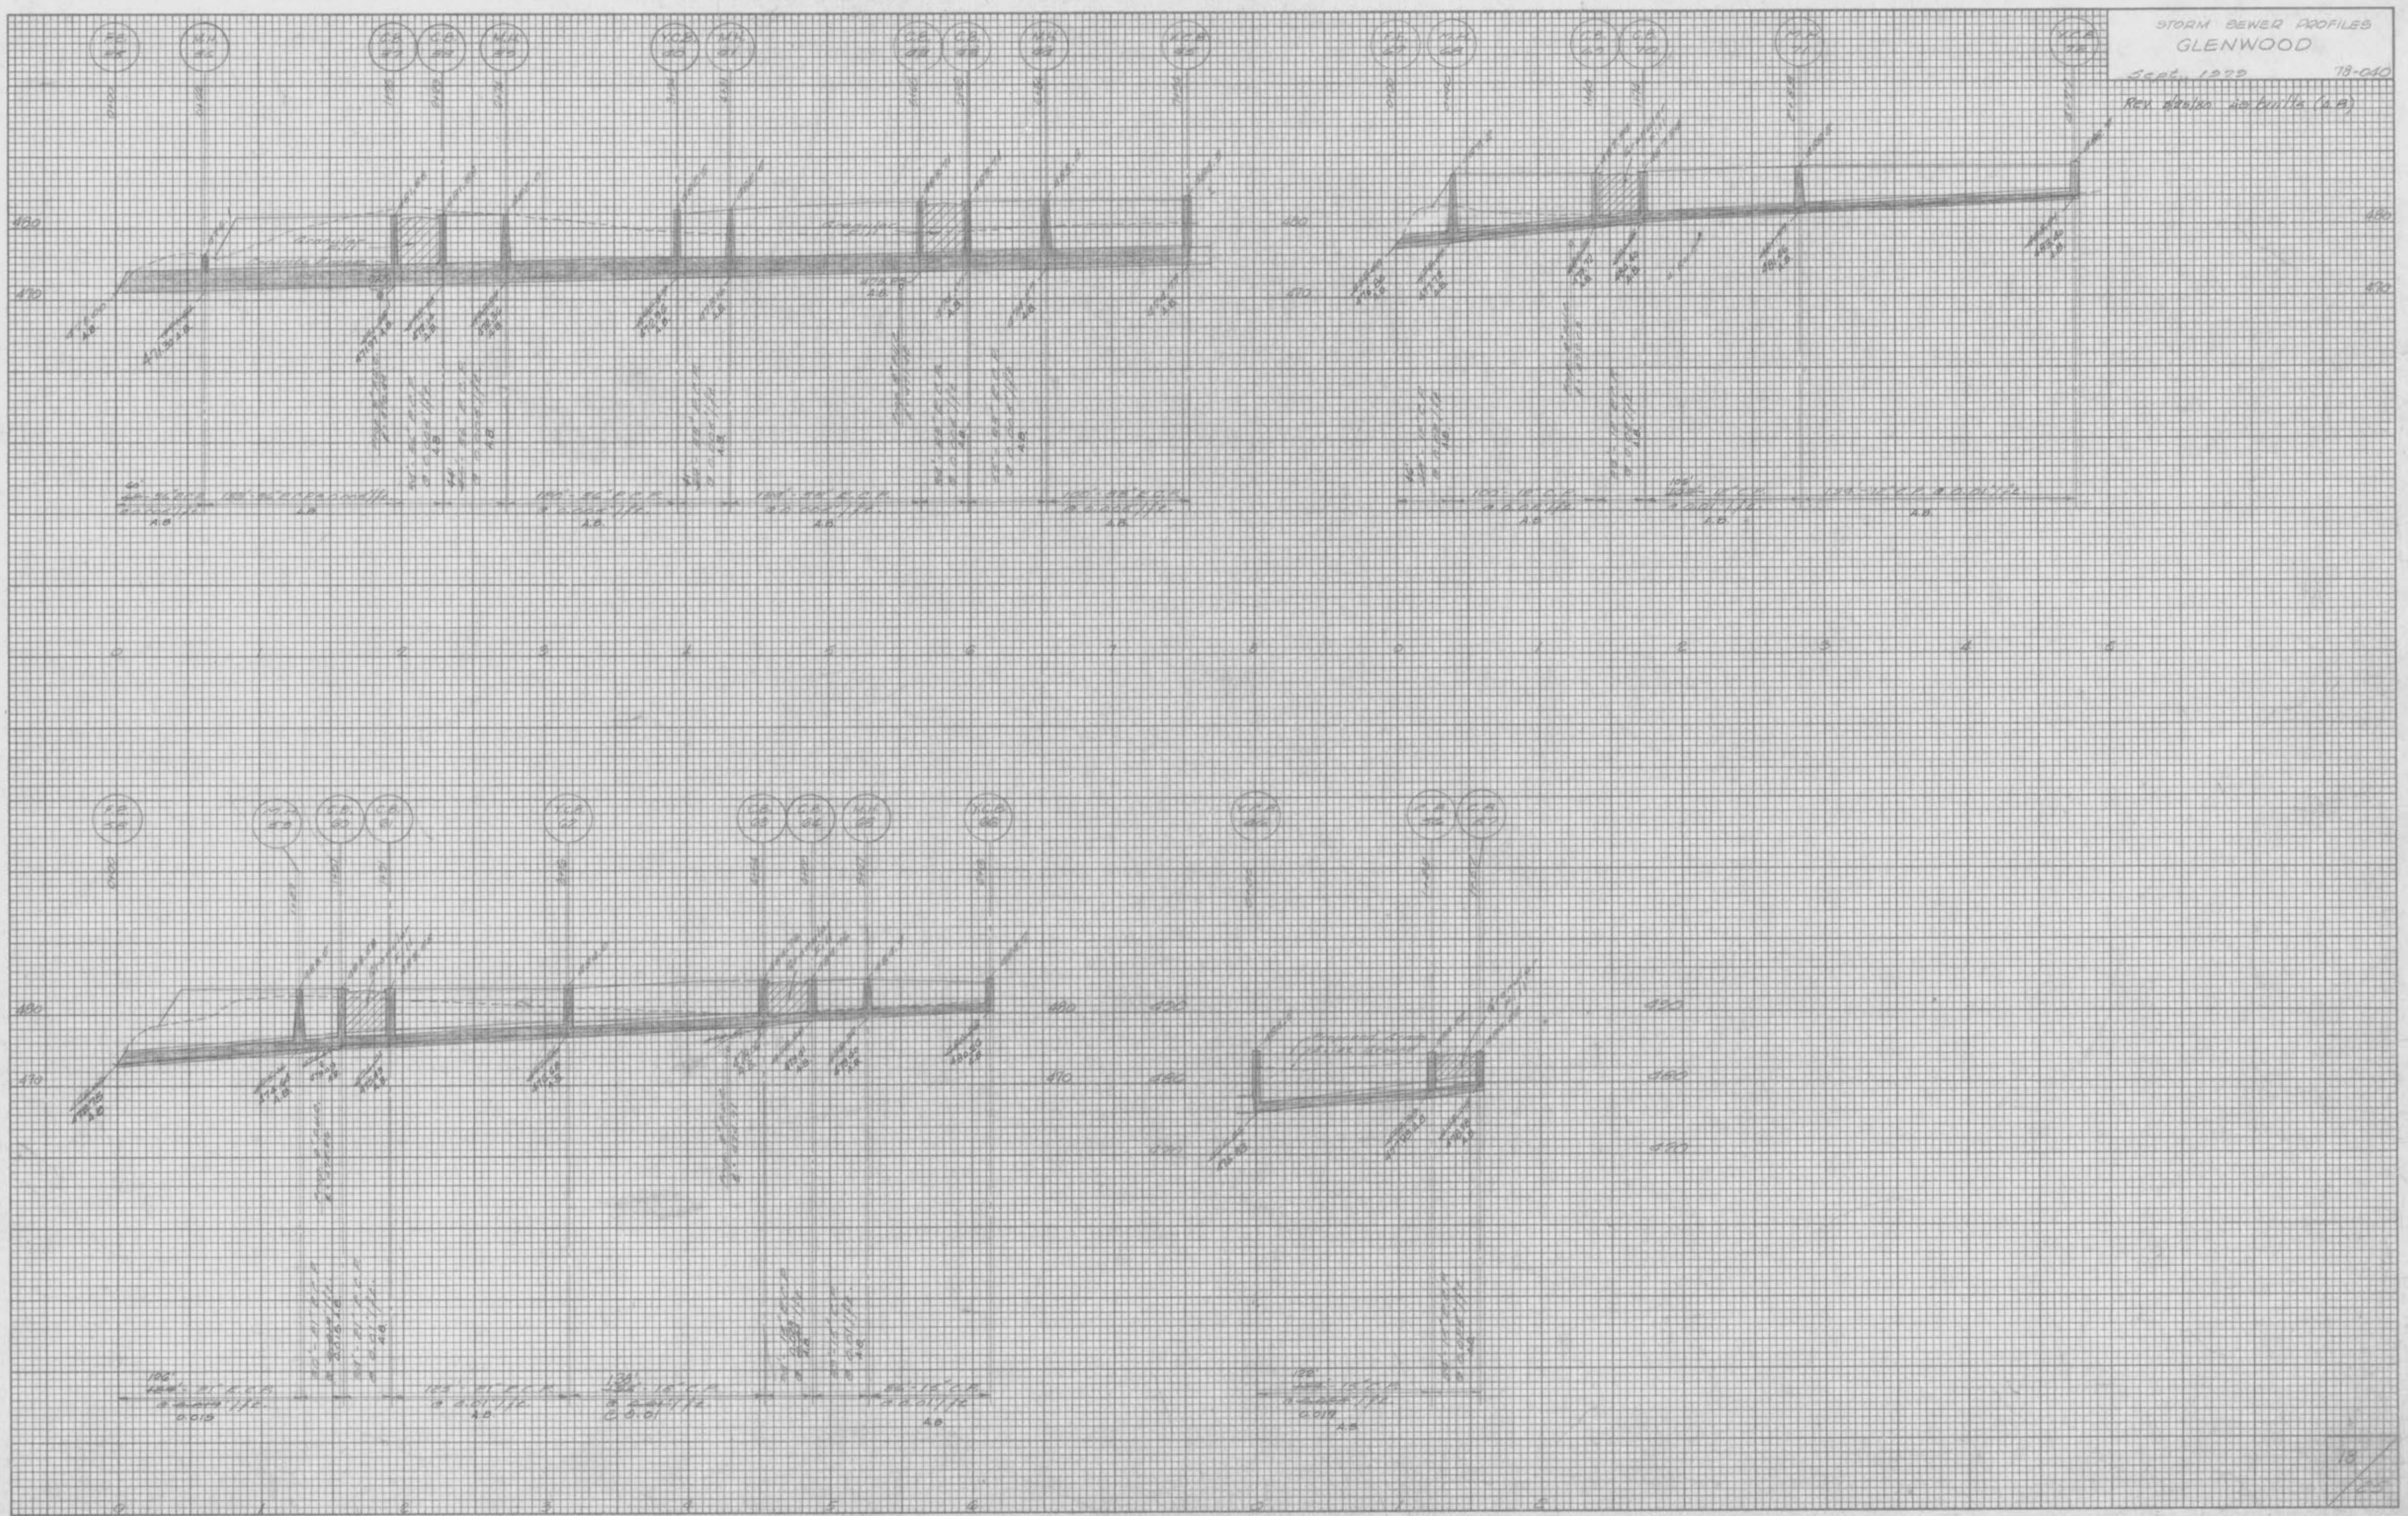

K&E PLATE 3, CROSS SECTION
 SHEETS & CO. INC.
 48 7050 MADE IN U.S.A.

PROPERTY OF
 CITY OF FALLON
 BUILDING DEPARTMENT

GLENWOOD
 STORM SEWER PROFILES
 AS SHOWN