

GENERAL NOTES

- Underground utilities have been plotted from available information and therefore their locations shall be considered approximate only. The verification of the location of all underground utilities, either shown or not shown on these plans, shall be the responsibility of the contractor, and shall be located prior to any grading and/or construction of improvements.
- Erosion control shall not be limited to what is shown on the plans. The contractor shall take whatever means necessary to prevent siltation from entering adjacent roadways, properties, and ditches. Such control might include channeling runoff into sediment basins, channeling runoff into areas where an extra row of straw bales are used. A silt fence might be considered, if necessary.
- No area shall be cleared without permission of the developer.
- Owner/Developer assumes full responsibility as to the performance of the grading operation and assurance that all properties and County and State roads will be adequately protected.
- Soil preparation and re-vegetation shall be performed according to Appendix A of the Model Sediment and Erosion Control Regulations for Urban Development.
- Where natural vegetation is removed during grading, vegetation shall be re-established in such a density as to prevent erosion. Permanent type grasses shall be established as soon as possible or during the next seeding period after grading has been completed. Refer to Appendix A of St. Charles Soil and Water Conservation District - Model Sediment and Erosion Control Regulations.
- Site preparation includes the clearance of all stumps, trees, bushes, shrubs, and weeds; the grubbing and removal of roots and other surface obstructions from the site; and the demolition and removal of any man-made structures. The unsuitable material shall be properly disposed of off-site. Topsoil and grass in the fill areas shall be thoroughly disc'd prior to the placement of any fill. The Soils Engineer shall approve the discing operation.
- Compaction equipment shall consist of tamping rollers, pneumatic-tired rollers, vibratory rollers or high speed impact type drum rollers acceptable to the Soils Engineer. The rollers shall be designed so as to avoid the creation of a layered fill without proper blending of successive fill layers.
- The Soils Engineer shall observe and test the placement of the fill to verify that specifications are met. A series of fill density tests will be determined on each lift of fill. Interim reports showing fill quality will be made to the Owner at regular intervals. Developer must supply City Construction inspectors with soils report prior to or during site soil testing.
- The Soils Engineer shall notify the Contractor of rejection of a lift of fill or portion thereof. The Contractor shall rework the rejected portion of fill and obtain notification from the Soils Engineer of its acceptance prior to the placement of additional fill.
- All areas to receive fill shall be scarified to a depth of not less than 6 inches and then compacted to at least 85 percent of the maximum density as determined by the Modified AASHTO T-1800 Compaction Test (ASTM-D1557). Natural slopes steeper than 1 vertical to 5 horizontal to receive fill shall have horizontal benches cut into the slopes before the placement of any fill. The width and height to be determined by the Soils Engineer. The fill shall be loosely placed in horizontal layers not exceeding 8 inches in thickness and compacted in accordance with the specifications given below. The Soils Engineer shall be responsible for determining the acceptability of soils placed. Any unacceptable soils placed shall be removed at the Contractor's expense.
- The sequence of operation in the fill areas will be; fill, compact, verify acceptable soil density, and repetition of the sequence. The acceptable moisture contents during the filling operation are those at which satisfactory dry densities can be obtained. The acceptable moisture contents during the filling operation in the remaining areas are from 2% to 8% above the optimum moisture content.
- The surface of the fill shall be finished so that it will not impound water. If at the end of a days work it would appear that there may be rain prior to the next working day, the surface shall be finished smooth. If the surface has been finished smooth for any reason, it shall be scarified before proceeding with the placement of succeeding lifts. Fill shall not be placed on frozen ground, nor shall filling operations continue when the temperature is such as to permit the layer under placement to freeze.
- All cut and fill slopes should be a maximum of 33% slope (3:1) after grading.
- All fill placed under proposed storm and sanitary sewer, proposed roads, and/or paved areas shall be compacted to 90% of maximum density as determined by the Modified AASHTO T-180 Compaction Test or 95% of maximum density as determined by the Standard Proctor Test AASHTO T-99. All fill placed in proposed roads shall be compacted from the bottom of the fill up. All tests shall be verified by a soils engineer concurrent with grading and backfilling operations. Ensure the moisture content of the soil in fill areas is to correspond to the compactive effort as defined by the Standard or Modified Proctor Test. Optimum moisture content shall be determined using the same test that was used for compaction. Soil compaction curves shall be submitted to the City of O'Fallon prior to the placement of fill. Proof rolling may be required to verify soil stability at the discretion to the City of O'Fallon.
- All paving to be in accordance with the St. Charles County Standards and specifications except as modified by the City of O'Fallon ordinances.
- Soft soil in the bottom and banks of any existing or former pond site should be removed, spread out and sufficiently dry sufficiently to be used as fill. None of this material should be placed in proposed right-of-way locations or on storm sewer locations.
- Temporary siltation control measures (structural) shall be maintained until vegetative cover is established at a sufficient density to provide erosion control on the site.
- If straw bales or silt fences are destroyed by heavy rains, vandalism, etc., they are to be replaced immediately by contractor.
- When grading operations are completed or suspended for more than thirty (30) days, permanent grass must be established at sufficient density to provide erosion control on the site. Between permanent grass seeding periods, temporary cover shall be provided according to the Designated Official's recommendation. Refer to Appendix A of St. Charles Soil and Water Conservation District - Model Sediment and Erosion Control Regulations. All finished grades (areas not to be disturbed by improvement) in excess of 20% slopes (5:1) shall be mulched and tacked at the rate of 1 pounds per 1000 square feet when seeded.
- All existing trash and debris on-site must be removed and disposed of off-site.
- Debris and foundation material from any existing on-site building or structure which is scheduled to be razed for this development must be disposed of off-site.
- The total yardage of this project is based on a 15% ± shrinkage factor.
- The shrinkage factor is subject to change, due to soil conditions (types and moisture content), weather conditions, and the percentage of compaction actually achieved at the time of the year grading is performed. As a result, adjustments in final grade may be required. If adjustments need to be made, the contractor shall contact St. Charles Engineering and Surveying prior to completion of the grading.
- Earth quantities were obtained from aerial grid mapping with contours at two foot intervals, with a tolerance of plus or minus one foot or one-half (2) contour intervals.
- The vertical grading tolerance shall be plus or minus 0.2 feet for all rough grading.
- The Contractor shall prevent all storm/surface water, mud or construction debris from entering the existing sanitary sewer system.
- The most stringent of the above requirements shall apply.
- Water for wash-off pad will be brought onto site by truck until such time that water can be provided through existing water lines.
- Coordination between the on-site grading of this project with any grading being done on the O'Fallon Road Improvement Project is required.
- Each fire hydrant shall be provided with a control valve in the hydrant connection such that the hydrant can be removed from service without shutting off water supply to other fire hydrants.

O'Fallon File
Number 1002.02

NOTE: 48 HOUR NOTICE REQUIRED ON ALL INSPECTIONS

AS-BUILT PLANS
HIDDEN CREEK
PHASE 2
A TRACT OF LAND BEING ALL
OF LOT 10 OF HOWELL'S PRAIRIE TRACT
U.S. SURVEY 1669
ST. CHARLES COUNTY, MISSOURI



SUBDIVISION NOTES:

AREA OF PHASE 2 - 43.51 ACRES
PHASE TWO EXTENDS NORTH OF PHASE ONE

NUMBER OF LOTS 73
FRONT YARD SETBACK 25'
SIDE YARD SETBACK 6'
REAR YARD SETBACK 25'

Drive way locations shall not interfere with the sidewalk handicap ramps.

City approval of the construction Site plans does not mean that single family dwelling units can be constructed on the lots without meeting the building setbacks as required by the Zoning Code.

All street signs and traffic signals shall be colored black in accordance with the approved MoDOT specifications.

All sign posts and backs and bracket arms shall be painted black using Carboline Rustbond Penetrating Sailer 5G and Carboline 133 HB paint (or equivalent as approved by the City and/or MoDOT)

The Contractor shall assume complete responsibility for controlling all siltation and erosion of the project area. The Contractor shall use whatever means necessary to control erosion and siltation including, but not limited to, stacked straw bales and/or siltation control fences (possible methods of control are detailed on the interim grading plan). Control shall commence with grading and be maintained throughout the project until acceptance of the work by the Owner and/or City of O'Fallon and/or St. Charles County. The Contractor's responsibilities include all design and implementation as required to prevent erosion and depositing of silt. The Owner and/or the City of O'Fallon and/or St. Charles County may at their option direct the Contractor in his methods as deemed fit to protect property and improvements. Any depositing of silts or mud on new or existing pavement or in new or existing storm sewers or swales shall be removed after each rain and affected areas cleaned to the satisfaction of the Owner and/or the City of O'Fallon and/or St. Charles County.

All paved surfaces will be kept free of dirt, mud, rocks, and other debris.

FLOOD PLAIN: ACCORDING TO FLOOD INSURANCE RATE MAP (FIRM) PANEL NUMBER 29183C435 E, DATED AUGUST 2, 1996, THIS PLAT IS IN ZONE AE FLOODPLAIN. THE LIMITS OF THE FLOODWAY, EXISTING FLOODPLAIN, AND PROPOSED FLOODPLAIN ARE PLOTTED ON THIS PLAN SET.

NOTE: ALL LOTS SHALL BE GRADED TO AN ELEVATION ABOVE THE 100-YEAR FLOODPLAIN. LOW SILL ELEVATIONS SHALL BE A MINIMUM OF ONE (1) FOOT ABOVE THE BFE.

Site Benchmark (On USGS Datum)- Elevation 485.66 - Iron Rod with Aluminum Disk on the North Side of existing O'Fallon Road being 59'+ or - East of the Most Northern Corner of Property.

Site is served by:

Water Missouri American Water 314-991-3404
Sewer Duckett Creek Sewer District 636-441-1244
Telephone Southwestern Bell Telephone 636-949-1320
Electric Ameren UE 636-925-3216
Gas St. Charles Gas Company 636-978-2663
Cottleville Fire Protection District
Francis Howell School District
Pipeline Explorer Pipeline

DEVELOPER

VANTAGE HOMES, INC.
P.O. BOX 1270
ST. PETERS, MO 63376
Rob Tiemann
(636) 240-7662

LEGEND

	SANITARY STRUCTURE	C.O.	CLEAN OUT
	STORM STRUCTURE	T.B.R.	TO BE REMOVED
	TEST HOLE	T.B.R.&R.	TO BE REMOVED & RELOCATED
	POWER POLE	T.B.P.	TO BE PROTECTED
	LIGHT STANDARD	T.B.A.	TO BE ABANDONED
	CURB INLET	B.C.	BASE OF CURB
	DOUBLE CURB INLET	T.C.	TOP OF CURB
	GRATE INLET (EXISTING)	T.W.	TOP OF WALL
	AREA INLET (EXISTING)	TYP.	TYPICAL
	DOUBLE AREA INLET	U.N.O.	UNLESS NOTED OTHERWISE
	FLARED END SECTION	U.I.P.	USE IN PLACE
	END PIPE		EXISTING CONTOUR
	ENERGY DISSIPATOR		PROPOSED CONTOUR
	MANHOLE		TREE LINE
	REINFORCED CONCRETE PIPE		SAN. SEWER (EXISTING)
	CORRUGATED METAL PIPE		SAN. SEWER (PROPOSED)
	CAST IRON PIPE		STORM DRAIN (EXISTING)
	POLYVINYL CHLORIDE		STORM DRAIN (PROPOSED)
	VITRIFIED CLAY PIPE		PHONE BOX
	GUY WIRE		IRON PIPE
	SIGN		WATER LINE, 3/2
	POST		HYDRANT
	WATER METER		CONCRETE PAVEMENT
	APPROX. DIRECTION OF WATER FLOW		PLACED RIP-RAP W/UNDERLAIN FABRIC
			STREET SIGN
			STOP SIGN

INDEX

1	COVER SHEET
2-3	FLAT PLAN
4-5	GRADING PLAN
6-7	STREET PROFILES
8	CUL-DE-SAC WARPINGS
9-10	SANITARY PROFILES
11-12	STORM PROFILES
13-14	WATER LINE PLANS
15-16	DRAINAGE AREA MAP
17	LANDSCAPING PLAN
D-1	PAVEMENT DETAILS
D-2	SIDEWALK DETAILS
D-3-D-5	STORM DETAILS
D-6-D-7	SANITARY DETAILS
D-8-D-9	WATER DETAILS

ENGINEERS AUTHENTICATION

The responsibility for the professional engineering liability on this project is hereby limited to the set of plans authenticated by the seal, signature and date hereunder attached. Responsibility is disclaimed for all other engineering plans involved in the project and specifically excludes revisions after this date unless reauthenticated.




ORDER NO.
02-0162
DATE
05/03/05
AB2-1

SDS-000002-05-BA-1104



HIDDEN CREEK
AS-BUILTS
PHASE 2
VANTAGE HOMES, INC.

ST. CHARLES ENGINEERING & SURVEYING, INC.
801 S. FIFTH STREET, SUITE 202
ST. CHARLES, MO 63301
TEL: (636) 947-0607 FAX: (636) 947-2448

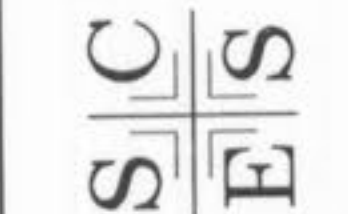

MONTICELLO VILLAGE "D"
P.B. 30 PGS. 337-339


MONTICELLO ESTATES PLAT 1
P.B. 31 PG. 121

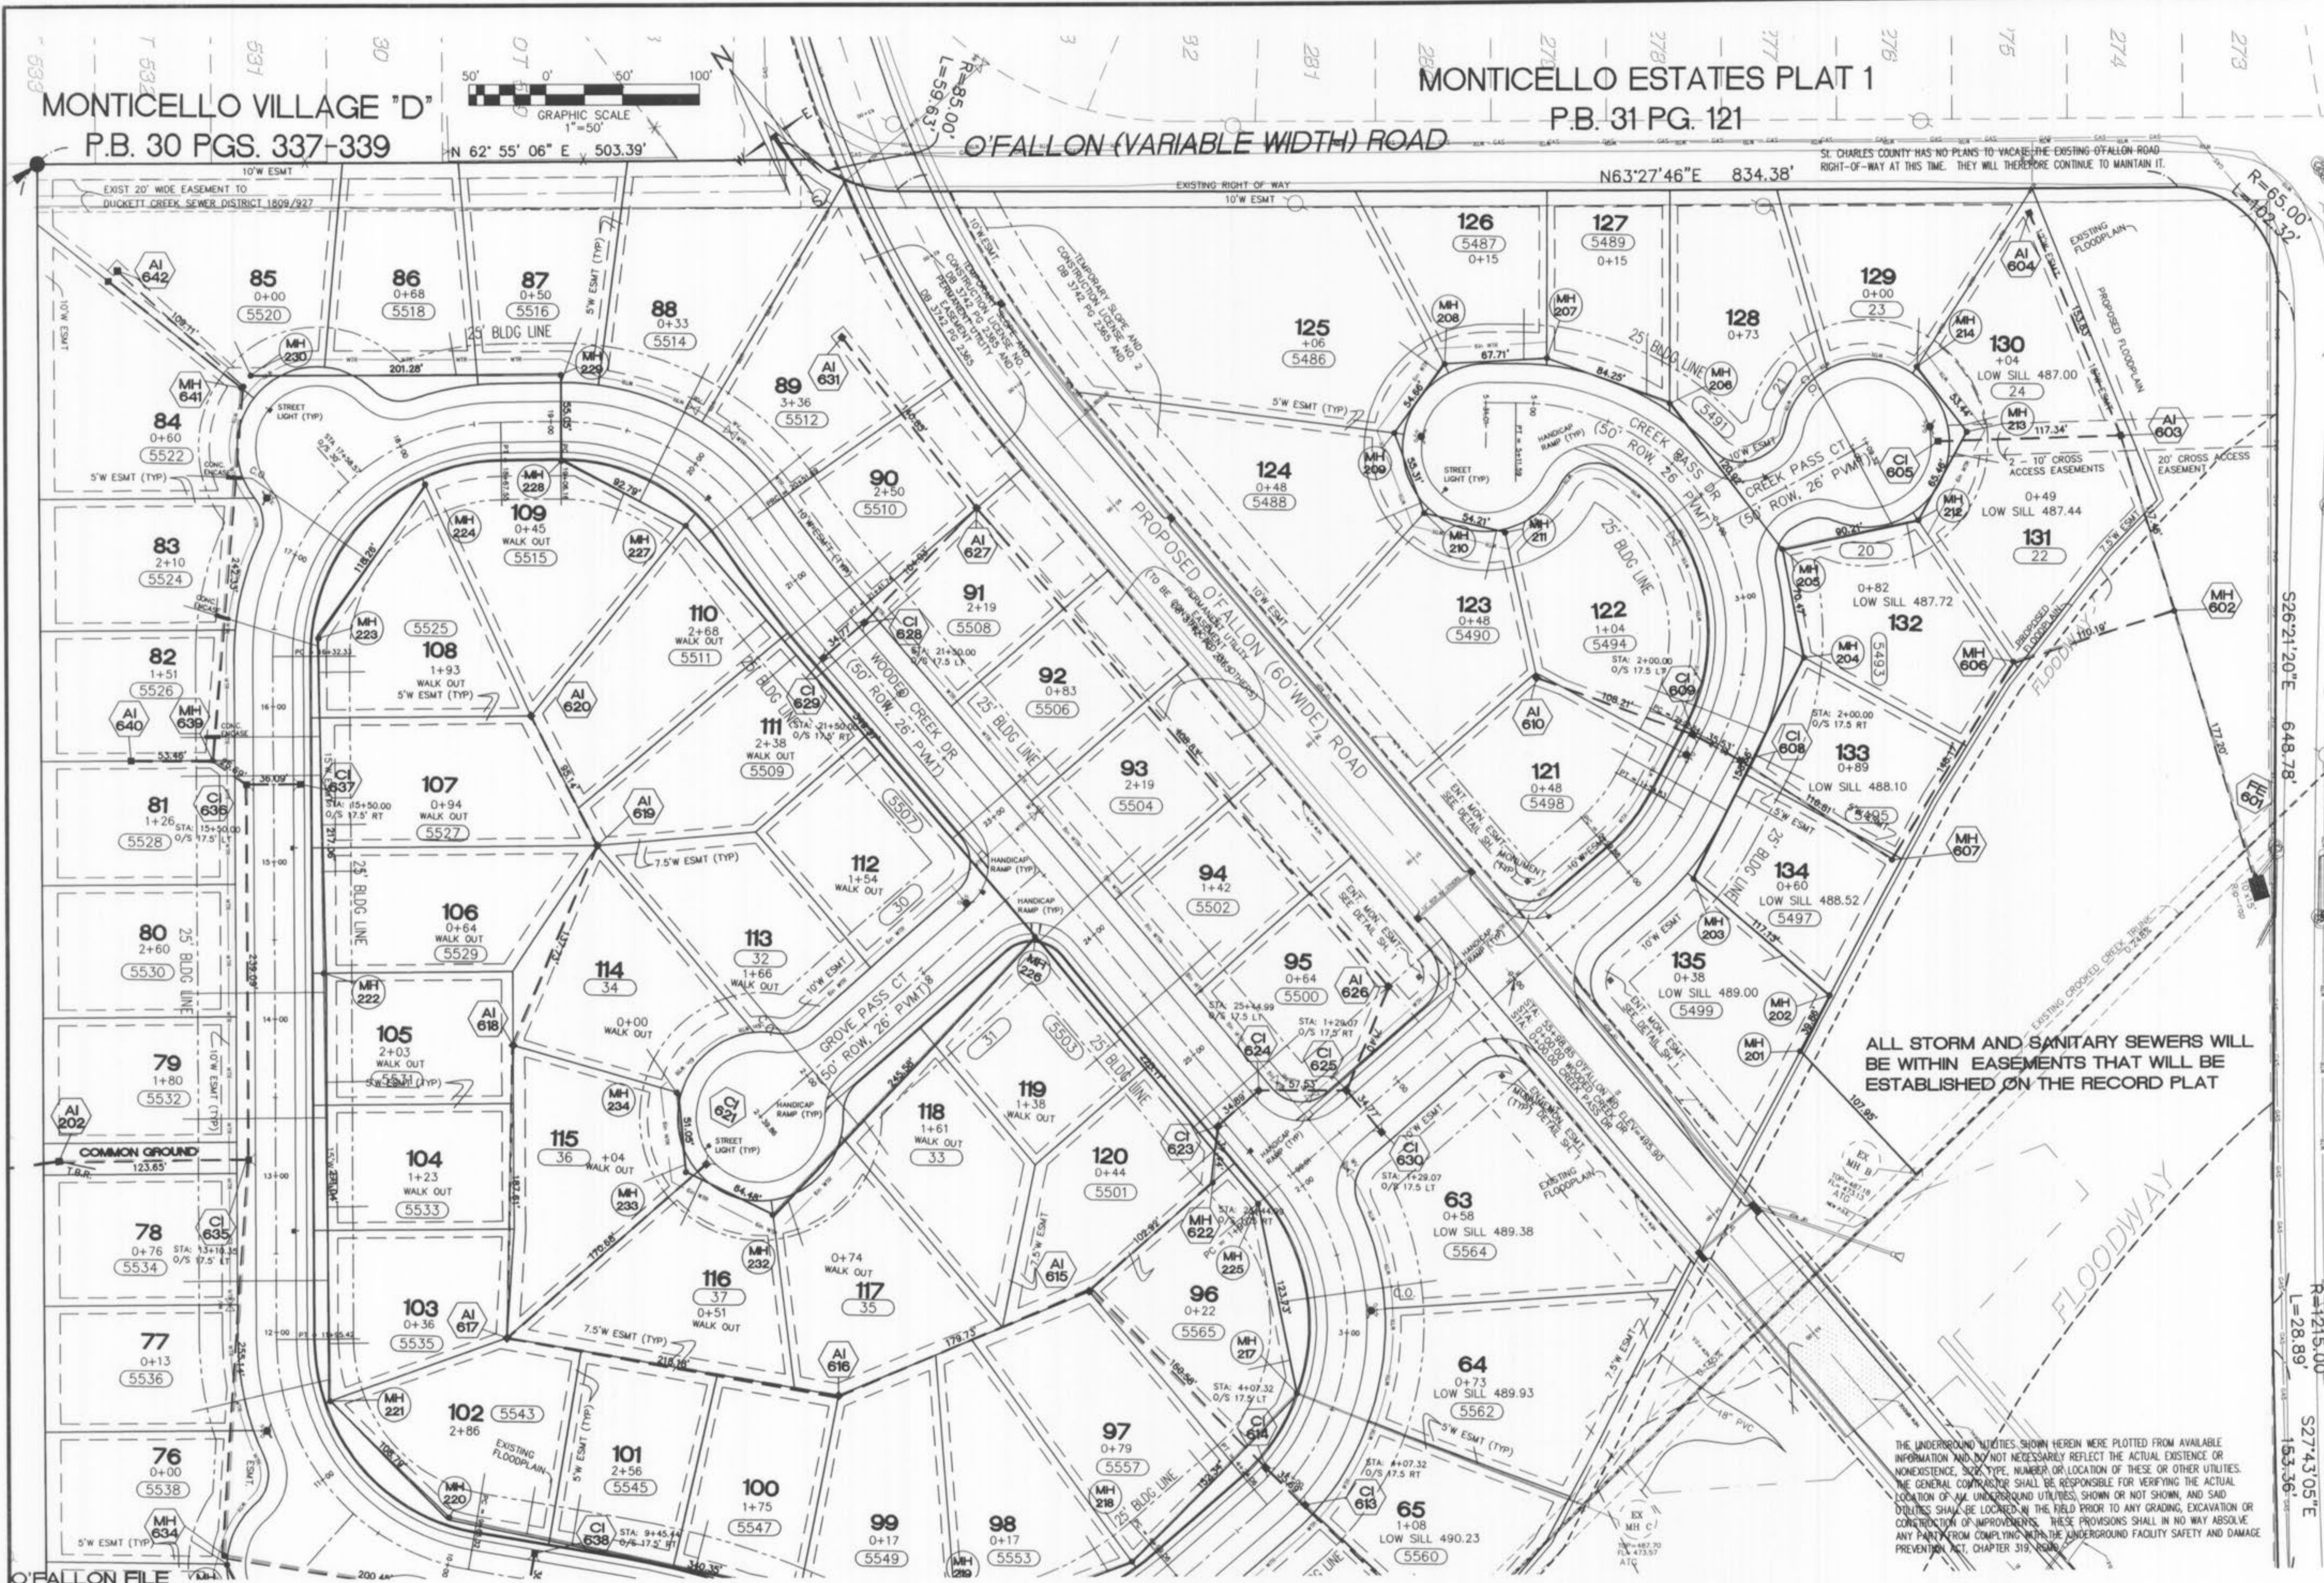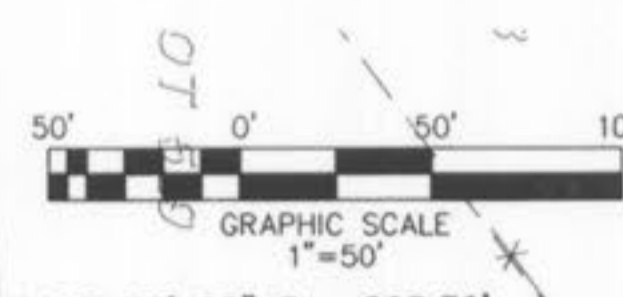

ALL STORM AND SANITARY SEWERS WILL BE WITHIN EASEMENTS THAT WILL BE ESTABLISHED ON THE RECORD PLAT

FLAT PLAN
AS-BUILTS
HIDDEN CREEK
PHASE 2

ST. CHARLES ENGINEERING & SURVEYING, INC.
801 S. FIFTH STREET, SUITE 202
ST. CHARLES, MO 63301
TEL: (636) 947-0607 FAX: (636) 947-2448

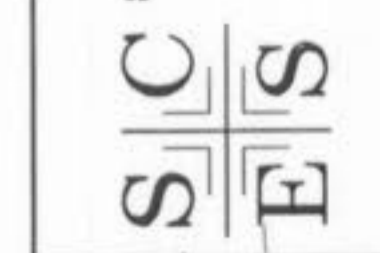




11/15/07
ORDER NO. 02-0162-01
DATE 05/03/05

AB2-2

O'FALLON FILE NUMBER 1002.02


THE UNDERGROUND UTILITIES SHOWN HEREIN WERE PLOTTED FROM AVAILABLE INFORMATION AND DO NOT NECESSARILY REFLECT THE ACTUAL EXISTENCE OR NONEXISTENCE, SIZE, TYPE, NUMBER OR LOCATION OF THESE OR OTHER UTILITIES. THE GENERAL CONTRACTOR SHALL BE RESPONSIBLE FOR VERIFYING THE ACTUAL LOCATION OF ALL UNDERGROUND UTILITIES, SHOWN OR NOT SHOWN, AND SAID UTILITIES SHALL BE LOCATED IN THE FIELD PRIOR TO ANY GRADING, EXCAVATION OR CONSTRUCTION OF IMPROVEMENTS. THESE PROVISIONS SHALL IN NO WAY ABSOLVE ANY PARTY FROM COMPLYING WITH THE UNDERGROUND FACILITY SAFETY AND DAMAGE PREVENTION ACT, CHAPTER 319, RSMO.

THE UNDERGROUND UTILITIES SHOWN HEREIN WERE PLOTTED FROM AVAILABLE INFORMATION AND DO NOT NECESSARILY REFLECT THE ACTUAL EXISTENCE OR NONEXISTENCE, SIZE, TYPE, NUMBER OR LOCATION OF THESE OR OTHER UTILITIES. THE GENERAL CONTRACTOR SHALL BE RESPONSIBLE FOR VERIFYING THE ACTUAL LOCATION OF ALL UNDERGROUND UTILITIES, SHOWN OR NOT SHOWN, AND SAID UTILITIES SHALL BE LOCATED IN THE FIELD PRIOR TO ANY GRADING, EXCAVATION OR CONSTRUCTION OF IMPROVEMENTS. THESE PROVISIONS SHALL IN NO WAY ABSOLVE ANY PARTY FROM COMPLYING WITH THE UNDERGROUND FACILITY SAFETY AND DAMAGE PREVENTION ACT, CHAPTER 319, RSMO.

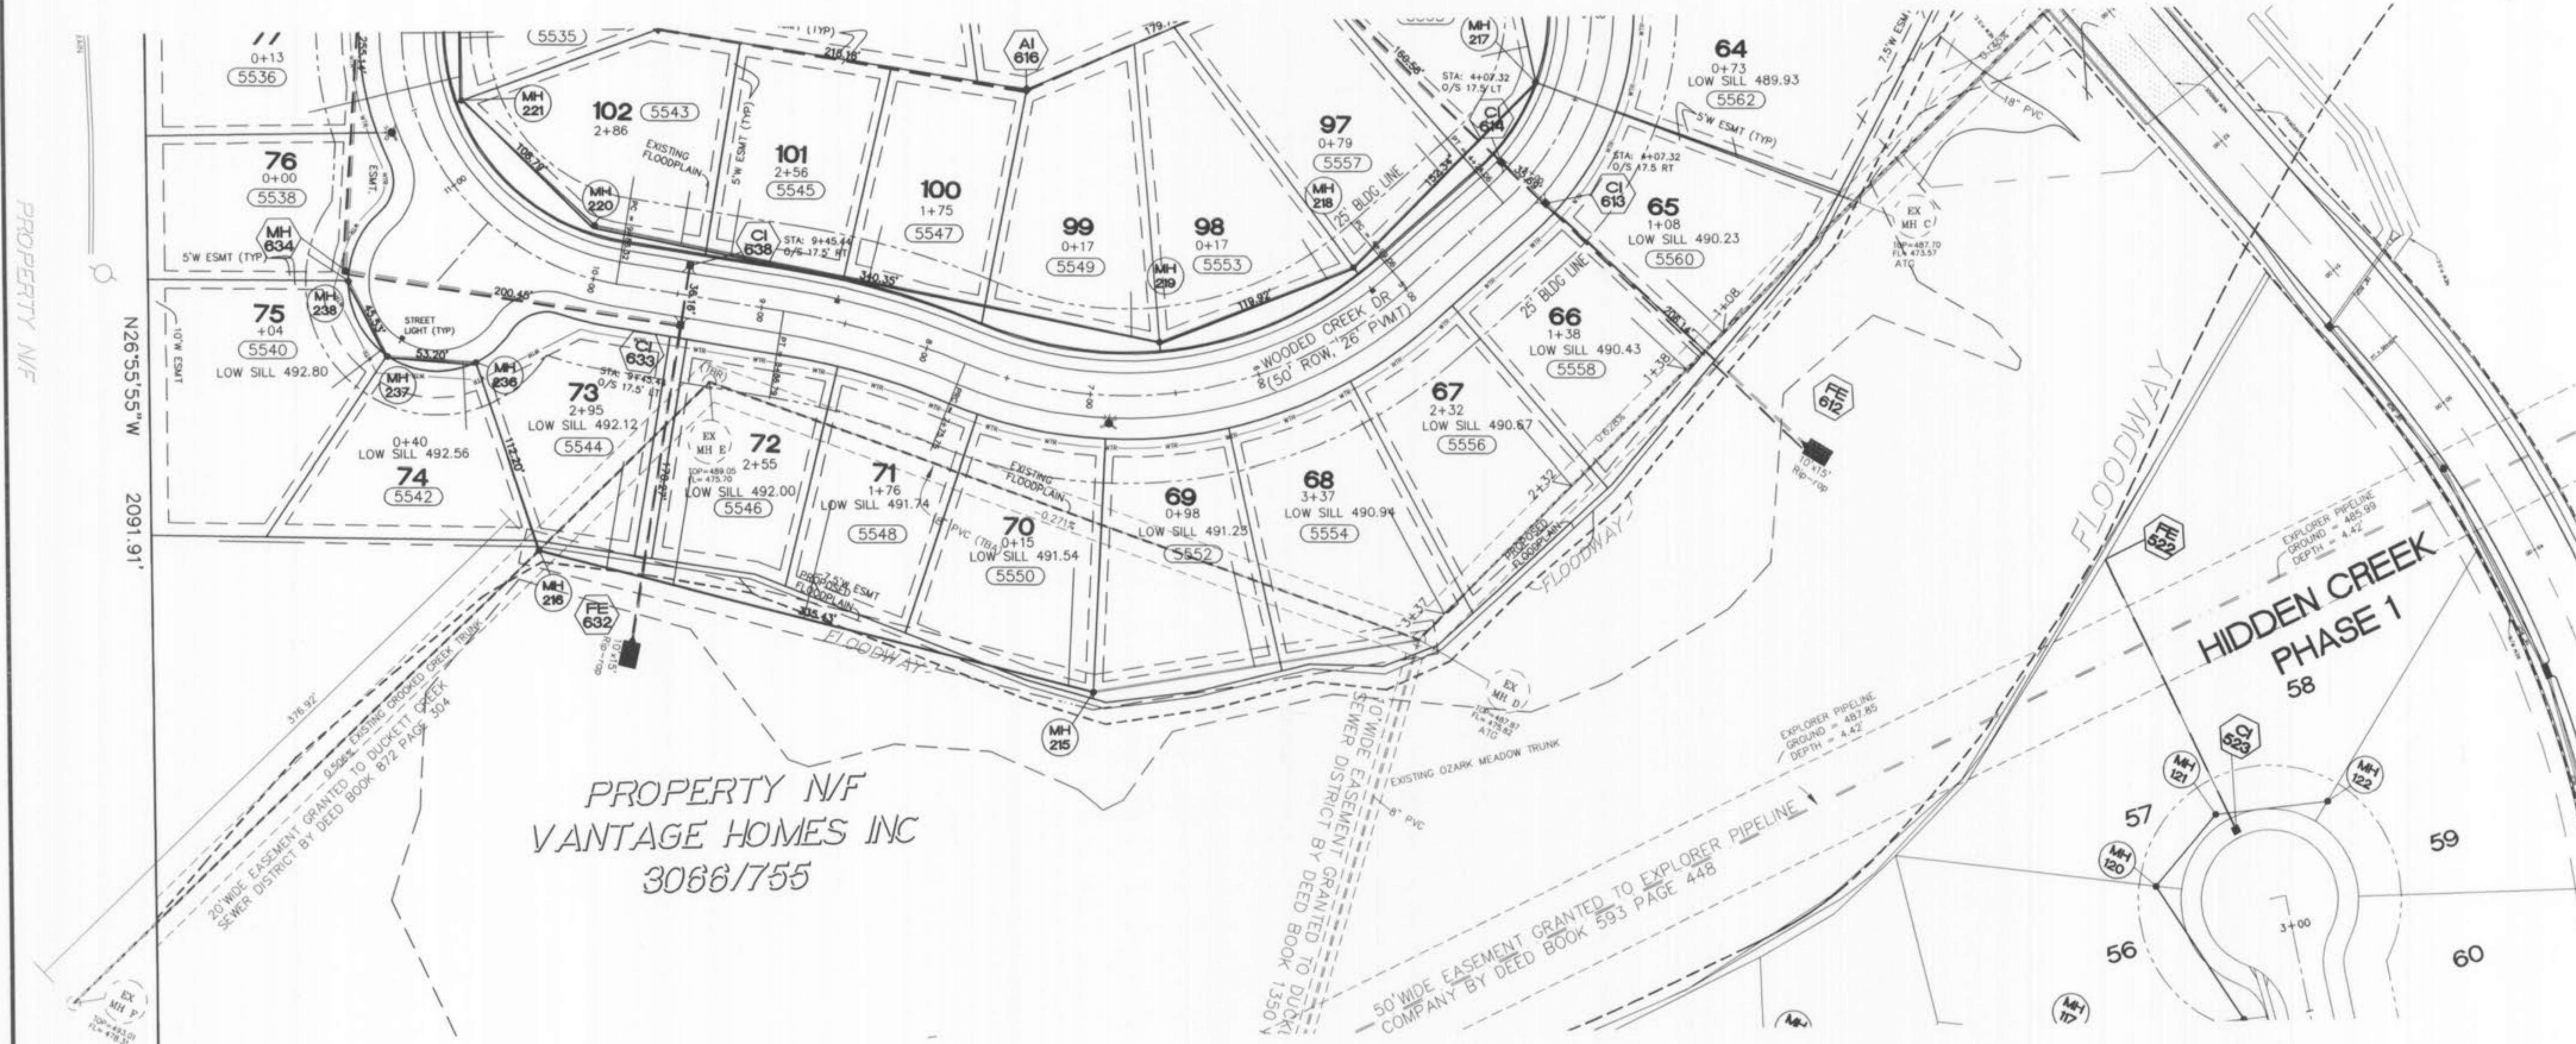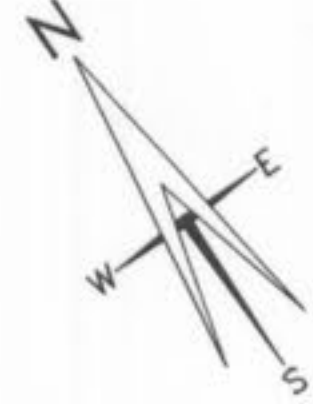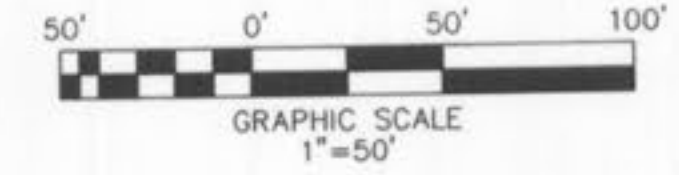

PROPERTY N/F
VANTAGE HOMES INC
3066/755

NOTES:
EXISTING SANITARY LINE TO BE REMOVED OR GROUTED FILLED WITH PRESENCE OF A D.C.S.D. INSPECTOR. A 24 HOUR NOTICE WILL BE REQUIRED.
ALL SADDLE TAPS TO EXISTING LINE MUST BE MADE WITH THE PRESENCE OF A D.C.S.D. INSPECTOR. A 24 HOUR NOTICE WILL BE REQUIRED.

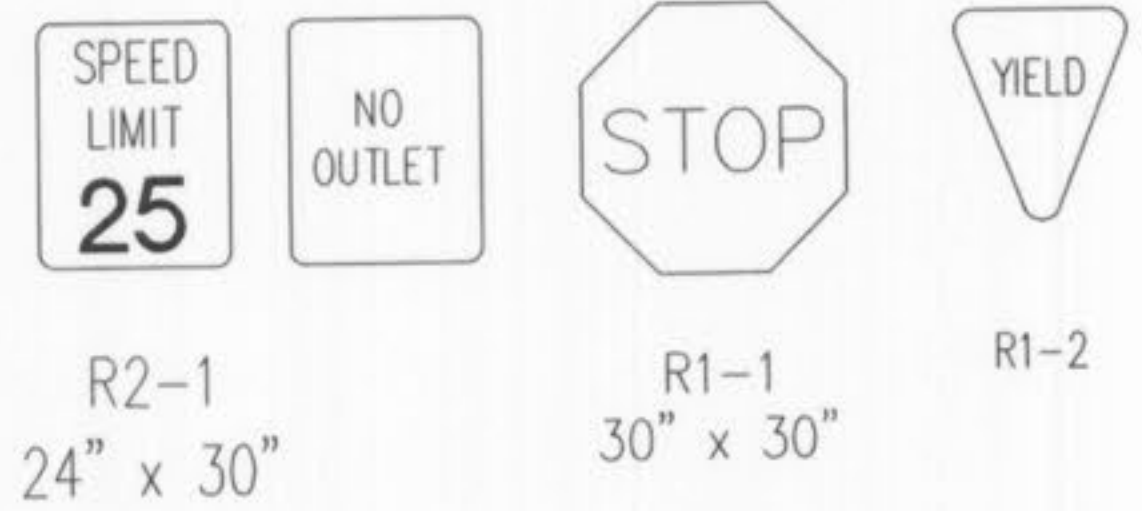





REQUIRED STREET SIGNS

FLAT PLAN
AS-BUILTS
HIDDEN CREEK
PHASE 2

ST. CHARLES ENGINEERING & SURVEYING, INC.
801 S. FIFTH STREET, SUITE 202
ST. CHARLES, MO 63301
TEL: (636) 947-0607 FAX: (636) 947-2448



11/15/07
ORDER NO. 02-0162-01
DATE 05/03/05
AB2-3

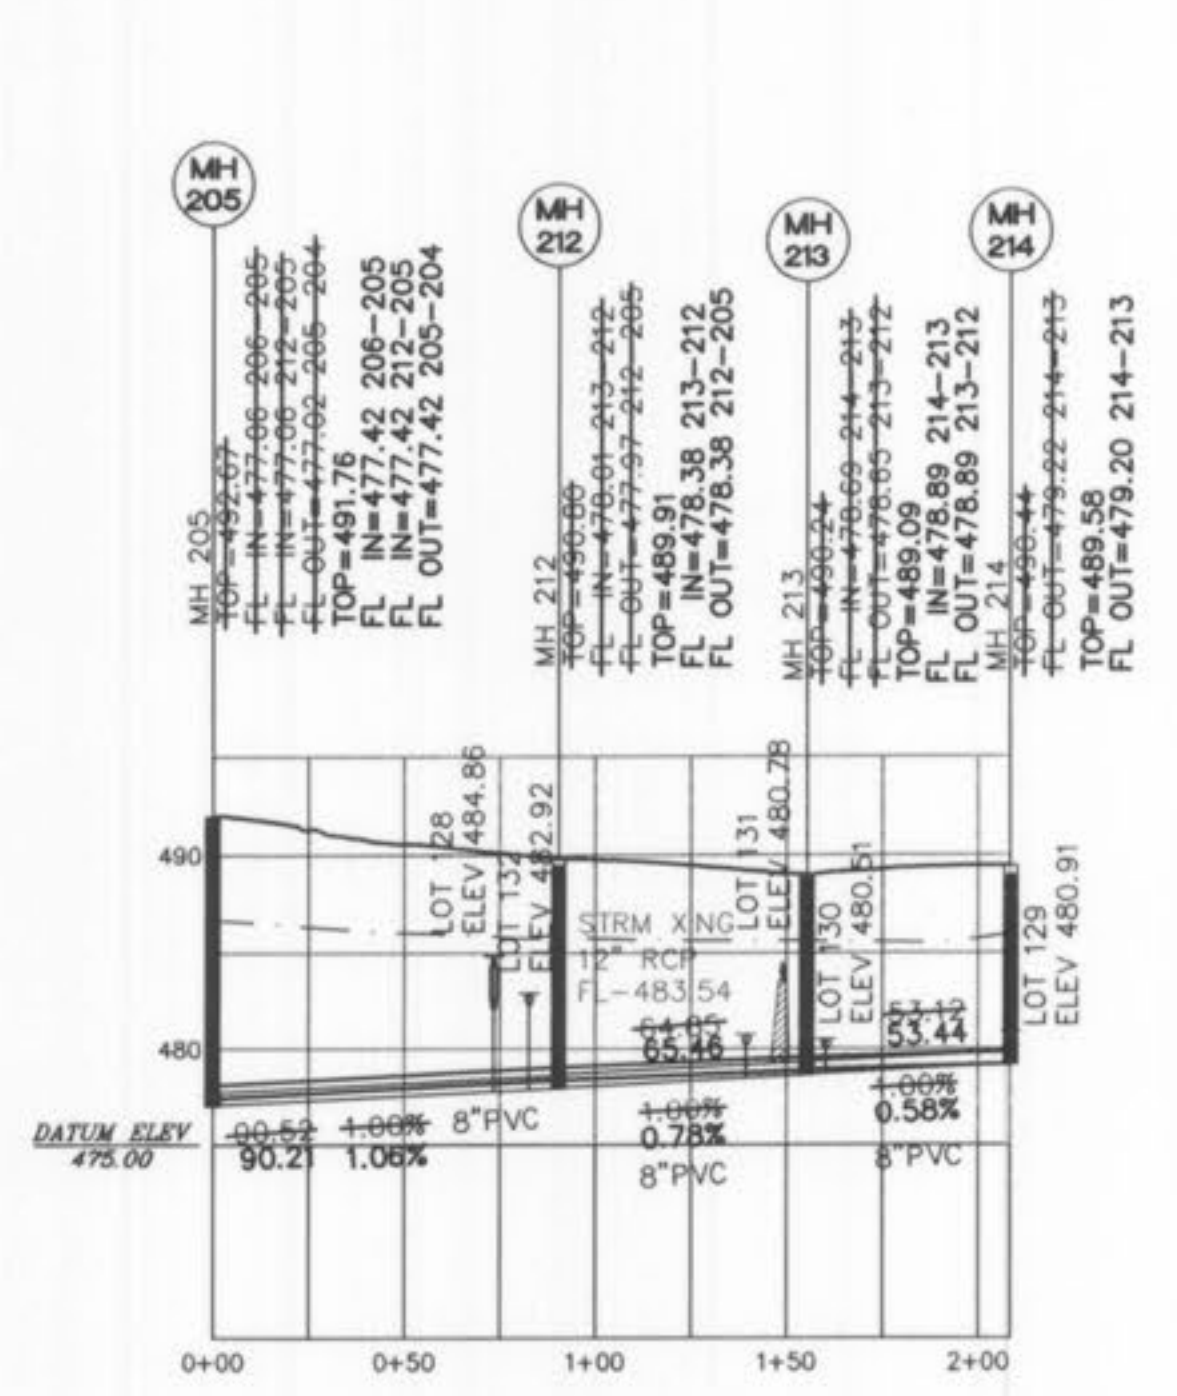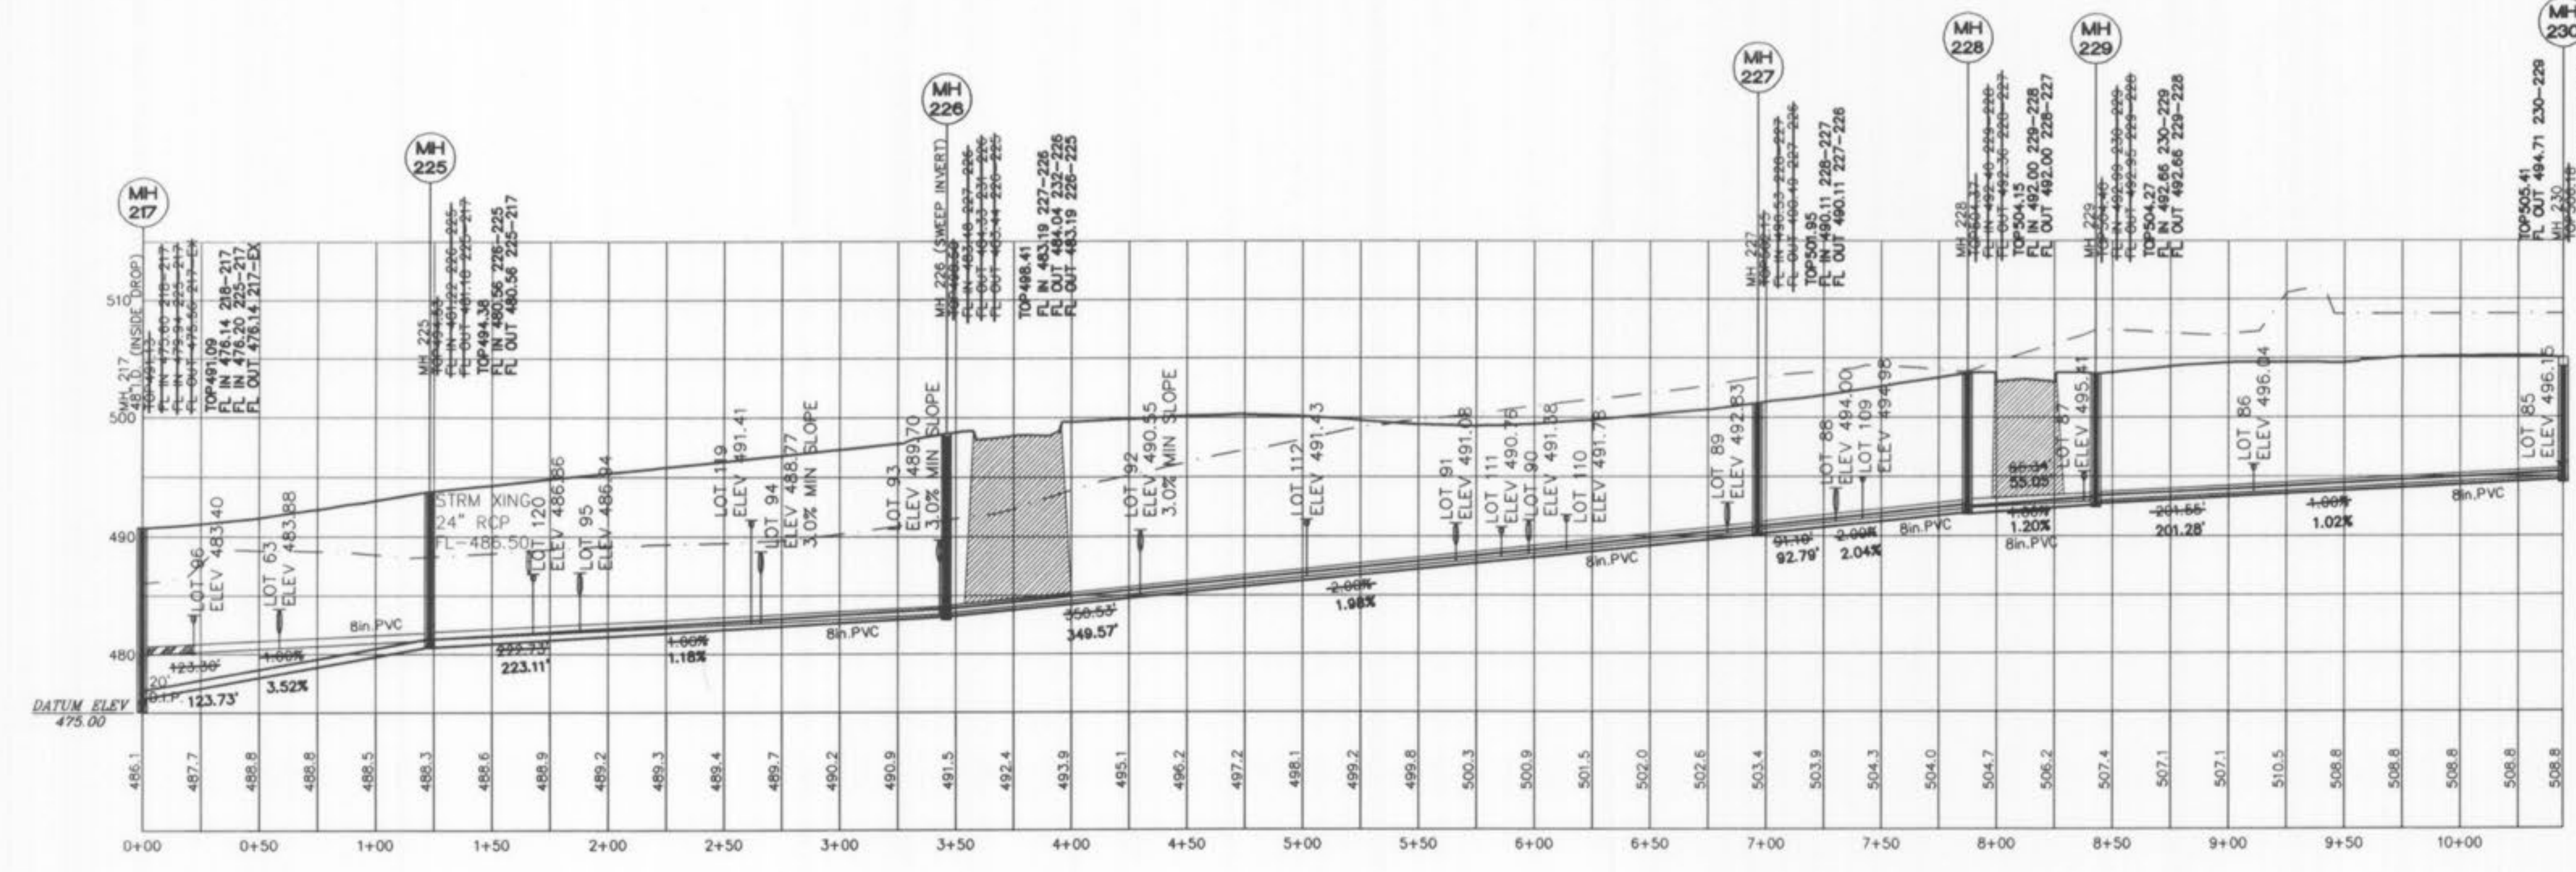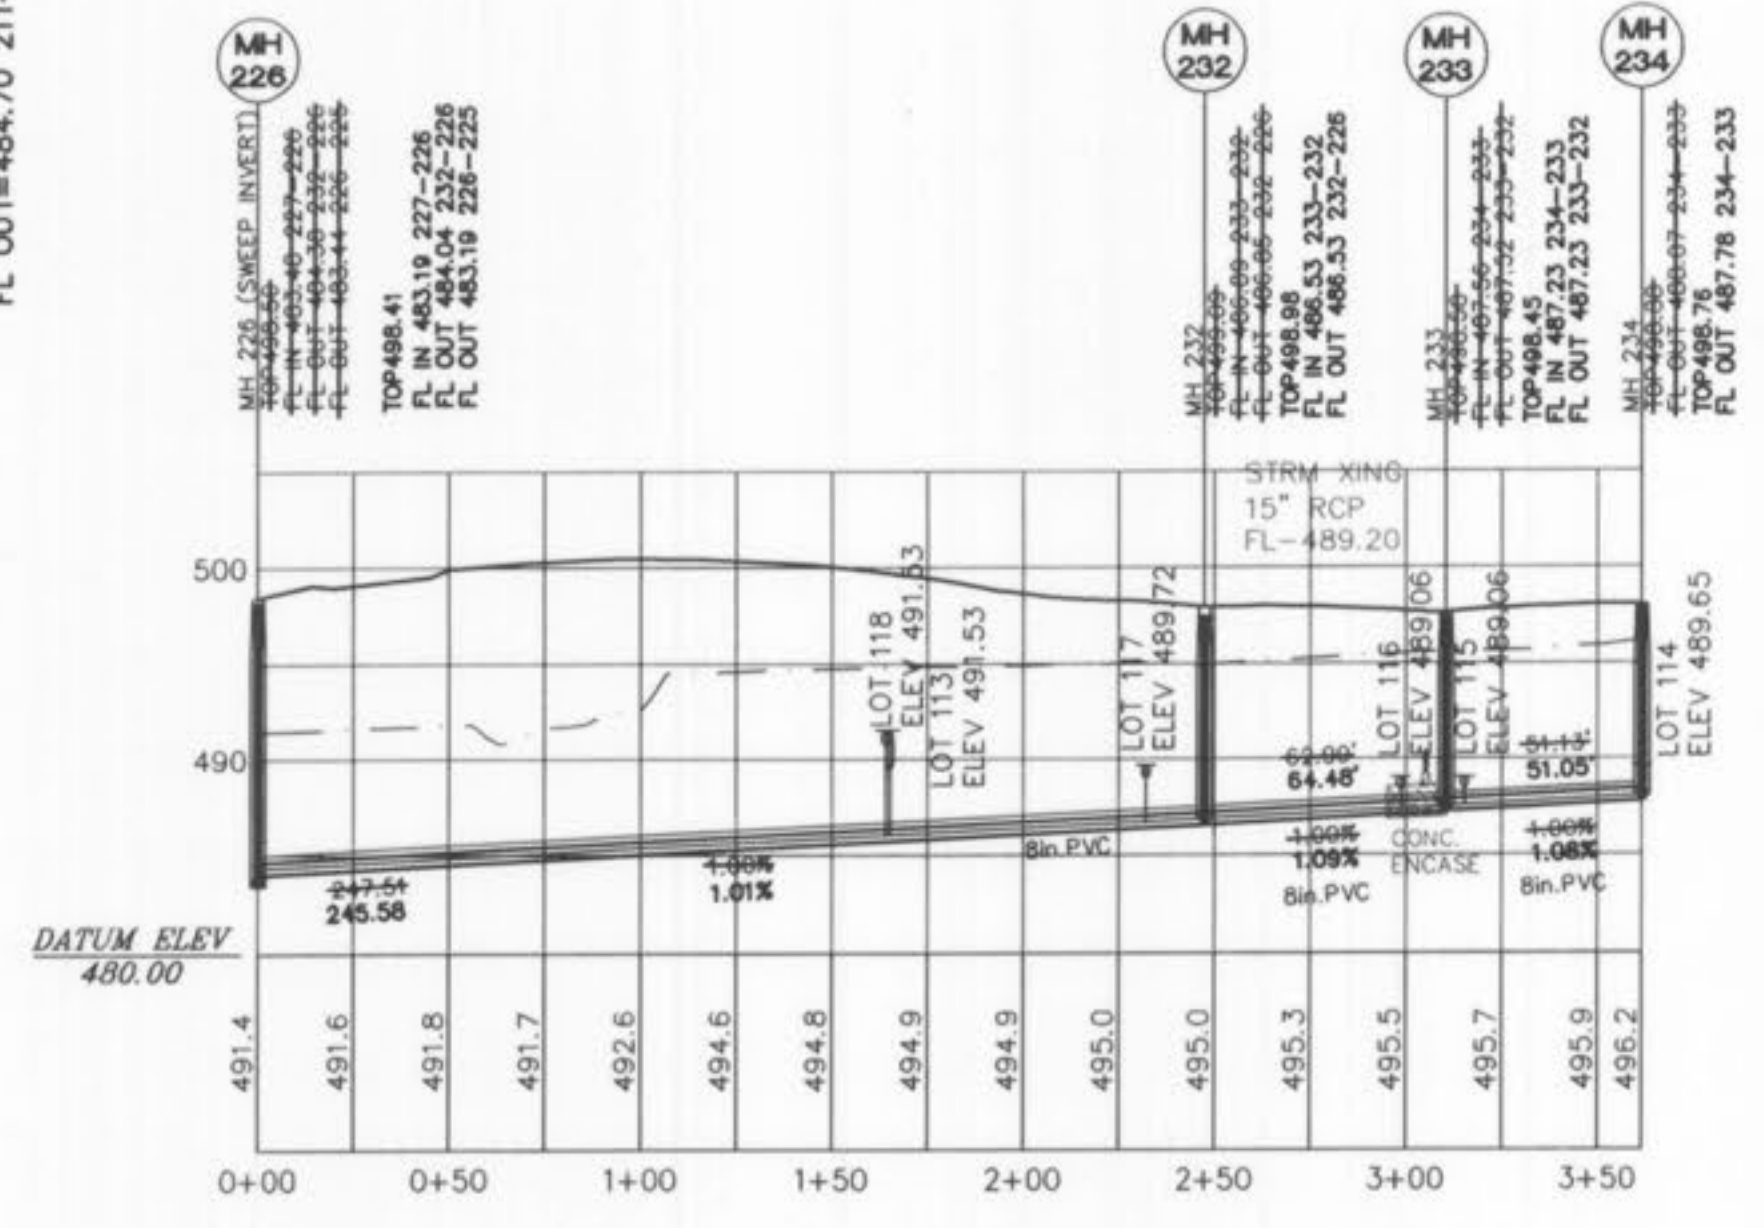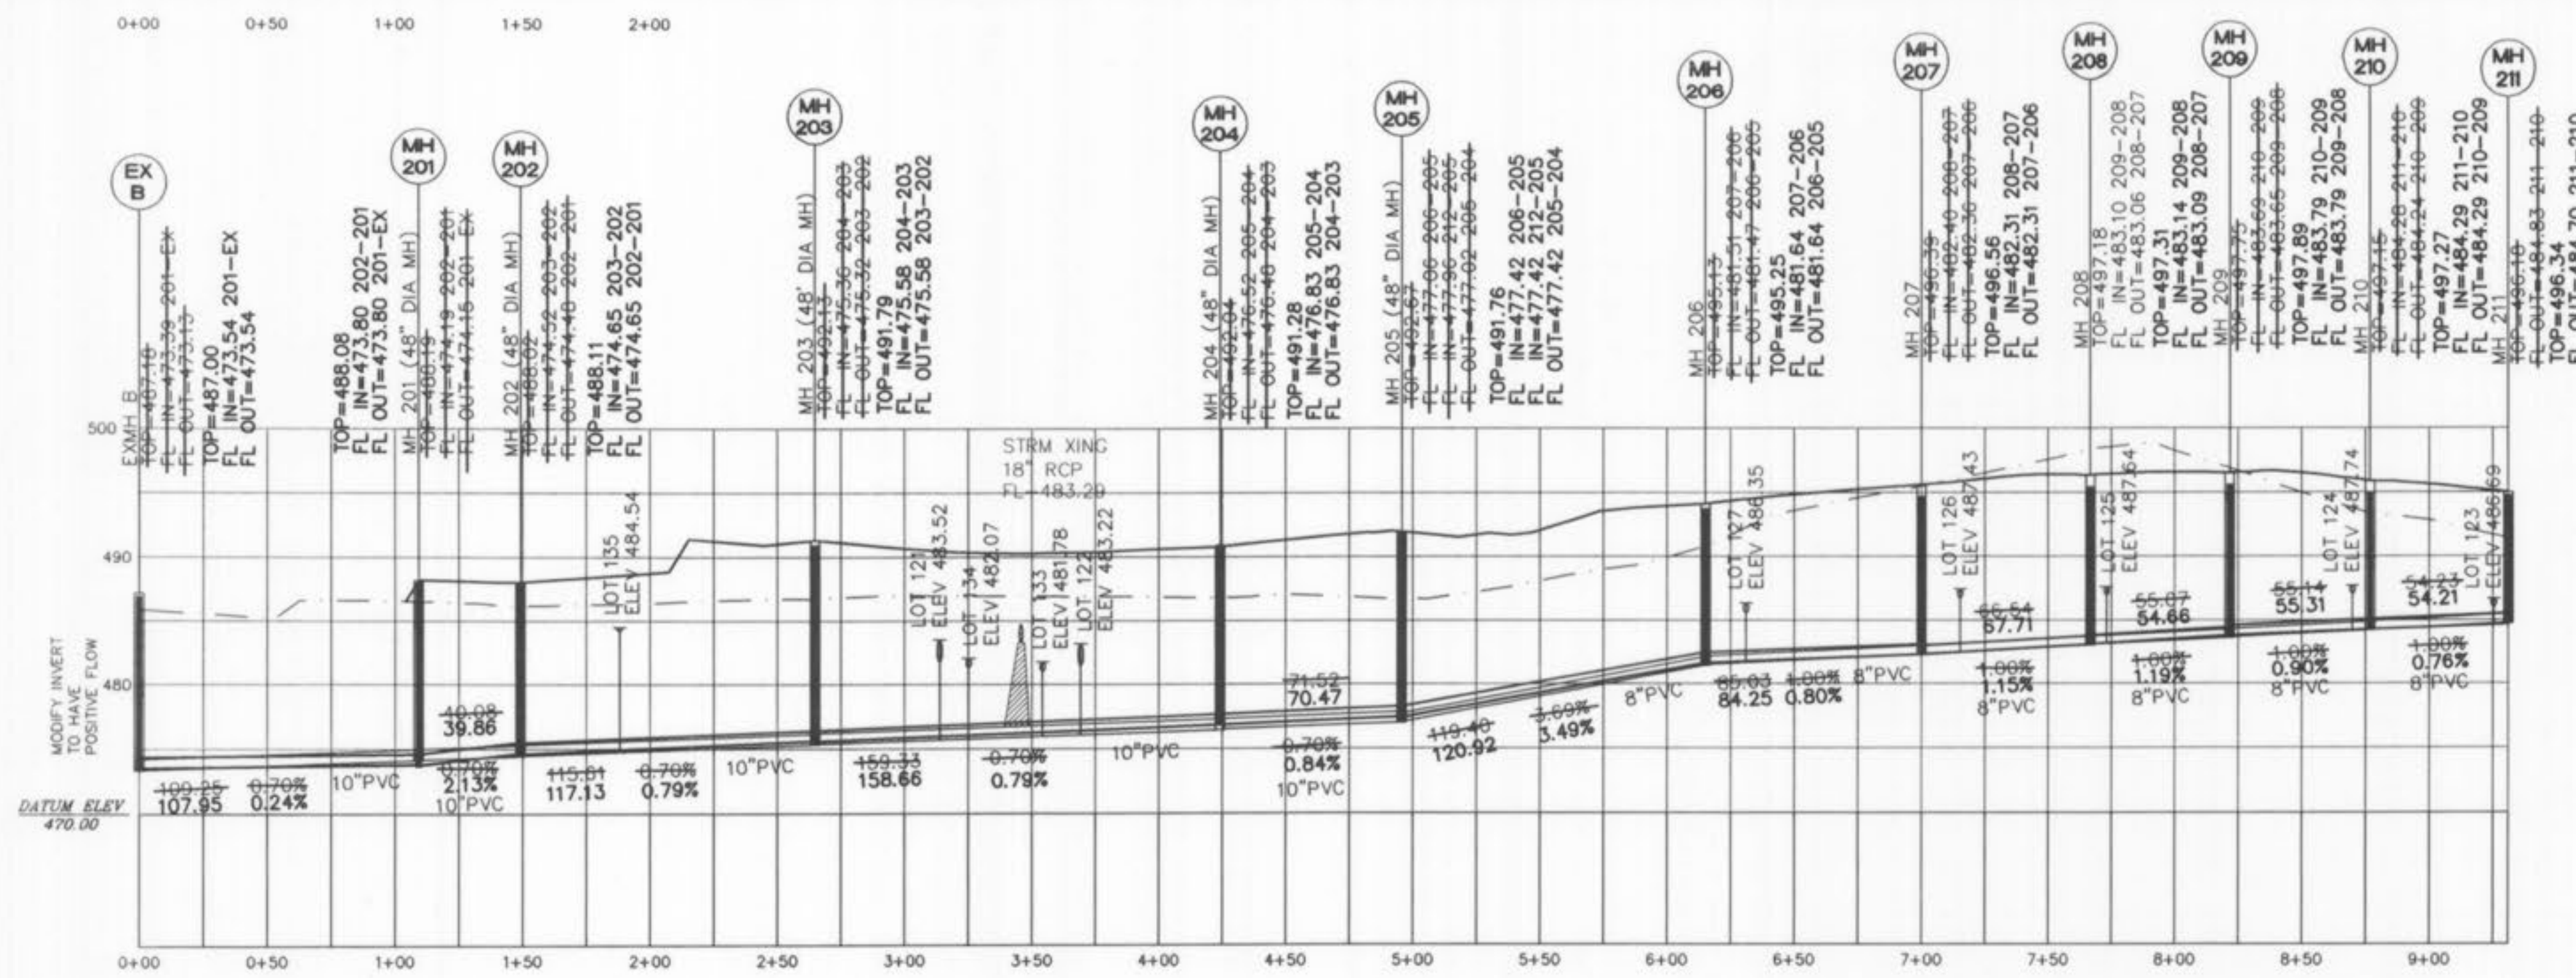

All sanitary lateral street crossings, if trenched, shall be backfilled with granular material (aggregate).

Storm sewer pipes that cross over existing or proposed sanitary sewer trenches shall be cradled in concrete through the full width of the sanitary sewer trench. The trench shall be backfilled and compacted with granular fill to the bottom of the concrete cradle.

If the storm and sanitary sewer are parallel and in the same trench or overdig, the upper pipe shall be placed on a shelf and the lower pipe shall be bedded in compacted granular fill to the flow line of the upper pipe.

Rock backfill all storm and sanitary sewers that lie within the 1:1 shear plane of the road.





VERT. 1" = 10'
HORIZ. 1" = 50'
SCALE:

**SANITARY PROFILES
AS-BUILTS
HIDDEN CREEK
PHASE 2**

ST. CHARLES ENGINEERING & SURVEYING, INC.
801 S. FIFTH STREET, SUITE 202
ST. CHARLES, MO 63301
TEL: (636) 947-0607 FAX: (636) 947-2448



11/15/07
ORDER NO. 02-0162-01
DATE 05/03/05

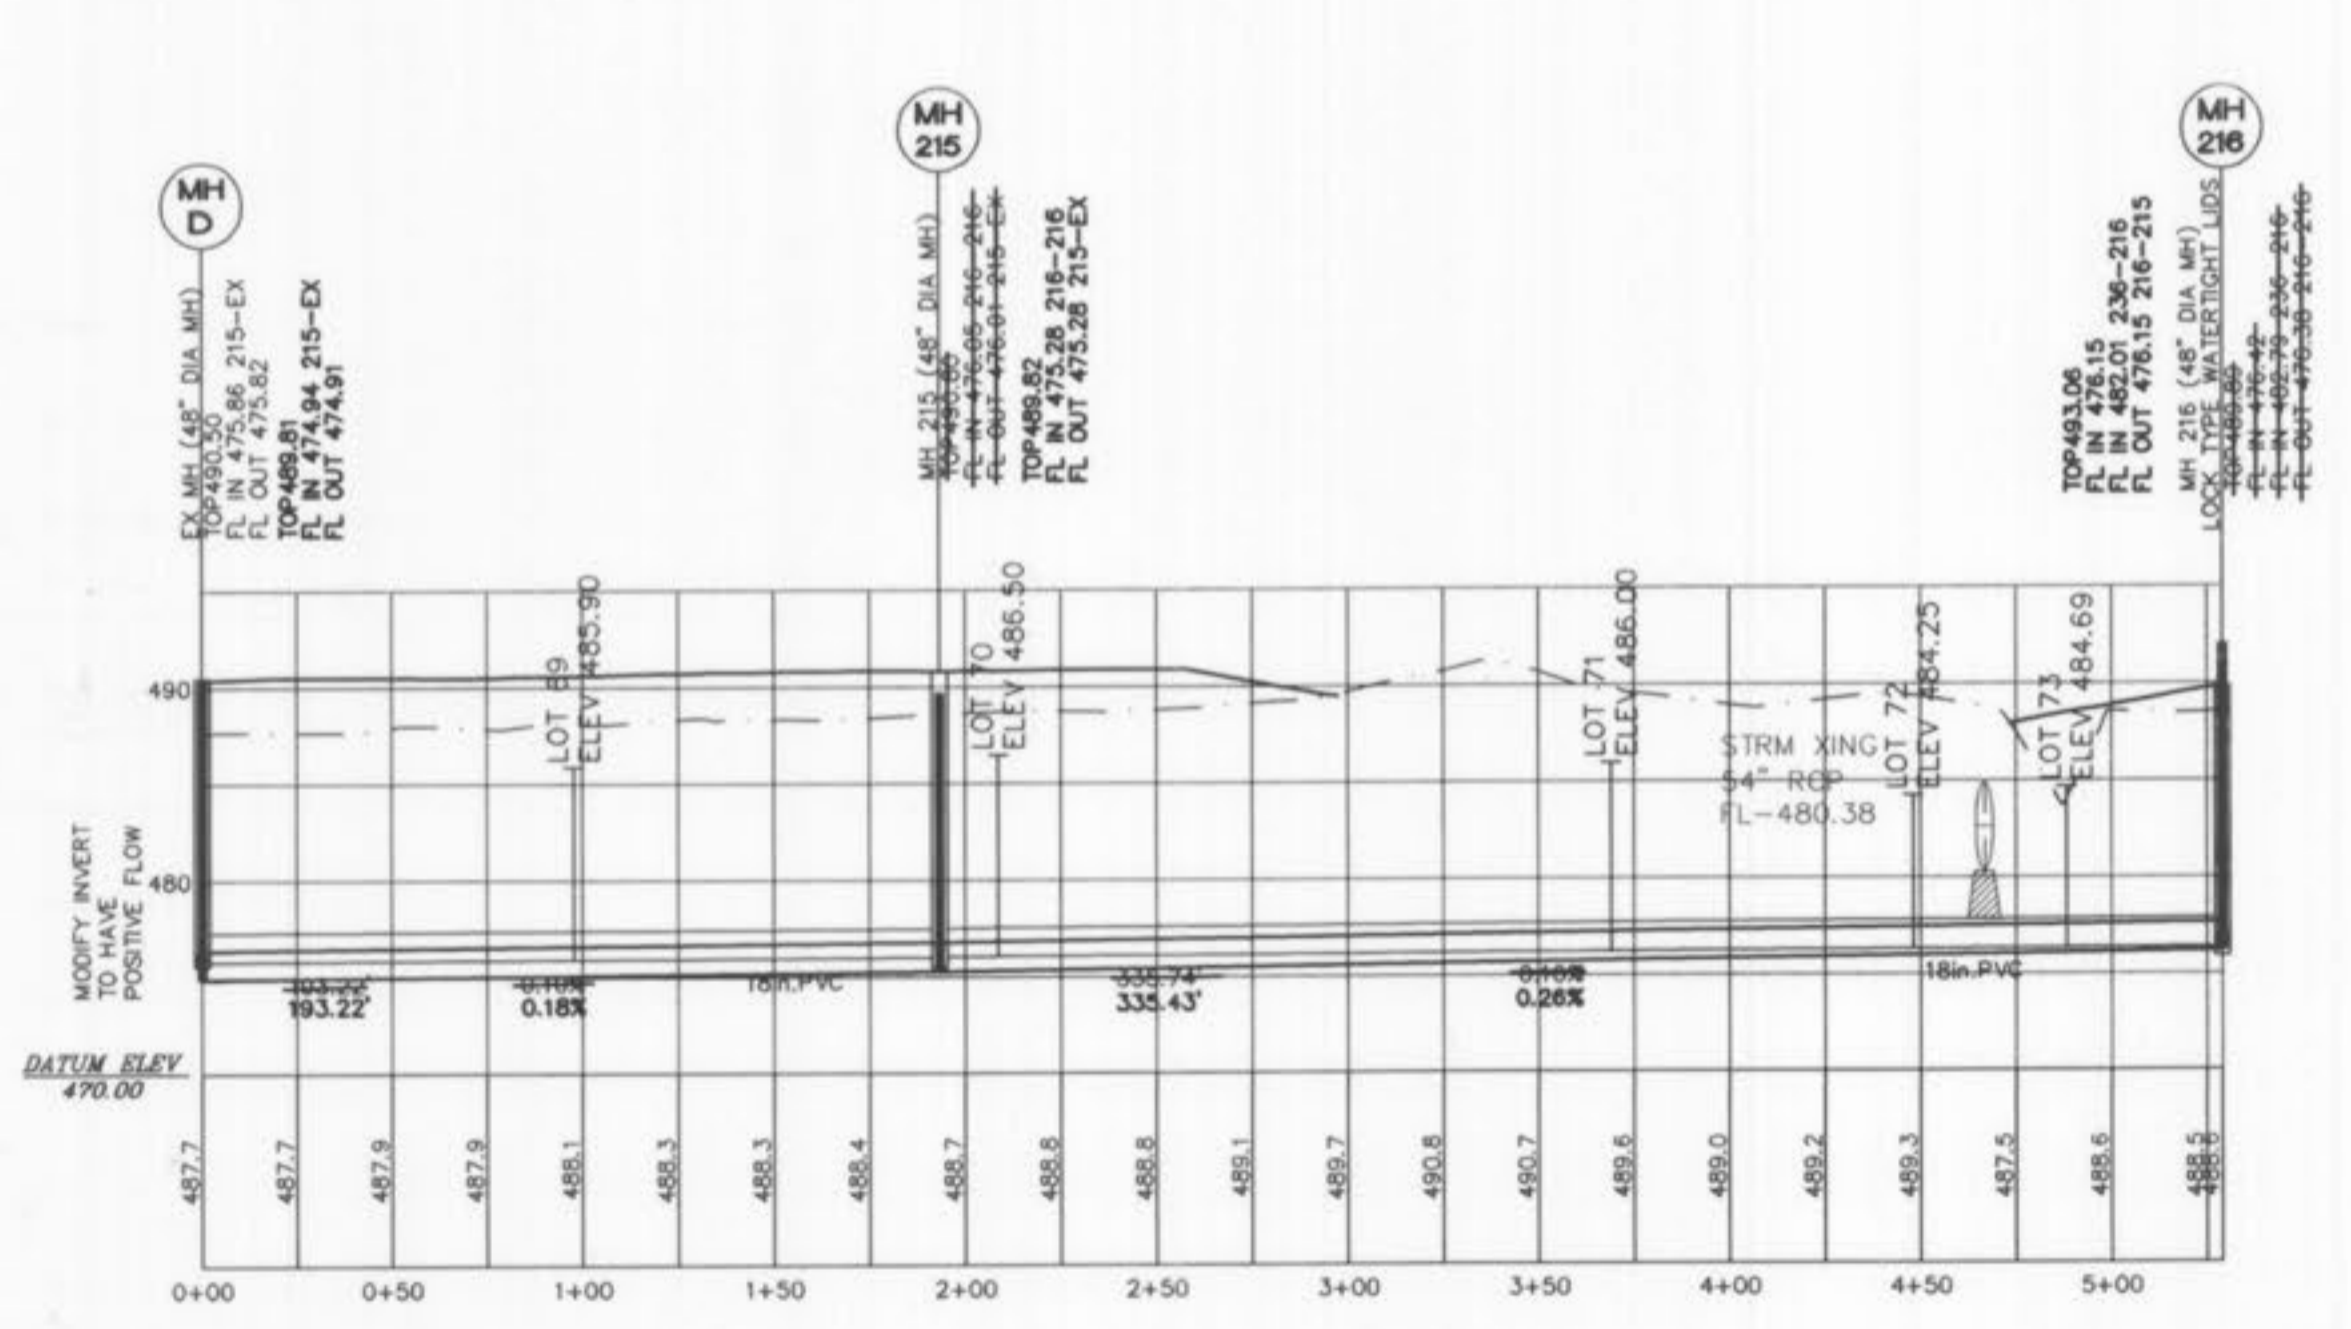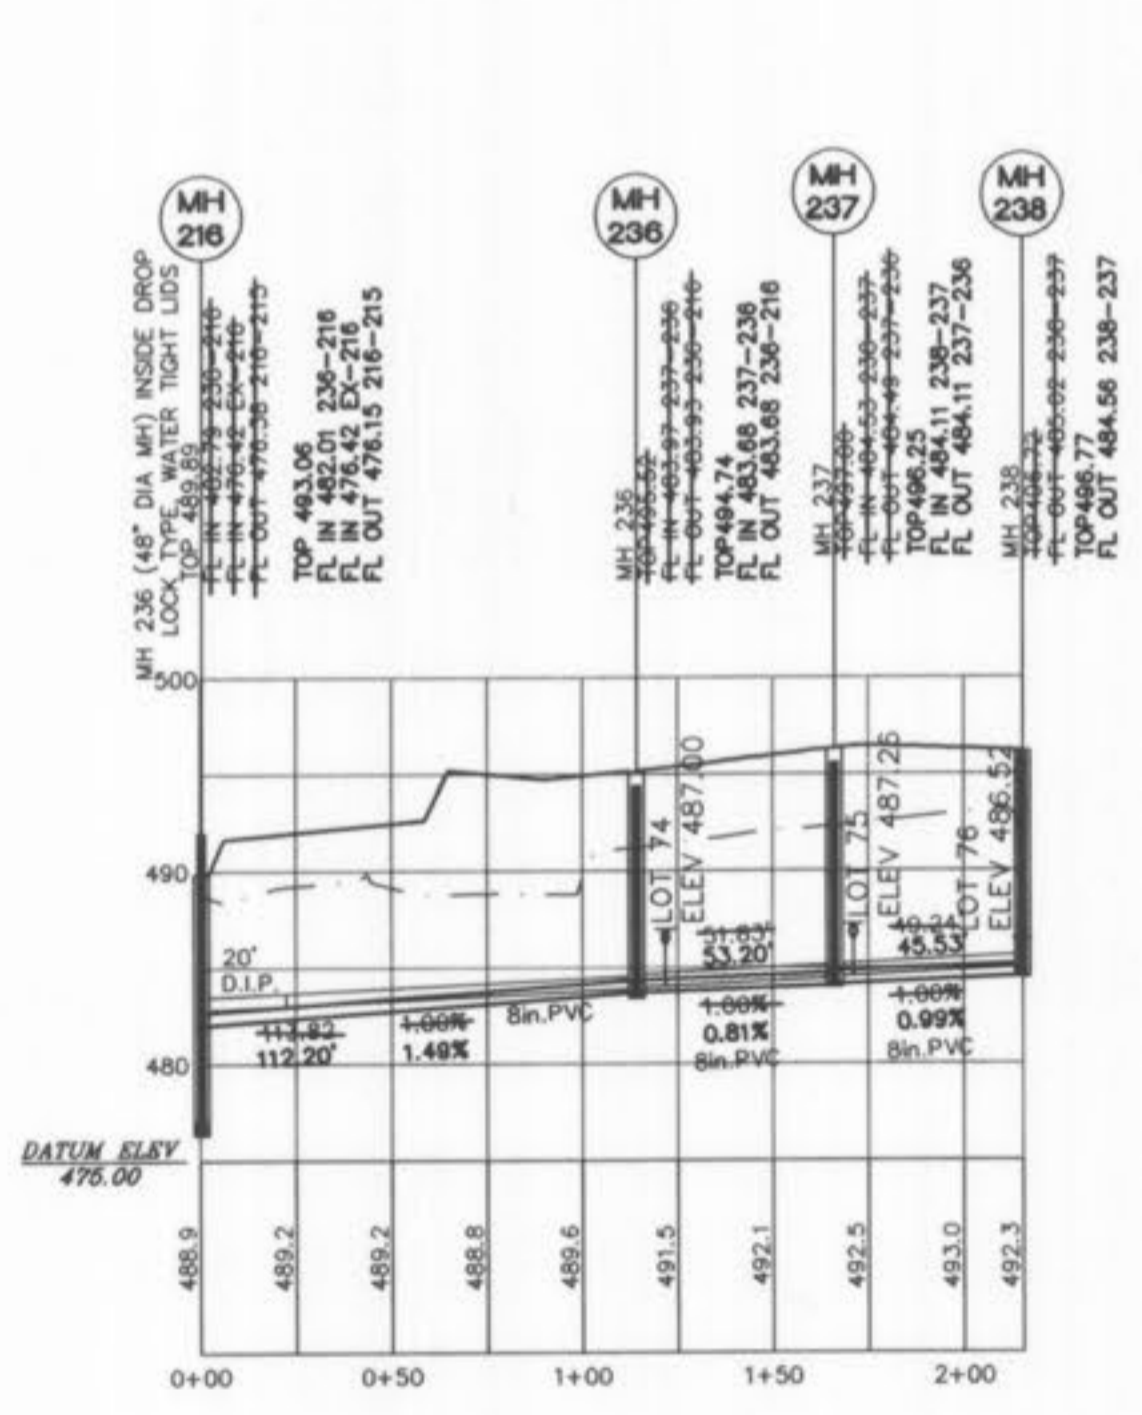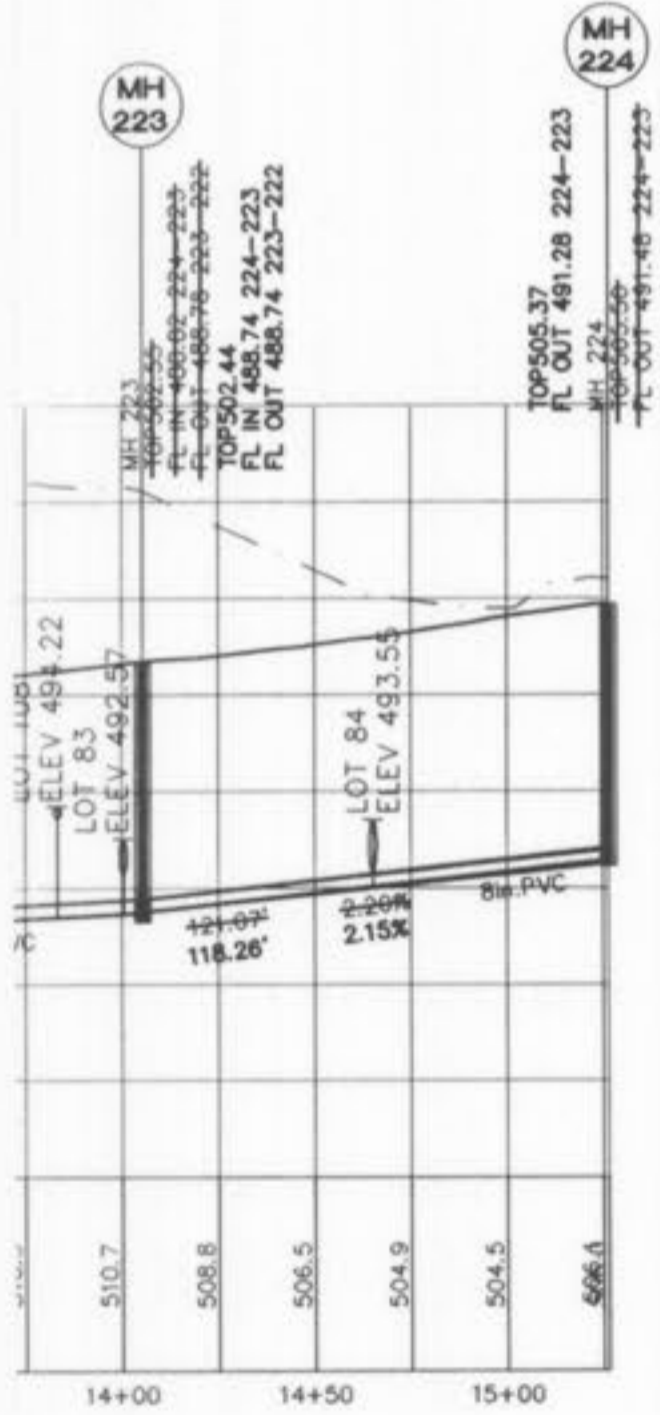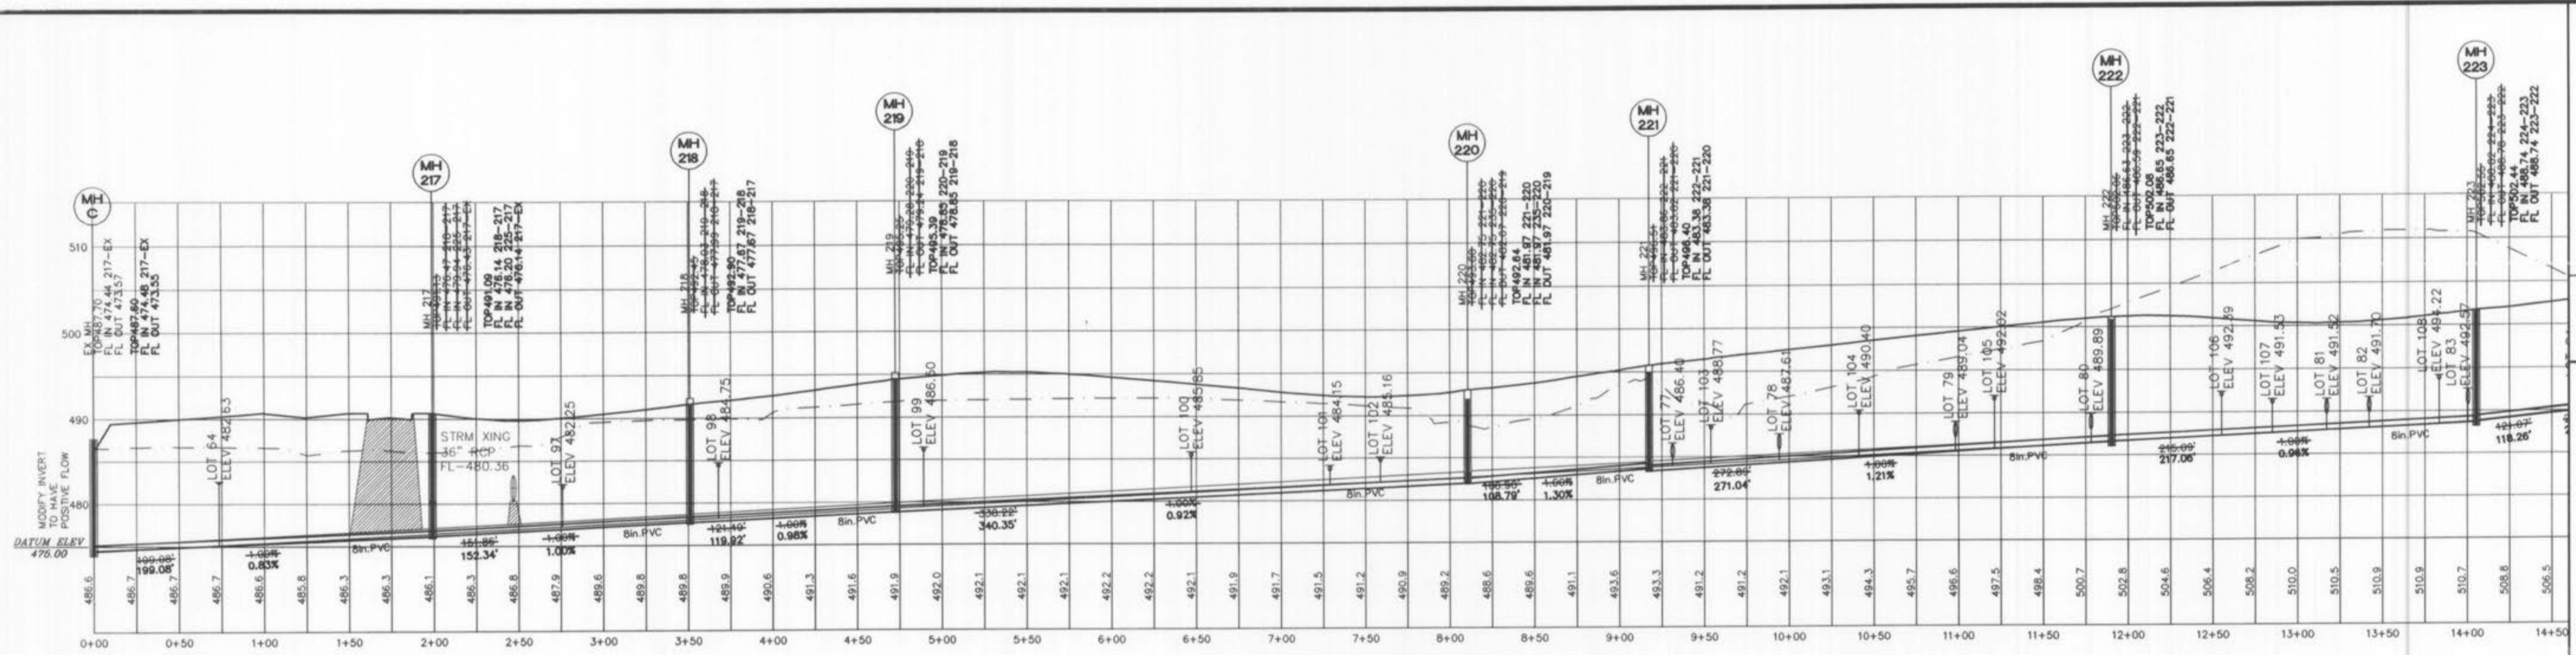

**SANITARY PROFILES
 AS-BUILTS
 HIDDEN CREEK
 PHASE 2**

ST. CHARLES ENGINEERING & SURVEYING, INC.
 801 S. FIFTH STREET, SUITE 202
 ST. CHARLES, MO 63301
 TEL: (636) 947-0607 FAX: (636) 947-2448




11-5-07
ORDER NO.
 02-0162-01
DATE
 05/03/05







All sanitary lateral street crossings, if trenched, shall be backfilled with granular material (aggregate).

Storm sewer pipes that cross over existing or proposed sanitary sewer trenches shall be cradled in concrete through the full width of the sanitary sewer trench. The trench shall be backfilled and compacted with granular fill to the bottom of the concrete cradle.

If the storm and sanitary sewer are parallel and in the same trench or overdig, the upper pipe shall be placed on a shelf and the lower pipe shall be bedded in compacted granular fill to the flow line of the upper pipe.

Rock backfill all storm and sanitary sewers that lie within the 1:1 shear plane of the road.

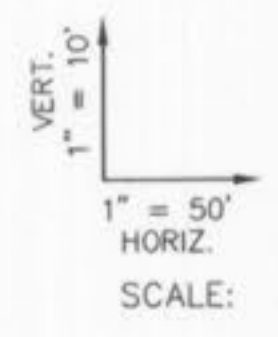

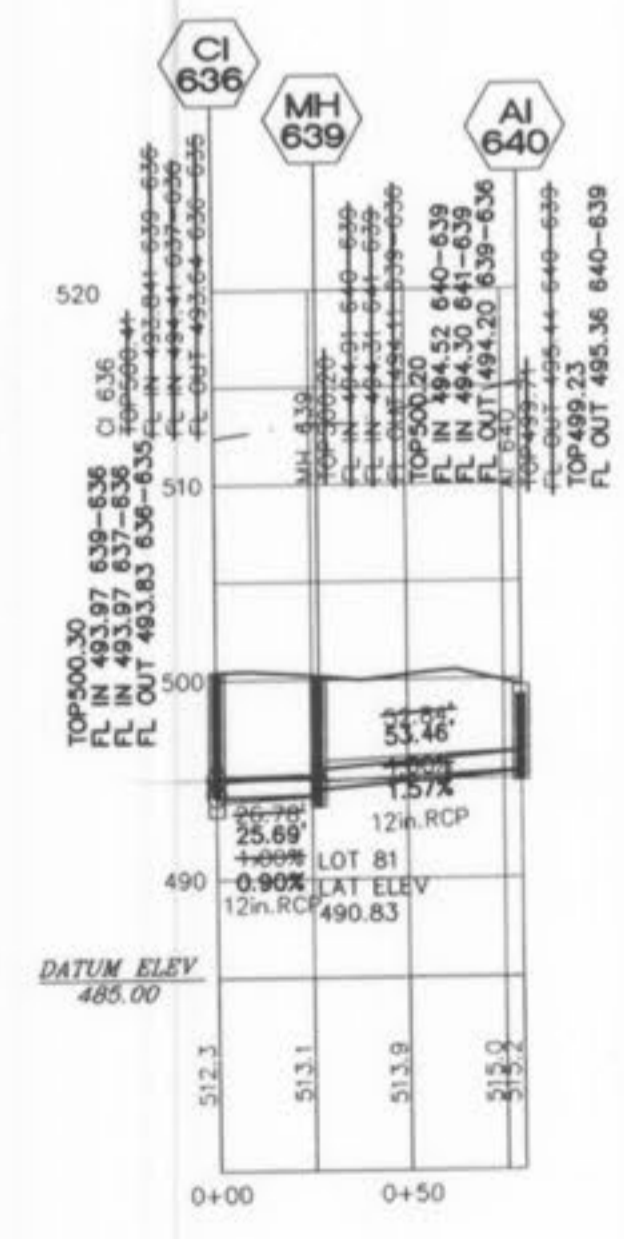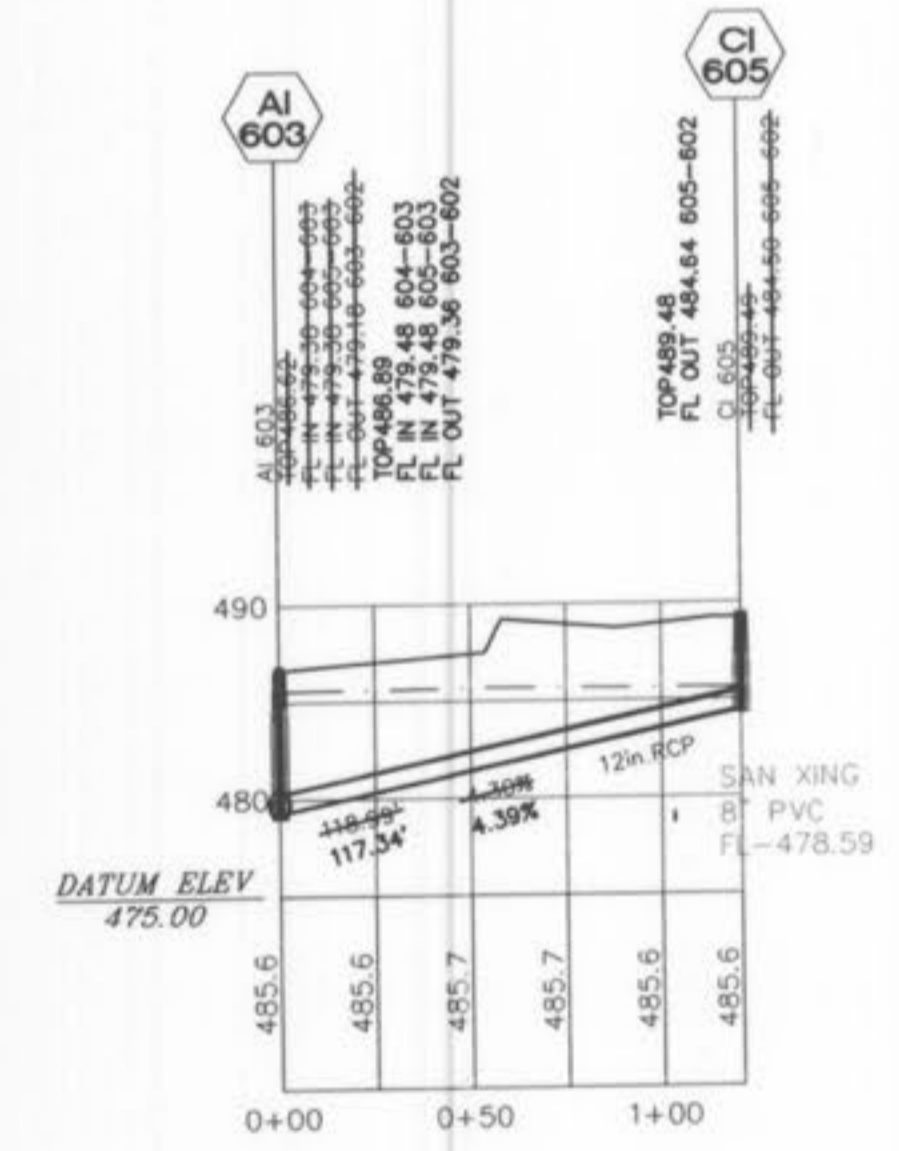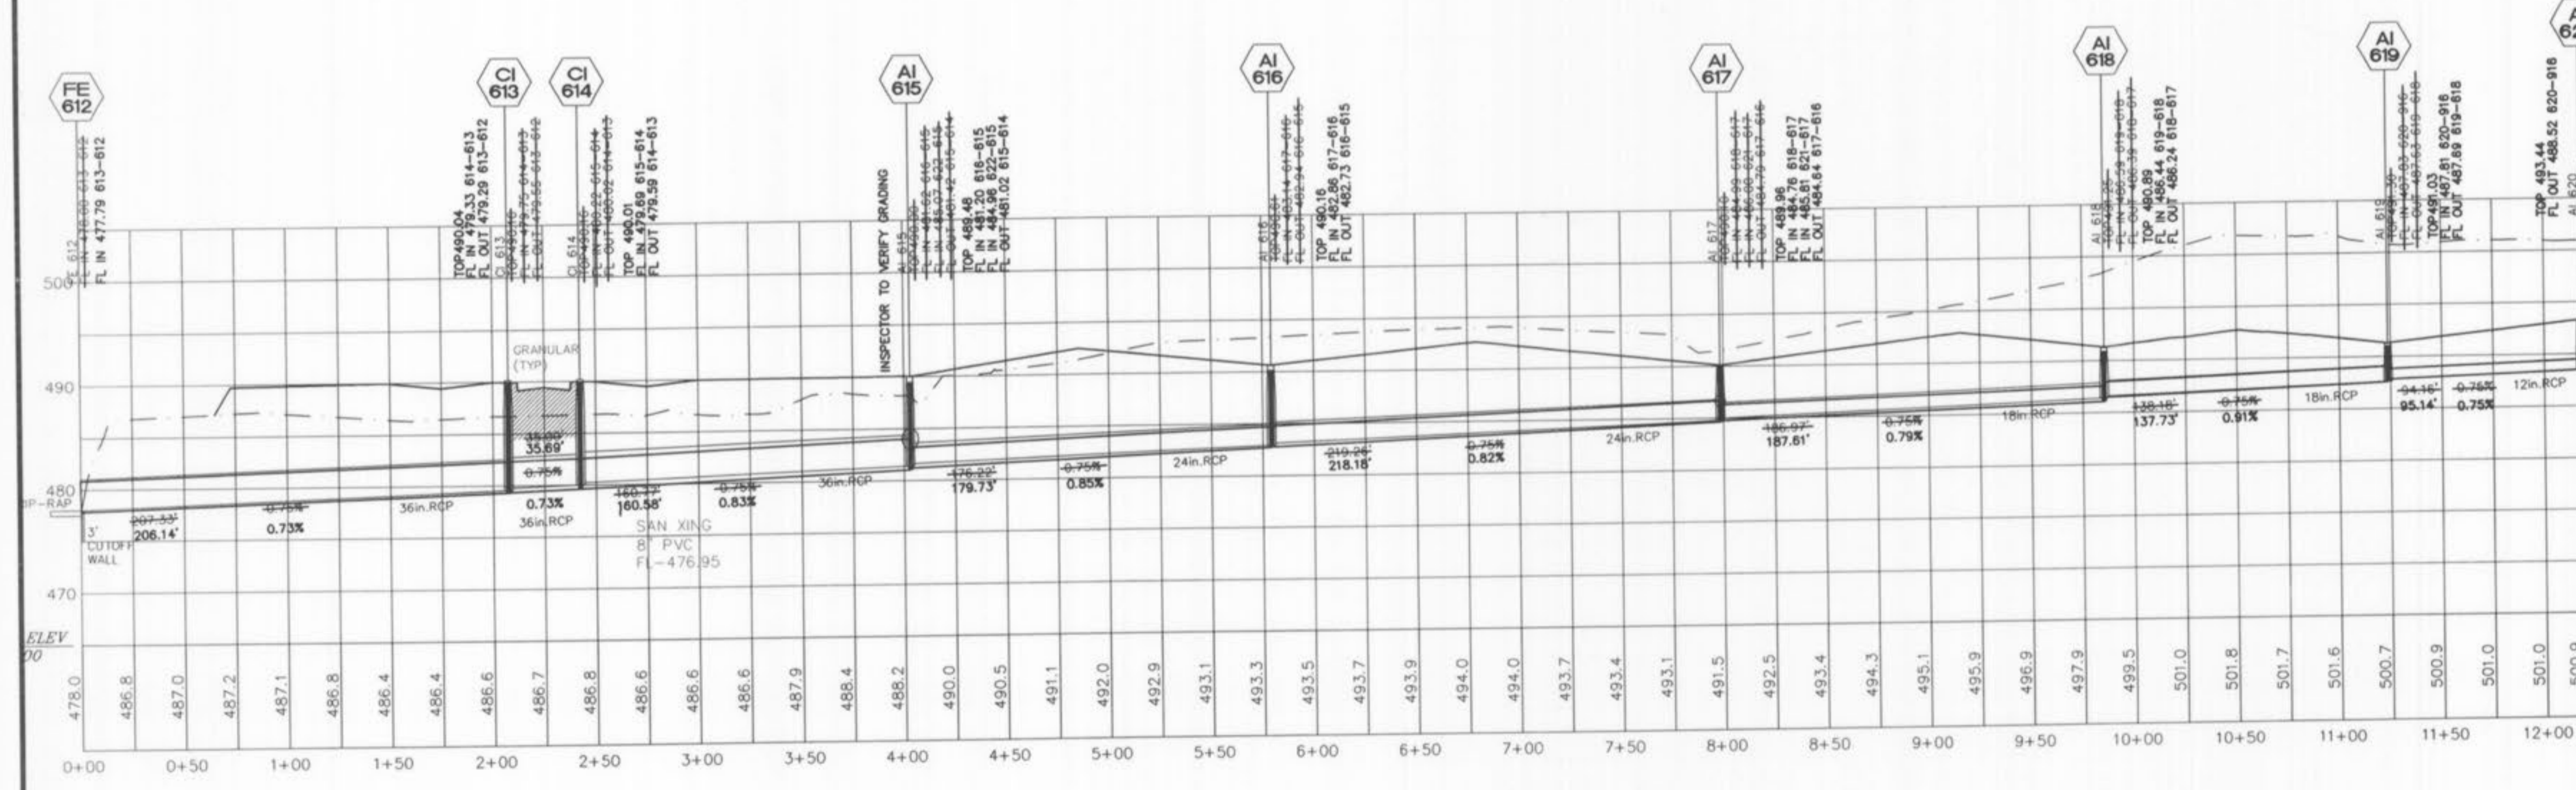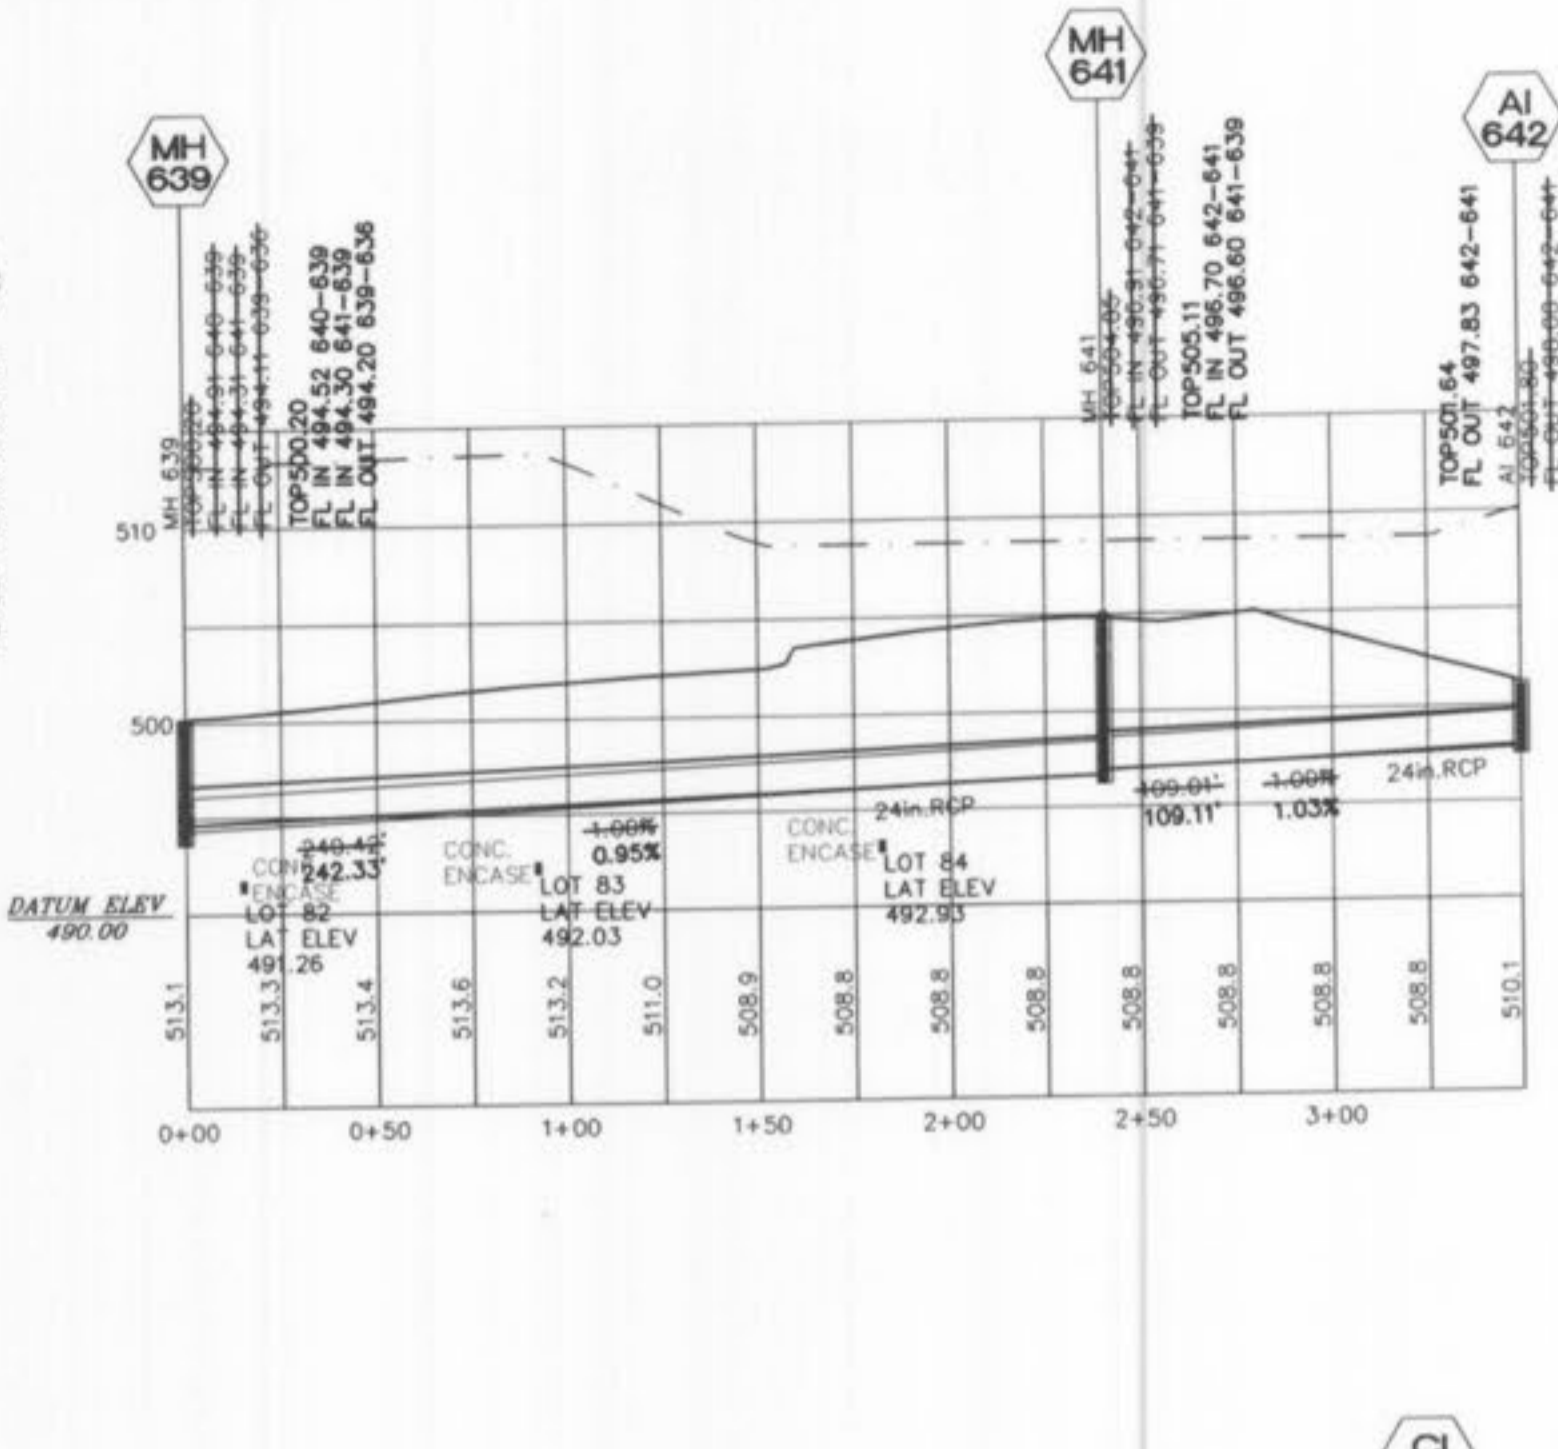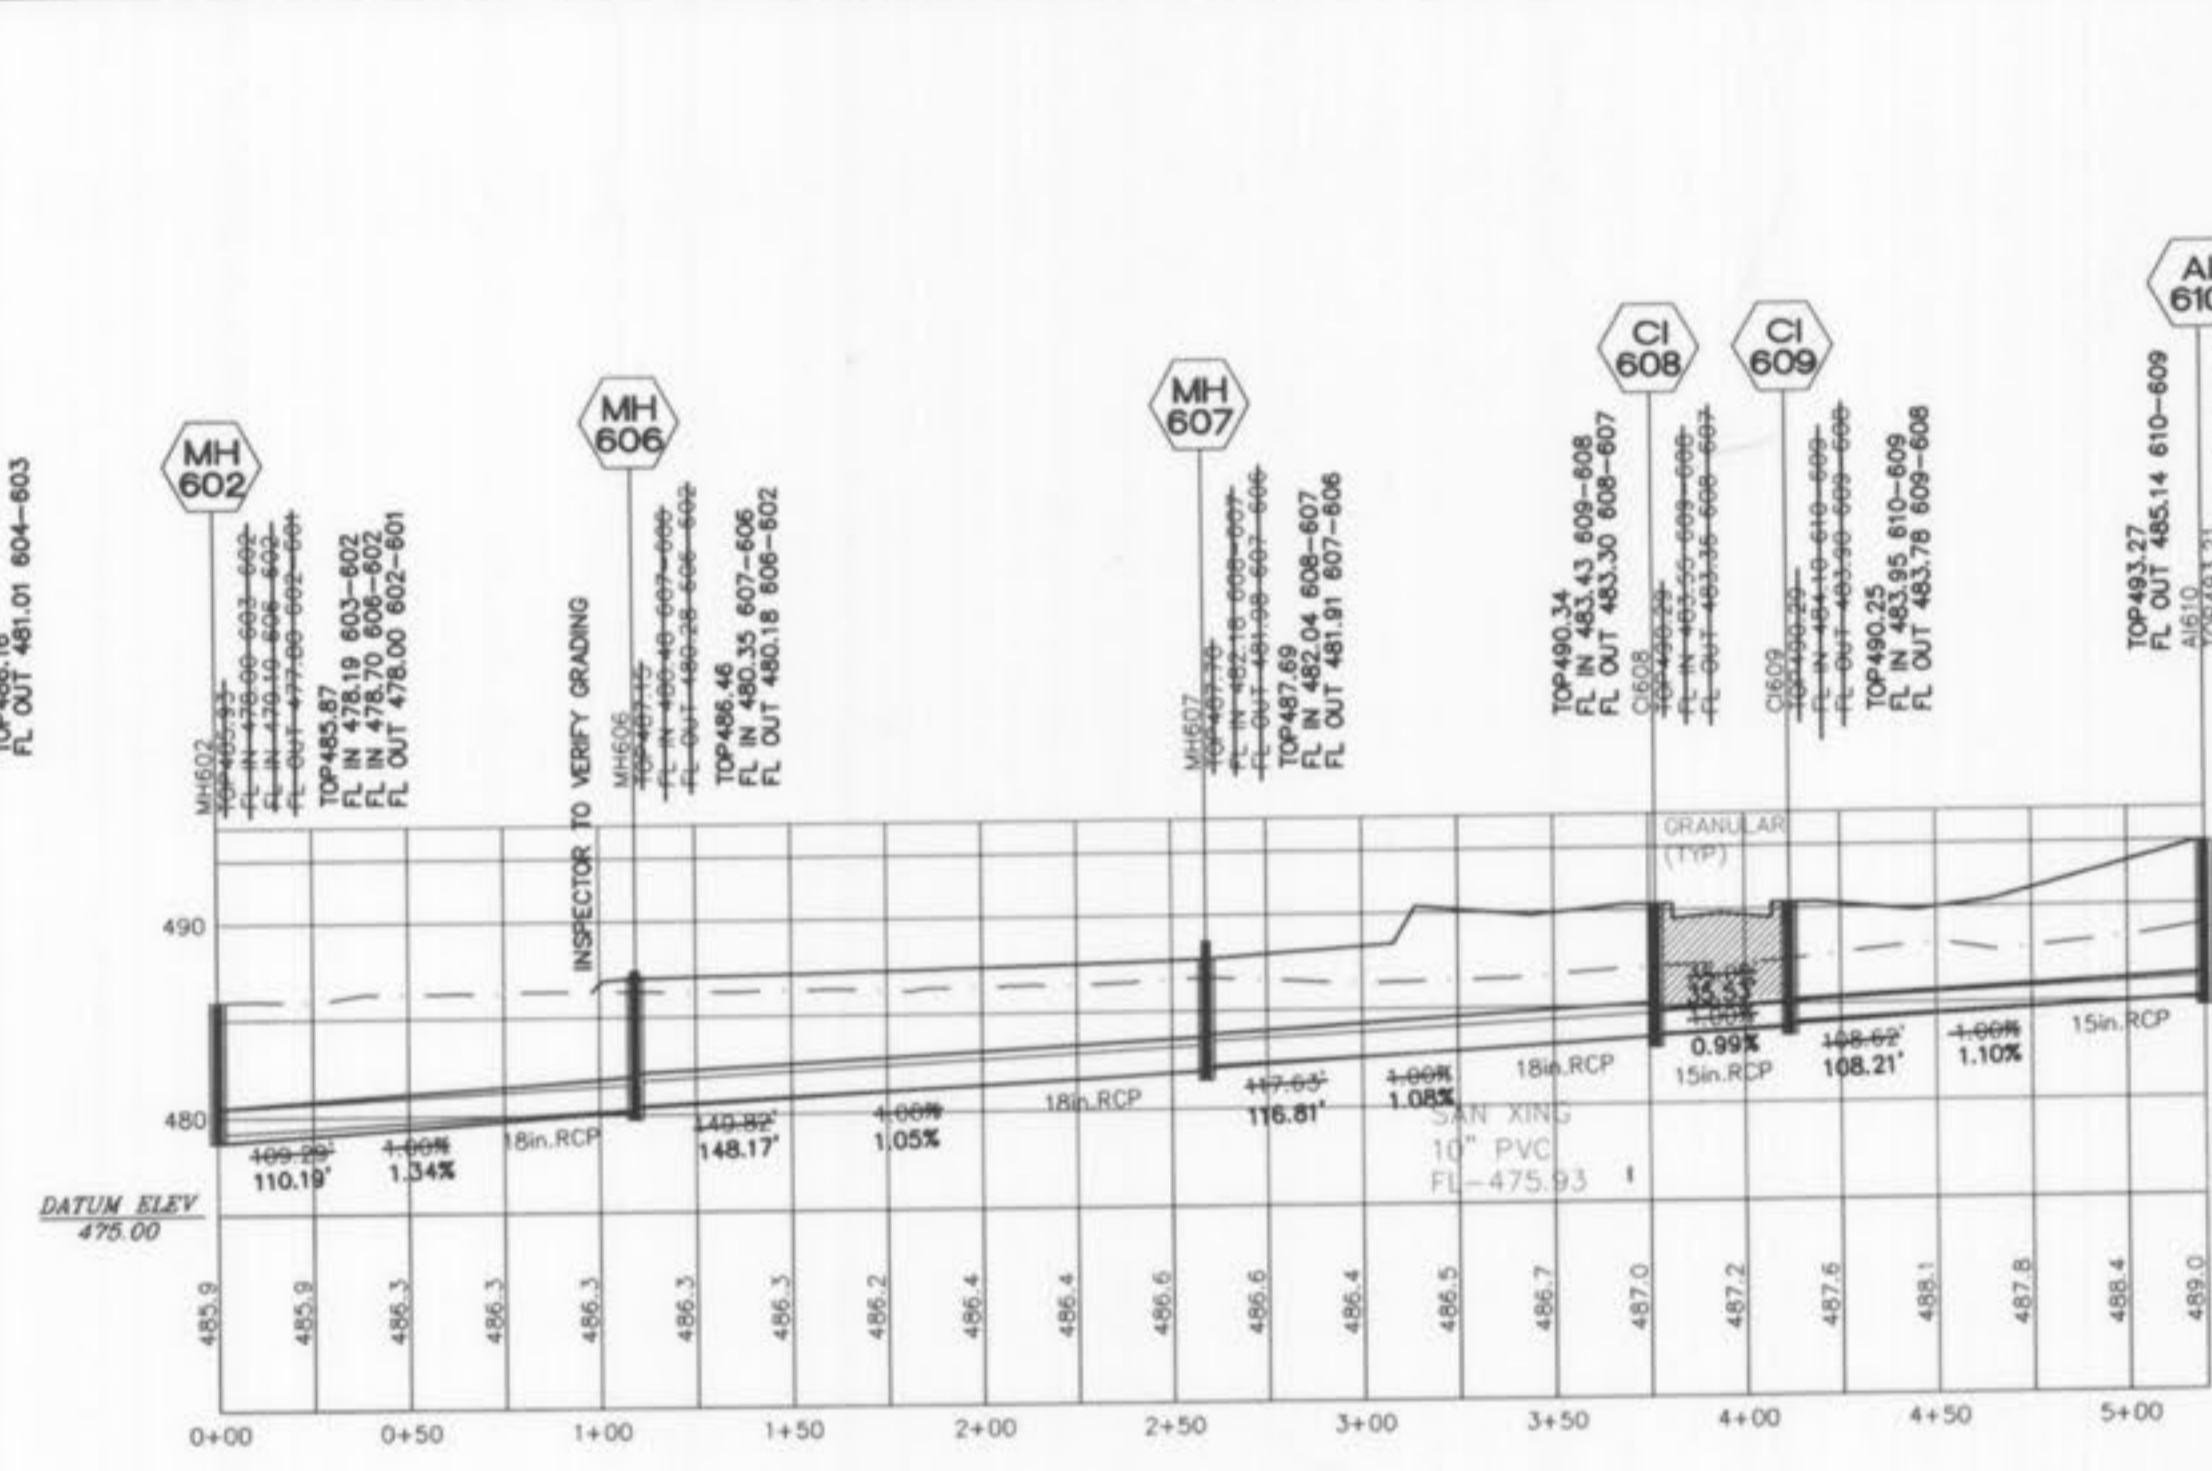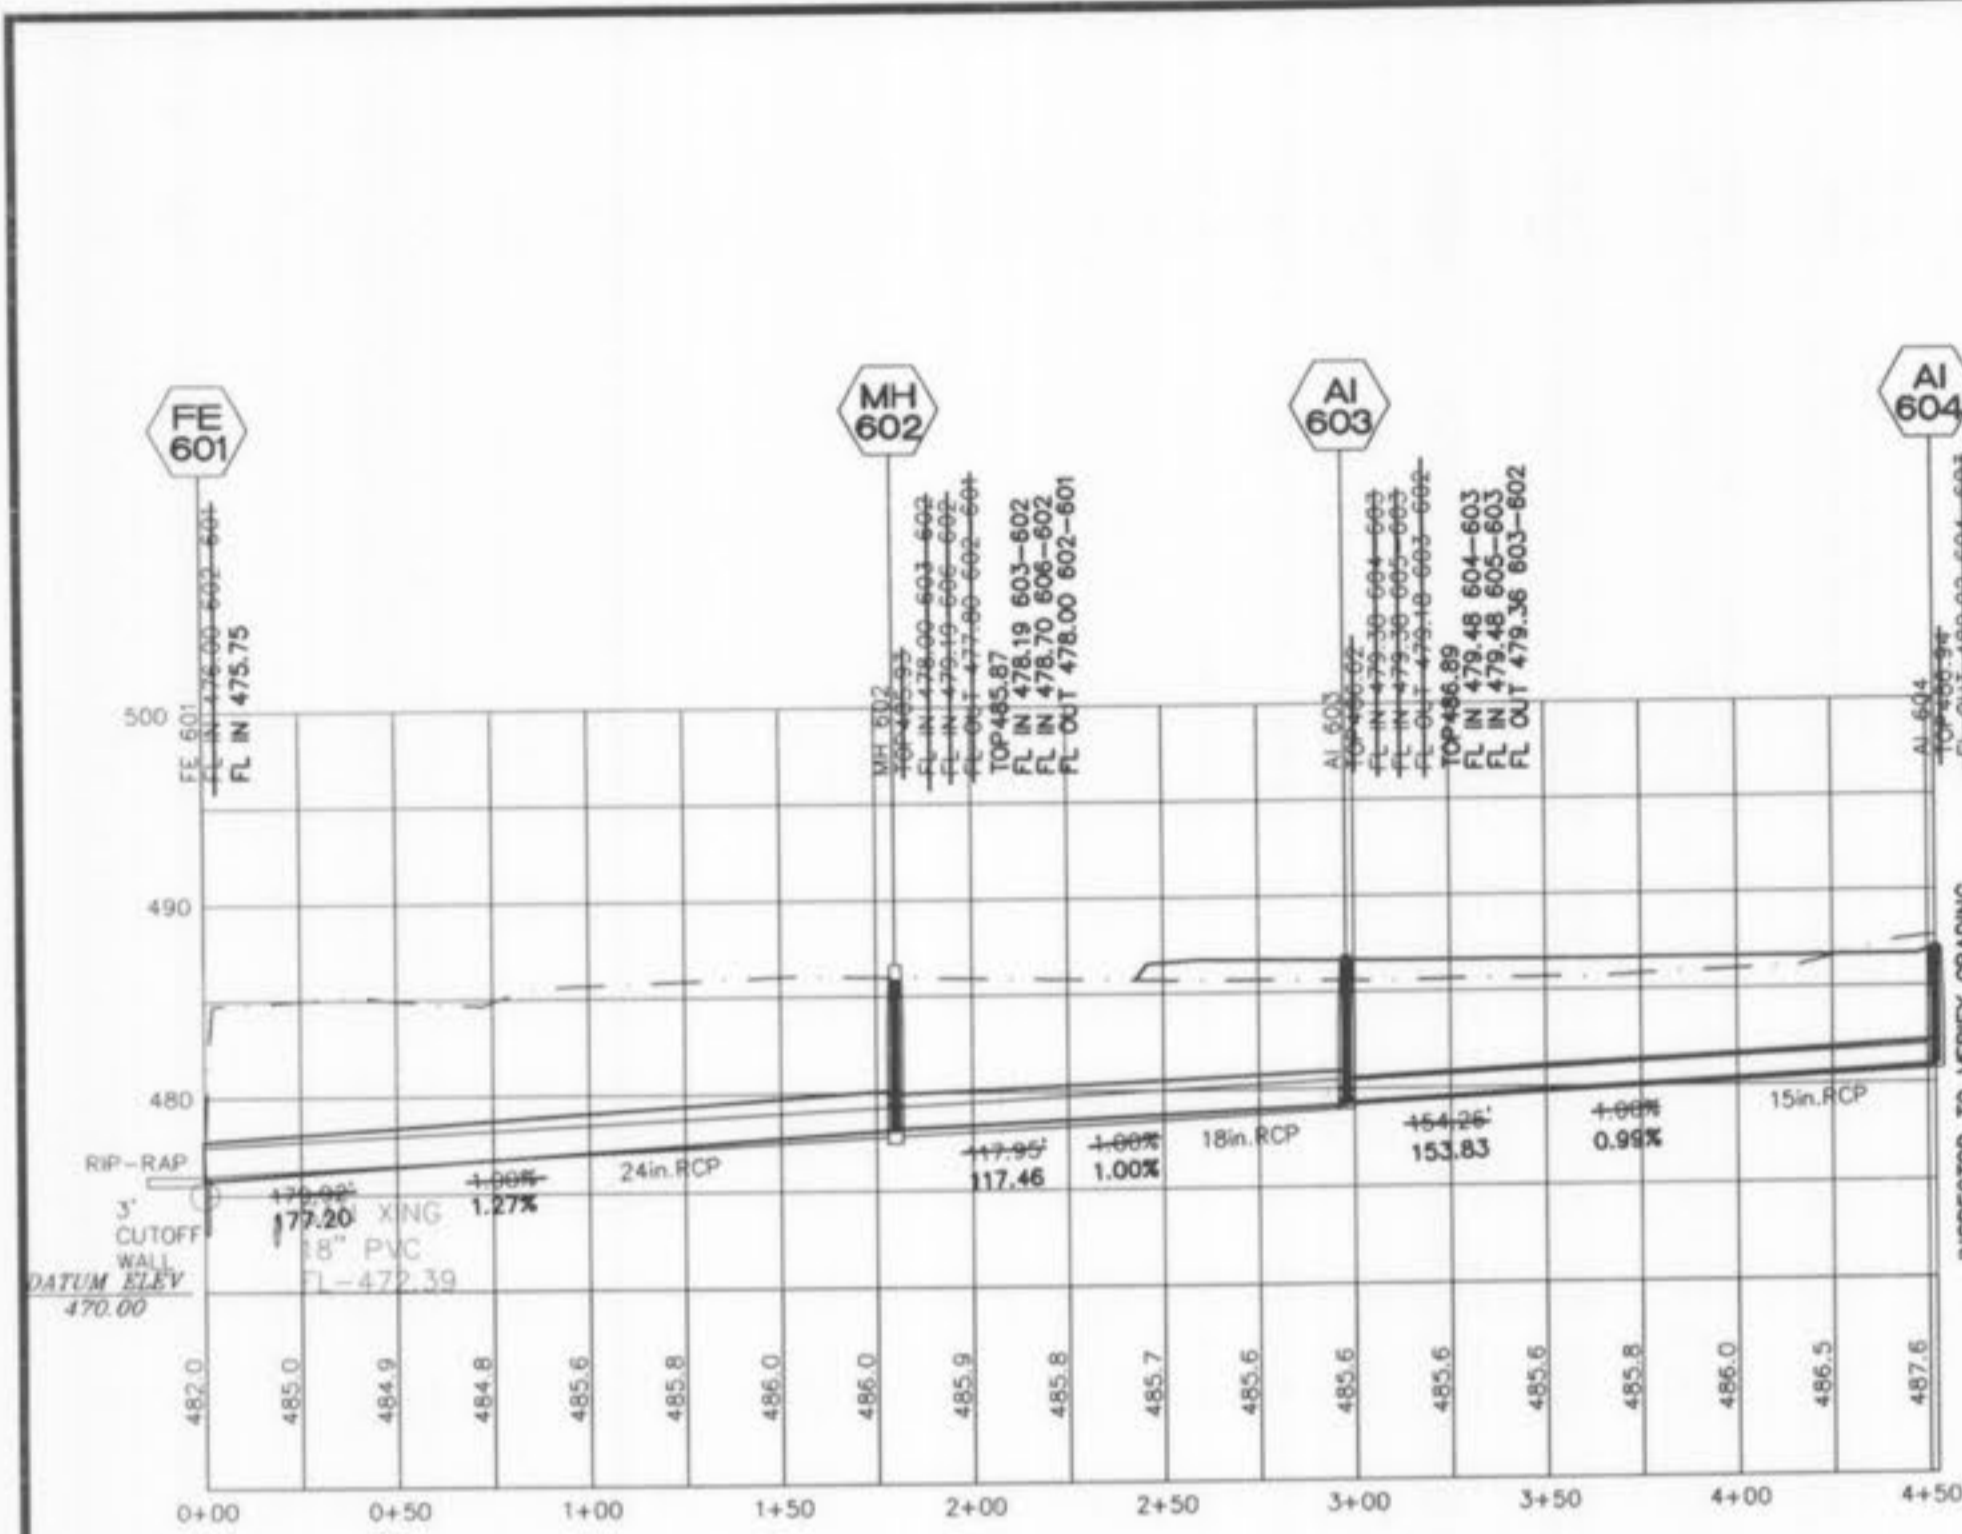

All sanitary lateral street crossings, if trenched, shall be backfilled with granular material (aggregate).

Storm sewer pipes that cross over existing or proposed sanitary sewer trenches shall be cradled in concrete through the full width of the sanitary sewer trench. The trench shall be backfilled and compacted with granular fill to the bottom of the concrete cradle.

If the storm and sanitary sewer are parallel and in the same trench or overdig, the upper pipe shall be placed on a shelf and the lower pipe shall be bedded in compacted granular fill to the flow line of the upper pipe.

Rock backfill all storm and sanitary sewers that lie within the 1:1 shear plane of the road.

VERT. 1"=10'
HORIZ. 1"=50'
SCALE:

REVISED PER CITY COMMENTS
3/12/07



**STROM PROFILES
AS-BUILTS
HIDDEN CREEK
PHASE II**

ST. CHARLES ENGINEERING & SURVEYING, INC.
801 S. FIFTH STREET, SUITE 202
ST. CHARLES, MO 63301
TEL: (636) 947-0607 FAX: (636) 947-2448








11/15/07
ORDER NO.
02-0162-01
DATE
06/03/06

AB2-11

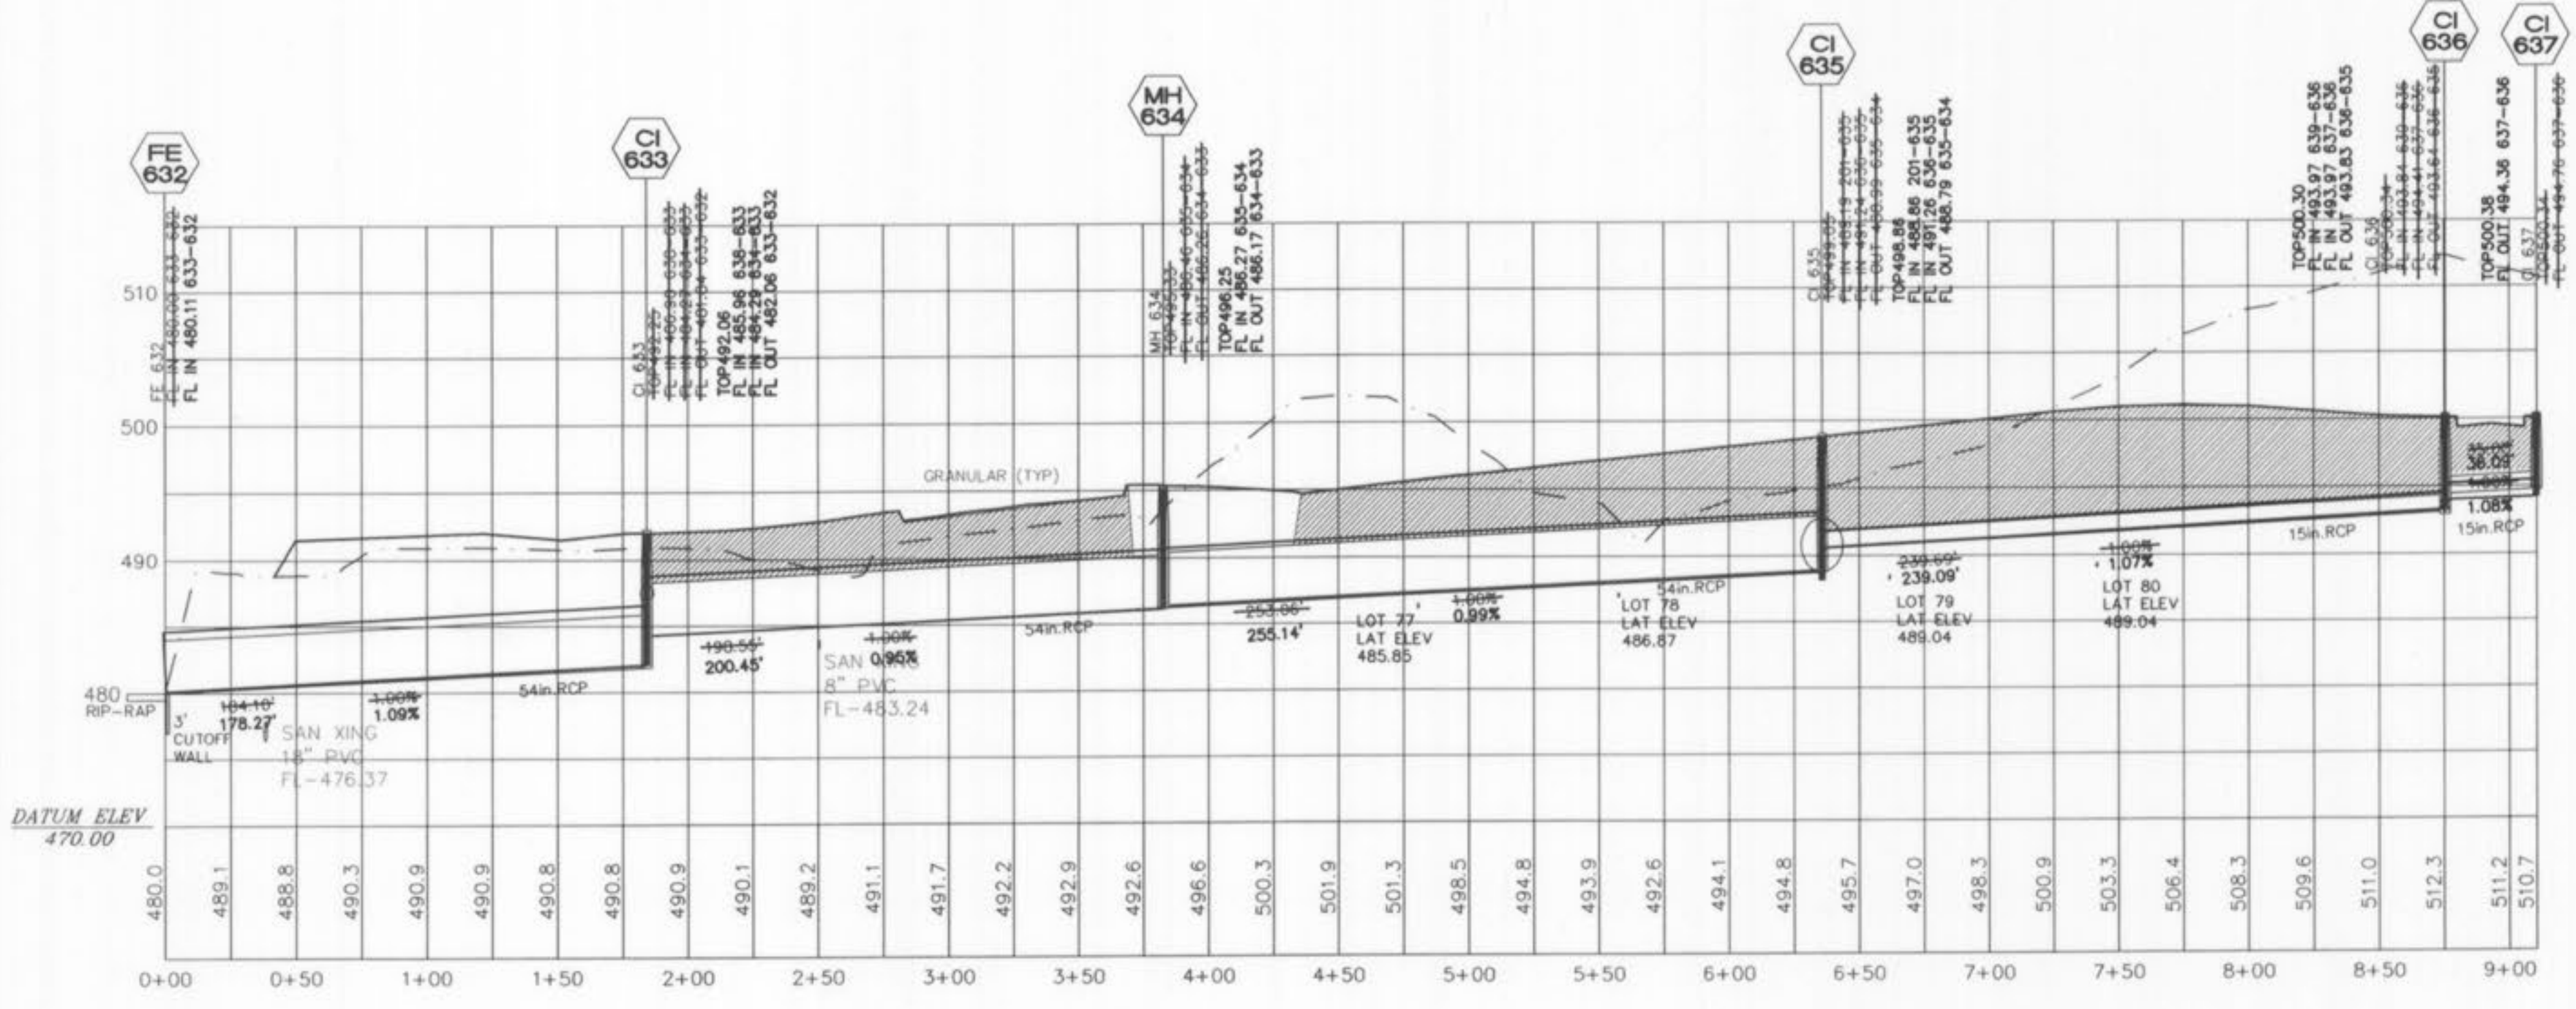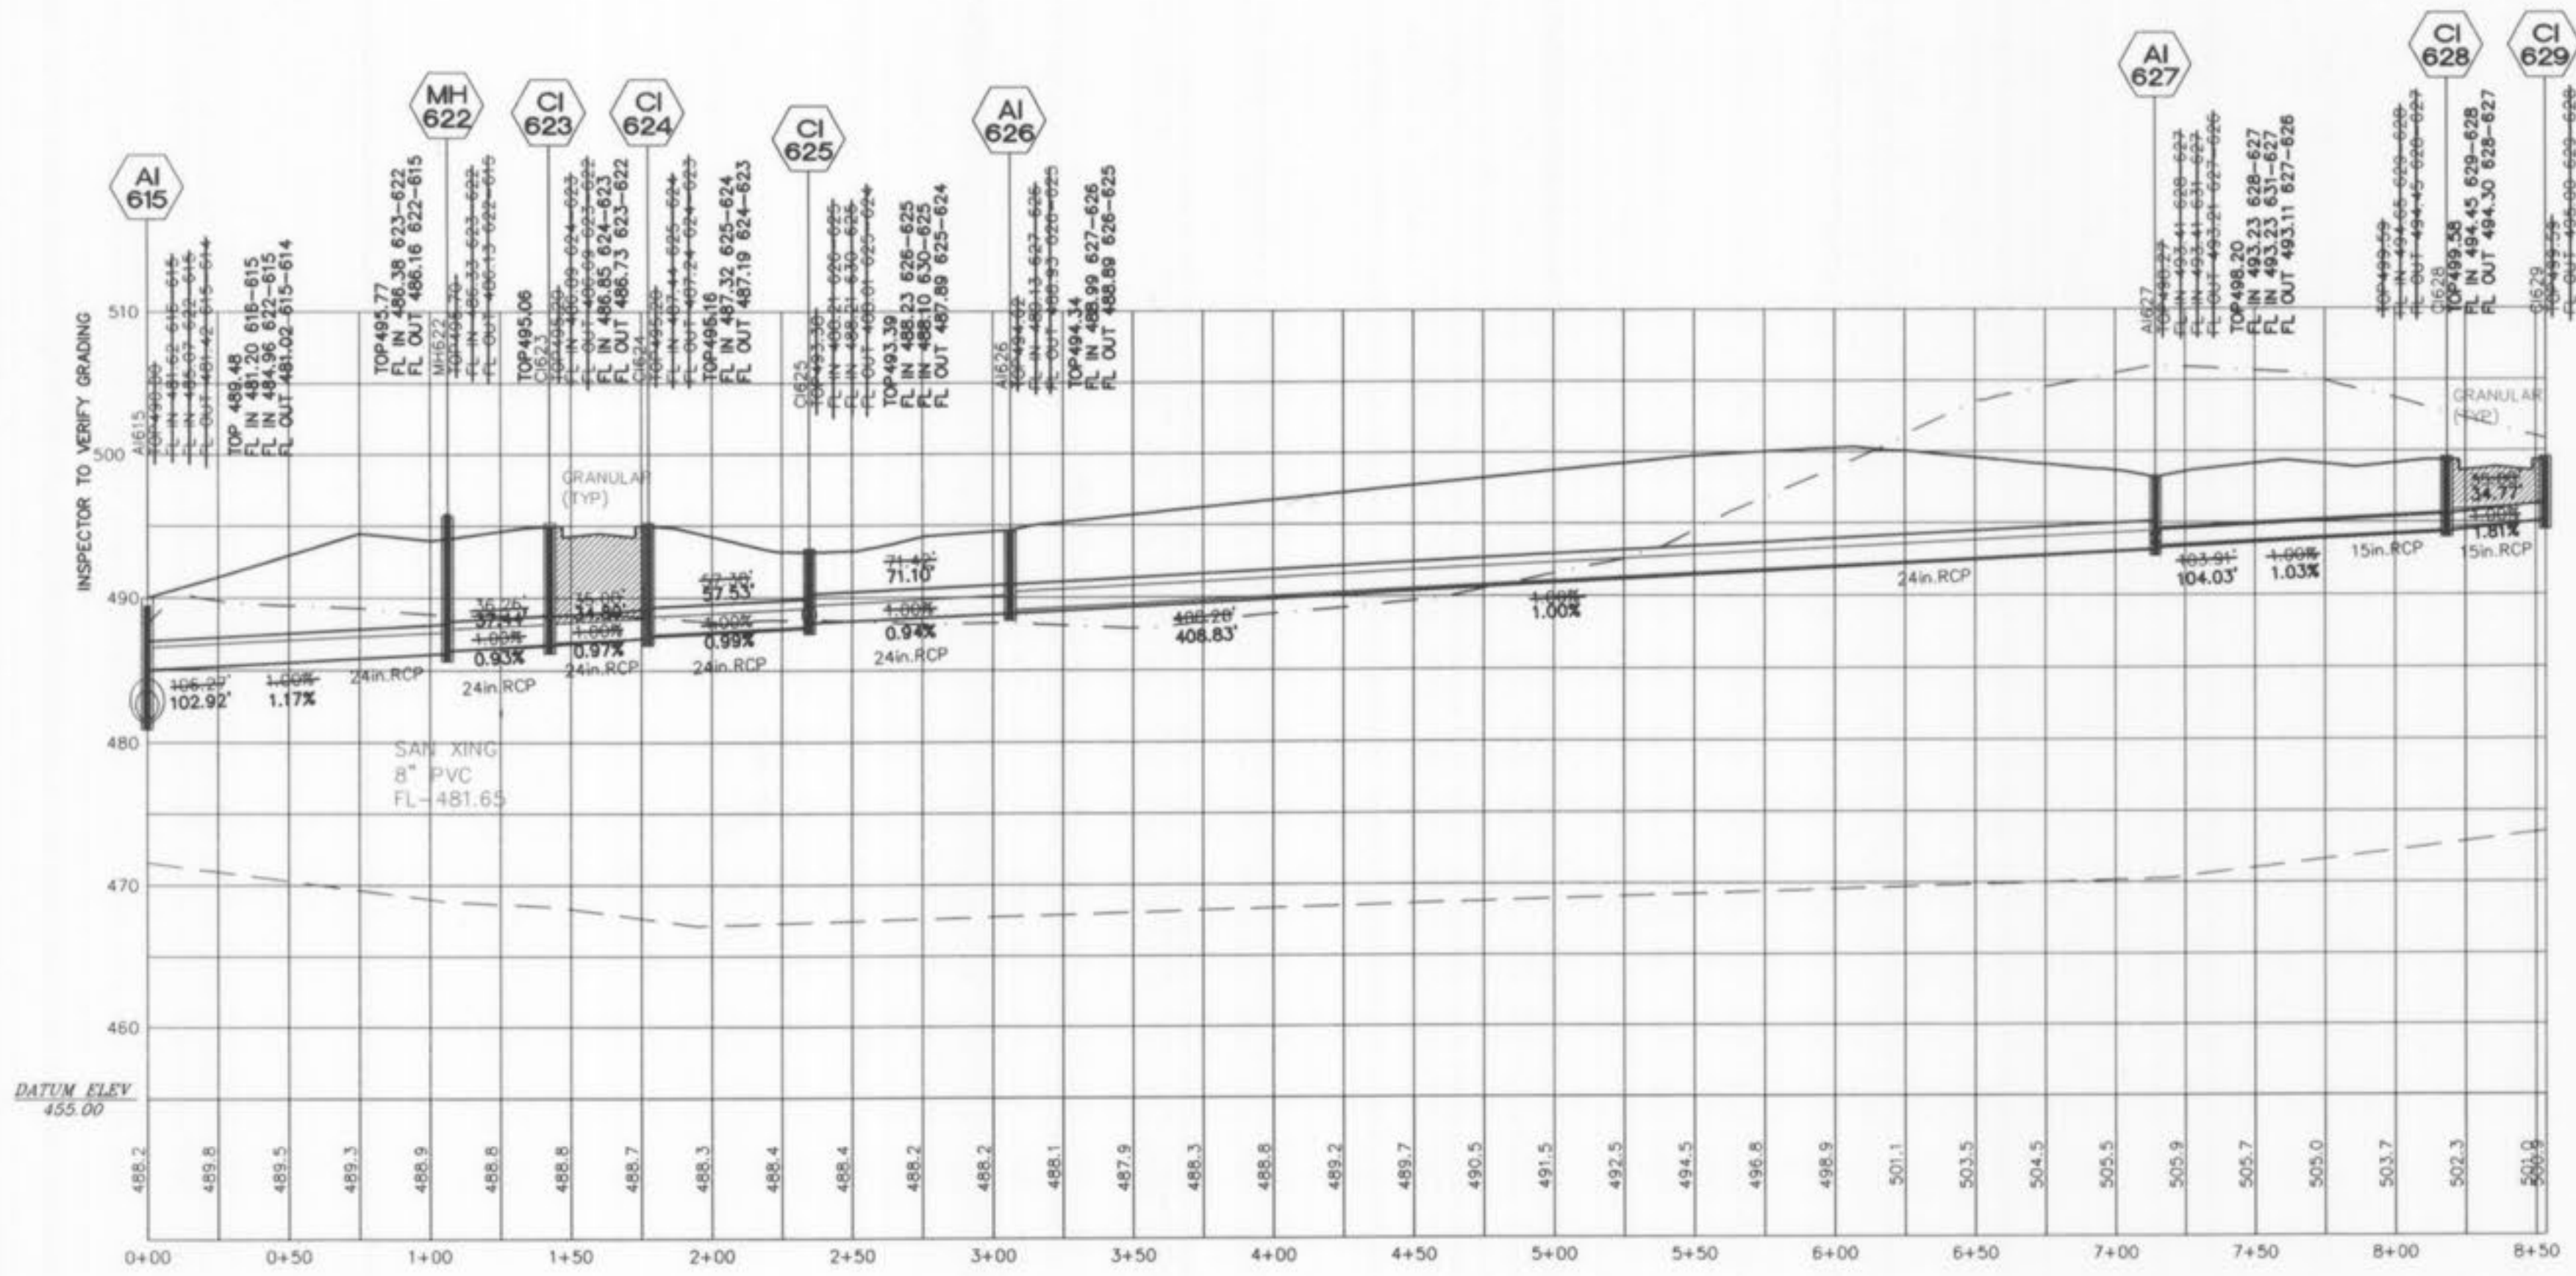

VERT. 1"=10'
HORIZ. 1"=50'
SCALE:

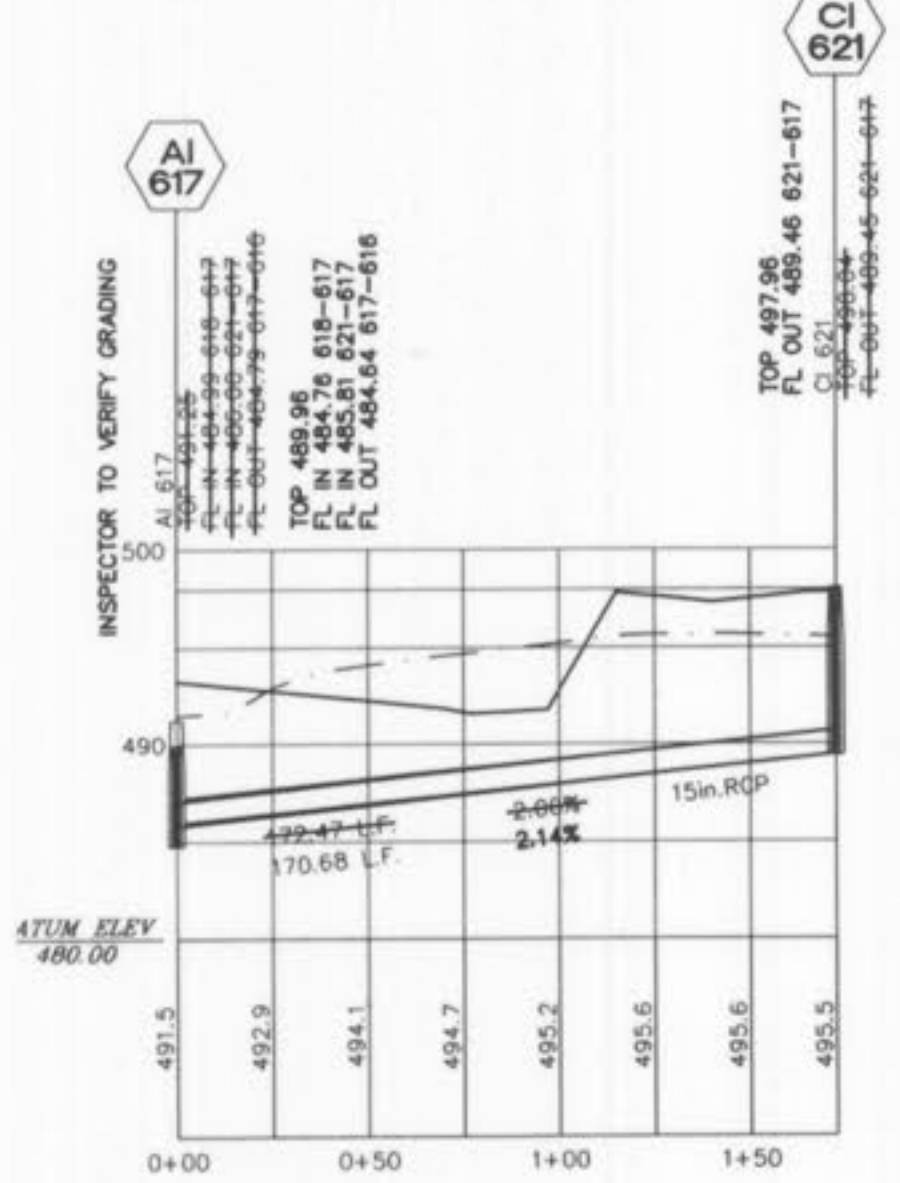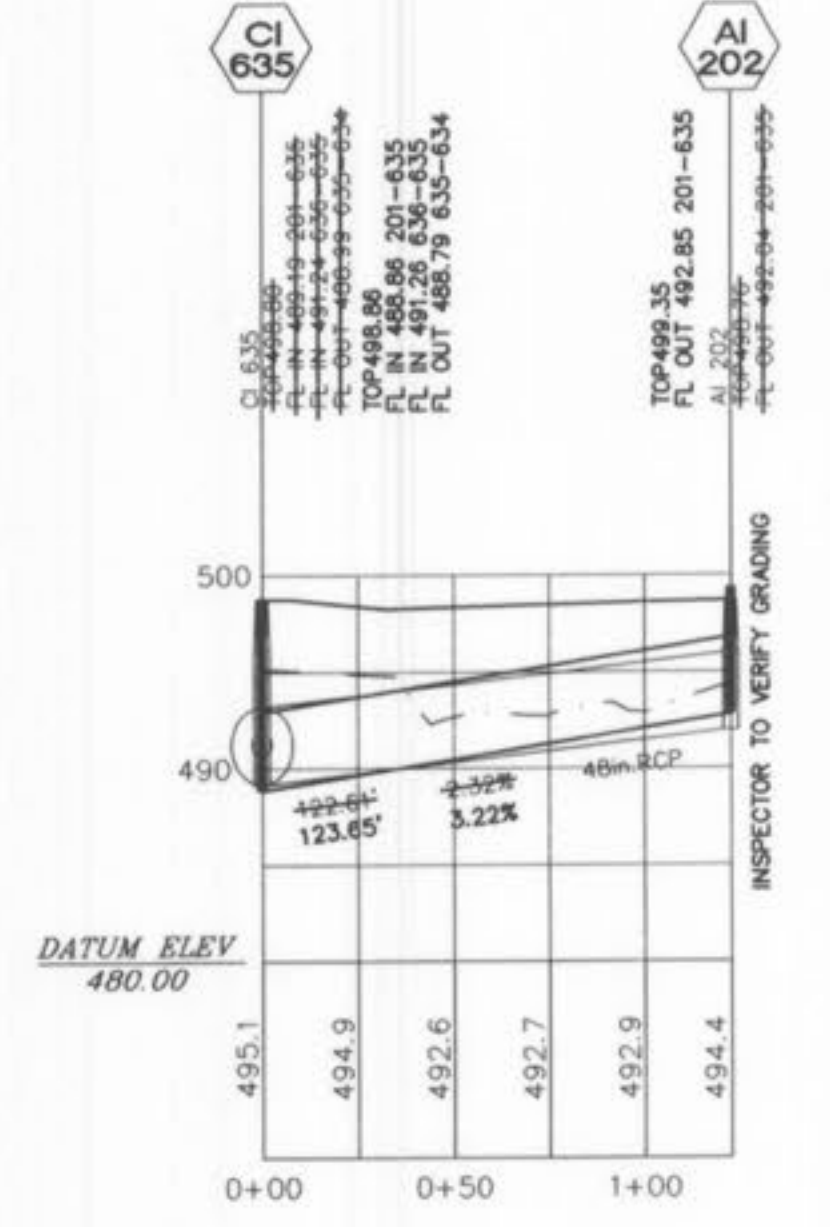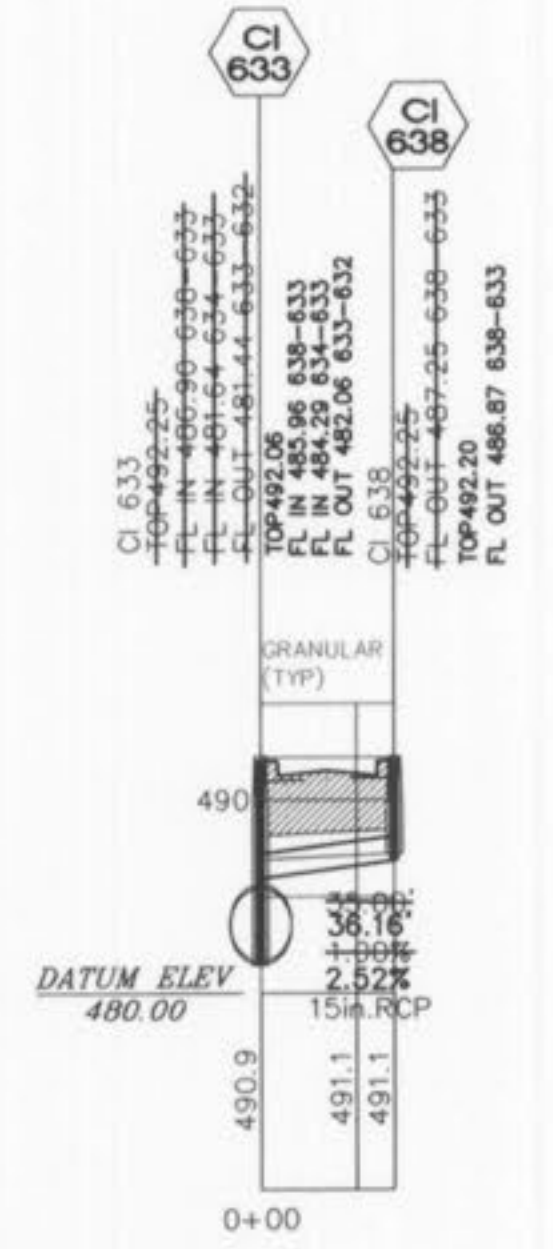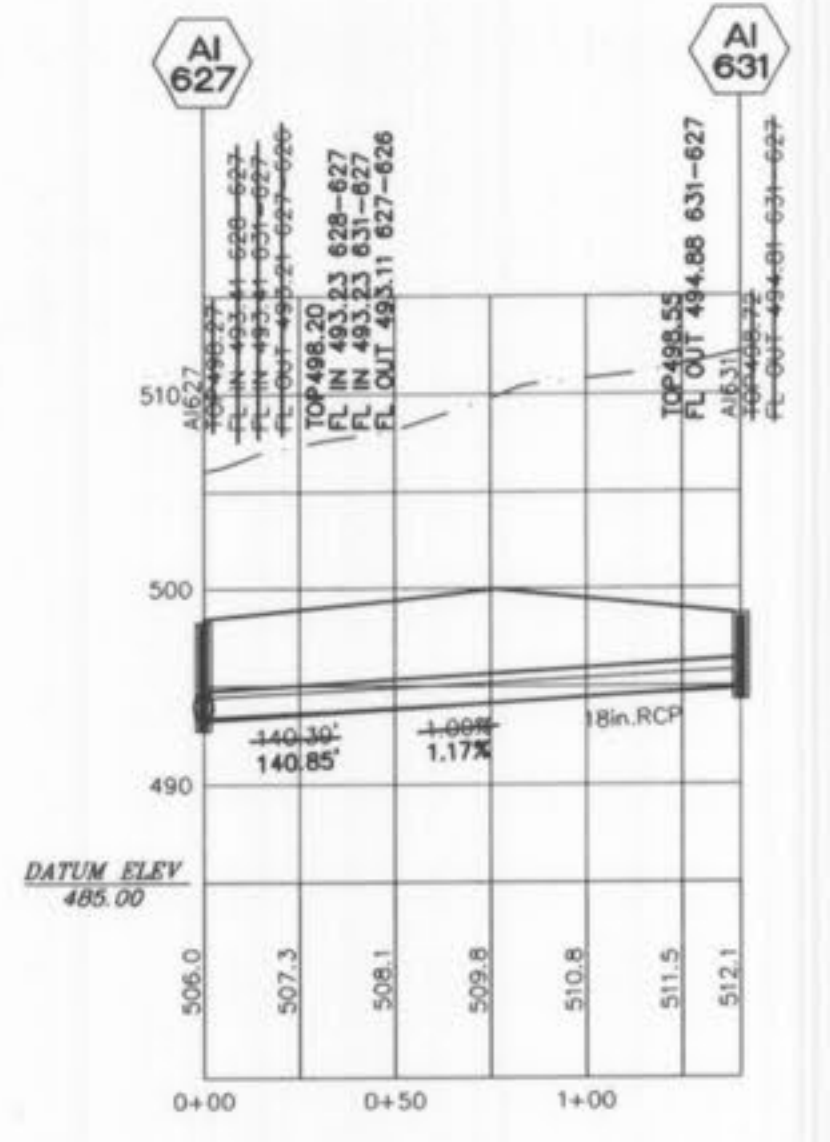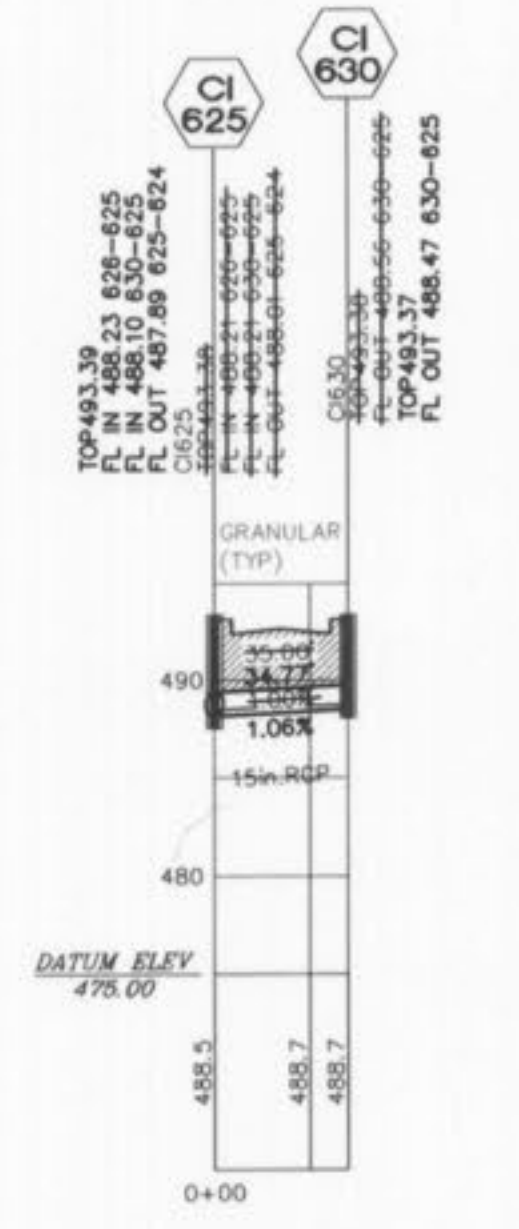

All sanitary lateral street crossings, if trenched, shall be backfilled with granular material (aggregate).

Storm sewer pipes that cross over existing or proposed sanitary sewer trenches shall be cradled in concrete through the full width of the sanitary sewer trench. The trench shall be backfilled and compacted with granular fill to the bottom of the concrete cradle.

If the storm and sanitary sewer are parallel and in the same trench or overdig, the upper pipe shall be placed on a shelf and the lower pipe shall be bedded in compacted granular fill to the flow line of the upper pipe.

Rock backfill all storm and sanitary sewers that lie within the 1:1 shear plane of the road.

**STORM PROFILES
AS-BUILTS
HIDDEN CREEK
PHASE 2**

ST. CHARLES ENGINEERING & SURVEYING, INC.
801 S. FIFTH STREET, SUITE 202
ST. CHARLES, MO 63301
TEL: (636) 947-0607 FAX: (636) 947-2448



11/15/07
ORDER NO. 02-0162-01
DATE 05/03/05
AB2-12

3/12/07
REVISED PER CITY COMMENTS