


HIDDEN CREEK
PHASE 1
SANITARY/STORM SEWER
AS-BUILTS




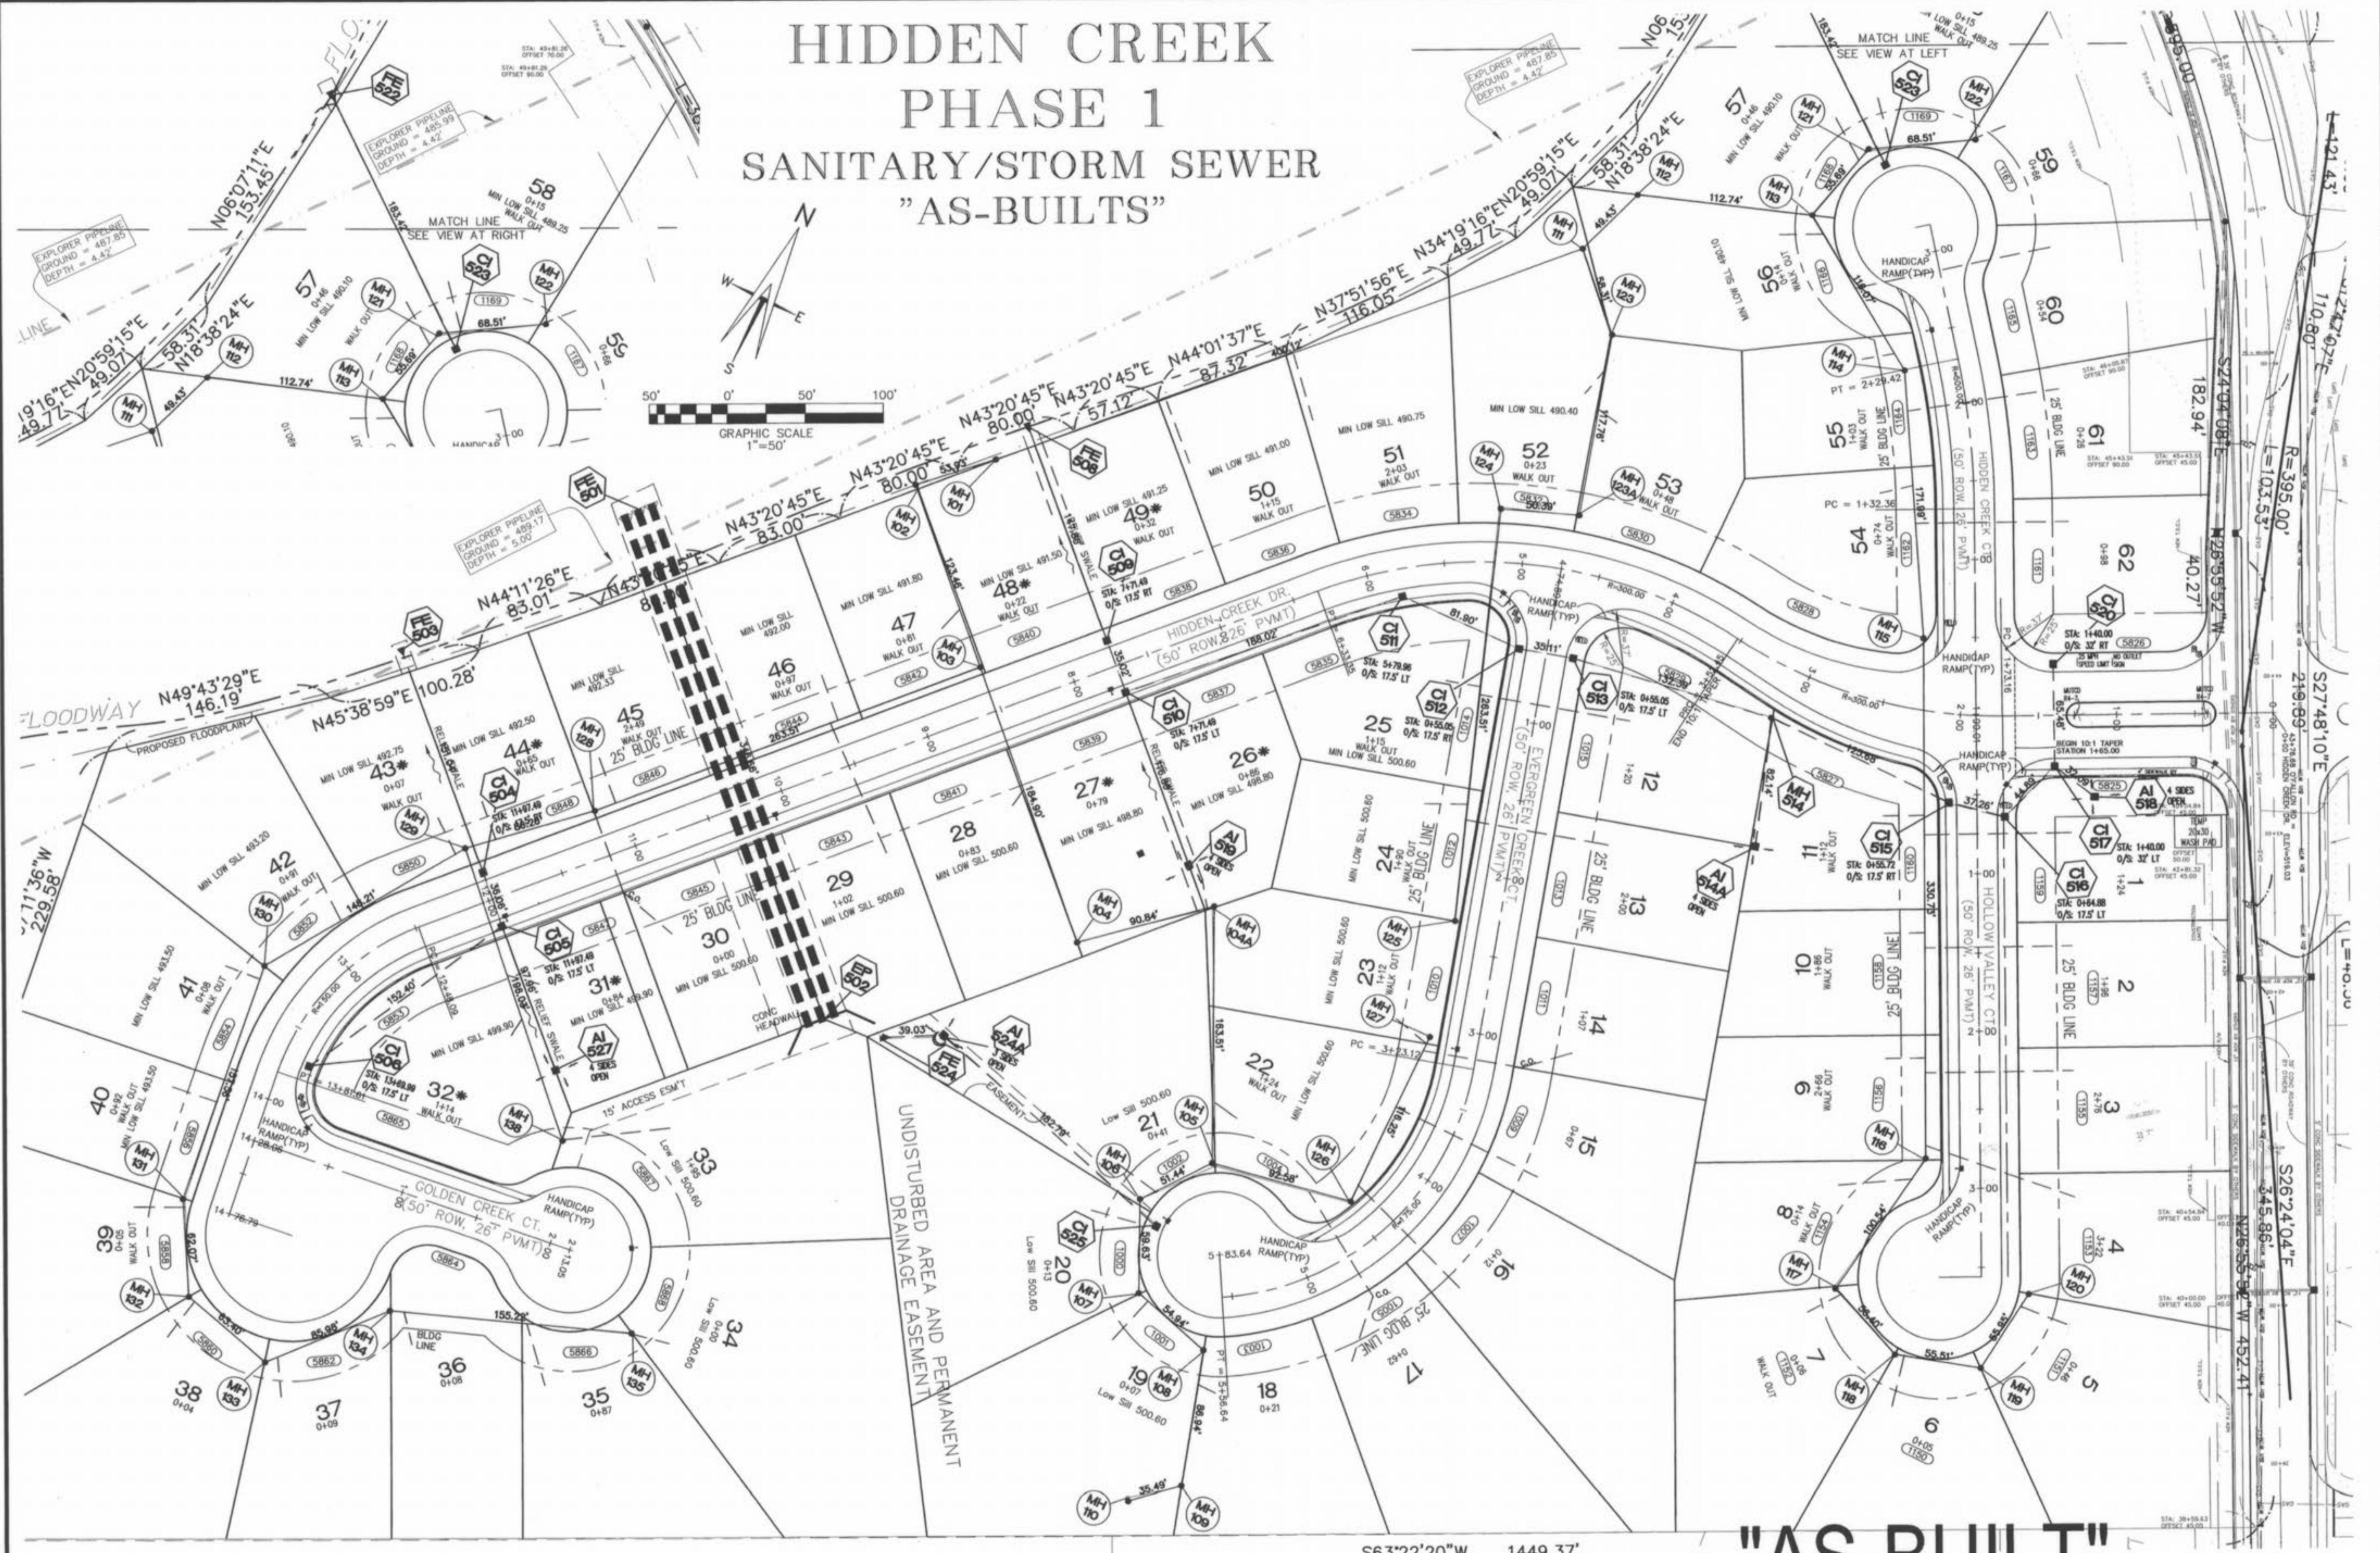


"AS-BUILT"



CHARLES ENGINEERING & SURVEYING, INC.
801 S. FIFTH STREET, SUITE 202
ST. CHARLES, MO 63301
TEL: (636) 947-0607 FAX: (636) 947-2448

HIDDEN CREEK PHASE 1 SANITARY SEWER "AS-BUILTS"

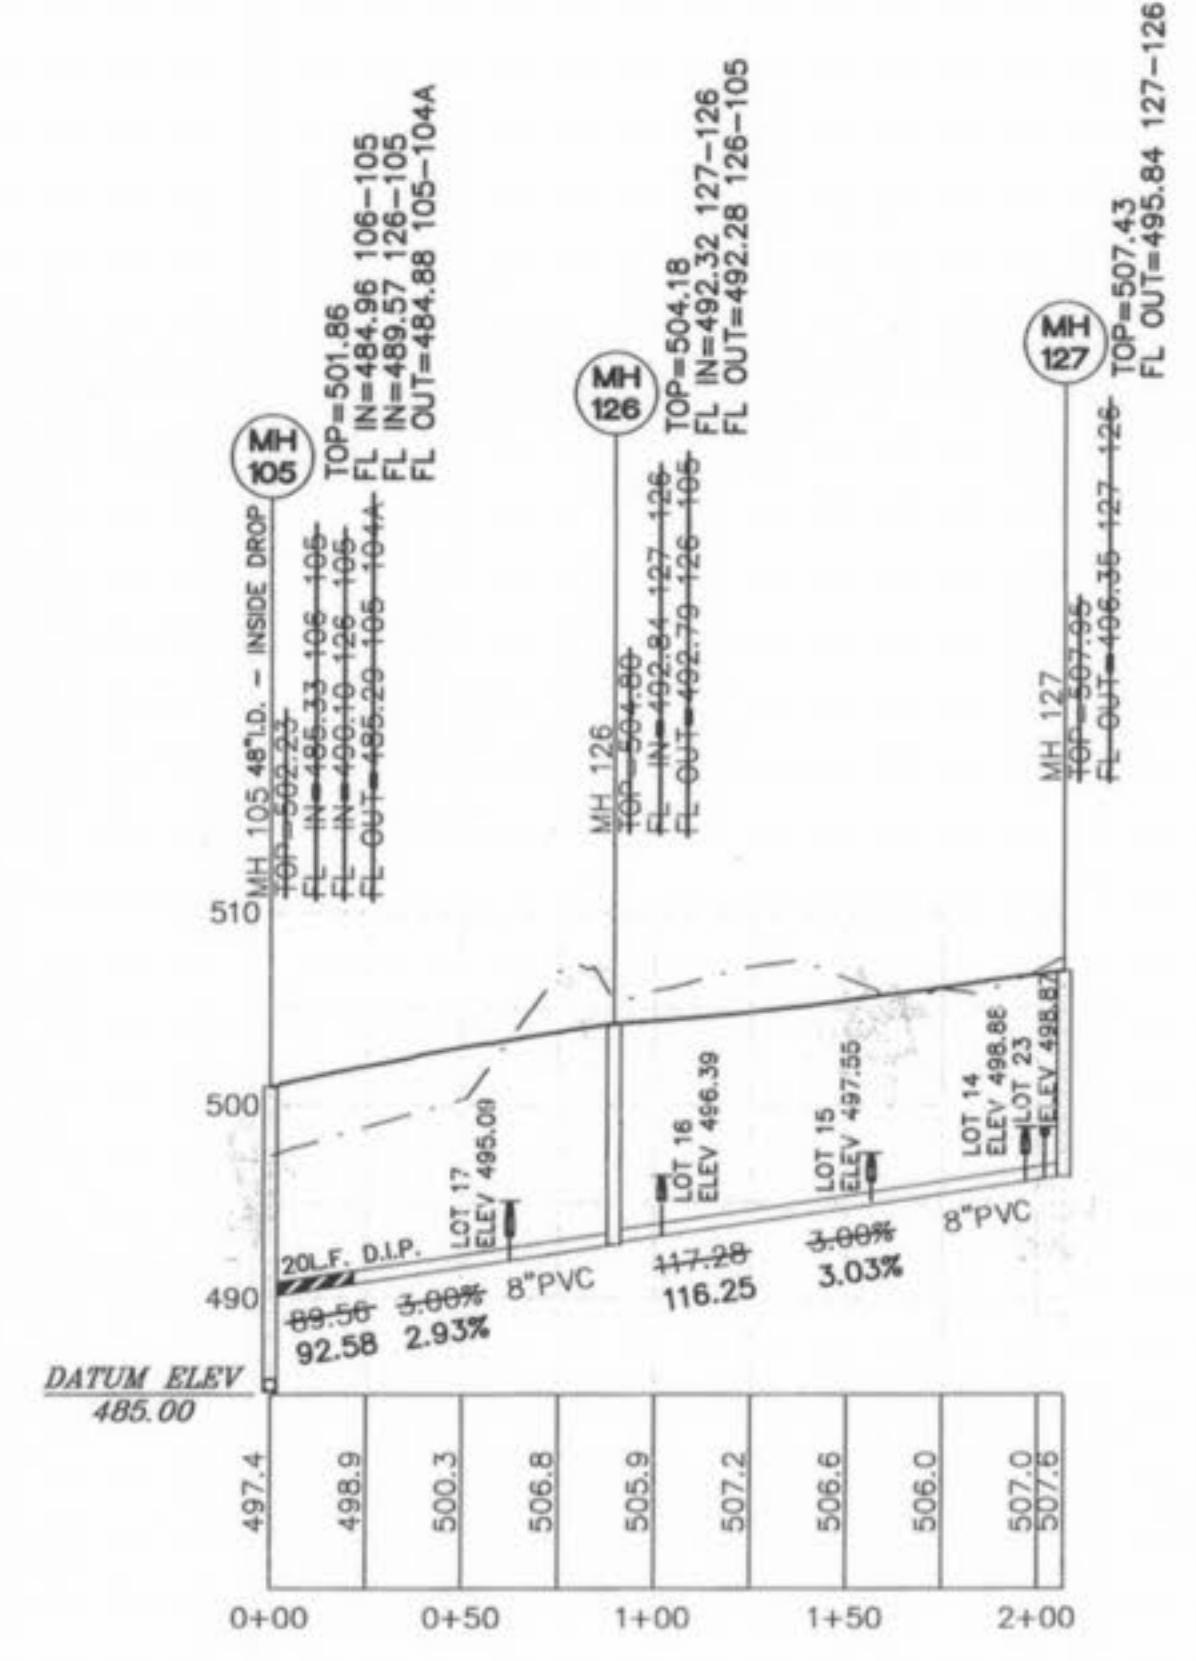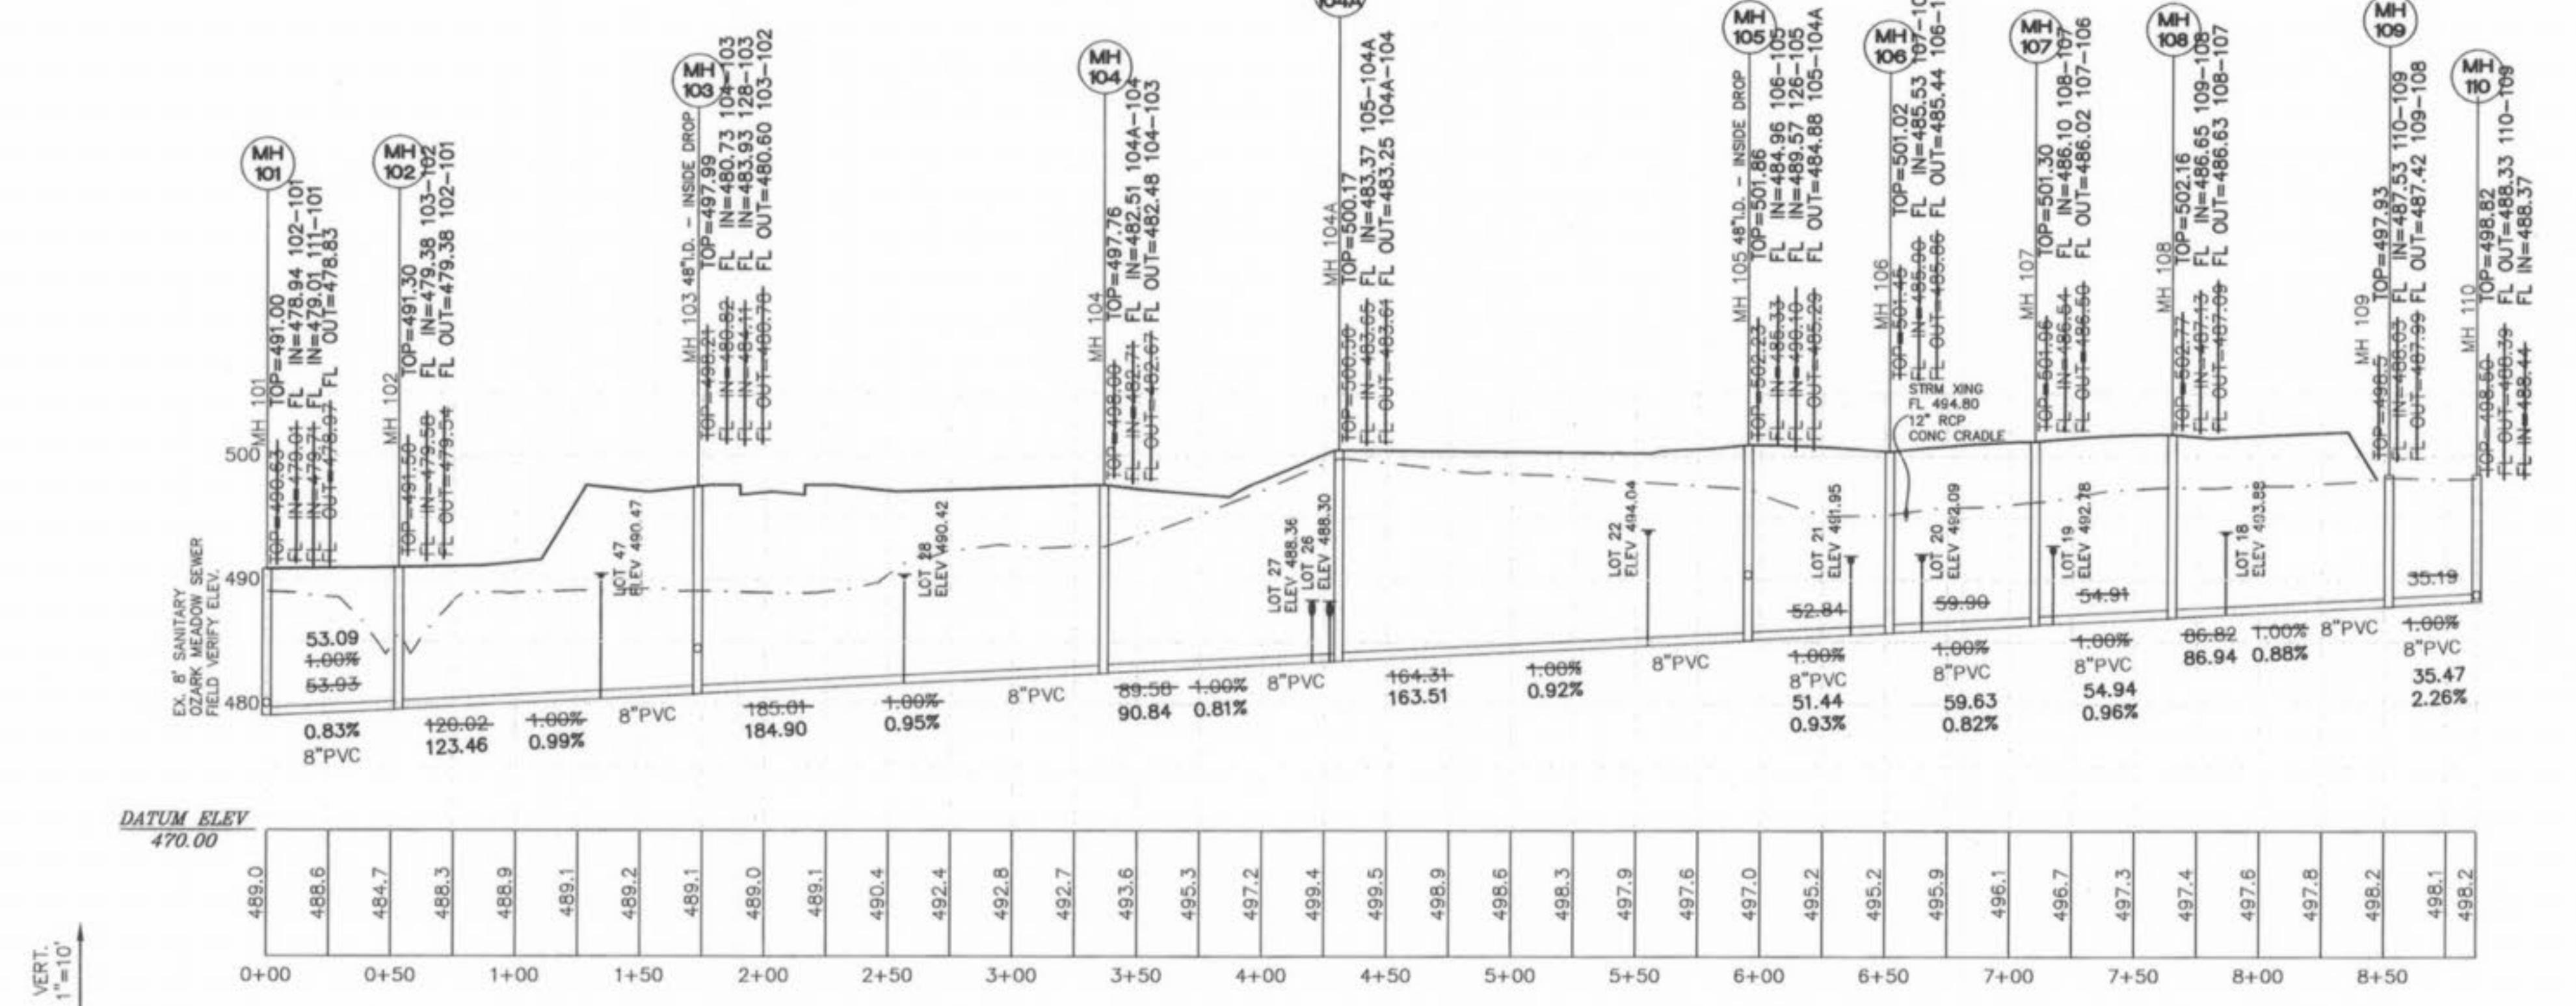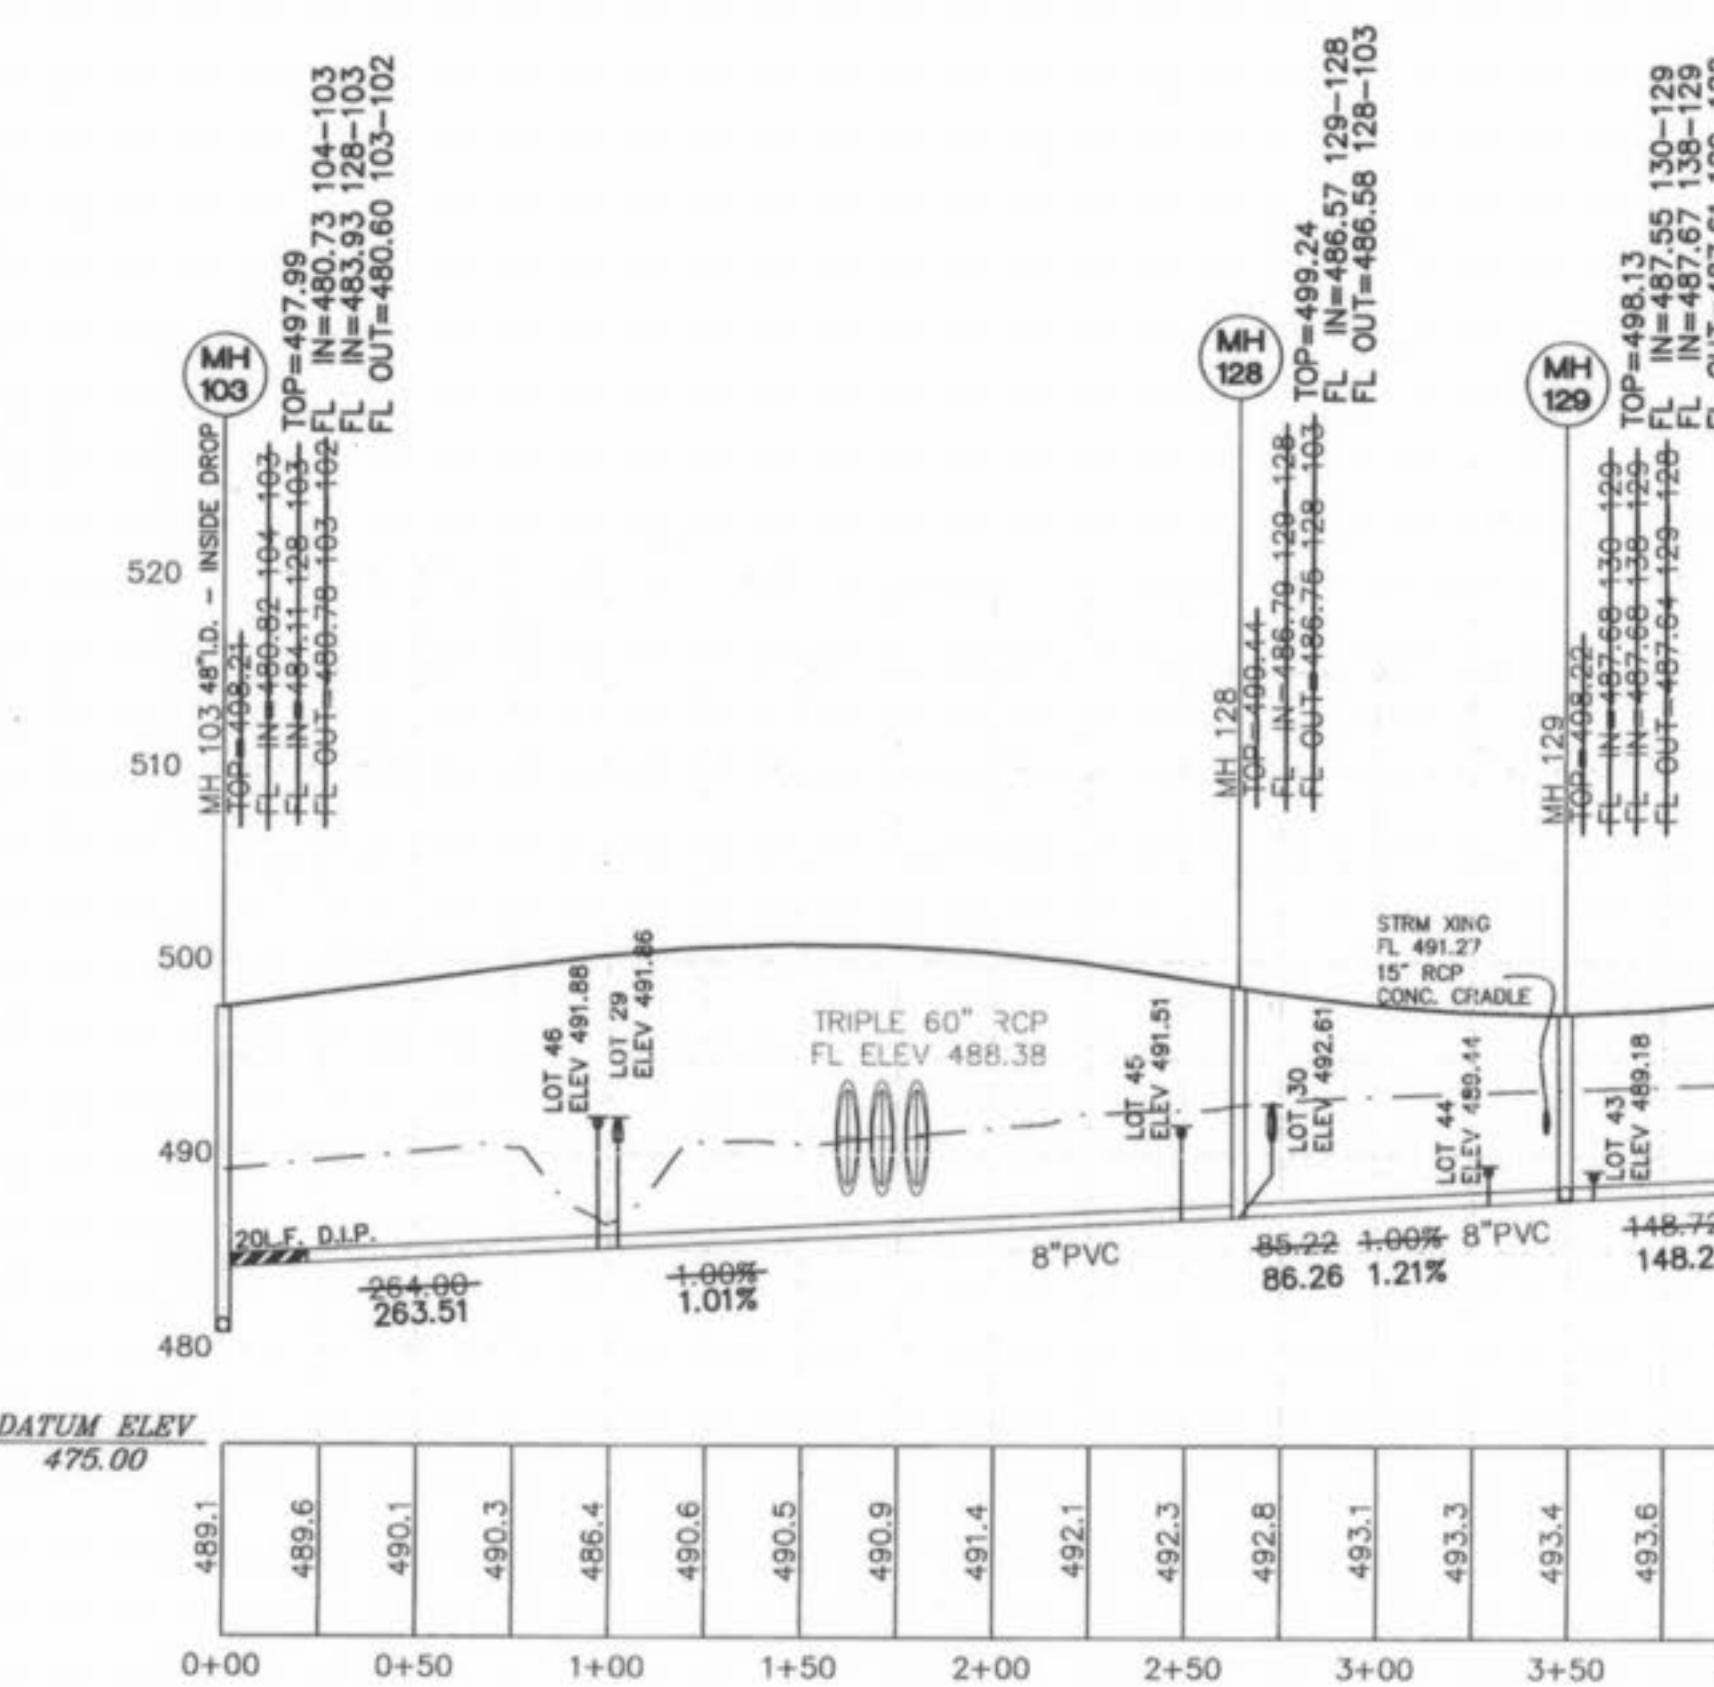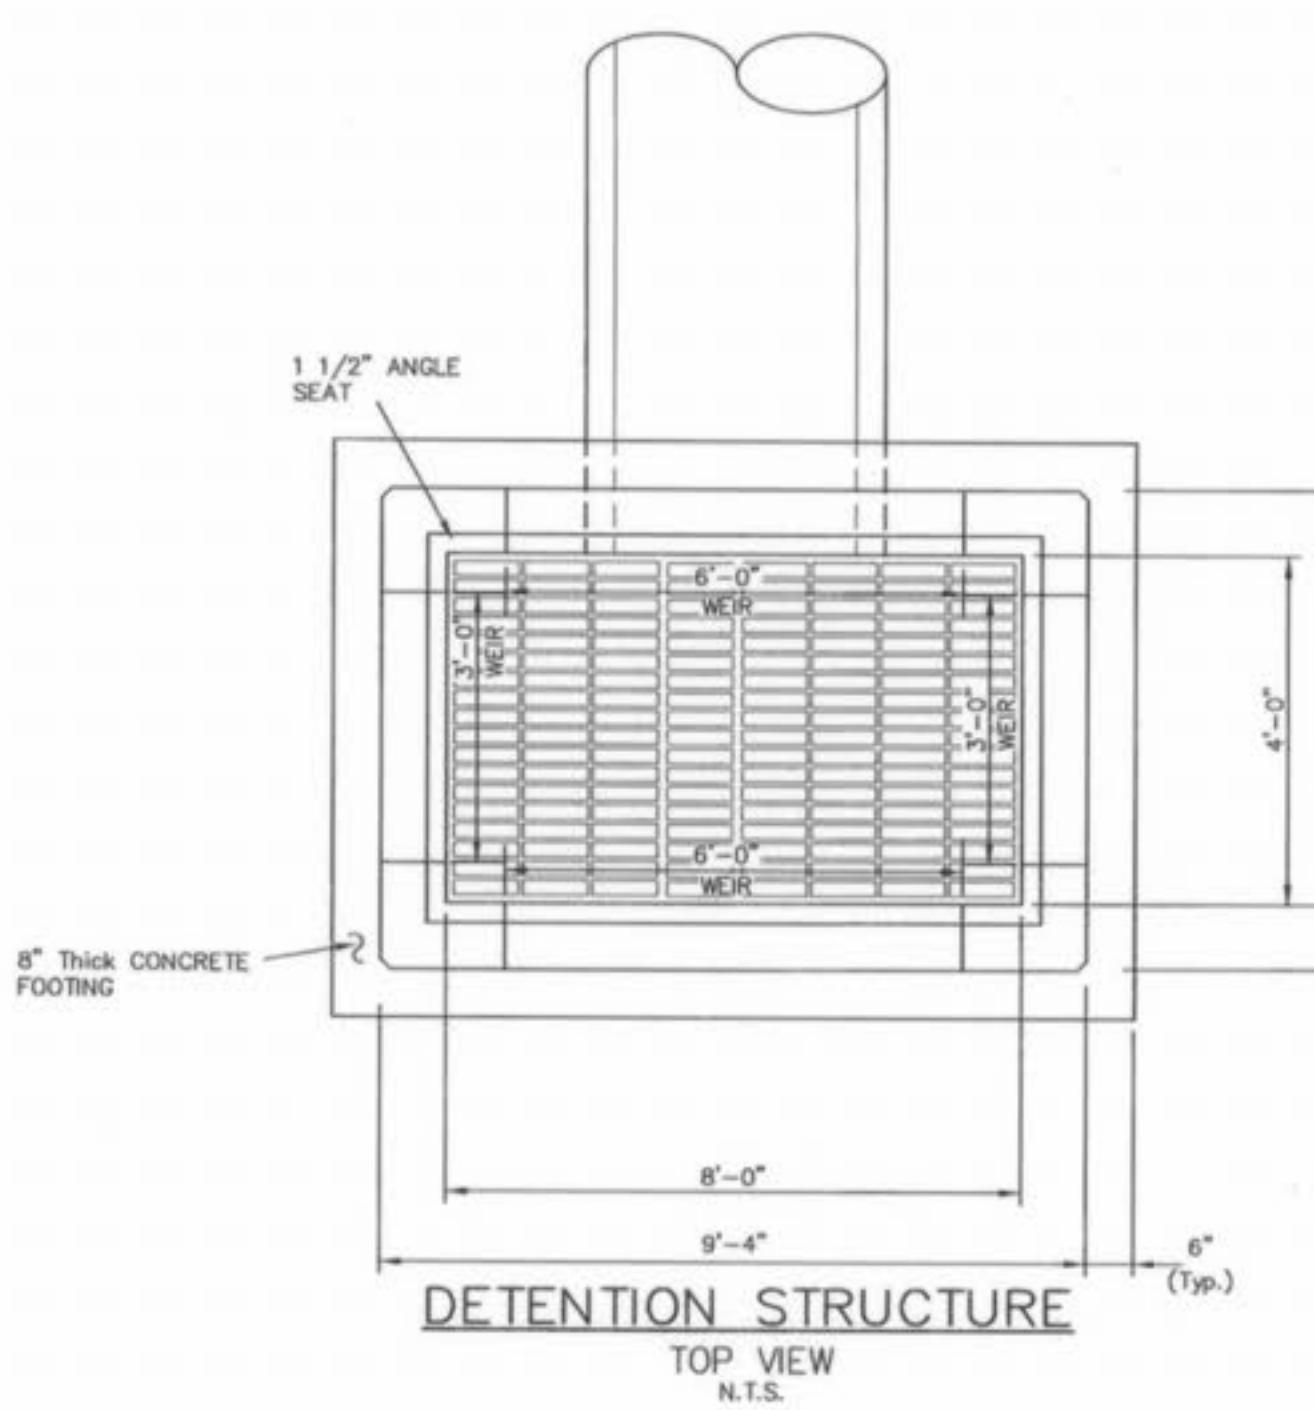


"AS-BUILT"




ST. CHARLES ENGINEERING & SURVEYING, INC.
801 S. FIFTH STREET, SUITE 202
ST. CHARLES, MO 63301
TEL: (636) 947-0607 FAX: (636) 947-2448

HIDDEN CREEK PHASE 1 "AS-BUILTS"

HIDDEN CREEK PHASE 1 SANITARY SEWER "AS-BUILTS"

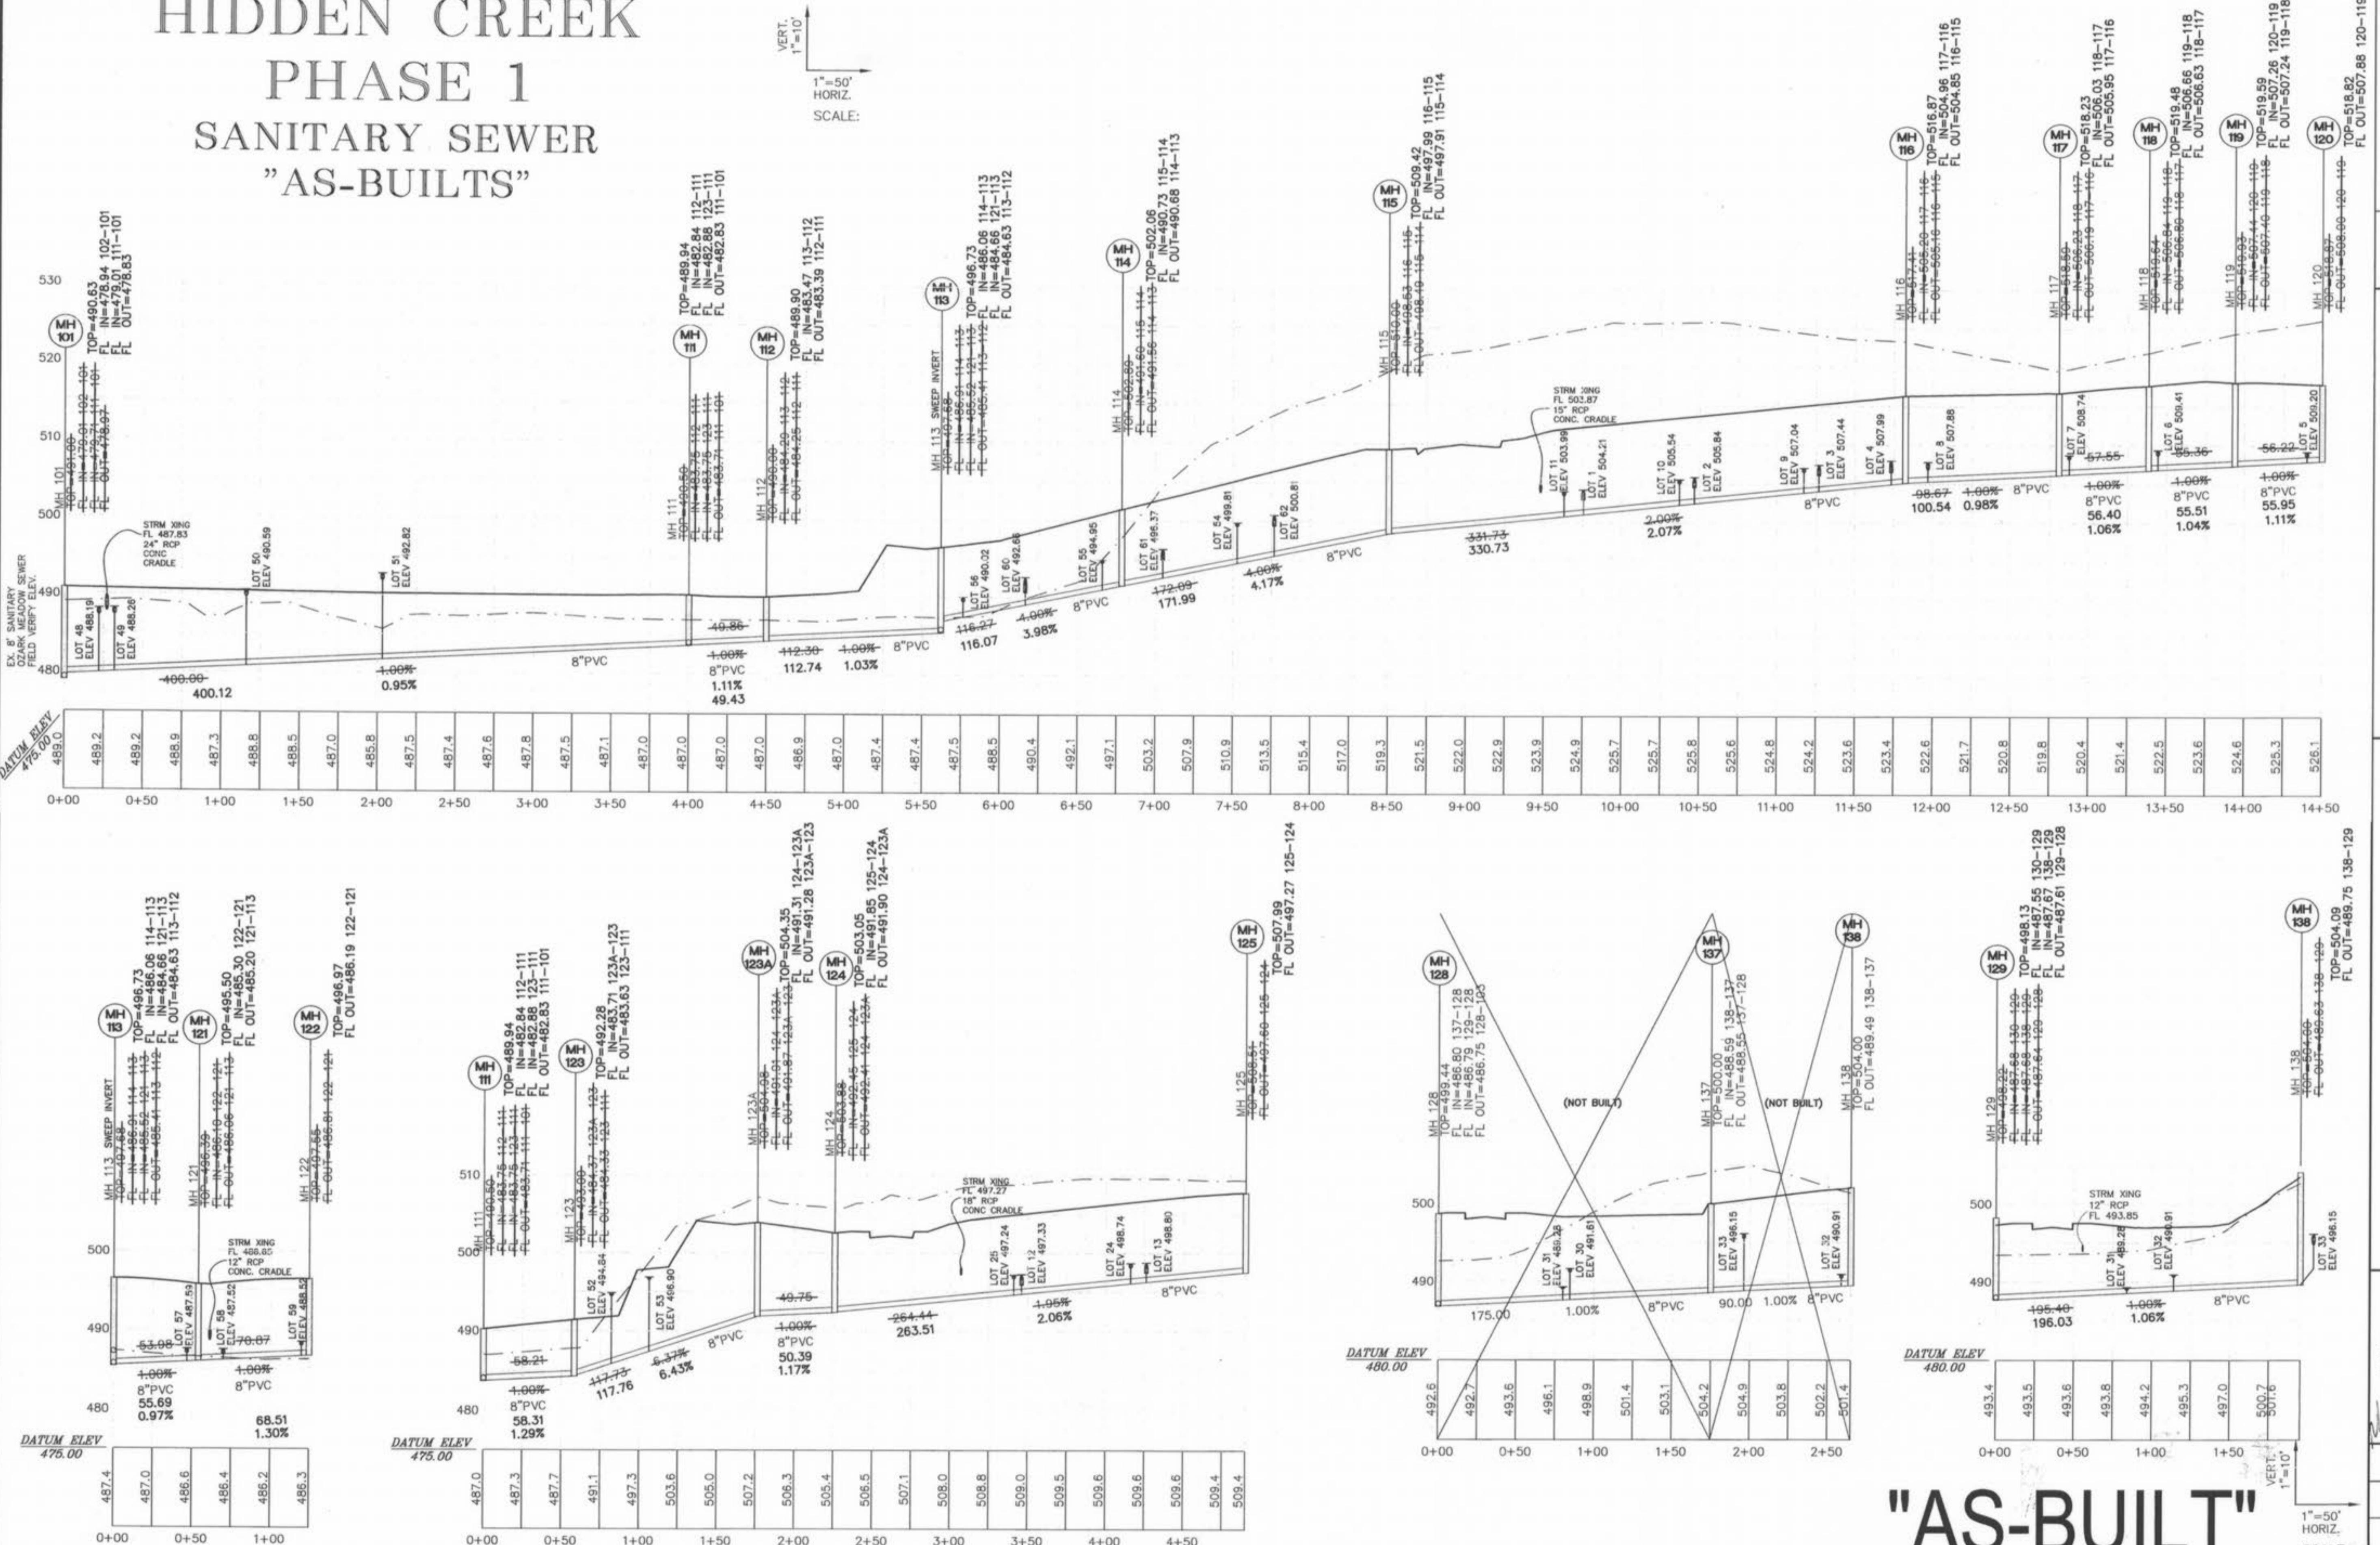

"AS-BUILT"

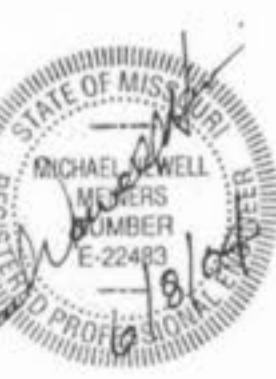


S C ST. CHARLES ENGINEERING
801 S. FIFTH ST.
ST. CHARLES
TEL: (636) 947-0607

CHARLES ENGINEERING & SURVEYING, INC.
801 S. FIFTH STREET, SUITE 202
ST. CHARLES, MO 63301
TEL: (636) 947-0607 FAX: (636) 947-2448










HIDDEN CREEK PHASE 1 "AS-BUILT'S"

HIDDEN CREEK PHASE 1 STORM SEWER "AS-BUILTS"

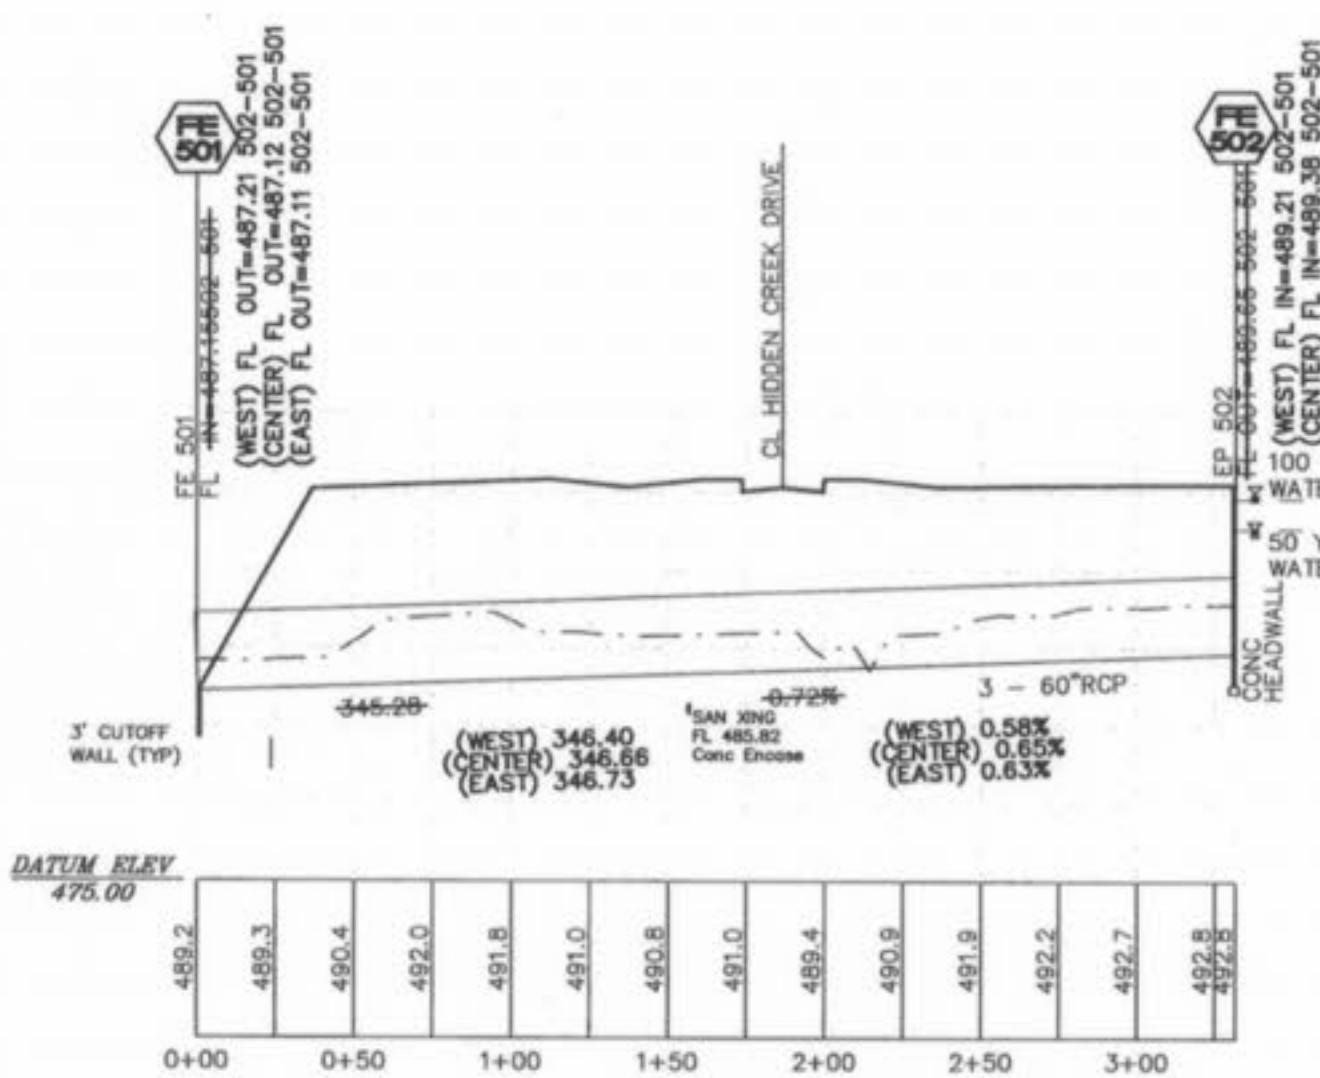

VERT.
 $1'' = 10'$

 $1'' = 50'$
 HORIZ.
 SCALE:

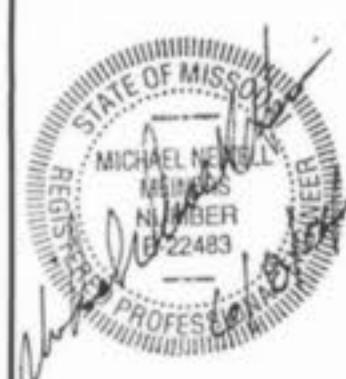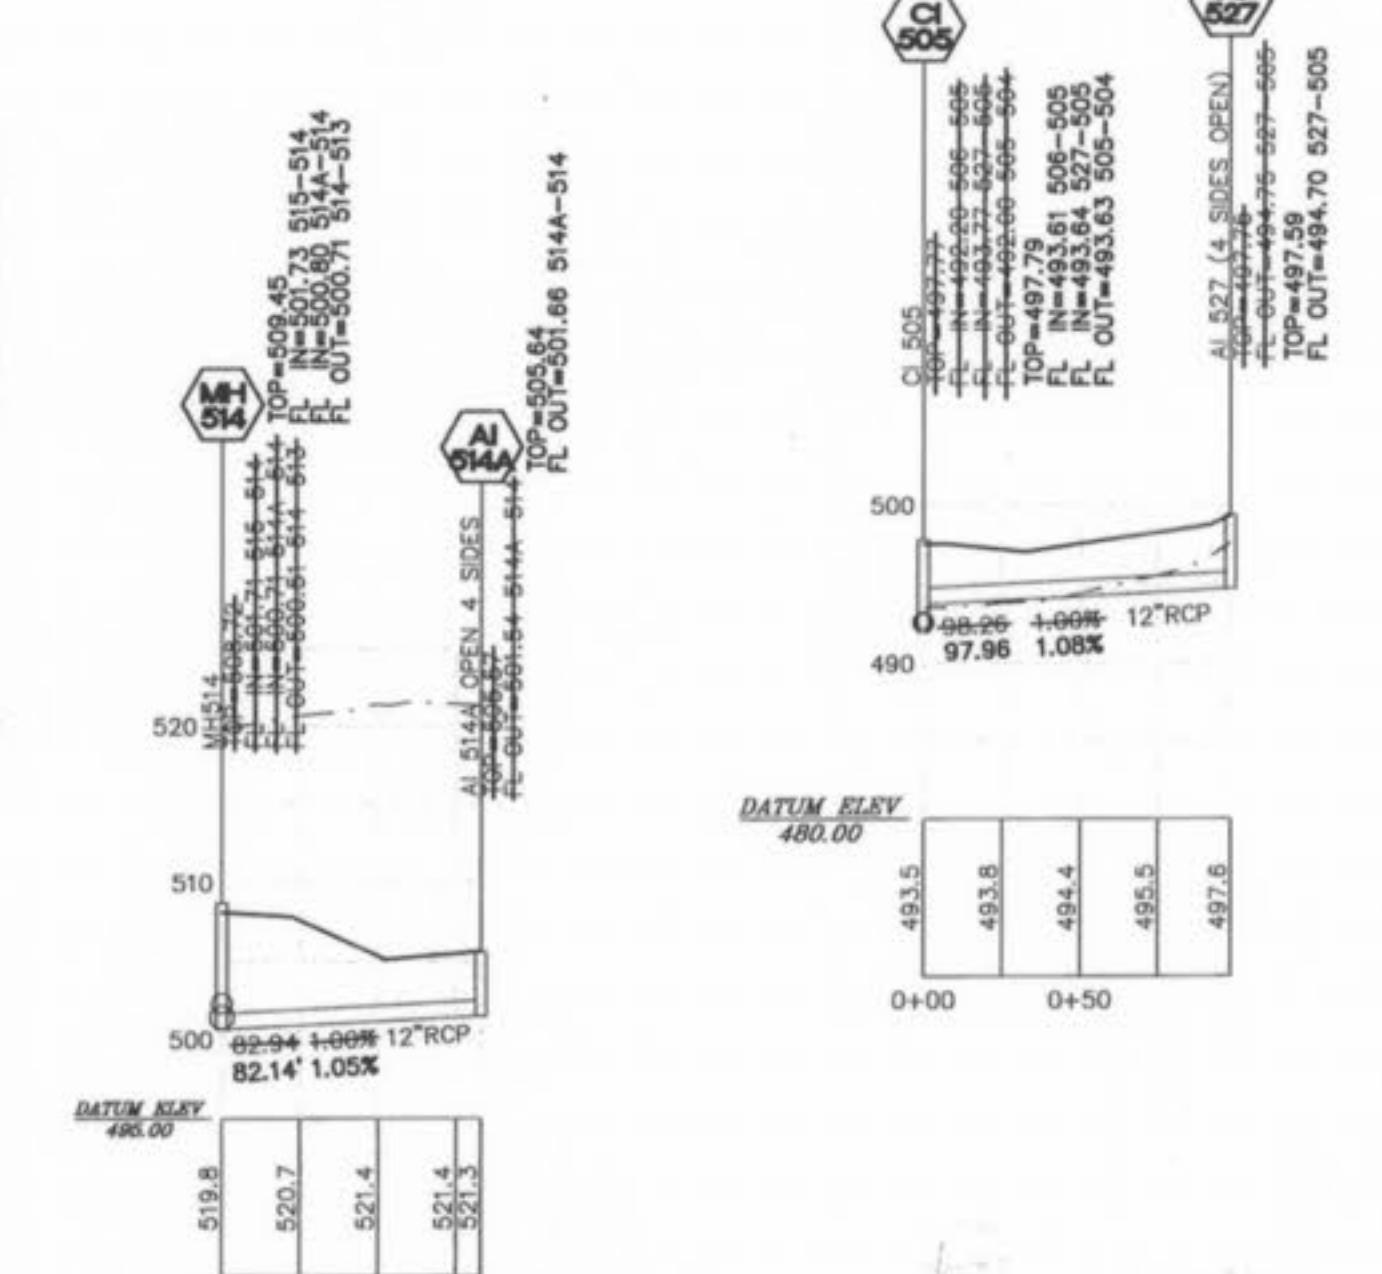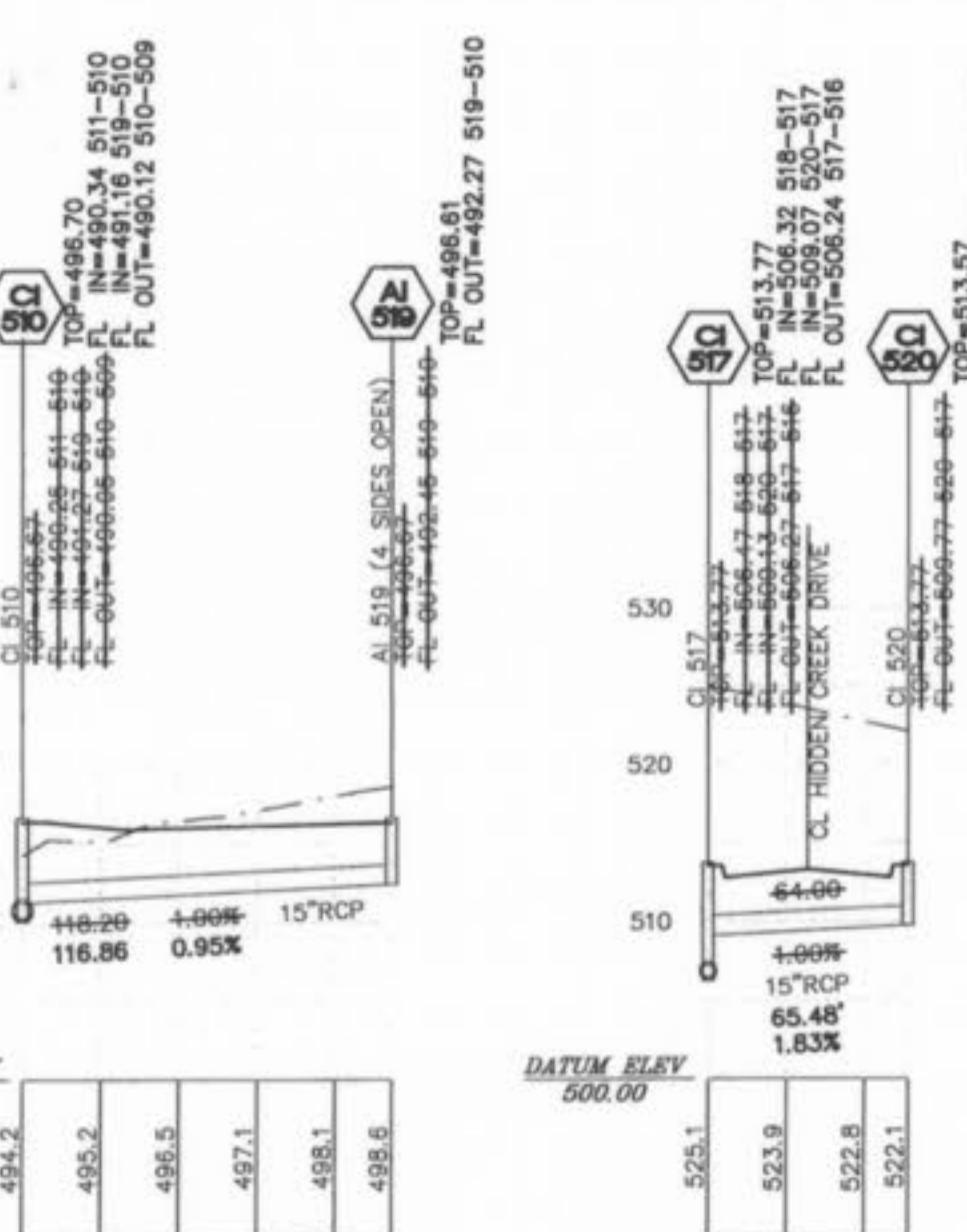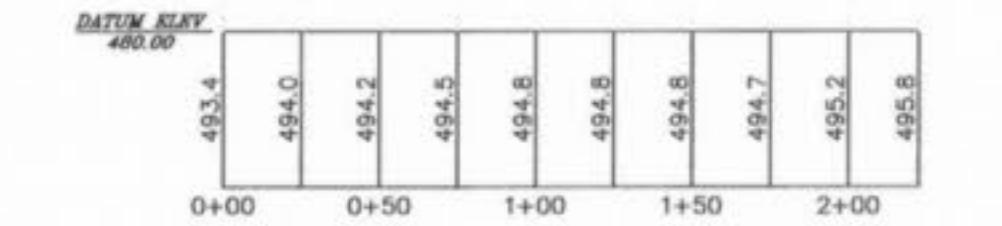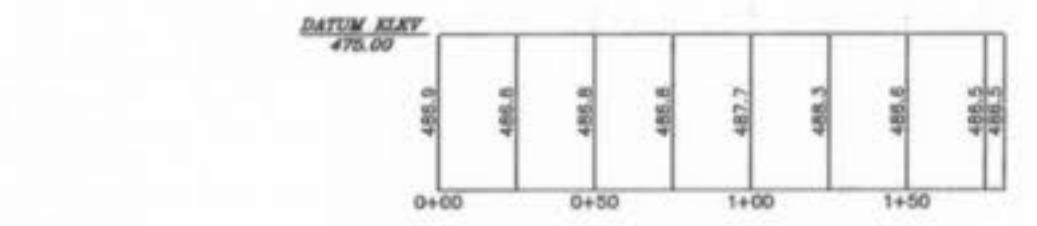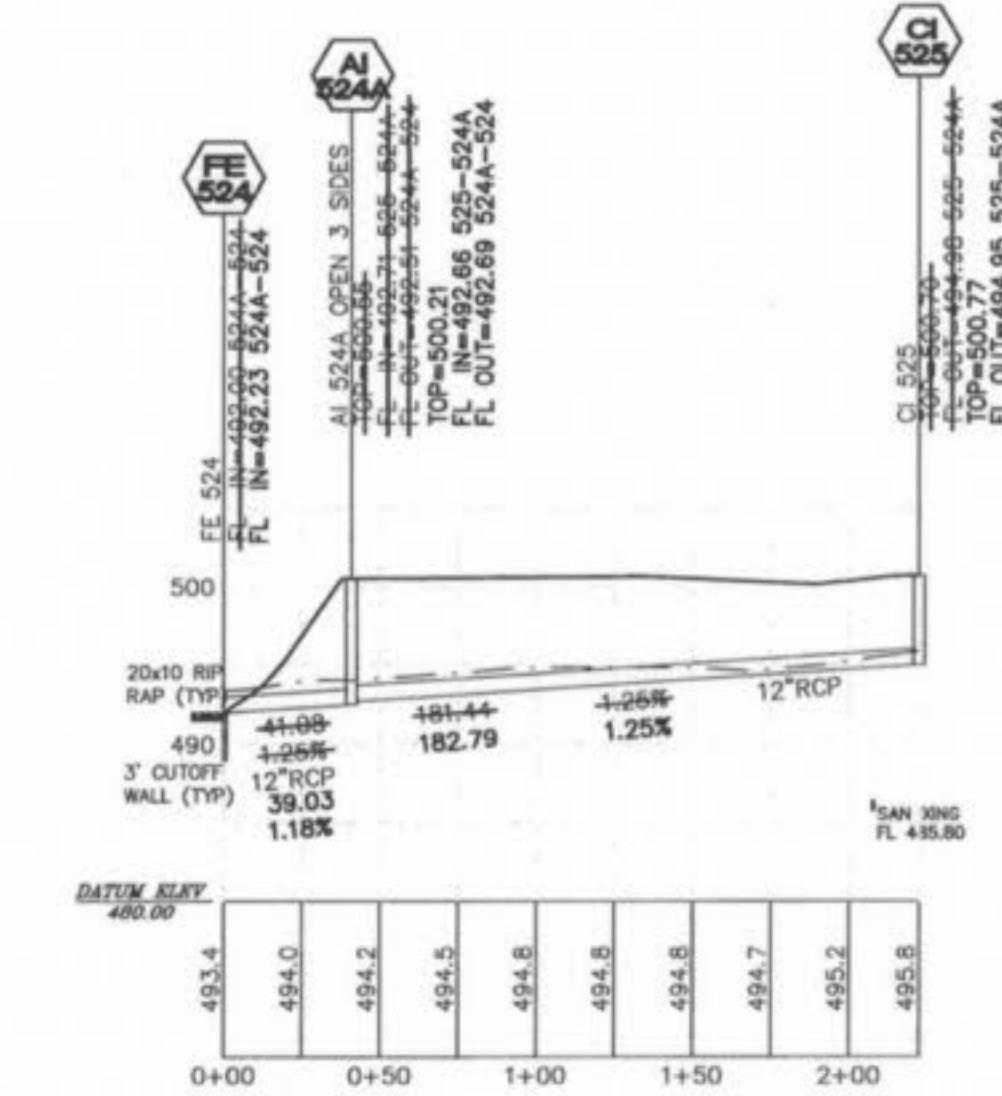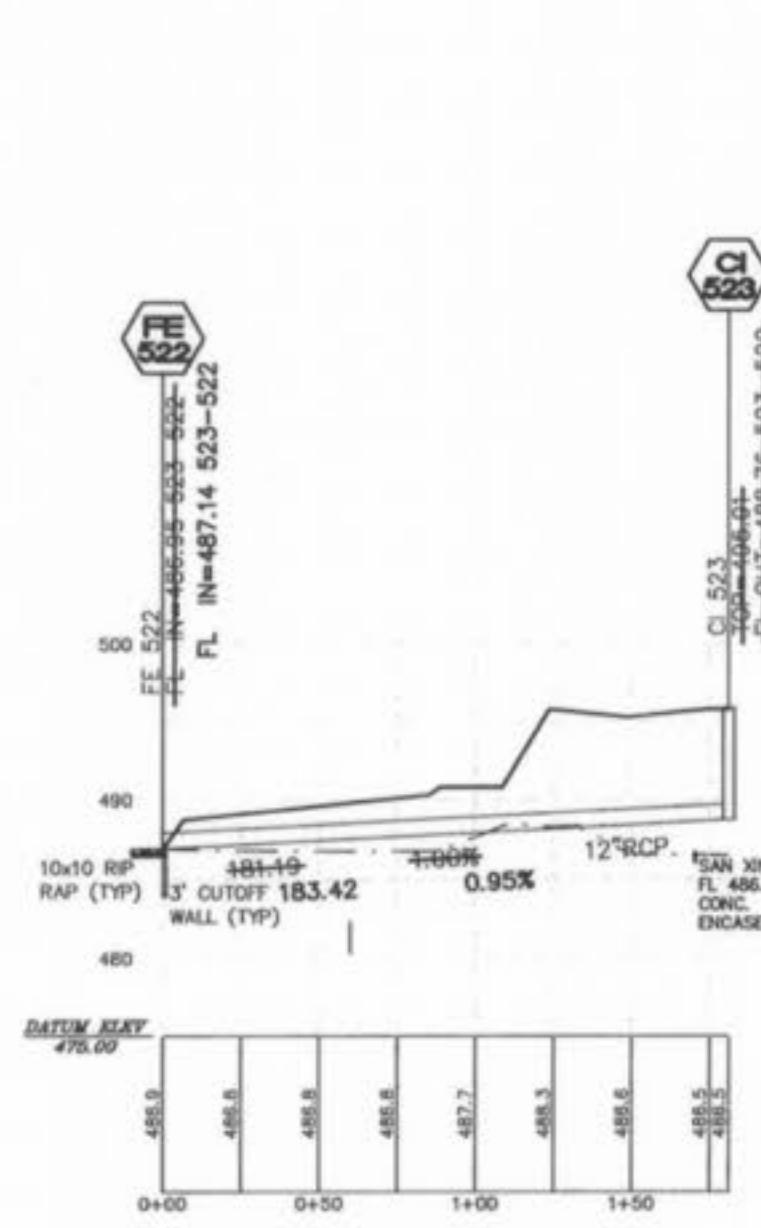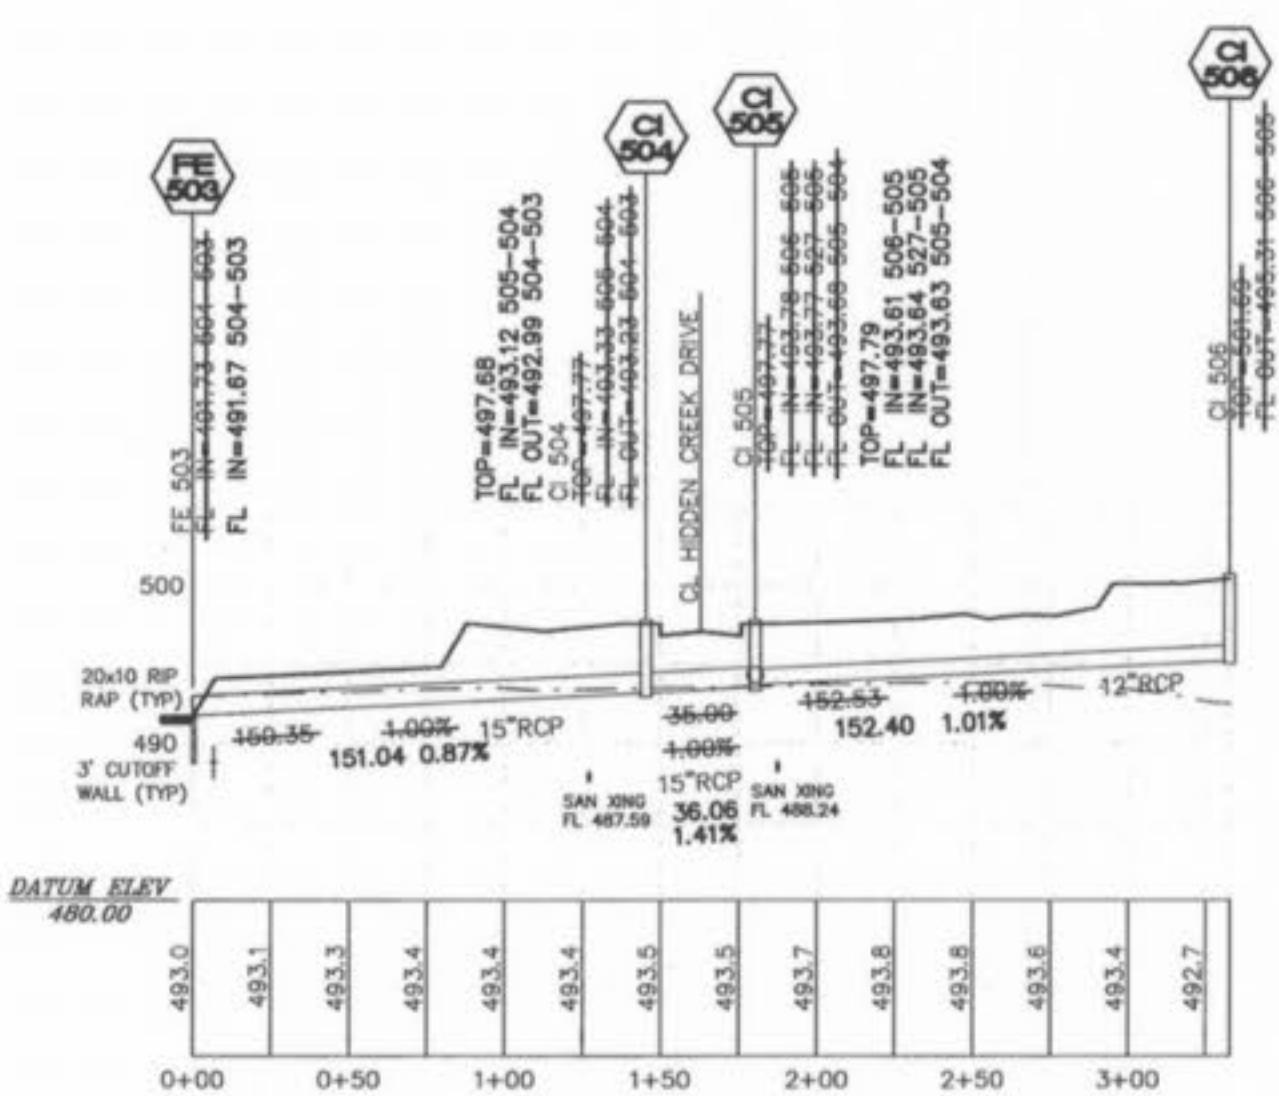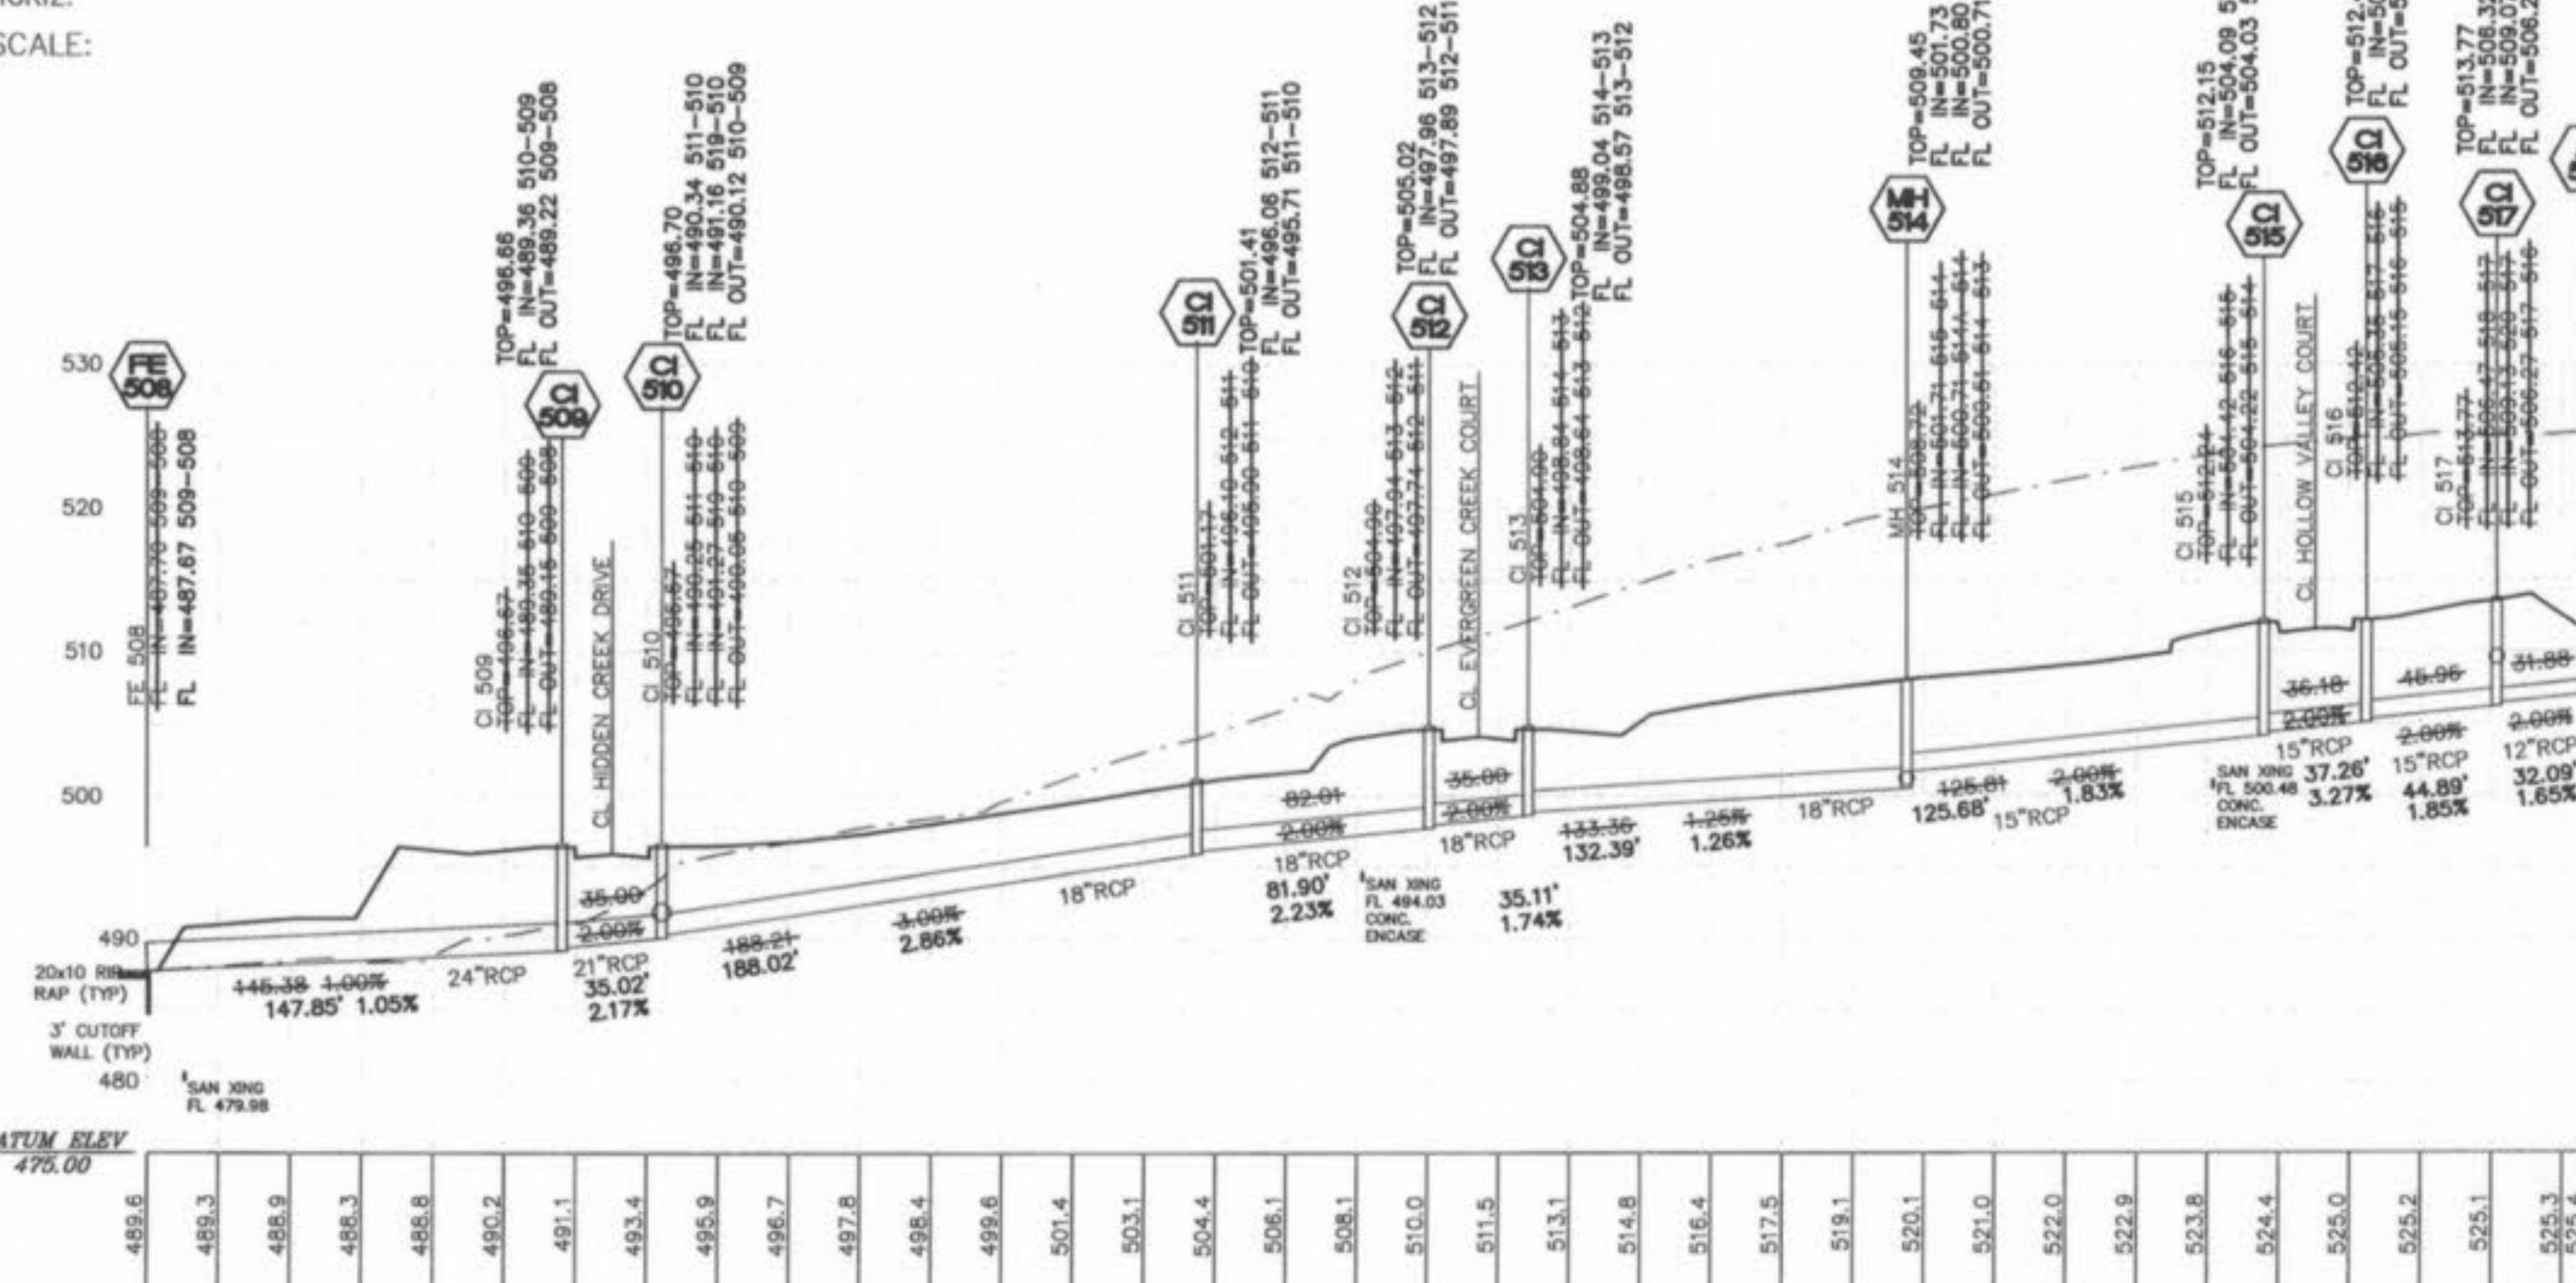

ORDER NO.	02-0162-01
DATE	11/18/03
5	

"AS-BUILT"

Hidden Creek Ph 1 App 8/6/04 ABK