

IMPROVEMENT PLANS

HIGHGROVE PLACE (NORTH PORTION)

*A TRACT OF LAND BEING PART OF
U.S. SURVEYS 469 AND 1790
TOWNSHIP 47 NORTH, RANGE 3 EAST
ST. CHARLES COUNTY, MISSOURI*

CITY OF O'FALLON GENERAL NOTES

1. Gas, water and other underground utilities shall not conflict with the depth or horizontal locations of existing and proposed sanitary and storm sewers, including house laterals.
2. Underground utilities have been plotted from available information and, therefore, their locations must be considered approximate only. The verification of the location of all underground utilities, either shown or not shown on these plans, shall be the responsibility of the contractor and shall be located prior to grading or construction of improvements.
3. Polyvinyl Chloride (PVC) shall conform to the requirements of ASTM D-3034 Standard Specifications for the PSM Polyvinyl Chloride (PVC) Sewer Pipe and Fittings, SDR-35.
4. All storm sewer pipe under pavement, regardless of size, shall be reinforced concrete pipe (ASTM C-76, Class III), unless noted otherwise in the plans.
5. Corrugated metal pipe shall conform to the standard specifications for corrugated culvert pipe M-36, A.A.S.H.T.O. See plans for gauge.
6. All filled places under buildings, proposed sanitary and storm sewer lines, and/or paved areas including backfills shall be compacted to 90% of maximum density as determined by the "Modified A.A.S.H.T.O. T-180 Compaction Test" (ASTM D-1557) unless otherwise specified by the local governing authority specifications. All tests will be verified by a soils engineer.
7. All earthen filled places within State, County, or City rights-of-way shall be compacted to 95% of maximum density as determined by the "Standard Proctor Test" A.A.S.H.T.O. T-99 (ASTM D-698) unless otherwise specified by local governing authority specifications. All tests will be verified by a soils engineer.
8. All storm and sanitary trench backfill shall be water jetted. Granular fill will be used under paved areas.
9. Easements shall be provided for storm sewers, sanitary sewers, and all utilities on the record plot. See record plot for location and size of easements. This does not apply to house laterals.
10. No area shall be cleared without the permission of the developer.
11. All grades shall be within 0.2 feet (more or less) of those shown on the grading plan.
12. No slope shall be greater than 3:1 and shall be either sodded or seeded and mulched.
13. Hazard markers will consist of three (3) standard specification, "Universal Uniform Traffic Control Device," mounted on two (2) pound "U" channel sign post. Each marker shall consist of an eighteen (18) inch diamond reflectorized red panel. The bottom of each panel shall be mounted a minimum of four (4) feet above the elevation of the pavement surface.
14. All manholes and curb inlet tops built without elevations furnished by the Engineer will be responsible of the sewer contractor. At the time of construction stake-out of the sewer lines, all curb and inlet stakes will be face staked. If normal face stakes fail in line with sewer construction, the Engineer will set these stakes on a double offset. It shall be the responsibility of the sewer contractor to preserve all face stakes from destruction.
15. All standard street curb inlets to have front of inlet 2 feet behind curb.
16. The minimum vertical distance from the low point of the basement to the flowline of a sanitary sewer at the corresponding house connection shall not be less than the diameter of the sanitary sewer plus a vertical distance not less than two and one-half feet (2-1/2").
17. Water lines, valves, sleeves, meters etc., shall meet all specifications and installation requirements of the local governing authority.
18. All cast iron pipe for water mains shall conform to A.W.W.A. specification C-106 and/or C-108. The cast iron fittings shall conform to A.W.W.A. specification C-110. All rubber gasket joints for water cast iron pressure pipe and fittings shall conform to A.W.W.A. specification C-111.
19. All water hydrants and valves shall be cast iron and installed in accordance with plans and details.
20. All sanitary and storm sewers shall meet all specifications and installation requirements of the local governing authority.
21. All PVC water pipe shall have a minimum pressure rating of PR-200 or SDR-21.

116 LOTS

"AS-BUILTS"

*LOCATION MAP
1" = 2000'*



EACH CONTRACTOR, SUBCONTRACTOR, ANGUS UTILITY COMPANY SHALL BE RESPONSIBLE FOR THE MAINTENANCE AND PAYMENT OF ANY SILTATION CONTROL PLACED ON THE DEVELOPMENT BY THE DEVELOPER AND SHALL NOT DISTURB THE SILITATION CONTROL EXCEPT AS PROVIDED IN THE CONTRACT. THE CONTRACTOR, SUBCONTRACTOR, OR SUBCONTRACTOR OR UTILITY COMPANY, AS APPLICABLE, DISBURSING SUCH SILITATION CONTROL SHALL IMMEDIATELY REPLACE THE SAME AT THE CONTRACTOR'S, SUBCONTRACTOR'S, AND UTILITY COMPANY'S, EXPENSE. IF THE CONTRACTOR, SUBCONTRACTOR, OR UTILITY COMPANY'S, PENALTIES BEING LEVIED AS A RESULT OF THE DISTURBANCE OF ANY SUCH SILITATION CONTROL, THE PARTY DISTURBING SUCH SILITATION CONTROL SHALL BE SOLELY RESPONSIBLE FOR PAYING THE SAME. THE CONTRACTOR, SUBCONTRACTOR, OR UTILITY COMPANY SHALL HOLD WHITTAKER CONSTRUCTION, INCORPORATED HARMLESS FROM ANY AND ALL LIABILITIES, DAMAGES, DEMANDS, COSTS AND EXPENSES, INCLUDING, WITHOUT LIMITATION, ATTORNEY'S FEES ARISING FROM OR IN CONNECTION WITH ANY SUCH DISTURBANCES.

PROJECT BENCHMARK :

RM 70 (U.S.G.S.) ELEVATION = 505.026
STANDARD DISK STAMPED "H 149 1935" SET IN TOP
OF WEST END OF THE BASE OF SOUTH PIER OF
NORFOLK SOUTHERN RAILWAY OVER STATE HIGHWAY 79.

by Pickett Ray & Silver

[Signature]
Delmar F. Vincent
MO R.L.S. No 1869
12-9-97
Date

PICKETT, RAY & SILVER, INC.
STATE OF MISSOURI
HAROLD J. BARTH
REG. NO. E-17751
PROFESSIONAL ENGINEER



WHITTAKER CONSTRUCTION CO., INC.
355A MID RIVERS MALL DRIVE
ST. PETERS, MO. 63376
(314)970-1511

DEVELOPER

12-9-97 "AS-BUILTS"

© Copyright 1996 by Pickett, Ray & Silver Inc.	
CONFIDENTIAL PROPRIETARY MATERIAL The use, reproduction and sales rights of this drawing are reserved by Pickett, Ray & Silver Inc.	
J.L.K.	DATE MAY, 1996
RECHECKED	DATE
FIELD BOOK 609	PROJECT # 95-067
	JOB ORDER # 34618

HIGHGROVE PLACE NORTH SEWER AS-BUILTS

DRAWING INDEX

Sheet	Description
1	COVER SHEET
2, 3	FLAT PLANS
4, 5	GRADING PLANS
6, 7	STREET PROFILES
8, 9 4-5	SANITARY SEWER PROFILES
10, 11 6-7	STORM SEWER PROFILES
12, 13	WATER PLAN
14, 15	DRAINAGE AREA MAP
16, 20	CONSTRUCTION DETAILS

LEGEND

	Sanitary Sewer (Proposed)	R.C.P.	Reinforced Concrete Pipe
	Sanitary Structure	C.M.P.	Corrugated Metal Pipe
	Storm Structure	C.I.P.	Cast Iron Pipe
	Test Hole	C.I.P.	Cast Iron Pipe
	Power Pole	P.V.C.	Polyvinyl Chloride
	Water Line & Size	V.C.P.	Vitrified Clay Pipe
	Light Standard		
	Double Water Meter Setting	C.O.	Clean Out
	Single Water Meter Setting	V.T.	Vent Trap
	Curb Inlet	T.B.R.	To Be Removed
	Skewed Curb Inlet	T.B.R.&R	To Be Removed & Relocated
	Double Curb Inlet	T.B.P.	To Be Protected
	Grate Inlet	T.B.A.	To Be Abandoned
	Area Inlet	B.C.	Base Of Curb
	Double Area Inlet	T.C.	Top Of Curb
	Existing Contour	F.E.	Flared End Section
	Existing Tree Line	E.P.	End Pipe
	Street Sign	E.D.	Energy Dissipator
	Concrete Collar	M.H.	Manhole
	Proposed Contour	C.P.	Concrete Pipe
	Flared End Section		Use In Place
	End Pipe		
	Energy Dissipator		
	Manhole		
	Concrete Pavement		

REVISIONS

REV. 7-16-96 CITY COMMENTS GS.
REV. 8-20-96 CITY COMMENTS GS.
REV. 1-11-97 SAN 85TH SEWER
REV. 4-24-97 PER CLIENT - NOTE LM

**HIGHGROVE PLACE
(NORTH PORTION)
FLAT PLAN**

MAY, 1996 Job No. 95-067

REVISED 7-16-96 CITY COMMENTS

REVISED 8-20-96 CITY COMMENTS

REVISED 12-06-96 CITY COMMENTS

REVISED 1-11-97 SAN SEWER & LATERALS

REVISED 5-6-97 PED. PATH

AS-BUILTS 12-3-97

NOTE: SHEDDING BASIN 0.5 FEET TO ACCOMMODATE 5 YEAR SEDIMENT ACCUMULATION

15YR H.W. = 478.81

25YR H.W. = 479.04

100YR H.W. = 479.33

GRAPHIC SCALE

50 0 50 100

(IN FEET)

1 inch = 50 ft.

MO. STATE HWY 79 (VARIABLE WIDTH)

555-4313'E


2

7

80


"AS-BUILTS"

AREA "C" HIGHGROVE PLACE NORTH SEWER AS-BUILTS

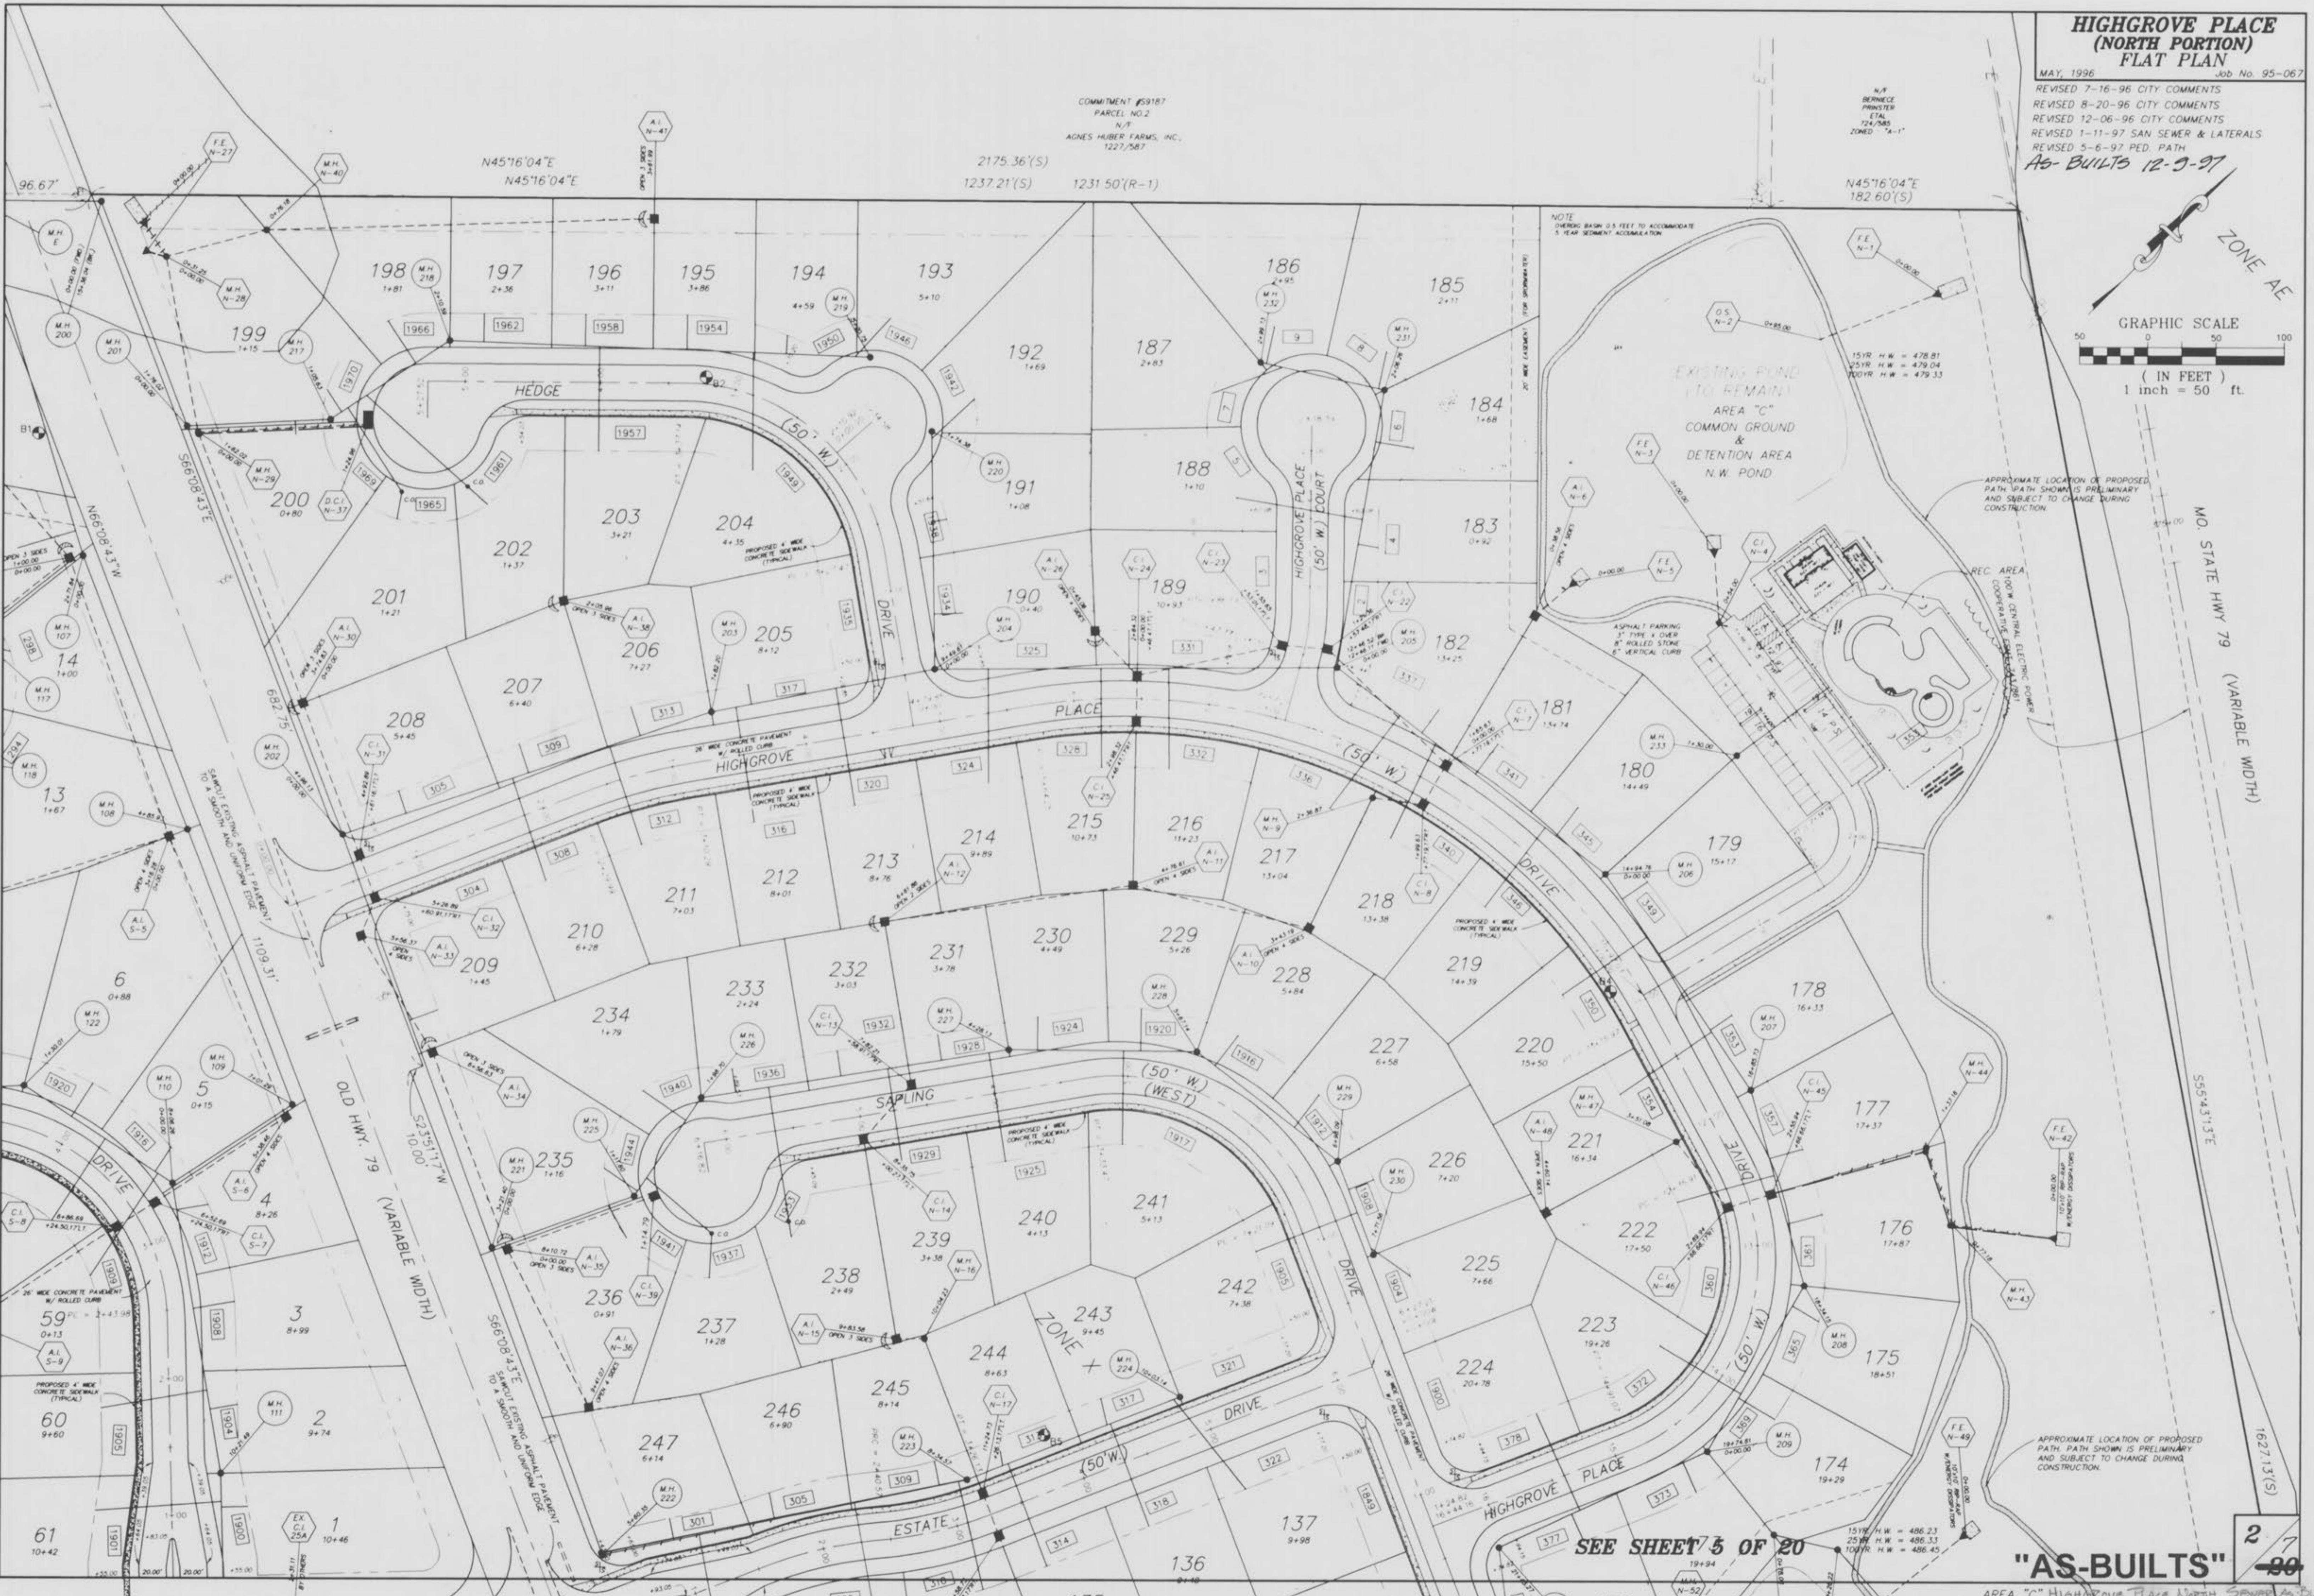



ORIGINAL SURVEY	SUBDIVIDED PLOTTED MAPS WHITE BROWN PC	DATE RECORDED
-----------------	--	------------------

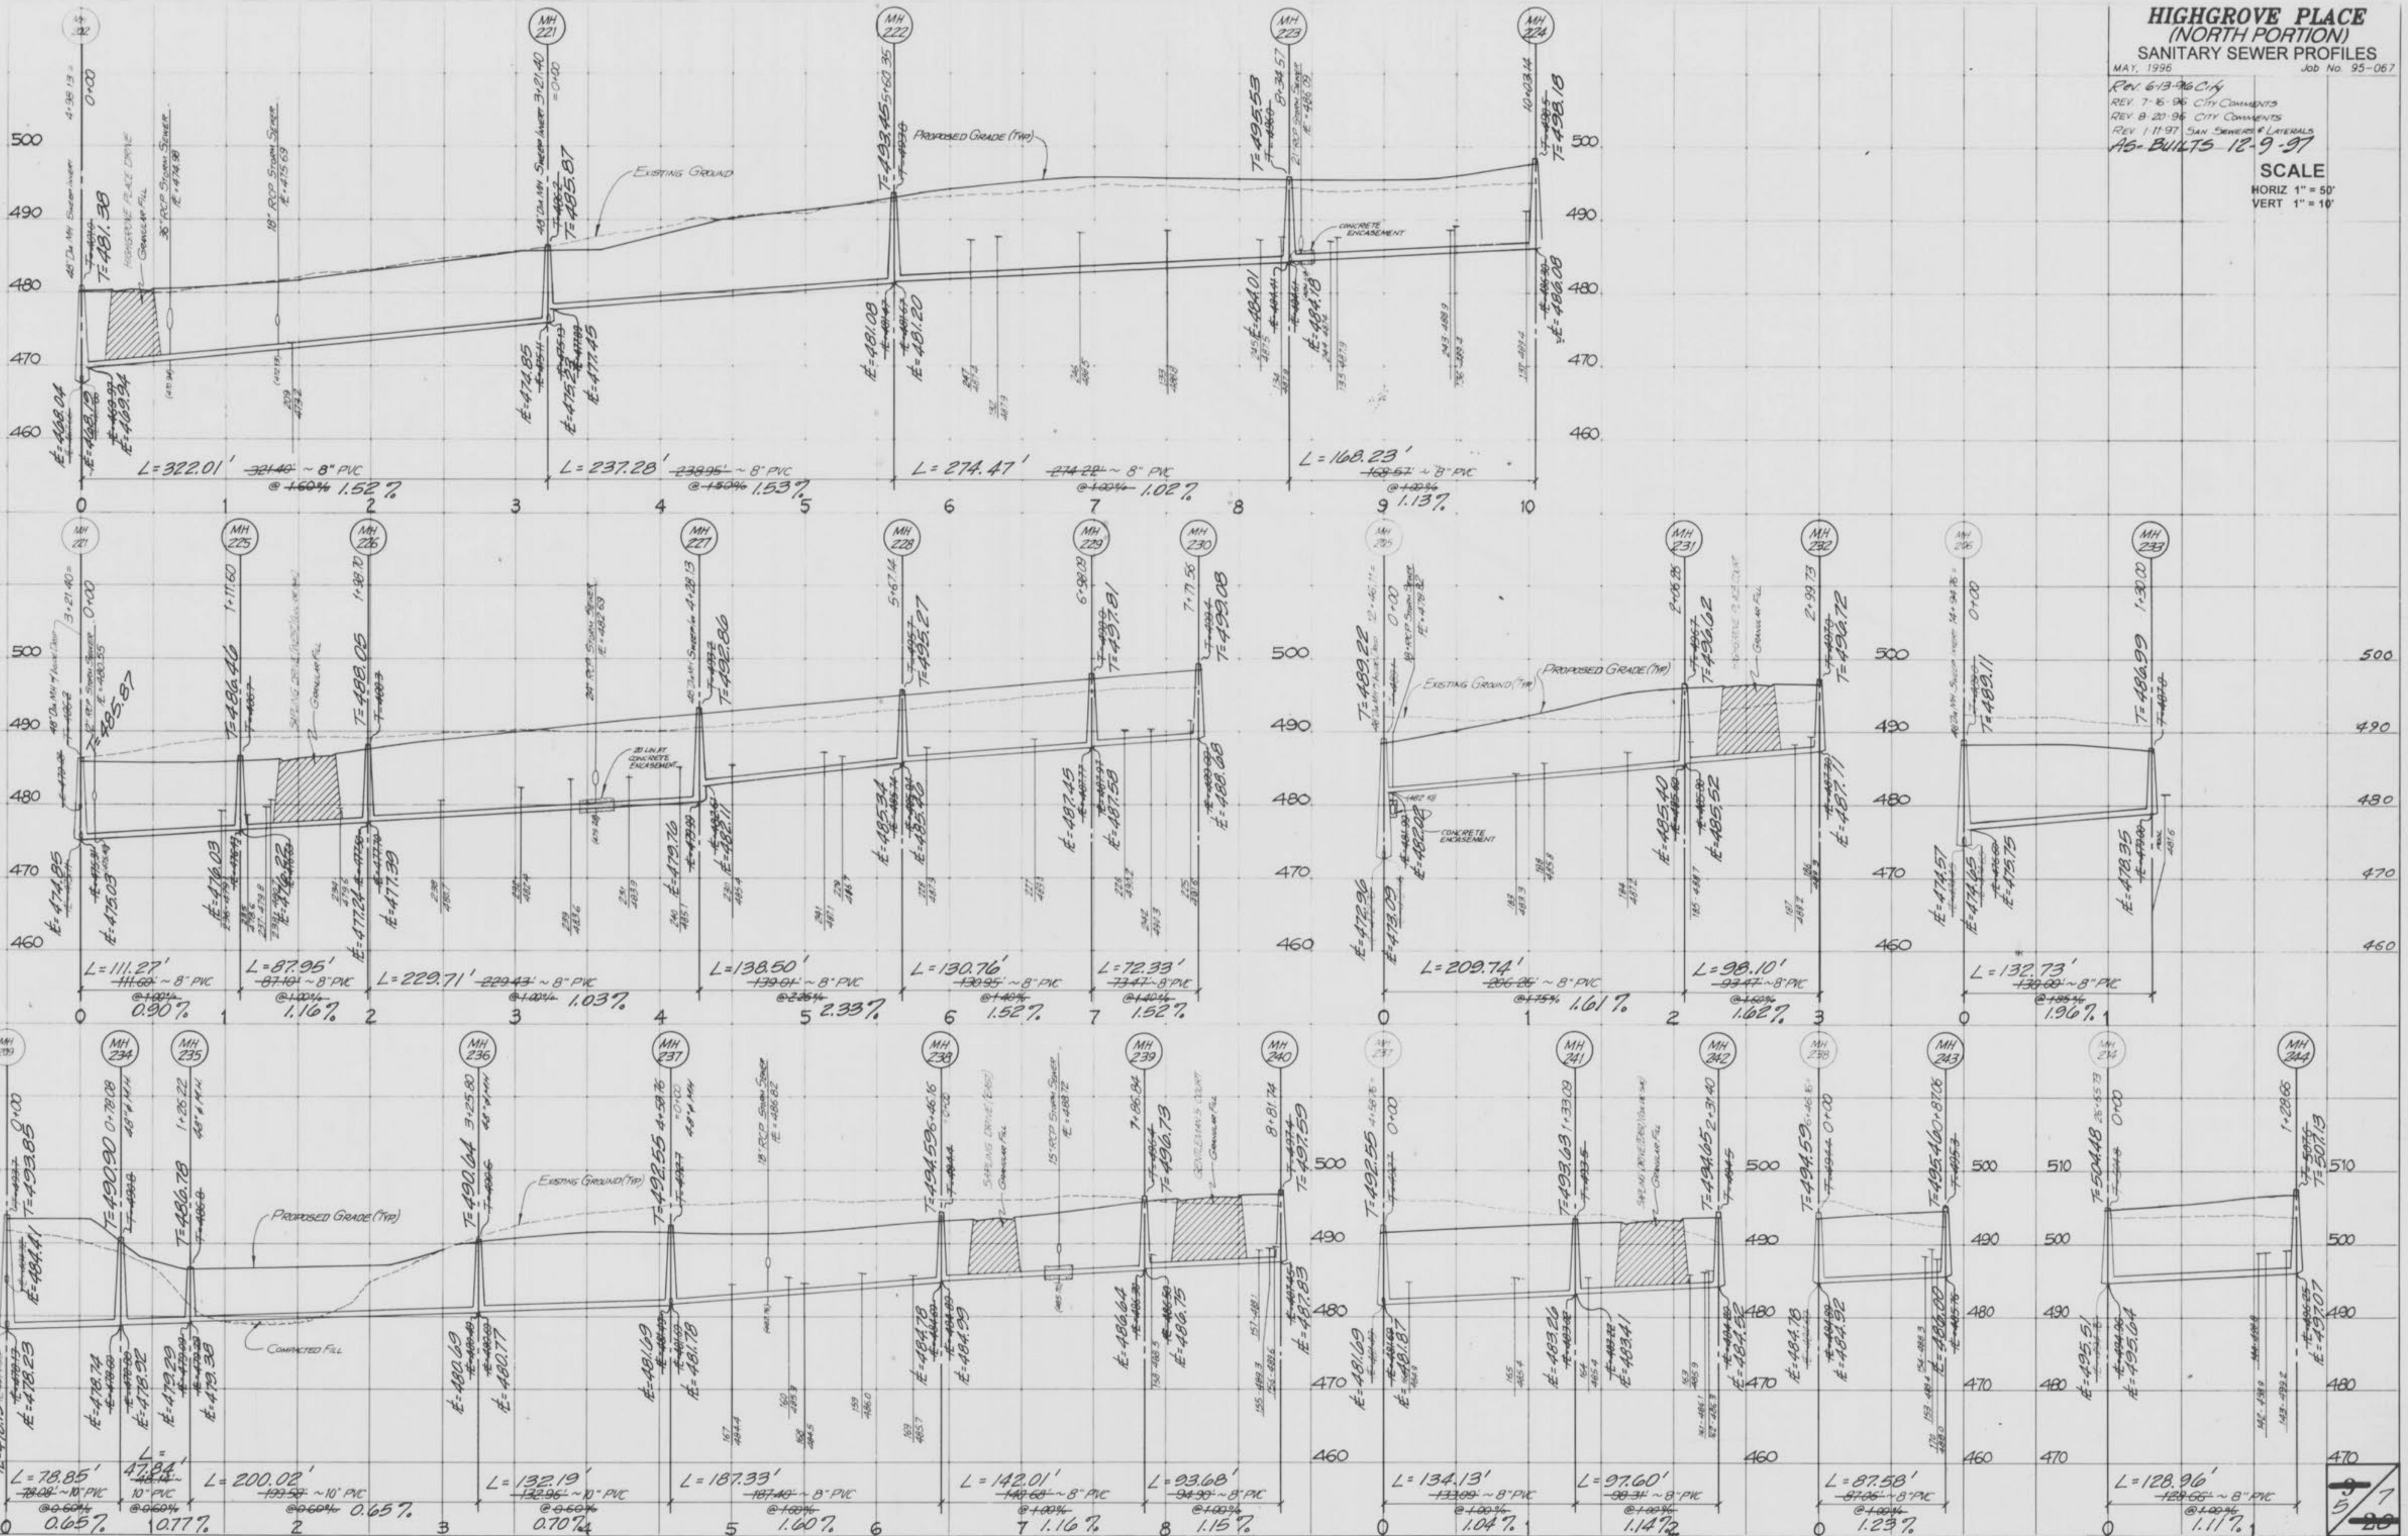

"AS-BUILTS"

HIGHGROVE PLACE NORTH SEWER AS-BUILT


HIGHGROVE PLACE
(NORTH PORTION)
STORM SEWER PROFILES

JOB NO. 95-067

REV. 7-16-96 CITY COMMENTS
REV. 8-20-96 CITY COMMENTS
REV. 1-11-97 See Sewer Storm Sewer Crossings
AS-BUILT 12-9-97

MAY, 1996

SCALE
HORIZ 1" = 50'
VERT 1" = 10'

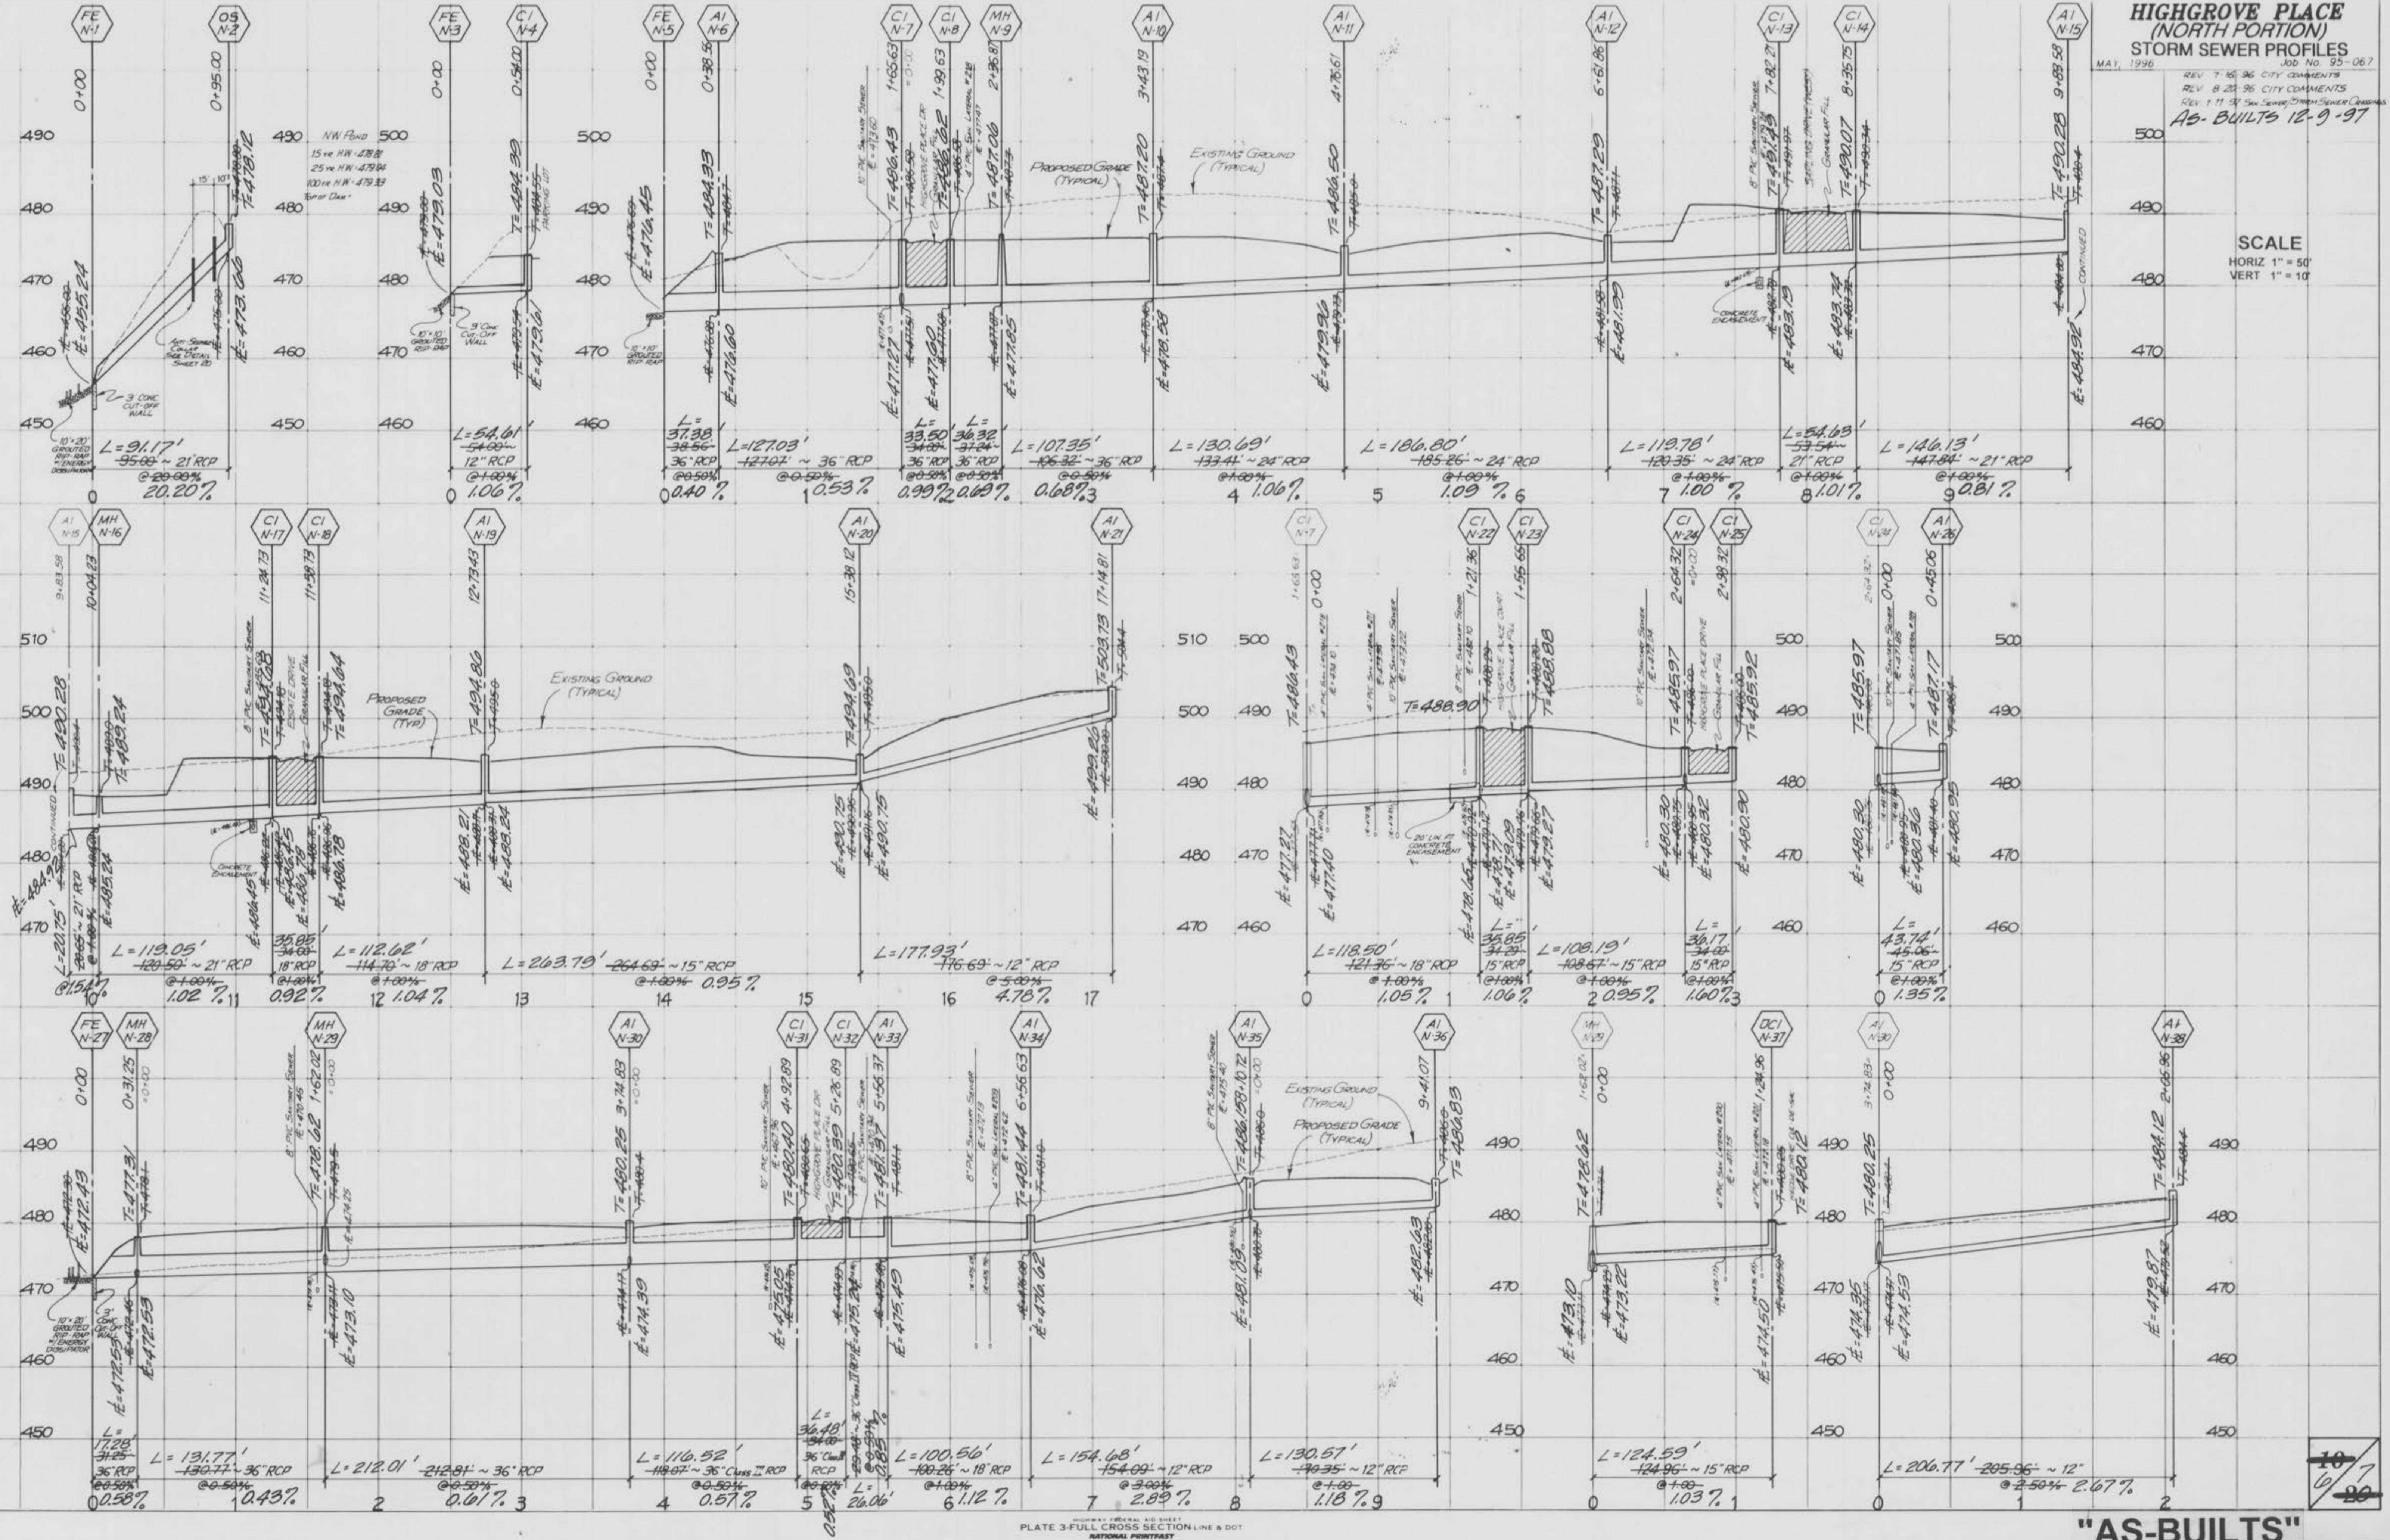

HIGHGROVE PLACE
(NORTH PORTION)
STORM SEWER PROFILES

MAY, 1996 Job No. 95-067

REV. 7/16/96 CITY COMMENTS

REV. 8/20/96 CITY COMMENTS

Rev. 11/31/96 Sewer Survey

Storm Sewer Crossing

AS-BUILT 12-9-97

NE POND

15' FR H.W. 485.23

25' FR H.W. 485.32

30' FR H.W. 485.45

Bank Elevation 485.70

AS-BUILT 12-9-97

500

490

480

500

490

480

500

490

480

500

490

480

160