

LOCATION MAP


Note: Existing underground and overhead utilities and drainage structures have been plotted from available information and their locations must be considered approximate only. It is the responsibility of the contractor to notify the utility companies and to verify the locations of existing utilities before actual construction begins. Any discrepancies noted must be reported to the Engineer immediately.

GBA GEORGE BUTLER ASSOCIATES, INC. Engineers / Architects / Landscape Architects / Planners Kansas City, Mo. / Lenexa, Ks. / O'Fallon, Mo. / Ames, Ia. / Oklahoma City, Ok.		DATE: JULY, 1992
DESIGN BY: PL		DRAWN BY: JG
PROJECT NO: 6603.01		SHEET NO: 1
TOTAL SHEETS: 1		DATE: 7/92
REVISIONS		
BY	DATE	



CURVE	DELTA ANGLE	RADIUS	ARC LENGTH	CHORD	TANGENT
C1	51°19'04"	28.00	17.91	17.32	9.61
C2	51°19'04"	28.00	17.91	17.32	9.61
C3	57°04'45"	25.00	24.91	23.09	13.68
C4	57°04'45"	25.00	24.91	23.09	13.68
C5	89°18'08"	25.00	38.91	35.18	24.64
C6	98°58'08"	25.00	39.63	35.61	25.37


LINE	DIRECTION	DISTANCE
L1	N 81°39'00" E	19.00
L2	N 65°08'18" E	48.28
L3	N 83°16'00" E	34.99
L4	N 83°16'00" E	38.99

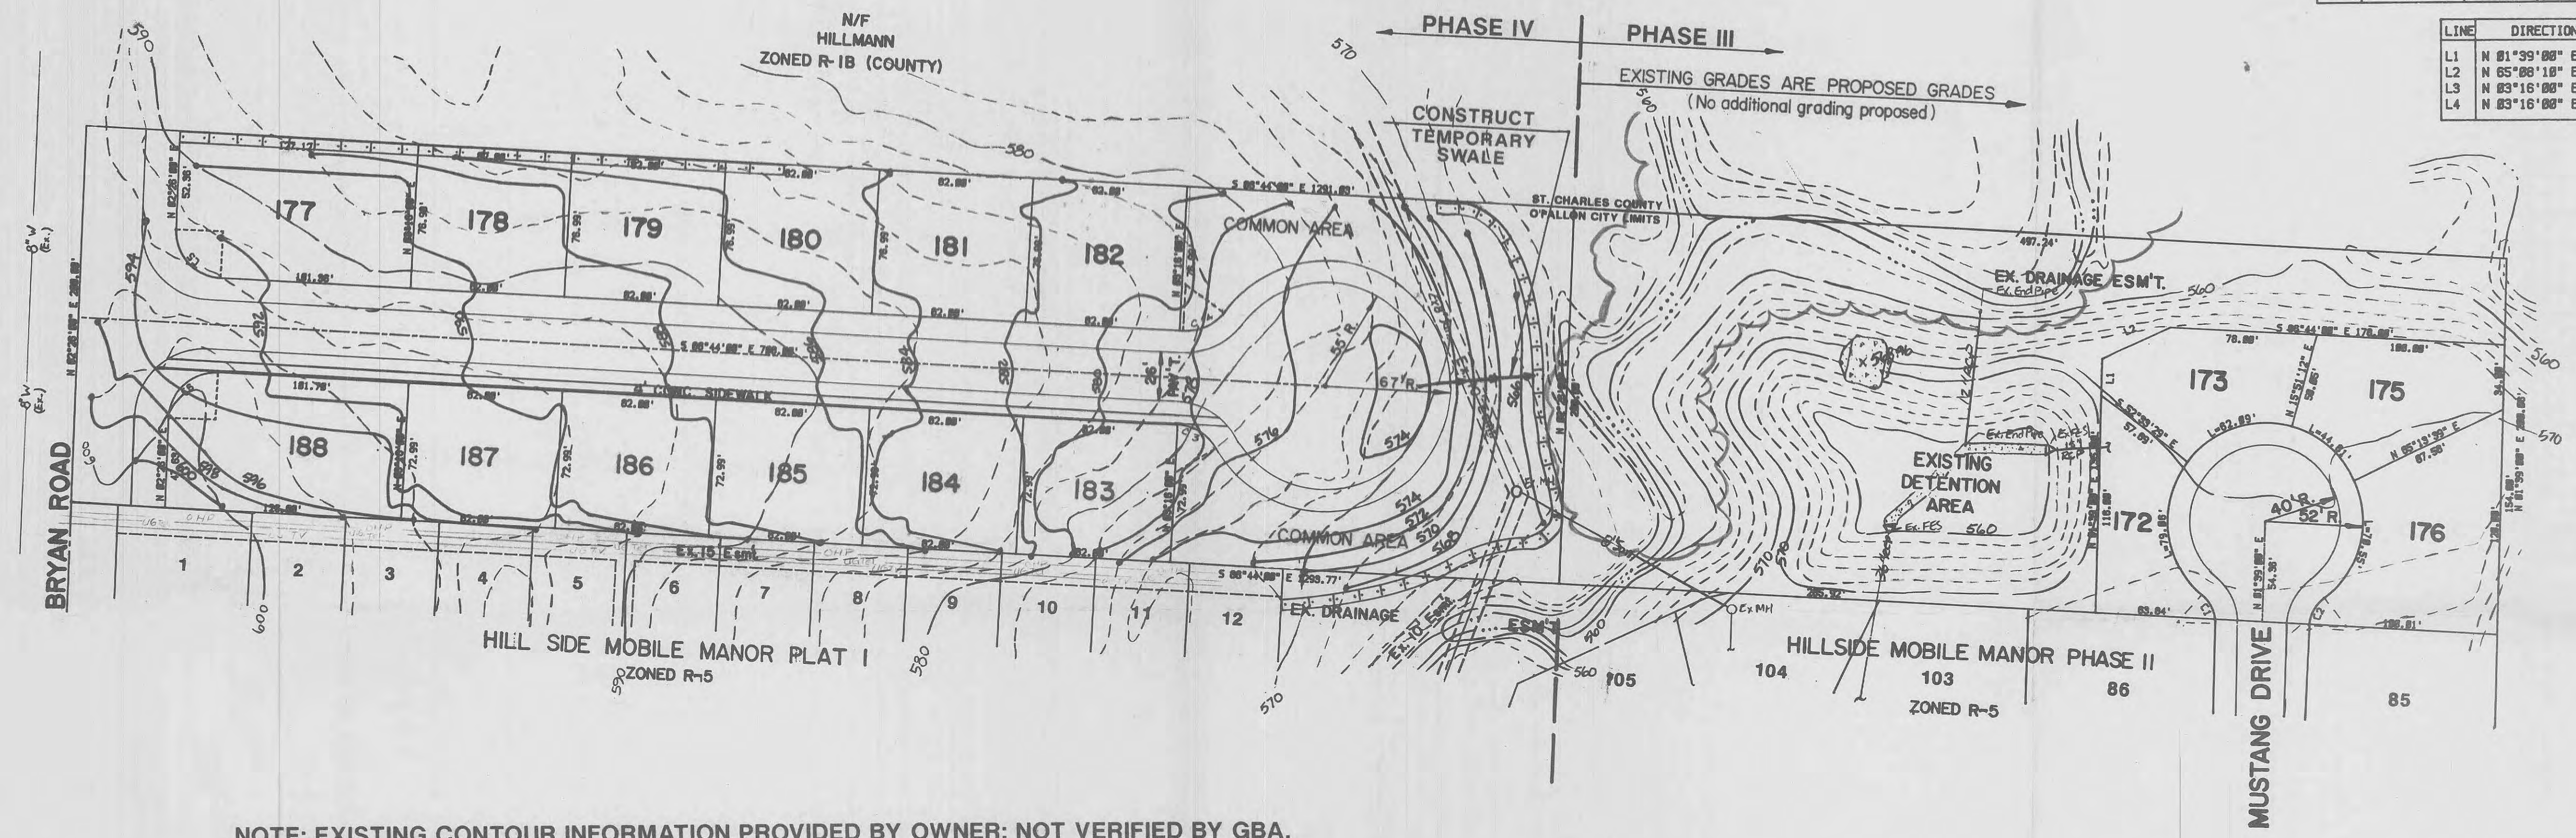

NOTE: EXISTING CONTOUR INFORMATION PROVIDED BY OWNER; NOT VERIFIED BY GBA.

GENERAL NOTES

- All filled and graded areas shall be seeded with grass within 45 days following completion of filling or grading.
- The only existing trees are located near the creek and none are proposed to be disturbed as part of the grading operation. Therefore, the Tree Protection Ordinance does not apply.
- No slope shall be steeper than 3:1.
- APPROXIMATE GRADING QUANTITIES:
C - 10,750 C.Y. F - 2860 C.Y. (Includes shrinkage)
- All existing underground utilities and services that are to remain are to be protected throughout construction.
- All construction and materials required shall conform to the City of O'Fallon standards.
- All filled places under proposed storm and sanitary sewer lines and/or paved areas shall be compacted to 90% of maximum density as determined by the Modified AASHTO T-180 Compaction Test or 95% of maximum density as determined by the Standard Proctor Test AASHTO T-99.
- All filled places in proposed roads shall be compacted from the bottom of the fill up to 90% maximum density as determined by the Modified AASHTO T-180 Compaction Test or 95% of maximum density as determined by the Standard Proctor Test AASHTO T-99. All tests shall be verified by a soils engineer concurrent with grading and backfilling operations.

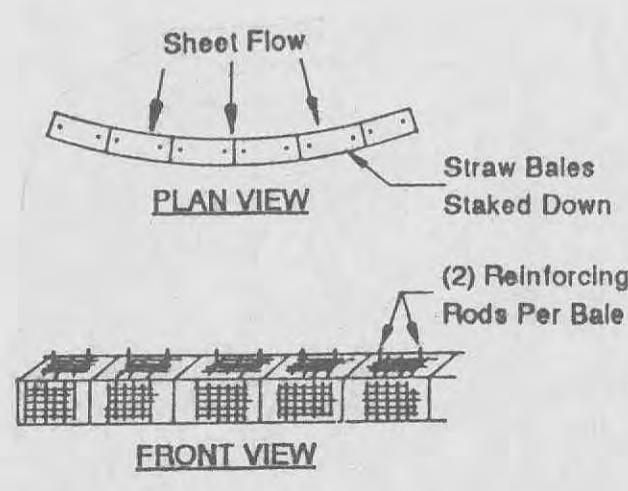

SILTATION CONTROL NOTE
Siltation Control shall be Bales of Straw placed end to end and anchored to ground with 4' long reinforcing rods.
Note: Siltation control is to be placed in all areas where a potential exists for silt to leave the construction site.
Note: Straw Bale Erosion Control to be used until vegetation is established.


STRAW BALE DETAIL
SILTATION CONTROL DETAIL
N.T.S.

FILE COPY
APPROVED
8-4-92
Frank Godwin



EXISTING GRADE
PROPOSED GRADE

Hillside Manor
Mobile Home

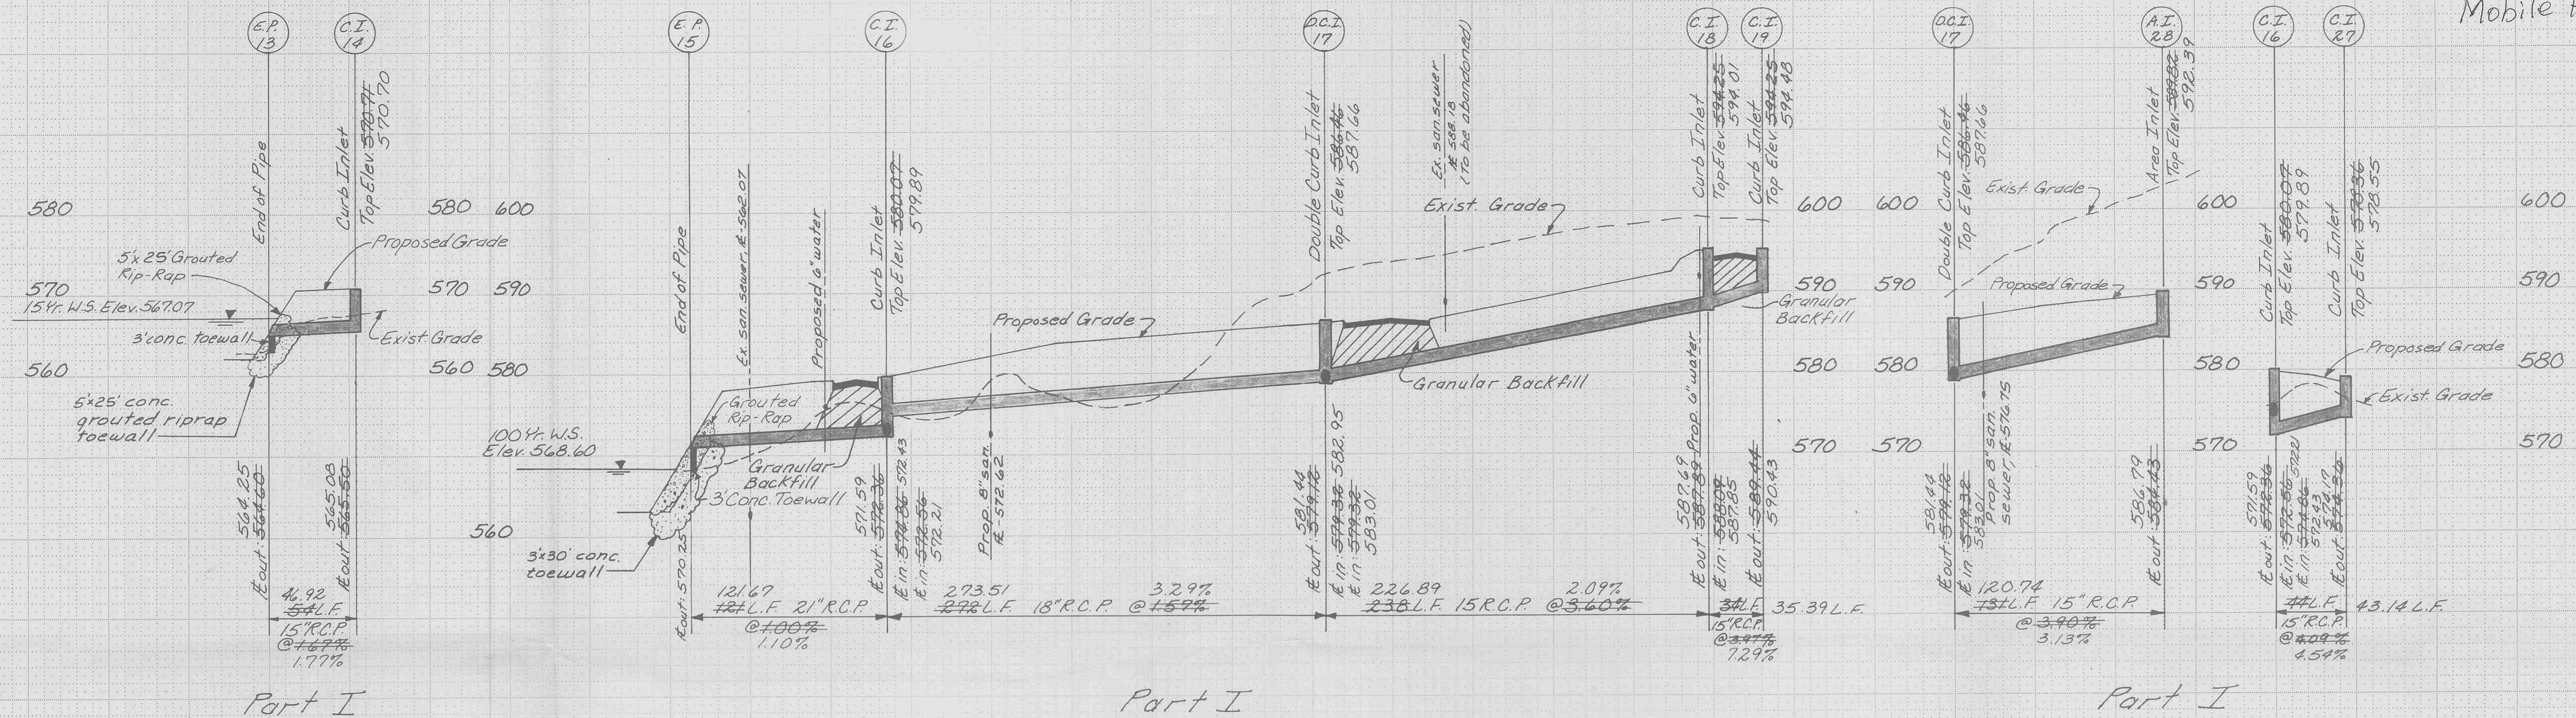

Detention Basin Calculations

Area of Hillside 25.75 Ac.
Area of Warehouse 3.90 Ac. - Current Ph. IV
29.65 Ac.

Undeveloped PI Factor = 2.31 (25 Year Storm)
Allowable discharge = 2.31 x 29.65 = 68.45 c.f.s.

Now find PI Factor for Hillside
Each lot is 6250 s.f. to the centerline of the street.

Trailer Pad	75'x14'	1050 s.f.
Shed Pad	10'x10'	100 s.f.
Patio	20'x10'	200 s.f.
Driveway	30'x20'	600 s.f.
Street	13'x50'	650 s.f.
Sidewalk	2'x50'	100 s.f.
		2700 s.f.

2700 = 43%
6250

Therefore, each lot will be approximately 43% impervious.

Now find PI Factor for Hillside

100% impervious	PI = 4.75 (25 Year)
5% impervious	PI = 2.31 (25 Year)

PI = 3.26

25 Year Discharge = (3.26x25.75) + (4.75x3.90) = 102.47 c.f.s.
(Developed Runoff).

Required Storage Volume = (102.47-68.45)1800 = 61,236 cu. ft.

25 Year Runoff tributary to detention basin

Q = 45.85 x 3.26 = 45.29 c.f.s.
3.30

Flow stored = 102.47-68.45 = 34.02 c.f.s.
Therefore we can release 45.29-34.02 = 11.27 c.f.s.

Stage vs. Storage

Elevation	Sq. In.	Sq. Ft.	Cu. Ft.	Storage Volume
570	7.80	19500	18688	121,317
569		17875	17063	102,629
568	6.50	16250	15407	85,566
567		14563	13719	70,169
566	5.15	12875	12188	56,440
565		11500	10813	44,252
564	4.05	10125	9500	33,439
563		8875	8250	23,939
562	3.05	7625	7063	15,689
561		6500	5938	8,626
560	2.15	5375	4938	2,688
559		0	0	0

Therefore, we are voluntarily storing an additional
11.27 - 10.44 = 0.83 c.f.s.

This will adjust our storage volume and 25 Year Water
Surface Elevation.

Elev. (Stage)	Cu. Ft. (Volume)
567	70,159
x	62,730
566	56,440
	6290 = 0.46
	13719

Revised 25 Year W.S. Elev. = 566.46

How check outfall pipe FE-1 to EP-2
Available Head = 566.46 - 558.70 - 1/2 = 7.26'

Q = .62 (.785) √(2)(32.2)(7.26) = 10.52 c.f.s.
10.52 c.f.s. ≈ 10.44 c.f.s.


Therefore no further adjustments are needed.

Now design 100 Year Emergency Spillway

25 Year Inflow = 45.29 c.f.s.
100 Year Inflow = 1.2777 x 45.29 = 57.83 c.f.s.

Place weir at 25 Year elevation at 566.46

A 20 foot wide flat bottom weir with 3:1 side slopes will allow
73 c.f.s. of flow with 1 foot of head. Our 100 Year flow is
57.83 c.f.s., therefore our weir design is adequate.

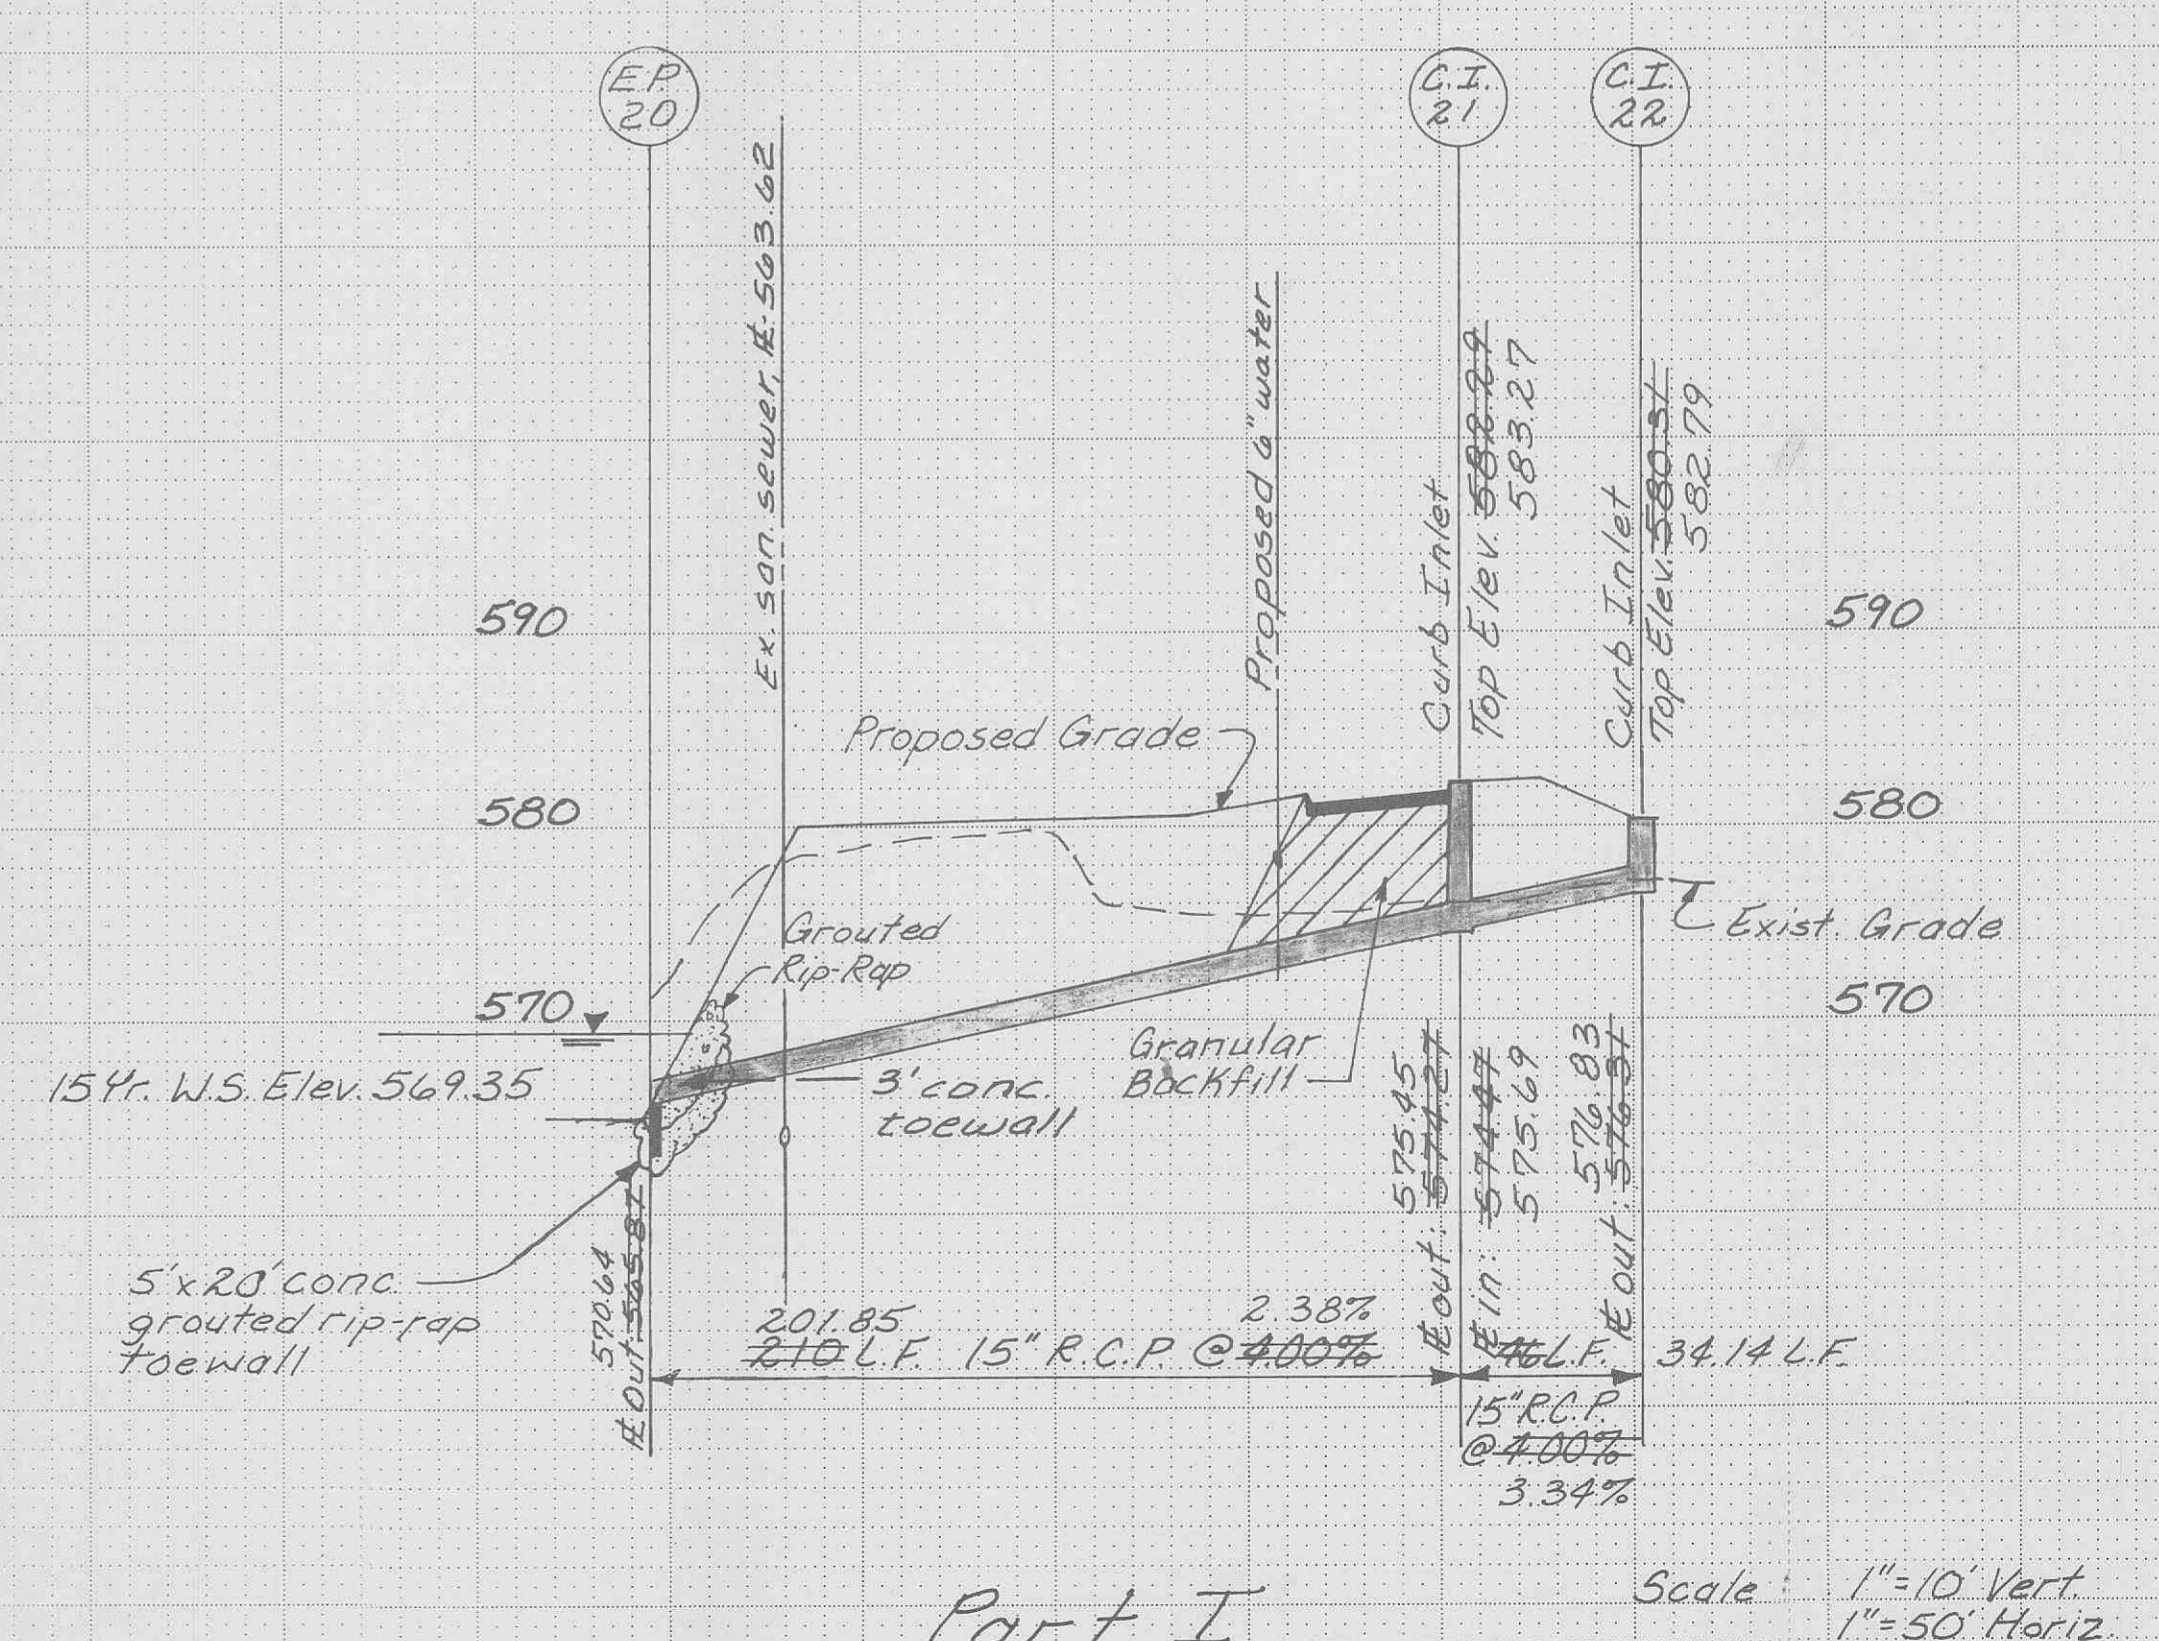

Part I
Scale: 1"=10' Vert.
1"=50' Horiz.
As Constructed 10-21-88 S.A.S.