



# AS-BUILT HILLMANN PLACE - PHASE 1

## O'FALLON, ST. CHARLES COUNTY, MISSOURI

APRIL 27, 2012

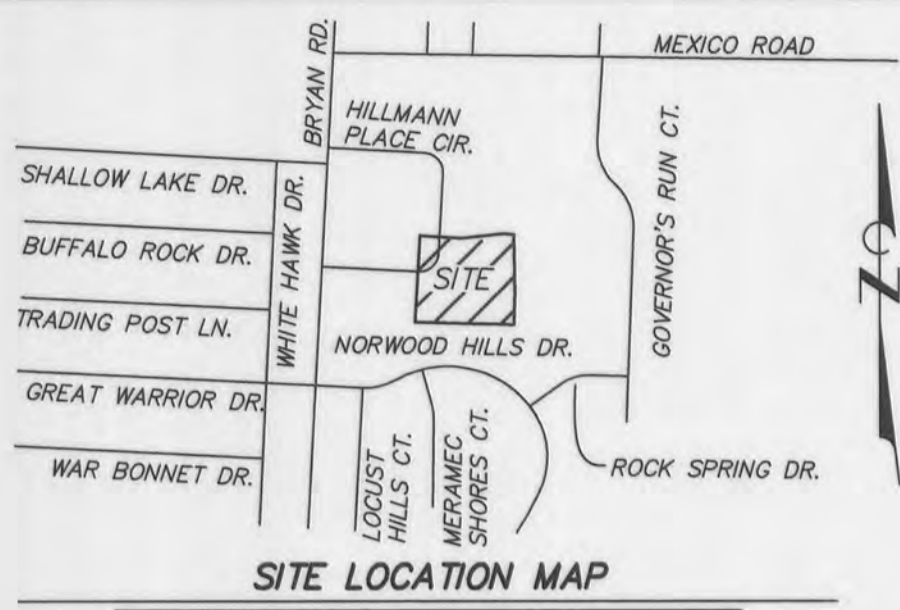


BENCH MARK

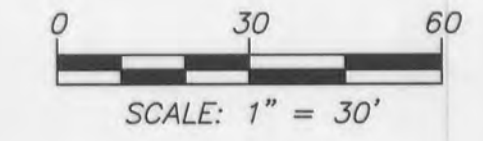

BM - A 600 NAIL IN POWER POLE AT THE NORTHWEST CORNER OF FIESE ROAD AND BRYAN ROAD AS SHOWN ON IMPROVEMENT PLANS FOR FIESE ROAD, O'FALLON PROJECT NO.210-005, AS PREPARED BY GEORGE BUTLER ASSOCIATES. ELEVATION = 643.21

TBM - CHISELED SQUARE ON THE SOUTHWEST CORNER OF CONCRETE TRANSFORMER PAD LOCATED NEAR THE NORTHWEST CORNER OF SURVEYED TRACT. ELEVATION = 620.57

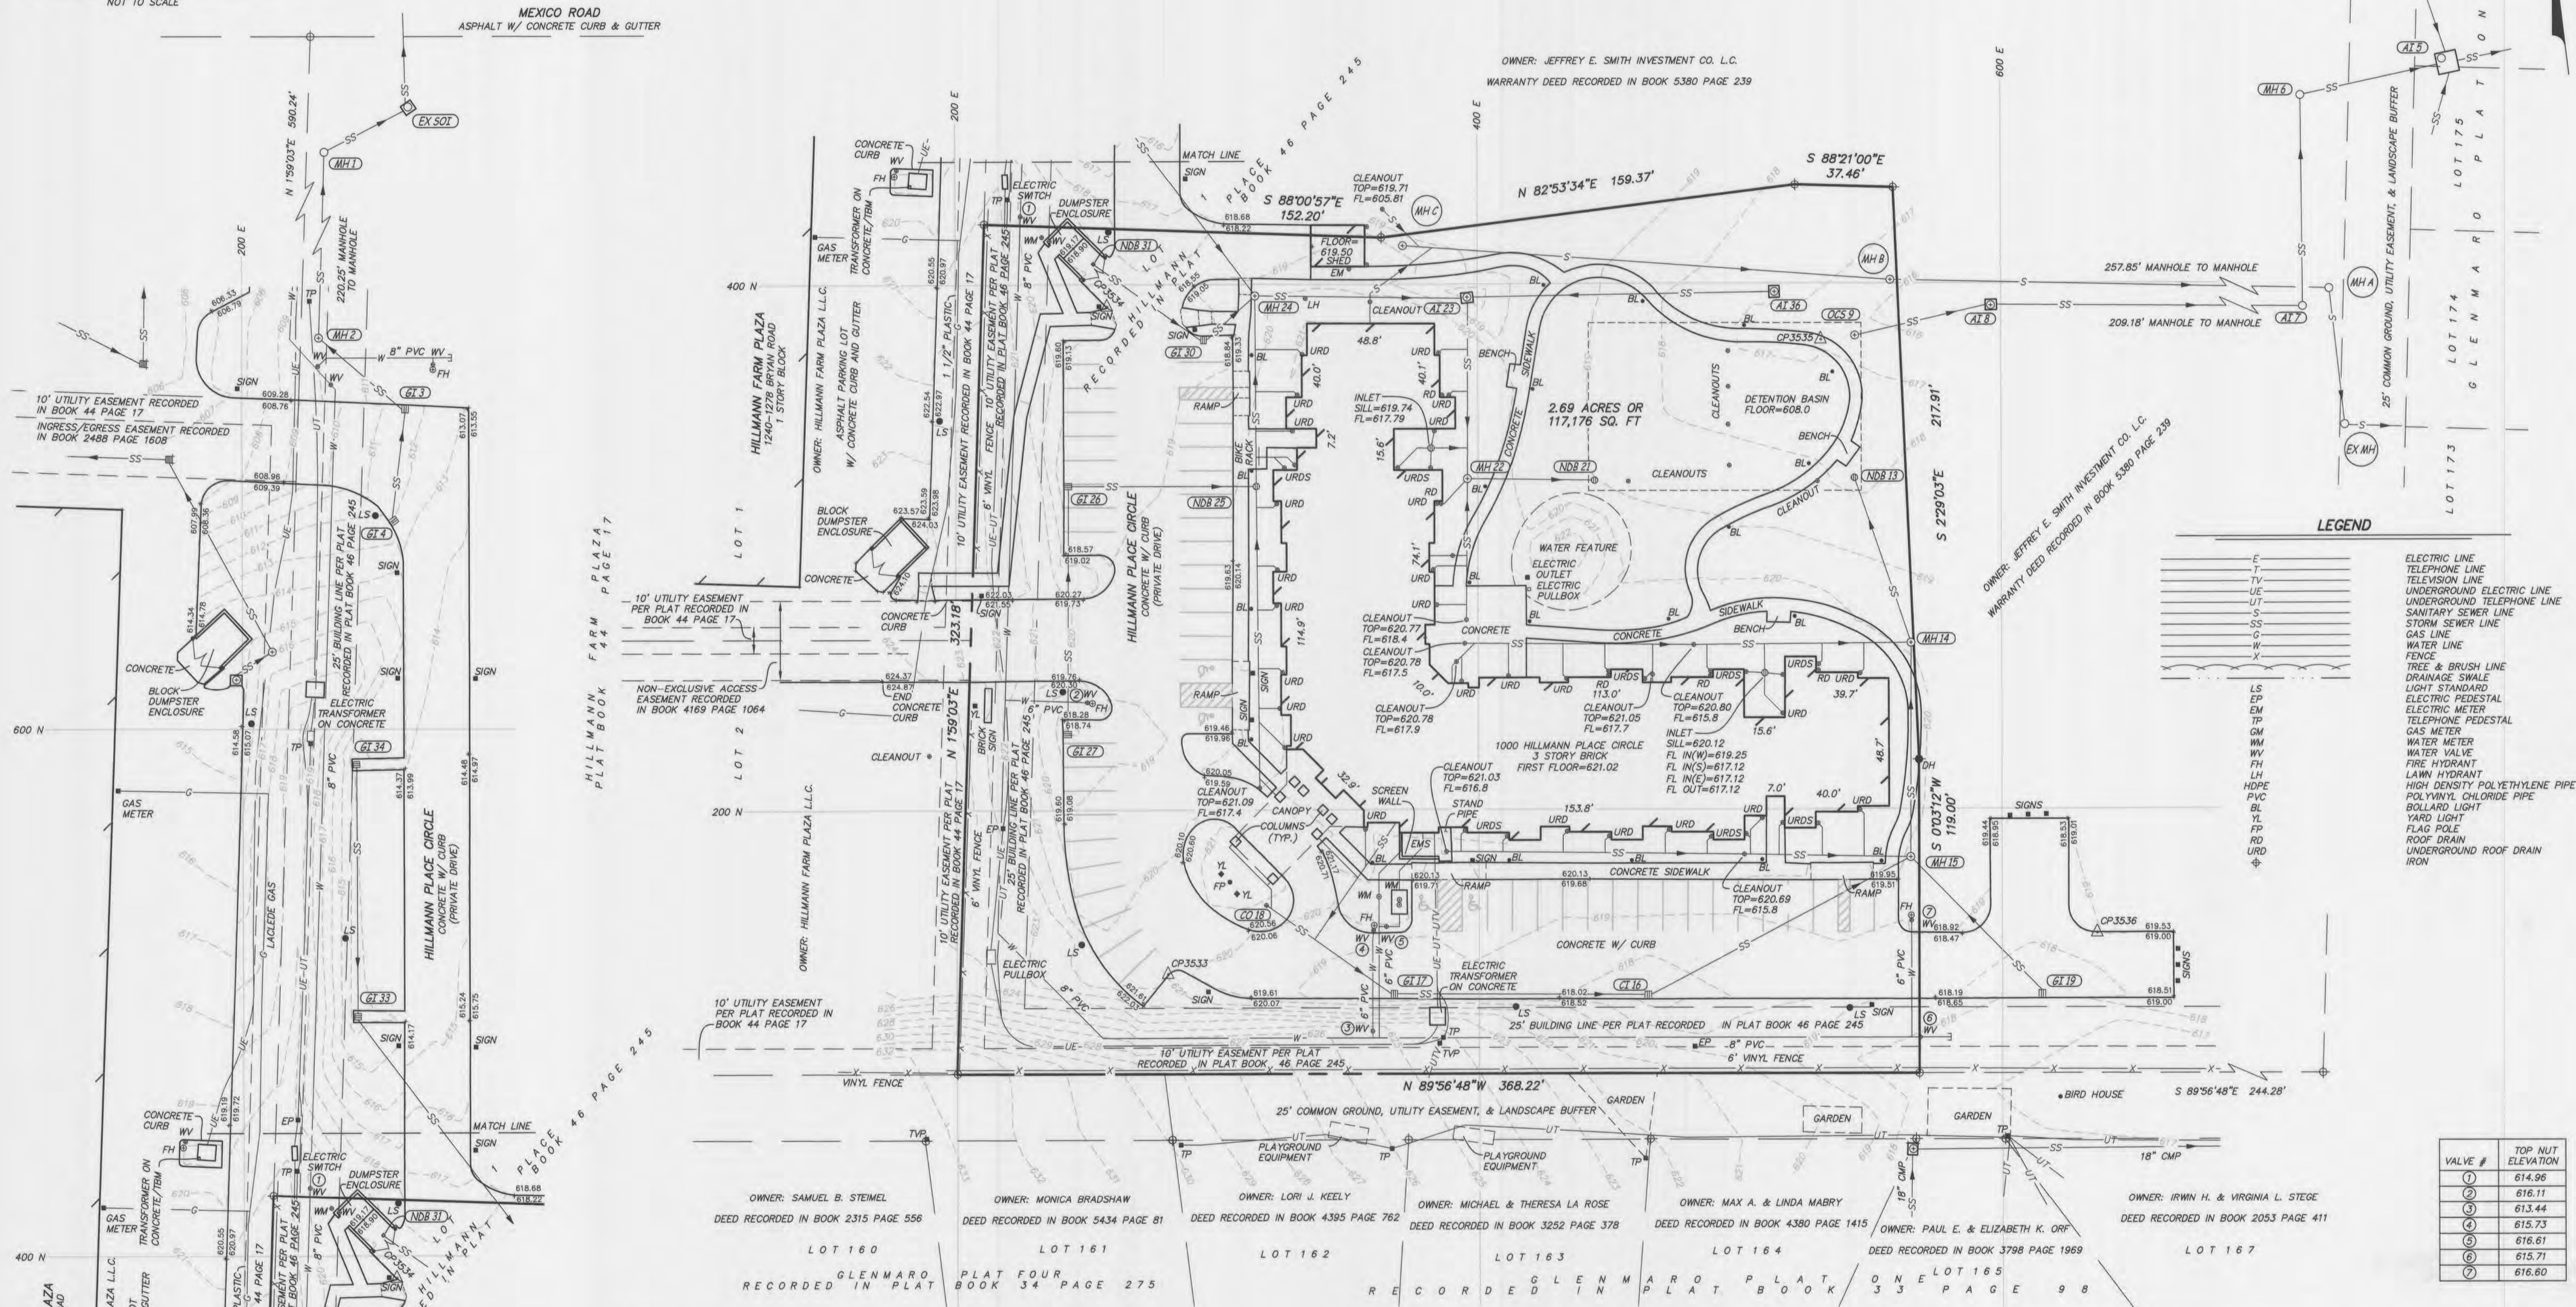

**LEGEND**

E	ELECTRIC LINE
T	TELEPHONE LINE
TV	TELEVISION LINE
UE	UNDERGROUND ELECTRIC LINE
UL	UNDERGROUND TELEPHONE LINE
US	SANITARY SEWER LINE
SS	STORM SEWER LINE
G	GAS LINE
W	WATER LINE
X	FENCE
LS	TREE & BRUSH LINE
EP	DRAINAGE SWALE
EM	LIGHT STANDARD
TP	ELECTRIC PEDESTAL
GM	ELECTRIC METER
WM	TELEPHONE PEDESTAL
WH	GAS METER
FW	WATER METER
LV	WATER VALVE
LH	FIRE HYDRANT
HP	LAWN HYDRANT
HDPE	HIGH DENSITY POLYETHYLENE PIPE
PVC	POLYVINYL CHLORIDE PIPE
BL	BOLLARD LIGHT
YL	YARD LIGHT
FP	FLAG POLE
RD	ROOF DRAIN
URD	UNDERGROUND ROOF DRAIN
IR	IRON

**SURVEY CONTROL POINTS**

POINT NUMBER	NORTH	EAST	ELEVATION	DESCRIPTION
OP3533	137.85	281.03	621.02	DRILL HOLE
OP3534	391.61	238.28	619.25	DRILL HOLE
OP3535	378.54	531.24	618.90	DRILL HOLE
OP3536	152.94	636.30	618.97	DRILL HOLE

**UTILITY NOTES**

WATER	GAS	TELEVISION	STORM SEWER
CITY OF O'FALLON 100 N MAIN ST. O'FALLON, MO 63366 CONTACT: KENT THAEMERT 314-522-2297 AS SHOWN	LAACLEDE GAS 6400 GRAHAM ROAD ST. LOUIS, MO 63134 CONTACT: JOHN GRANT 636-387-6642 AS SHOWN	CHARTER COMMUNICATIONS 815 CHARTER COMMONS DRIVE TOWN AND COUNTRY, MO 63017 CONTACT: JOHN GRANT 636-387-6642 AS SHOWN	CITY OF O'FALLON 100 N MAIN ST. O'FALLON, MO 63366 CONTACT: KENT THAEMERT 314-522-2297 AS SHOWN
AMEREN UE 200 CALLAHAN ROAD WENTZVILLE, MO 63386 CONTACT: JOHN CLARK 636-639-8312 AS SHOWN	CENTURYLINK 1151 CENTURYLINK DRIVE, BLDG A WENTZVILLE, MO 63386 CONTACT: MICHELE GERTEISEN 636-332-7392 AS SHOWN	CITY OF O'FALLON 100 N MAIN ST. O'FALLON, MO 63366 CONTACT: KENT THAEMERT 314-522-2297 AS SHOWN	NOTE: LOCATION OF IRRIGATION LINES AND UNDERGROUND ELECTRIC LINES TO LIGHT STANDARDS NOT SHOWN.

STATE OF MISSOURI  
FREDERICK E. CARROZ III  
PROFESSIONAL LAND SURVEYOR  
PLS - 2008016655


**HILLMANN PLACE - PHASE 1**  
O'FALLON, ST. CHARLES COUNTY, MISSOURI

Engineering Surveys & Services  
1113 Fay Street  
Columbia, Missouri  
573-449-2646  
Missouri Land Surveying Corporation # 2004004672


Surveyed: NTL	Checked: FEC	Scale: 1" = 30'	Date: APRIL 27, 2012	Job: 11936	Sheet: 1 of 3
---------------	--------------	-----------------	----------------------	------------	---------------

**VALVE # TOP NUT ELEVATION**


1	614.96
2	616.11
3	613.44
4	615.73
5	616.61
6	615.71
7	616.60

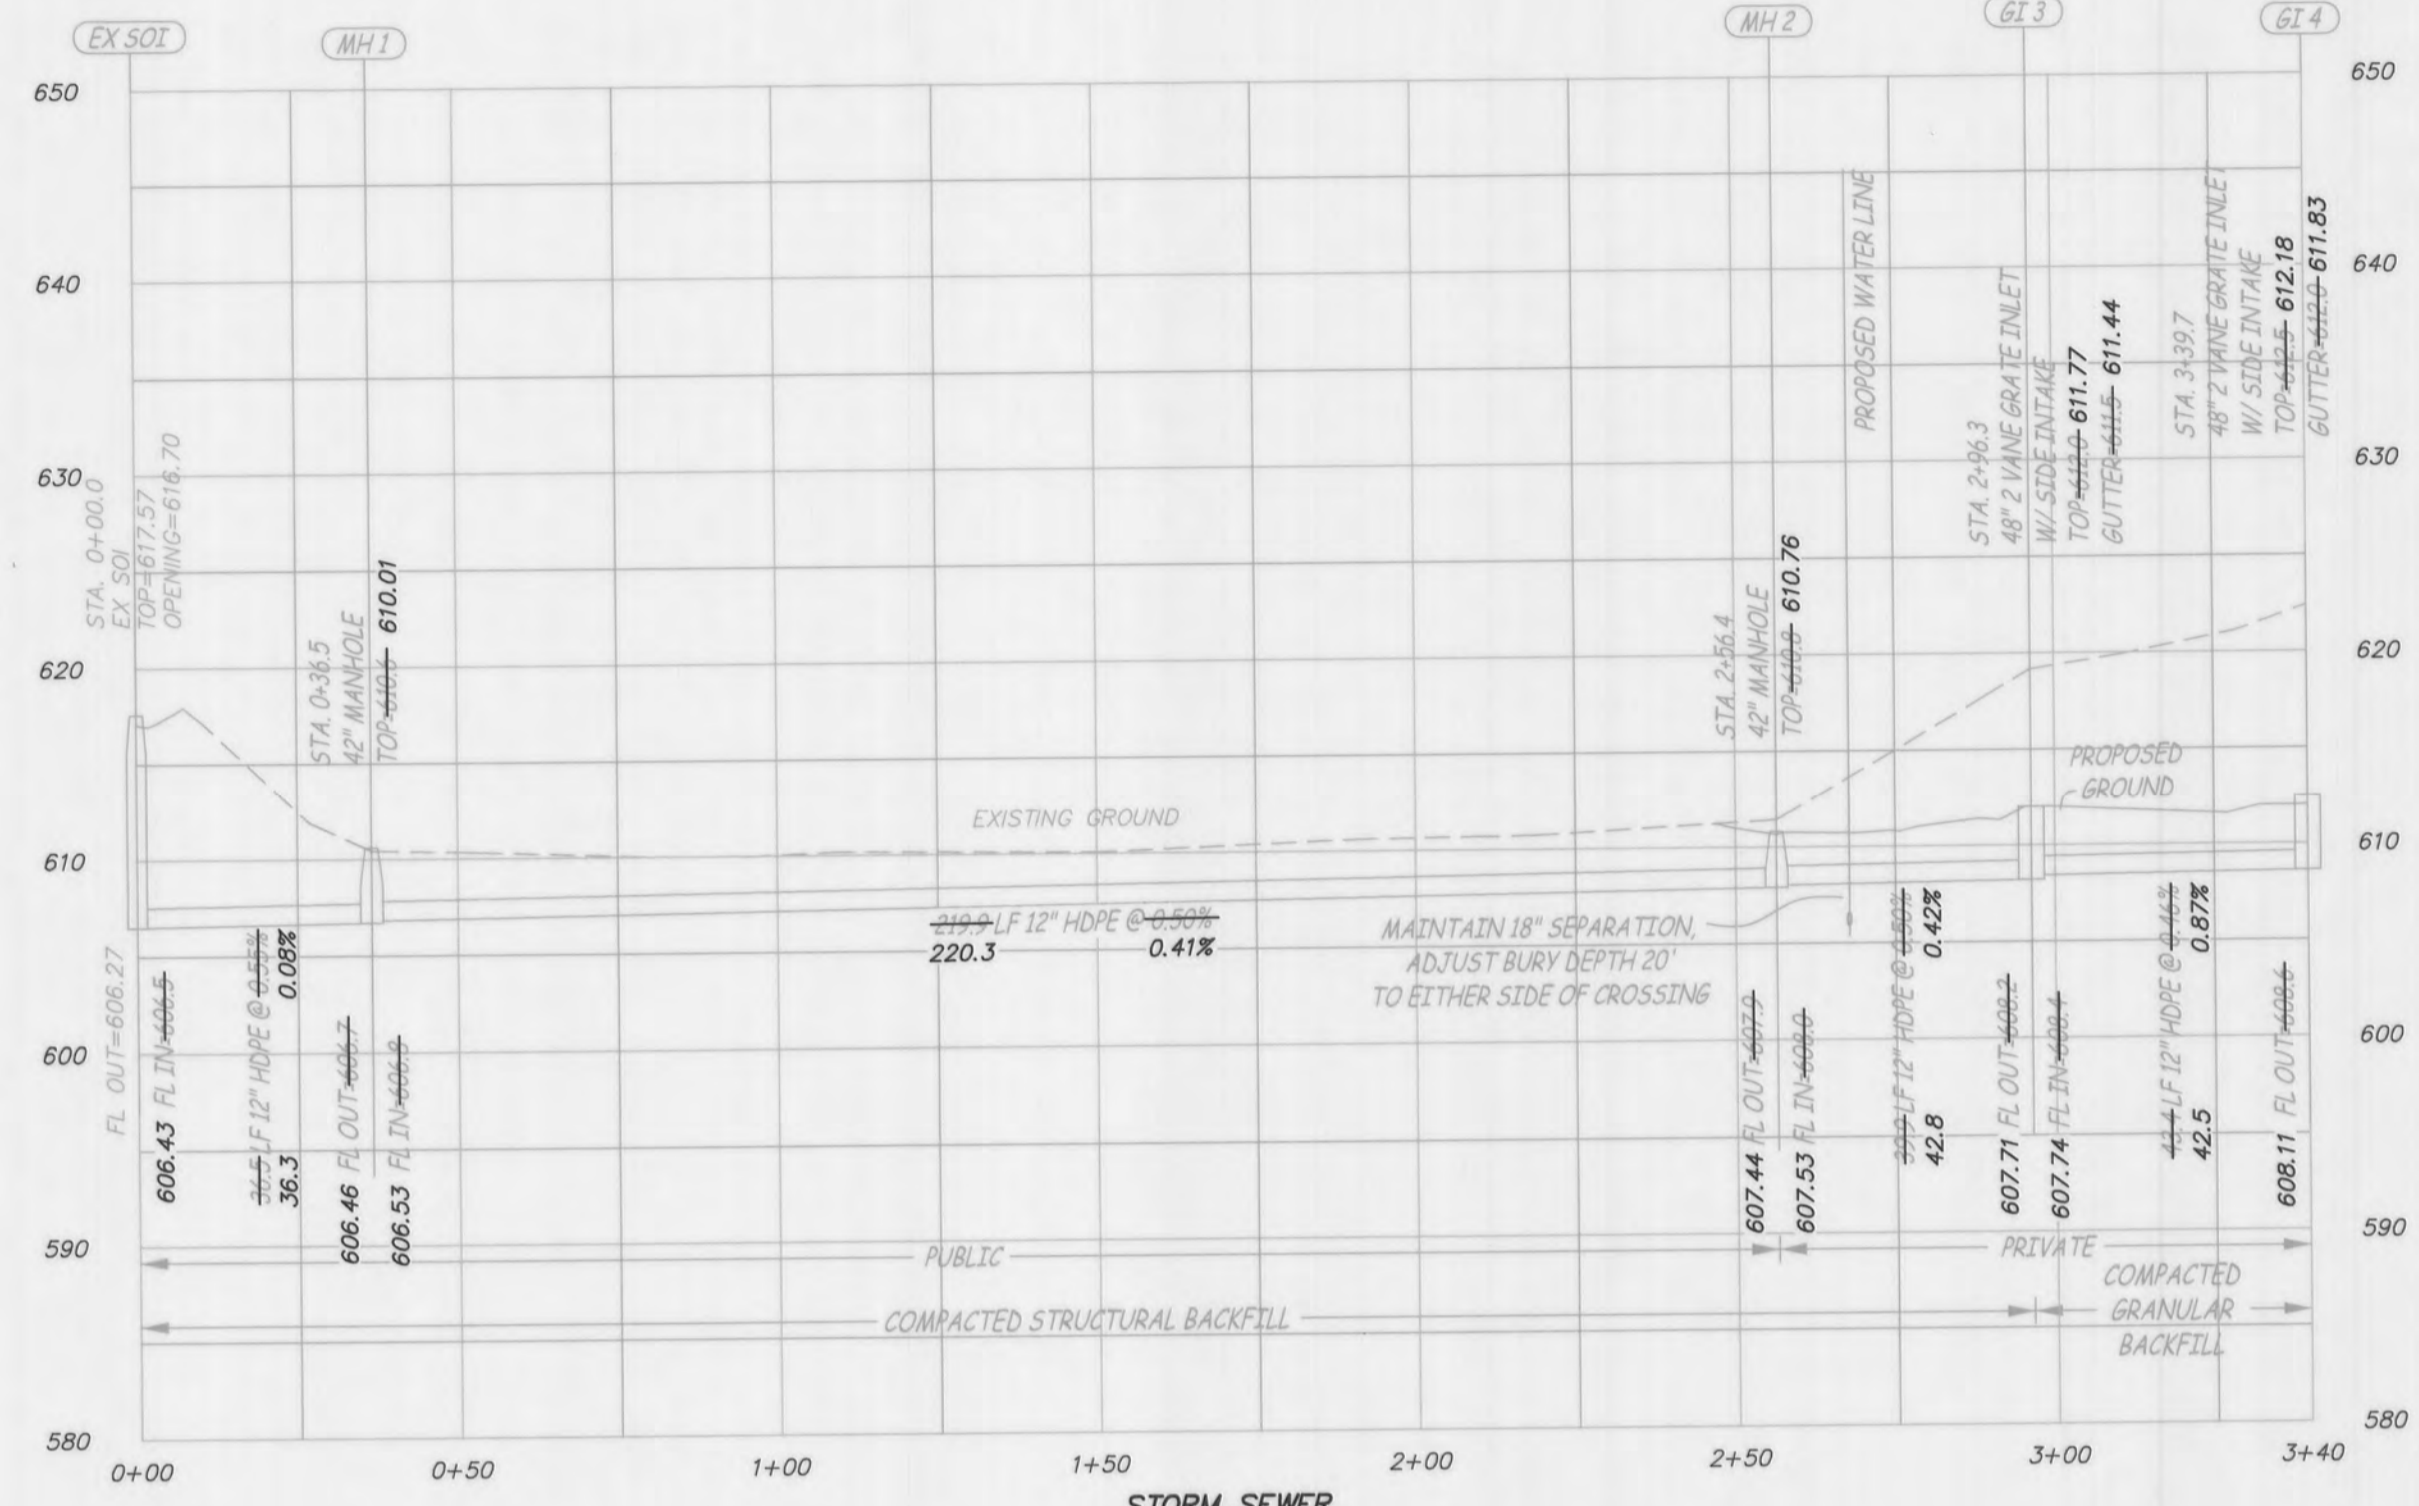

STORM SEWER  
EX SOL THRU GI 4  
SCALE - HORIZ. 1" = 30'  
VERT. 1" = 10'

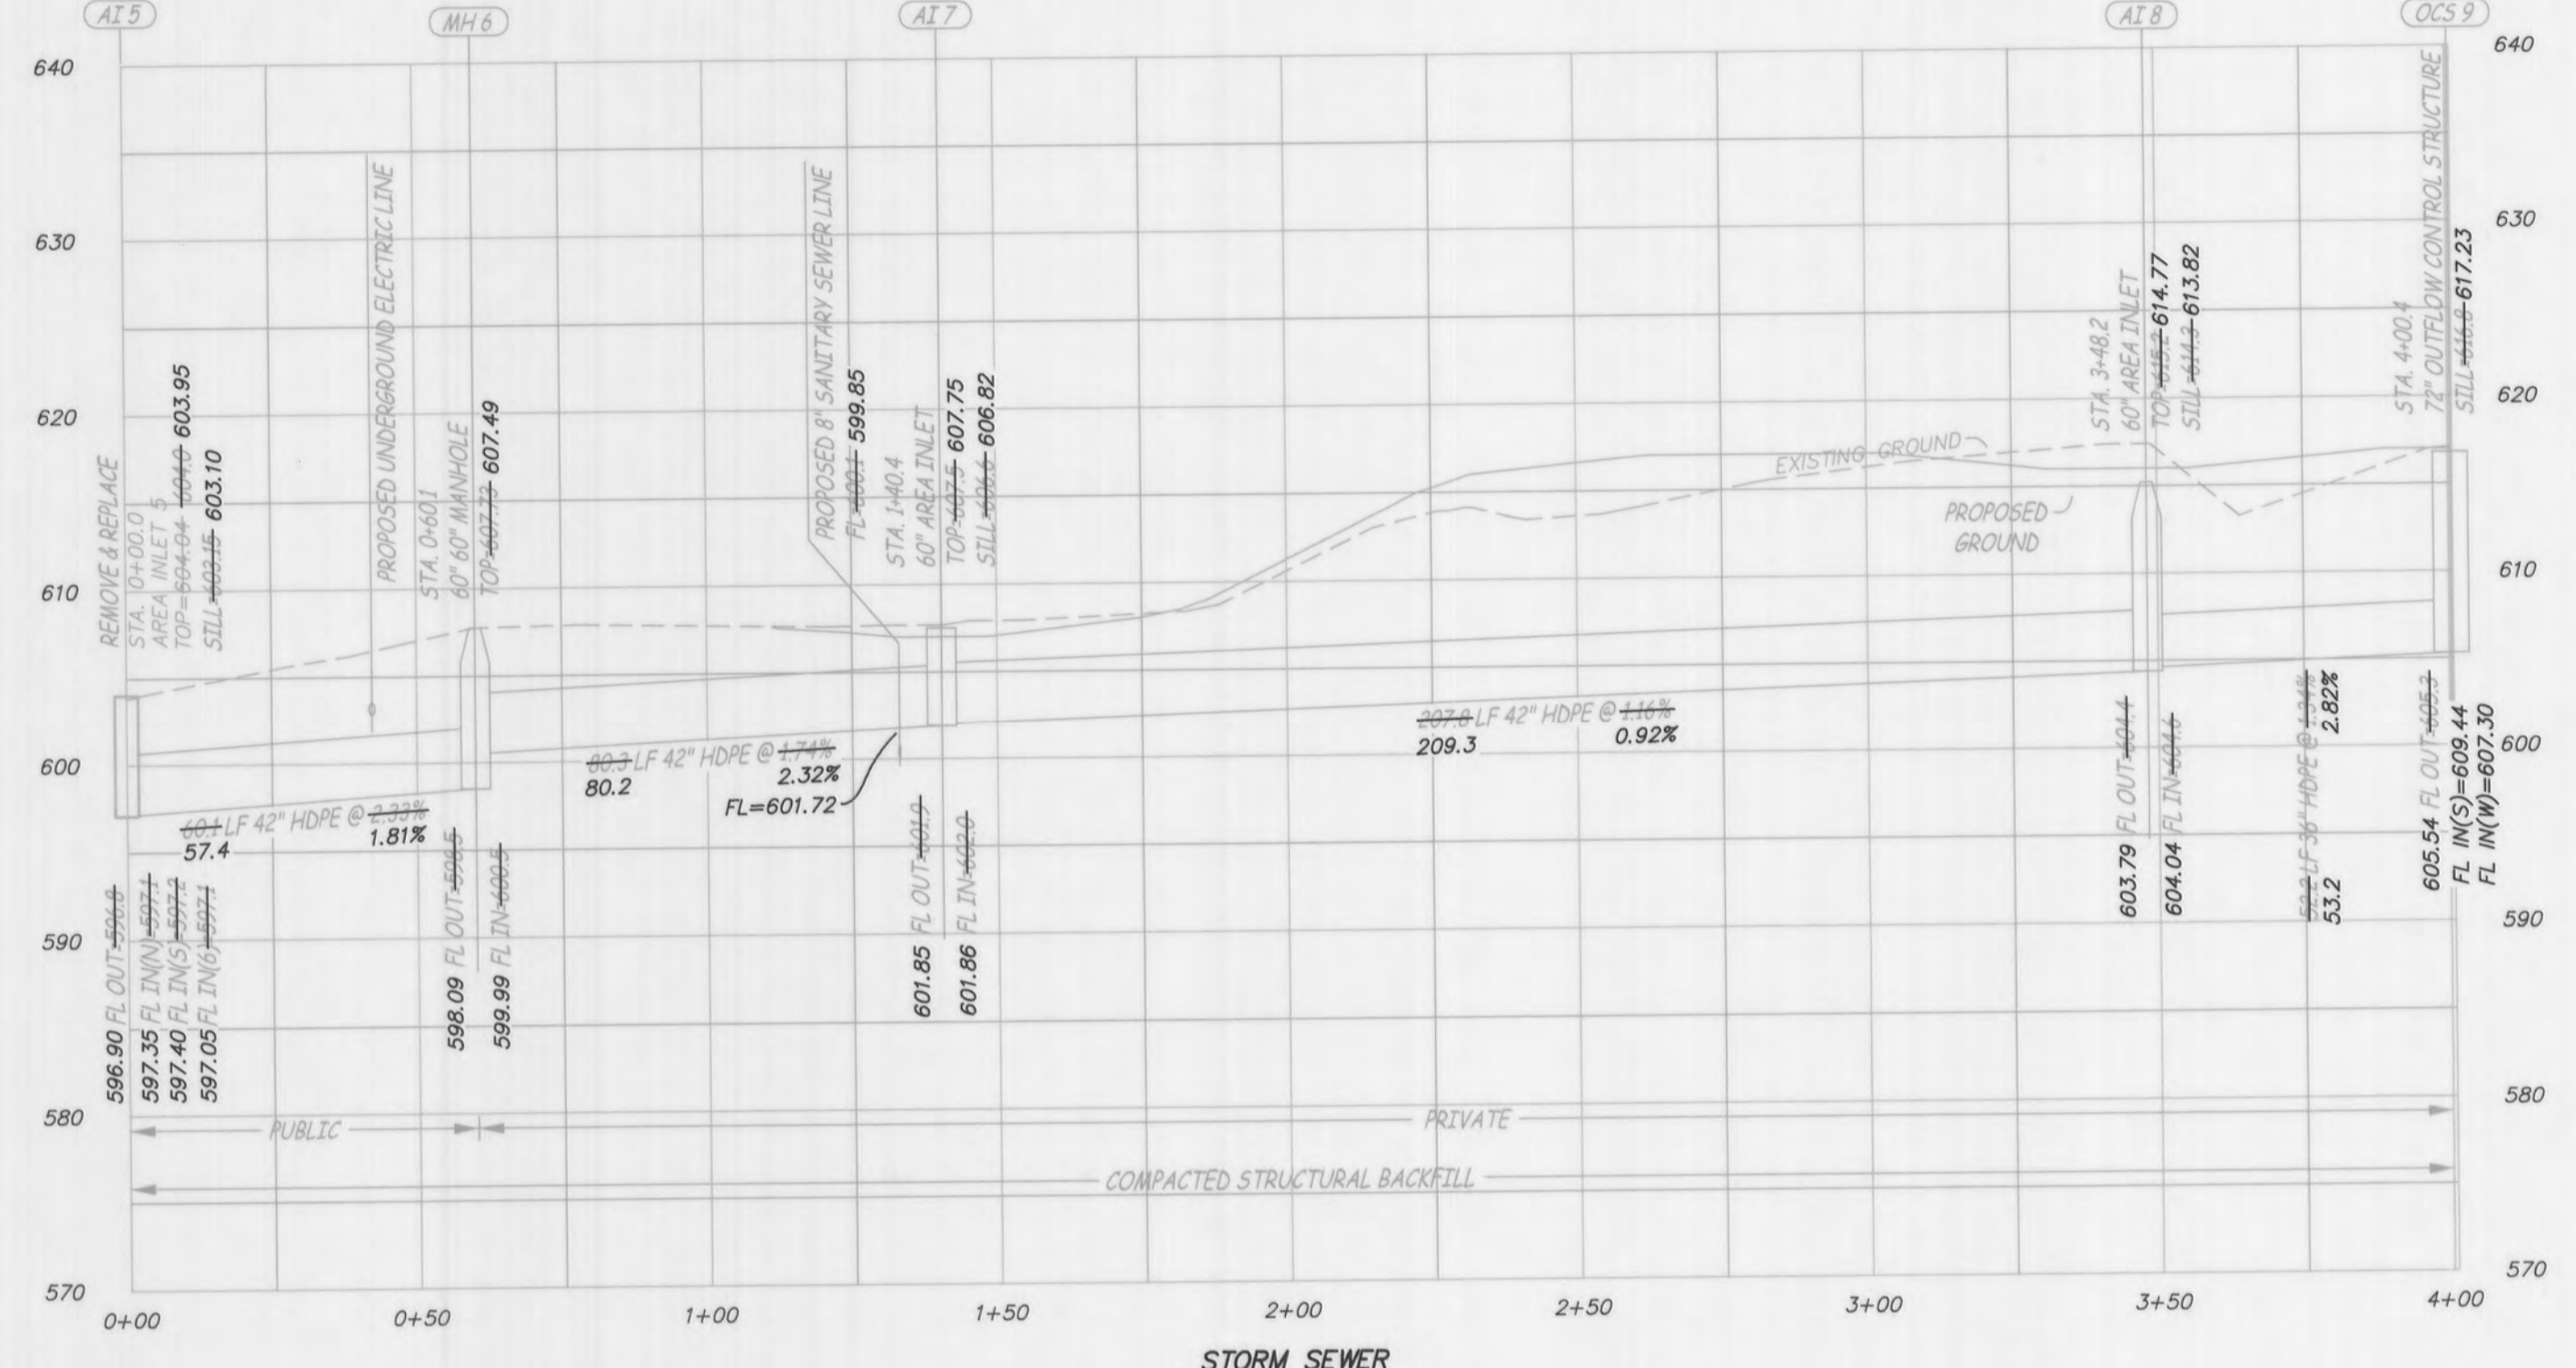

STORM SEWER  
MH 10 THRU OCS 9  
SCALE - HORIZ. 1" = 30'  
VERT. 1" = 10'

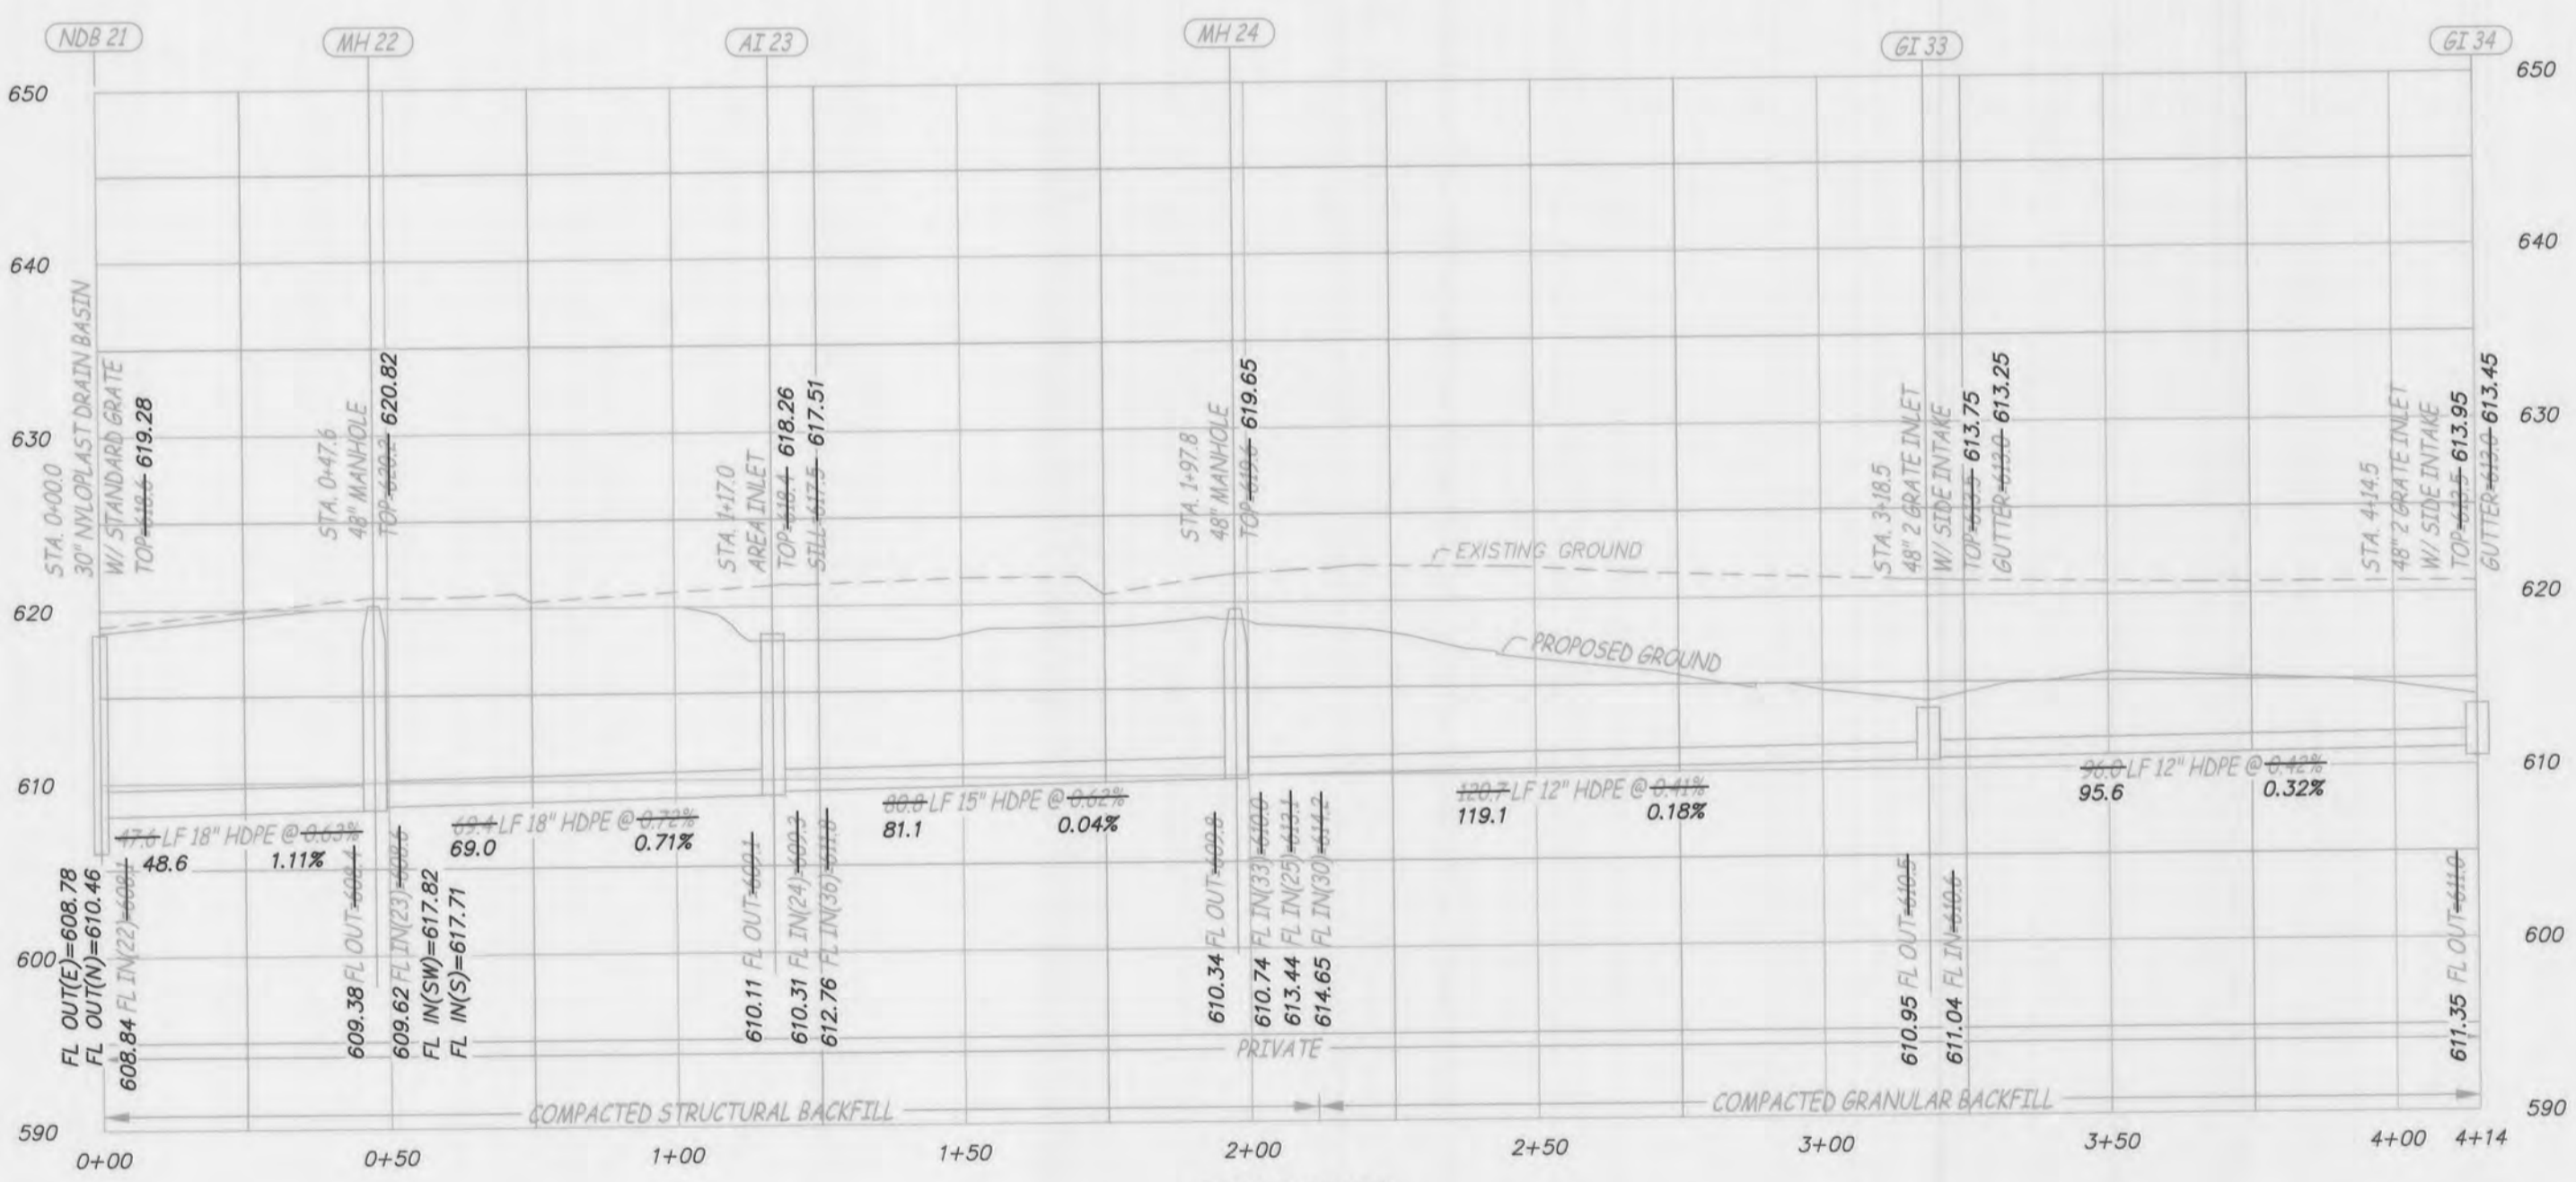


STORM SEWER  
NDB 21 THRU GI 34  
SCALE - HORIZ. 1" = 30'  
VERT. 1" = 10'




STORM SEWER  
MH 24 THRU GI 27  
SCALE - HORIZ. 1" = 30'  
VERT. 1" = 10'

STORM SEWER  
MH 15 THRU GI 19  
SCALE - HORIZ. 1" = 30'  
VERT. 1" = 10'


		SEWER AS-BUILT PROFILES	
		HILLMANN PLACE - PHASE 1	
OFALLON, ST. CHARLES COUNTY, MISSOURI		Surveyed: NTL Drawn: RTM Checked: FEC	Revised:
Engineering Surveys & Services 1113 Fay Street Columbia, Missouri 573 - 449 - 2646 Missouri Land Surveying Corporation # 2004004672		Scale: HORIZ. 1" = 30' VERT. 1" = 10'	Date: APRIL 27, 2012 Job: 11936 Sheet: 2 of 3

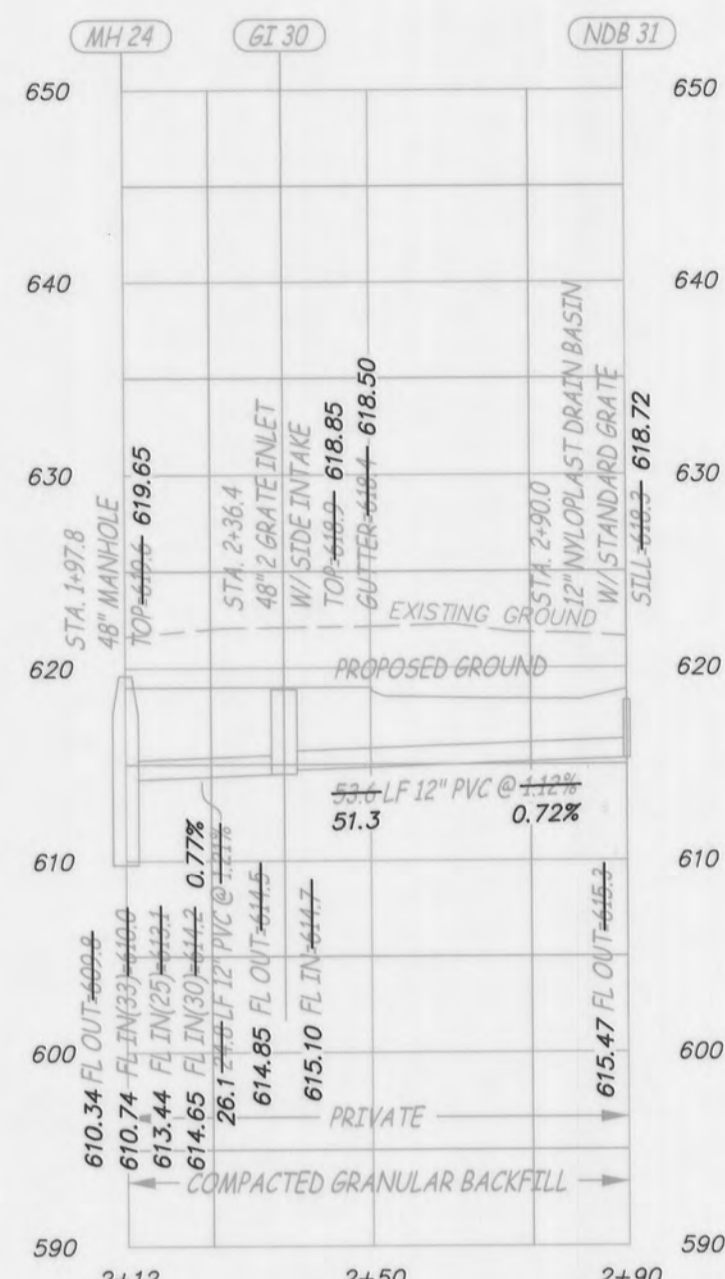


**STORM SEWER  
MH 24 THRU NDB 31**  
SCALE - HORIZ. 1" = 30'  
VERT. 1" = 10'

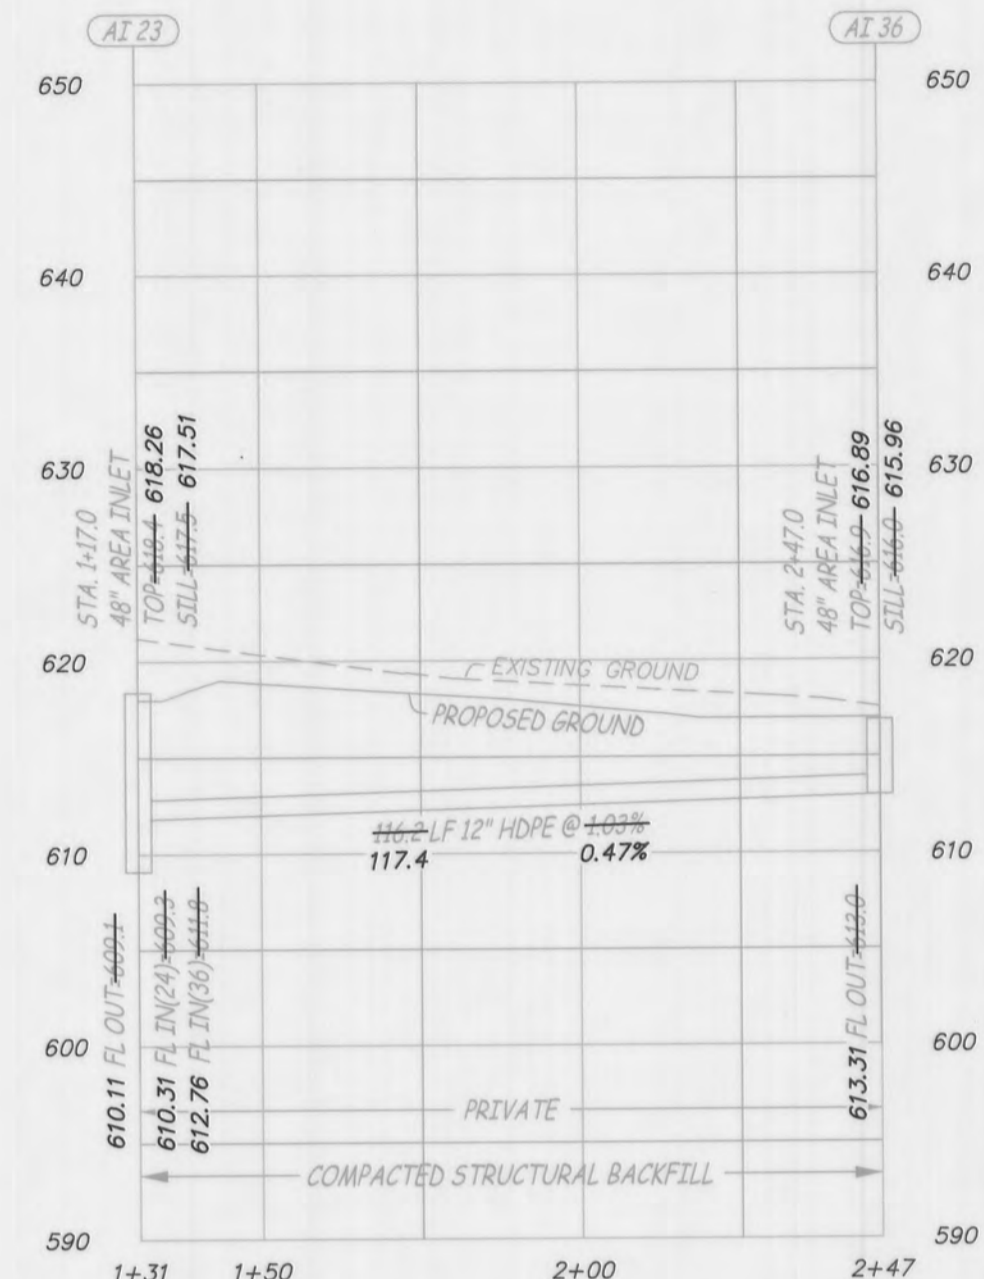

**STORM SEWER  
AI 23 THRU AI 36**  
SCALE - HORIZ. 1" = 30'  
VERT. 1" = 10'

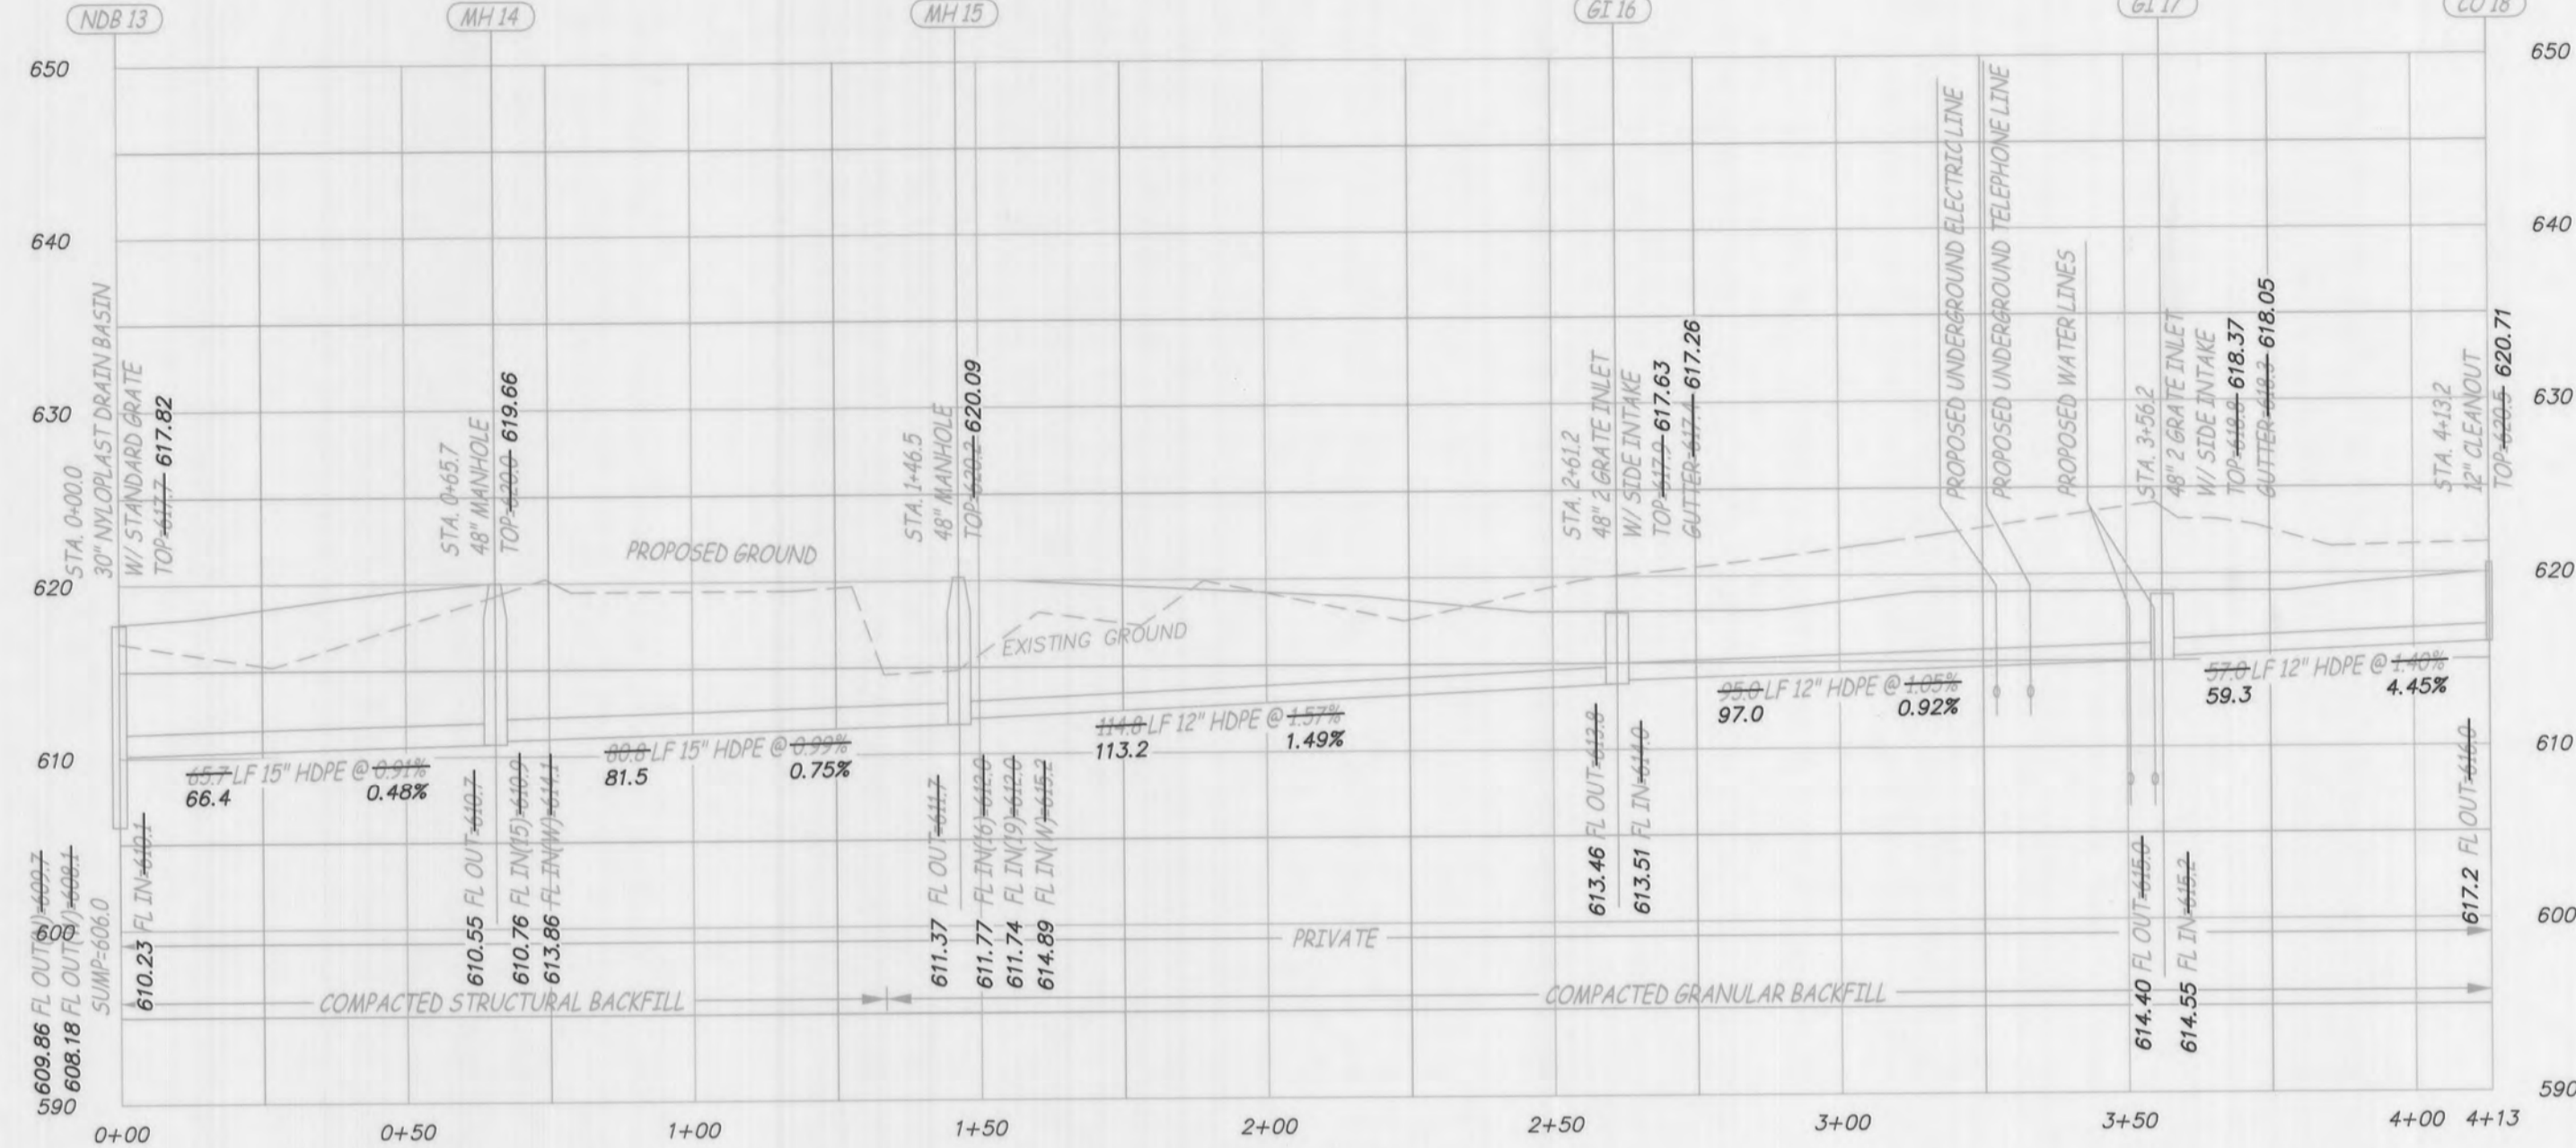

**STORM SEWER  
NDB 13 THRU GI 18**  
SCALE - HORIZ. 1" = 30'  
VERT. 1" = 10'

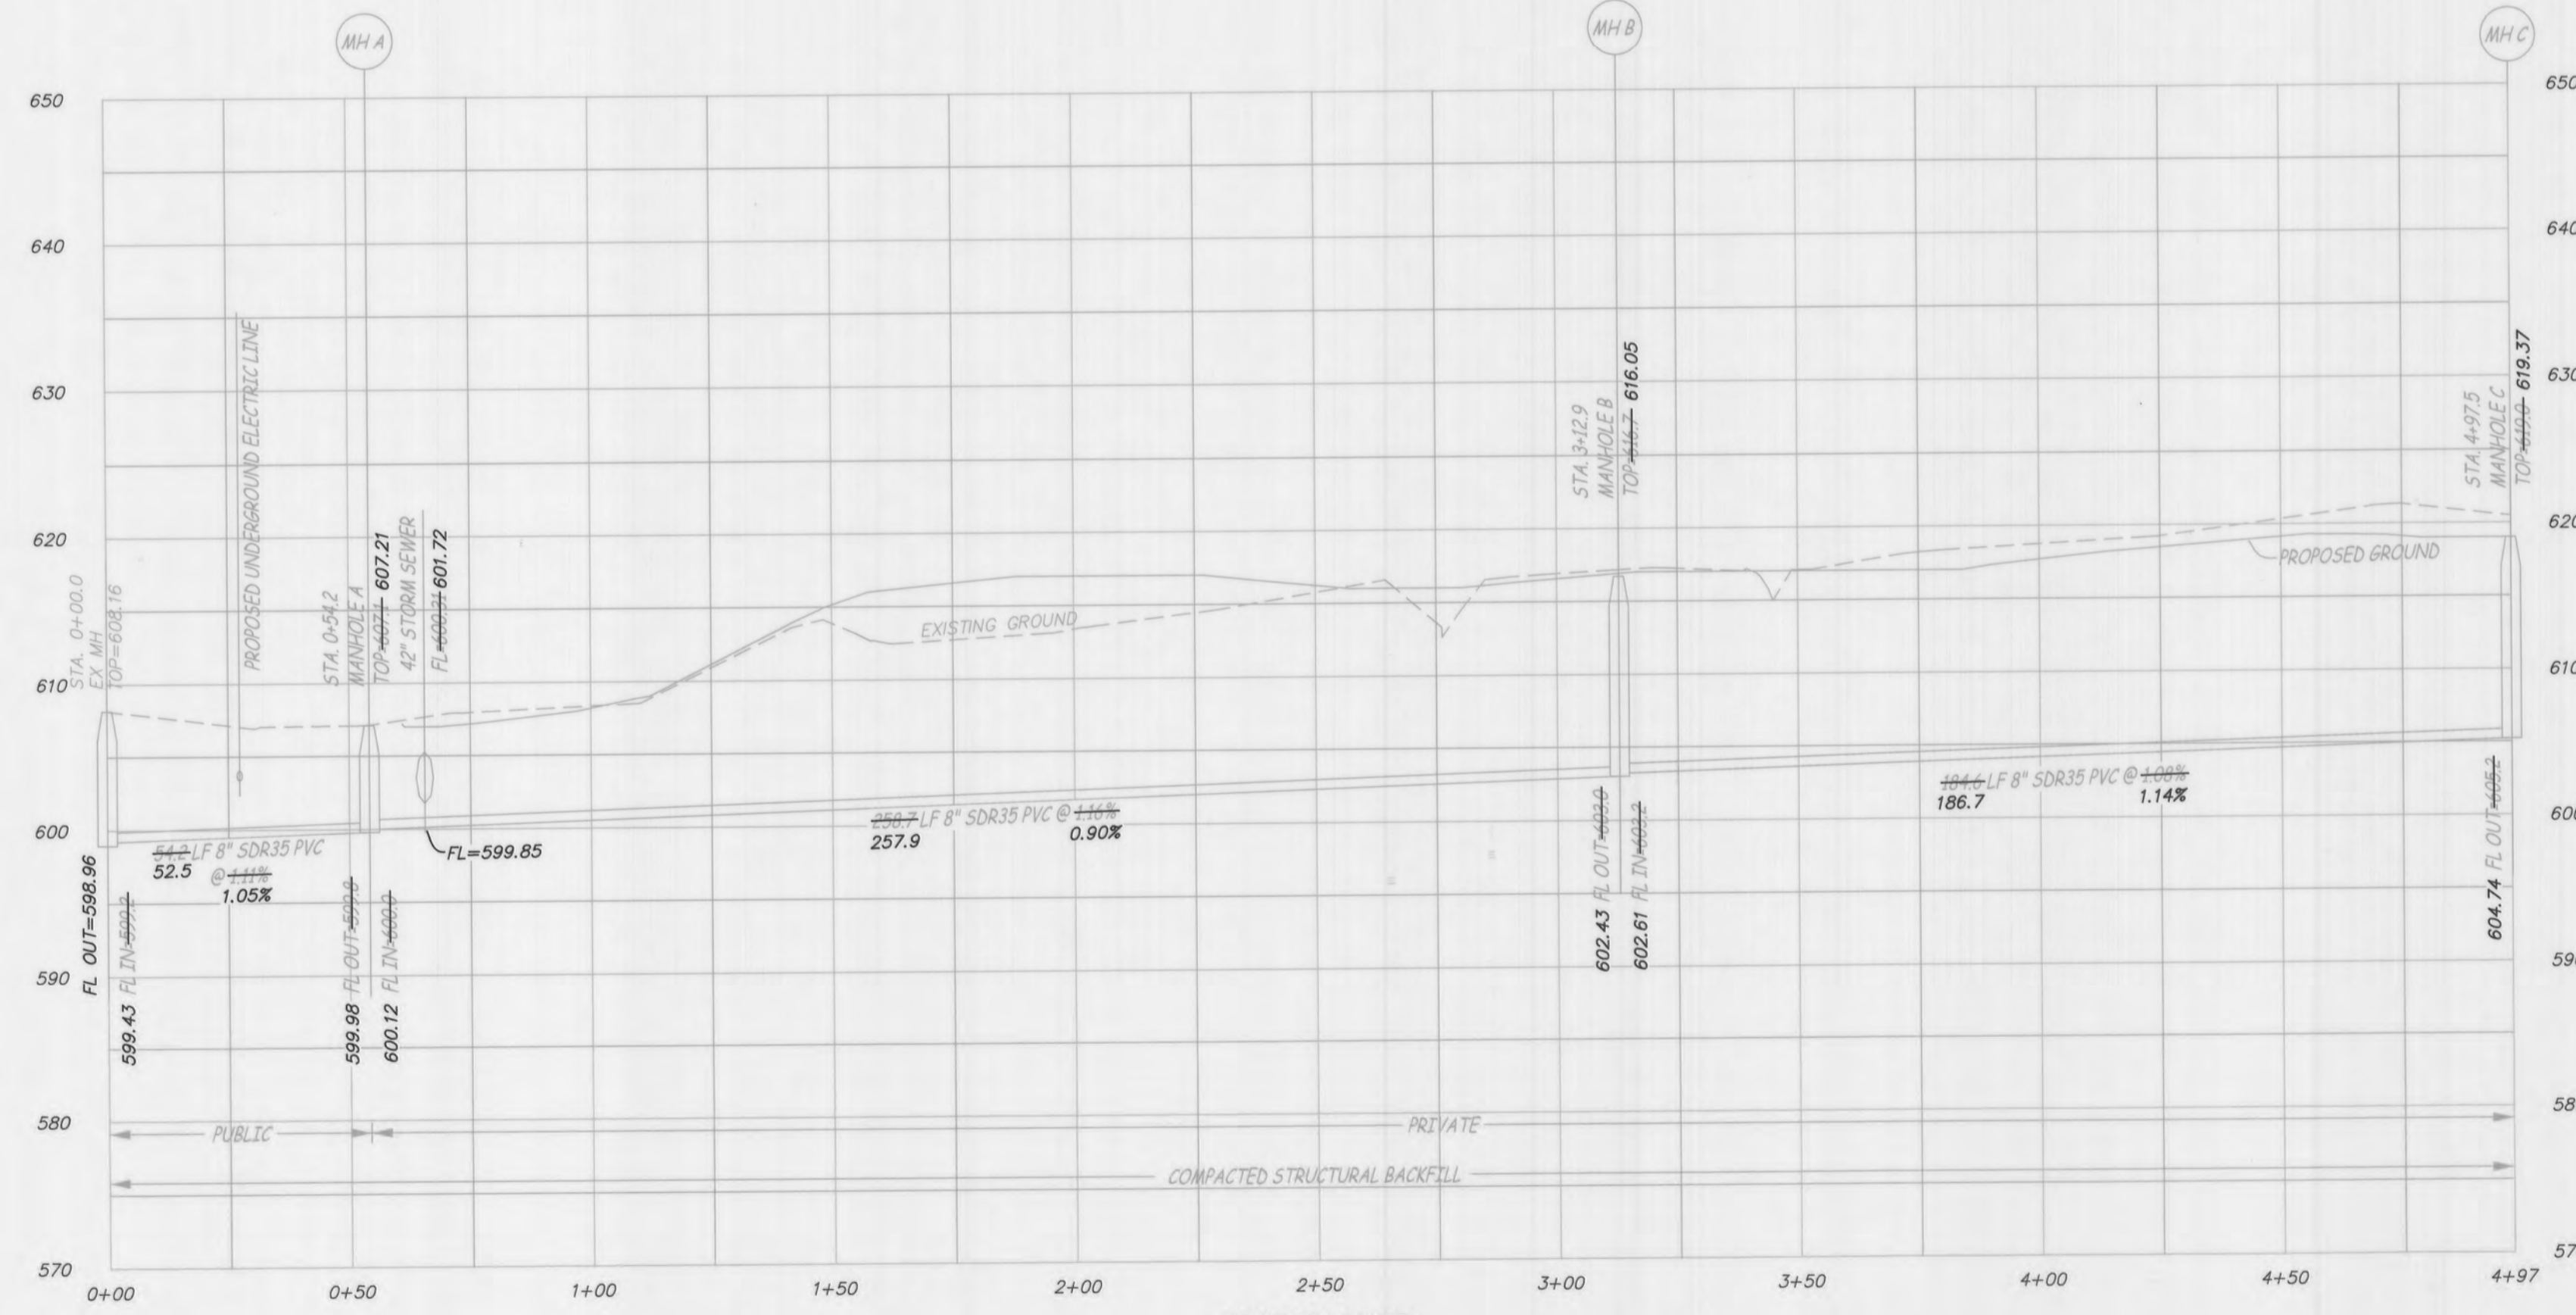

**SANITARY SEWER  
EX MH THRU MH C**  
SCALE - HORIZ. 1" = 30'  
VERT. 1" = 10'

		SEWER AS-BUILT PROFILES			
		<b>HILLMANN PLACE - PHASE 1</b>			
O'FALLON, ST. CHARLES COUNTY, MISSOURI					
Surveyed: NTL		<b>Engineering Surveys &amp; Services</b>			
Drawn: RTM		1113 Fay Street Columbia, Missouri			
Checked: FEC		573 - 449 - 2646 Missouri Land Surveying Corporation # 2004004672			
FREDERICK E. CARROZ III PROFESSIONAL LAND SURVEYOR PLS - 2008016655		Scale HORIZ. 1" = 30' VERT. 1" = 10'	Date APRIL 27, 2012	Job 11936	Sheet 3 of 3