

A SET OF AS-BUILT PLANS FOR A WAREHOUSE ADDITION

A TRACT OF LAND BEING ALL OF LOT 3 OF "HOFF INDUSTRIAL PARK", P.B. 40 PGS. 155-156, BEING ALSO WITHIN THE SOUTHWEST QUARTER OF THE SOUTHWEST QUARTER OF SECTION 24, TOWNSHIP 47 NORTH, RANGE 2 EAST OF THE FIFTH PRINCIPAL MERIDIAN, ST. CHARLES COUNTY, MISSOURI

STANDARD SYMBOLS & ABBREVIATIONS	
TREE OR BUSH	○
LIGHT POLE	⊙
SANITARY SEWER & MANHOLE	—○—
STORM SEWER & INLET	—○—
MAILBOX	□
ELECTRIC LINE	—E—
GAS LINE	—G—
WATER LINE	—W—
TELEPHONE LINE	—T—
CABLE TV LINE	—CATV—
OVERHEAD WIRE	—OHW—
UTILITY POLE	⊙
UTILITY POLE W/ DOWN GUY	⊙
FIRE HYDRANT	⊙
WATER VALVE	⊙
WATER METER	⊙
GAS VALVE	⊙
ROAD SIGN	⊙
TELEPHONE PEDESTAL	⊙
FENCE	—x—

PREPARED FOR:
 BILL DAVIS
 2209 DROSTE ROAD
 ST. CHARLES, MO 63301
 (636) 949-0680

LOT 3 OF HOFF INDUSTRIAL PARK - OMNI CABLE

PRINCIPLES & STANDARDS:

- All excavations, grading, or filling shall have a finished grade not to exceed a 3:1 slope (33%). Steeper grades may be approved by the designated official if the excavation is through rock or the excavation or the fill is adequately protected (a designed head wall or toe wall may be required). Retaining walls that exceed a height of four (4) feet shall require the construction of safety guards as identified in the appropriate section(s) of the adopted BOCA Codes and must be approved by the Building Department. Permanent safety guards will be constructed in accordance with the appropriate section(s) of the adopted BOCA Codes.
- Sediment and erosion control plans for sites that exceed 20,000 square feet of grading shall provide for sediment or debris basins, silt traps or filters, staked straw bales or other approved measures to remove sediment from run-off waters. The design to be approved by the Designated Official. Temporary siltation control measures (structural) shall be maintained until vegetative cover is established at a sufficient density to provide erosion control on the site.
- Where natural vegetation is removed during grading, vegetation shall be reestablished in such a density as to prevent erosion. Permanent type grasses shall be established as soon as possible during the next seeding period after grading has been completed.
- When grading operations are completed or suspended for more than 14 days permanent grass must be established at sufficient density to provide erosion control on the site. Between permanent grass seeding periods, temporary cover shall be provided according to the City Engineer's recommendations. All finished grades (areas not to be disturbed by future improvement) in excess of 20% slopes (5:1) shall be mulched and tacked at the rate of 100 pounds per 1,000 square feet when seeded.
- Provisions shall be made to accommodate the increased runoff caused by changed soils and surface conditions during and after grading. Unvegetated open channels shall be designed so that gradients result in velocities of 2 fps (feet per second) or less. Open channels with velocities more than 2 fps and less than 5 fps shall be established in permanent vegetation by use of commercial erosion control blankets or lined with rock rip rap or concrete or other suitable materials as approved by the City Engineer. Detention basins, diversions, or other appropriate structures shall be constructed to prevent velocities above 5 fps.
- The adjoining ground to development sites (lots) shall be provided with protection from accelerated and increased surface water, silt from erosion, and any other consequence of erosion. Run-off water from developed areas (parking lots, paved sites and buildings) above the area to be developed shall be directed to diversions, detention basins, concrete gutters and/or underground outlet systems. Sufficiently anchored straw bales may be temporarily substituted with the approval of the City Engineer.
- Development along natural watercourses shall have residential lot lines, commercial or industrial improvements, parking areas or driveways set back a minimum of 25 feet from the top of the existing stream bank. The watercourse shall be maintained and made the responsibility of the subdivision trustees or in the case of a site plan by the property owner. Permanent vegetation should be left intact. Variances will include designed stream bank erosion control measures and shall be approved by the City Engineer, FEMA and U.S. Army Corps of Engineers guidelines shall be followed where applicable regarding site development areas designated as flood plains and wetlands.
- All lots shall be seeded and mulched at the minimum rates defined in Appendix A or sodded before an occupancy permit shall be issued except that a temporary occupancy permit may be issued by the Building Department in cases of undue hardship because of unfavorable ground conditions.

VEGETATIVE ESTABLISHMENT For Urban Development Sites APPENDIX A

- Seeding Rates:**
- Permanent:**
 Tall Fescue - 30 lbs./ac.
 Smooth Brome - 20 lbs./ac.
 Combined Fescue & Brome @ 15 lbs./ac. and Brome @ 10 lbs./ac.
- Temporary:**
 Wheat or Rye - 150 lbs./ac. (3.5 lbs. per square foot)
 Oats - 120 lbs./ac. (2.75 lbs. per square foot)
- Seeding Periods:**
 Fescue or Brome - March 1 to June 1
 August 1 to October 1
 Wheat or Rye - March 15 to November 1
 Oats - March 15 to September 15
- Mulch Rates:**
 100 lbs. per 1,000 sq. feet (4,356 lbs. per acre)
- Fertilizer Rates:**
 Nitrogen 30 lbs./ac.
 Phosphate 30 lbs./ac.
 Potassium 30 lbs./ac.
 Lime 600 lbs./ac. ENM*
- * ENM = effective neutralizing material as per State evaluation of quarried rock.

U.S.G.S. BENCHMARKS

REFERENCE BENCHMARK: RM 45 (ELEV 526.16) - CHISELED SQUARE ON THE SOUTHEAST WINGWALL OF THE LAKE SAINT LOUIS BOULEVARD BRIDGE OVER THE SPILLWAY OF LAKE SAINT LOUIS.

SITE BENCHMARK: ELEV 548.70 OUT CROSS IN CONCRETE DRIVE 30.0 FEET NORTH OF THE SOUTHEAST PROPERTY CORNER ON SUBJECT PROPERTY.

O'FALLON NOTES

- Underground utilities have been plotted from available information and therefore their locations shall be considered approximate only. The verification of the location of all underground utilities, either shown or not shown on these plans shall be the responsibility of the contractor, and shall be located prior to any grading or construction of the improvements.
- All filled places under proposed storm and sanitary sewer, proposed roads, and/or paved areas shall be compacted to 95% of the maximum density as determined by the Modified AASHTO T-180 Compaction Test, or 100% of maximum density as determined by the standard Proctor Test AASHTO T-99. All tests shall be verified by a soils engineer concurrent with grading and backfilling operations. All filled places in proposed roads shall be compacted from the bottom up. All test shall be verified by a soil engineer concurrent with grading and backfilling operations. Ensure the moisture content of the soil in the fill area is to correspond to the compactive effort as defined by the Standard or Modified Proctor Test. Optimum moisture content shall be determined using the same test that was used for compaction. Soil compaction curves shall be submitted to The City of O'Fallon prior to the placement of fill. Proof rolling may be required to verify soil stability at the discretion of The City of O'Fallon.
- No area shall be cleared without the permission of the Project Engineer.
- The City of O'Fallon shall be notified 48 hours prior to construction for coordination and inspection.
- All existing site improvements disturbed, damaged or destroyed shall be repaired or replaced to closely match pre-construction conditions.
- All construction and materials shall conform to the current construction standards of the City of O'Fallon.
- Any permits, licenses, easements, or approvals required to work on public or private properties or roadways are the responsibility of the developer.
- No slopes shall exceed 3(Horizontal) : 1(Vertical).
- The Contractor shall assume complete responsibility for controlling all siltation and erosion of the project area. The Contractor shall use whatever means necessary to control erosion and siltation including, but not limited to, staked straw bales and/or siltation fabric fences (possible methods of control are detailed in the plan). Control shall commence with grading and be maintained throughout the project until acceptance of the work by the Owner and/or the City of O'Fallon and/or MODO. The Contractor's responsibilities include all design and implementation as required to prevent erosion and the depositing of silt. The Owner and/or the City of O'Fallon and/or MODO may at their option direct the Contractor in his methods as deemed fit to protect property and improvements. Any depositing of silts or mud on new or existing pavement or in new or existing storm sewers or swales shall be removed after each rain and affected areas cleaned to the satisfaction of the Owner and/or the City of O'Fallon and/or MODO.
- Erosion control systems shall not be limited to what is shown on the plan. Whatever means necessary shall be taken to prevent siltation and erosion from entering natural streams and adjacent roadways, properties and ditches.
- All building mounted lights shall be pointed downward and fully screened to prevent light from spilling over onto adjacent properties.
- All ground and roof hvac mechanical units to be screened from view.
- The Developer must supply City Construction inspectors with soil reports prior to or during site soil testing.

O'FALLON NOTES (CONTINUED)

Manufacturer	Size	Adhesive	Style	Message (Part #)	Website
ACP International	3 7/8"	Epoxy	Crystal Cap	No Dumping Drains To Waterways (SD-W-CC)	www.acpinternational.com
DAS Manufacturing, Inc.	4"	Epoxy	Standard	No Dumping Drains To Stream (#605)	www.dasmanufacturing.com

- Developer must supply City Construction inspectors with soil reports prior to or during site soil testing. The soil report will be required to contain the following information on soil test curves (Proctor reports) for projects within the City:
 - Maximum dry density
 - Optimum moisture content
 - Maximum and minimum allowable moisture content
 - Curve must be plotted to show density from a minimum of 95% Compaction and above as determined by the "Modified AASHTO T-180 Compaction Test" (A.S.T.M.-D-1157) or from a minimum of 100% as determined by the "Standard Proctor Test AASHTO T-99, Method C" (A.S.T.M.-D-698). Proctor type must be designated on document.
 - Curve must have at least 5 density points with moisture content and sample locations listed on document.
 - Specific gravity.
 - Natural moisture content.
 - Liquid limit.
 - Plastic limit.
- It is advised that if this information is not provided to the City's Construction Inspector the City will not allow grading or construction activities to proceed on any project site.
- Trees, organic debris, rubble, foundations and other deleterious material shall be removed for the site and disposed in compliance with all applicable laws and regulations. Landfill tickets for such disposal shall be maintained on file by the developer. Burning on site shall be allowed only be permit from the local fire district. If a burn pit is proposed the location and mitigation shall be shown on the grading plan and documented by the soils engineer.
- HDPE pipe is to be N-12WT or equal and to meet ASTM F1417 water tight field test.
- If there are any physical changes to MoDOT's right of way, such as grading or entrance modification, MoDOT requests the opportunity to review the plans, there may be improvements to the roadway required to support the proposed development within MoDOT's Access Management Guidelines.
- Connections at all sanitary or storm structures to be made with A-lock joint or equal.
- Traffic control is to be per MoDOT or MUTCD whichever is most stringent.
- All sanitary laterals and sanitary main crossing under pavement must have the proper rock backfill and to required compaction.



**CALL BEFORE
YOU DIG!**
1-800-DIG-RITE

SHEET INDEX

- SHEET 1 COVER SHEET
 SHEET 2 SITE PLAN/PROFILE

GRADING QUANTITIES:

1,749 C.Y. CUT (INCLUDES SUBGRADES)
 2,830 C.Y. FILL (INCLUDES 8% SHRINKAGE)
 1,081 C.Y. SHORT

THE ABOVE GRADING QUANTITY IS APPROXIMATE ONLY, NOT FOR BIDDING PURPOSES. CONTRACTOR SHALL VERIFY QUANTITIES PRIOR TO CONSTRUCTION.

SEWER MEASUREMENTS

THE EXISTING SEWER LENGTHS, SIZES, FLOWLINES, DEPTHS OF STRUCTURES AND SEWERS AND LOCATIONS WITH RESPECT TO EXISTING OR PROPOSED EASEMENTS HAVE BEEN MEASURED. THE RESULTS OF THOSE MEASUREMENTS ARE SHOWN ON THIS SET OF FINAL MEASUREMENT PLANS.

ALL PUBLIC SEWERS ARE LOCATED WITH DESIGNATED EXISTING OR PROPOSED EASEMENTS EXCEPT AS FOLLOWS:

SIGNED: P.E./S. [Signature]
 DATE: 10/10/08



GRADING NOTES:

- A Geotechnical Engineer shall be employed by the owner and be on site during grading operations. All soils tests shall be verified by the Geotechnical Engineer concurrent with the grading and back-filling operations.
- The grading contractor shall perform a complete grading and compaction operation as shown on the plans, stated in these notes, or reasonably implied therefrom, all in accordance with the plans and notes as interpreted by the Geotechnical Engineer.
- The Contractor shall notify the Soils Engineer at least two days in advance of the start of the grading operation.
- All areas shall be allowed to drain. All low points shall be provided with temporary ditches.
- A sediment control plan that includes monitored and maintained sediment control basins and/or straw bales should be implemented as soon as possible. No graded area is to be allowed to remain bare over the winter without being seeded and mulched. Care should be exercised to prevent soil from damaging adjacent property and silting up existing downstream storm drainage system.
- Any existing trash and debris currently on this property must be removed and disposed of off-site.
- Soft soil in the bottom and banks of any existing or former pond sites or tributaries should be removed, spread out and permitted to dry sufficiently to be used as fill. None of this material should be placed in proposed right-of-way locations or on storm sewer locations.
- Site preparation includes the clearance of all stumps, trees, bushes, shrubs, and weeds; the grubbing and removal of roots and other surface obstructions from the site; and the demolition and removal of any man-made structures. The unsuitable material shall be properly disposed of off-site. Topsoil and grass in the fill areas shall be thoroughly disced prior to the placement of any fill. The Soils Engineer shall approve the discing operation.
- Compaction equipment shall consist of tamping rollers, pneumatic-tired rollers, vibratory roller, or high speed impact type drum rollers acceptable to the Soils Engineer. The roller shall be designed so as to avoid the creation of a layered fill without proper blending of successive fill layers.
- The Soils Engineer shall observe and test the placement of the fill to verify that specifications are met. A series of fill density tests will be determined on each lift of fill. Interim reports showing fill quality will be made to the Owner at regular intervals.
- The Soils Engineer shall notify the Contractor of rejection of a lift of fill or portion thereof. The Contractor shall rework the rejected portion of fill and obtain notification from the Soils Engineer of its acceptance prior to the placement of additional fill.
- All areas to receive fill shall be scarified to a depth of not less than 6 inches and then compacted in accordance with the specifications given below. Natural slopes steeper than 1 vertical to 5 horizontal to receive fill shall have horizontal benches, cut into the slopes before the placement of any fill. The width and height to be determined by the Soils Engineer. The fill shall be loosely placed in horizontal layers not exceeding 8 inches in thickness and compacted in accordance with the specifications given below. The Soils Engineer shall be responsible for determining the acceptability of soils placed. Any unacceptable soils placed shall be removed at the Contractor's expense.
- The surface of the fill shall be finished so that it will not impound water. If at the end of a days work it would appear that there may be rain prior to the next working day, the surface shall be finished smooth. If the surface has been finished smooth for any reason, it shall be scarified before proceeding with the placement of succeeding lifts. Fill shall not be placed on frozen ground, nor shall filling operations continue when the temperature is such as to permit the layer under placement to freeze.
- All siltation control devices shall be inspected by the contractor after any rain of 1/2" or more with any appreciable accumulation of mud to be removed and siltation measures repaired where necessary.
- No slope shall be steeper than 3(Horizontal):1(Vertical). All slopes shall be sodded or seeded and mulched.
- Any contaminated soil encountered during excavation shall be hauled and placed as directed by the owners environmental engineering representative.
- The location of and details for all siltation control devices (silt fences and sediment basins) must follow the "St. Charles County Soil and Water Conservation District Erosion and Sediment Control" guidelines.

DEVELOPMENT NOTES

- Area of Tract: 1.843 Acres
Area Disturbed: 1.347 Acres
- Existing Zoning: I-2 Heavy Industrial (City of O'Fallon)
- Existing Use: Office/Warehouse
- Area of Existing Building: 15,054.71 sq.ft.
Area of Proposed Building: 16,833.6 sq.ft.
- The required height and building setbacks are as follows:
 Minimum Front Yard: 30 feet
 Minimum Side Yard: 25 feet
 Minimum Rear Yard: 50 feet
 Maximum Height of Building: 50 feet
- Site is served by:
 City of O'Fallon Sewer: 636-281-2858
 AmerenUE Company: 636-639-8312
 Loadele Gas Company: 636-946-8937
 City of O'Fallon Water: 636-281-2858
 Century Tel: 636-332-3011
 O'Fallon Fire Protection District: 636-272-3493
 Fort Zumwalt School District: 636-272-6620
- Property Owner:
 Siegfried O'Fallon, L.P.
 Contact: Mike Scholer
 2 Hogerty Blvd.
 Westchester, PA 19382
 Phone: (610) 883-4737
 Fax: (610) 701-0199
- According to the Flood Insurance Rate Map of St. Charles County, (Community Panel number 290315 0220 E dated March 17,2003) this property lies within zone X. Zone X is defined as an area outside the 500 year Flood Plain Limits.
- Parking Required:
 Office: 1 space per 300 s.f. office space
 1,080 sq. ft. / 300 sq. ft. = 3.6
 Warehouse: 1 space per 1,000 s.f. plus 1 space per employee
 30,808.31 / 1,000 = 30.81 plus 10 employees
 Total Parking Required: 44.41 ~ 45 spaces
 Total Parking Provided: 48 spaces (including 2 handicap spaces)
- Loading space: Over 5,000 s.f. requires 1 space.
 1 space per 20,000 over
 Total required and provided: 2 spaces
- Landscape Required: 47 (spa.) x 270 = 12,690 S.F.
 12,690 sq. ft. x 0.06 (%) = 761.40
 Total Interior Landscape Required: 761.40 S.F.
 Total Interior Landscape Provided: 2,613.28 S.F.
 1 per 40' of road frontage
 182.50' / 40' = 4.56 ~ 5 trees
 Total Road Trees Required: 5
 Total Trees Provided: 5
 No tree preservation is required, no existing trees being removed.
- Site Coverage Calculations: 80,315.02 S.F.
 Building = 31,888.31 sq.ft. ~ 39.70%
 Pavement = 27,138.71 sq.ft. ~ 33.79%
 Green Space = 21,287.34 sq.ft. ~ 26.51%
- Detention for this site was provided as part of Lone Star Industrial Park.
- No additional sanitary flow to be contributed by this site.
- All HVAC and mechanical units on site shall be properly screened as required by City Code. Rooftop units shall be screened by a parapet wall that extends around the entire perimeter of the building; ground mounted HVAC and mechanical units shall be screened by fencing, vegetation or some other means (approved by the Planning and Zoning Commission) that has a minimum height that is at least as tall as the tallest unit being screened.
- All proposed utilities to be located underground.
- All siltation control to be per St. Charles County Soil and Water Conservation District Erosion and Sediment Control Guidelines.
- No off-site grading assessments will be required, Contractor is owner of adjacent parcels.



DISCLAIMER OF RESPONSIBILITY
 I hereby certify that the documents intended to be authenticated by my seal are true to the sheet, and I hereby disclaim any responsibility for all other drawings, specifications, estimates, reports or other documents or instruments existing or intended to be used for any part or parts of the architectural or engineering project or survey.

REVISIONS	
DATE	DESCRIPTION
10/22/08	ADDED HYD. CALCS



**ENGINEERING
PLANNING
SURVEYING**
 221 Point West Blvd.
 St. Charles, MO 63301
 636-928-5552
 FAX 928-1718


10/10/08
 DATE
 07-14019A
 PROJECT NUMBER
 1 OF 2
 SHEET OF
 14019A-ASB
 FILE NAME
 JLH
 DRAWN
 ALJ LDW
 DESIGNED CHECKED

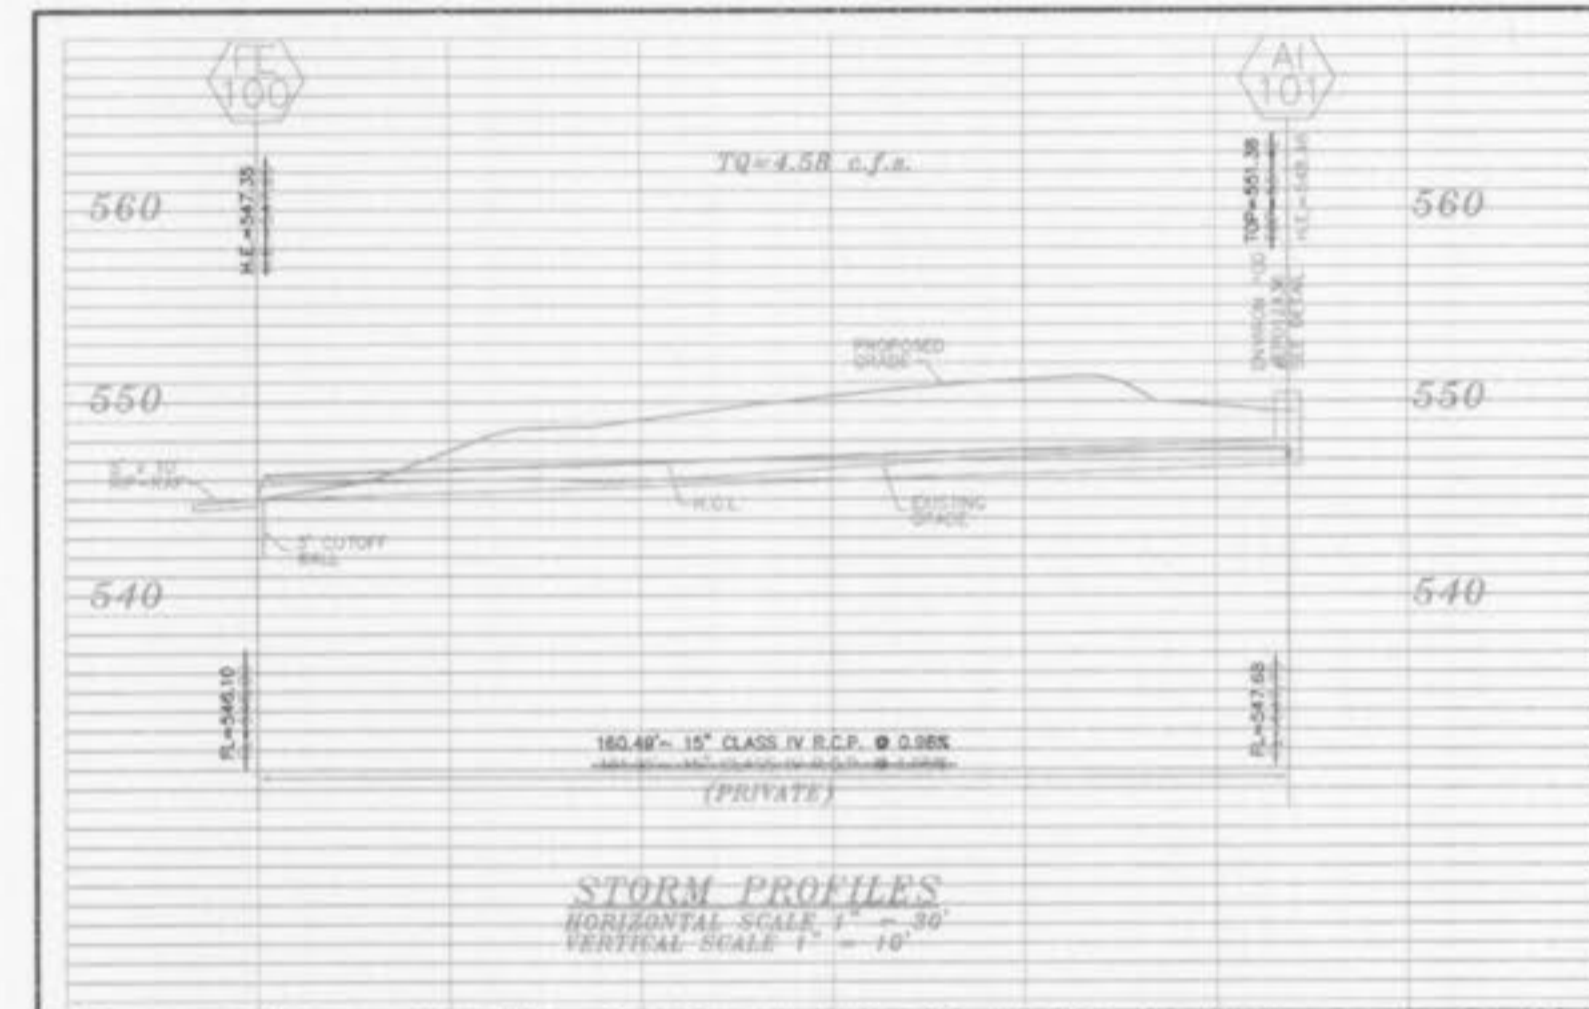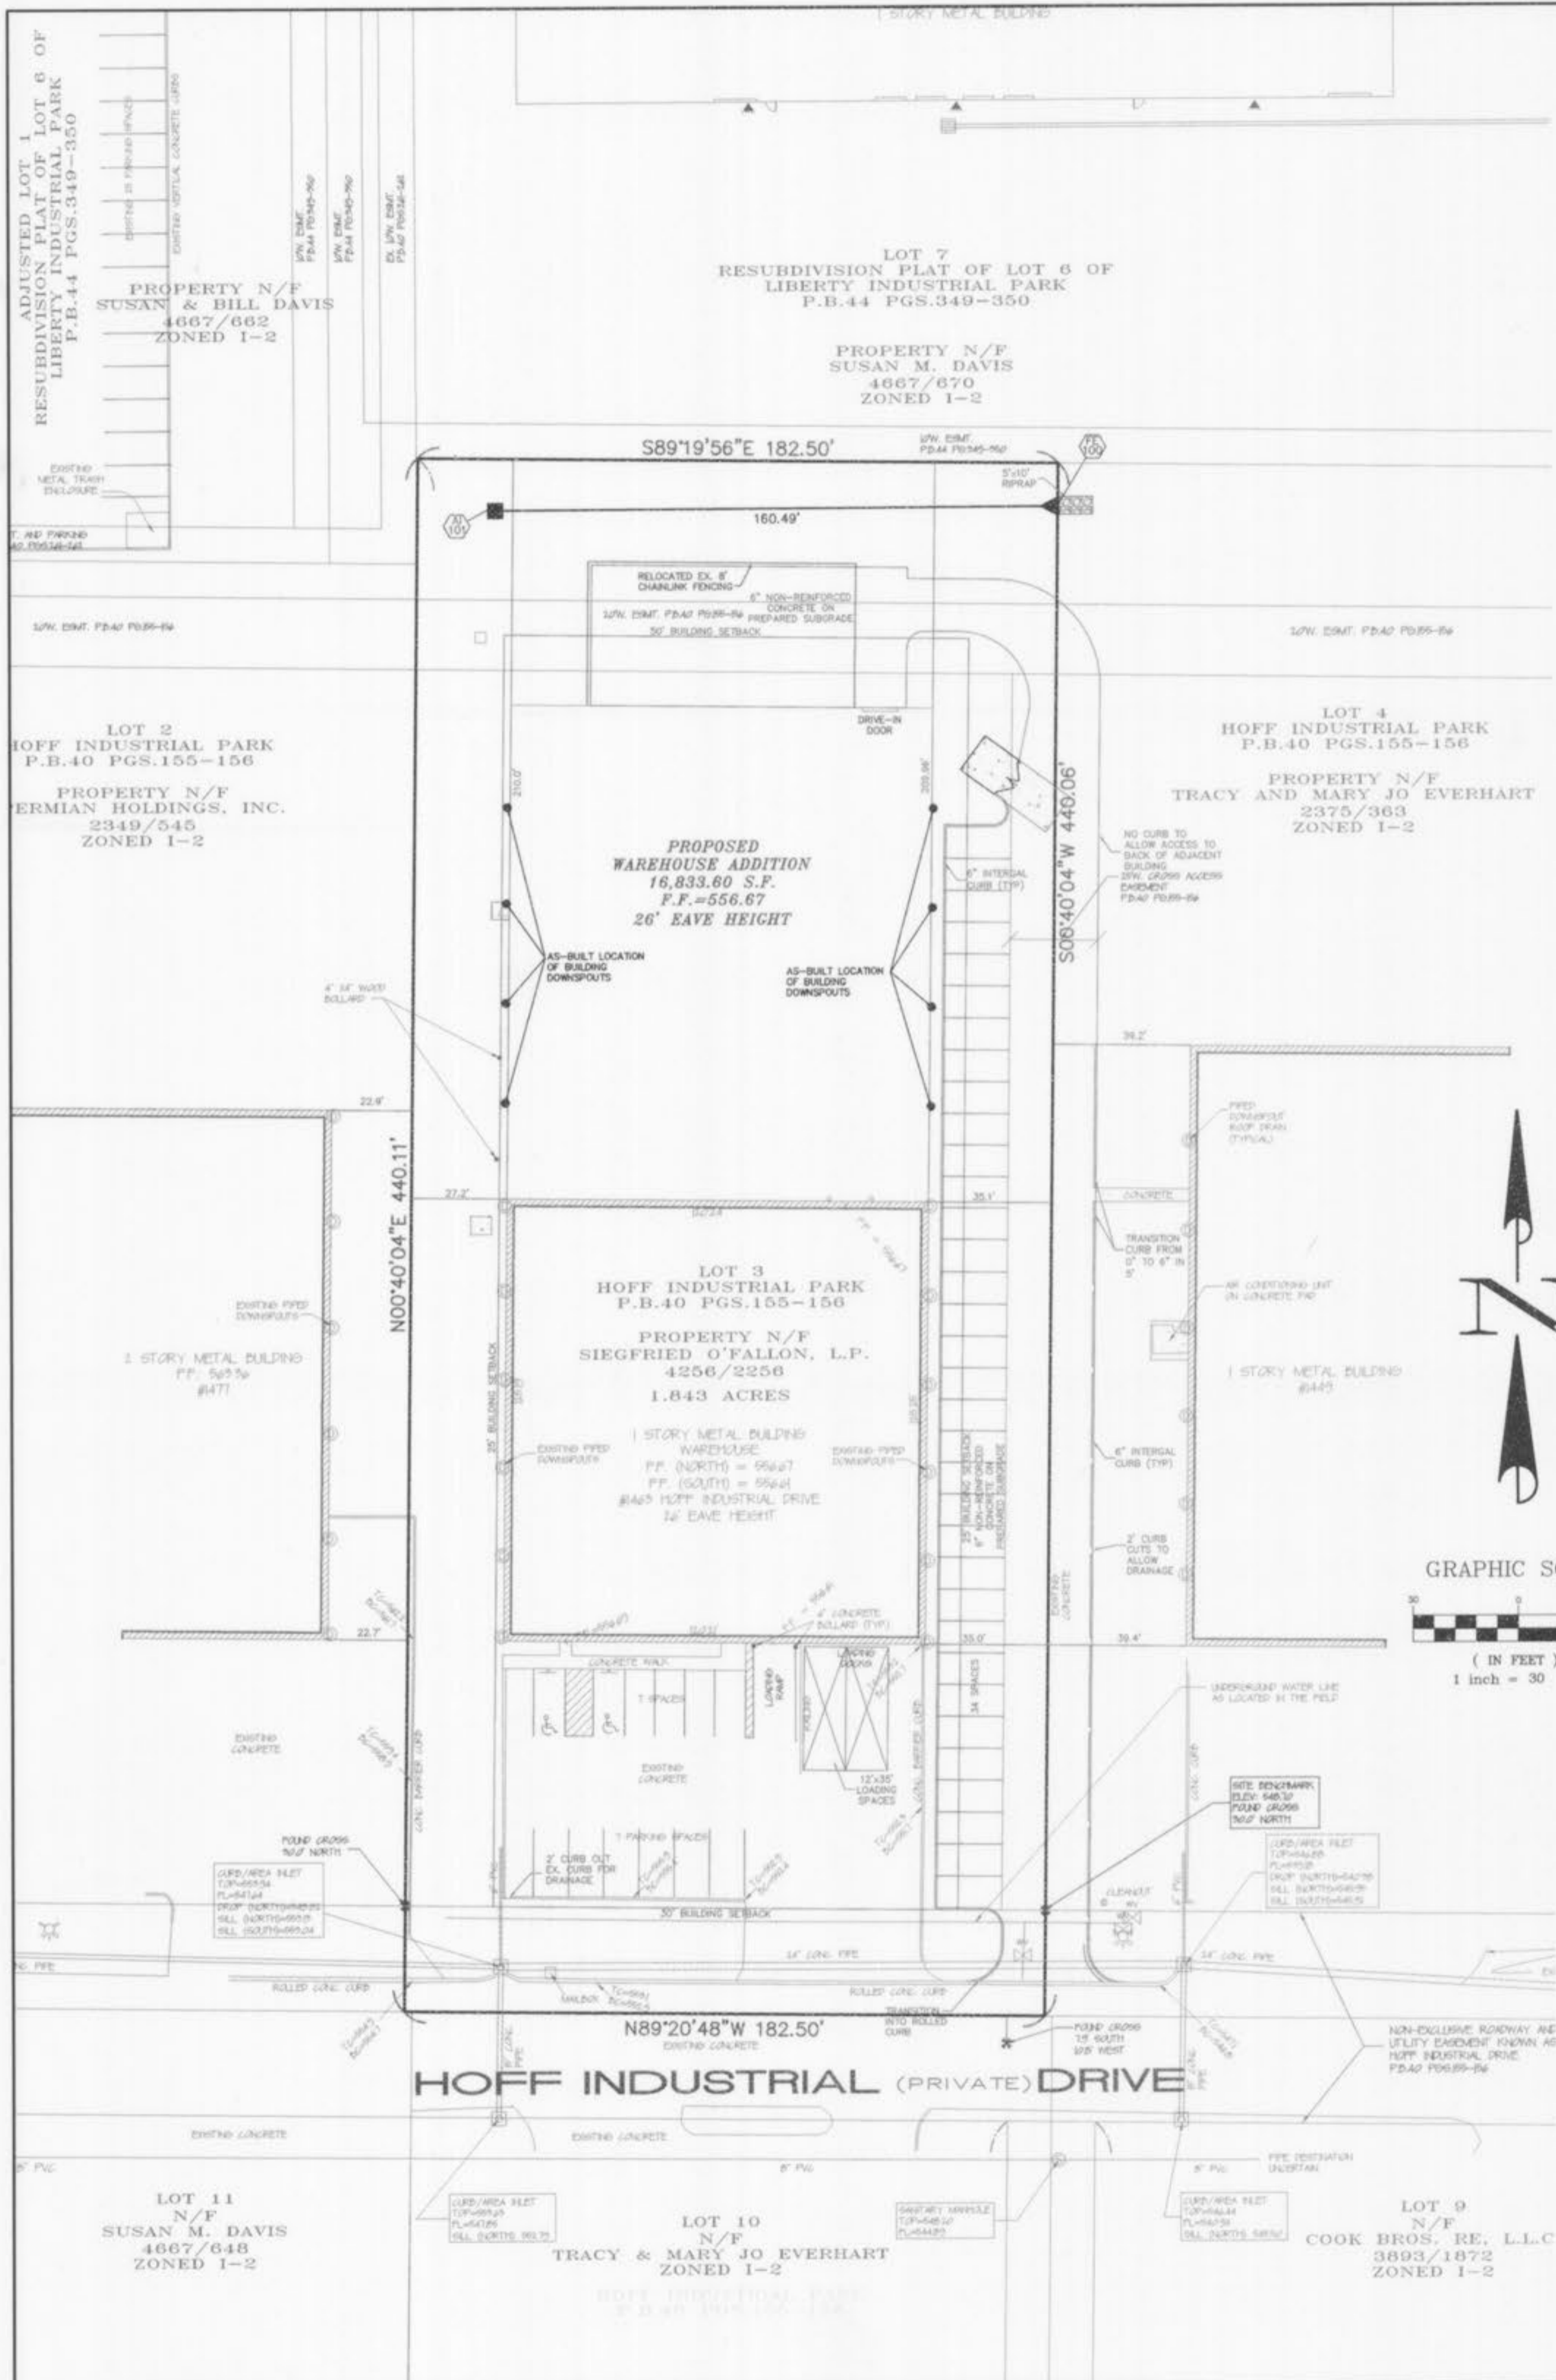

BAX PROJECT NAME: OMMI CABLE - LOT 3 OF HOFF INDUSTRIAL
 BAX PROJECT NO.: 07-14019A
 FILENAME: 14019a (Asbuilt)

STN	OFF STN	LOW	UPPER	LOWER	HYDR	FR	VEL	VEL	JONC	TORN	CURVE	STR	INL	DR	PT	Q	TO	PIPE	REMARKS					
101	FE	100	180	15	547.68	546.10	0.98	551.38	2.92	348.46*	547.35	-0.0500	0.81	3.73	0.22	0.22	0.00	0.00	0.00	0.00	4.58	6.41	1	HW-547.35

* INDICATES CRITICAL DEPTH

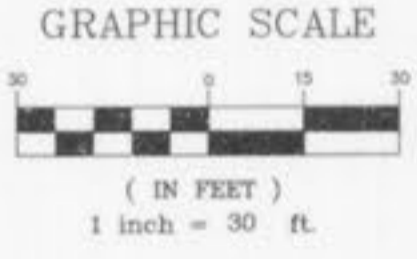

AS-BUILTS ADDED OCTOBER, 2008