


**A SET OF AS-BUILT PLANS FOR
OFFICE BUILDING
A TRACT OF LAND BEING PART OF LOT 3 OF
"FALLON CREST TOWNHOMES PLAT ONE",
PLAT BOOK 32 PAGE 182-183, IN FRACTIONAL
SECTION 29, TOWNSHIP 47 NORTH, RANGE 3 EAST
OF THE FIFTH PRINCIPAL MERIDIAN,
ST. CHARLES COUNTY, MISSOURI**

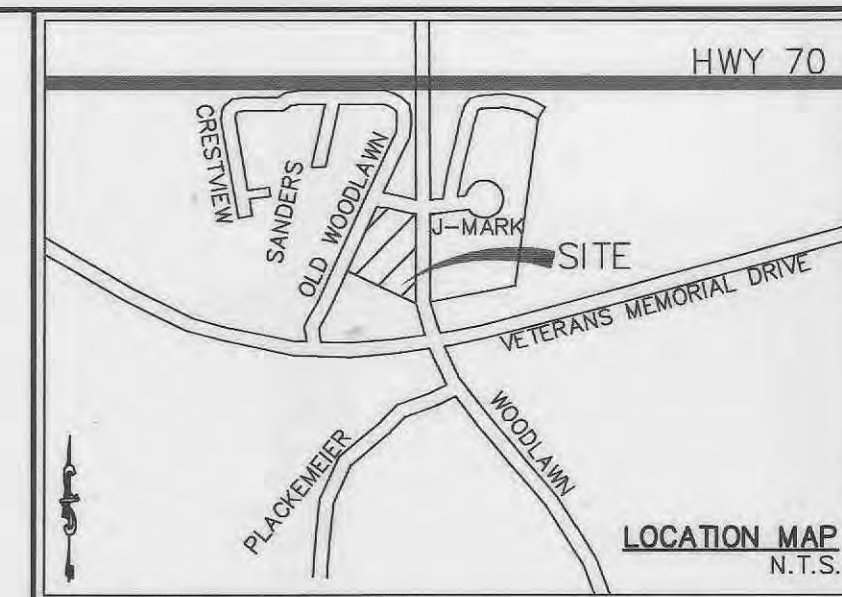

STANDARD SYMBOLS & ABBREVIATIONS

TREE OR BUSH	○
LIGHT POLE	☆
SANITARY SEWER & MANHOLE	⊙
STORM SEWER & INLET	⊕
MAILBOX	□
ELECTRIC LINE	—E—
GAS LINE	—G—
WATER LINE	—W—
TELEPHONE LINE	—T—
CABLE TV LINE	—CATV—
OVERHEAD WIRE	—OHV—
UTILITY POLE	⊕
UTILITY POLE W/ DOWN GUY	⊕ ↓
FIRE HYDRANT	⊕
WATER VALVE	⊕
WATER METER	⊕
GAS VALVE	⊕
ROAD SIGN	⊕
TELEPHONE PEDESTAL	⊕ TEL. PED.
FENCE	—X—

GRADING NOTES:

- A Geotechnical Engineer shall be employed by the owner and be on site during grading operations. All soils tests shall be verified by the Geotechnical Engineer concurrent with the grading and back filling operations.
- The grading contractor shall perform a complete grading and compaction operation as shown on the plans, stated in these notes, or reasonably implied there from, all in accordance with the plans and notes as interpreted by the Geotechnical Engineer.
- The Contractor shall notify the Soils Engineer at least two days in advance of the start of the grading operation.
- All areas shall be allowed to drain. All low points shall be provided with temporary ditches.
- A sediment control plan that includes monitored and maintained sediment control basins and/or straw bales should be implemented as soon as possible. No graded area is to be allowed to remain bare over the winter without being seeded and mulched. Care should be exercised to prevent soil from damaging adjacent property and silted up existing downstream storm drainage system.
- Any existing trash and debris currently on this property must be removed and disposed of off-site.
- Soft soil in the bottom and banks of any existing or former pond sites or tributaries should be removed, spread out and permitted to dry sufficiently to be used as fill. None of this material should be placed in proposed right-of-way locations or on storm sewer locations.
- Site preparation includes the clearance of all stumps, trees, bushes, shrubs, and weeds; the grubbing and removal of roots and other surface obstructions from the site; and the demolition and removal of any man-made structures. The unsuitable material shall be properly disposed of off-site. Topsoil and grass in the fill areas shall be thoroughly disc'd prior to the placement of any fill. The Soils Engineer shall approve the discing operation.
- Compaction equipment shall consist of tamping rollers, pneumatic-tired rollers, vibratory roller, or high speed impact type drum rollers acceptable to the Soils Engineer. The roller shall be designed so as to avoid the creation of a layered fill without proper blending of successive fill layers.
- The Soils Engineer shall observe and test the placement of the fill to verify that specifications are met. A series of fill density tests will be determined on each lift of fill. Interim reports showing fill quality will be made to the Owner at regular intervals.
- The Soils Engineer shall notify the Contractor of rejection of a lift of fill or portion thereof. The Contractor shall rework the rejected portion of fill and obtain notification from the Soils Engineer of its acceptance prior to the placement of additional fill.
- All areas to receive fill shall be scarified to a depth of not less than 6 inches and then compacted in accordance with the specifications given below. Natural slopes steeper than 1 vertical to 5 horizontal to receive fill shall have horizontal benches, cut into the slopes before the placement of any fill. The width and height to be determined by the Soils Engineer. The fill shall be loosely placed in horizontal layers not exceeding 8 inches in thickness and compacted in accordance with the specifications given below. The Soils Engineer shall be responsible for determining the acceptability of soils placed. Any unacceptable soils placed shall be removed at the Contractor's expense.
- The sequence of operation in the fill areas will be fill, compact, verify acceptable soil density, and repetition of the sequence.
- The surface of the fill shall be finished so that it will not impound water. If at the end of a days work it would appear that there may be rain prior to the next working day, the surface shall be finished smooth. If the surface has been finished smooth for any reason, it shall be scarified before proceeding with the placement of succeeding lifts. Fill shall not be placed on frozen ground, nor shall filling operations continue when the temperature is such as to permit the layer under placement to freeze.
- All siltation control devices shall be inspected by the contractor after any rain of 1/2" or more with any appreciable accumulation of mud to be removed and siltation measures repaired where necessary.
- No slope shall be steeper than 3(Horizontal):1(Vertical). All slopes shall be sodded or seeded and mulched.
- Any contaminated soil encountered during excavation shall be hauled and placed as directed by the owners environmental engineering representative.
- No grading will begin prior to approval of a grading plan by the City of O'Fallon.
- All grades shall be within 0.2 feet of those shown on the grading plan.

STORM SEWER MEASUREMENTS

THE EXISTING SEWER LENGTHS, SIZES, FLOWLINES, DEPTHS OF STRUCTURES AND SEWERS AND LOCATIONS WITH RESPECT TO EXISTING OR PROPOSED EASEMENTS HAVE BEEN MEASURED. THE RESULTS OF THOSE MEASUREMENTS ARE SHOWN ON THIS SET OF FINAL MEASUREMENT PLANS.

ALL PUBLIC SEWERS ARE LOCATED WITHIN DESIGNATED EXISTING OR PROPOSED EASEMENTS EXCEPT AS FOLLOWS:

SIGNED:
P.E./L.S. DATE: 11/5/05

AS-BUILTS ADDED NOVEMBER 2005

O'FALLON NOTES

- Underground utilities have been plotted from available information and therefore their locations shall be considered approximate only. The verification of the location of all underground utilities, either shown or not shown on these plans shall be the responsibility of the contractor, and shall be located prior to any grading or construction of the improvements.
- All filled places under proposed storm and sanitary sewer, proposed roads, and/or paved areas shall be compacted to 90% of the maximum density as determined by the Modified AASHTO T-180 Compaction Test, or 95% of maximum density as determined by the standard Proctor Test AASHTO T-99. All tests shall be verified by a soils engineer concurrent with grading and backfilling operations. All filled places in proposed roads shall be compacted from the bottom up. All test shall be verified by a soil engineer concurrent with grading and backfilling operations. Ensure the moisture content of the soil in the fill areas is to correspond to the compactive effort as determined by the Standard or Modified Proctor Test. Optimum moisture content shall be determined using the same test that was used for compaction. Soil compaction curves shall be submitted to the City of O'Fallon prior to the placement of fill. Proof tilling may be required to verify soil stability at the discretion of the City of O'Fallon.
- No area shall be cleared without the permission of the Project Engineer.
- The City of O'Fallon shall be notified 48 hours prior to construction for coordination and inspection.
- All existing site improvements disturbed, damaged or destroyed shall be repaired or replaced to closely match pre-construction conditions.
- All construction and materials shall conform to the current construction standards of the City of O'Fallon.
- Any permits, licenses, easements, or approvals required to work on public or private properties or roadways are the responsibility of the developer.
- No slopes shall exceed 3(Horizontal) : 1(Vertice).
- The Contractor shall assume complete responsibility for controlling all siltation and erosion of the project area. The Contractor shall use whatever means necessary to control erosion and siltation including, but not limited to, staked straw bales and/or siltation fabric fences (possible methods of control are detailed in the plan). Control shall commence with grading and be maintained throughout the project until acceptance of the work by the Owner and/or the City of O'Fallon and/or MODOT. The Contractor's responsibilities include all design and implementation as required to prevent erosion and the depositing of silt. The Owner and/or the City of O'Fallon and/or MODOT may at their option direct the Contractor in his methods as deemed fit to protect property and improvements. Any depositing of silts or mud on new or existing pavement or in new or existing storm sewers or swales shall be removed after each rain and affected areas cleaned to the satisfaction of the Owner and/or the City of O'Fallon and/or MODOT.
- Erosion control systems shall not be limited to what is shown on the plan. Whatever means necessary shall be taken to prevent siltation and erosion from entering natural streams and adjacent roadways, properties and ditches.
- All building mounted lights shall be pointed downward and fully screened to prevent light from spilling over onto adjacent properties.
- All rooftop hvac mechanical units to be screened by parapet wall and ground mounted units with materials and/or landscaping.
- The Developer must supply City Construction Inspectors with soil reports prior to or during site soil testing.
- All paving to be in accordance with St. Charles County standards and specifications except as modified by the City of O'Fallon ordinances.
- All sidewalks, curb ramps, ramps and accessible parking spaces shall be constructed in accordance with the current approved "Americans with Disabilities Act Accessibility Guidelines" (ADAAG) along with the required grades, construction materials, specifications and signage. If any conflict occurs between the above information and the plans, the ADAAG guidelines shall take precedence and the contractor prior to any construction shall notify the Project Engineer. Ensure at least one 8' wide handicap access aisle is provided and curb ramps do not project into handicap access aisles.
- Brick shall not be used in the construction of storm or sanitary sewer structures.
- The Contractor shall ensure all storm and sanitary sewer joint shall be gasketed O-Ring type.
- Lighting values will be reviewed on the site prior to the final occupancy inspection. Corrections will need to be made if not in compliance with City standards.
- All proposed fencing requires a separate permit through the Planning Division.
- All sign locations and sizes must be approved separately through the Planning Division.
- All sign post and backs and bracket arms shall be painted black using Carboline Rustbond Penetrating Sealer SG and Carboline 133 HB paint (or equivalent as approved by the City of O'Fallon and MoDOT). Sign designating street names shall be on the opposite side of the street from traffic control signs.
- All new utility line shall be located underground.
- All erosion control systems shall be inspected and necessary corrections shall be made within 24 hours of any rainstorm resulting in one-half inch of rain or more.
- All graded areas that are to remain bare for over 2 weeks shall be seeded and mulched per DNR requirements.
- Prior to Construction Site Plan approval, a photometric lighting plan in accordance with the city of O'Fallon's Exterior Lighting Standards shall be submitted for review and approval for all proposed exterior lighting.
- All rip-rap shown at flared ends shall be evaluated in the field after installation for effectiveness and field modified if necessary to reduce erosion on and off-site.
- All drop structures shall have compacted rock backfill in the disturbed ground around the structure.

PRINCIPLES & STANDARDS:

- All excavations, grading, or filling shall have a finished grade not to exceed a 3:1 slope (33 %). Steeper grades may be approved by the designated official if the excavation is through rock or the excavation or the fill is adequately protected (a designed head wall or toe wall may be required). Retaining walls that exceed a height of four (4) feet shall require the construction of safety guards as identified in the appropriate section(s) of the adopted BOCA Codes and must be approved by the Building Department. Permanent safety guards will be constructed in accordance with the appropriate section(s) of the adopted BOCA Codes.
- Sediment and erosion control plans for sites that exceed 20,000 square feet of grading shall provide for sediment or debris basins, silt traps or filters, staked straw bales or other approved measures to remove sediment from run-off waters. The design to be approved by the Designated Official. Temporary siltation control measures (structural) shall be maintained until vegetative cover is established at a sufficient density to provide erosion control on the site.
- Where natural vegetation is removed during grading, vegetation shall be reestablished in such a density as to prevent erosion. Permanent type grasses shall be established as soon as possible during the next seeding period after grading has been completed.
- When grading operations are completed or suspended for more than 30 days permanent grass must be established at sufficient density to provide erosion control on the site. Between permanent grass seeding periods, temporary cover shall be provided according to the City Engineer's recommendations. All finished grades (areas not to be disturbed by future improvement) in excess of 20% slopes (5:1) shall be mulched and tacked at the rate of 100 pounds per 1,000 square feet when seeded.
- Provisions shall be made to accommodate the increased runoff caused by changed soils and surface conditions during and after grading. Unvegetated open channels shall be designed so that gradients result in velocities of 2 fps (feet per second) or less. Open channels with velocities more than 2 fps and less than 5 fps shall be established in permanent vegetation by use of commercial erosion control blankets or lined with rock rip rap or concrete or other suitable materials as approved by the City Engineer. Detention basins, diversions, or other appropriate structures shall be constructed to prevent velocities above 5 fps.
- The adjoining ground to development sites (lots) shall be provided with protection from accelerated and increased surface water, silt from erosion, and any other consequence of erosion. Run-off water from developed areas (parking lots, paved sites and buildings) above the area to be developed shall be directed to diversions, detention basins, concrete gutters and/or underground outlet systems. Sufficiently anchored straw bales may be temporarily substituted with the approval of the City Engineer.
- Development along natural watercourses shall have residential lot lines, commercial or industrial improvements, parking areas or driveways set back a minimum of 25 feet from the top of the existing stream bank. The watercourse shall be maintained and made the responsibility of the subdivision trustees or in the case of a site plan by the property owner. Permanent vegetation should be left intact. Variances will include designed stream bank erosion control measures and shall be approved by the City Engineer, FEMA and U.S. Army Corps of Engineers guidelines shall be followed where applicable regarding site development areas designated as flood plains and wetlands.
- All lots shall be seeded and mulched at the minimum rates defined in Appendix A or sodded before an occupancy permit shall be issued except that a temporary occupancy permit may be issued by the Building Department in cases of undue hardship because of unfavorable ground conditions.

VEGETATIVE ESTABLISHMENT
For Urban Development Sites
APPENDIX A

Seeding Rates:
Permanent:
Tall Fescue - 30 lbs./ac.
Smooth Brome - 20 lbs./ac.
Combined Fescue @ 15 lbs./ac. and Brome @ 10 lbs./ac.

Temporary:
Wheat or Rye - 150 lbs./ac. (3.5 lbs. per square foot)
Oats - 120 lbs./ac. (2.75 lbs. per square foot)

Seeding Periods:
Fescue or Brome - March 1 to June 1
Wheat or Rye - August 1 to October 1
Oats - March 15 to November 1

Mulch Rates:
100 lbs. per 1,000 sq. feet (4,356 lbs. per acre)

Fertilizer Rates:
Nitrogen 30 lbs./ac.
Phosphate 30 lbs./ac.
Potassium 30 lbs./ac.
Lime 600 lbs./ac. ENM*

* ENM = effective neutralizing material as per State evaluation of quarried rock.

DEVELOPMENT NOTES

- Area of Tract: 1.307 Acres
- Existing Zoning: C-2 GENERAL BUSINESS DISTRICT (REZONED SEPT. 9, 2004)
- Proposed Use: OFFICE BUILDING
- Area of Building: 14,642 Sq. Ft.
- The required height and building setbacks are as follows:
Minimum Front Yard: 25 Feet
Minimum Side Yard: 0 Feet
Minimum Rear Yard: 0 Feet
Maximum Height: 50 Feet
- Site is served by:
City of O'Fallon Sewer 636-272-6818
Ameren Union Electric Company 1-800-55-ASKUE
St. Charles Gas Company 636-946-0352
City of O'Fallon Water 636-272-6818
Century Telephone Company 636-332-7318
O'Fallon Fire Protection District 636-272-3493
- According to F.I.R.M. # 29183C0237E, dated August 2, 1996, this area lies within Zone X. Zone X is an area determined to be outside the 500-year floodplain.
- Parking Required:
Office Building - One space for every 300 sq. ft. of floor area
14,642/300 = 48.80 spaces required
Total Spaces Required - 49
Total Spaces Provided - 49 (Including 2 HC spaces)
- Site Coverage Calculations:
Building = 7,321 S.F. ~ 12.86%
Pavement = 22,161 S.F. ~ 38.92%
Green Space = 27,451 S.F. ~ 48.22%
- Landscape Required:
49 (spa.) x 270 = 13,230 S.F.
12,690 sq. ft. x 0.06 (%) = 793.80
Total Interior Landscape Required: 793.80 S.F.
Total Interior Landscape Provided: 1,537.06 S.F.
719.65 L.F. / 40 L.F. = 17.99 ~ 18
Total Street Trees Required: 18 Trees
Total Street Trees Provided: 18 Trees
191.15 L.F. / 100 L.F. = 1.91 x 2 = ~ 3.82
Total Buffer Units Required: 4
Total Buffer Units Provided: 4
- Detention will be provided in connection with J-Mark Apartments off-site.
- Electric service to be provided underground to building by Ameren UE, location to be provided to contractor from Ameren.
- All storm sewer RGP shall be Class III.

U.S.G.S. BENCHMARKS:

REFERENCE BENCHMARK: RM 59 - ELEVATION 526.36 (USGS CHISELED SQUARE ON THE EAST END OF ASPHALT STREET, AT THE SOUTHEAST CORNER OF PLACKMEIER DRIVE AND ERNST PLACE.

SITE BENCHMARK: ELEV 585.63 THE "M" OF MUELLER ON FIRE HYDRANT NEAR NORTHWEST CORNER OF SUBJECT PROPERTY

GRADING QUANTITIES:

3,114 C.Y. CUT (INCLUDES SUBGRADES)
3,114 C.Y. FILL (INCLUDES 15% SHRINKAGE)
BALANCED

THE ABOVE GRADING QUANTITY IS APPROXIMATE ONLY. NOT FOR BIDDING PURPOSES. CONTRACTOR SHALL VERIFY QUANTITIES PRIOR TO CONSTRUCTION.




**CALL BEFORE
YOU DIG!
1-800-DIG-1876**

**PREPARED FOR: KEVIN AND ALEXIS WOOD
1409 POWDER ROAD
ST. PAUL, MO 63366
(636) 240-0833**

DISCLAIMER OF RESPONSIBILITY
I hereby certify that the documents intended to be authorized by my seal are limited to this sheet, and I hereby disclaim any responsibility for all other drawings, Specifications, Estimates, Reports or other documents or instruments relating to or intended to be used for any part or parts of the architectural or engineering project or survey.

Copyright 2002
B&B Engineering Company, Inc.
All Rights Reserved





REVISIONS

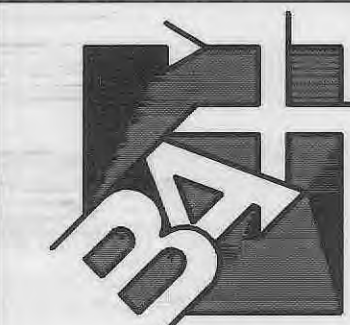

**ENGINEERING
PLANNING
SURVEYING**
1052 South Cloverleaf Drive
St. Peters, MO. 65376-6445
636-928-5552
FAX 928-1718

11/03/05
DATE
95-6789E
PROJECT NUMBER
1 OF 3
SHEET OF
6789E.ASB.DWG
FILE NAME
GMH
DRAWN
DESIGNED CHECKED

*J Mark Office Bldg
As built
Assured Title*

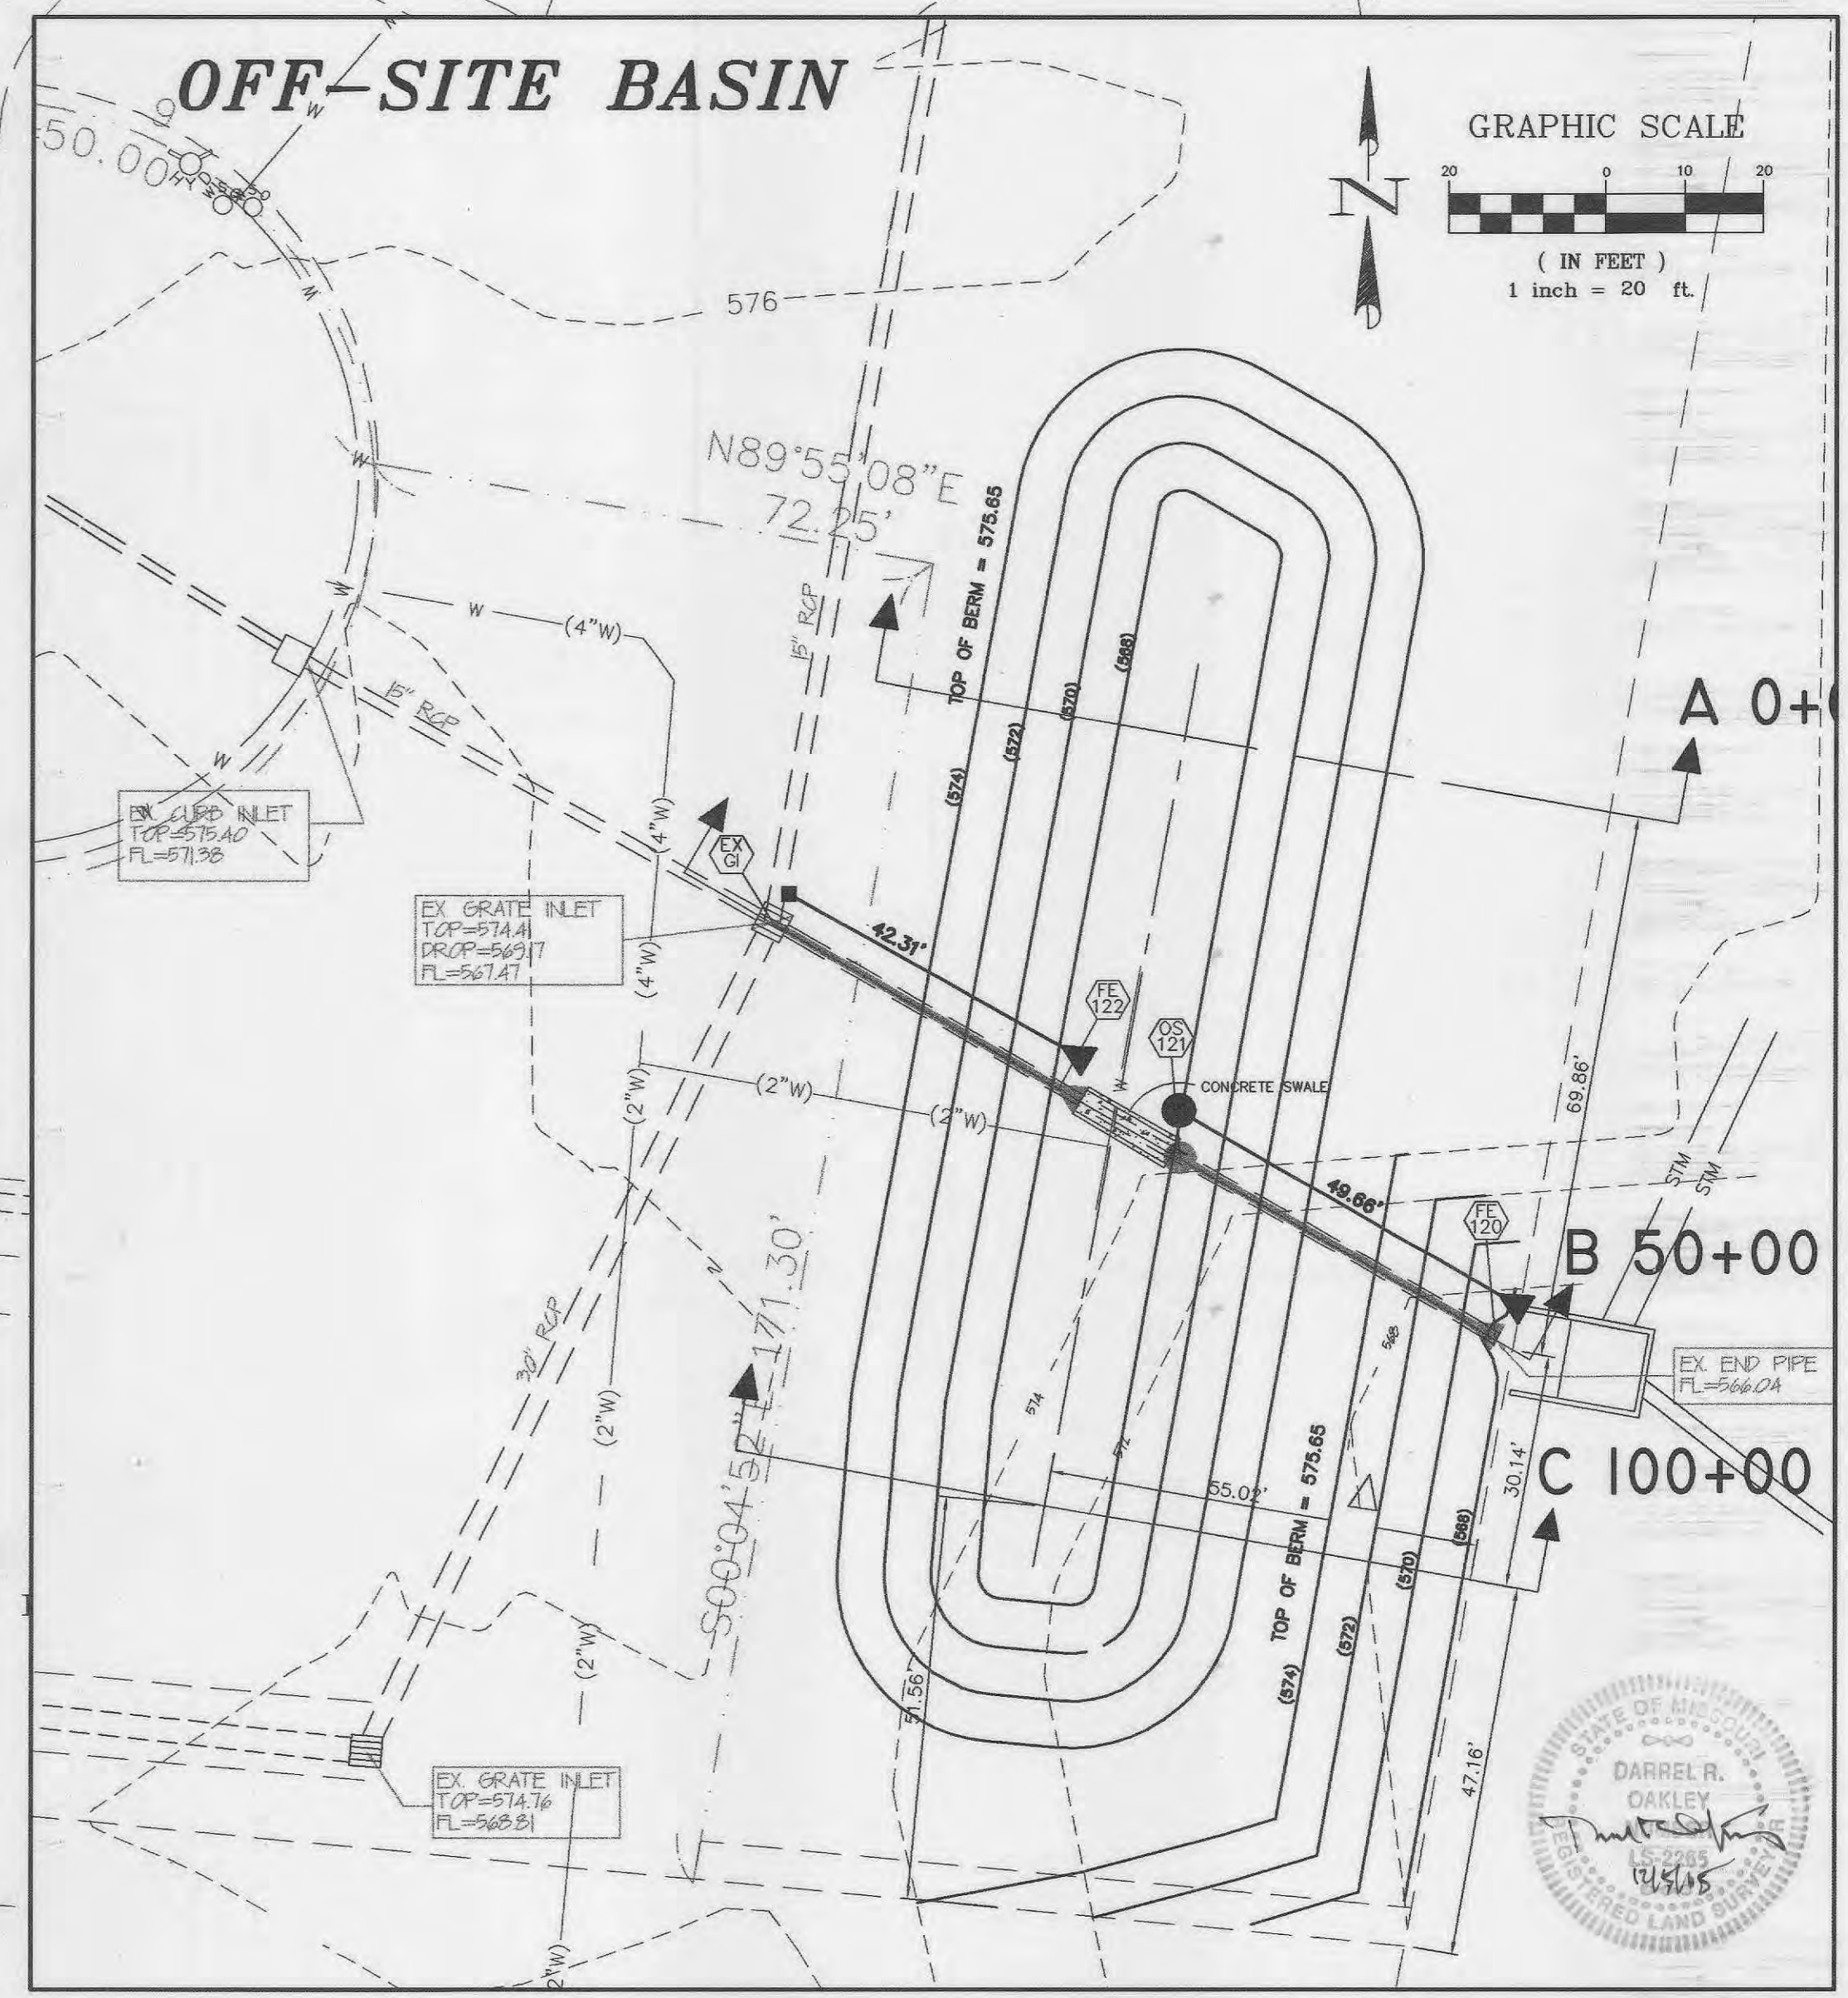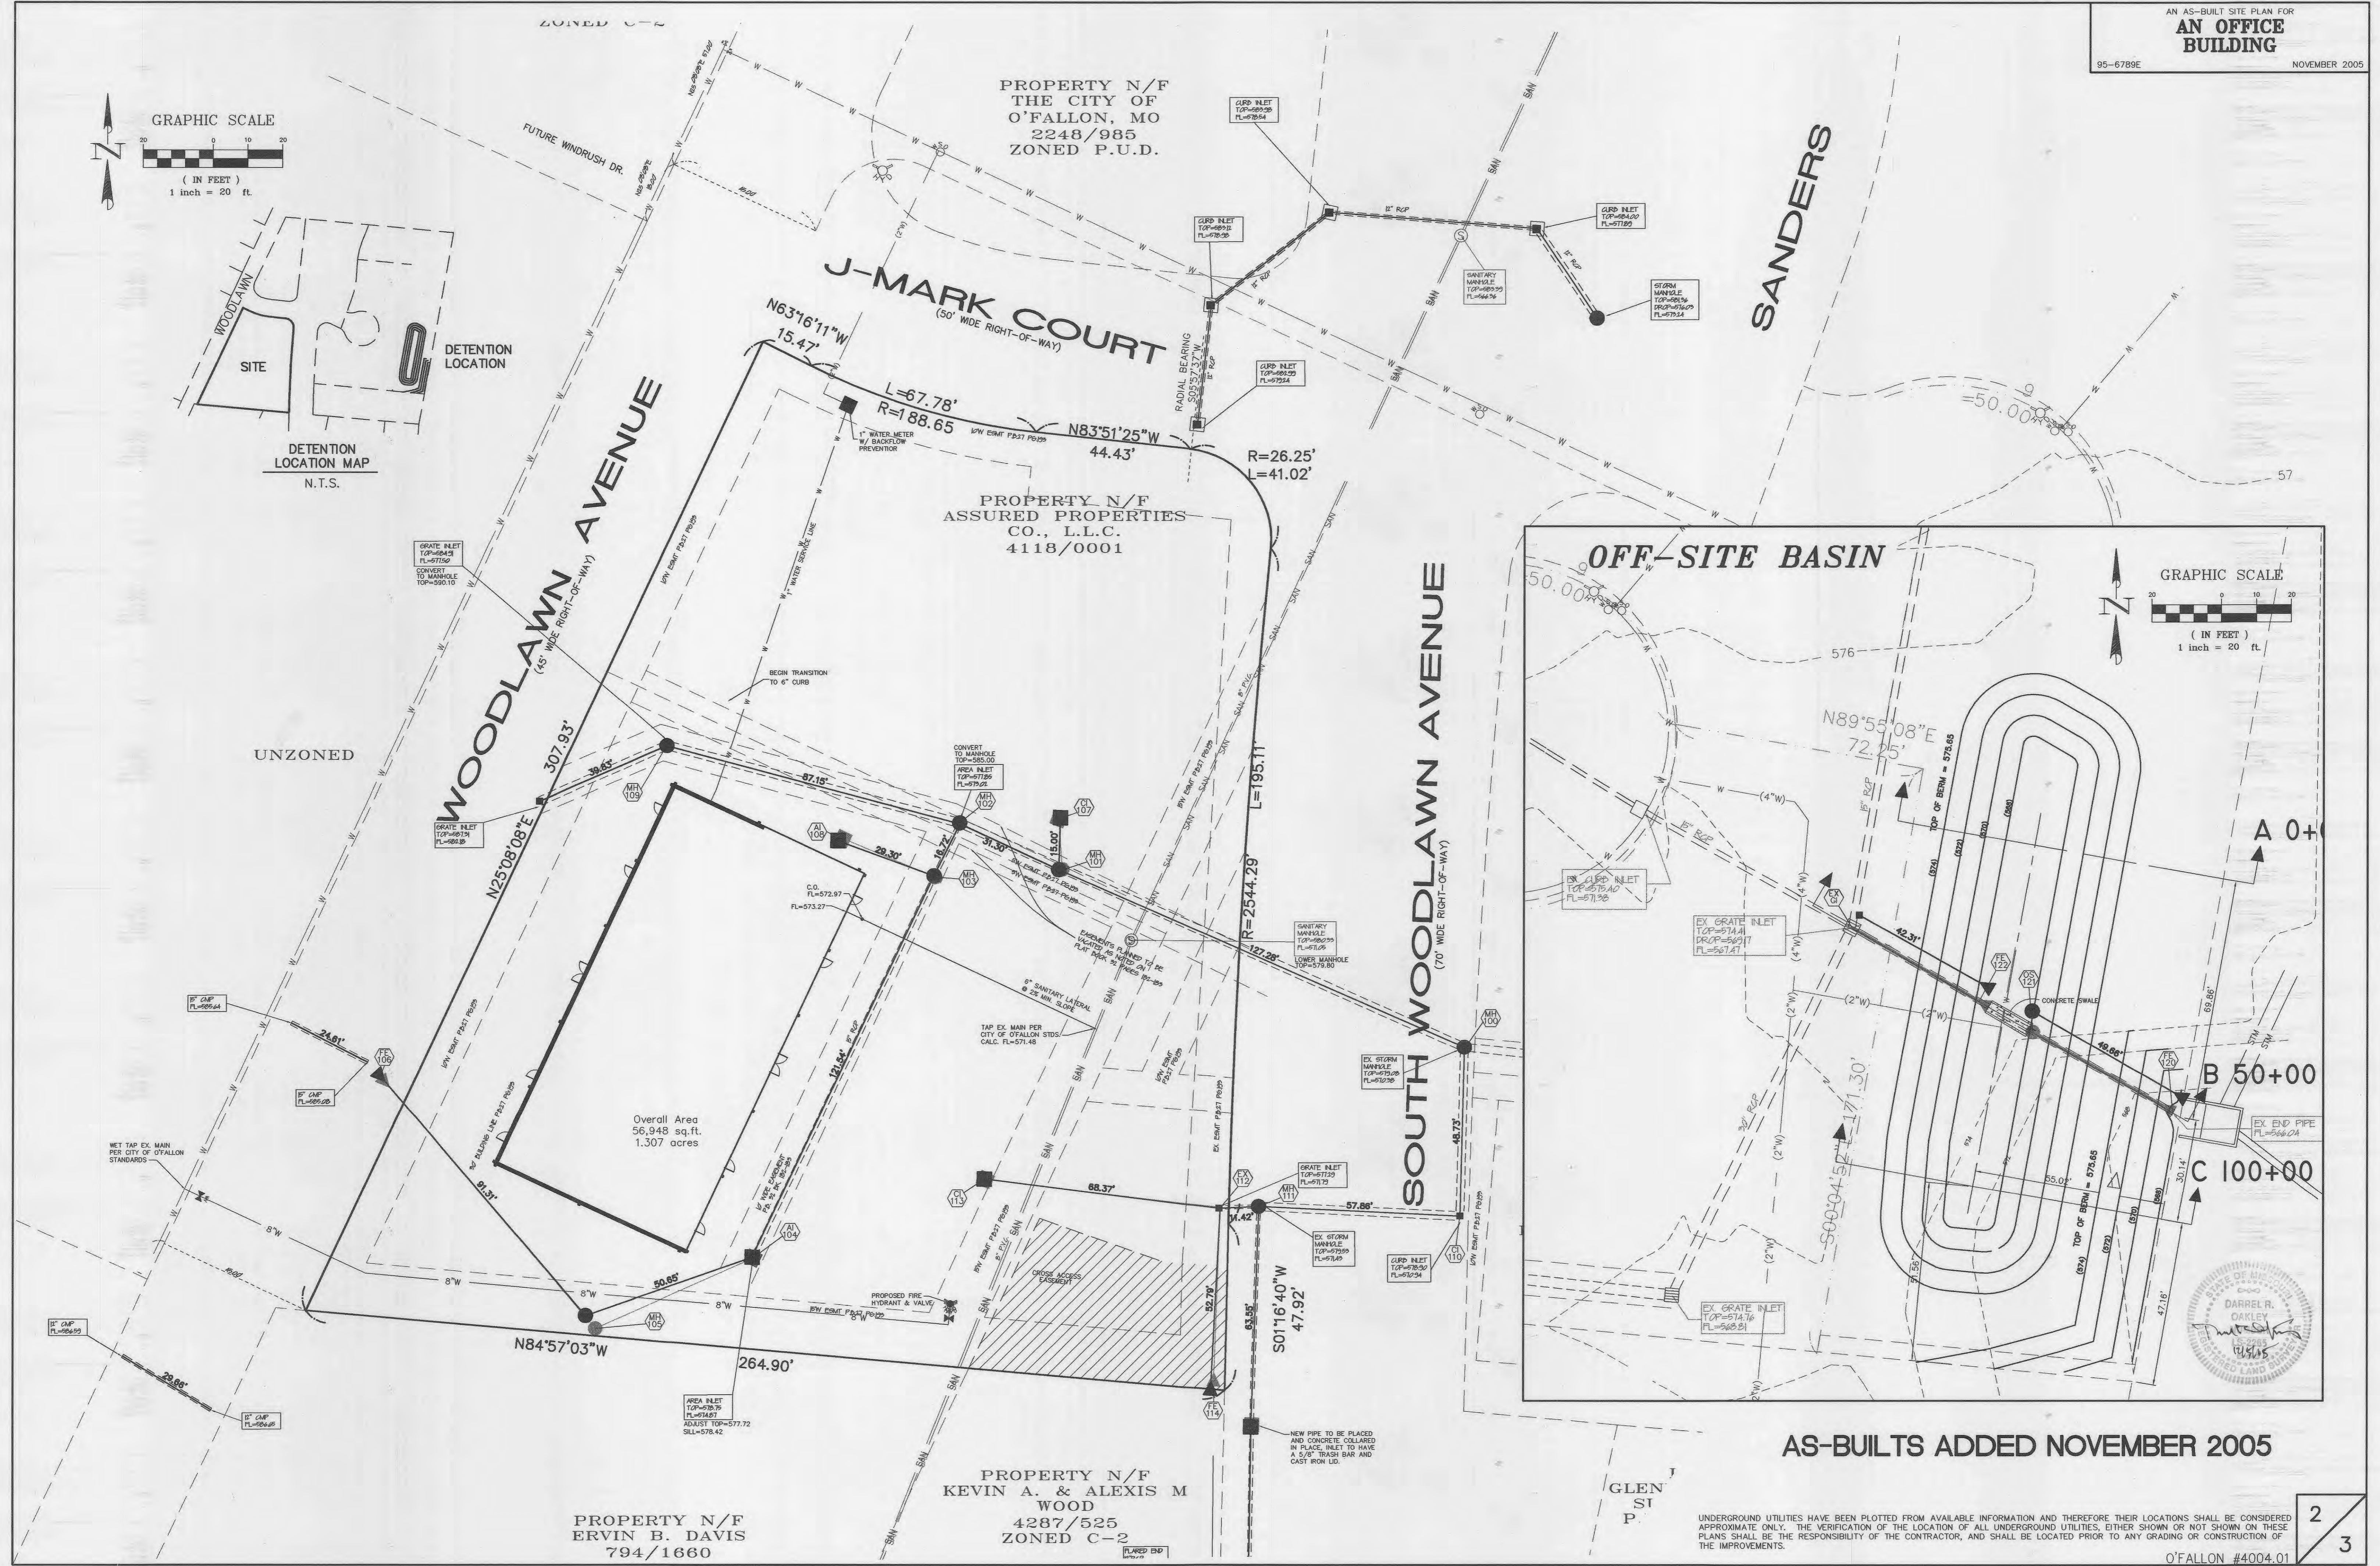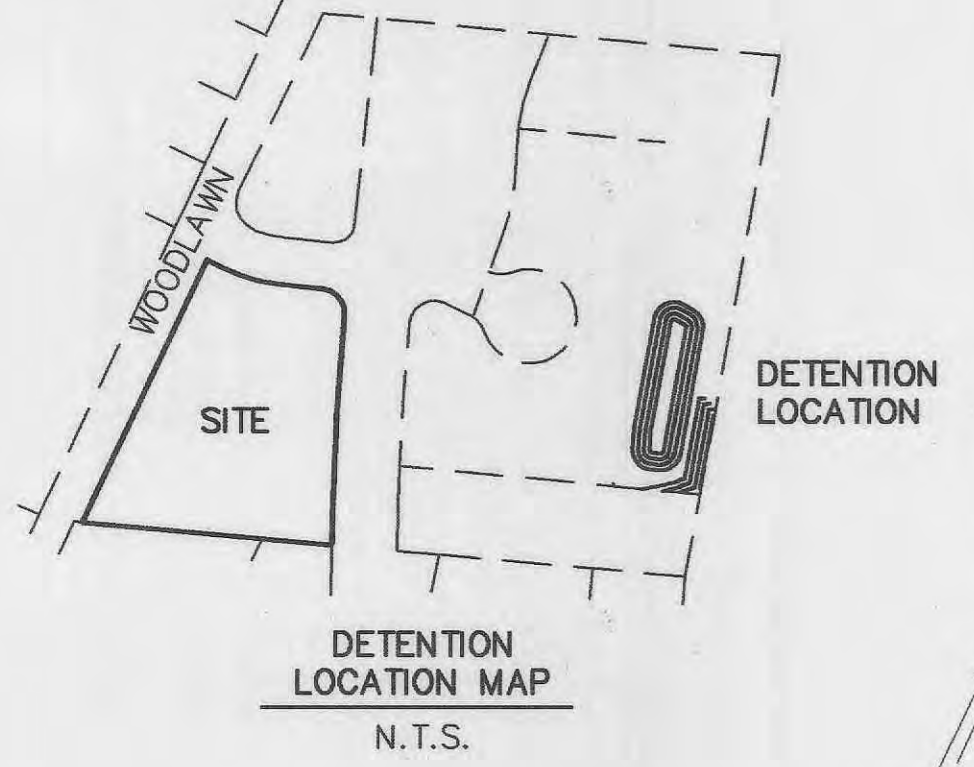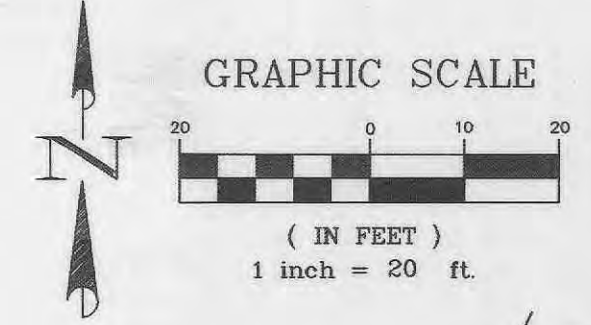


UNDERGROUND UTILITIES HAVE BEEN PLOTTED FROM AVAILABLE INFORMATION AND THEREFORE THEIR LOCATIONS SHALL BE CONSIDERED APPROXIMATE ONLY. THE VERIFICATION OF THE LOCATION OF ALL UNDERGROUND UTILITIES, EITHER SHOWN OR NOT SHOWN ON THESE PLANS SHALL BE THE RESPONSIBILITY OF THE CONTRACTOR, AND SHALL BE LOCATED PRIOR TO ANY GRADING OR CONSTRUCTION OF THE IMPROVEMENTS.

2
3

O'FALLON #4004.01



J mark Office Bldg

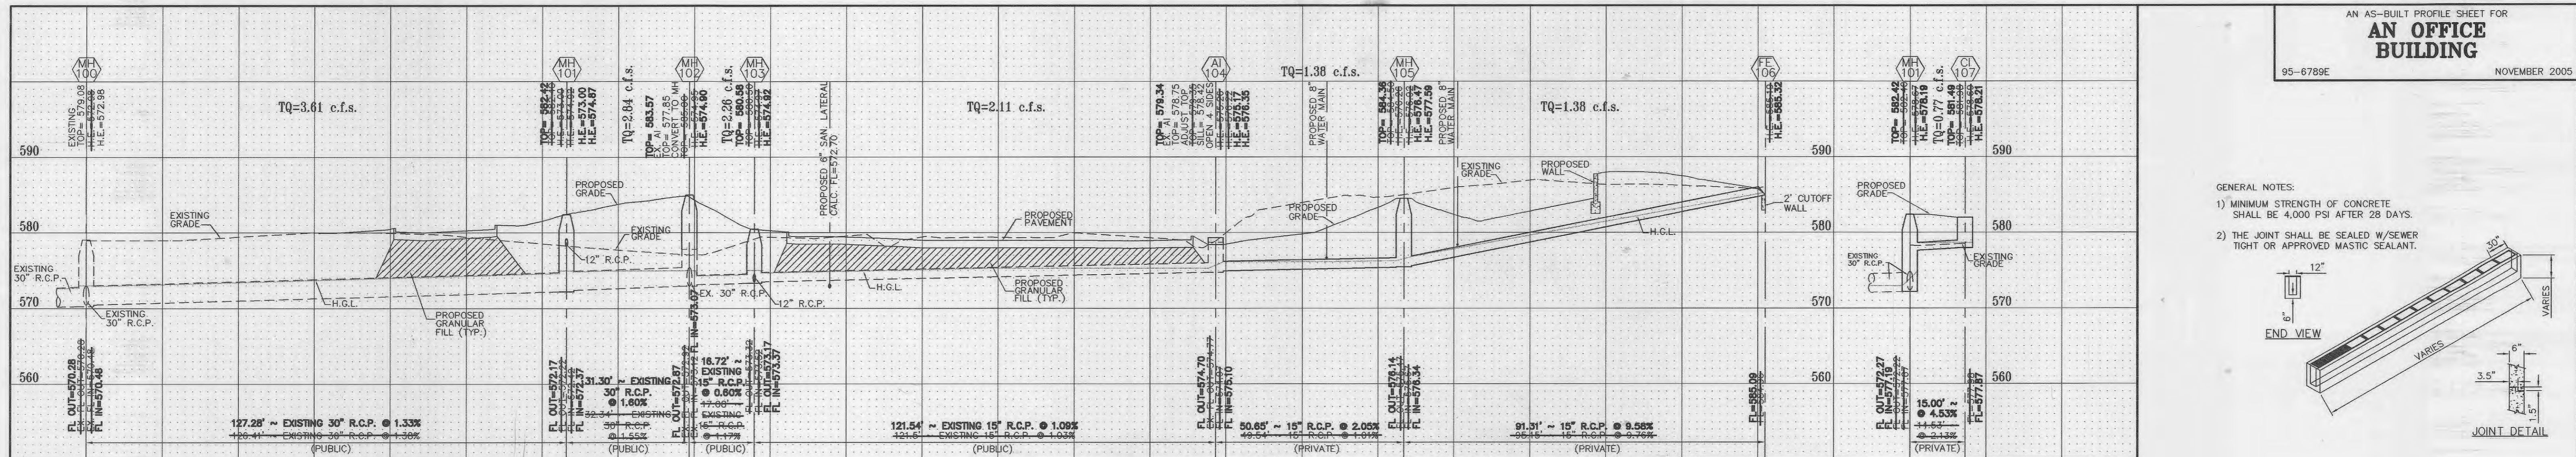

STORM SEWER PROFILES
SCALE: 1" = 20' HORIZONTAL
1" = 10' VERTICAL

STORM SEWER PROFILES
SCALE: 1" = 20' HORIZONTAL
1" = 10' VERTICAL



STORM SEWER PROFILES
SCALE: 1" = 20' HORIZONTAL
1" = 10' VERTICAL

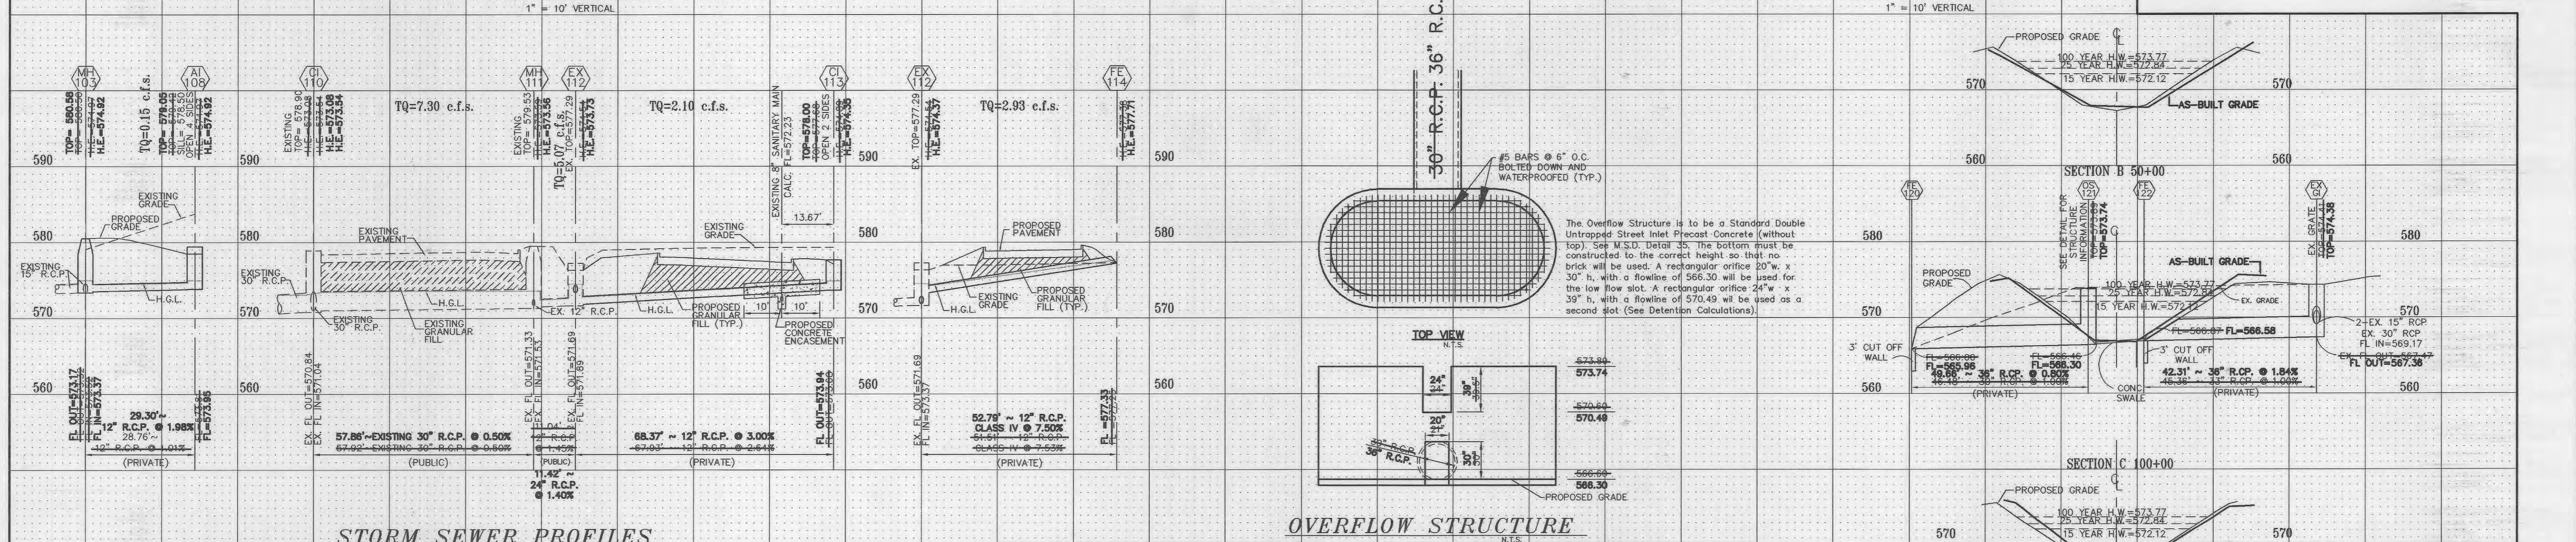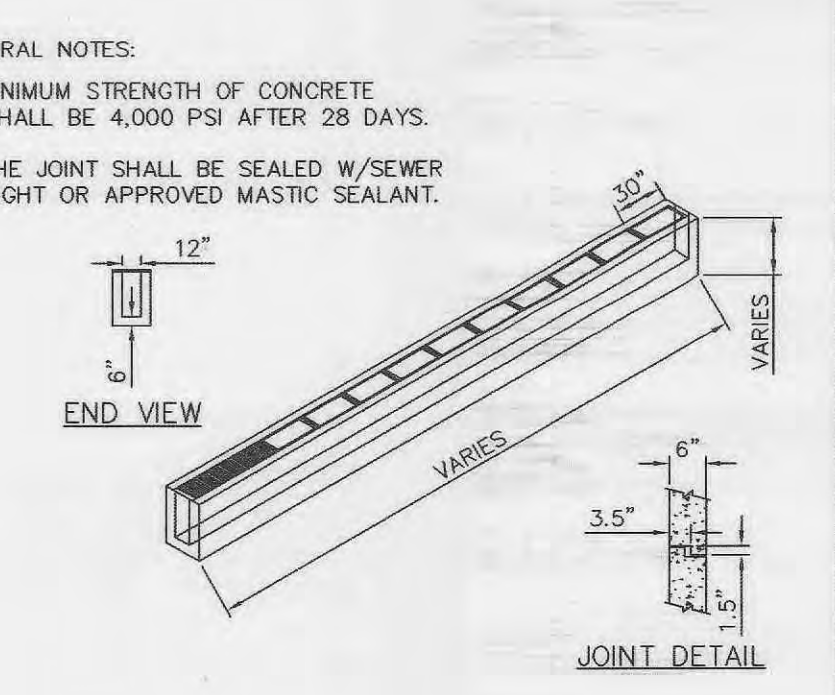

STORM SEWER PROFILES
SCALE: 1" = 20' HORIZONTAL
1" = 10' VERTICAL

OVERFLOW STRUCTURE
N.T.S.

DETENTION BASIN SECTIONS
SCALE: 1" = 20' HORIZONTAL
1" = 10' VERTICAL

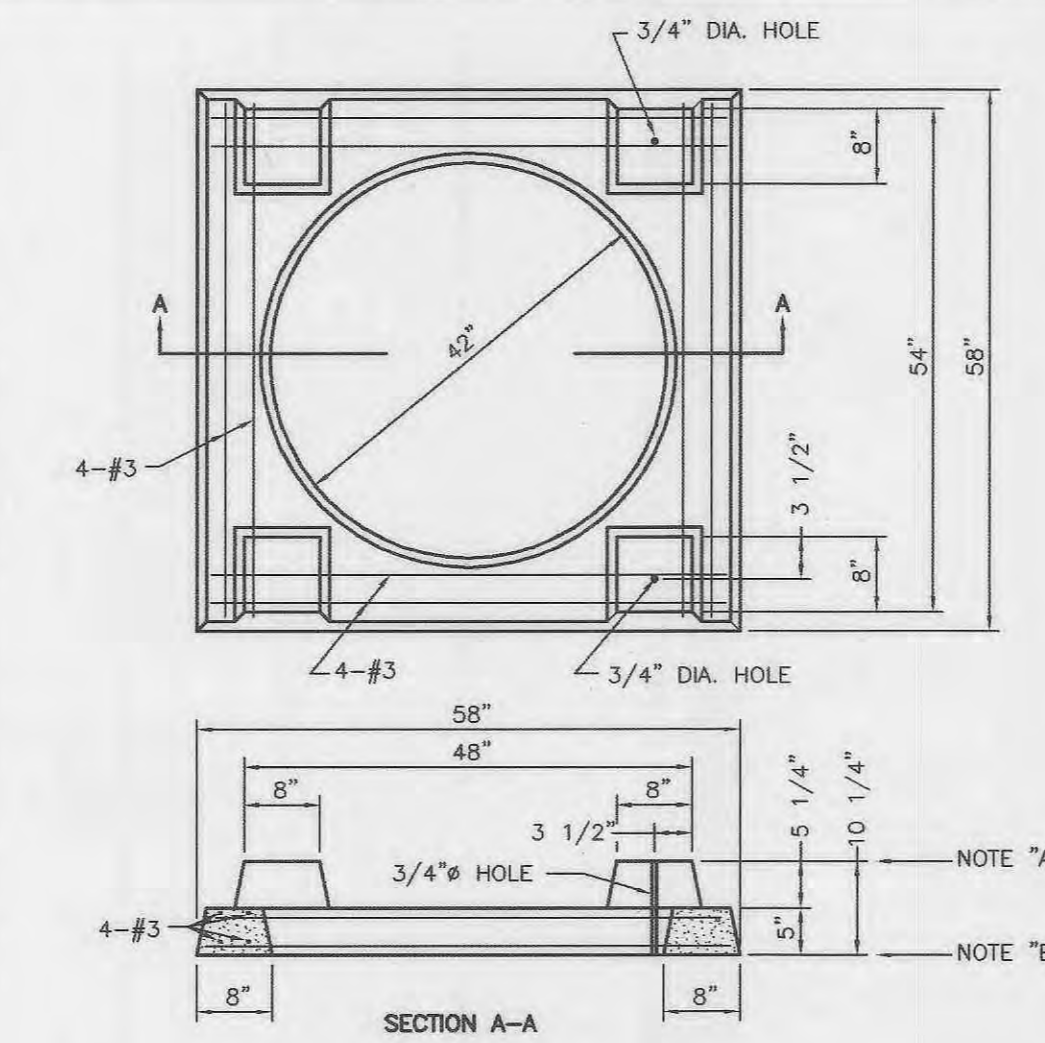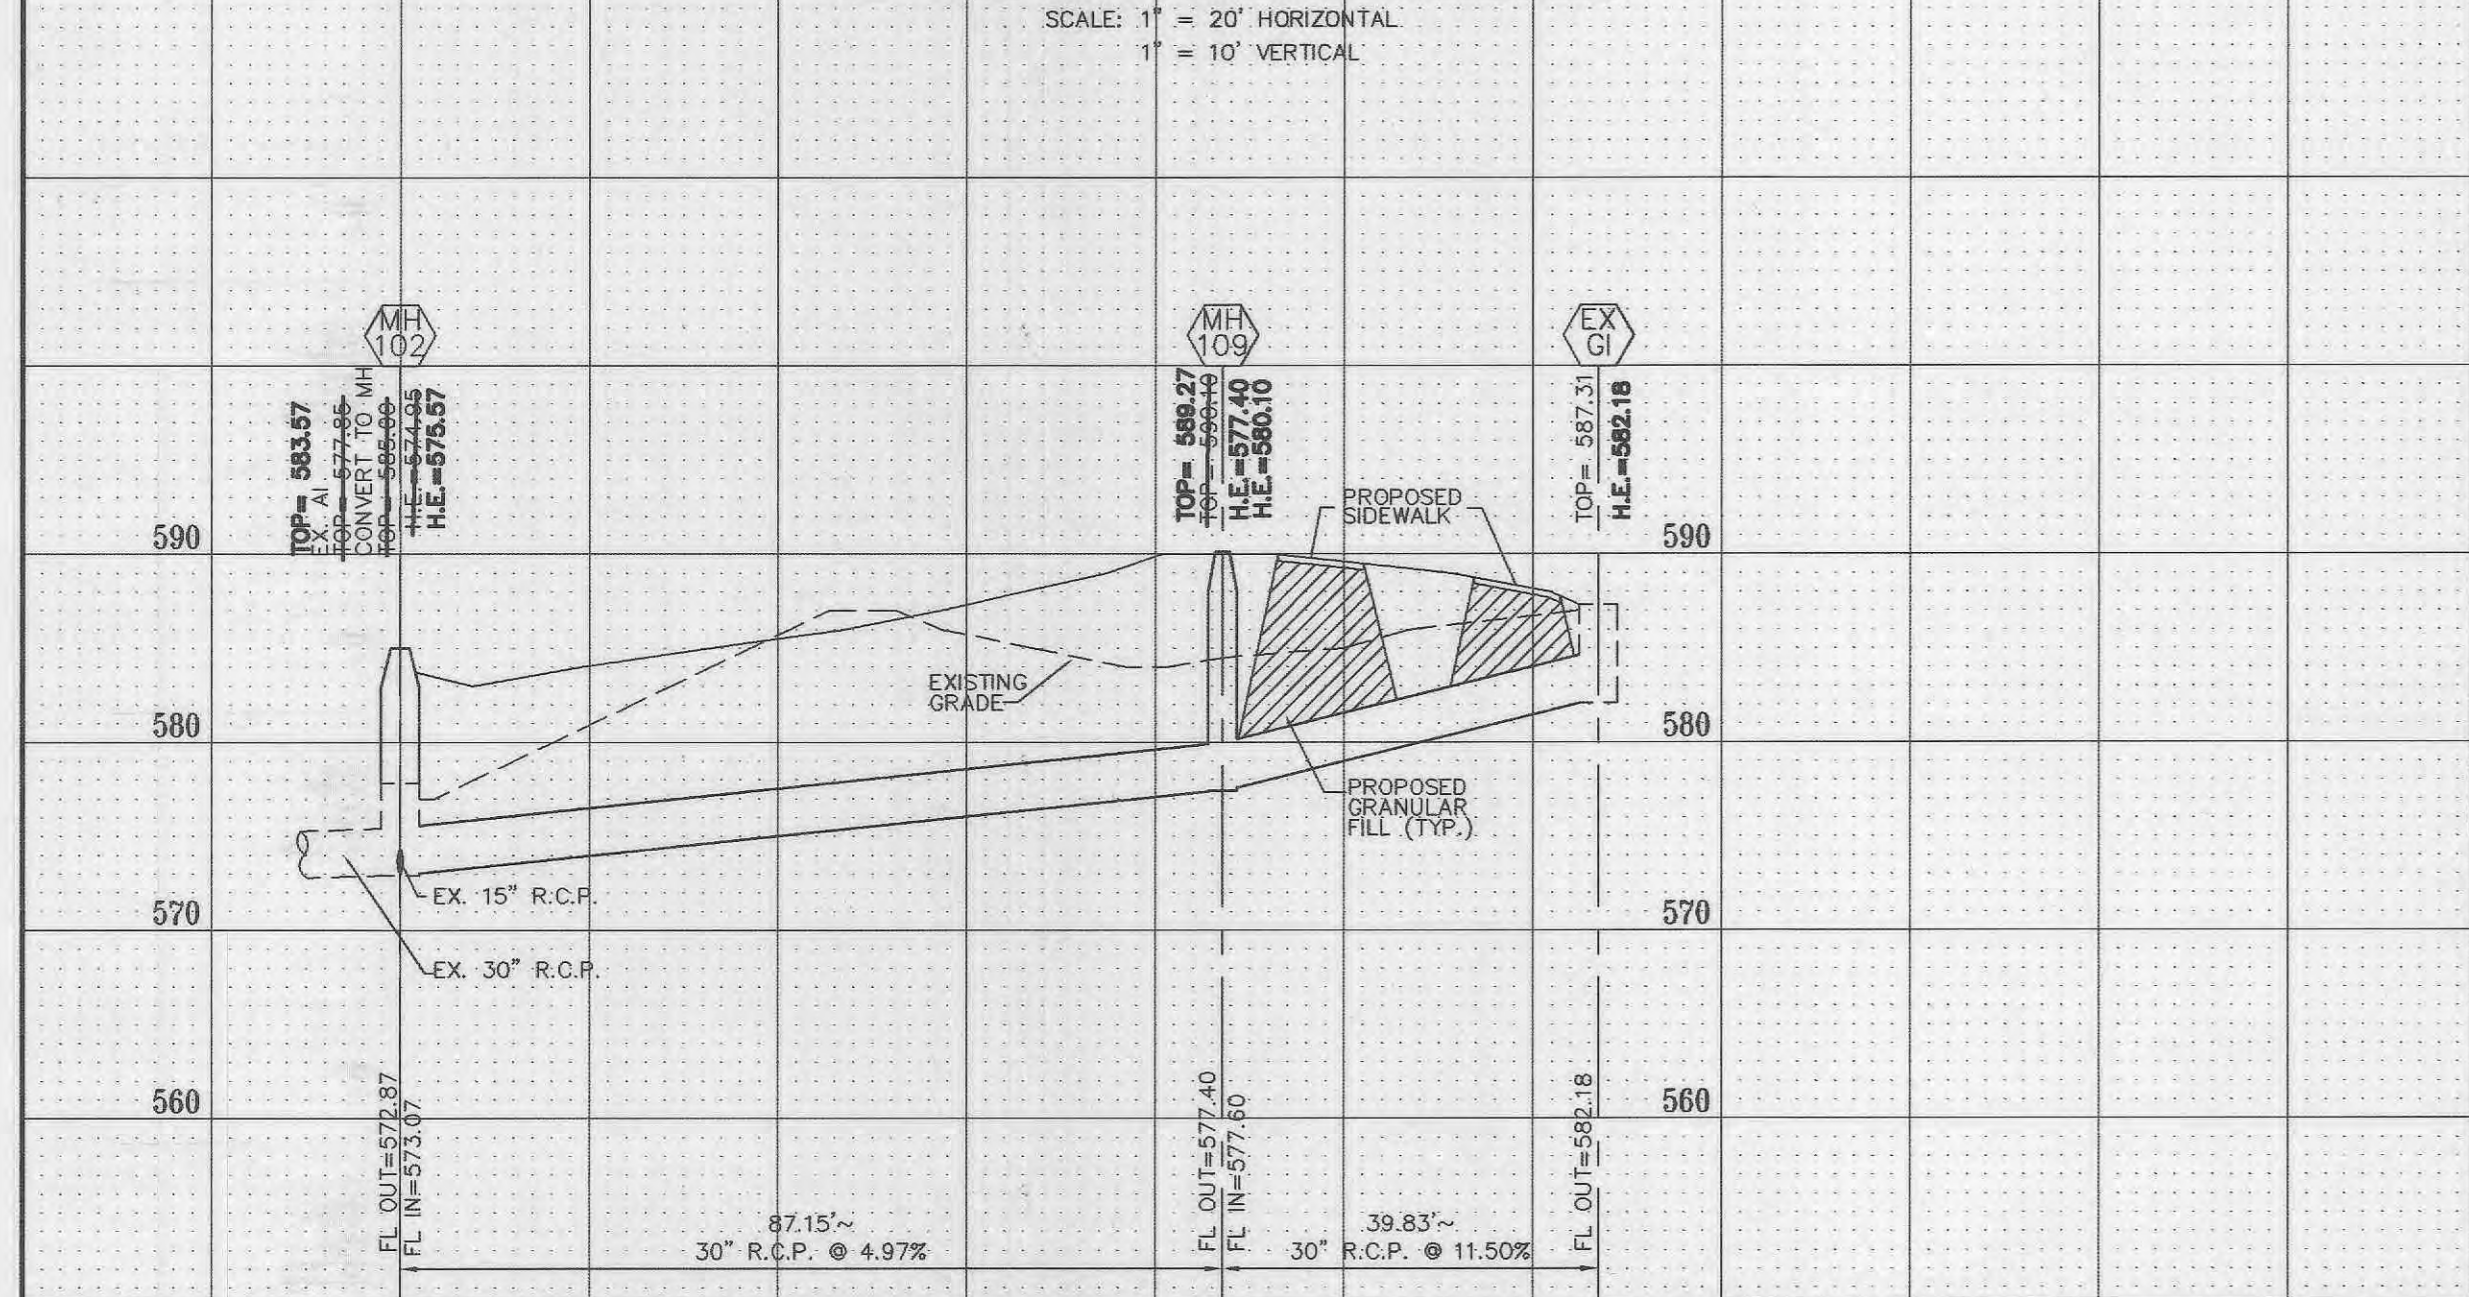

4000 P.S.I. CONCRETE REQUIRED

NOTES:
A. SET STANDARD INLET STONE IN 3/4" MORTAR BED AND DOWEL WITH 5/8" DIA. 1'-0" LONG PINS AND GROUT.
B. RAISE TO FINAL GRADE WITH COURSES OF BRICK AND SET THE UNIT TO BASE WITH 3/4" MORTAR BED.
C. THIS UNIT TO BE USED WITH 42" L.D., POURED IN PLACE CONCRETE OR BRICK BASE.
D. PROVIDE 5/8" DIAMETER TRASH BAR REQUIRED.

PRECAST CONCRETE UNIT FOR 4-WAY AREA INLET

BAX PROJECT NAME : OFFICE BUILDING (AS-BUILT)
BAX PROJECT NO. : 95-6789E
DESIGN DATE : 11-07-05
DESIGNED BY : ALJ

DATE SUBMITTED: 11-07-05 FILENAME: 95-6789E (AS BUILT)

UPP STR	LOW STR	L	DIA	UPPER FL LN	LOWER FL LN	PS	UPPER ST EL	DEPTH HY GR	UPPER HY EL	LOWER HY EL	HYDR GRADE	FR HEAD	VEL HEAD	VEL HEAD	JUNC LOSS	TURN LOSS	TQ	PIPE CAP	REMARKS
FE114	EX112	53	12	577.33	573.37	7.50	578.33	0.63	577.71*	574.37	.00680	0.36	3.73	0.22	0.22	0.00	2.93	9.76	1
CI113	EX112	68	12	573.94	571.99	3.00	578.00	3.65	574.35*	573.73	.00250	0.24	2.67	0.11	0.11	0.00	2.10	6.17	2
EX112	MH111	11	24	571.69	571.53	1.40	577.29	3.56	573.73	573.56	.00050	0.01	1.61	0.04	0.00	0.16	5.07	26.78	3
MH111	CI110	58	30	571.33	571.04	0.50	579.53	5.97	573.56	573.54	.00050	0.02	1.49	0.03	0.00	0.00	7.30	29.04	4
CI110	MH100	49	30	570.84	570.48	0.74	578.90	5.82	573.08	572.98	.00050	0.03	1.95	0.06	0.05	0.02	9.56	35.26	5
HW=572.98																			
AI108	MH103	29	12	573.95	573.37	1.98	579.05	4.13	574.92	574.92	.00000	0.00	0.19	0.00	0.00	0.00	0.15	5.01	6
EXGI	MH109	40	30	582.18	577.60	11.50	587.31	5.13	582.18*	580.10	.00000	0.00	0.12	0.00	0.00	0.00	0.58	139.09	7
MH109	MH102	87	30	577.40	573.07	4.97	590.10	12.70	577.40*	575.57	.00000	0.00	0.12	0.00	0.00	0.00	0.58	91.43	8
CI107	MH101	15	12	577.87	577.19	4.53	581.49	3.28	578.21	578.19	.00050	0.01	0.98	0.01	0.01	0.00	0.77	7.59	9
FE106	MH105	91	15	585.09	576.34	9.58	586.34	1.03	585.32*	577.59	.00050	0.04	1.12	0.02	0.02	0.00	1.38	20.00	10
MH105	AI104	51	15	576.14	575.10	2.05	584.36	7.89	576.47*	576.35	.00050	0.02	1.12	0.02	0.01	0.01	1.38	9.26	11
AI104	MH103	122	15	574.70	573.37	1.09	579.34	4.17	575.37*	574.92	.00110	0.13	1.72	0.05	0.04	0.01	2.11	6.76	12
MH103	MH102	17	15	573.17	573.07	0.60	580.59	5.66	574.92	574.90	.00120	0.02	1.84	0.05	0.00	0.00	2.26	5.00	13
MH102	MH101	31	30	572.87	572.37	1.60	583.57	8.67	574.90	574.87	.00000	0.00	0.58	0.01	0.00	0.03	2.84	51.84	14
MH101	MH100	127	30	572.17	570.48	1.33	582.42	9.42	573.00	572.98	.00010	0.01	0.74	0.01	0.00	0.01	3.61	47.26	15
HW=572.98																			

* INDICATES CRITICAL DEPTH



AS-BUILTS ADDED NOVEMBER 2005