

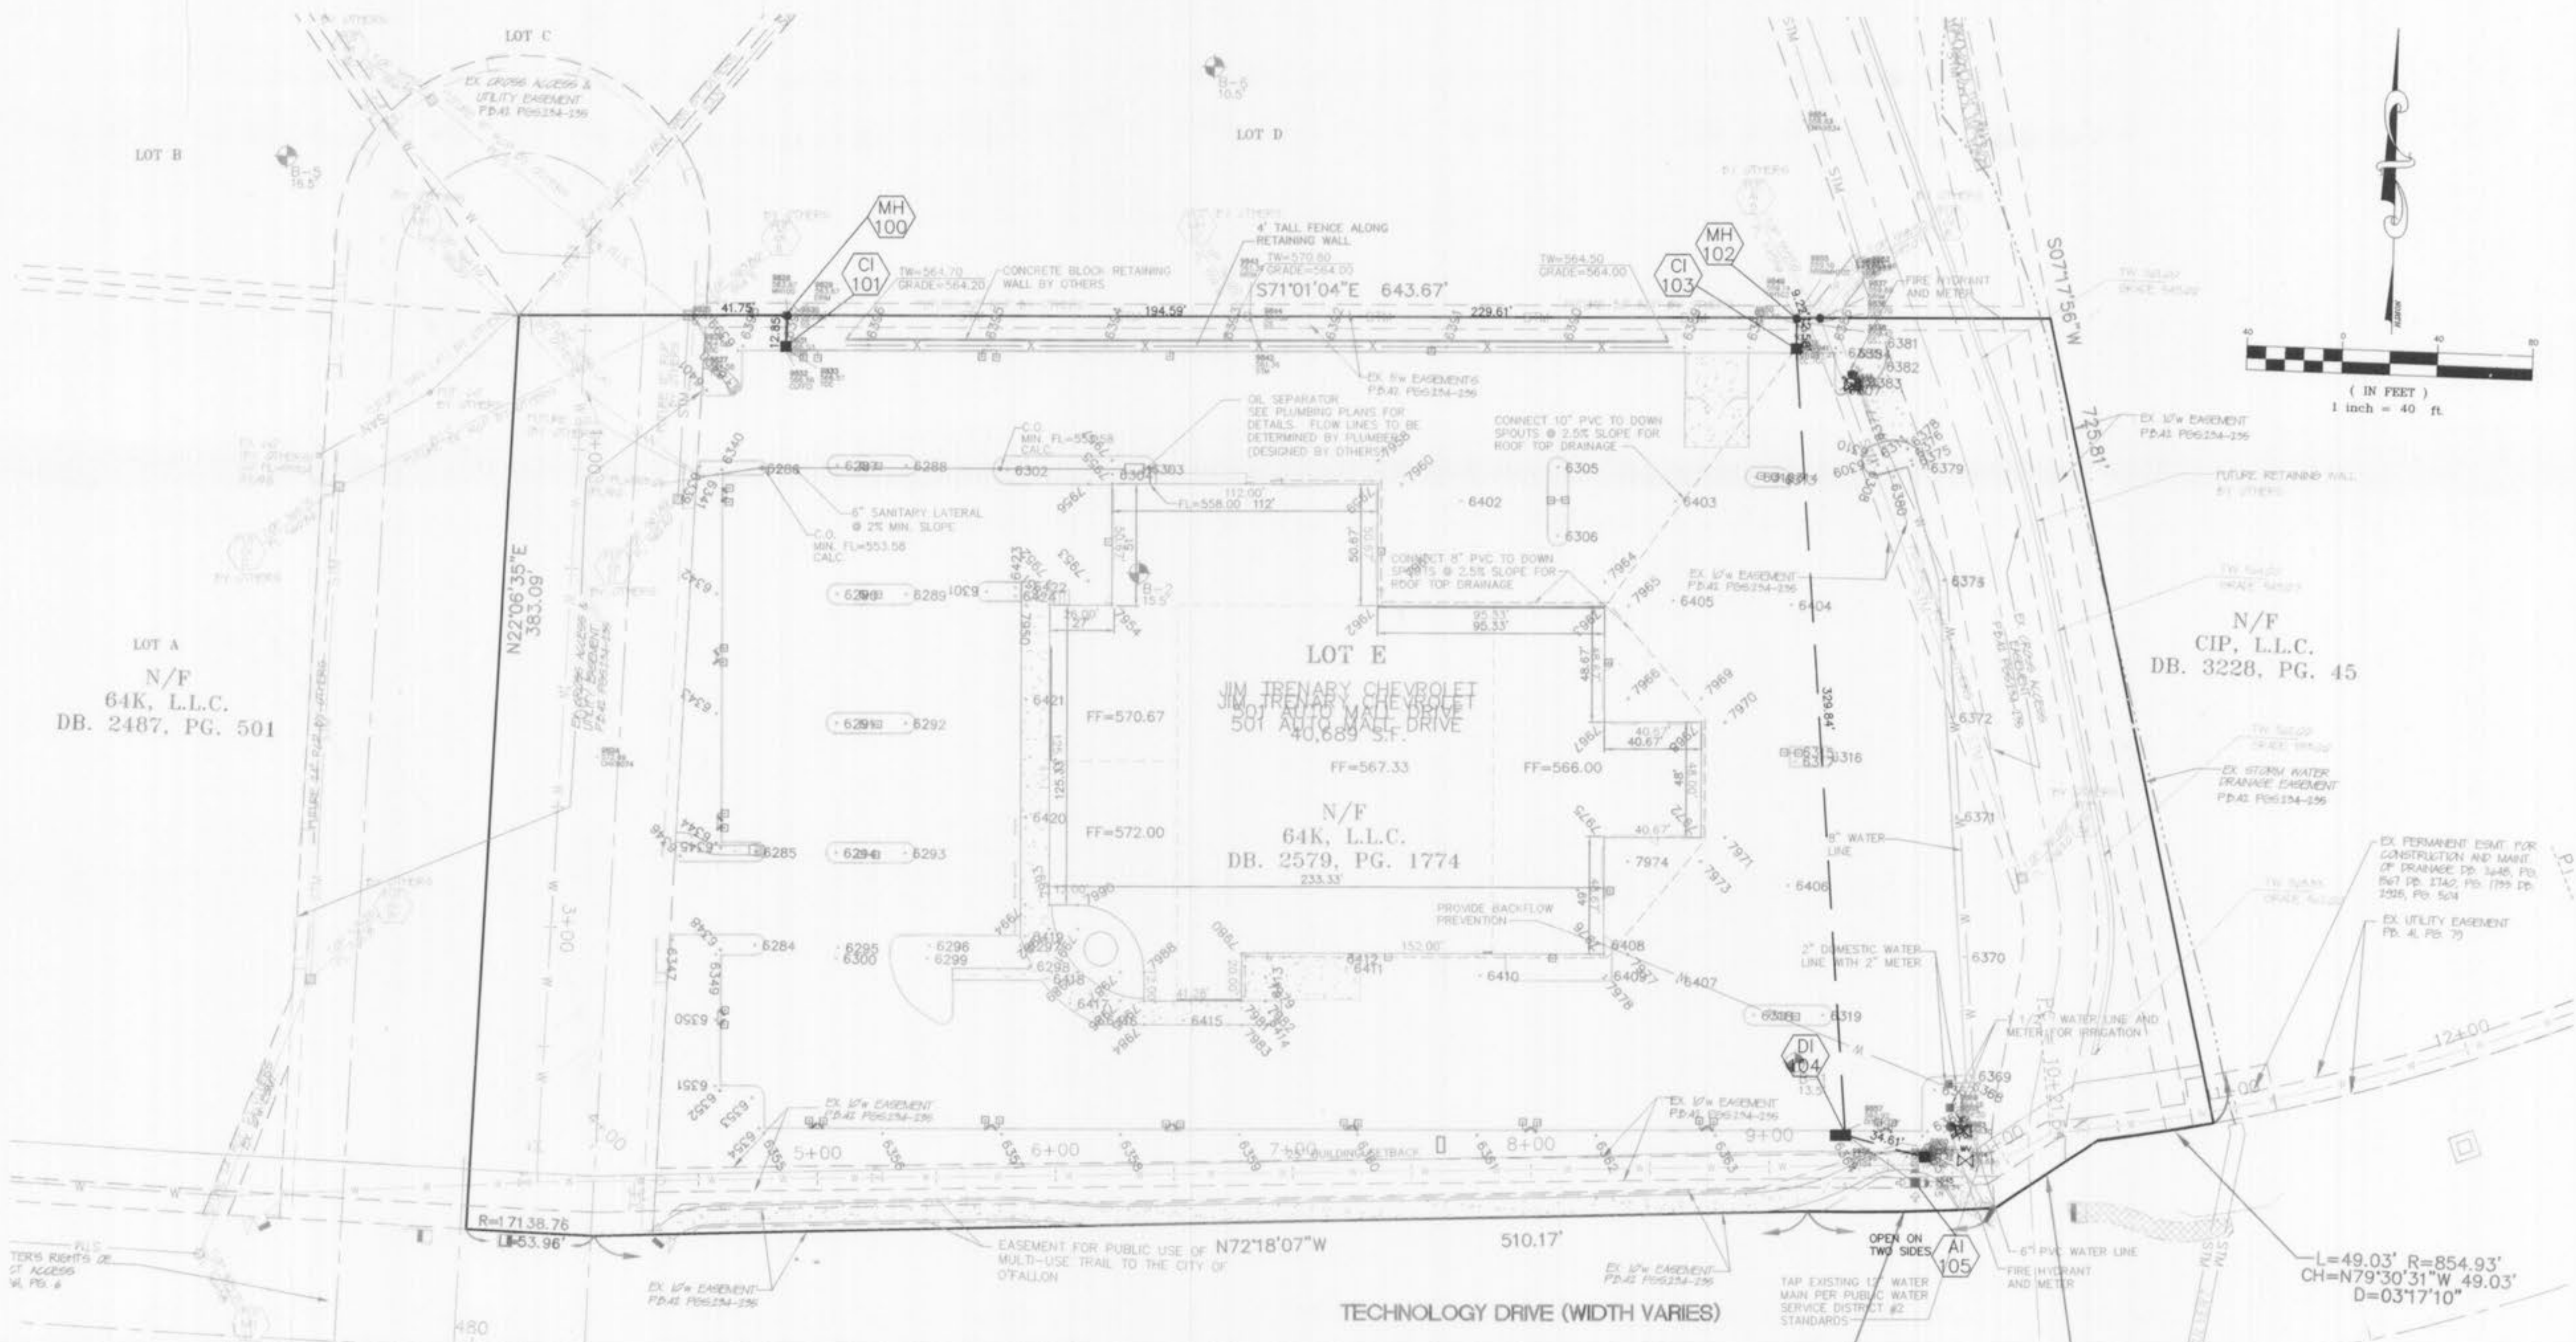
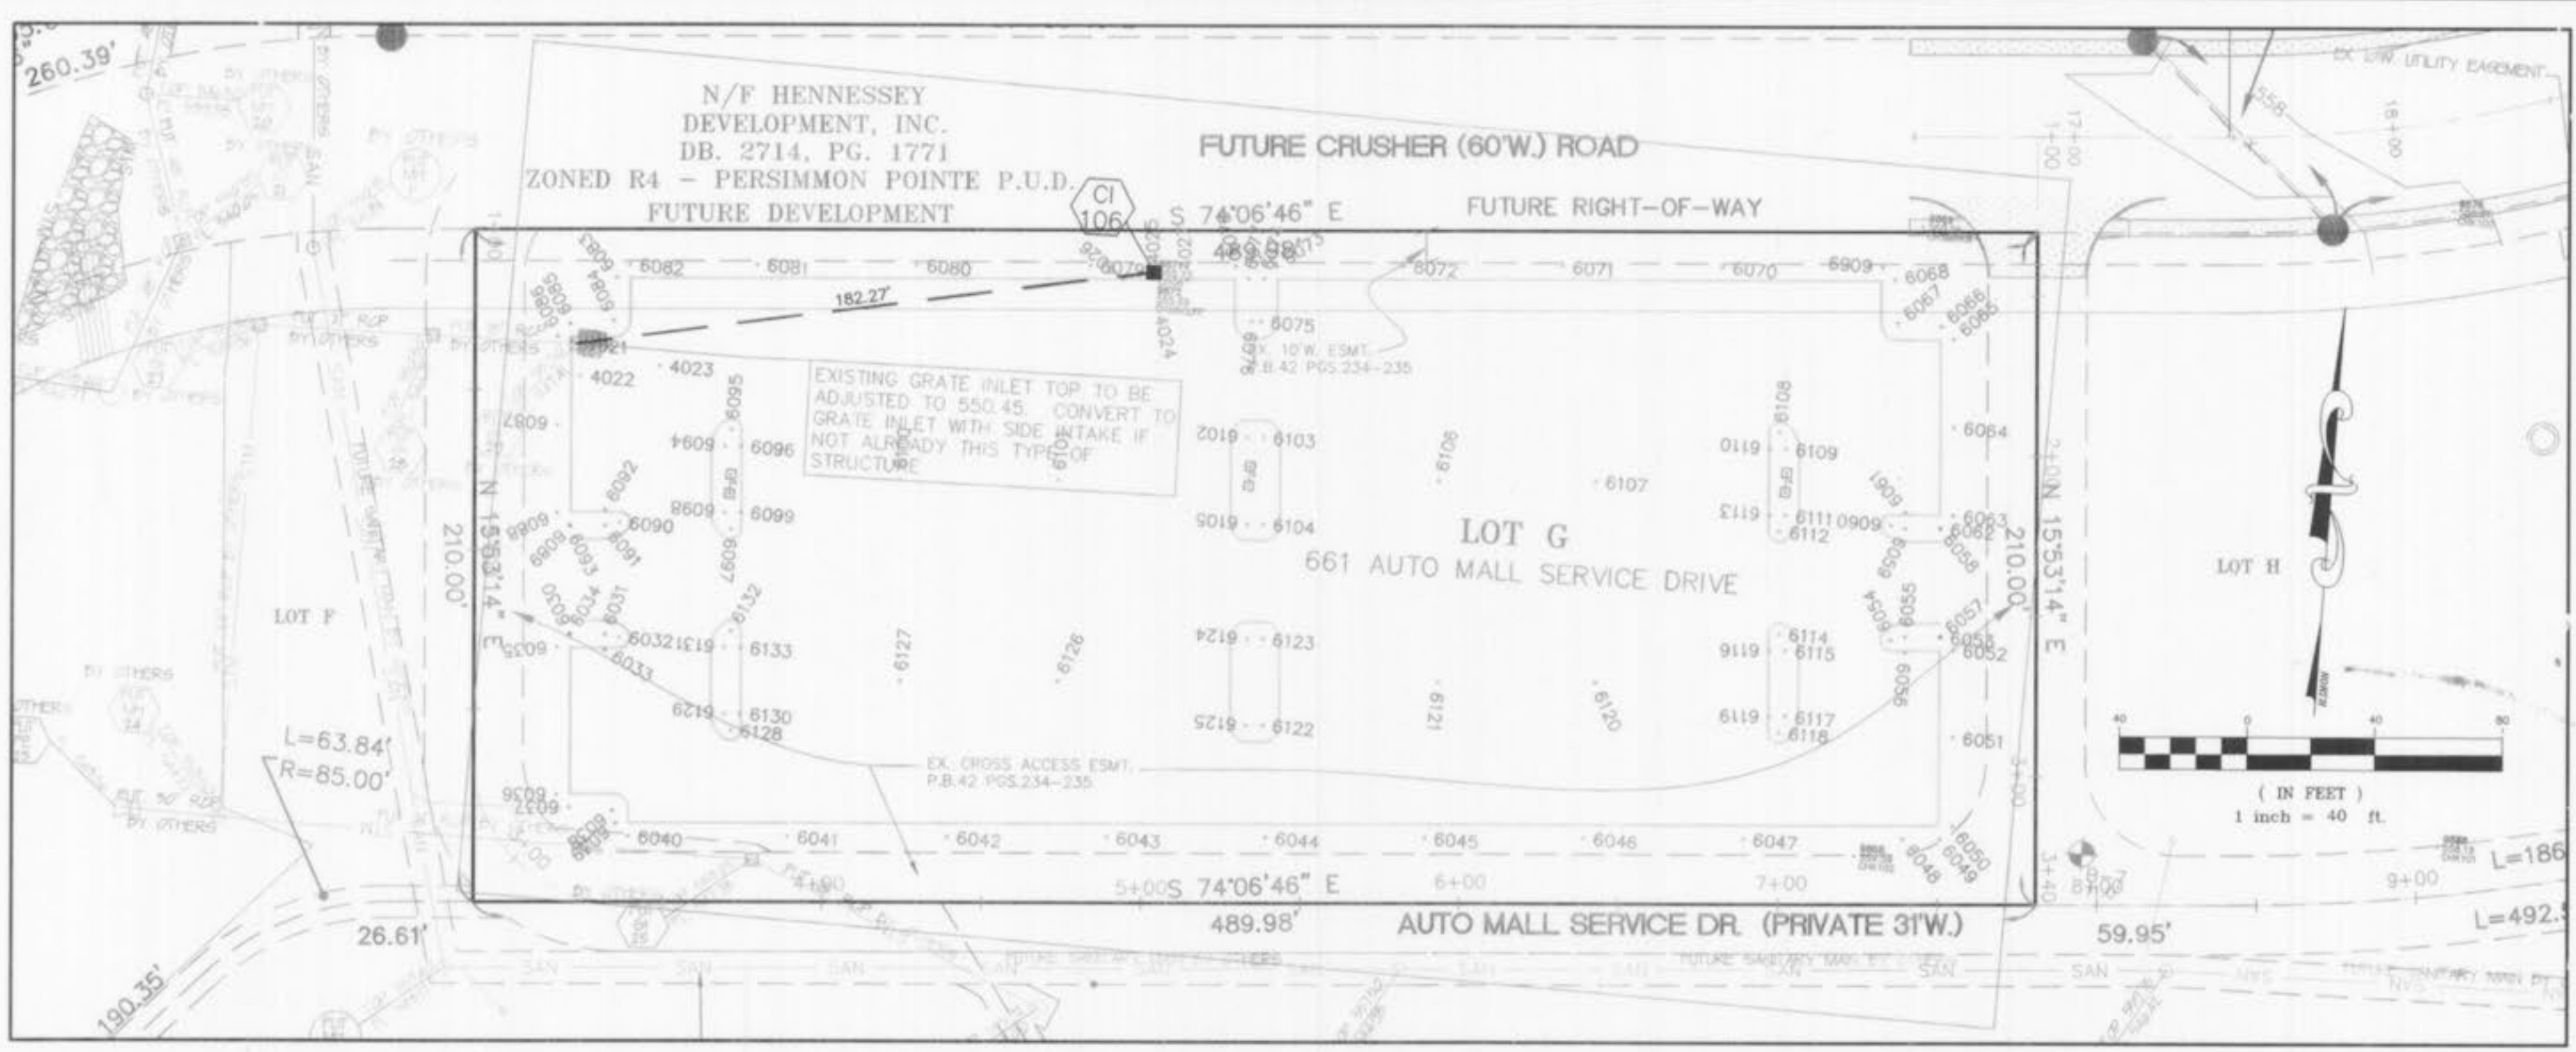


ASBUILTS ADDED JULY, 2007

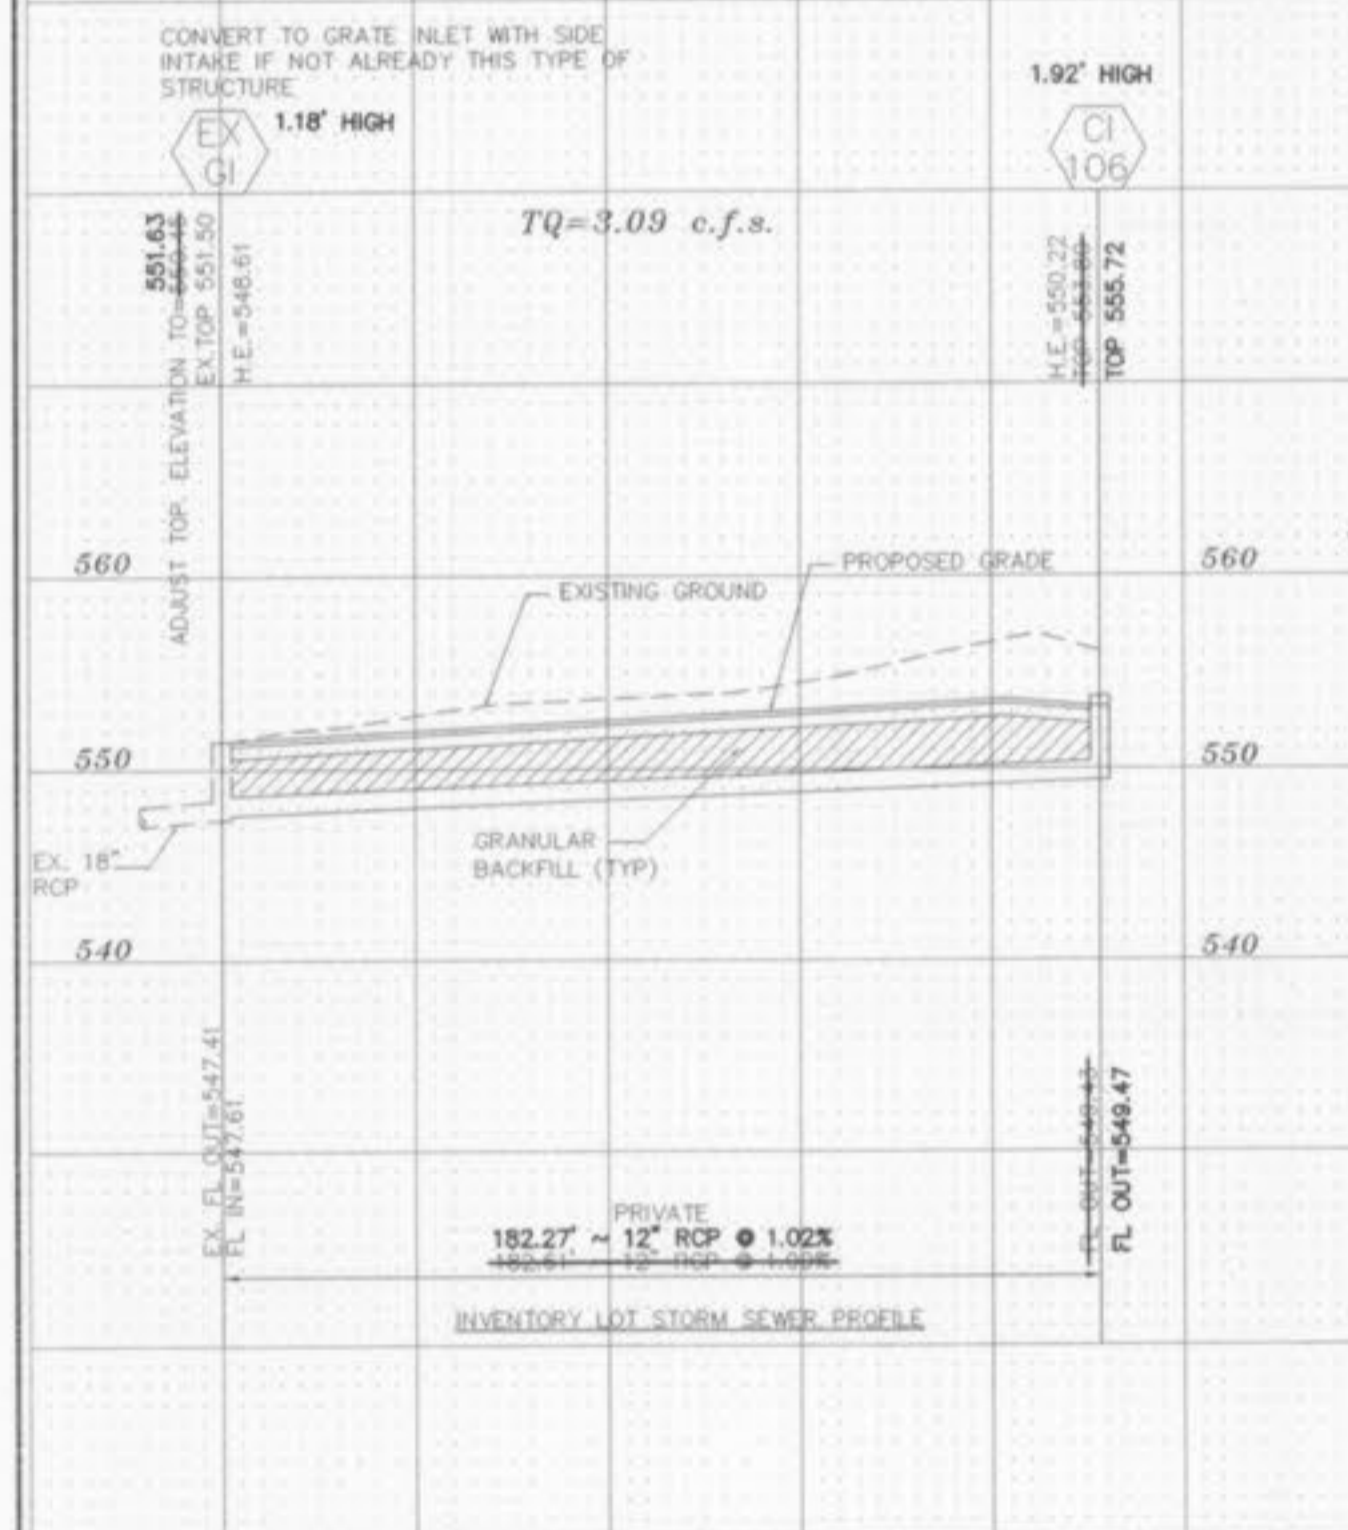

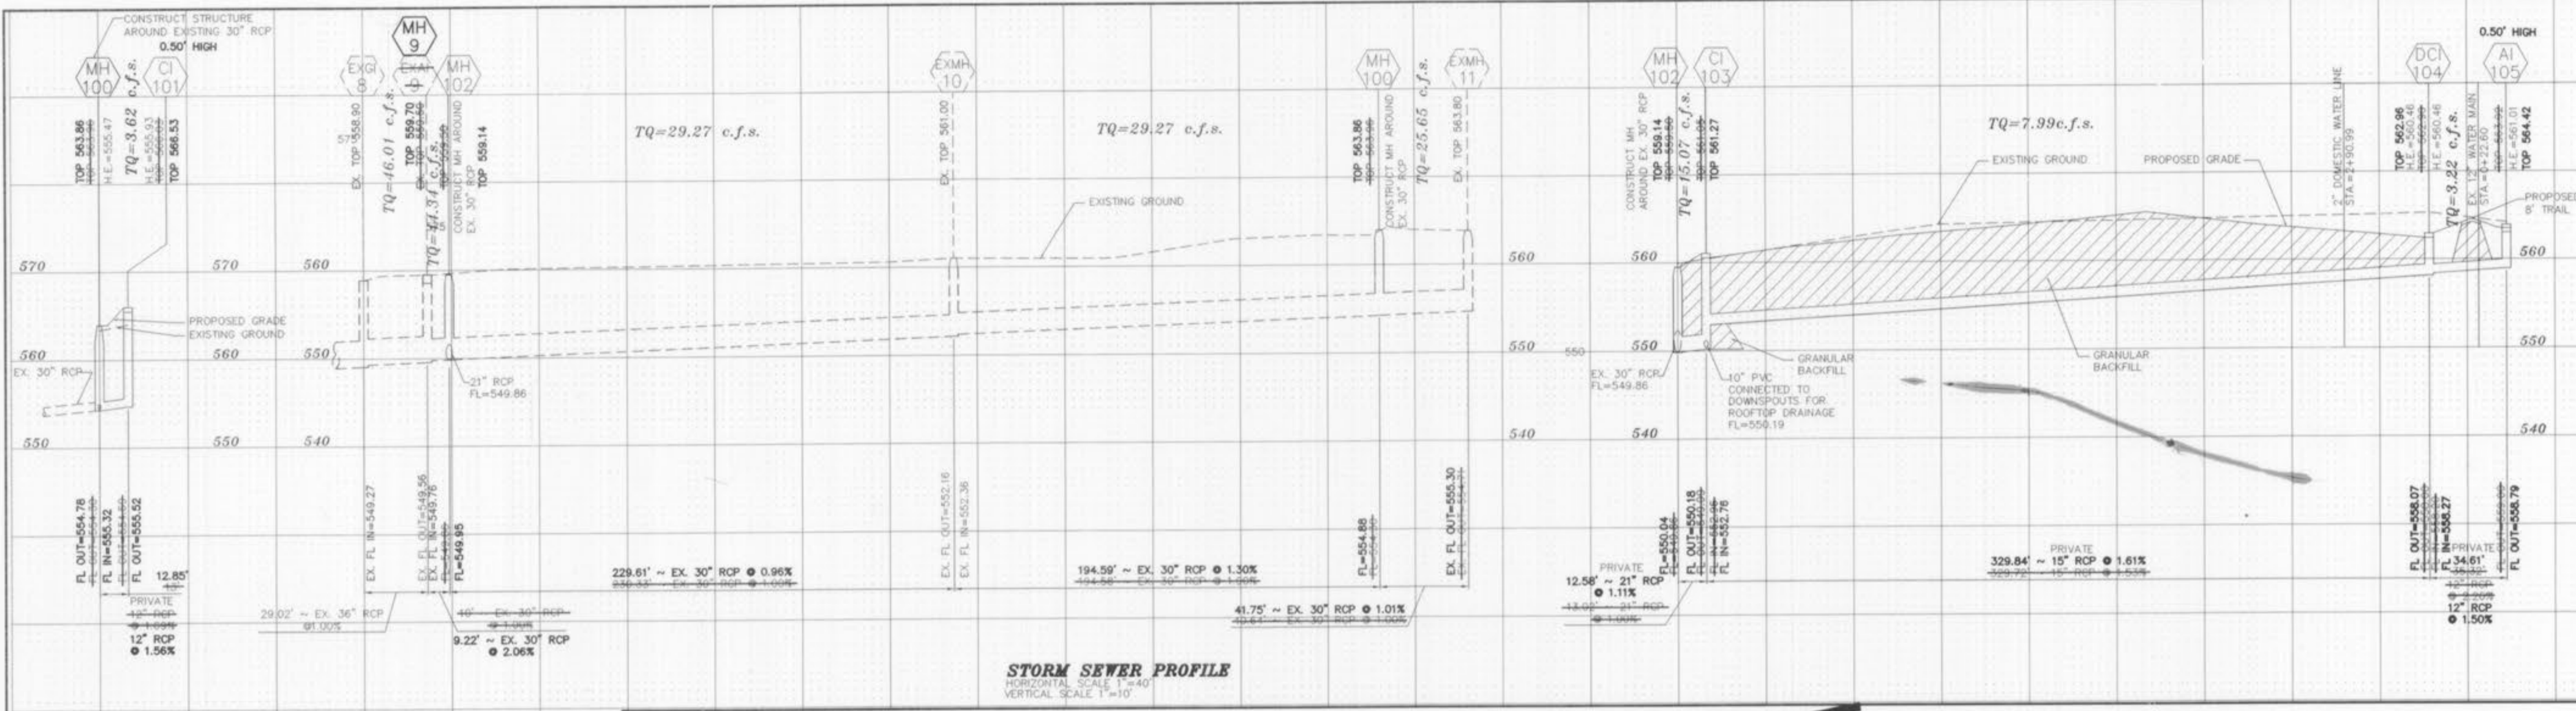

FILENAME: 13173 DESIGN HYDRAULICS

UPP STR	LOW STR	L DIA	UPPER FL LN	LOWER FL LN	PS	UPPER ST EL	DEPTH HY GR	UPPER HY EL	LOWER HY EL	HYDR GRADE	FR HEAD	VEL	VEL HEAD	JUNC LOSS	TURN LOSS	TQ	PIPE CAP	REMARKS
CI 101 MH 100	13	12	554.69	554.30	1.56	566.03	8.50	557.53	557.07	.01030	0.13	4.61	0.33	0.33	0.00	3.62	6.17	1
AI 105 DCI 104	35	12	559.00	558.20	2.26	563.24	6.11	561.27	560.30	.00820	0.29	4.10	0.26	0.26	0.00	3.22	5.36	2
DCI 104 CI 103	330	15	558.00	552.96	1.53	562.50	1.78	555.68	554.99	.01530	5.04	6.51	0.66	0.61	0.13	7.99	7.99	3
CI 103 MH 102	13	21	549.99	549.86	1.00	561.05	6.11	555.68	554.81	.00900	0.12	6.27	0.61	0.28	0.03	15.07	15.83	4
EXGI 11MH 100	41	30	554.71	554.30	1.01	565.72	6.15	557.65	557.07	.00900	0.16	5.23	0.42	0.42	0.00	25.65	41.20	5
MH 100 EXMH 10	195	30	554.30	552.36	1.57	563.96	6.89	557.07	555.68	.00510	1.17	5.96	0.55	0.17	0.23	29.27	40.96	6
EXMH 10MH 102	230	30	552.16	549.95	0.96	561.00	5.32	555.68	554.51	.00510	1.17	5.96	0.55	0.00	0.00	29.27	40.99	7
MH 102 EXAI 9	10	30	549.95	549.76	1.00	559.50	4.99	554.51	553.12	.01170	0.12	9.03	1.27	0.84	0.43	44.34	41.01	8
EXAI 9 EXGI 8	79	30	549.56	549.27	1.00	559.50	6.38	553.12	552.27	.00480	0.14	6.51	0.66	0.66	0.00	46.01	66.67	9
* INDICATES CRITICAL DEPTH																		

FILENAME: 13173 AS BUILT HYDRAULICS

UPP STR	LOW STR	L DIA	UPPER FL LN	LOWER FL LN	PS	UPPER ST EL	DEPTH HY GR	UPPER HY EL	LOWER HY EL	HYDR GRADE	FR HEAD	VEL	VEL HEAD	JUNC LOSS	TURN LOSS	TQ	PIPE CAP	REMARKS
CI101 MH100	13	12	555.52	555.32	1.56	566.53	9.01	557.52	557.06	.01030	0.13	4.61	0.33	0.33	0.00	3.62	4.44	1
AI105 DCI104	35	12	558.79	558.27	1.50	564.42	3.13	561.29	560.75	.00820	0.28	4.10	0.26	0.26	0.00	3.22	4.37	2
DCI104 CI103	330	15	558.07	552.76	1.81	562.96	2.21	560.75	554.92	.01530	5.05	6.51	0.66	0.62	0.16	7.99	8.20	3
CI103 MH102	13	21	550.18	550.04	1.11	561.27	6.35	554.92	554.50	.00900	0.11	6.27	0.61	0.28	0.03	15.07	16.72	4
EXGI1 MH100	42	30	555.30	554.88	1.01	563.80	5.84	557.96	557.38	.00390	0.16	5.23	0.42	0.42	0.00	25.65	41.145	5
MH100 EXMH10	195	30	554.88	552.36	1.30	563.86	6.80	557.06	555.67	.00510	0.99	5.96	0.55	0.17	0.23	29.27	46.68	6
EXMH10 MH102	230	30	552.16	549.95	0.96	561.00	5.33	555.67	554.50	.00510	1.17	5.96	0.55	0.00	0.00	29.27	40.24	7
MH102 EXAI9	9	30	549.95	549.76	2.06	559.14	4.64	554.50	553.12	.01170	0.11	9.03	1.27	0.84	0.43	44.34	39.88	8
EXAI9 EXGI8	29	36	549.56	549.27	1.00	559.70	6.58	553.12	552.27	.00480	0.14	6.51	0.66	0.66	0.00	46.01	66.67	9
CI106 EXGI	182	12	549.47	547.61	1.02	555.72	5.20	550.52	548.91	.00750	1.37	3.93	0.24	0.24	0.00	3.09	3.60	10
* INDICATES CRITICAL DEPTH																		

