



## FLAT PLAN

KINGSPONTE

MAY 29, 1989 89-3080


REV. G-7-89

REV. G-21-89

20'

N

SCALE: 1"=50'

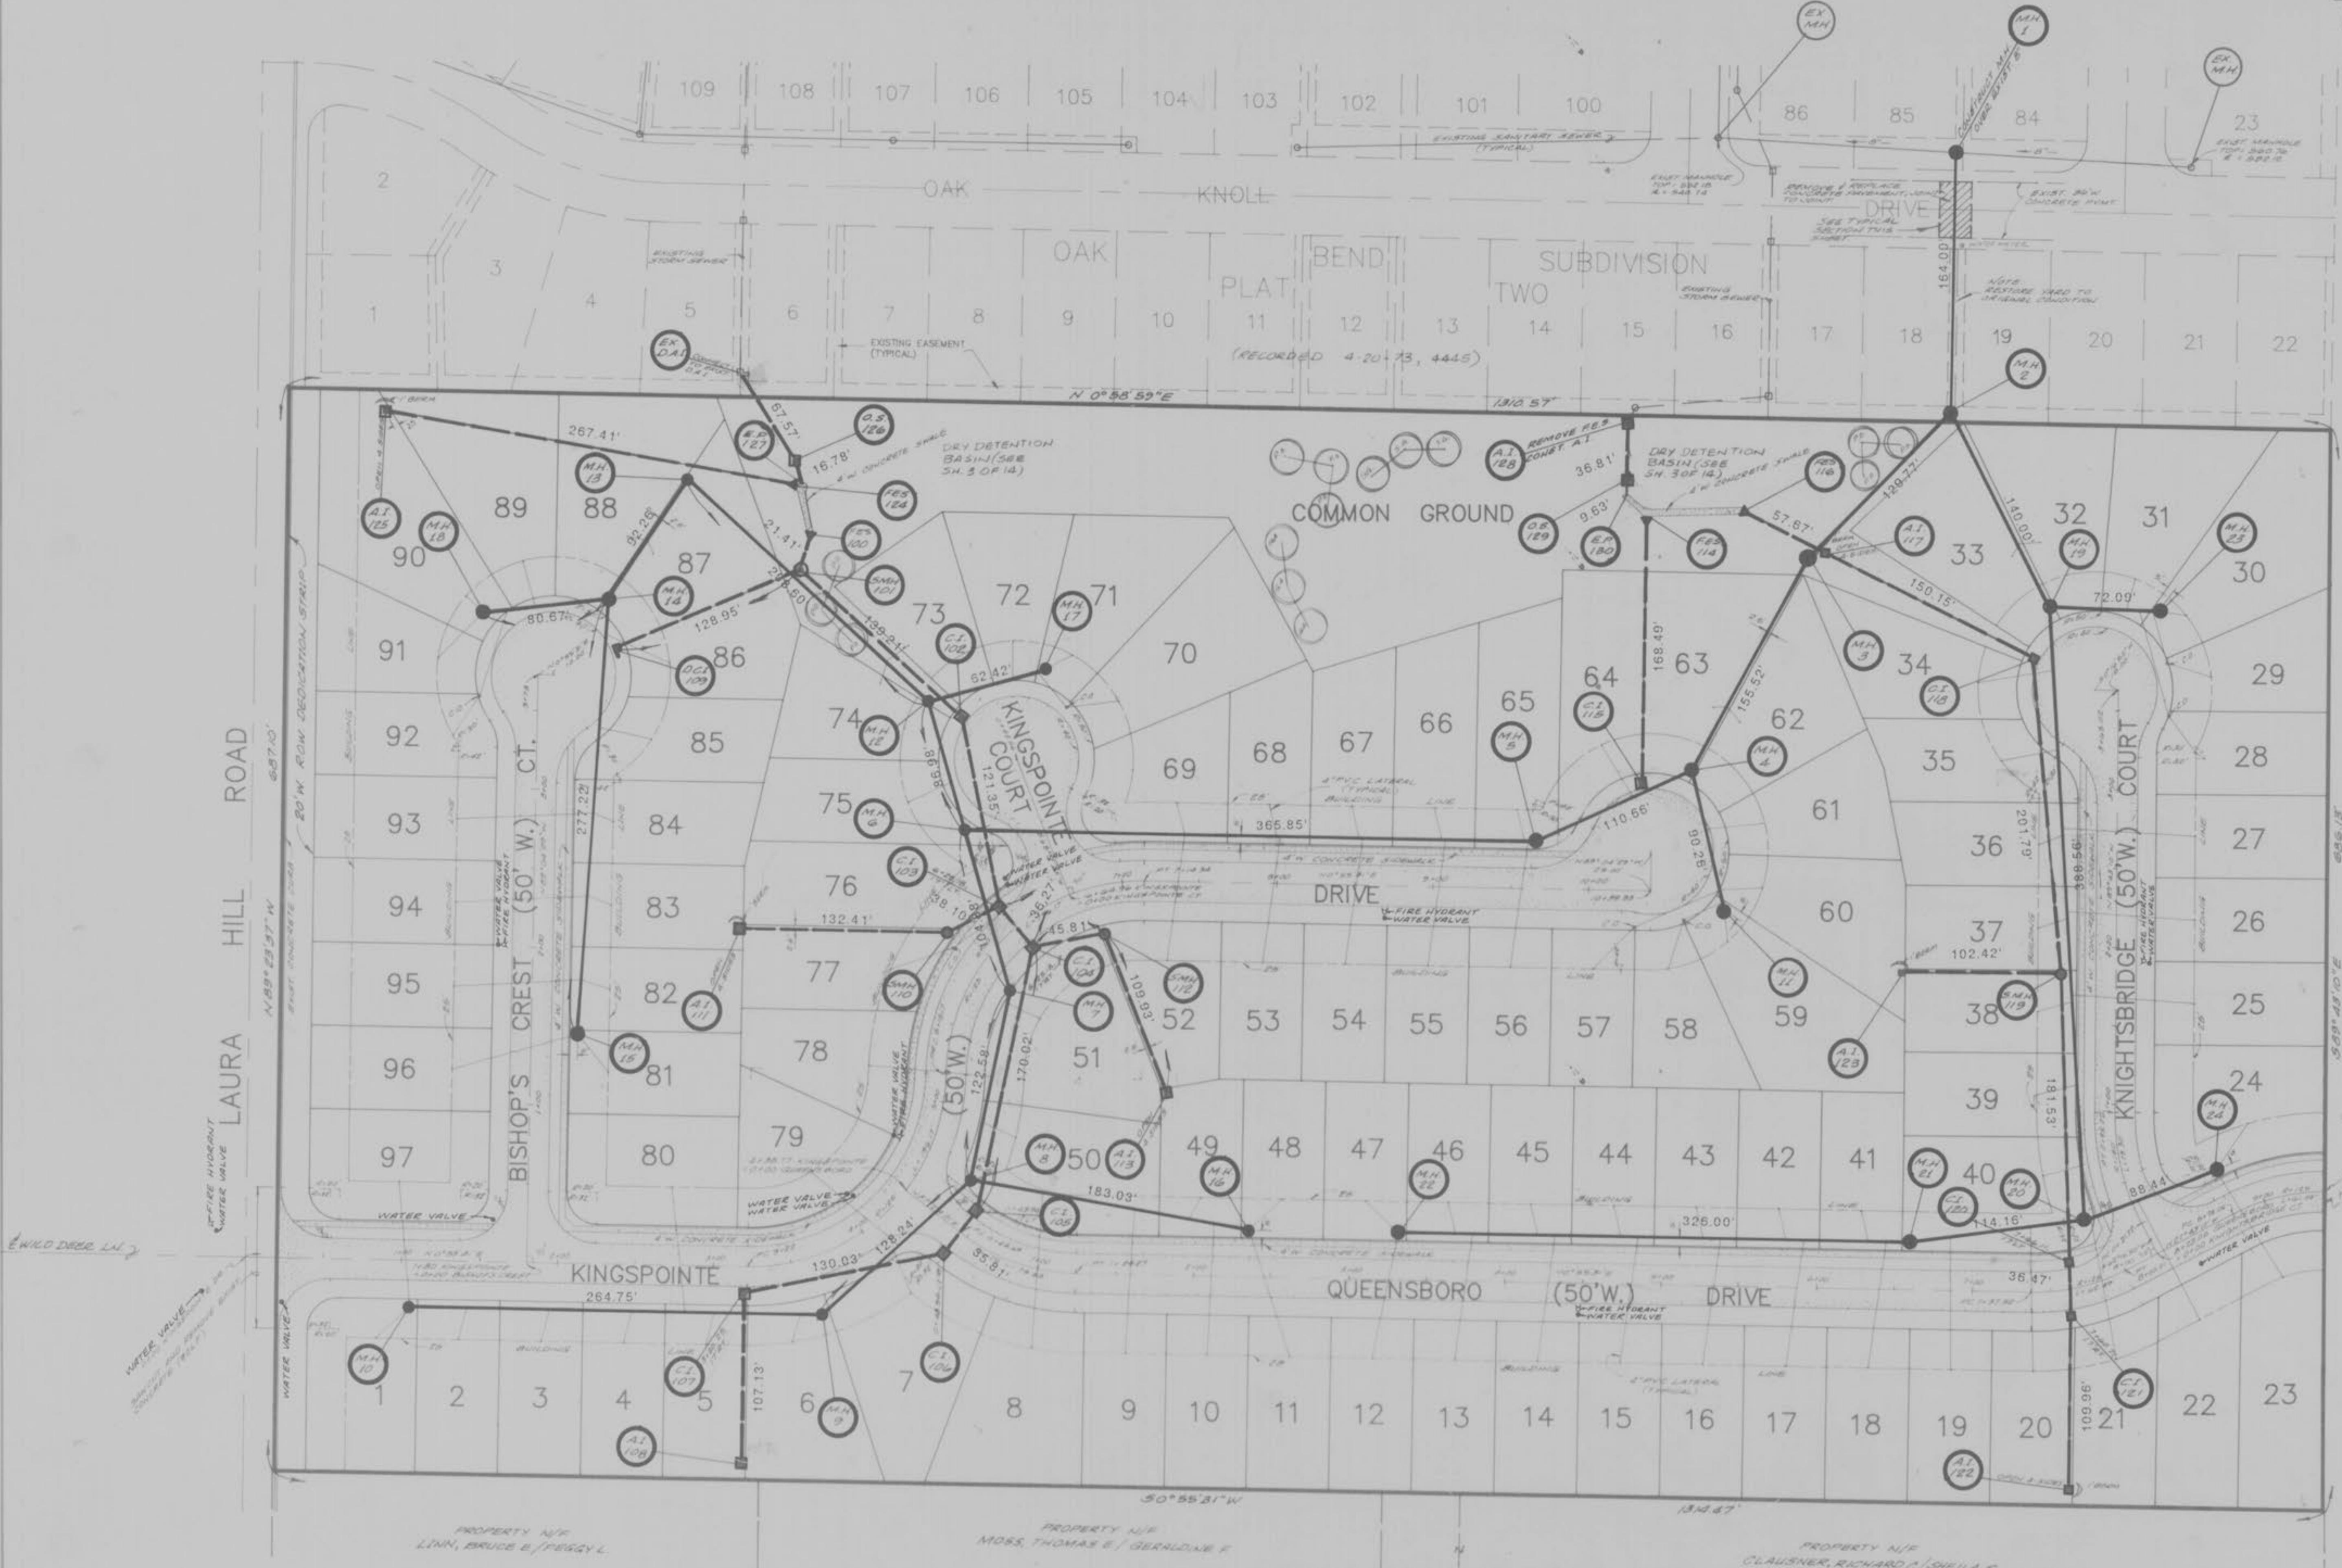

## LANDSCAPE LEGEND

(P) PIN OAK - 2" CALIPER  
3 EACH REQUIRED.

(S) SWEET GUM - 2" CALIPER  
3 EACH REQUIRED.

(G) GREEN ASH - 2" CALIPER  
3 EACH REQUIRED.

NOTE: SEE PLANTING DETAIL ON  
SHEET 13 OF 14.

PROPERTY OF  
CITY OF O'FALLON  
BUILDING DEPARTMENT

AS-BUILTS ADDED JANUARY, 1990

2 5

25


KINGSPONTE - AS-BUILTS

SEWER PROFILES  
KINGSPONTE

MAY 26, 1989  
REV 6-7-89

89-3030

SCALE:  
1"=30' HORZ.  
1"=10' VERT.

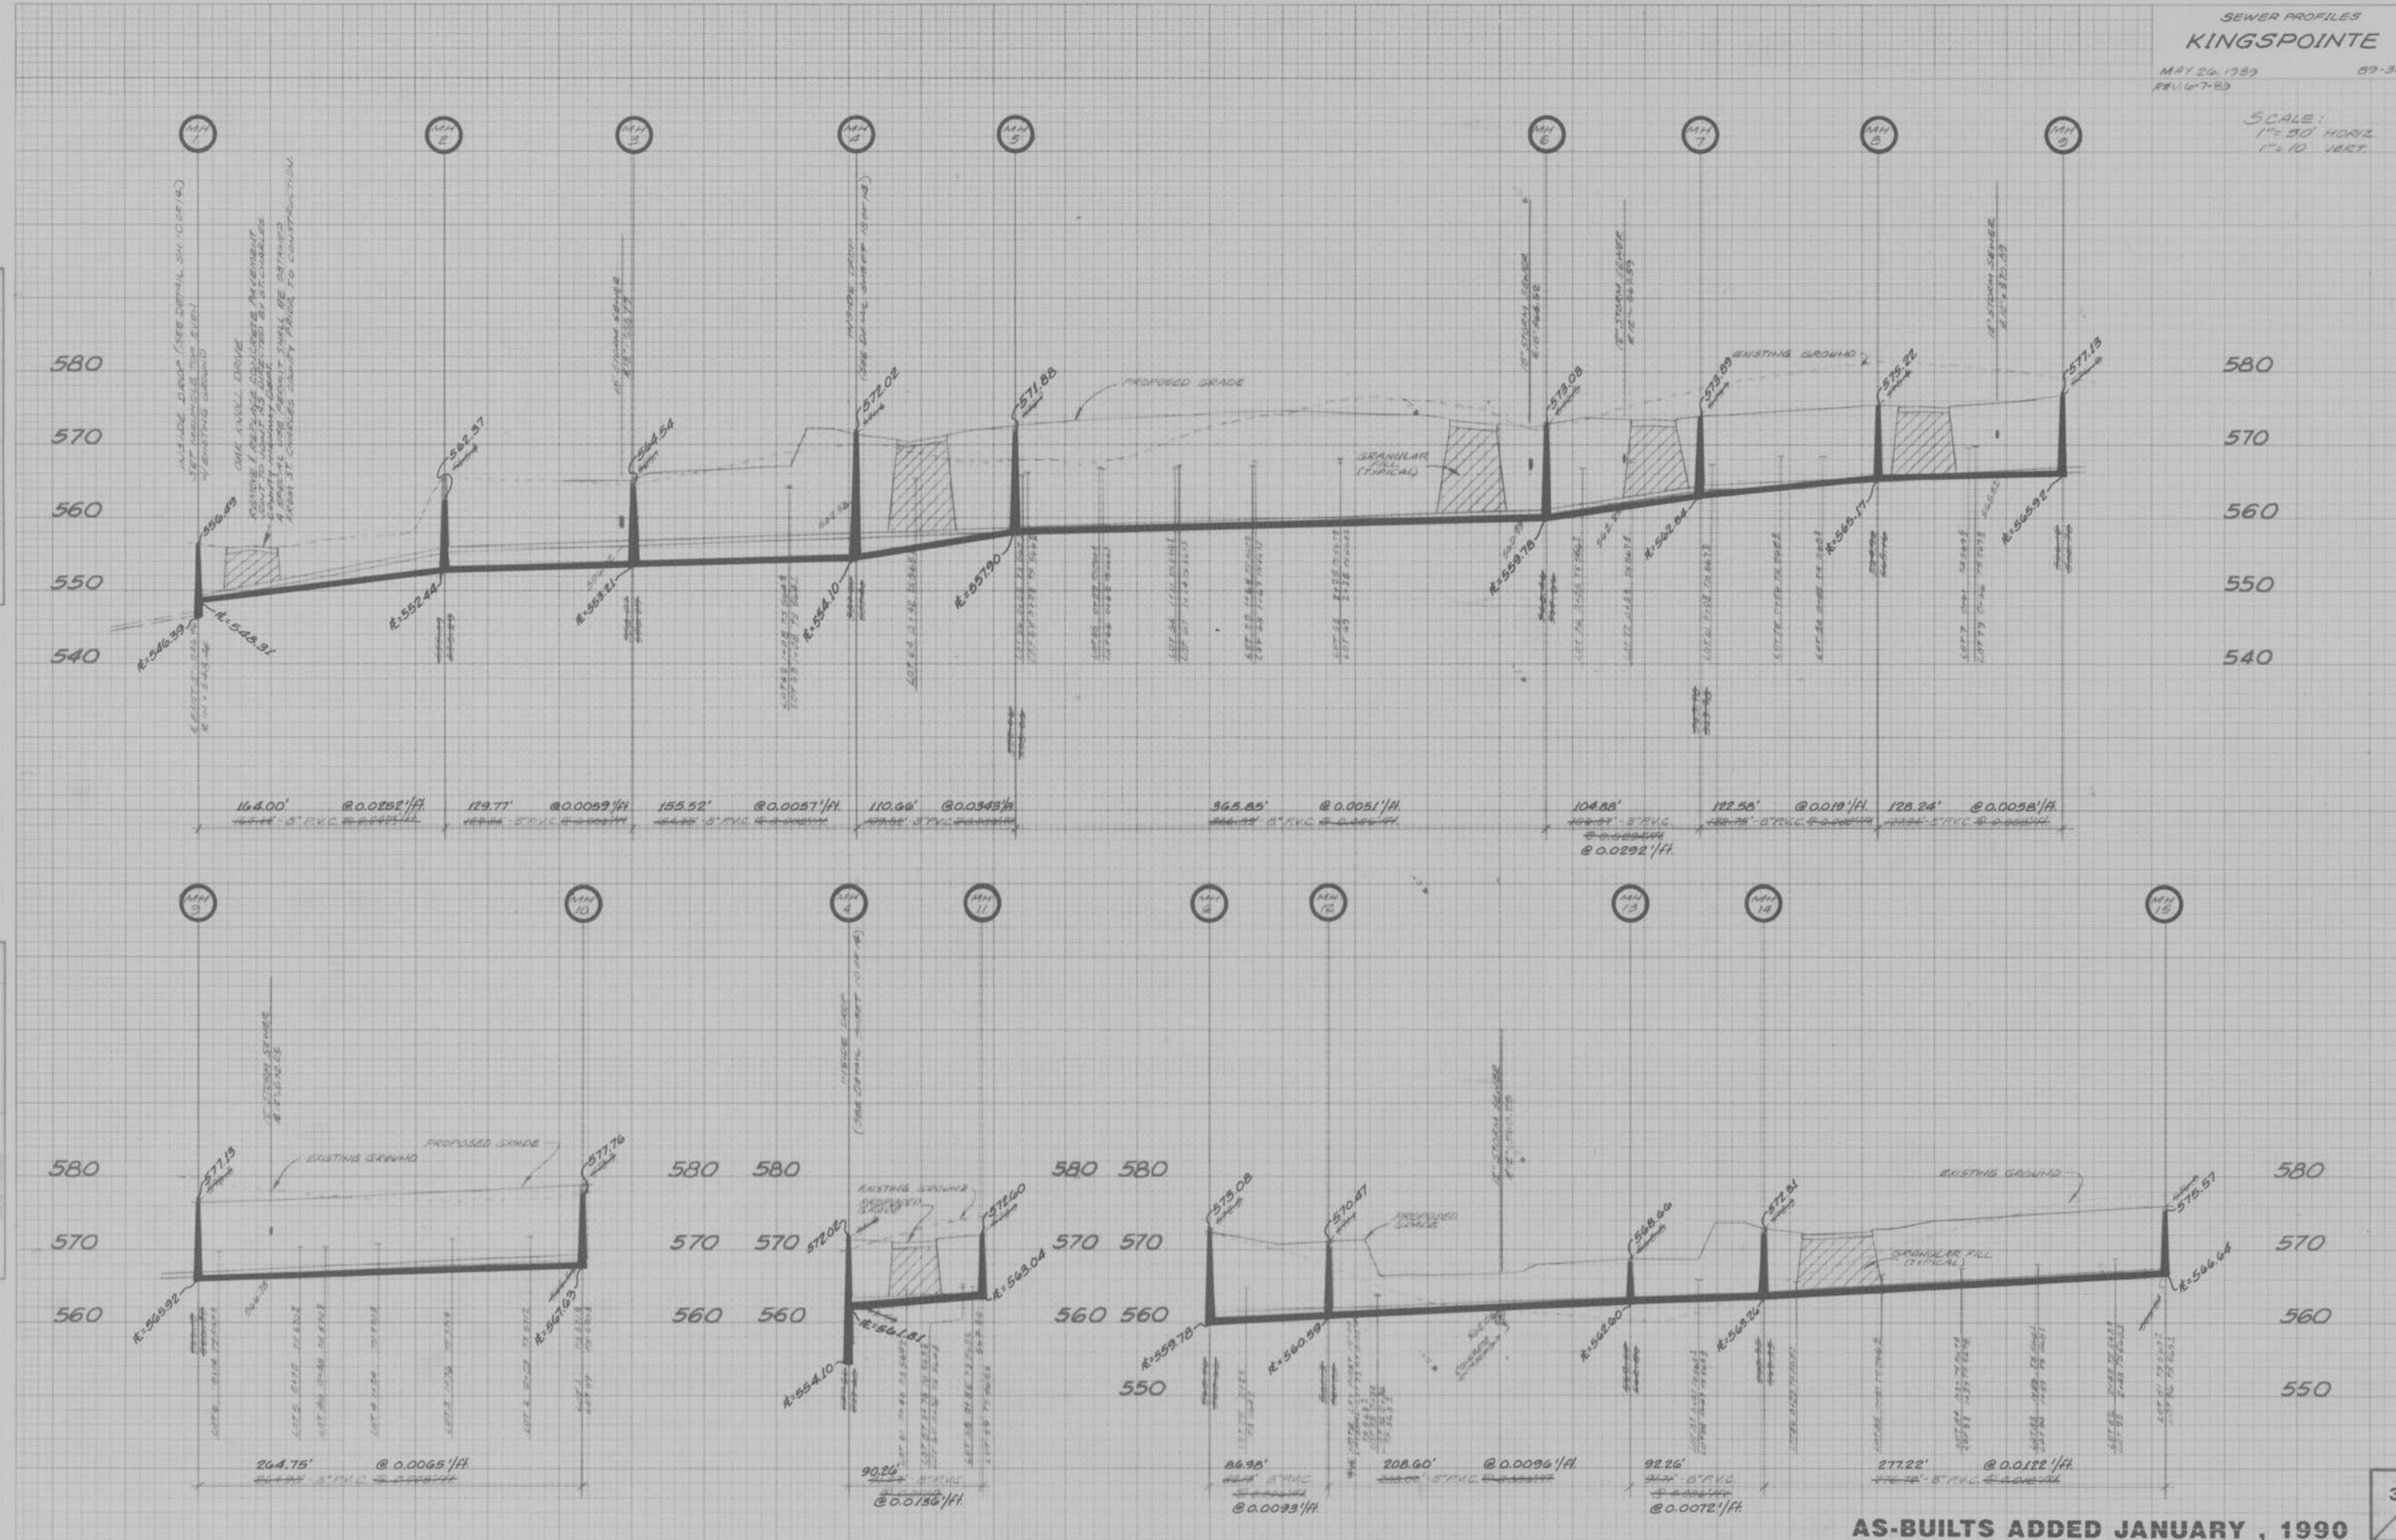

PROPERTY OF  
CITY OF O'FALON  
BUILDING DEPARTMENT

SEWER PROFILES  
KING'S POINTE


MAY 26, 1989  
REV. G-6-B9

89-3030

SCALE:  
1" = 50' HORIZ.  
1" = 10' VERT.

FINAL SURVEY PLAN FOR THE  
WATER BORNE SANITARY  
SYSTEM, CANNON

ORIGINAL SURVEY PLAN FOR THE  
WATER BORNE SANITARY  
SYSTEM, CANNON

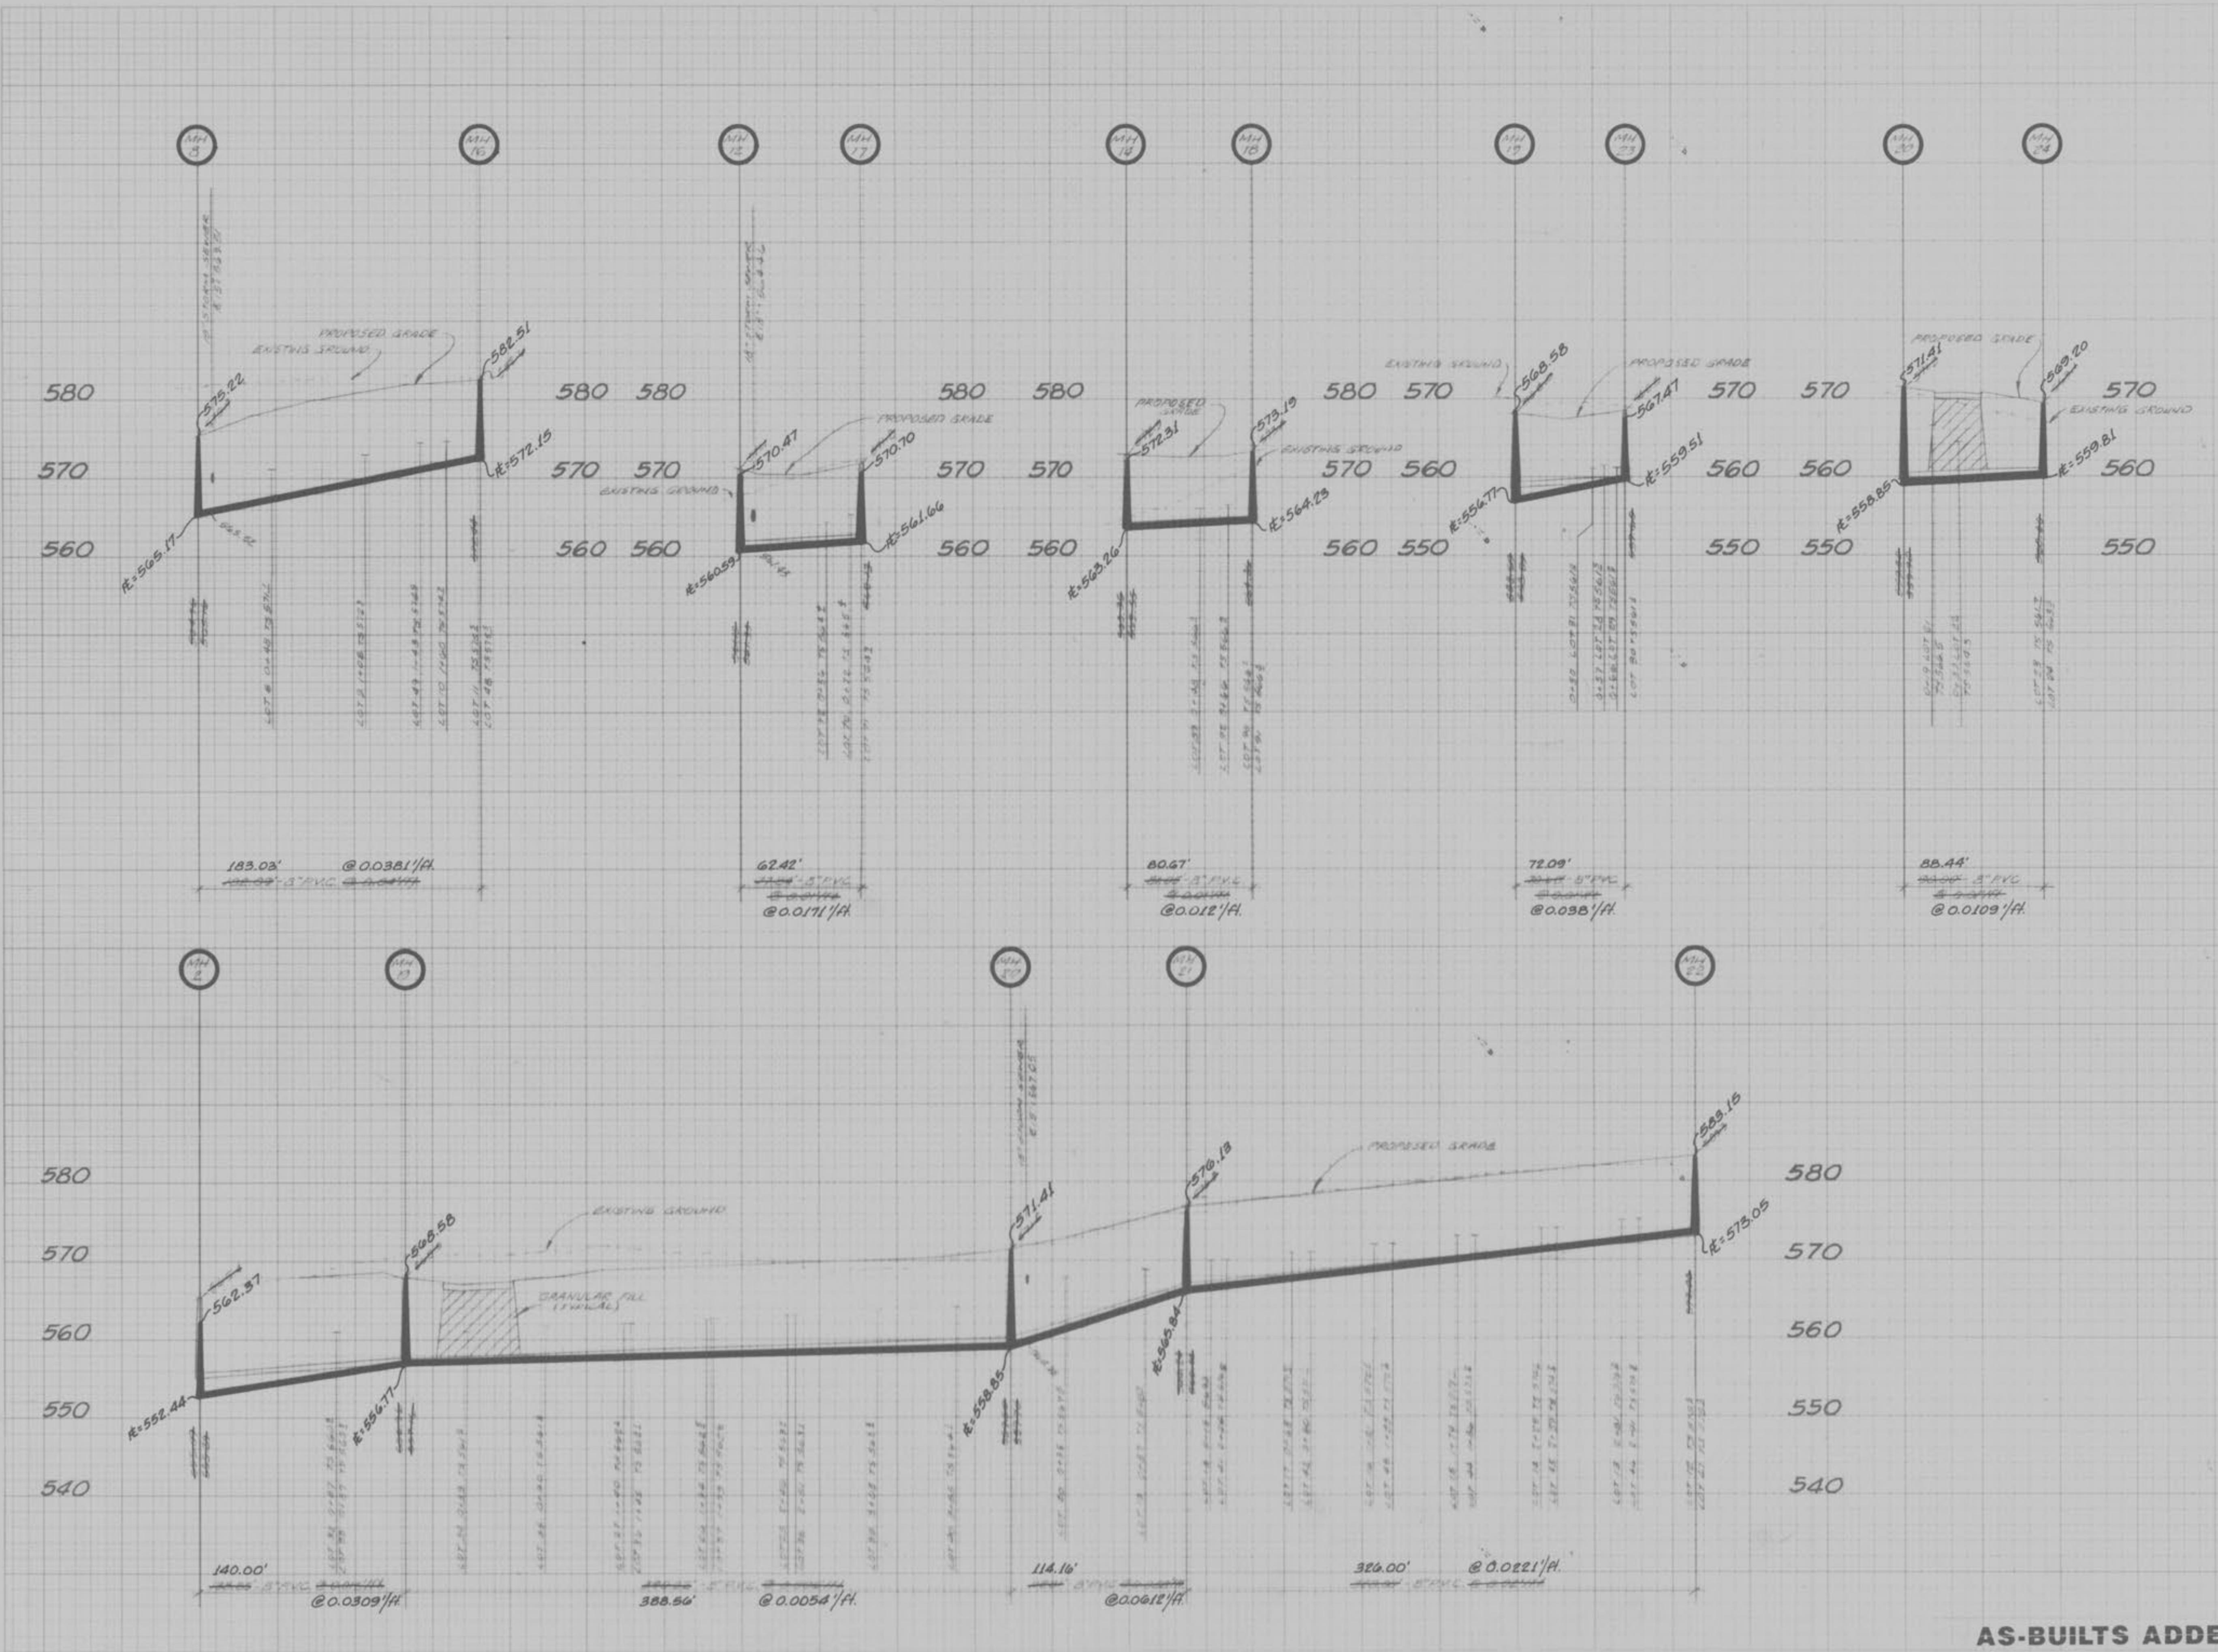


AS-BUILTS ADDED JANUARY , 1990


4  
5

SEWER PROFILES  
KINGSPONTE


89-3030

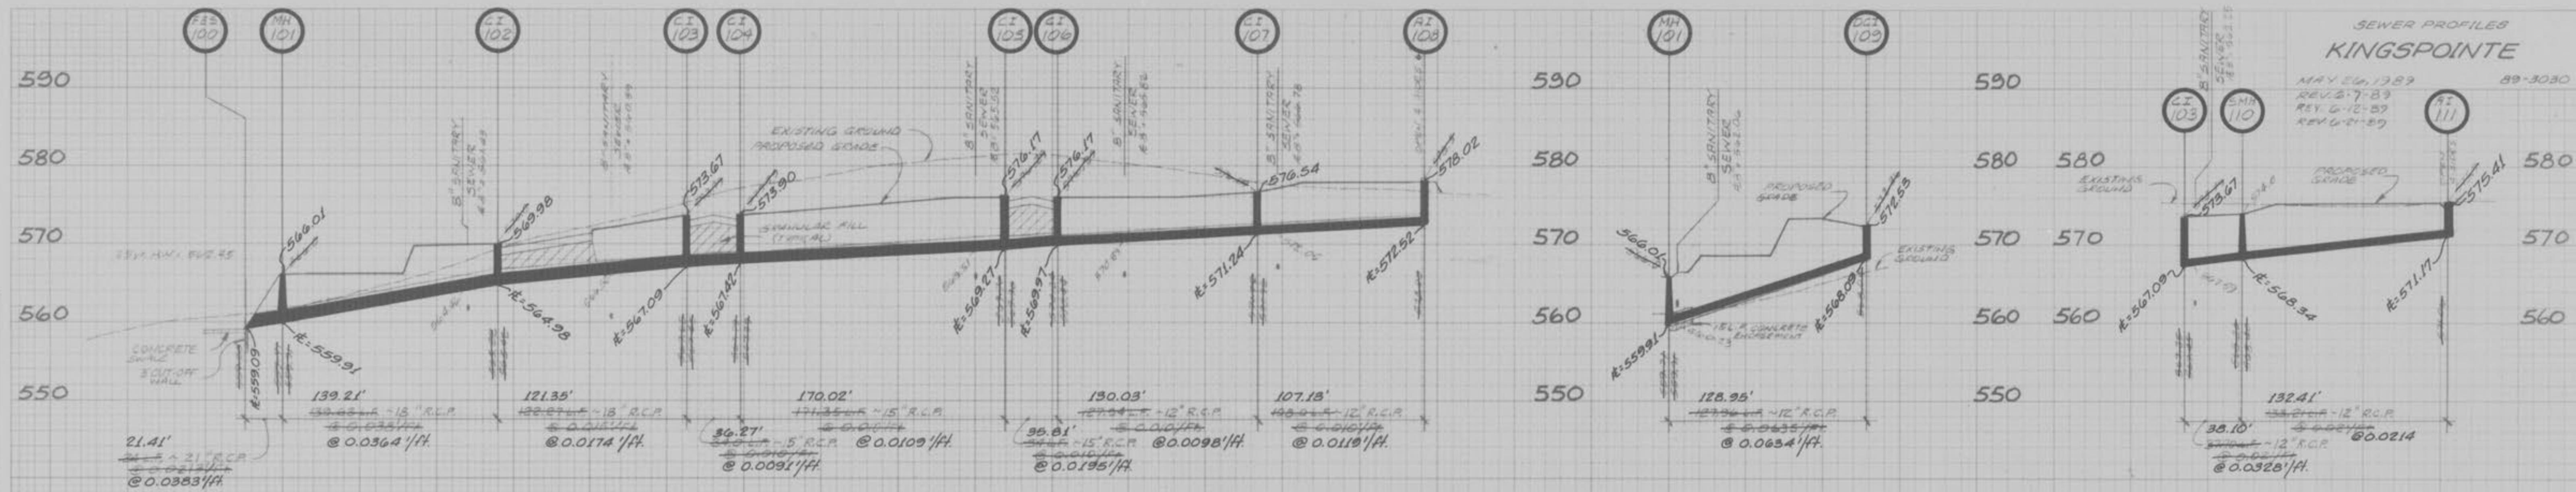

FINAL SURVEY  
ADJUSTED SURVEY  
PLAT SURVEY  
ADJUSTED SURVEY  
PDS

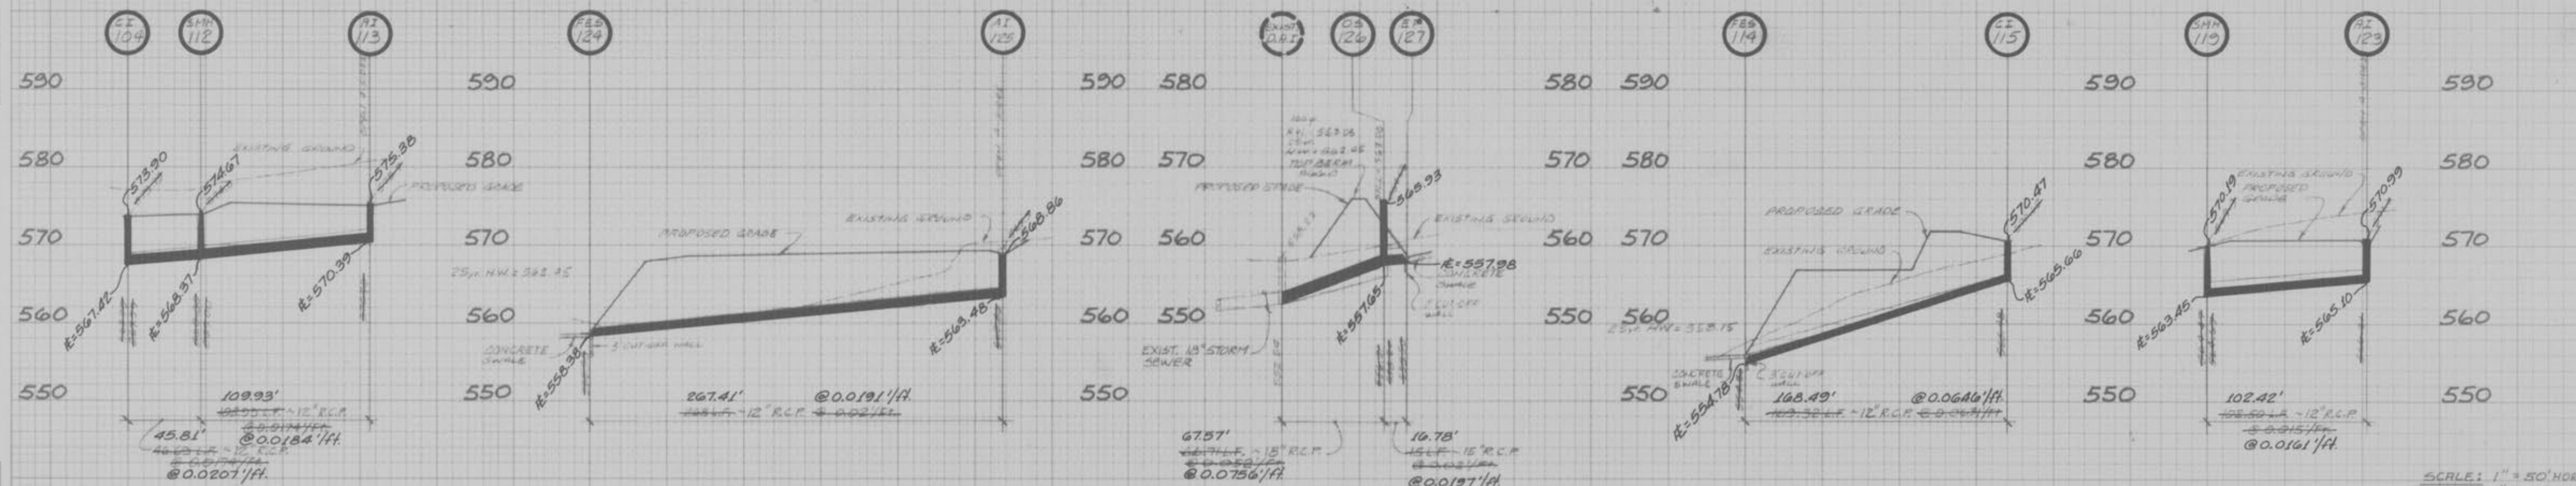

SCALE: 1" = 50' HORIZ.  
1" = 10' VERT.

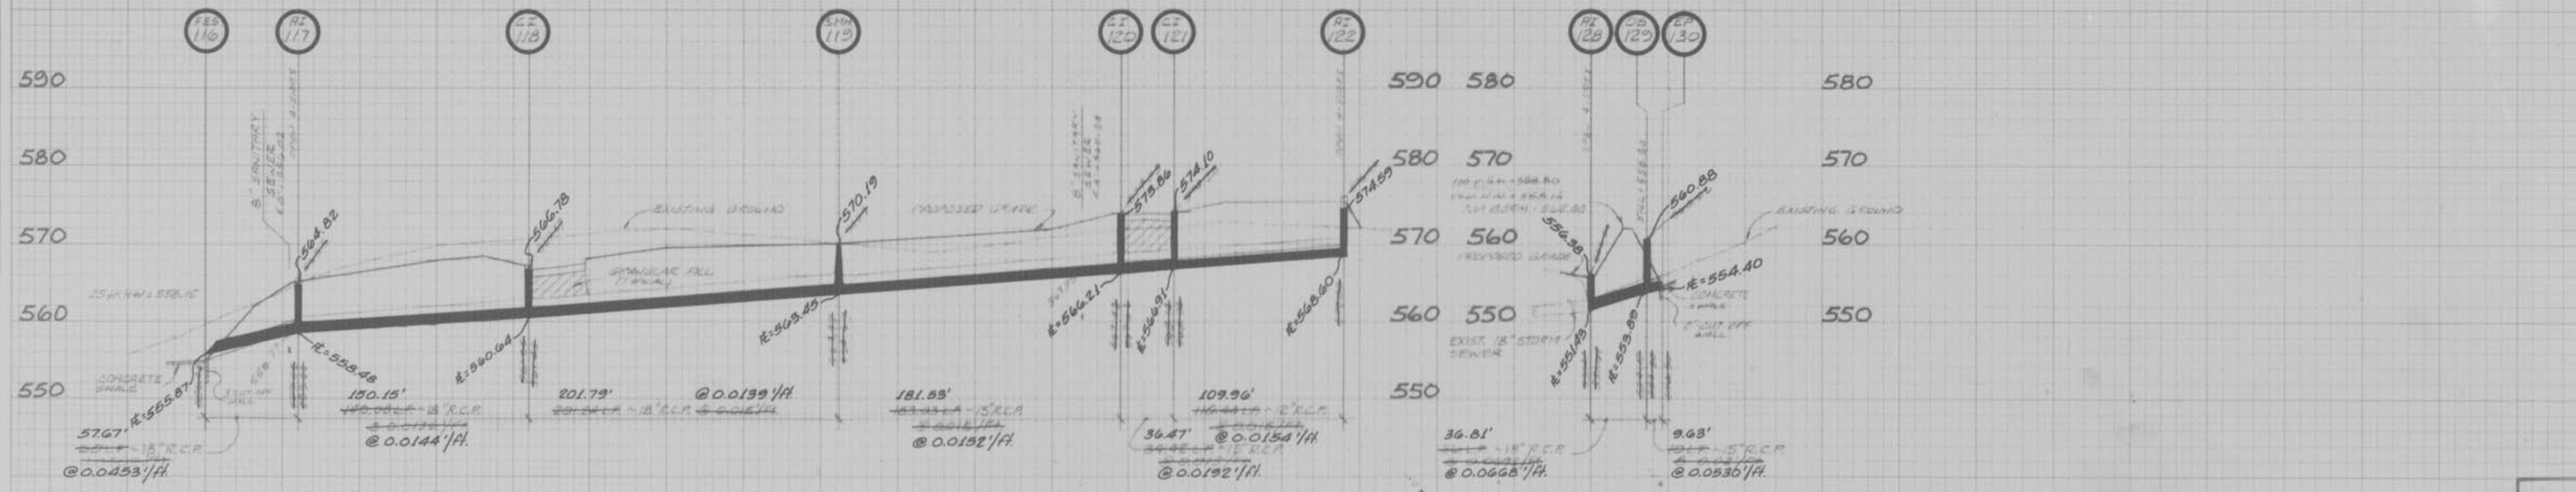

5  
5

AS-BUILTS ADDED JANUARY , 1990

PROPERTY OF  
CITY OF GLENDALE  
Engineering Department

KINGSPONTE - AS-BLT6

55