

LAKE CHARLES HILLS N.I.D. IMPROVEMENT PLANS

SANITARY SEWER

CITY OF O'FALLON GENERAL NOTES

- Underground utilities have been plotted from available information and therefore their locations shall be considered approximate only. The verification of the location of all underground utilities, either shown or not shown on these plans shall be the responsibility of the contractor, and shall be located prior to any grading or construction of the improvements.
- No area shall be cleared without the permission of the Project Engineer.
- Easements shall be provided for sanitary sewers. See plan for location and size of easements. This does not apply to house laterals.
- The City of O'Fallon shall be notified 48 hours prior to construction for coordination and inspection.
- All existing site improvements disturbed, damaged or destroyed shall be repaired or replaced to closely match pre-construction conditions.
- The contractor shall prevent all storm, surface water, mud and construction debris from entering the existing sanitary sewer system.
- All construction and materials shall conform to the current construction standards of the City of O'Fallon. Where conflicts exist, the contractor shall notify the Engineer for resolution.
- All construction methods and practices shall conform with current OSHA standards.
- The Contractor shall assume complete responsibility for controlling all siltation and erosion of the project area. The Contractor shall use whatever means necessary to control erosion and siltation including, but not limited to, staked straw bales and/or siltation fabric fences (possible methods of control are detailed in the plan).
- Control shall commence with grading and be maintained throughout the project until acceptance of the work by the Owner and/or the City of O'Fallon and/or MoDOT. The Contractor's responsibilities include all design and implementation as required to prevent erosion and to deposit no silt. The Owner and/or the City of O'Fallon and/or MoDOT may at their option direct the Contractor in his methods as deemed fit to protect property and improvements. Any depositing of silt or mud on new or existing pavement or in new or existing storm sewers or swales shall be removed after each rain and affected areas cleaned to the satisfaction of the Owner and/or the City of O'Fallon and/or MoDOT.
- Developer must supply City construction inspectors with reports prior to or during site soil testing.
- The area of phase development 101 Acres affecting 135 Lots.
- No slopes shall exceed 3 to 1.
- All utilities shall be located underground.
- Contractor shall use the designed staging/mobilization area located at the northeast corner of Lorene Drive and Fire Lane Drive. This property is owned by the City of O'Fallon. The contractor shall provide a stabilized entrance and wash down area of site. The contractor shall restore the area after construction of improvements.

SANITARY SEWER NOTES

- All manhole bottoms to have at least 0.2' fall. Manhole tops built without elevations furnished by the Engineer will be the responsibility of the sewer contractor.
- 8" P.V.C. sanitary sewer pipe shall meet the following standards. A.S.T.M.-D-3034 SDR-35, with wall thickness compression joint A.S.T.M.-D-3212. An appropriate rubber seal water stop as approved by the sewer district shall be installed between P.V.C. pipe and masonry structures.
- All fill placed under proposed storm and sanitary sewer, proposed roads, and/or paved areas shall be compacted to 90% of maximum density as determined by the Modified AASHTO T-180 Compaction Test or 95% of maximum density as determined by the Standard Proctor Test AASHTO T-99. All fill placed in proposed roads shall be compacted from the bottom of the fill up. All tests shall be verified by a soils engineer concurrent with grading and backfilling operations. Ensure the moisture content of the soil in fill areas is to correspond to the compactive effort as defined by the Standard or Proctor Test. Optimum moisture content shall be determined using the same test that was used for compaction. Soil compaction curves shall be submitted to the City of O'Fallon prior to the placement of fill. Proof rolling may be required to verify soil stability at the discretion of the City of O'Fallon.
- All trench back fills under paved areas shall be granular back fill, and shall be compacted to 90 % of the maximum density as determined by the "Modified AASHTO T-180 Compaction Test," (A.S.T.M.-D-1557). All other trench back fills may be earth material (free of large clods or stones). All trench back fills shall be water jetted.
- All sanitary house connections have been designed so that the minimum vertical distance from the low point of the basement to the flow line of a sanitary sewer at the corresponding house connection is not less than the diameter of the pipe plus the vertical distance of 2 1/2 feet.
- All P.V.C. sanitary sewer is to be SDR-35 or equal with clean 1/2" to 1" granular stone bedding uniformly graded. This bedding shall extend from 4" below the pipe to the springline of the pipe. Immediate back fill over pipe shall consist of some size "clean" or minus stone from spring line of pipe to 12" above the top of the pipe.
- All sanitary manholes shall be waterproofed on the exterior in accordance with Missouri Department of Natural Resources specifications 10 CSR-8.120 (7E).
- Brick will not be used in the construction of sanitary sewer manholes.
- All connections at sanitary structures shall be made with A-LOCK joints or equal.
- All pipes shall have positive drainage through manholes. No flat base structures are allowed. Structures shall have a 0.2' min. difference in invert elevation unless otherwise approved.
- Gas, water and other underground utilities shall not conflict with the depth or horizontal location of existing or proposed sanitary or storm sewers, including house laterals.
- All sanitary and storm sewer trench back fills shall be water jetted. Granular back fill will be used under pavement areas.
- All existing areas disturbed during construction of the sanitary sewer line shall be seeded and mulched to prevent erosion.
- All sanitary sewer laterals shall be a minimum of 4" in diameter per City of O'Fallon.
- Sod or erosion control blankets may be used in disturbed areas as directed by engineer.
- Abandonment of existing septic tanks shall be pump out and abandonment shall be done according to St. Charles County requirements and inspected by the governing authority.
- All foul water drop manholes shall be a minimum of 48" in diameter.
- Only wyes or T-wyes as approved by the City of O'Fallon shall be used to connect to sanitary sewer mains.
- Location of septic tanks to be located before construction by existing residents.
- All street crossings can be open cut per the St. Charles County Highway Department Standard Specifications.
- Rock backfill shall be used in all sanitary sewers that lie within the 1:1 shear plane of the road.
- Rock excavation shall consist of either trenching, boring or breaking. Blasting is not permitted.
- St. Charles County Highway Department shall be notified 48 hours prior to any work performed in their Right of Way. Contact Vance Gribble, (636-949-7900 Ext. 7154). All work must meet St. Charles County Highway Standard Specifications.
- All sewer main will be maintained by the City of O'Fallon. Laterals to be private and the responsibility of the homeowner, including grinder pumps.
- LATERAL LOCATIONS ARE APPROXIMATE. WYE LOCATIONS TO BE DETERMINED IN THE FIELD AT THE TIME OF CONSTRUCTION. ALL LATERALS WILL BE FIELD LOCATED AND SHOWN ON THE AS-BUILT PLANS. CONTRACTOR IS RESPONSIBLE FOR STATIONING WYES.
- PROJECT BENCHMARK RM-78: 447.61 CHISLED SQUARE ON WEST HEADWALL OF CONCRETE CULVERT LOCATED ABOUT 25 FEET NORTHWEST OF INTERSECTION OF DALBO ROAD AND STATE HIGHWAY 79.
- SITE BENCHMARK: 577.82 EXISTING FIRE HYDRANT (BOTTOM FLANGE SILL) @ FRONT CORNER OF LOT 36 & 37, AT A STREET CURVE IN FRONT OF #405 LORENE DR.

UTILITY NOTES

- Underground utilities have been plotted from available information and therefore their locations shall be considered approximate only. The verification of the location of all underground utilities, either shown or not shown on these plans shall be the responsibility of the contractor, and shall be located prior to any grading or construction of the improvements.
- Easements shall be provided for sanitary sewer mains, and any private laterals if needed. See Easement Exhibits for location and size of easements.
- All construction and materials shall conform to the current construction standards of the City of O'Fallon.
- All utilities shown are existing, unless otherwise noted. All new utilities shall be located underground.

This tract is served by:
 STORM SEWER - CITY OF O'FALLON TELEPHONE - CENTURYTEL
 WATER - CITY OF O'FALLON FIRE - O'FALLON FIRE PROTECTION DISTRICT
 TRAFFIC LOCATES - CITY OF O'FALLON SCHOOL DISTRICT - FORT ZUMWALT
 SANITARY SEWER - CITY OF O'FALLON CABLE COMPANY - CHARTER COMMUNICATIONS
 ELECTRIC - AMEREN

PICKETT RAY & SILVER

Civil Engineers
Planners
Land Surveyors

333 Mid Rivers Mall Dr.
St. Peters, MO 63376
397-1211 FAX 397-1104

4776
X312

REVISED 12-29-06 PER CITY LETTER 12/06/06
REVISED SHEETS 1, 3-7, 19 & 21 4-26-06 REVISED 4-13-07

ENGINEERS AUTHENTICATION
The responsibility for professional engineering liability on this project is hereby limited to the set of plans authenticated by the seal, signature and date hereunder, otherwise the responsibility for such liability is hereby disclaimed. The engineer has reviewed the project and specifically includes revisions after this date unless reauthenticated.
 PICKETT, RAY & SILVER, INC.
 SIGNATURE DATE

DEVELOPER:

Mr. Charles Feldman, P.E.
St. Charles County Gov't
201 N. Second St. - Suite 420
St. Charles, MO 63301
Tele: 636-949-7564
Fax: 636-949-7336


CONFIDENTIAL PROPRIETARY MATERIAL
The use, reproduction and sales rights of this drawing are reserved by Pickett, Ray & Silver Inc.
 © Copyright 2000 by Pickett, Ray & Silver Inc.
 DRAWN MK DATE 01-04-05
 CHECKED D.S.T. DATE 07-21-05
 FIELD BOOK 934 PROJECT # 83054-STCC.00R
 JOB ORDER # 21

A tract of land being part of Southeast Quarter of
Section 13, Township 47 North, Range 2 East,
St. Charles County, Missouri,

AS-BUILT DRAWINGS

WYE LOCATIONS PROVIDED BY CONTRACTOR

Sheet
1
2
3-8
9-16
17-21

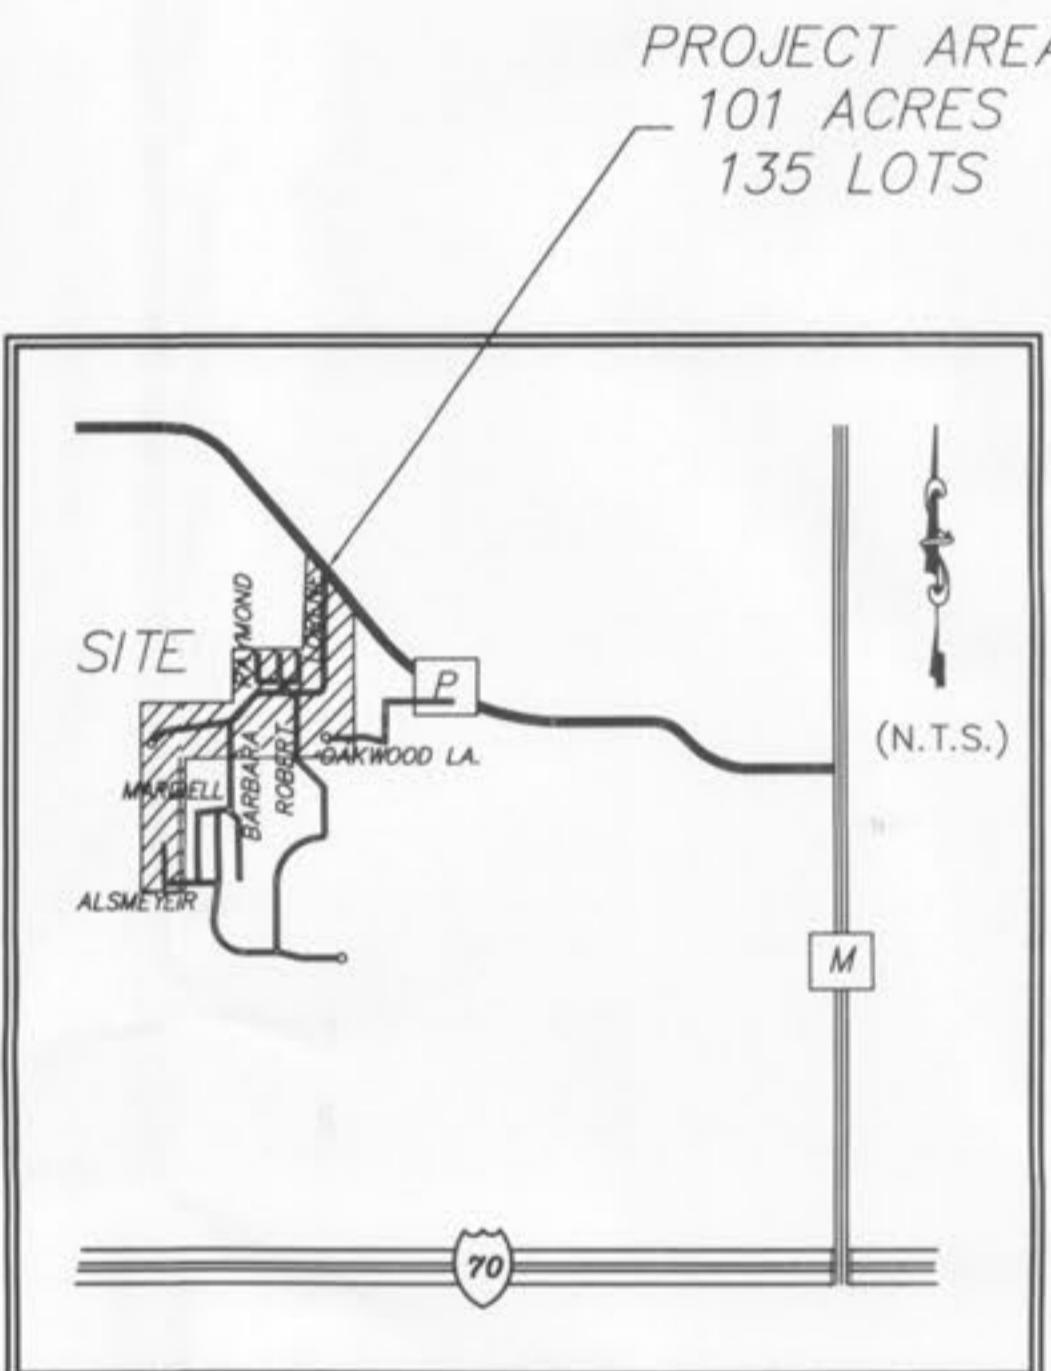

LOCATION MAP

To THE CITY OF O'FALLON.
 These "As-Built" SANITARY SEWERS plans are based on actual field measurements conducted during August, September October 2008 and the results are shown hereon.

By: STANLEY M. MUNDWILLER LPLS-2005019226
STATE OF MISSOURI

PICKETT, RAY & SILVER'S CORPORATE
REGISTRATION NO. LS-54-D

PROJECT BENCHMARK RM-78: 447.61 CHISLED SQUARE ON WEST HEADWALL OF CONCRETE CULVERT LOCATED ABOUT 25 FEET NORTHWEST OF INTERSECTION OF DALBO ROAD AND STATE HIGHWAY 79.

SITE BENCHMARK: 577.82 EXISTING FIRE HYDRANT (BOTTOM FLANGE SILL) @ FRONT CORNER OF LOT 36 & 37, AT A STREET CURVE IN FRONT OF #405 LORENE DR.

DISCLAIMER: It is the intent of this document to set forth plans and specifications for a complete and usable project. It shall be the duty of the contractor to bring to the attention of the engineer any omissions, conflicts, or errors which could compromise this aim.

DRAWING INDEX

Description
COVER SHEET
OVERALL SHEET
SITE PLAN
SANITARY SEWER PROFILES
DETAILS/EROSION CONTROL NOTES


LEGEND

● Sanitary Sewer (Proposed)	Sanitary Structure	R.C.P. Reinforced Concrete Pipe
○ Sanitary Sewer (Existing)	Storm Structure	C.M.P. Corrugated Metal Pipe
— Storm Sewer (Proposed)	Test Hole	C.I.P. Cast Iron Pipe
— Storm Sewer (Existing)	Power Pole	P.V.C. Polyvinyl Chloride
->- Water Line & Size	Light Standard	V.C.P. Vitrified Clay Pipe
->- Existing water line		C.O. Clean Out
Tee & Valve	Double Water Meter Setting	V.T. Vent Trap
Hydrant	Single Water Meter Setting	T.B.R. To Be Removed
Cap	Curb Inlet	T.B.R.&R. To Be Removed & Relocated
— Existing Fence Line	Skewed Curb Inlet	T.B.P. To Be Protected
Lot or Building Number	Double Curb Inlet	T.B.A. To Be Abandoned
x Existing Contour	Grate Inlet	B.C. Base Of Curb
Existing Tree Line	Area Inlet	T.C. Top Of Curb
Street Sign	Double Area Inlet	T.W. Top Of Wall
Existing Contour	Concrete Collar	F.E. Flared End Section
Rip-Rap	End Pipe	(TYP) Typical
End of Lateral	Energy Dissipater	U.N.O. Unless Noted Otherwise
Asphalt Pavement	Manhole	U.I.P. Use In Place
Concrete Pavement	Concrete Pipe	*** Siltation Control (Typ.)


CONSTRUCTION TO START SUMMER OF 2007
CONSTRUCTION TO END SUMMER OF 2008

FIRM MAP NUMBER: 29183C0230E
AUGUST 2, 1996

AS-BUILT PLANS

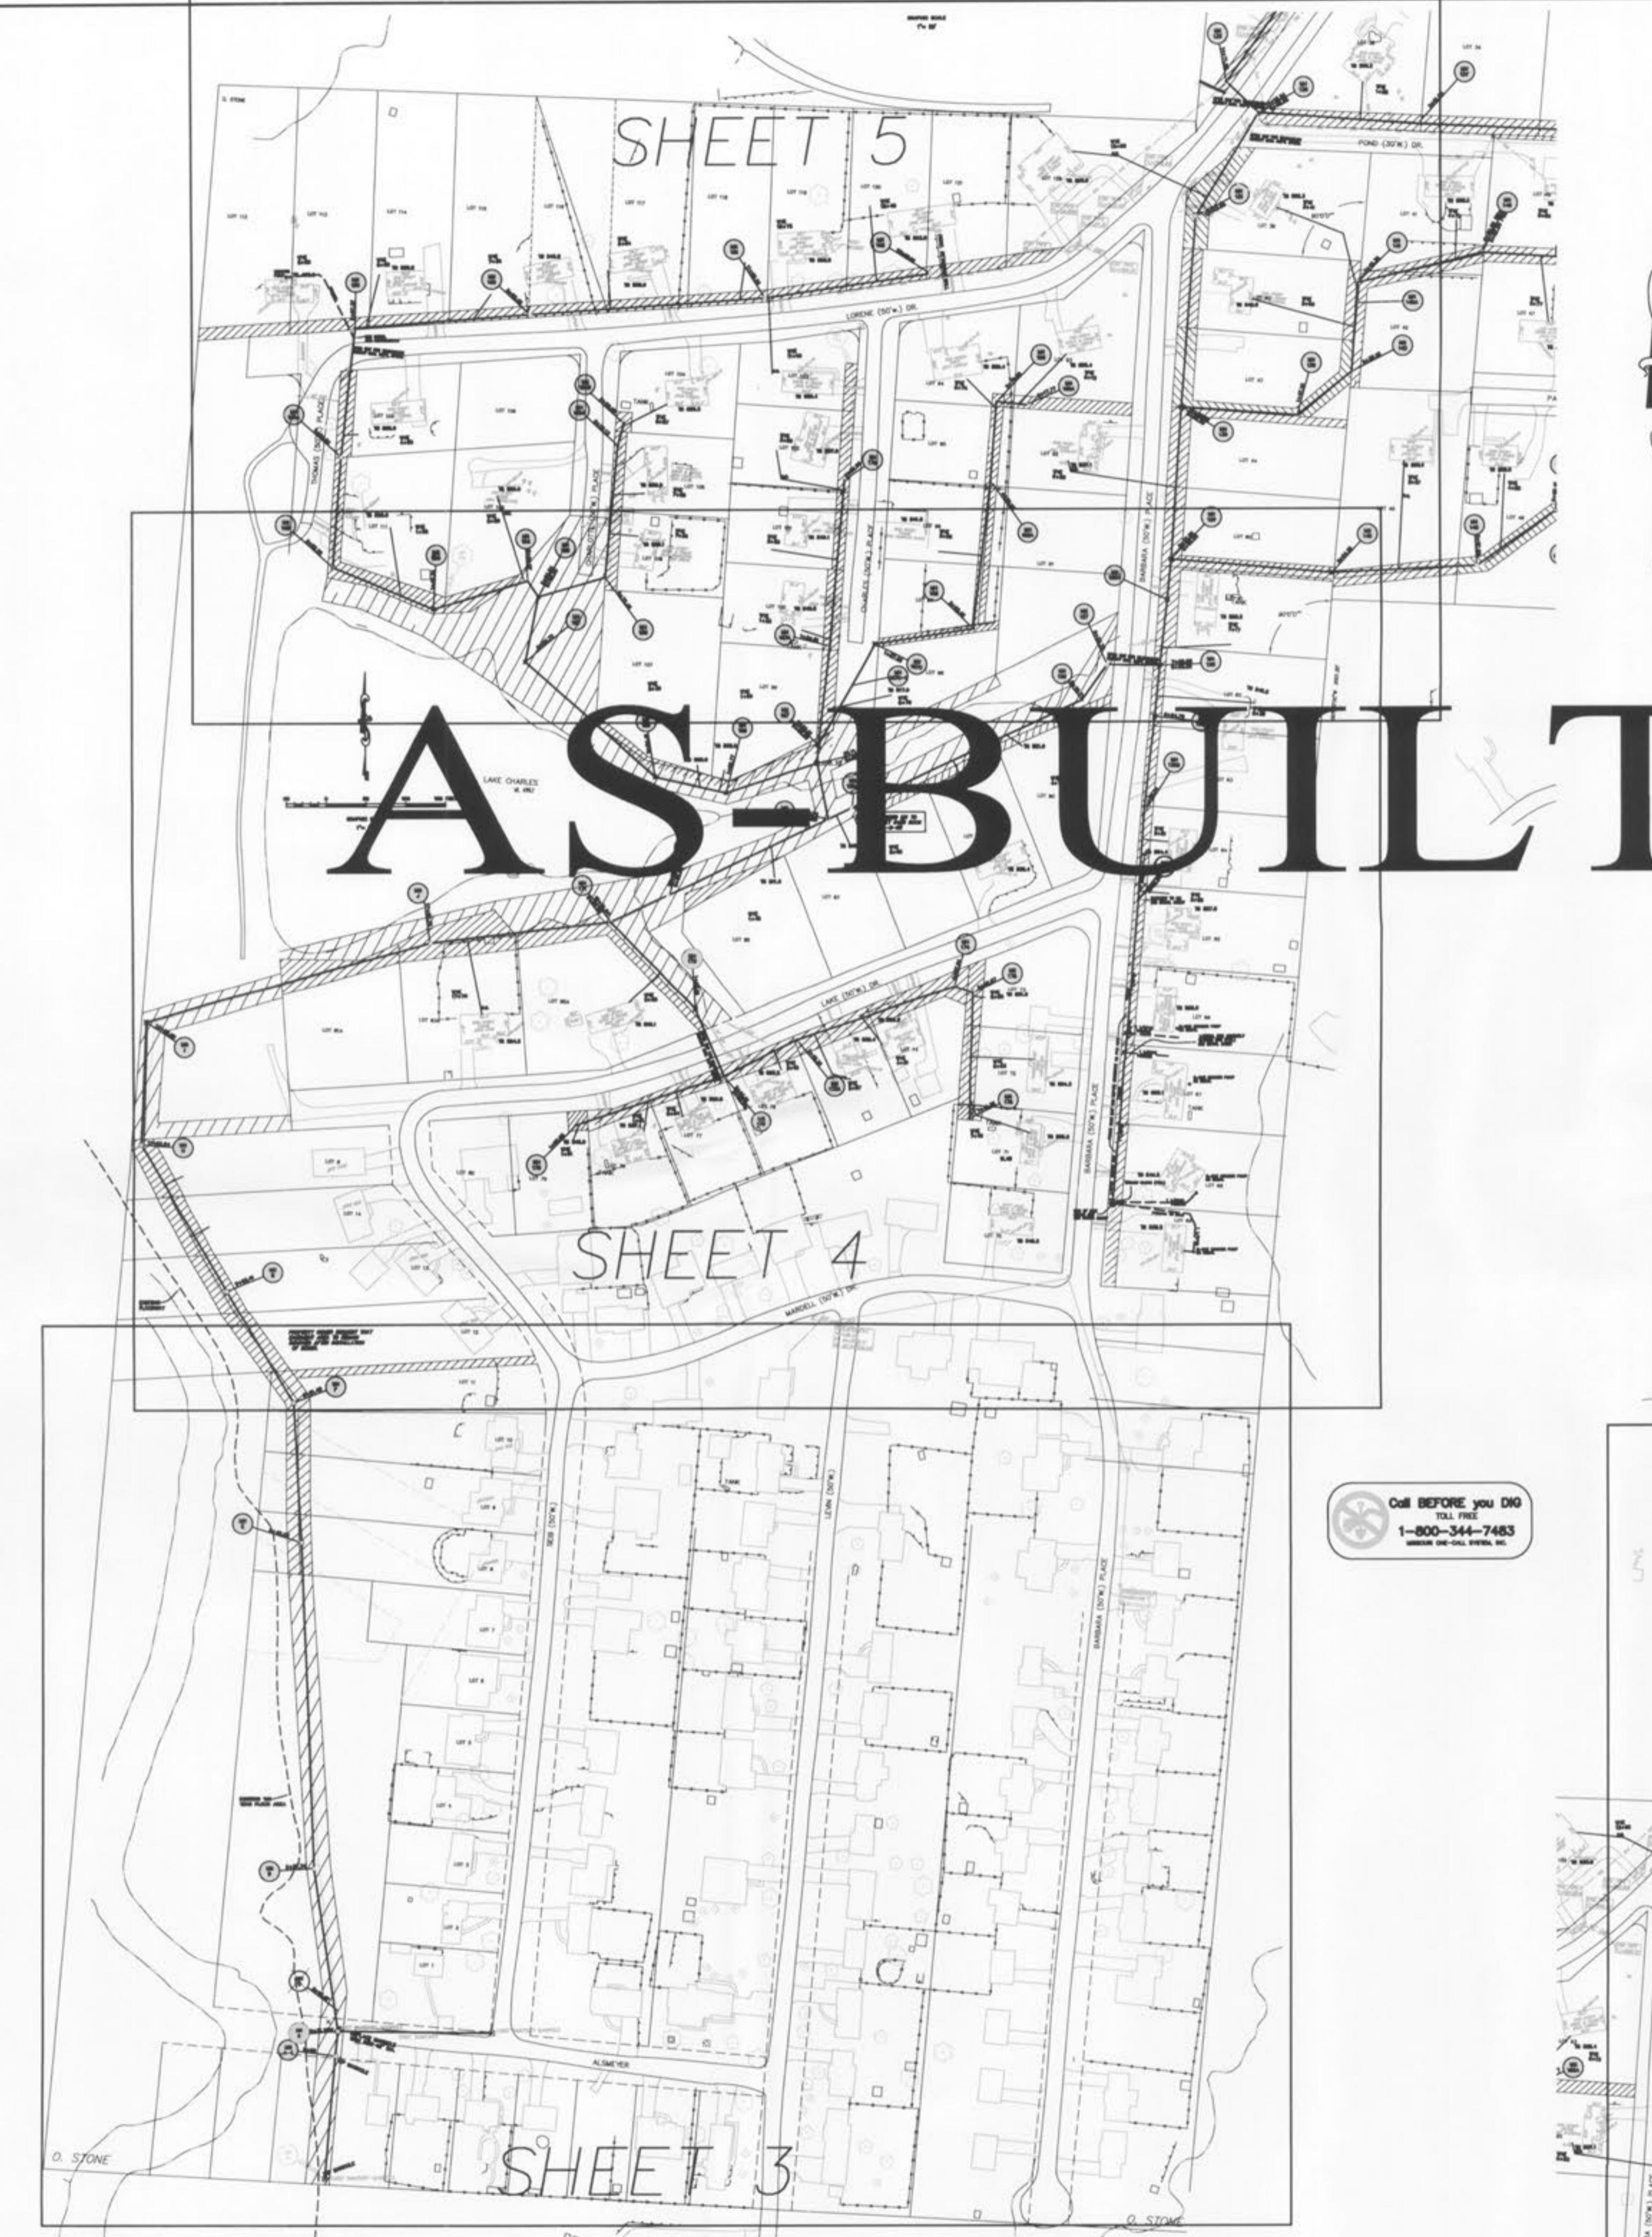

WYE LOCATIONS PROVIDED BY CONTRACTOR

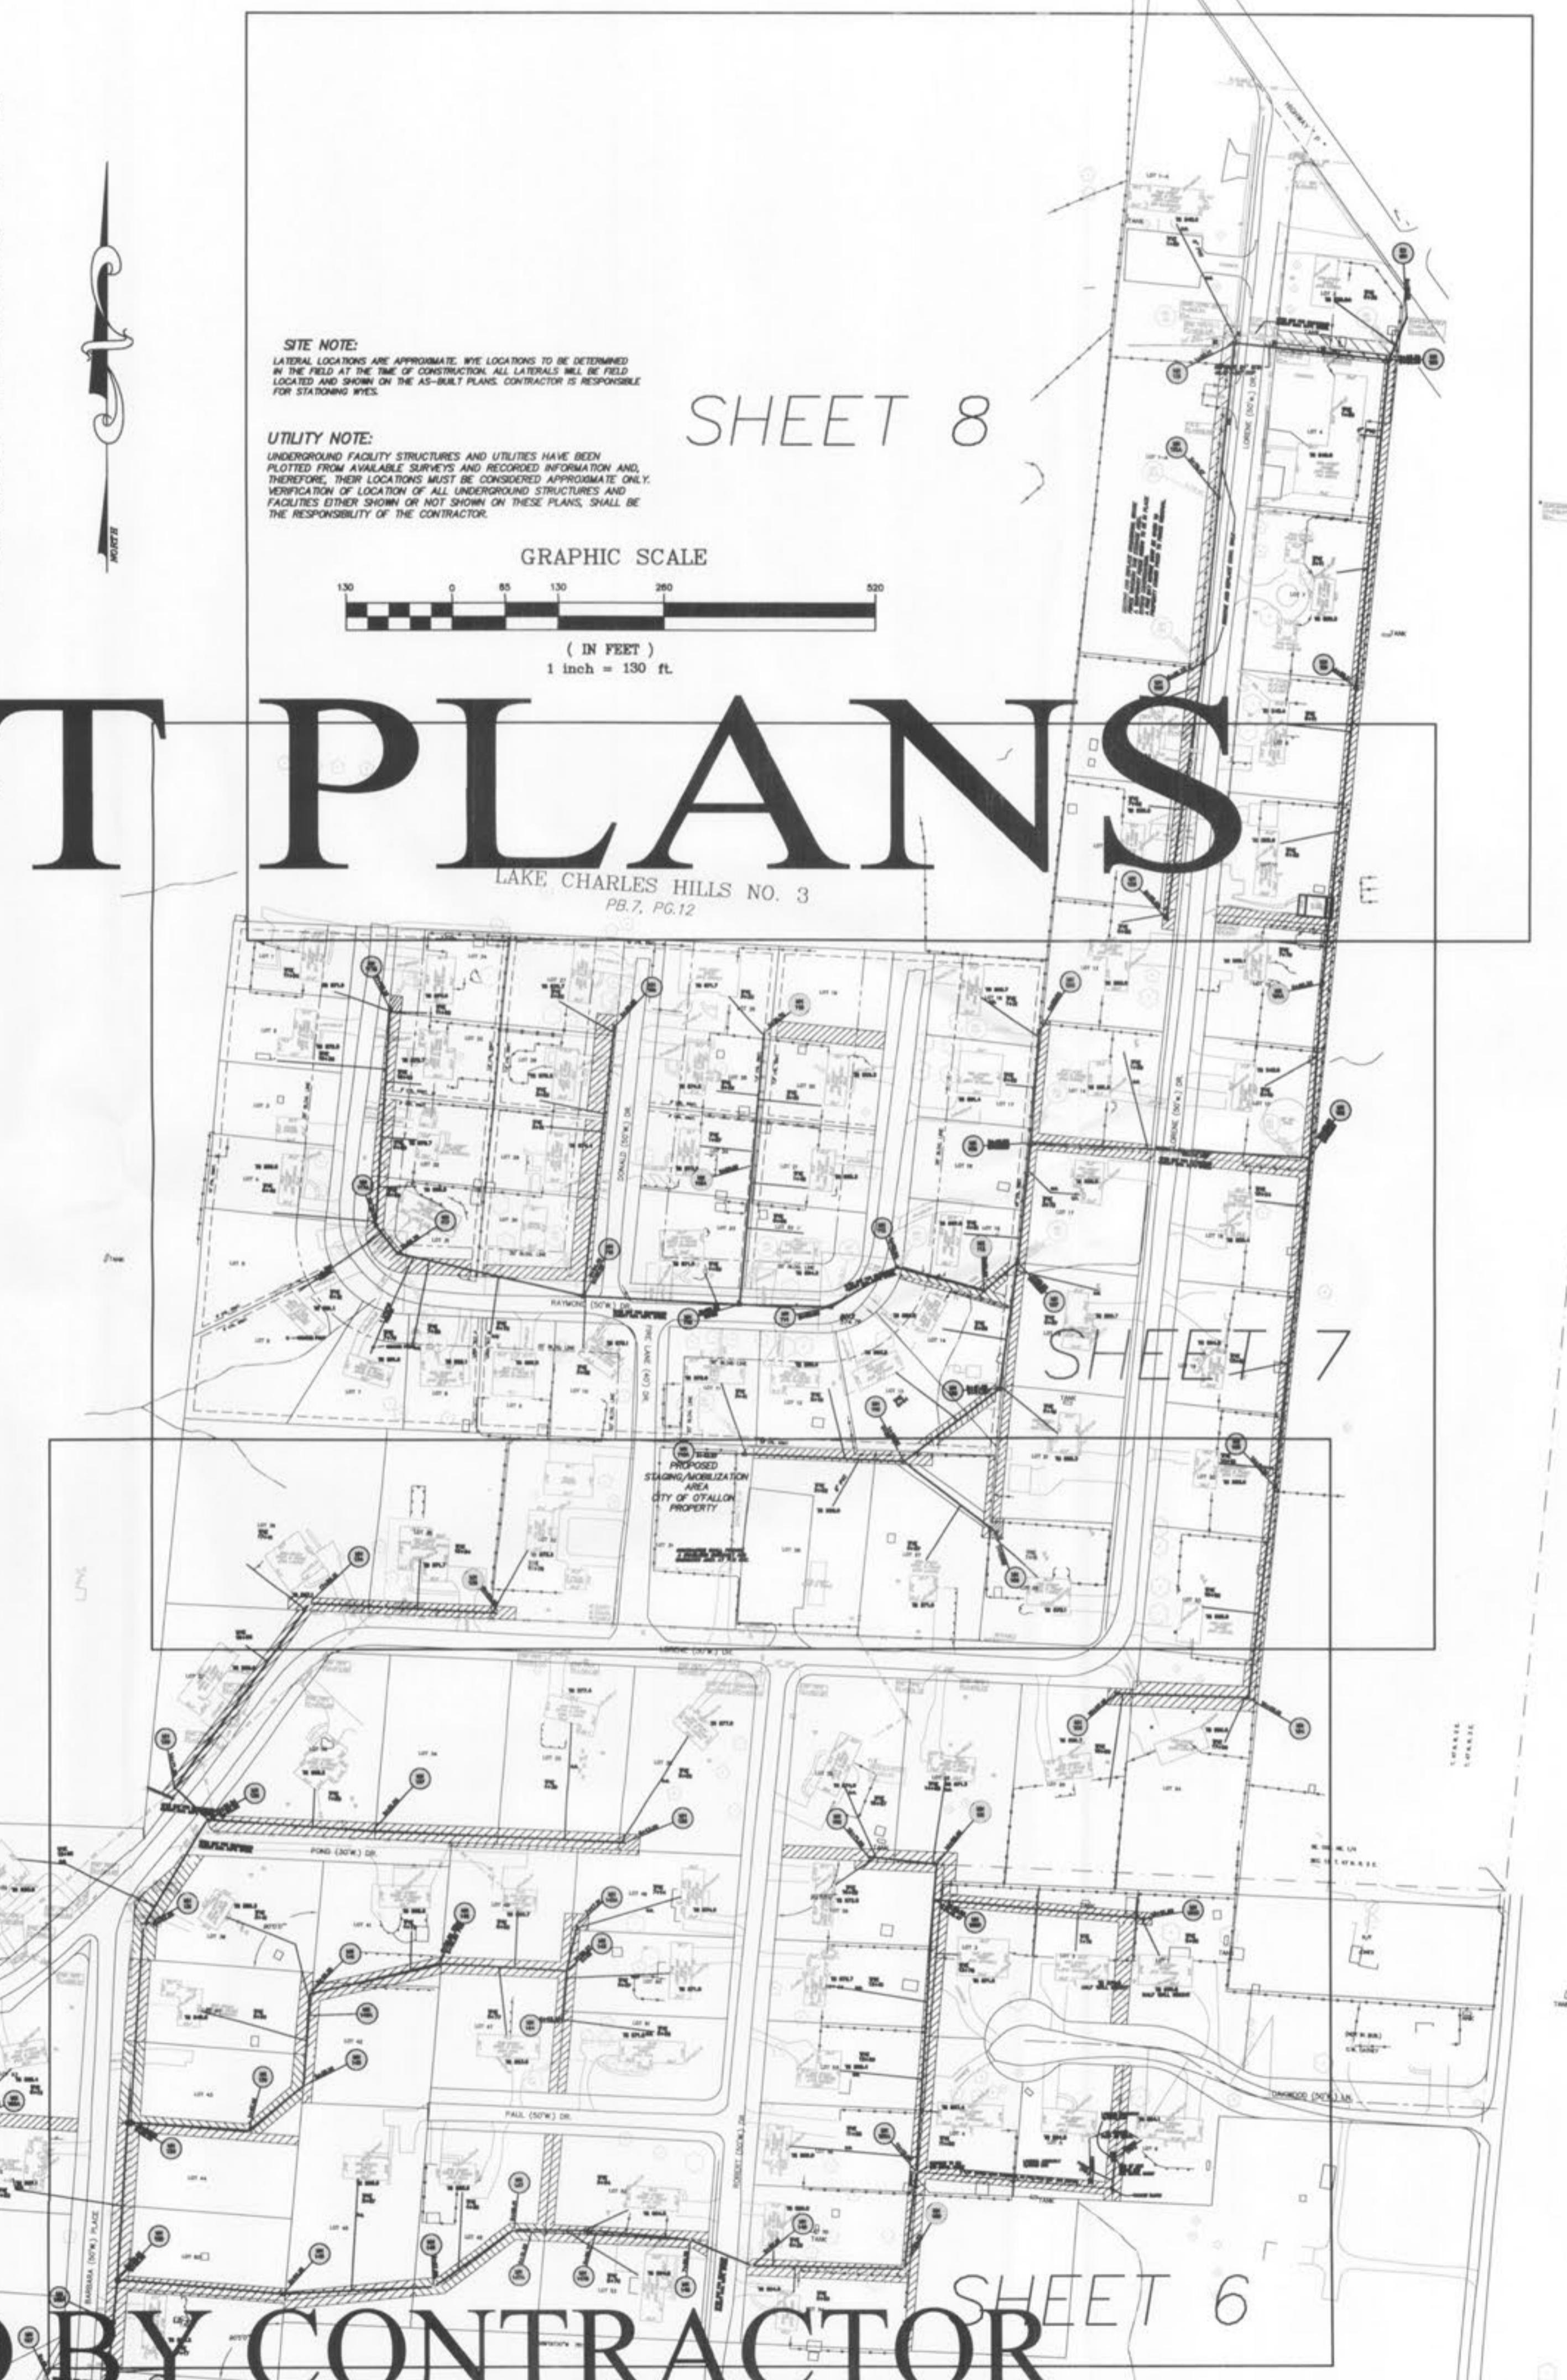

**LAKE CHARLES HILLS N.I.D.
IMPROVEMENT PLANS
OVERALL PLAN**

Prepared For:
ST. CHARLES COUNTY

PICKETT RAY & SILVER
CIVIL ENGINEERS
PLANNERS
LAND SURVEYORS

333 Mid Rivers Mall Drive
St. Peters, MO 63376
Phone (636) 397-1211
Fax (636) 397-1104

REVISIONS	DATE	PER CITY COMMENTS
1	7-18-05	

ENGINEERS AUTHENTICATION
The responsibility for professional engineering liability on this project is held by the engineer whose plans are authenticated by the seal, signature, and date hereunder attached.
Responsibility is disclaimed for all changes made in the plans after this date and specifically excludes revisions after this date unless reauthenticated.

PICKETT, RAY & SILVER, INC.


DRAWN	DATE
MK	01/04/04
CHECKED	DATE
DST	01/04/04

PROJECT # 83054-STCC.00R
TASK # 1 FIELD BOOK

LAKE CHARLES HILLS N.I.D.
IMPROVEMENT PLANS
OVERALL PLAN
SHEET 2 OF 21

© Copyright 2001 by Pickett, Ray & Silver, Inc.

MATCH SHEET 4

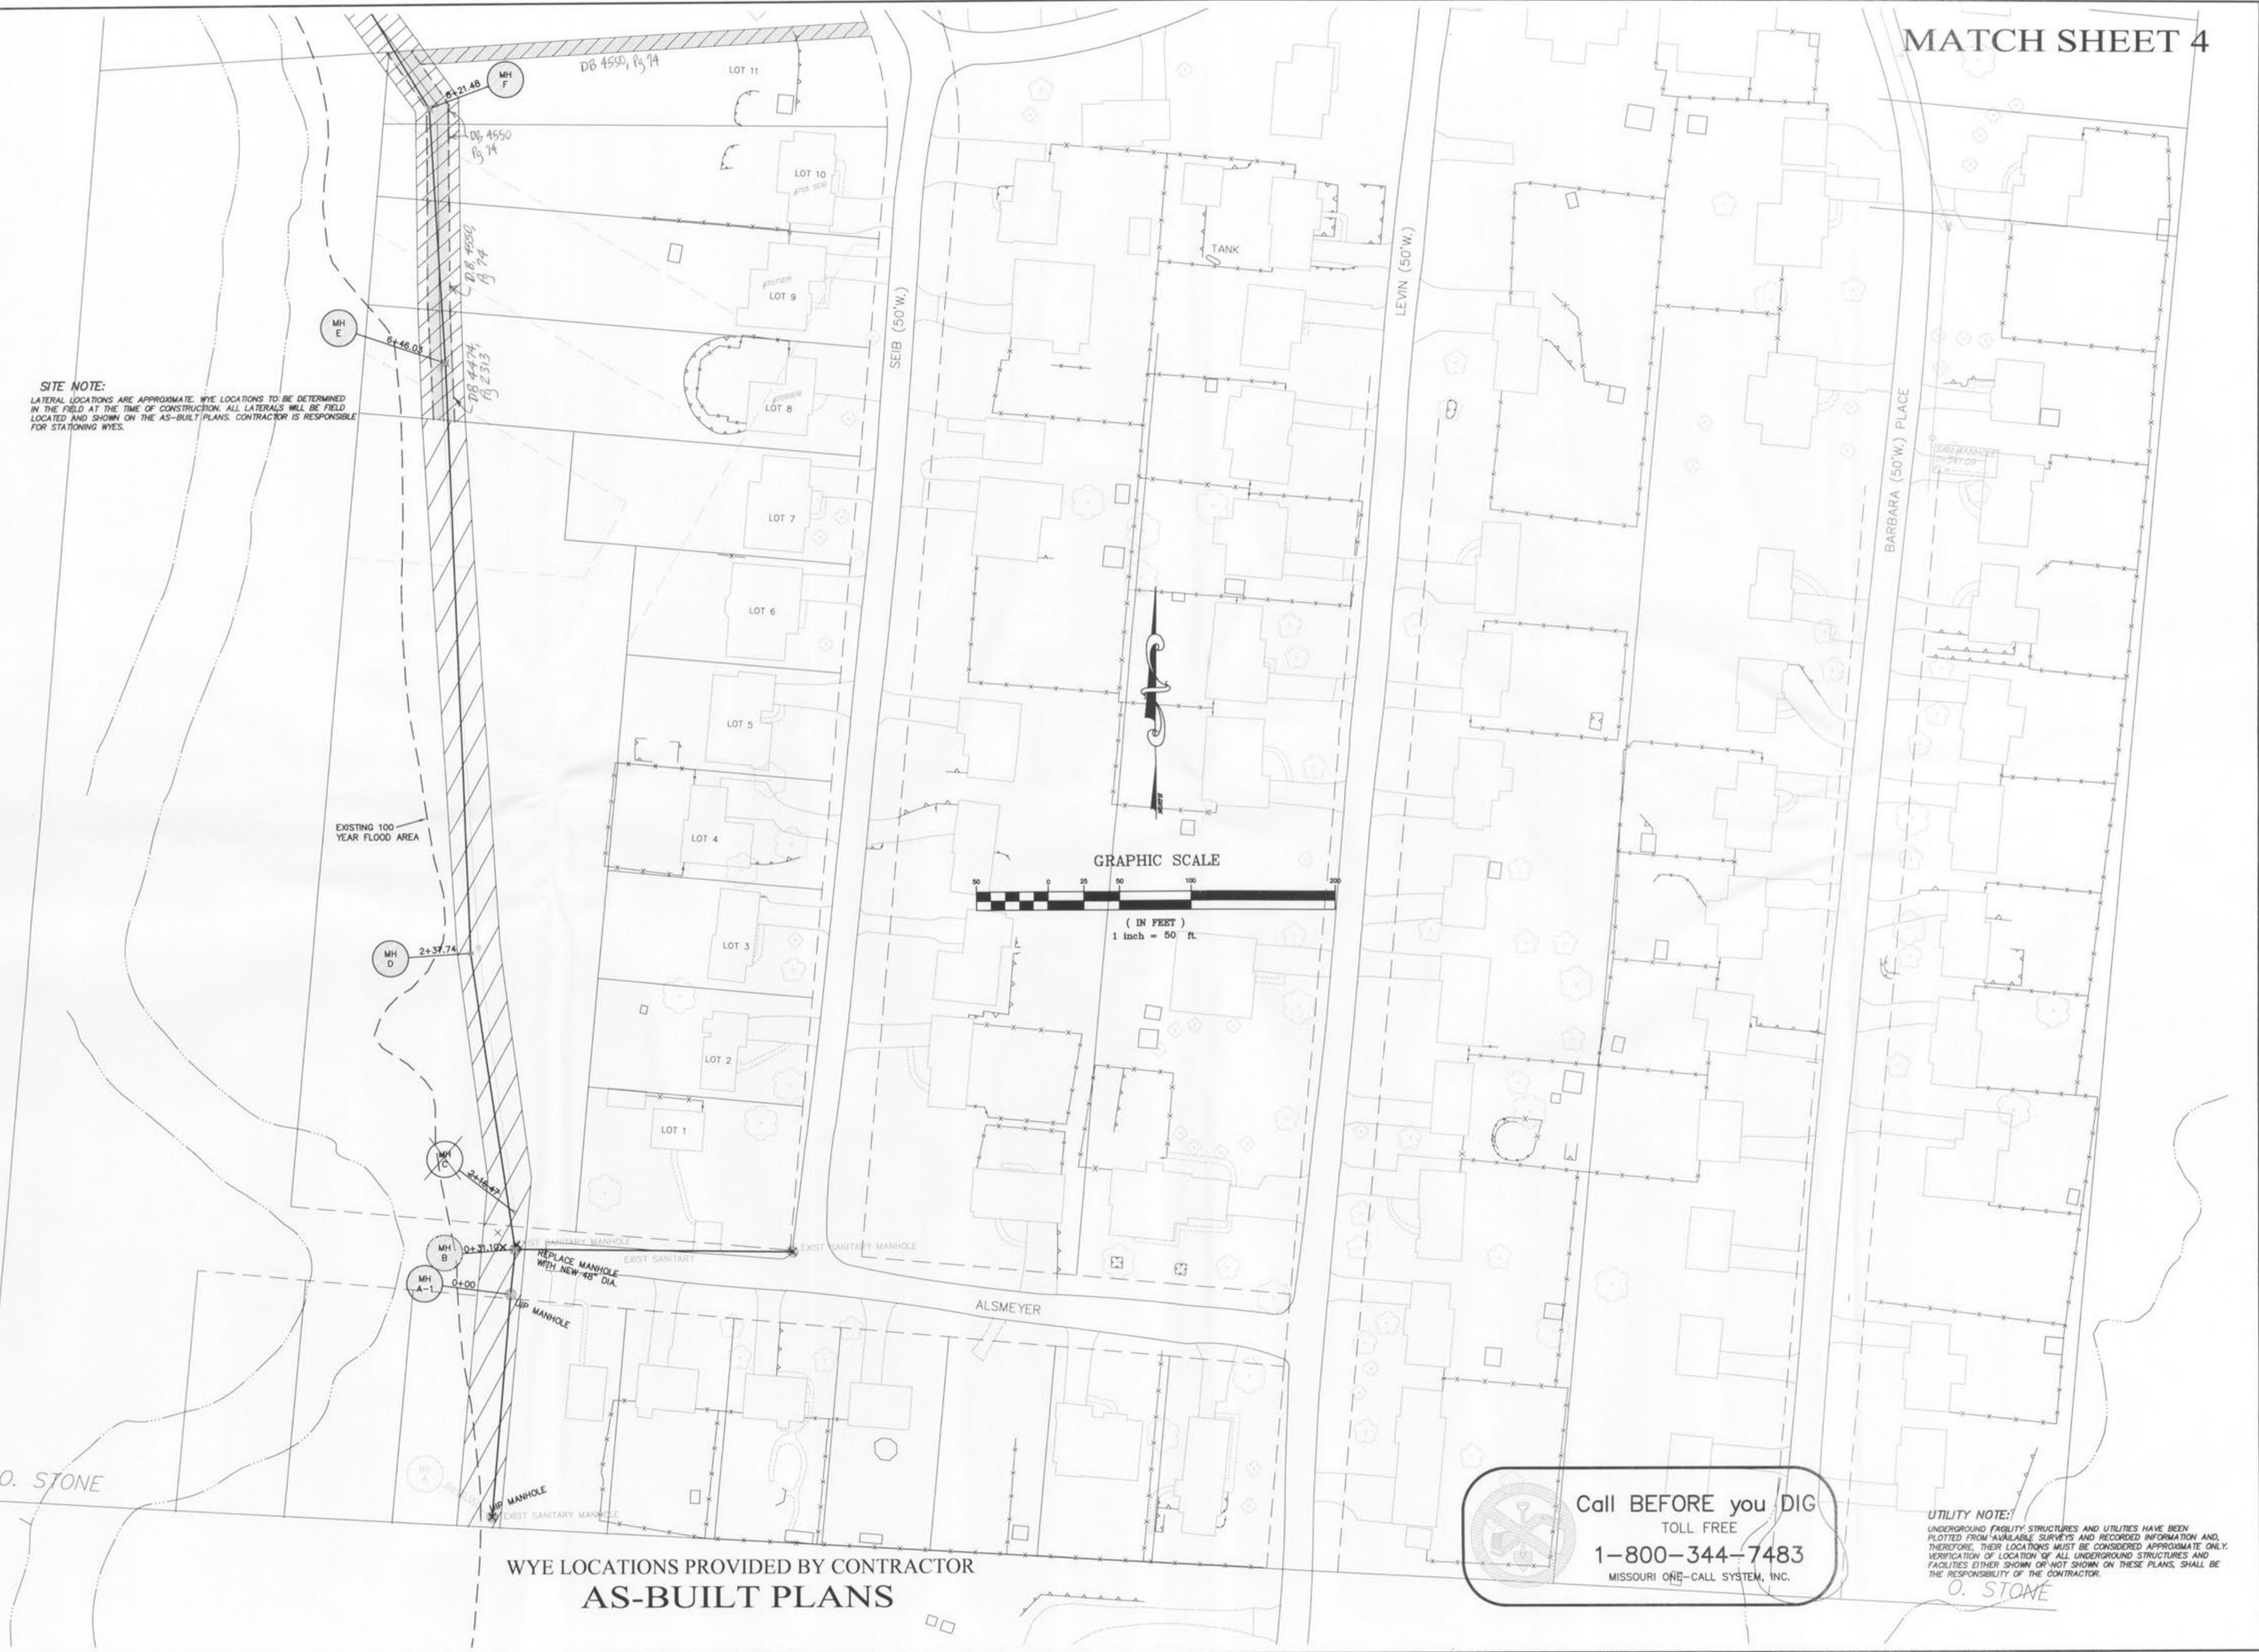

PICKETT RAY & SILVER


CIVIL ENGINEERS
PLANNERS
LAND SURVEYORS
333 Mid Rivers Mall Drive
St. Peters, MO 63376
Phone (636) 397-1211
Fax (636) 397-1104

LAKE CHARLES HILLS N.I.D. IMPROVEMENT PLANS SITE PLAN

Mr. Charles Feldman
St. Charles County Gov't
201 N. Second St., Suite 240
St. Charles, MO 63301
Tel: 636-342-7364
Fax: 636-342-7366

DRAWN MK DATE 01/04/04
CHECKED DST DATE 01/04/04
PROJECT # 83054.STC.00R
TASK # 1 FIELD BOOK

LAKE CHARLES HILLS N.I.D. IMPROVEMENT PLANS SITE PLAN
SHEET 3 OF 21
© Copyright 2001 by Pickett, Ray & Silver Inc.

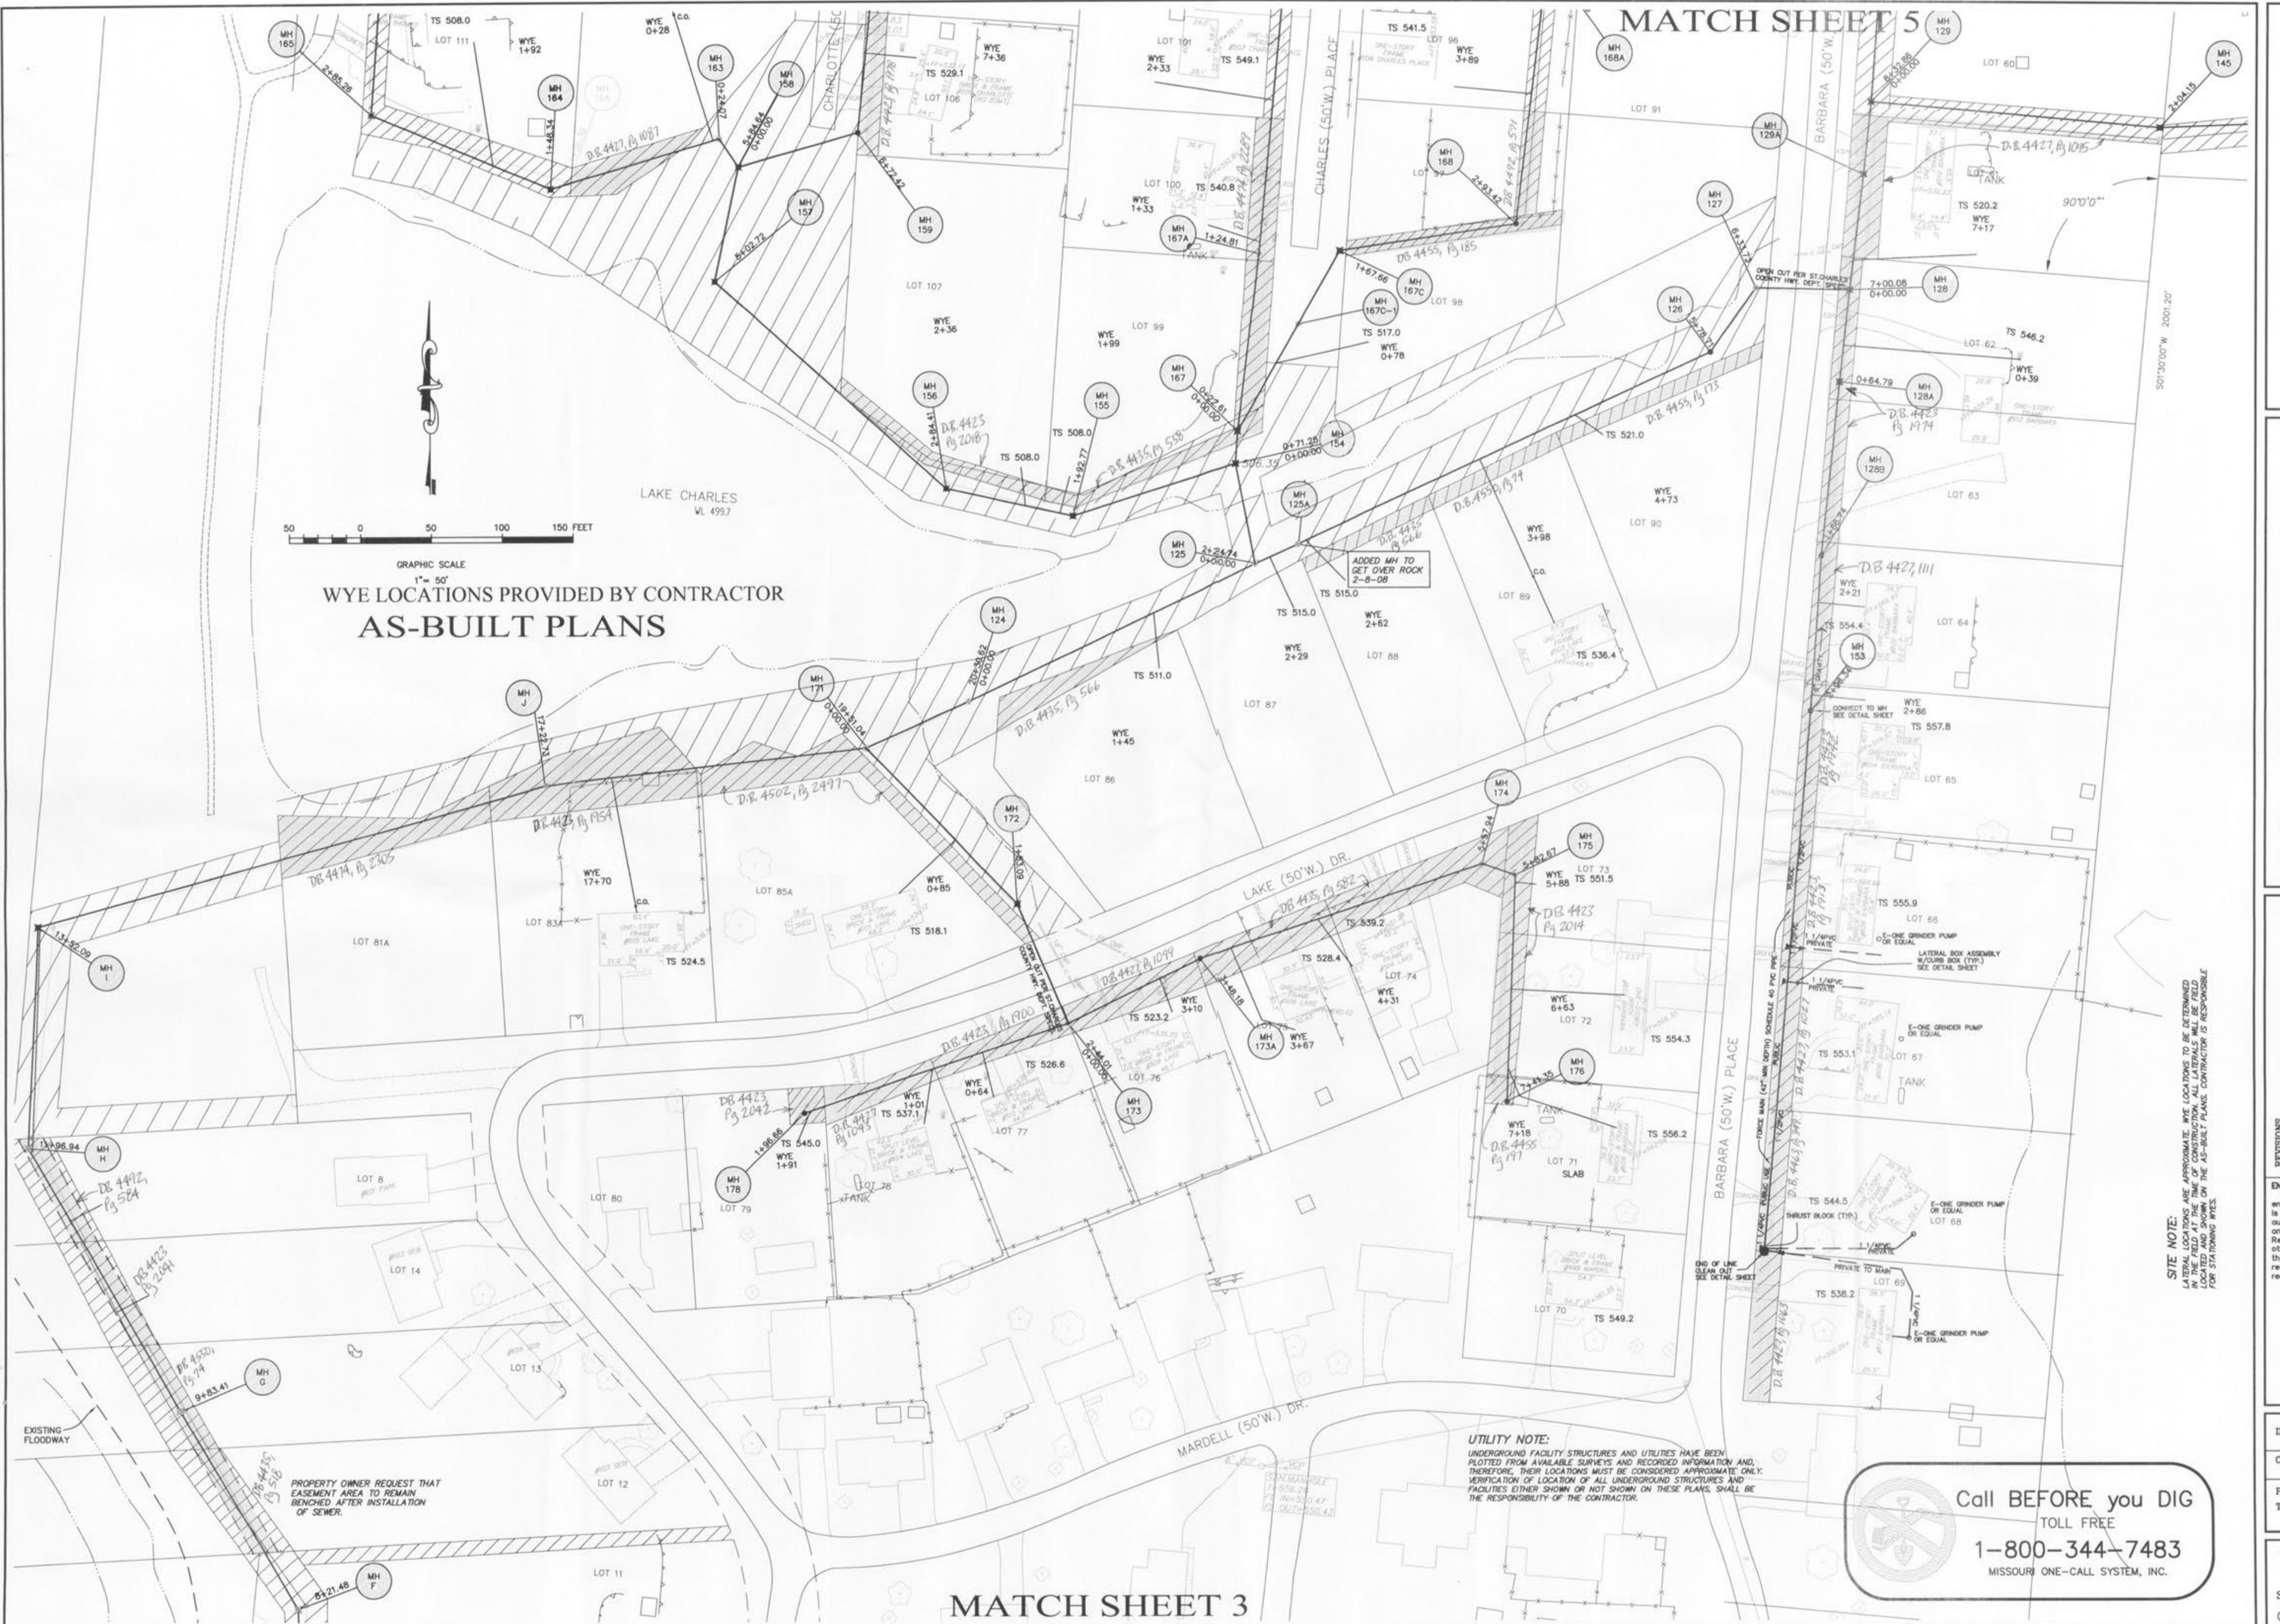

PICKETT RAY & SILVER

333 Mid Rivers Mall Drive
St. Peters, MO 63376
Phone (636) 397-1211
Fax (636) 397-1104

IMPROVEMENT PLANS SITE PLAN

Prepared For:
ST. CHARLES COUNTY

Mr. Charles Feldman
St. Charles County Gov't
201 N. Second St., Suite 420
St. Charles, MO 63301
Tele: 636-949-7564
Fax: 636-949-7336

N MK	DATE 01/04/04
KED DST	DATE 01/04/04
ACT # 83054-STCC.00R	
# 1	FIELD BOOK

CHARLES HILLS N.I.D.
IMPROVEMENT PLANS
SITE PLAN
1 - 21

Copyright 2001 by Pickett, Roy & Silver Inc.

MATCH SHEET 6



UTILITY NOTE:
UNDERGROUND FACILITY STRUCTURES AND UTILITIES HAVE BEEN
PLACED ON THESE PLANS AS OF THE DATE OF THIS PUBLICATION AND,
THEREFORE, THEIR LOCATIONS MUST BE CONSIDERED APPROXIMATE ONLY.
VERIFICATION OF LOCATION OF ALL UNDERGROUND STRUCTURES AND
FACILITIES EITHER SHOWN OR NOT SHOWN ON THESE PLANS, SHALL BE
THE RESPONSIBILITY OF THE CONTRACTOR.

SITE NOTE:
LATERAL LOCATIONS ARE APPROXIMATE. WYE LOCATIONS TO BE DETERMINED
IN THE FIELD AT THE TIME OF CONSTRUCTION. ALL LATERALS WILL BE FIELD
LOCATED AND SHOWN ON THE AS-BUILT PLANS. CONTRACTOR IS RESPONSIBLE
FOR STATIONING WYES.

50 0 50 100 150 FEET
GRAPHIC SCALE
1" = 50'

AS-BUILT PLANS

WYE LOCATIONS PROVIDED BY CONTRACTOR



MATCH SHEET 7

UTILITY NOTE:

UNDERGROUND FACILITY STRUCTURES AND UTILITIES HAVE BEEN PLOTTED FROM AVAILABLE SURVEYS AND RECORDED INFORMATION AND, THEREFORE, THEIR LOCATIONS MUST BE CONSIDERED APPROXIMATE ONLY. VERTICALLY APPROXIMATE LOCATIONS OF UNDERGROUND STRUCTURES AND FACILITIES EITHER SHOWN OR NOT SHOWN ON THESE PLANS, SHALL BE THE RESPONSIBILITY OF THE CONTRACTOR.


SITE NOTE:

LATERAL LOCATIONS ARE APPROXIMATE. WYE LOCATIONS TO BE DETERMINED IN THE FIELD AT THE TIME OF CONSTRUCTION. ALL LATERALS WILL BE FIELD LOCATED AND SHOWN ON THE AS-BUILT PLANS. CONTRACTOR IS RESPONSIBLE FOR STATIONING WYES.


PROPOSED STAGING/MOBILIZATION AREA CITY OF O'FALLON PROPERTY

CONTRACTOR SHALL PROVIDE A STABILIZED ENTRANCE AND WASHDOWN AREA AT THIS SITE.

GRAPHIC SCALE

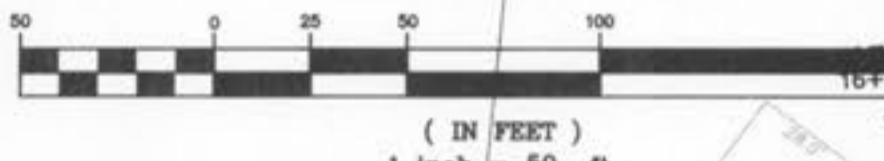

N/F
ECKER, F. LIMA, LIMA
946-1752

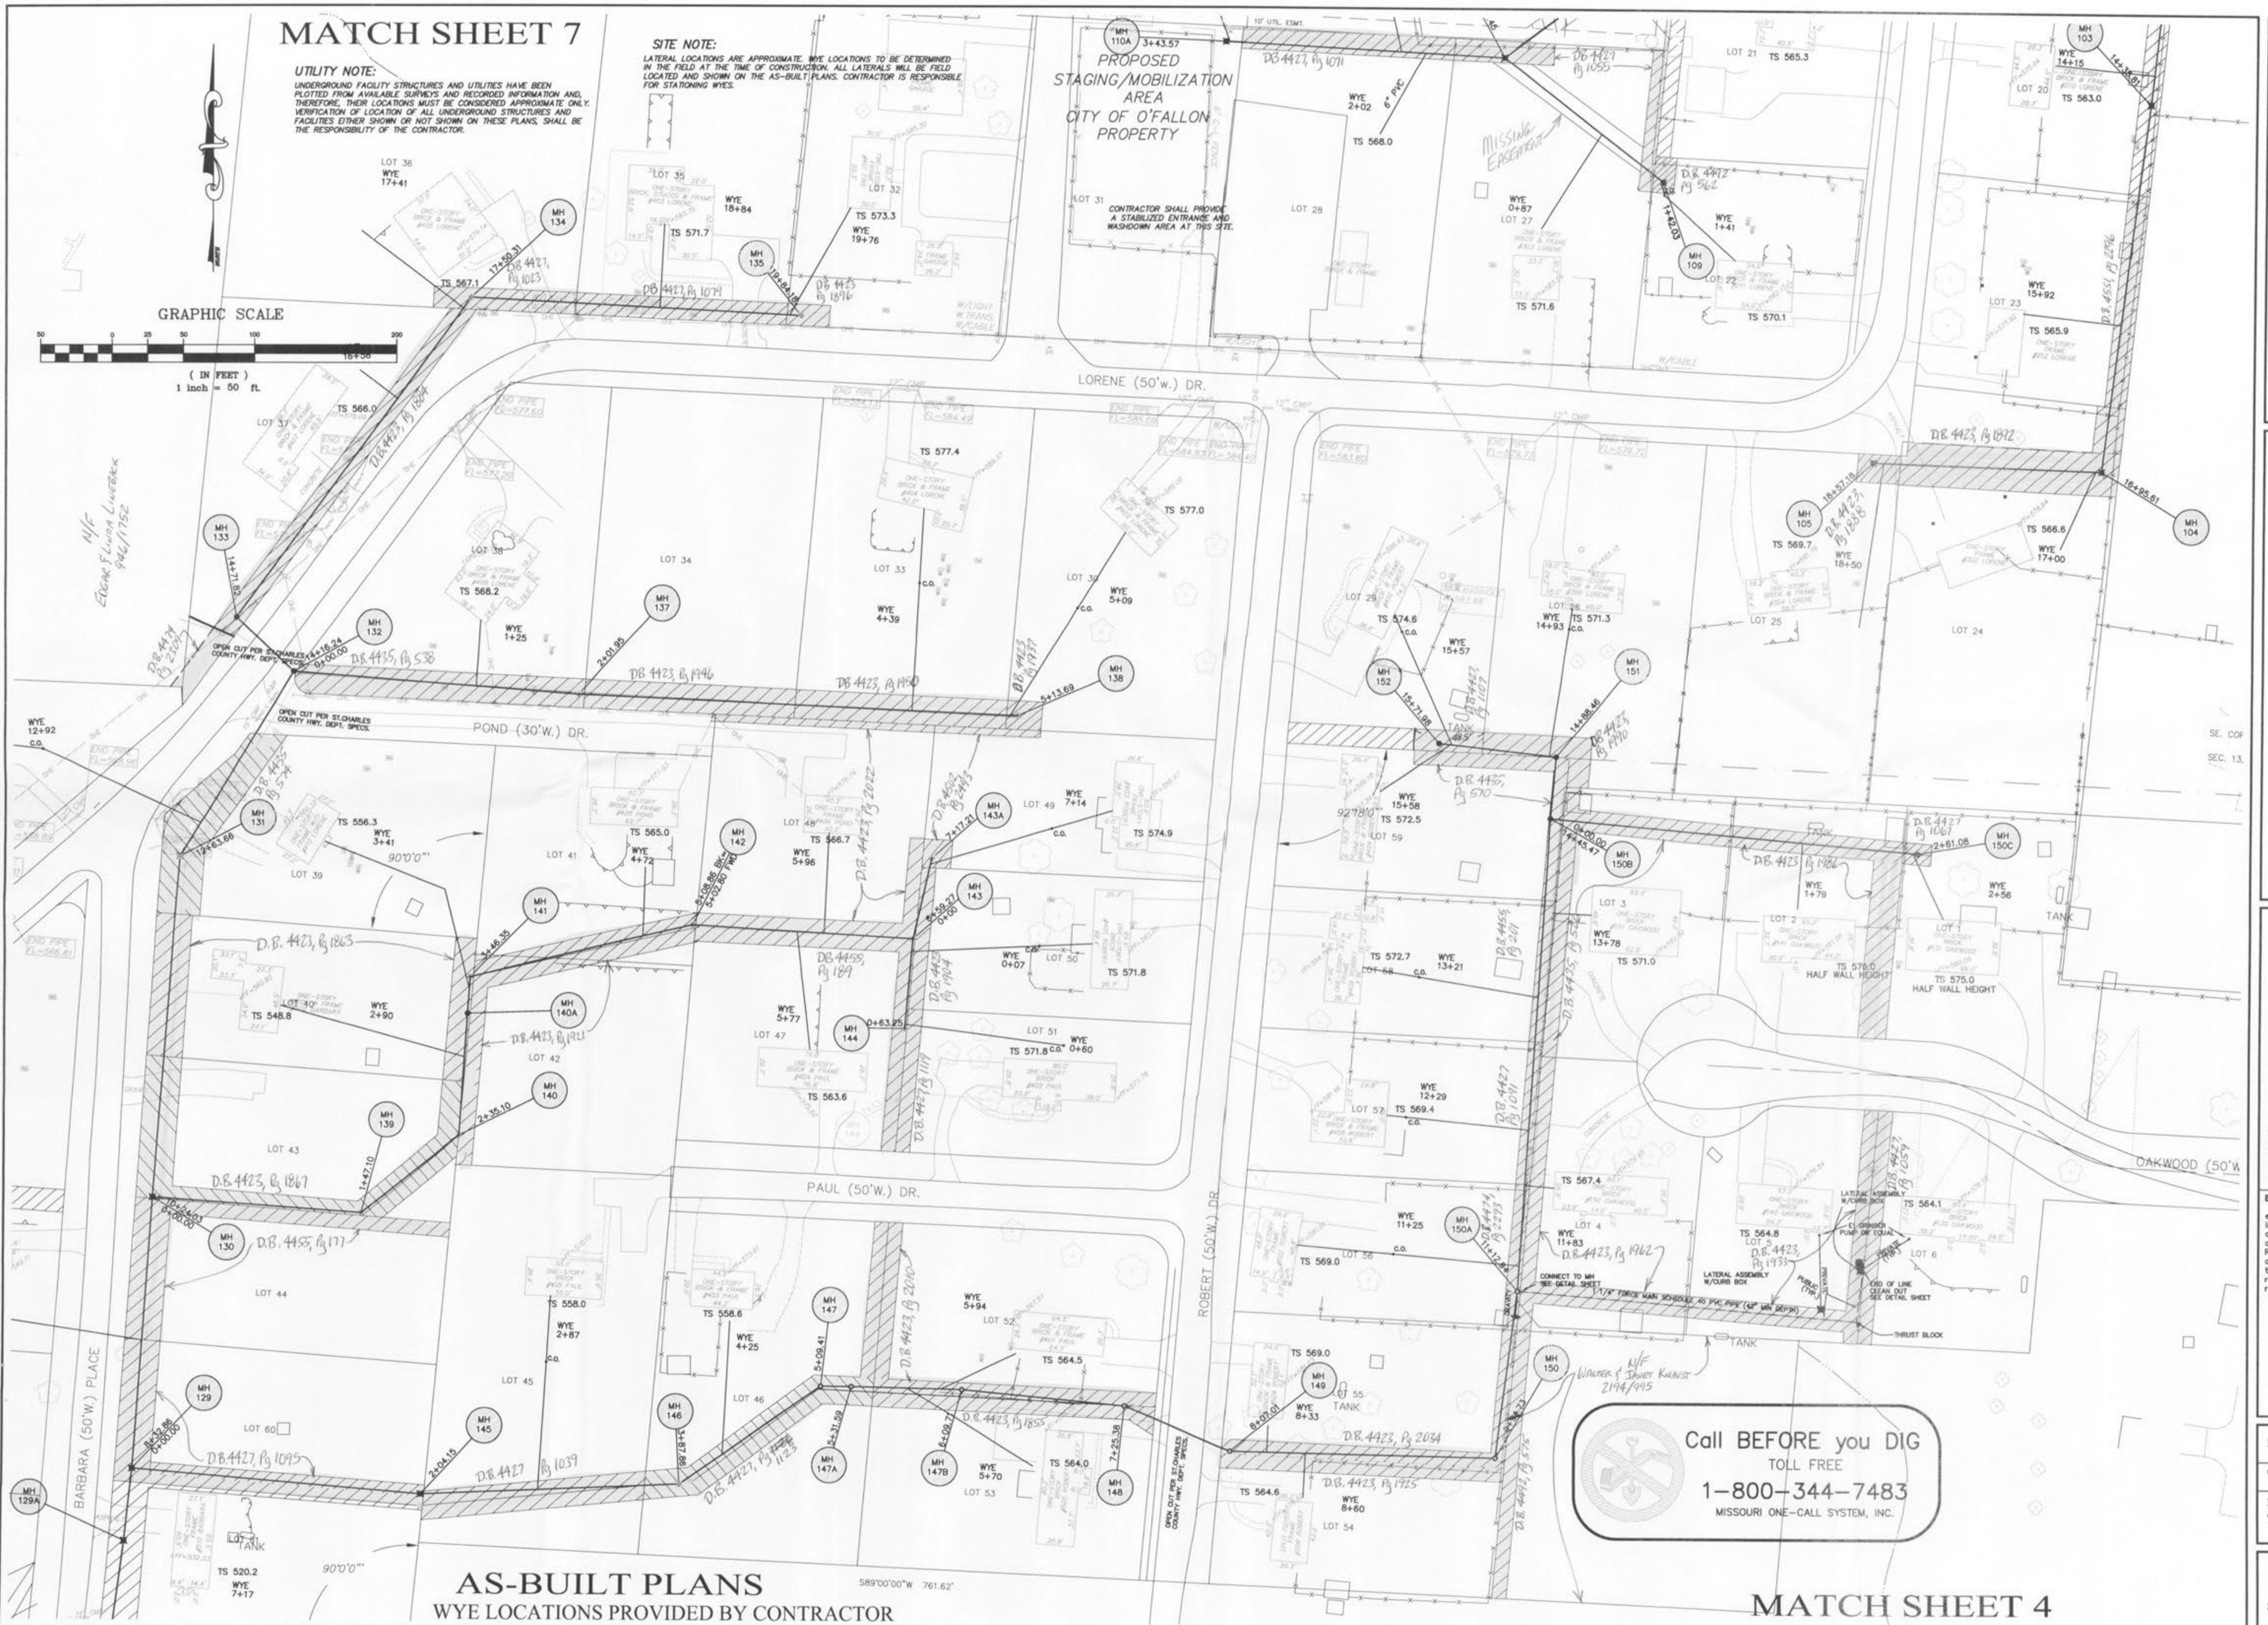

PICKETT RAY & SILVER

CIVIL ENGINEERS
PLANNERS
LAND SURVEYORS

LAKE CHARLES HILLS N.I.D. IMPROVEMENT PLANS SITE PLAN

Prepared For:

ST. CHARLES COUNTY

REVISIONS	NO.	DATE	PER CITY COMMENTS
	1	7-18-06	
	2	12-15-06	SHOW ESWW ESWN T. PER CITY COMMENTS
	3	4-28-06	Sediment control to Lots 23 & 24 also Lots 84+56, 4-6
	4	12-29-06	PER CITY LETTER 12/06/06
	5	3-20-07	PER CITY LETTER 1/16/07
	6	4-13-07	FORCE MAIN

DRAWN	MK	DATE
		01/04/04
CHECKED	DST	DATE
		01/04/04

PROJECT # 83054.STCC.00R
TASK # 1
FIELD
BOOK

LAKE CHARLES HILLS N.I.D.
IMPROVEMENT PLANS
SITE PLAN

SHEET 6 OF 21

Copyright 2001 by Pickett, Ray & Silver, Inc.

333 Mid Rivers Mall Drive
St. Charles, MO 63376
Phone (636) 397-1211
Fax (636) 397-1104

Mr. Charles Feldman
St. Charles County Gov't
201 S. Second St., Suite 200
St. Charles, MO 63301
Tel: 636-349-7564
Fax: 636-349-7536

ENGINEERS AUTHENTICATION:
The responsibility for professional engineering liability on this project is hereby limited to the set of plans authorized by the seal, signature, and date hereon. Responsibility is disclaimed for all other engineering plans involved in this project and specifically excludes revisions after this date unless reauthenticated.

PICKETT, RAY & SILVER, INC.

MATCH SHEET 8

UTILITY NOTE:
UNDERGROUND FACILITY STRUCTURES AND UTILITIES HAVE BEEN
PLOTTED FROM AVAILABLE SURVEYS AND RECORDED INFORMATION AND,
THEREFORE, THEIR LOCATIONS MUST BE CONSIDERED APPROXIMATE ONLY.
VERIFICATION OF LOCATION OF ALL UNDERGROUND STRUCTURES AND
FAUCET EJECTORS SHOWN OR NOT SHOWN ON THESE PLANS, SHALL BE
THE RESPONSIBILITY OF THE CONTRACTOR.

Call BEFORE you DIG
TOLL FREE
1-800-344-7483
MISSOURI ONE-CALL SYSTEM, INC.

SITE NOTE:
LATERAL LOCATIONS ARE APPROXIMATE. WYE LOCATIONS TO BE DETERMINED
IN THE FIELD AT THE TIME OF CONSTRUCTION. ALL LATERALS WILL BE FIELD
LOCATED AND SHOWN ON THE AS-BUILT PLANS. CONTRACTOR IS RESPONSIBLE
FOR STATIONING WYES.

AS-BUILT PLANS

WYE LOCATIONS PROVIDED BY CONTRACTOR

LAKE CHARLES HILLS NO. 3
PB.7, PG.12



MATCH SHEET 6

PICKETT RAY & SILVER

CIVIL ENGINEERS
PLANNERS
LAND SURVEYORS

LAKE CHARLES HILLS N.I.D.

IMPROVEMENT PLANS

SITE PLAN

333 Mid Rivers Mall Drive
St. Peters, MO 63376
Phone (636) 397-1211
Fax (636) 397-1104

REVISIONS	NO.	DATE	PER CITY COMMENTS
	1	7-18-05	SHOW BSMT. PER CITY COMMENTS
	2	12-15-05	Sediment control to lots 20 & 23
	3	4-28-06	OPEN CUT PER ST. CHARLES COUNTY HWY. DEPT. SPEC.
	4	12-29-06	PER CITY LETTER 12/06/06
	5	2-02-07	PER CITY LETTER 1/18/07
	6	4-13-07	NOTED RAIR 24-CMP W/ 24° RCP

DRAWN	DATE
MK	01/04/04
CHECKED	01/04/04
PROJECT # 83054.STCC.00R	
TASK # 1	FIELD BOOK

LAKE CHARLES HILLS N.I.D.
IMPROVEMENT PLANS
SITE PLAN
SHEET 7 OF 21
© Copyright 2001 by Pickett, Ray & Silver Inc.

PICKETT RAY & SILVER

CIVIL ENGINEERS
PLANNERS
LAND SURVEYORS

333 Mid Rivers Mall Drive
St. Peters, MO 63376
Phone (636) 397-1211
Fax (636) 397-1104

LAKE CHARLES HILLS N.I.D.

IMPROVEMENT PLANS

SITE PLAN

Mr. Charles Feldman
St. Charles County Gov't
St. Charles, MO 63301
7am 636-397-1211
Fax 636-397-1336

REVISIONS	NO.	DATE	PER CITY COMMENTS
	1	7-18-05	SHOW BSMT. PER CITY COMMENTS
	2	12-15-05	Sediment control to lots 20 & 23
	3	4-28-06	OPEN CUT PER ST. CHARLES COUNTY HWY. DEPT. SPEC.
	4	12-29-06	PER CITY LETTER 12/06/06
	5	2-02-07	PER CITY LETTER 1/18/07
	6	4-13-07	NOTED RAIR 24-CMP W/ 24° RCP

DRAWN	DATE
MK	01/04/04
CHECKED	01/04/04
PROJECT # 83054.STCC.00R	
TASK # 1	FIELD BOOK

LAKE CHARLES HILLS N.I.D.
IMPROVEMENT PLANS
SITE PLAN
SHEET 7 OF 21
© Copyright 2001 by Pickett, Ray & Silver Inc.

PICKETT RAY & SILVER

CIVIL ENGINEERS
PLANNERS
LAND SURVEYORS

333 Mid Rivers Mall Drive
St. Peters, MO 63376
Phone (636) 397-1211
Fax (636) 397-1104

LAKE CHARLES HILLS N.I.D.

IMPROVEMENT PLANS

SITE PLAN

Mr. Charles Feldman
St. Charles County Gov't
St. Charles, MO 63301
7am 636-397-1211
Fax 636-397-1336

REVISIONS	NO.	DATE	PER CITY COMMENTS
	1	7-18-05	SHOW BSMT. PER CITY COMMENTS
	2	12-15-05	Sediment control to lots 20 & 23
	3	4-28-06	OPEN CUT PER ST. CHARLES COUNTY HWY. DEPT. SPEC.
	4	12-29-06	PER CITY LETTER 12/06/06
	5	2-02-07	PER CITY LETTER 1/18/07
	6	4-13-07	NOTED RAIR 24-CMP W/ 24° RCP

DRAWN	DATE
MK	01/04/04
CHECKED	01/04/04
PROJECT # 83054.STCC.00R	
TASK # 1	FIELD BOOK

LAKE CHARLES HILLS N.I.D.
IMPROVEMENT PLANS
SITE PLAN
SHEET 7 OF 21
© Copyright 2001 by Pickett, Ray & Silver Inc.

AS-BUILT PLANS

WYE LOCATIONS PROVIDED BY CONTRACTOR




50 0 50 100 150 FEET
GRAPHIC SCALE
1" = 50'

UTILITY NOTE:
UNDERGROUND FACILITY STRUCTURES AND UTILITIES HAVE BEEN PLOTTED FROM AVAILABLE SURVEYS AND RECORDED INFORMATION AND, THEREFORE, THEIR LOCATIONS MUST BE CONSIDERED APPROXIMATE ONLY. VERIFICATION OF LOCATION OF ALL UNDERGROUND STRUCTURES AND FACILITIES, EITHER IN THE FIELD OR AS SHOWN ON THESE PLANS, SHALL BE THE RESPONSIBILITY OF THE CONTRACTOR.

LAKE CHARLES HILLS NO. 3
PB.7, PG.12
50 0 50 100 150 FEET
GRAPHIC SCALE
1" = 50'

MATCH SHEET 7

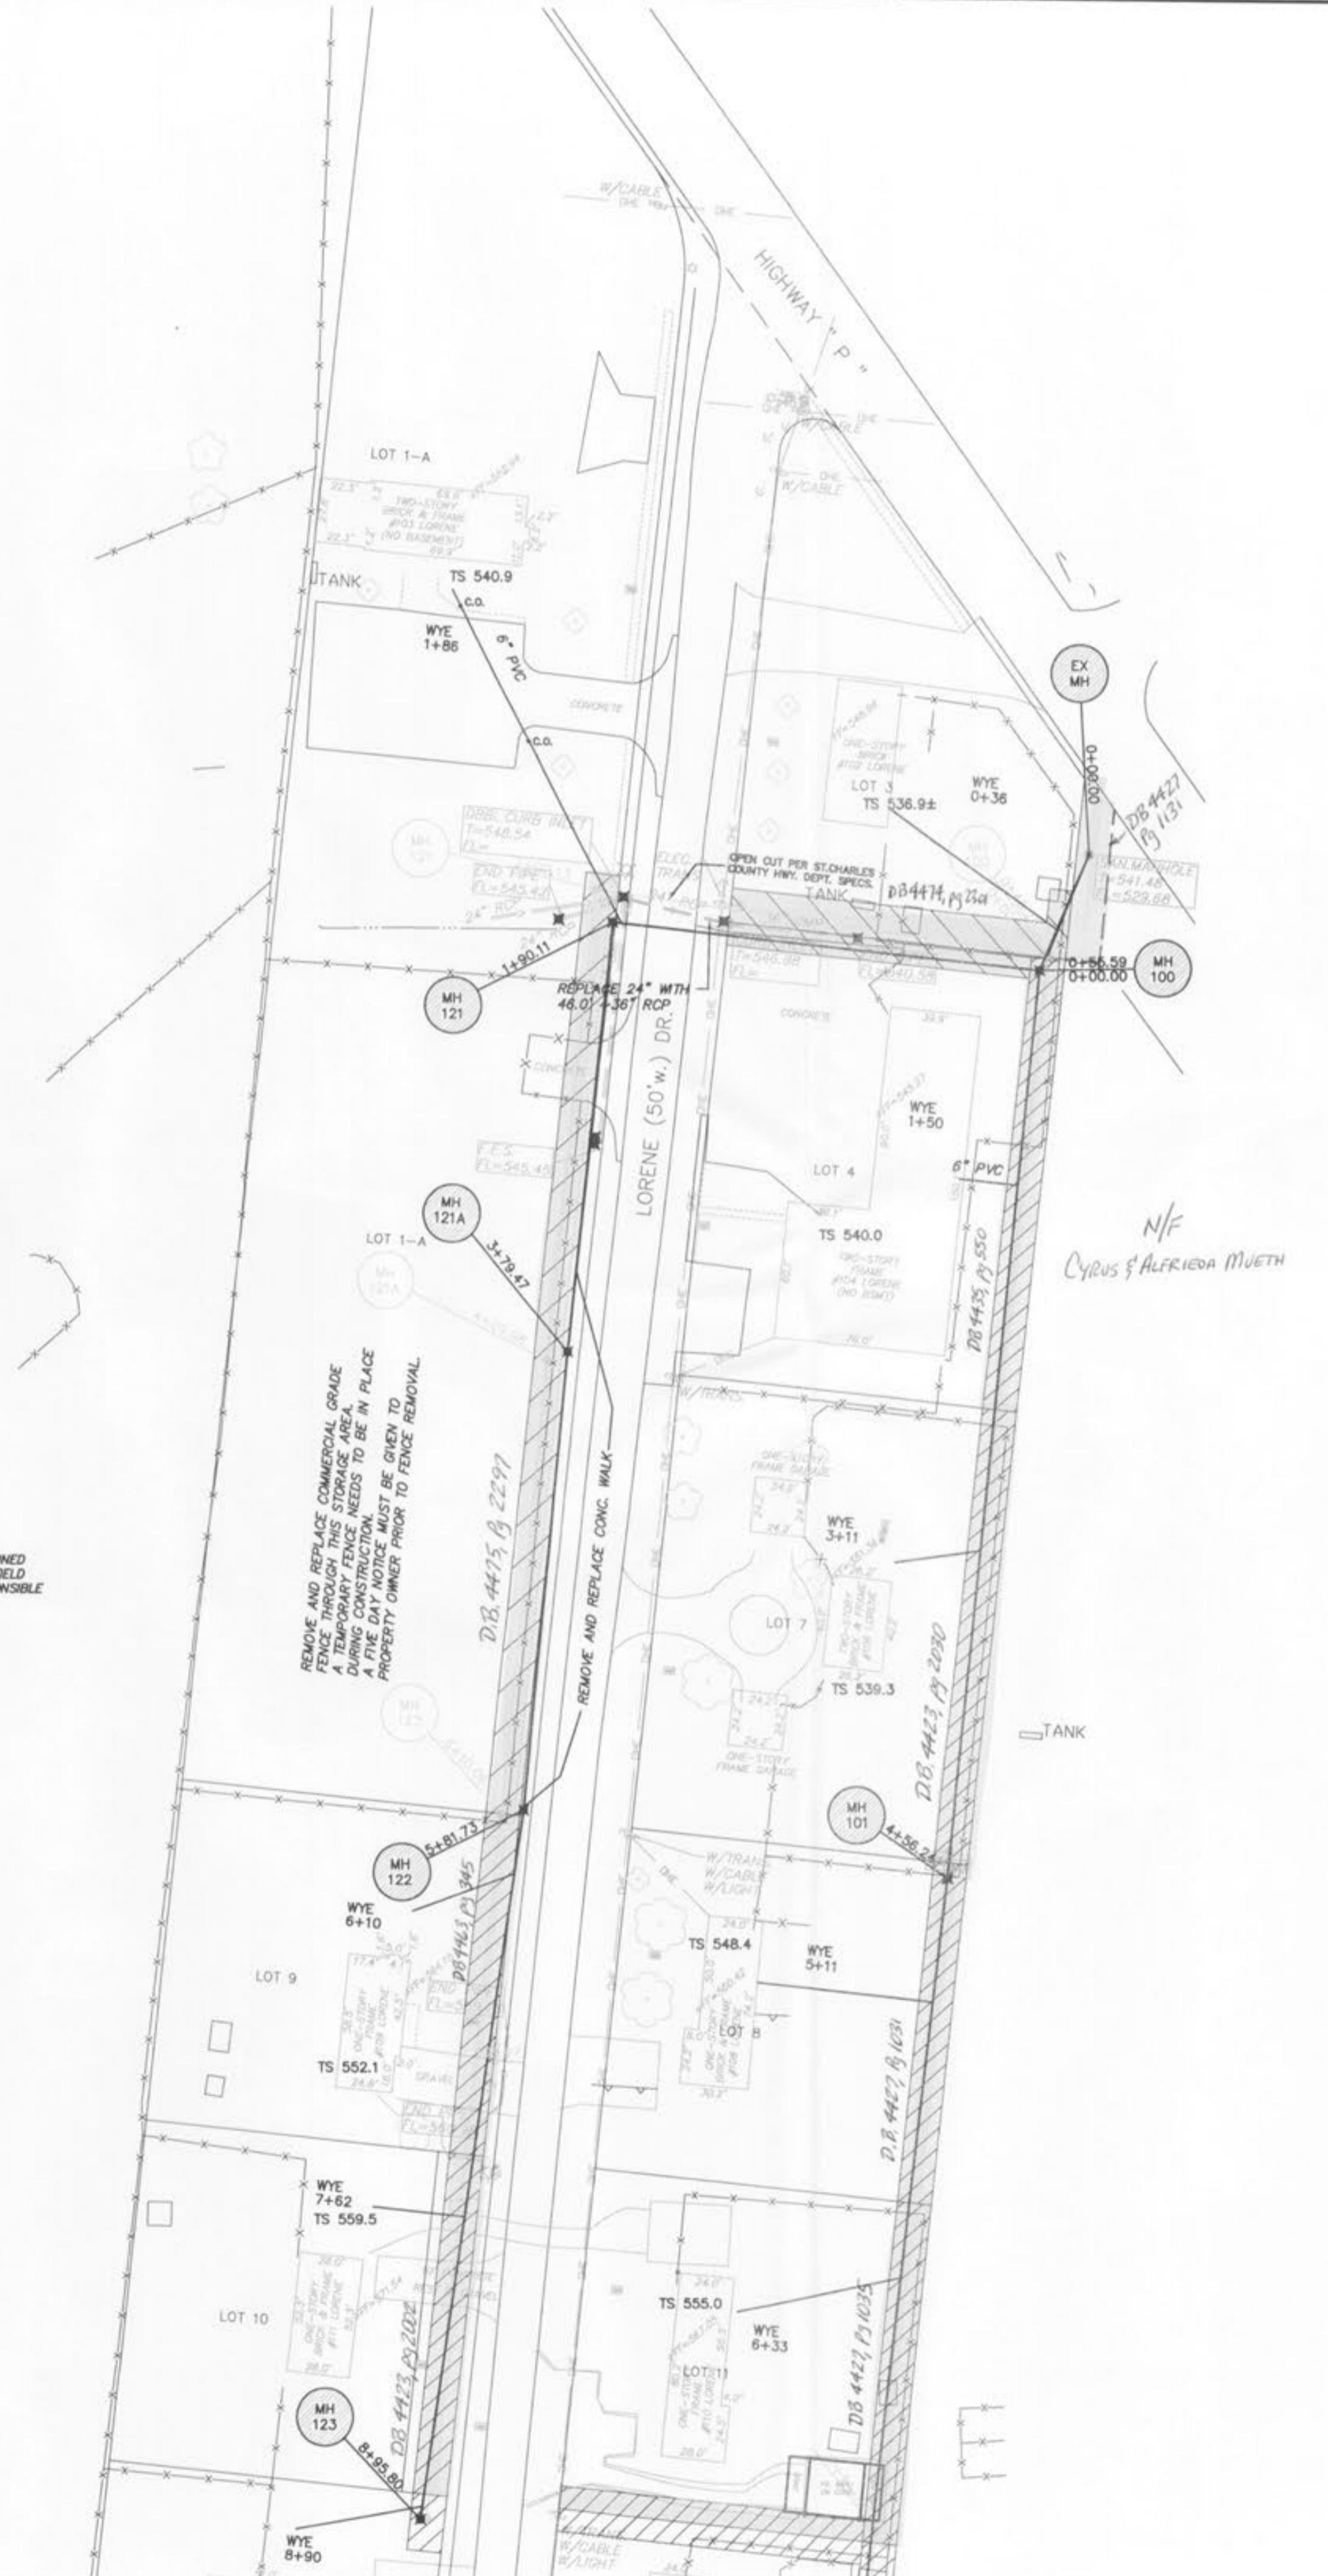

LAKE CHARLES HILLS N.I.D. IMPROVEMENT PLANS SITE PLAN

Prepared For:
ST. CHARLES COUNTY

PICKETT RAY & SILVER

CIVIL ENGINEERS
PLANNERS
LAND SURVEYORS
333 Mid Rivers Mall Drive
St. Peters, MO 63376
Phone (636) 397-1211
Fax (636) 397-1104


REVISIONS	DATE	PER CITY COMMENTS
1	7-18-06	SHOW BSMT. PER CITY COMMENTS
2	12-15-06	PER CITY LETTER 12/06/06
3	12-29-06	

ENGINEERS AUTHENTICATION:
The responsibility for professional engineering liability on this project is hereby limited to the set of plans authenticated by the seal, signature, and date shown below. Responsibility is disclaimed for all other engineering plans involved in this project and specifically excludes revisions made to this date unless reauthenticating.

PICKETT, RAY & SILVER, INC.

DRAWN	DATE
MK	01/04/04
CHECKED	DATE
DST	01/04/04
PROJECT # 83054-STC.C00R	
TASK # 1	FIELD BOOK

LAKE CHARLES HILLS N.I.D.
IMPROVEMENT PLANS
SITE PLAN
SHEET 8 OF 21
© Copyright 2001 by Pickett, Ray & Silver Inc.

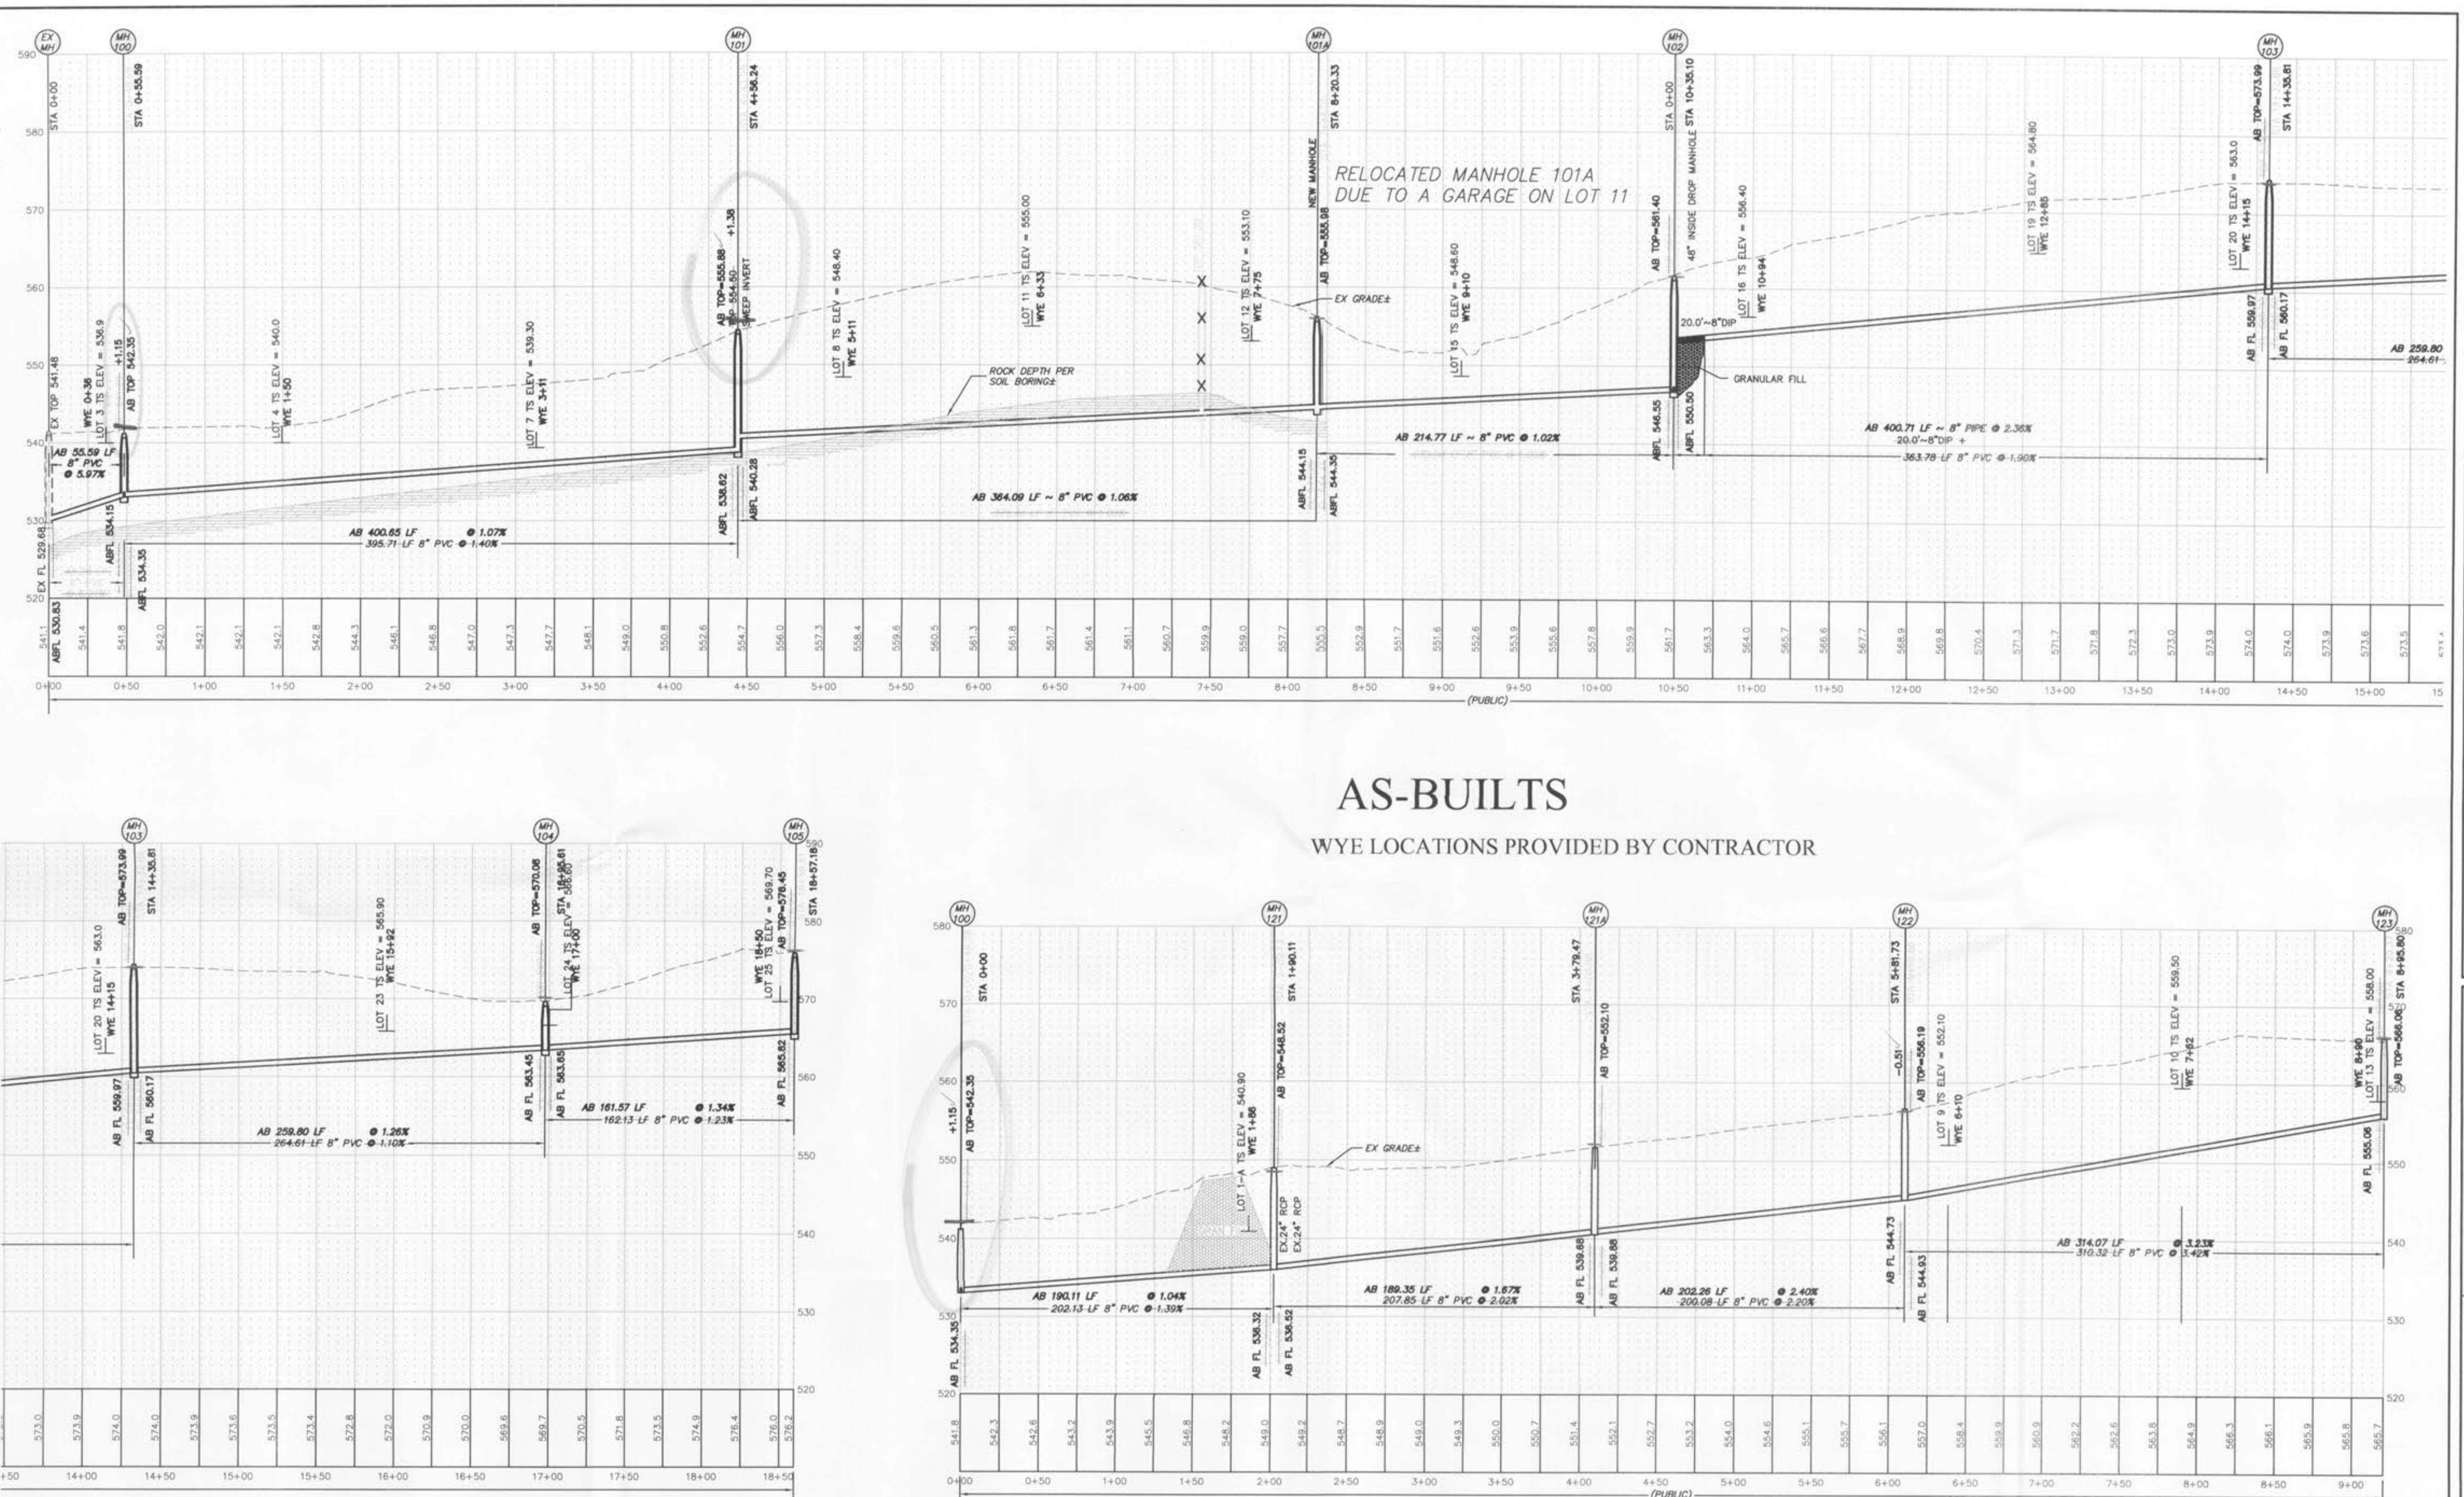

UTILITY NOTE:
UNDERGROUND FACILITY STRUCTURES AND UTILITIES HAVE BEEN PLOTTED FROM AVAILABLE SURVEYS AND RECORDED INFORMATION AND, THEREFORE, THEIR LOCATIONS MUST BE CONSIDERED APPROXIMATE ONLY. MISPLACEMENT, LOSS, OR DAMAGE TO THESE UTILITIES, OR OTHER FACILITIES EITHER SHOWN OR NOT SHOWN ON THESE PLANS, SHALL BE THE RESPONSIBILITY OF THE CONTRACTOR.

SITE NOTE:
LATERAL LOCATIONS ARE APPROXIMATE. WYE LOCATIONS TO BE DETERMINED IN THE FIELD AT THE TIME OF CONSTRUCTION. ALL LATERALS WILL BE FIELD LOCATED AND SHOWN ON THE AS-BUILT PLANS. CONTRACTOR IS RESPONSIBLE FOR STATIONING WYES.

SCALE: HORIZONTAL 1"=50'
VERTICAL 1"=10'

LAKE CHARLES HILLS N.I.D. IMPROVEMENT PLANS SANITARY SEWER PROFILES

Prepared For:
ST. CHARLES COUNTY

PICKETT RAY & SILVER

333 Mid Rivers Mall Drive
St. Peters, MO 63376
Phone (636) 397-1211
Fax (636) 397-1104

CIVIL ENGINEERS
PLANNERS
LAND SURVEYORS

REVISIONS	DATE	PER CITY COMMENTS
1	7-18-05	
2	8-16-05	PER CITY SHOW 0.2' DROP IN MHS
3	12-29-06	PER CITY LETTER 12/06/06

ENGINEERS AUTHENTICATION
The responsibility for professional engineering liability on this project is hereby limited to the set of plans authorized by the engineer's signature, and date hereunder attached. Responsibility is disclaimed for all other engineering plans involved in this project which specifically excludes review after this date unless reauthenticated.

PICKETT, RAY & SILVER, INC.

DRAWN	DATE
MK	01/04/04
DST	01/04/04
PROJECT #	FIELD
83054-STC.GOR	BOOK
TASK # 1	

LAKE CHARLES HILLS N.I.D.
IMPROVEMENT PLANS
SANITARY SEWER PROFILES
SHEET 9 OF 21

Copyright 2001 by Pickett, Ray & Silver Inc.

PICKETT RAY & SILVER

CIVIL ENGINEERS
PLANNERS
LAND SURVEYORS

333 Mid Rivers Mall Drive
St. Peters, MO 63376
Phone (636) 397-1211
Fax (636) 397-1104

LAKE CHARLES HILLS N.I.D. IMPROVEMENT PLANS SANITARY SEWER PROFILES

Prepared For:
ST. CHARLES COUNTY

REVISIONS	DATE	PER CITY COMMENTS
1	7-18-06	PER CITY SHOW 0' DROP IN MH'S
2	6-18-06	PER CITY
3	12-28-06	PER CITY LETTER 12/06/06

ENGINEERS AUTHENTICATION
The responsibility for professional engineering liability on this project is hereby limited to the seal, signature, and date hereunder attached.
Revisions made to these plans or all other engineering plans involved in this project and specifically excludes revisions after this date unless reauthenticated.

PICKETT, RAY & SILVER, INC.

DRAWN	DATE
MK	01/04/04

CHECKED	DATE
DST	01/04/04

PROJECT #	83054.STCC.00R
TASK #	1 FIELD BOOK

LAKE CHARLES HILLS N.I.D.
IMPROVEMENT PLANS
SANITARY SEWER PROFILES
SCALE: HORIZONTAL 1"=50'
VERTICAL 1"=10'

Copyright 2001 by Pickett, Ray & Silver Inc.



AS-BUILTS



WYE LOCATIONS PROVIDED BY CONTRACTOR






1-800-344-7483

MISSOURI ONE-CALL SYSTEM, INC.

UTILITY NOTE:
UNDERGROUND FACILITY STRUCTURES AND UTILITIES HAVE BEEN
PLOTTED FROM AVAILABLE SURVEYS AND RECORDED INFORMATION AND,
THEREFORE, THEIR LOCATIONS SHALL BE CONSIDERED APPROXIMATE ONLY.
VERIFICATION OF LOCATION OF ALL UNDERGROUND STRUCTURES AND
FACILITIES EITHER SHOWN OR NOT SHOWN ON THESE PLANS, SHALL BE
THE RESPONSIBILITY OF THE CONTRACTOR.

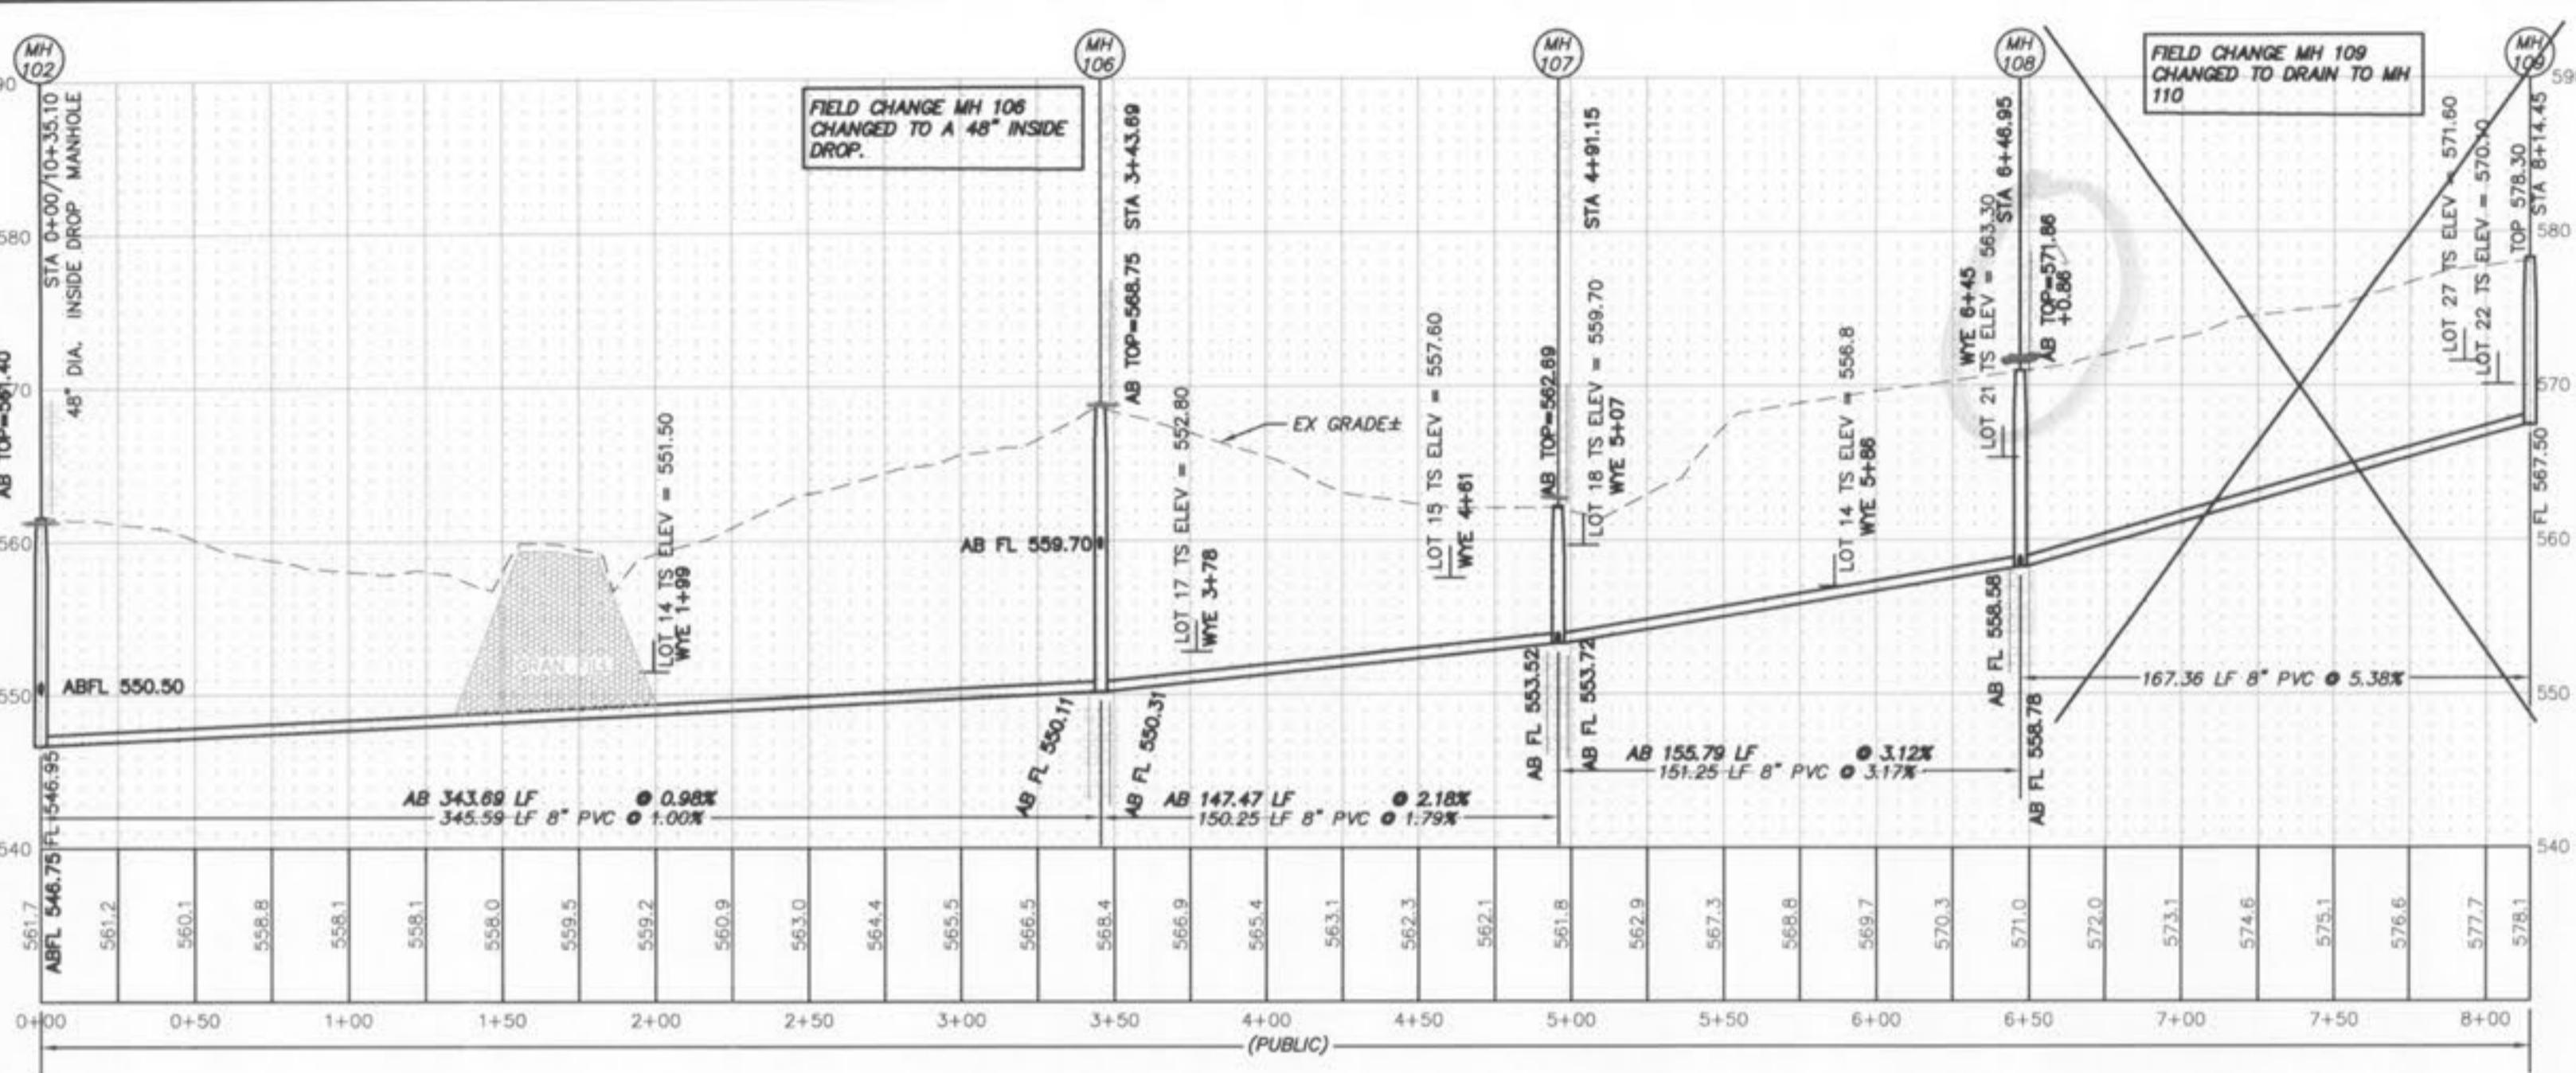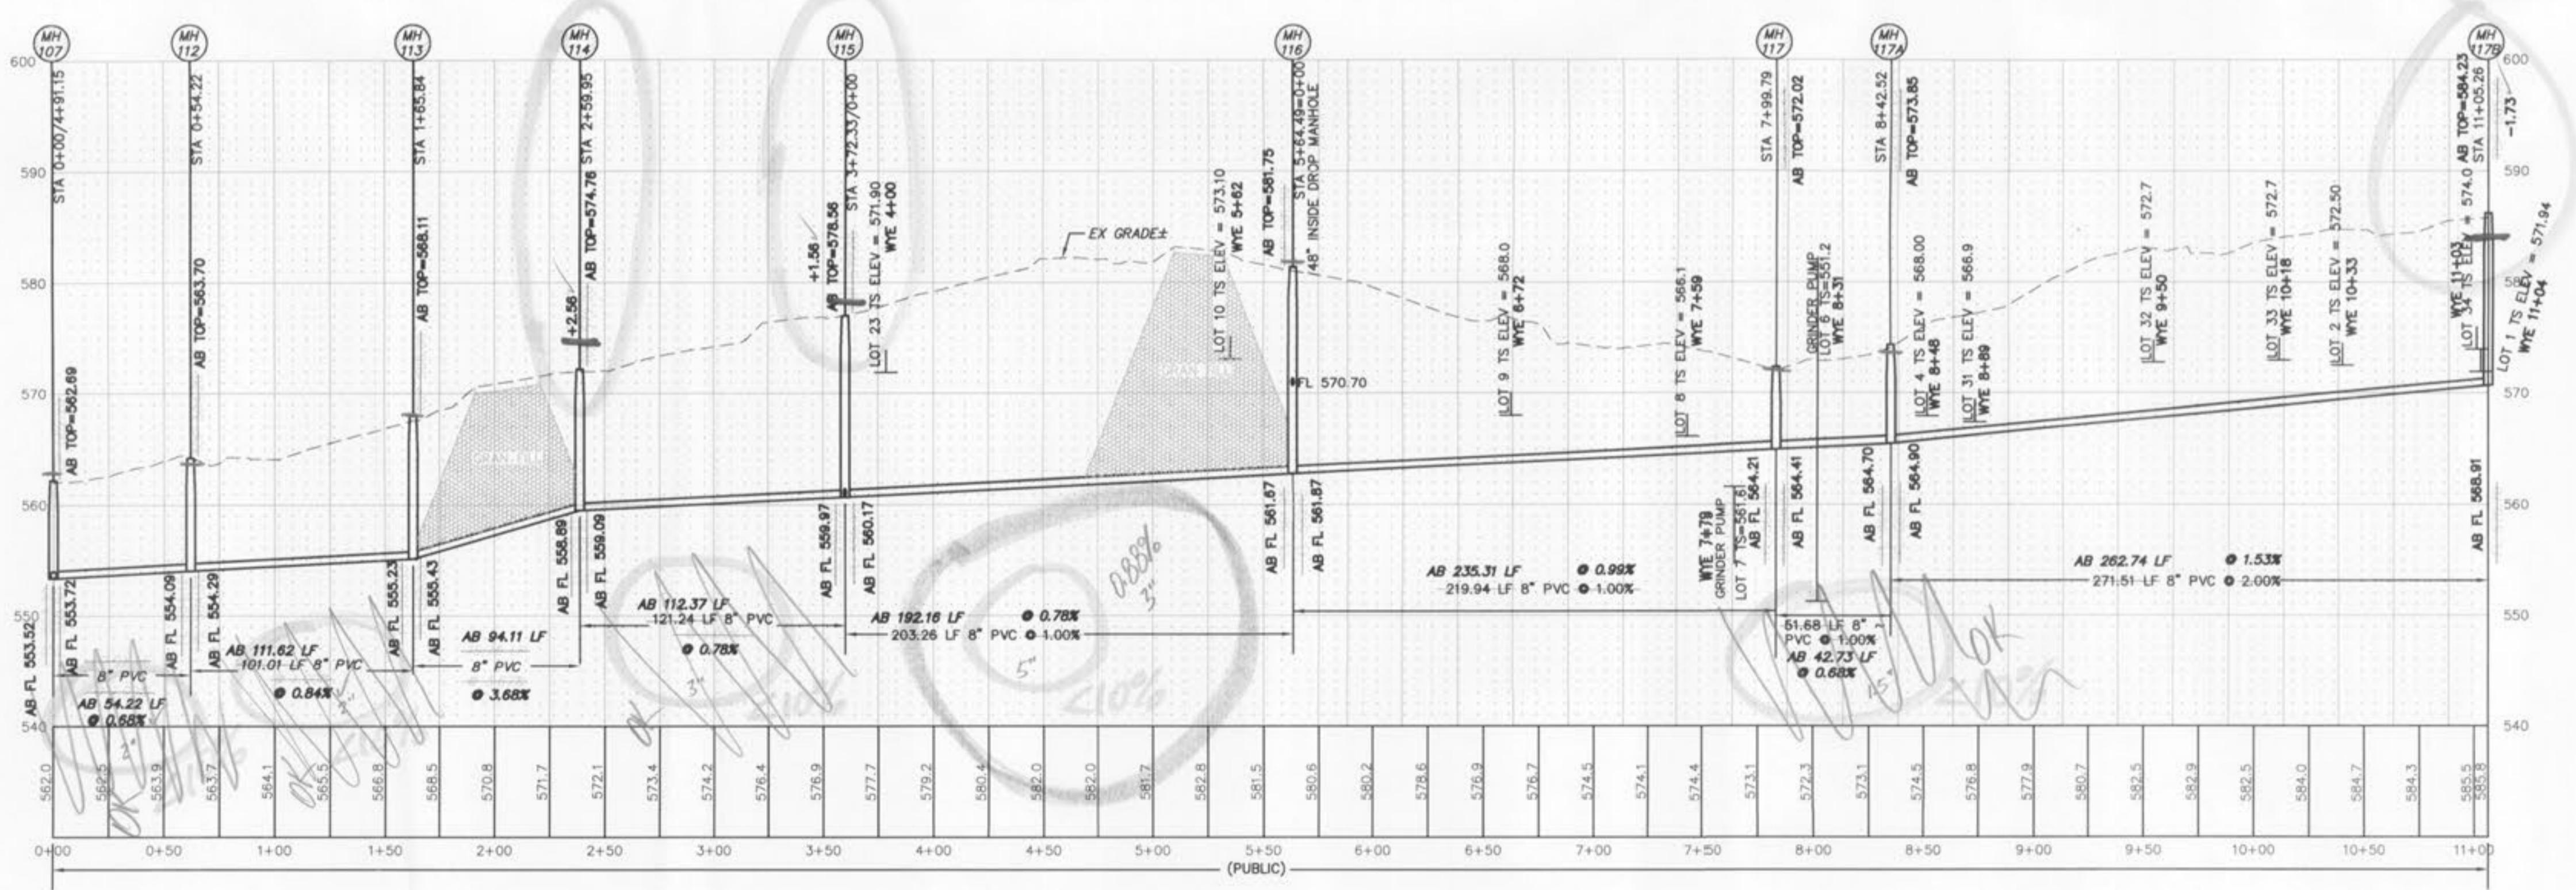

SITE NOTE:
LATERAL LOCATIONS ARE APPROXIMATE. WYE LOCATIONS TO BE DETERMINED
IN THE FIELD AT THE TIME OF CONSTRUCTION. ALL LATERALS WILL BE FIELD
LOCATED AND SHOWN ON THE AS-BUILT PLANS. CONTRACTOR IS RESPONSIBLE
FOR STATIONING WYES.

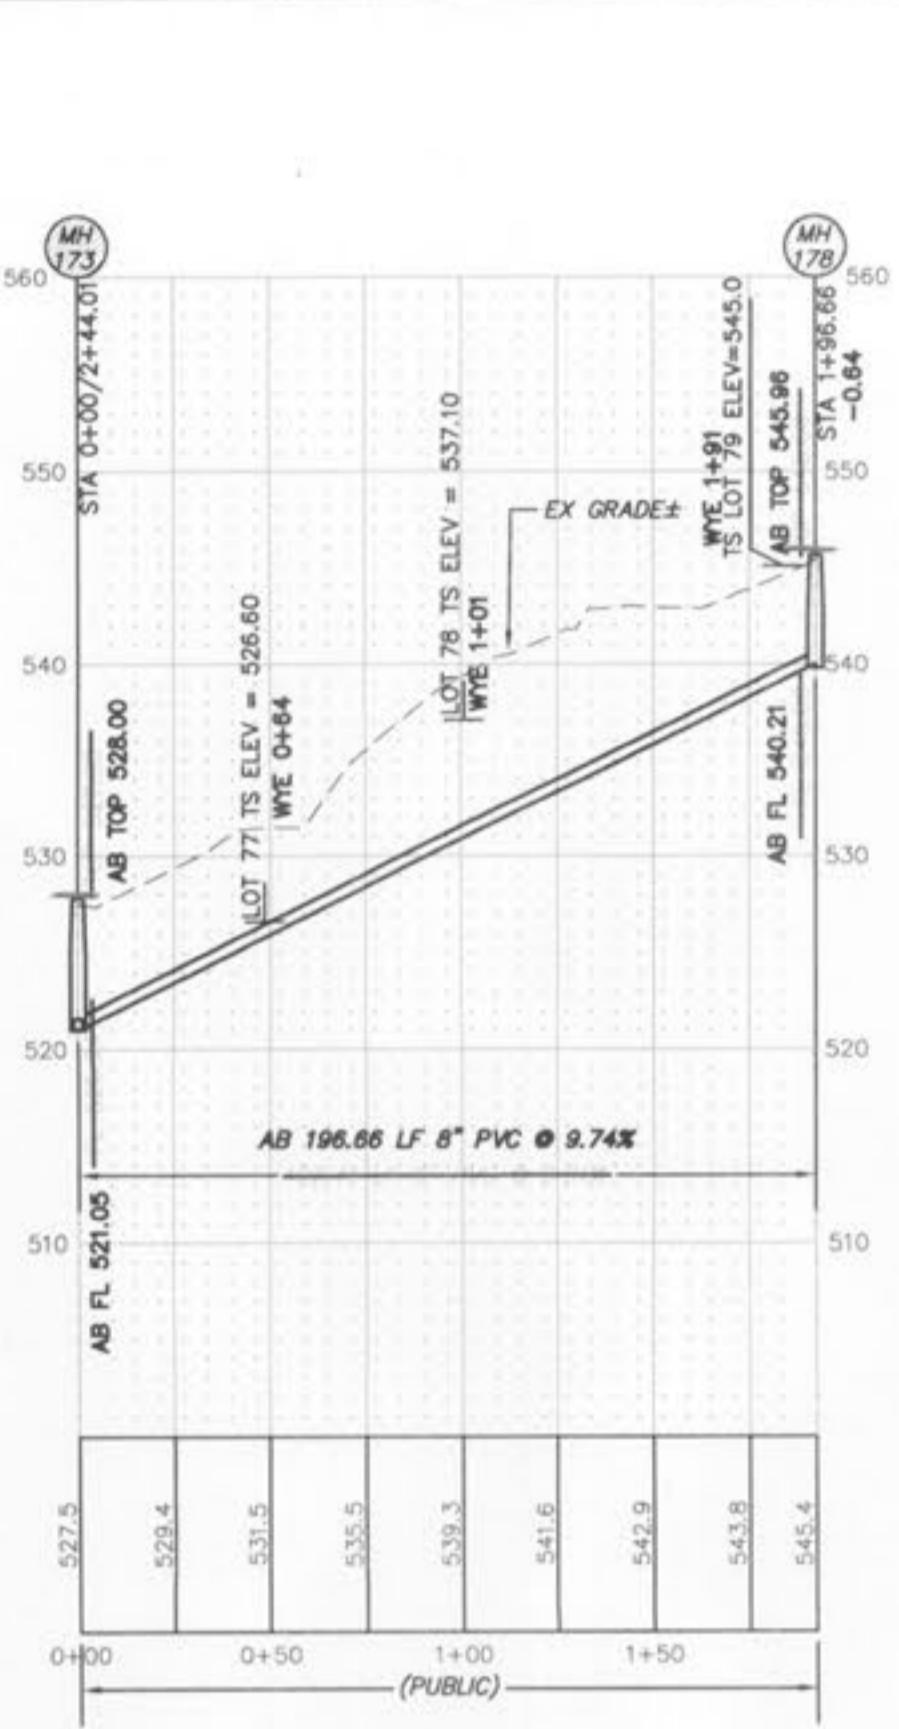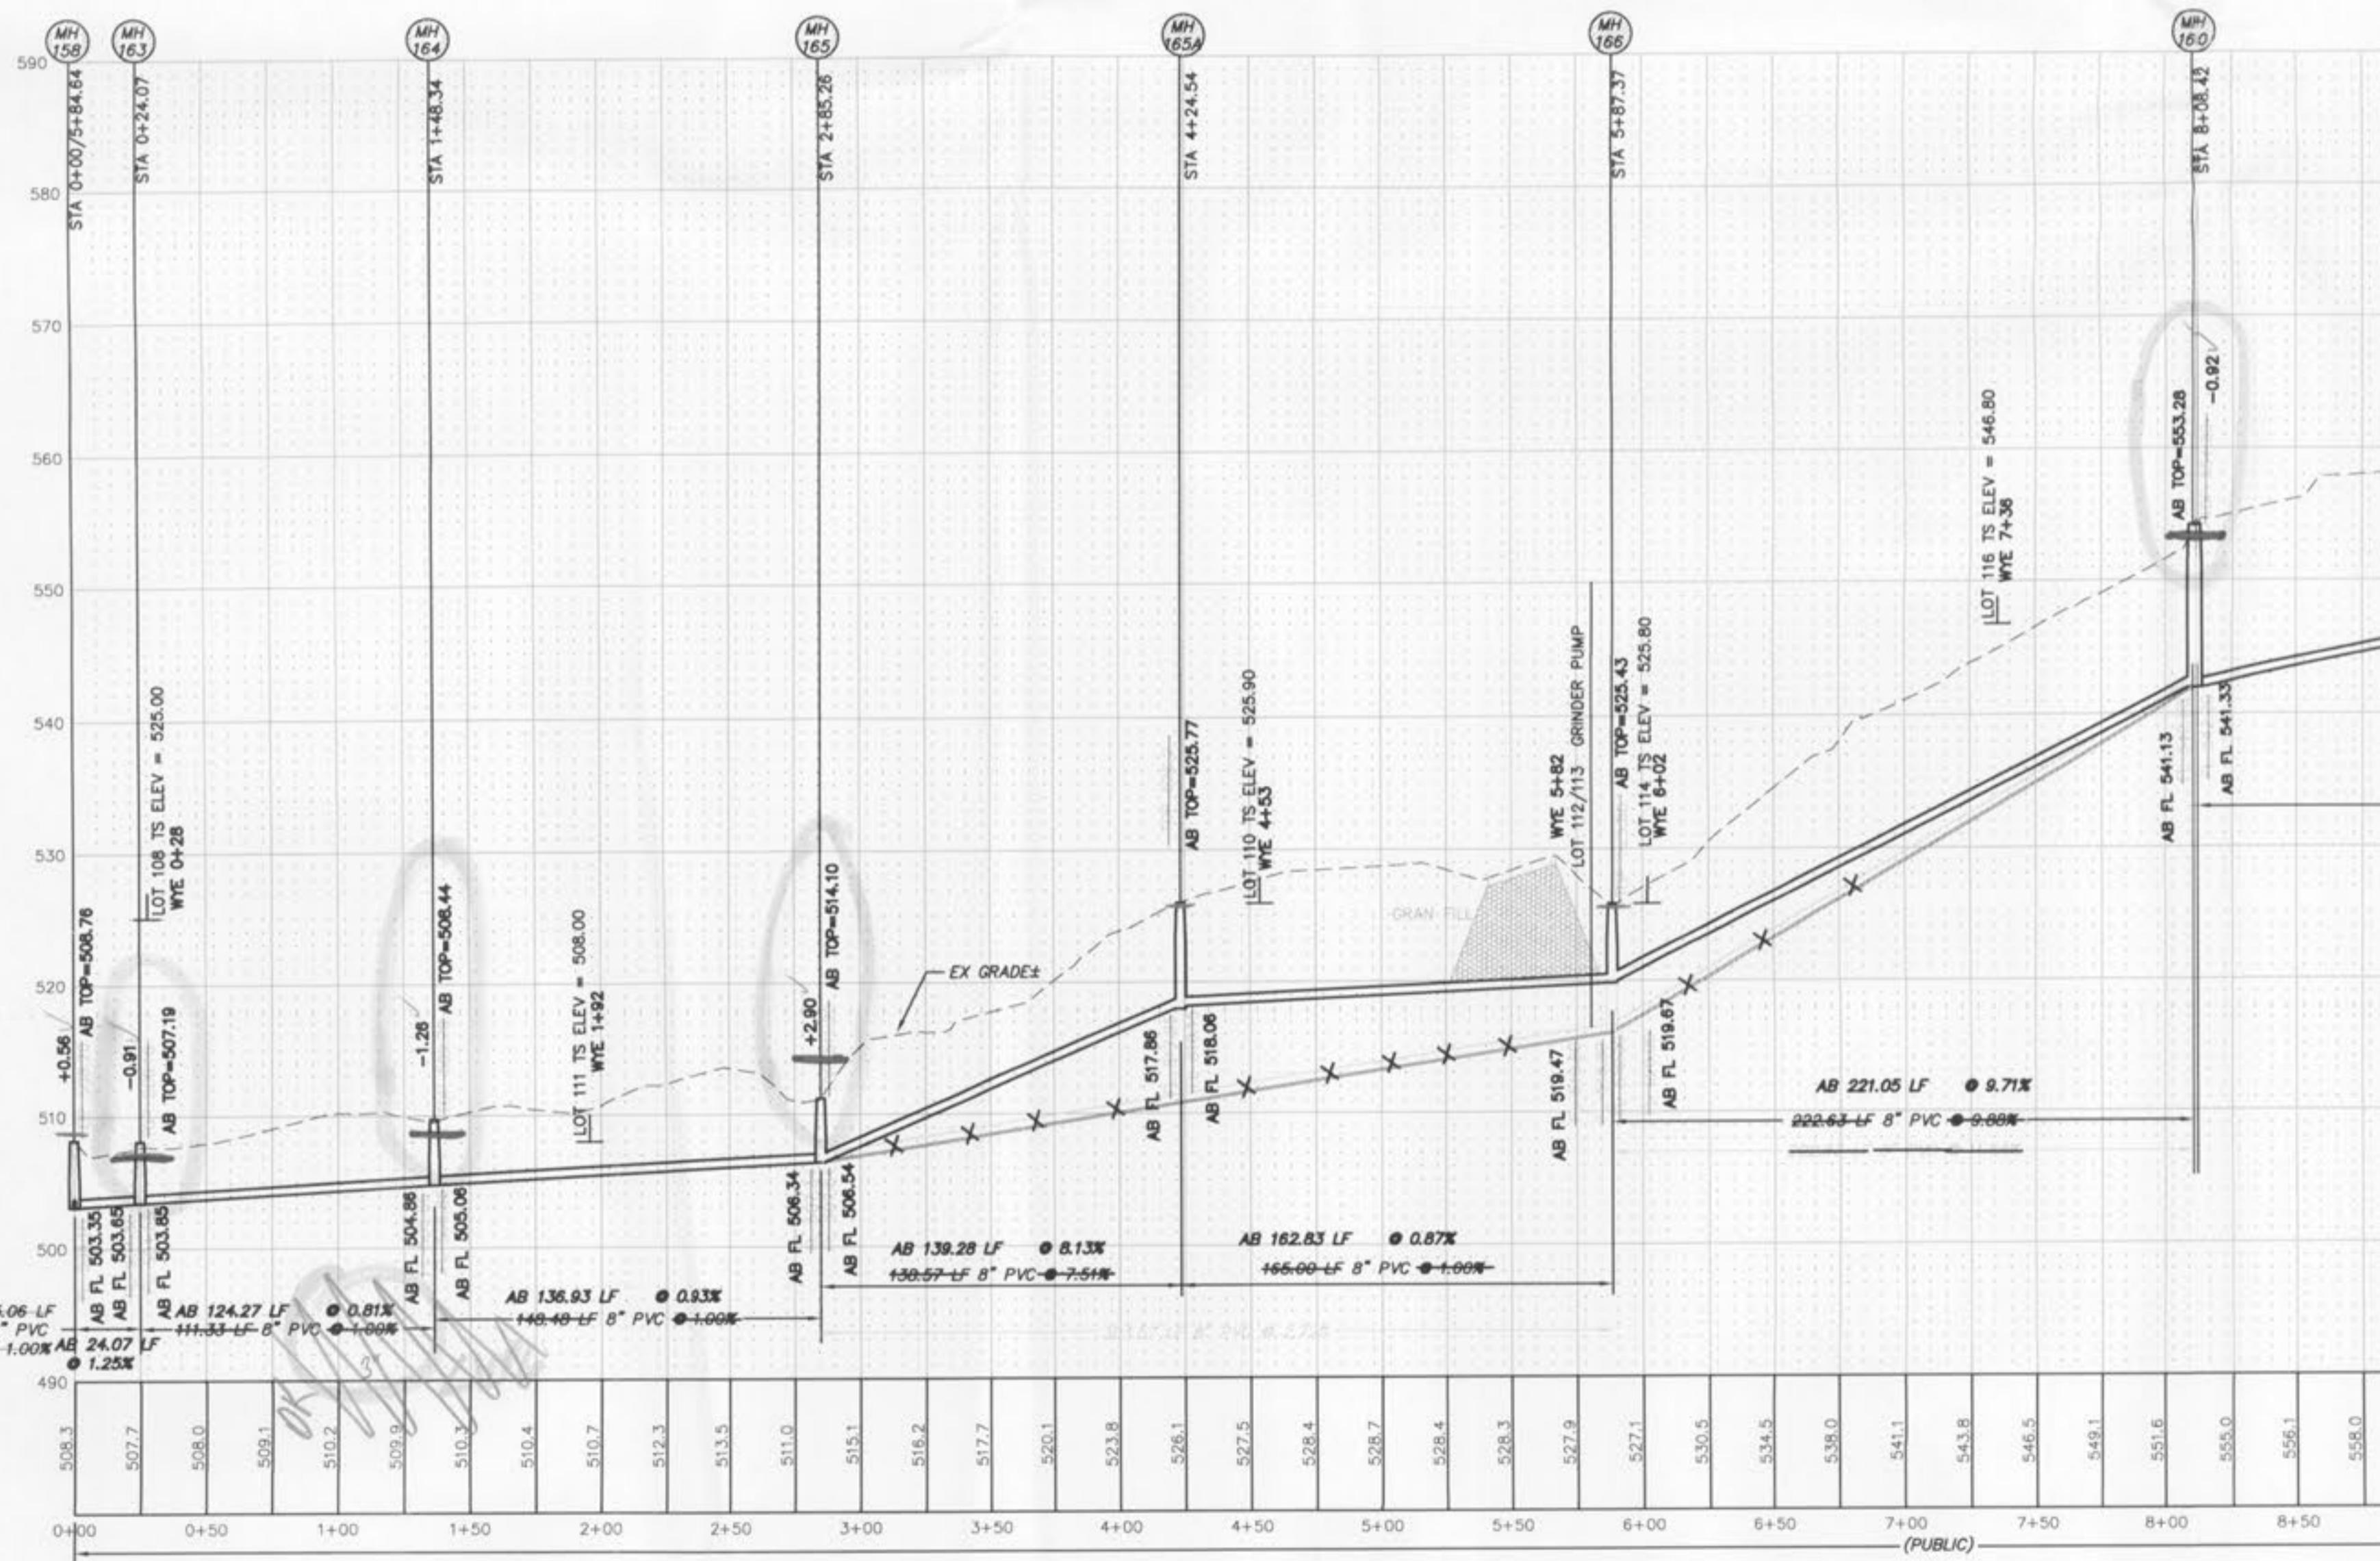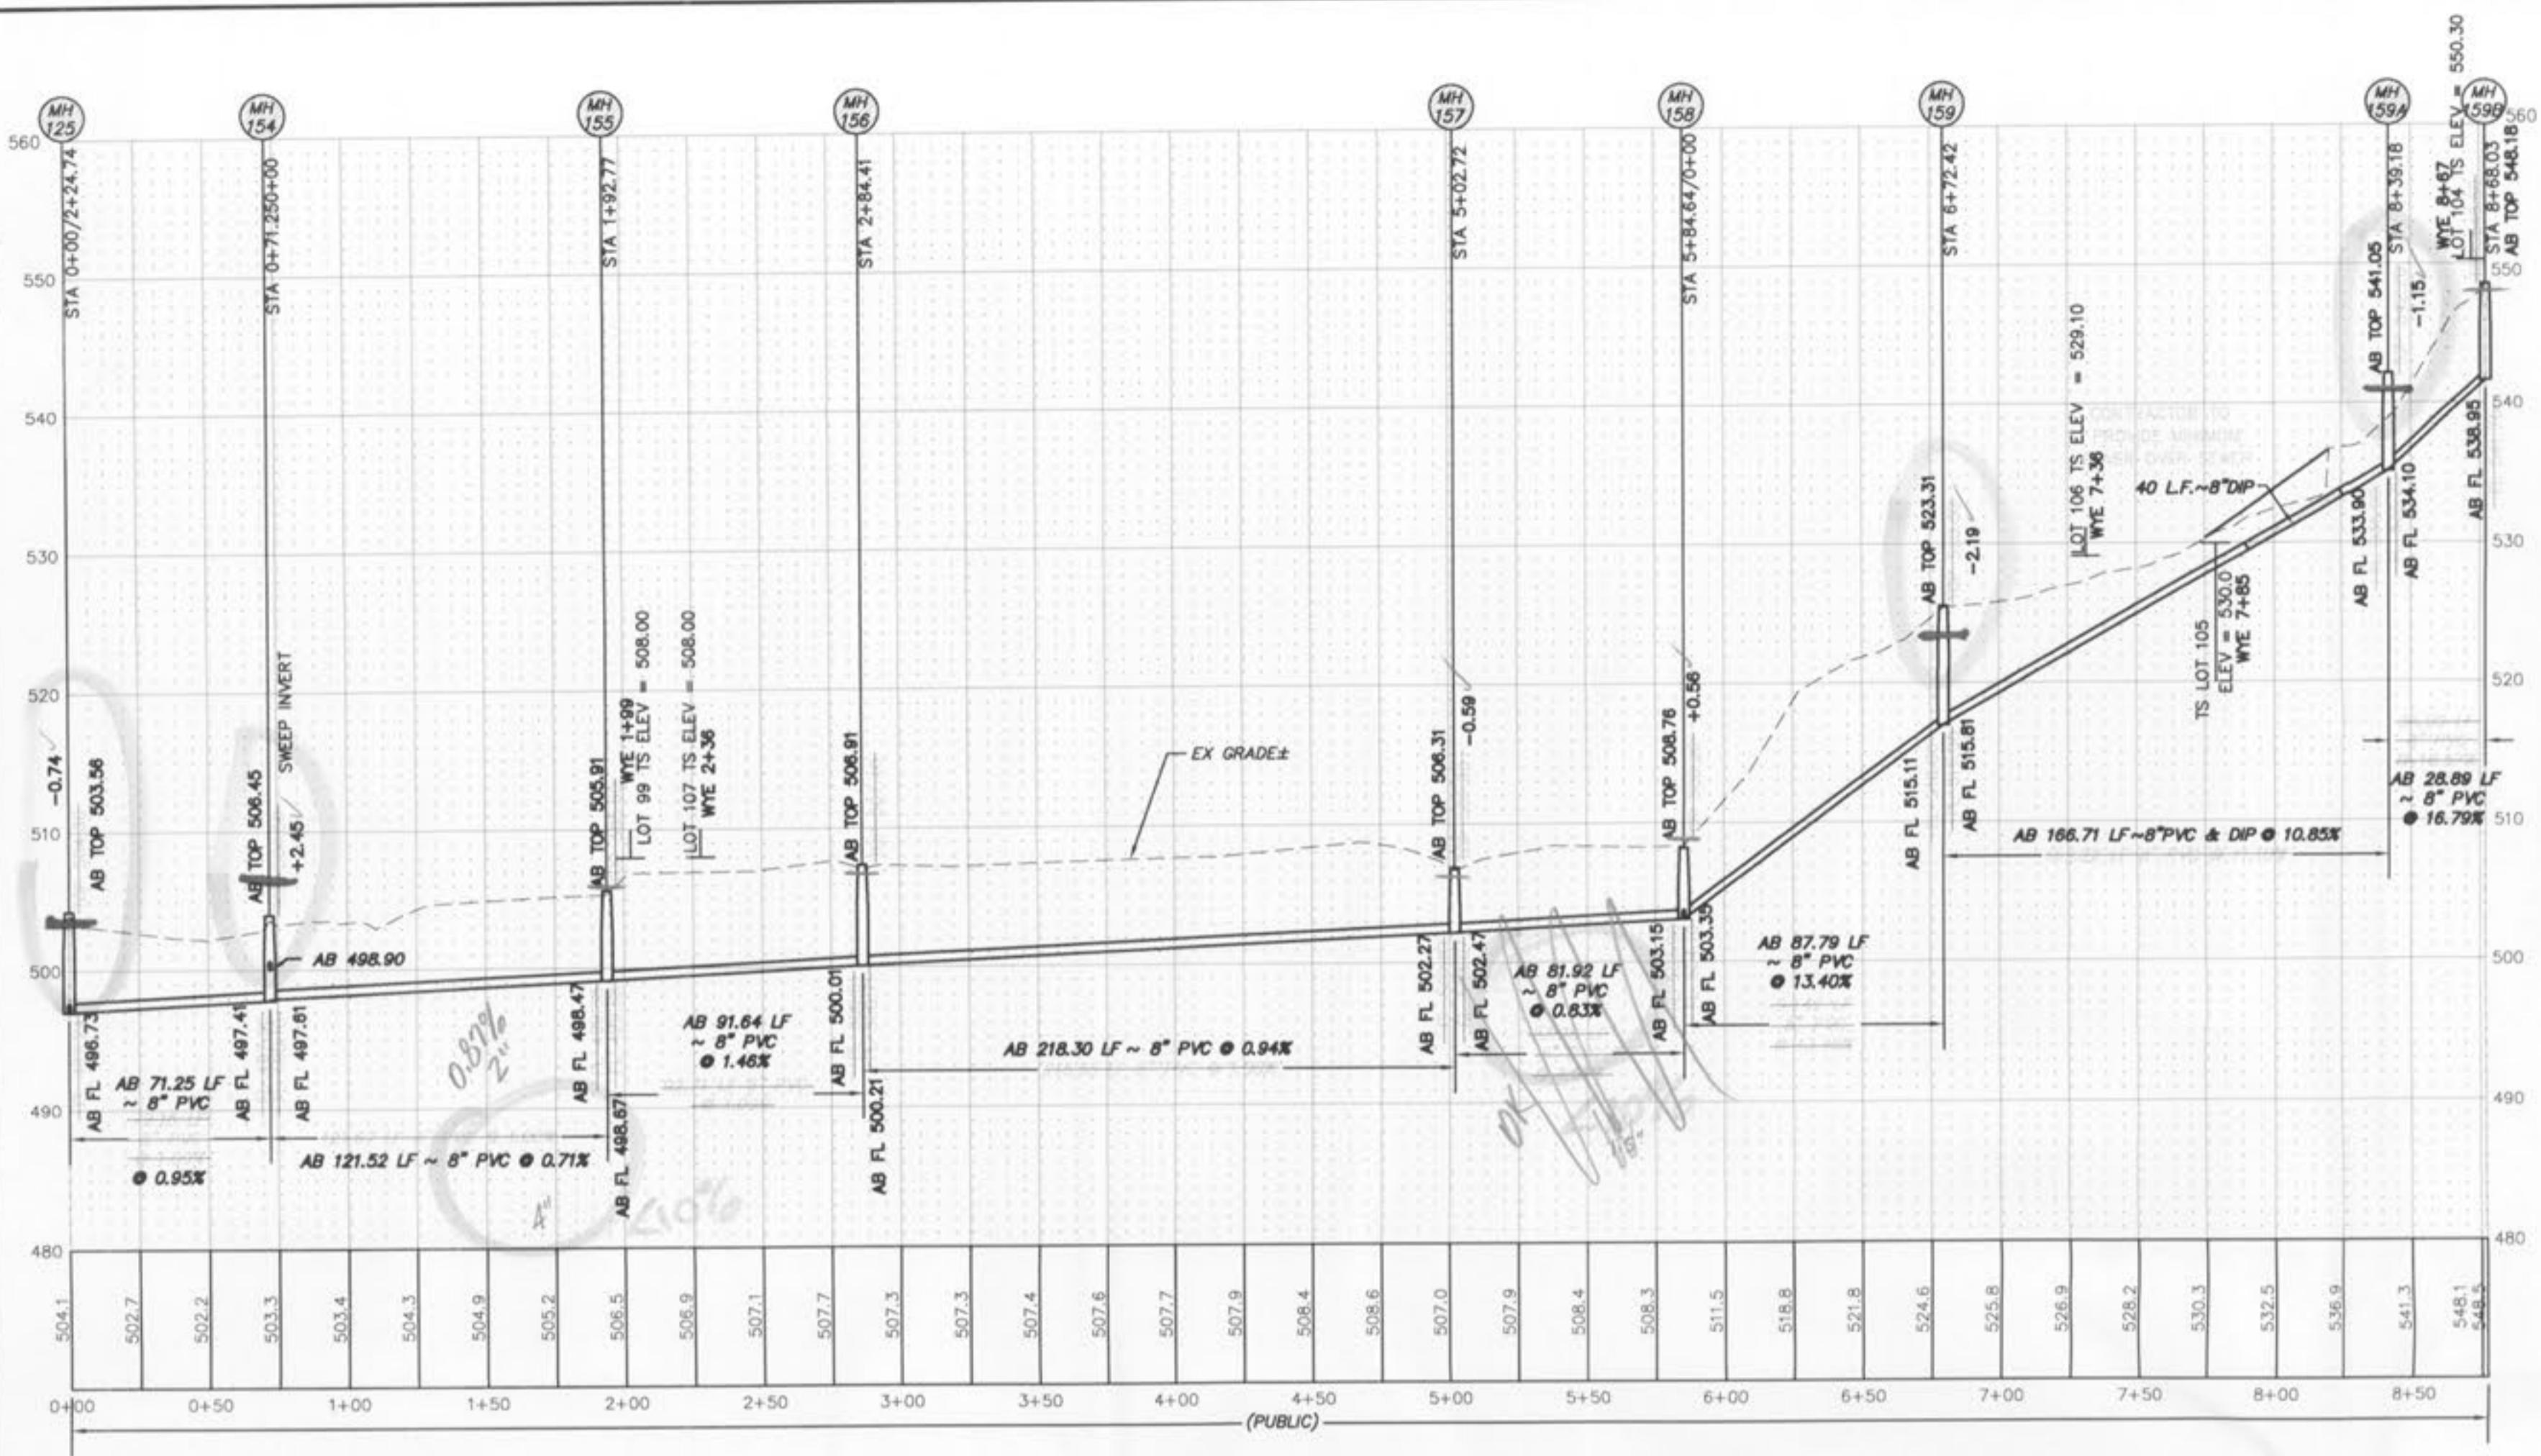

AS-BUILTS WYE LOCATIONS PROVIDED BY CONTRACTOR

SCALE: HORIZONTAL 1"=50'
VERTICAL 1"=10'

SITE NOTE:
LATERAL LOCATIONS ARE APPROXIMATE. WYE LOCATIONS TO BE DETERMINED
IN THE FIELD AT THE TIME OF CONSTRUCTION. ALL LATERALS WILL BE FIELD
LOCATED AND SHOWN ON THE AS-BUILT PLANS. CONTRACTOR IS RESPONSIBLE
FOR STATIONING WYES.



UTILITY NOTE:
UNDERGROUND FACILITY STRUCTURES AND UTILITIES HAVE BEEN
PLOTTED FROM AVAILABLE SURVEYS AND RECORDED INFORMATION AND
SHOULD NOT BE USED FOR DESIGN PURPOSES. CONTRACTOR IS RESPONSIBLE
ONLY FOR VERIFICATION OF LOCATION OF ALL UNDERGROUND STRUCTURES AND
FACILITIES EITHER SHOWN OR NOT SHOWN ON THESE PLANS. SHALL BE
THE RESPONSIBILITY OF THE CONTRACTOR.


PICKETT RAY & SILVER

CIVIL ENGINEERS
PLANNERS
LAND SURVEYORS

333 Mid Rivers Mall Drive
St. Peters, MO 63376
Phone (314) 397-1121
Fax (314) 397-1104


LAKE CHARLES HILLS N.I.D. IMPROVEMENT PLANS SANITARY SEWER PROFILES

Mr. Charles Feldman
Sgt. Charles N. Morris
20 N. Second Street
St. Charles, MO 63301
Tele: 636-949-2564
Fax: 636-949-7336

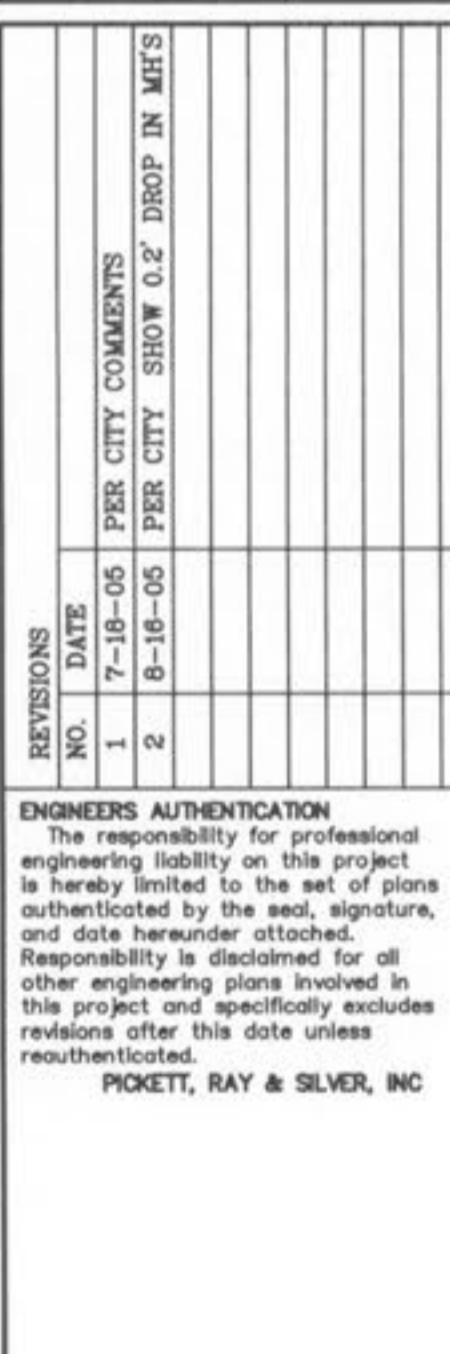

DRAWN	DATE	
MK	01/04/04	
REVISIONS	NO.	DATE
CHECKED	PER CITY COMMENTS	PER CITY SHOW 0.2' DROP IN MH'S
DST	01/04/04	
PROJECT #	83054-STCC.00R	
TASK #	1	FIELD BOOK

LAKE CHARLES HILLS N.I.D.
IMPROVEMENT PLANS
SANITARY SEWER PROFILES
SHEET 12 OF 21
© Copyright 2001 by Pickett, Ray & Silver Inc.

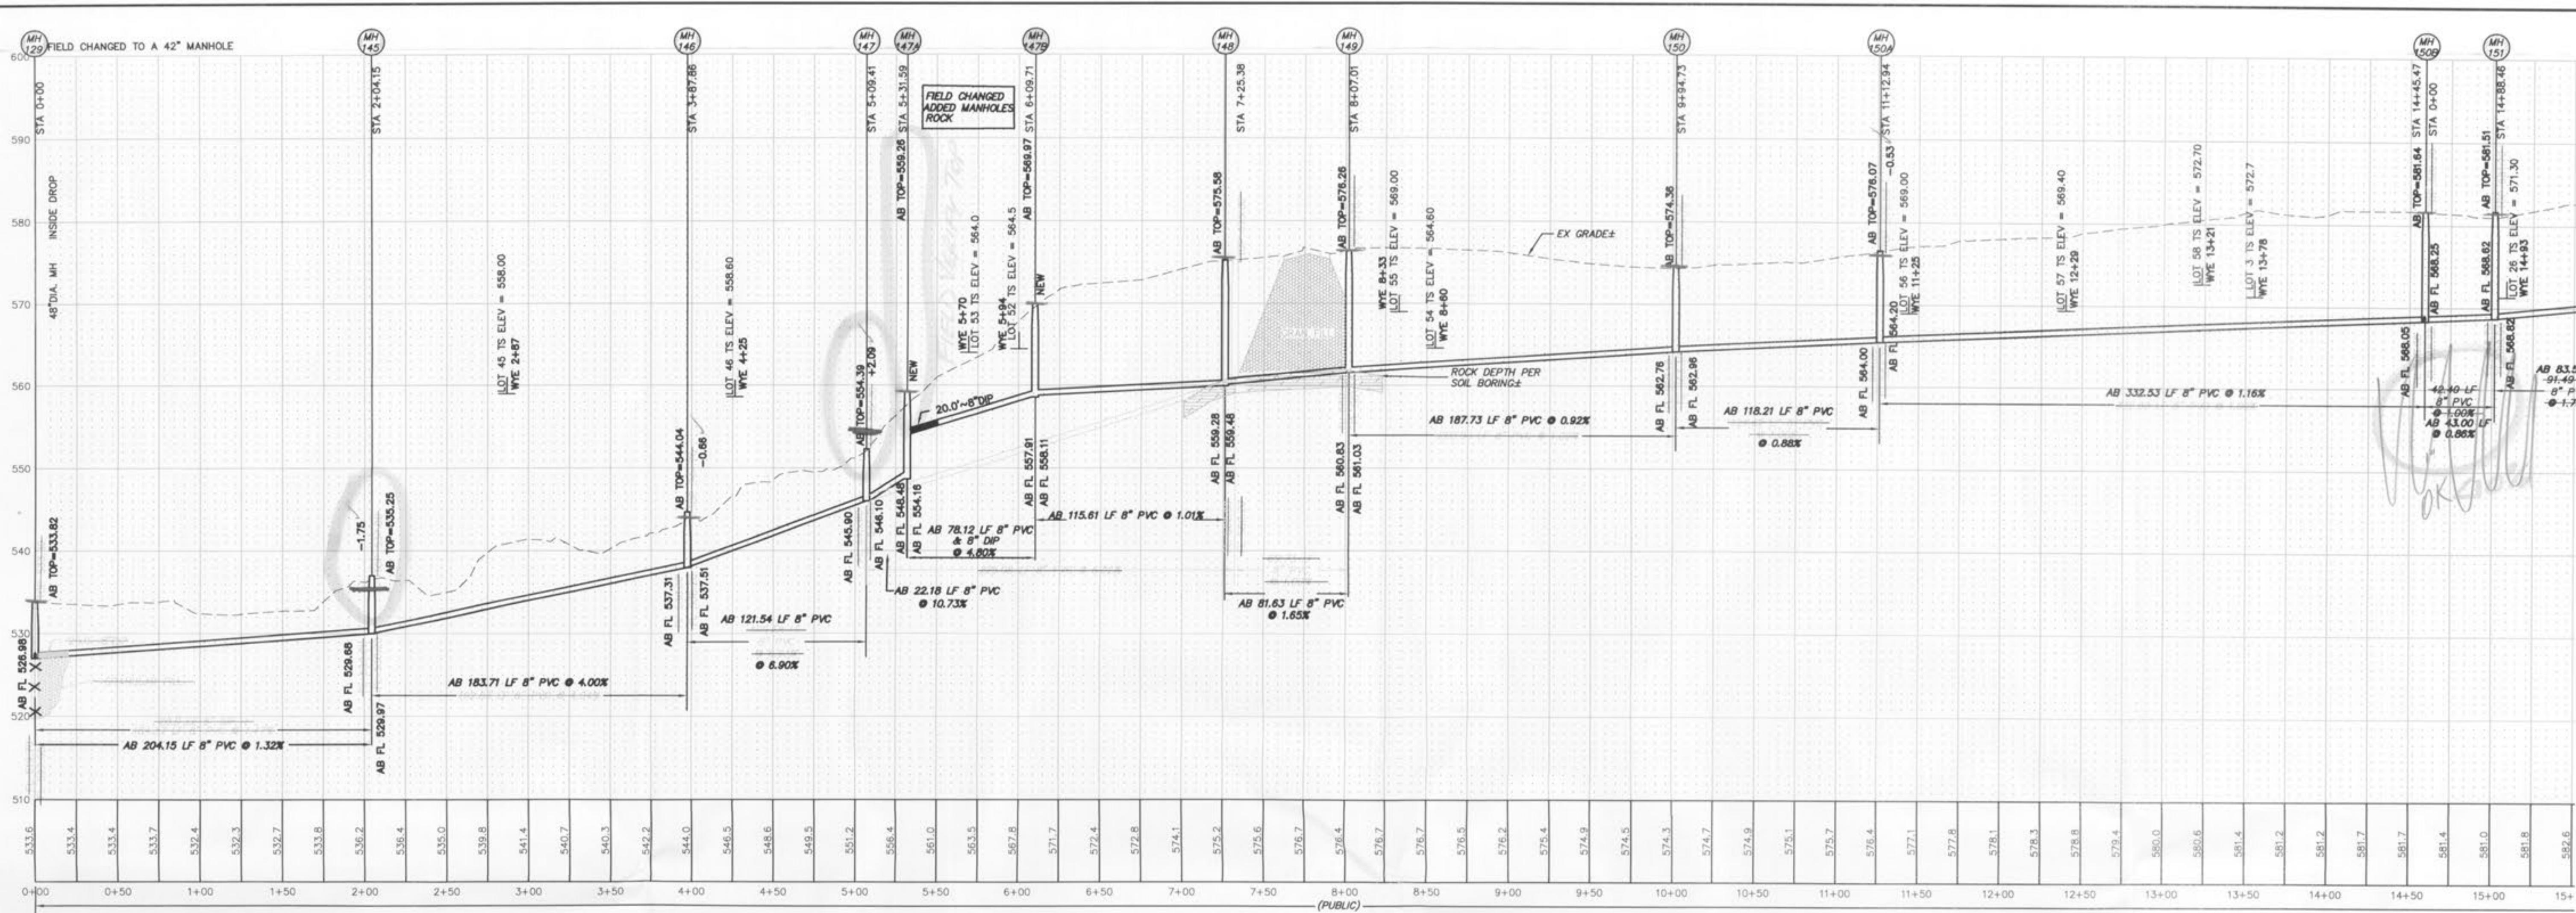

UTILITY NOTE

UNDERGROUND FACILITY STRUCTURES AND UTILITIES HAVE BEEN PLOTTED FROM AVAILABLE SURVEYS AND RECORDED INFORMATION AND, THEREFORE, THEIR LOCATIONS MUST BE CONSIDERED APPROXIMATE ONLY. VERIFICATION OF LOCATION OF ALL UNDERGROUND STRUCTURES AND FACILITIES EITHER SHOWN OR NOT SHOWN ON THESE PLANS, SHALL BE THE RESPONSIBILITY OF THE CONTRACTOR.

WYE LOCATIONS PROVIDED BY CONTRACTOR

AS-BUILTS





Call BEFORE you DIG
TOLL FREE
1-800-344-7483

*SCALE: HORIZONTAL 1"=50'
VERTICAL 1"=10'*

SITE NOTE:

LATERAL LOCATIONS ARE APPROXIMATE. WYE LOCATIONS TO BE DETERMINED IN THE FIELD AT THE TIME OF CONSTRUCTION. ALL LATERALS WILL BE FIELD LOCATED AND SHOWN ON THE AS-BUILT PLANS. CONTRACTOR IS RESPONSIBLE FOR STATIONING WYES.

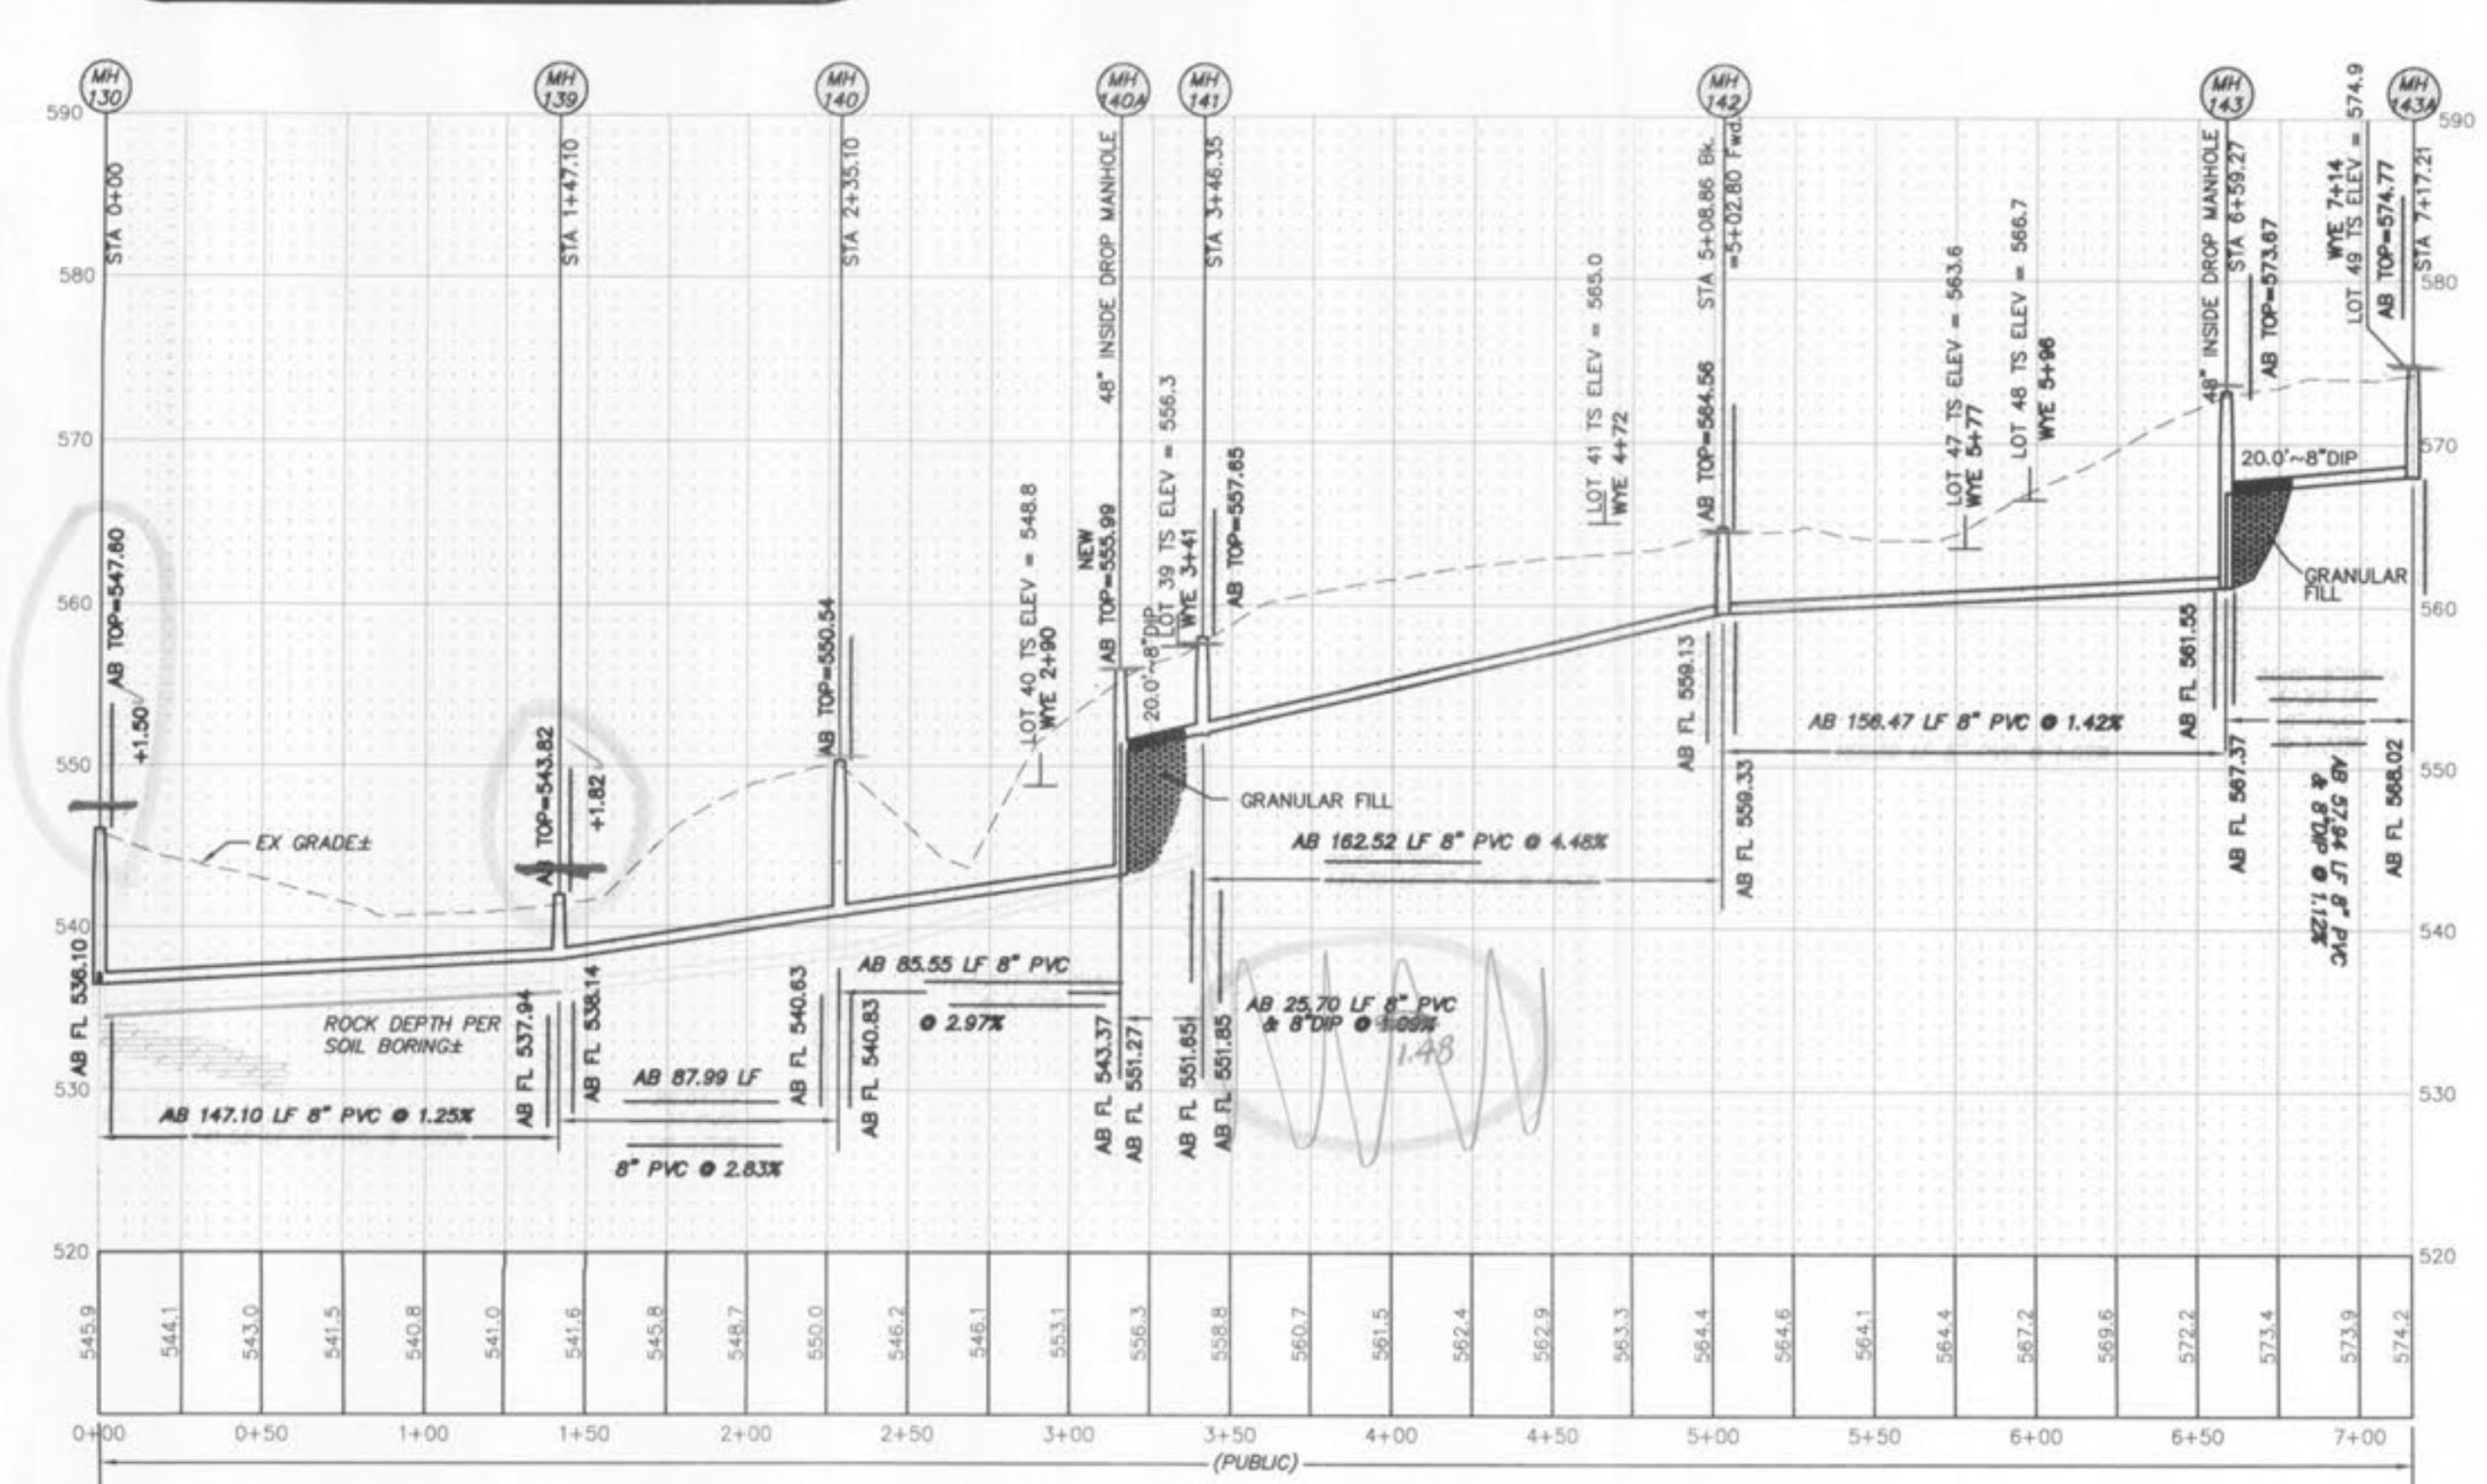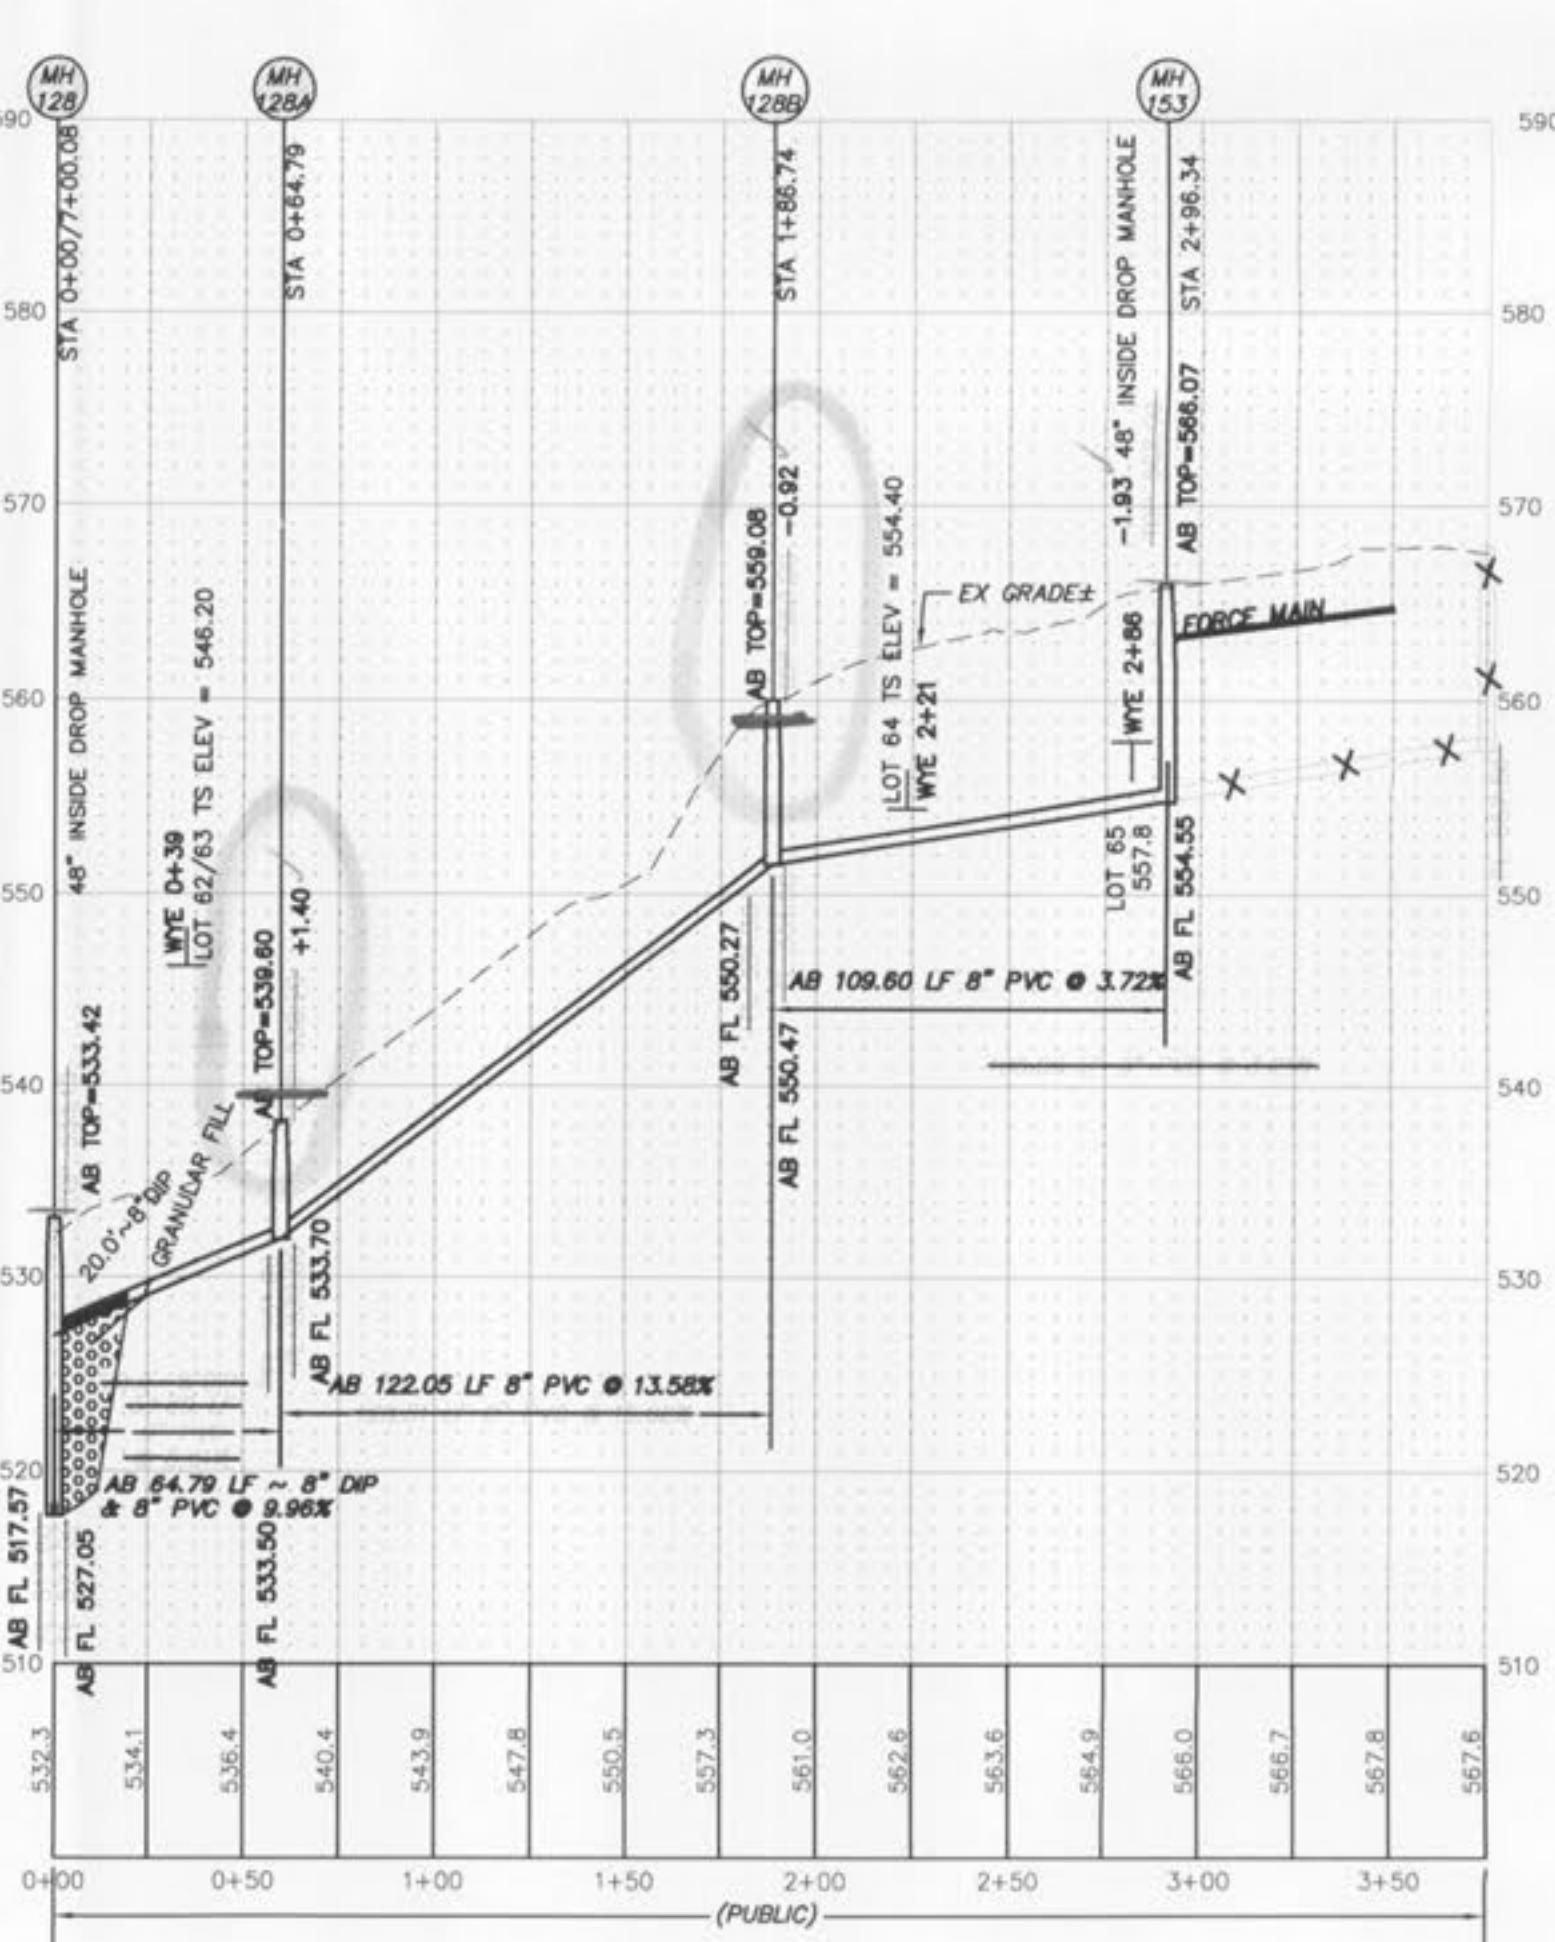

LAKE CHARLES HILLS N.I.D.
IMPROVEMENT PLANS
SANITARY SEWER PROFILES

Prepared For:
ST. CHAR

CIVIL ENGINEERS
333 Mid Rivers Mall Drive
St. Peters, MO 63376


St. Peters, MO 63376
Phone (636) 397-1211
Fax (636) 397-1104

PLANNERS
AND SURVEYORS


St. Charles County
St. Charles County Gov't
201 N. Second St.
Suite 420
St. Charles, MO 63301
Tele: 636-949-7564
Fax: 636-949-7336

ST. C

AS-BUILTS

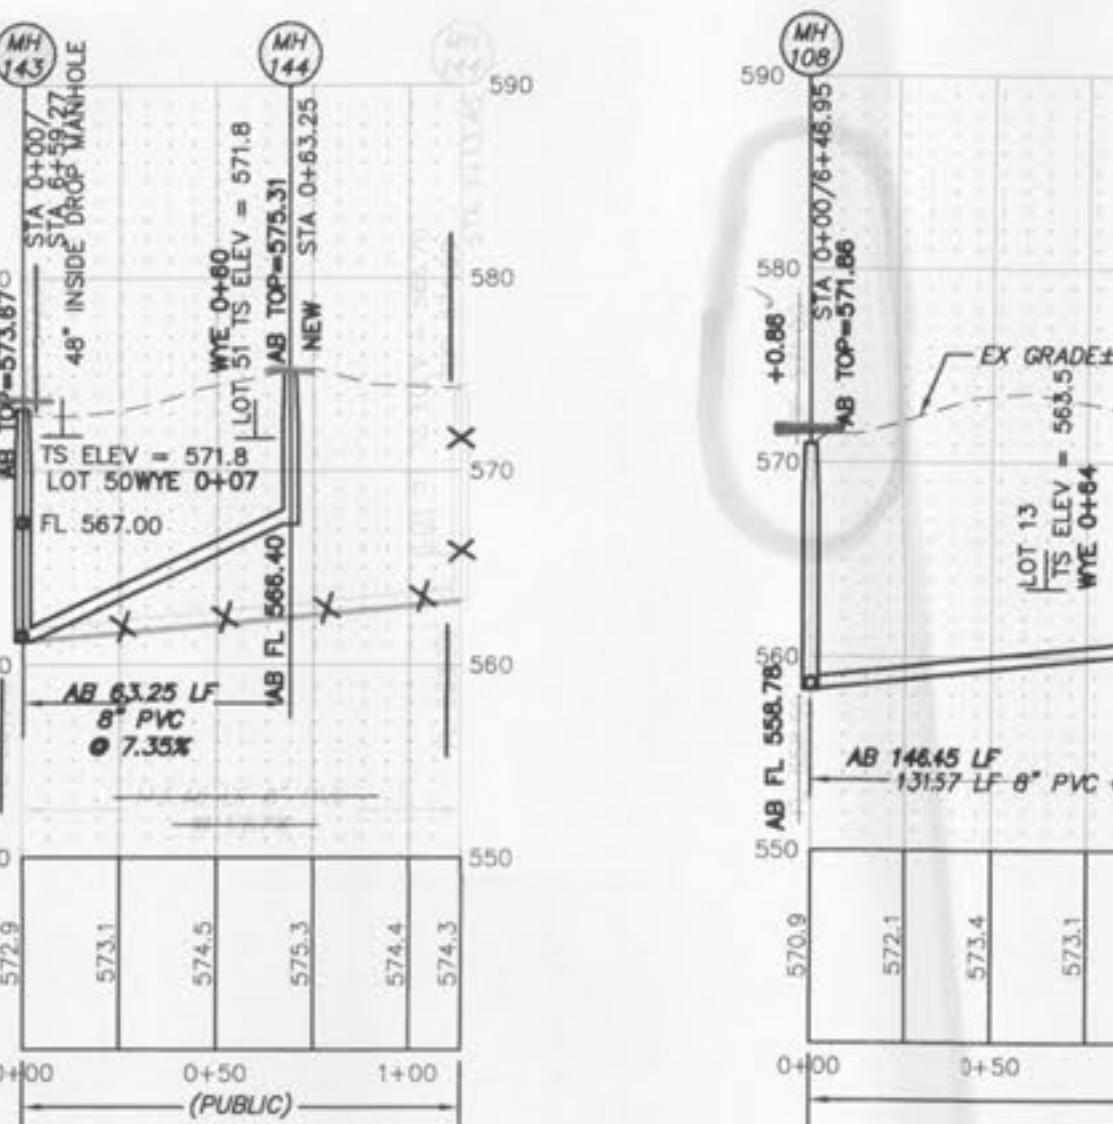




WYE LOCATIONS PROVIDED BY CONTRACTOR

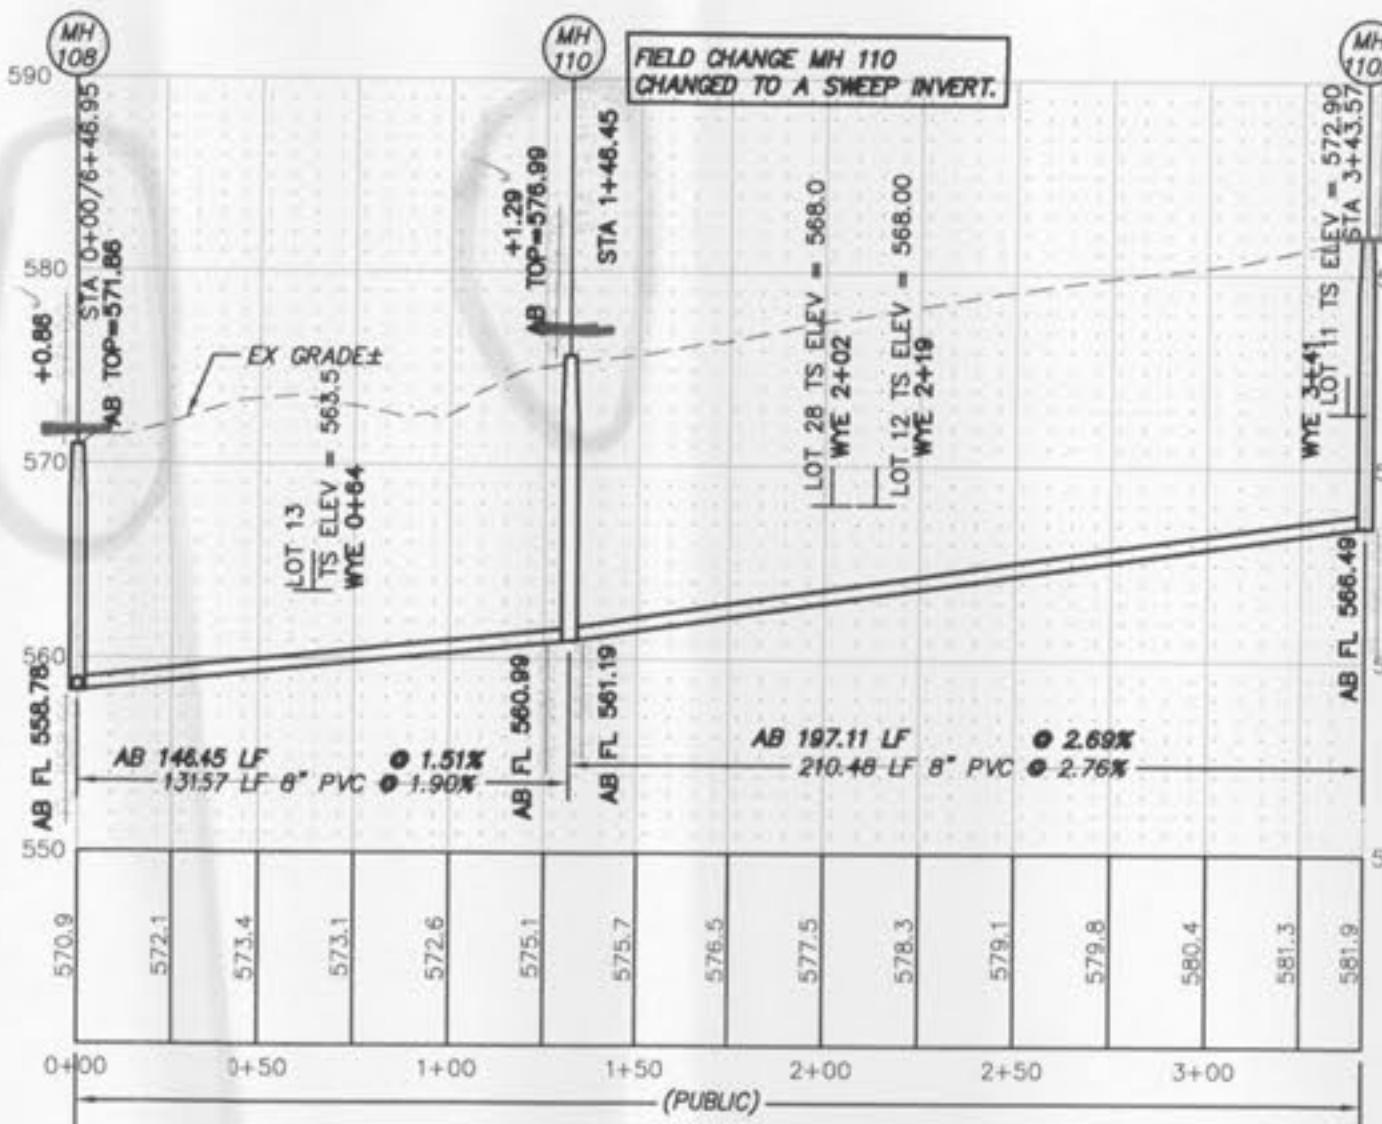

SCALE: HORIZONTAL 1"-50'
VERTICAL 1"-10"

SITE NOTE:
LOT LOCATIONS ARE APPROXIMATE. WYE LOCATIONS TO BE DETERMINED
IN THE FIELD AT THE TIME OF CONSTRUCTION. ALL LATERALS WILL BE FIELD
LOCATED AND SHOWN ON THE AS-BUILT PLANS. CONTRACTOR IS RESPONSIBLE
FOR STATIONING WYES.

UTILITY NOTE:
UNDERGROUND FACILITY STRUCTURES AND UTILITIES HAVE BEEN
PLOTTED FROM AVAILABLE SURVEYS AND RECORDED INFORMATION AND
THEREFORE THEIR LOCATIONS MUST BE CONSIDERED APPROXIMATE ONLY.
EXCAVATION NEAR ANY OF THESE UNDERGROUND STRUCTURES AND
FAUCILITIES EITHER SHOWN OR NOT SHOWN ON THESE PLANS, SHALL BE
THE RESPONSIBILITY OF THE CONTRACTOR.

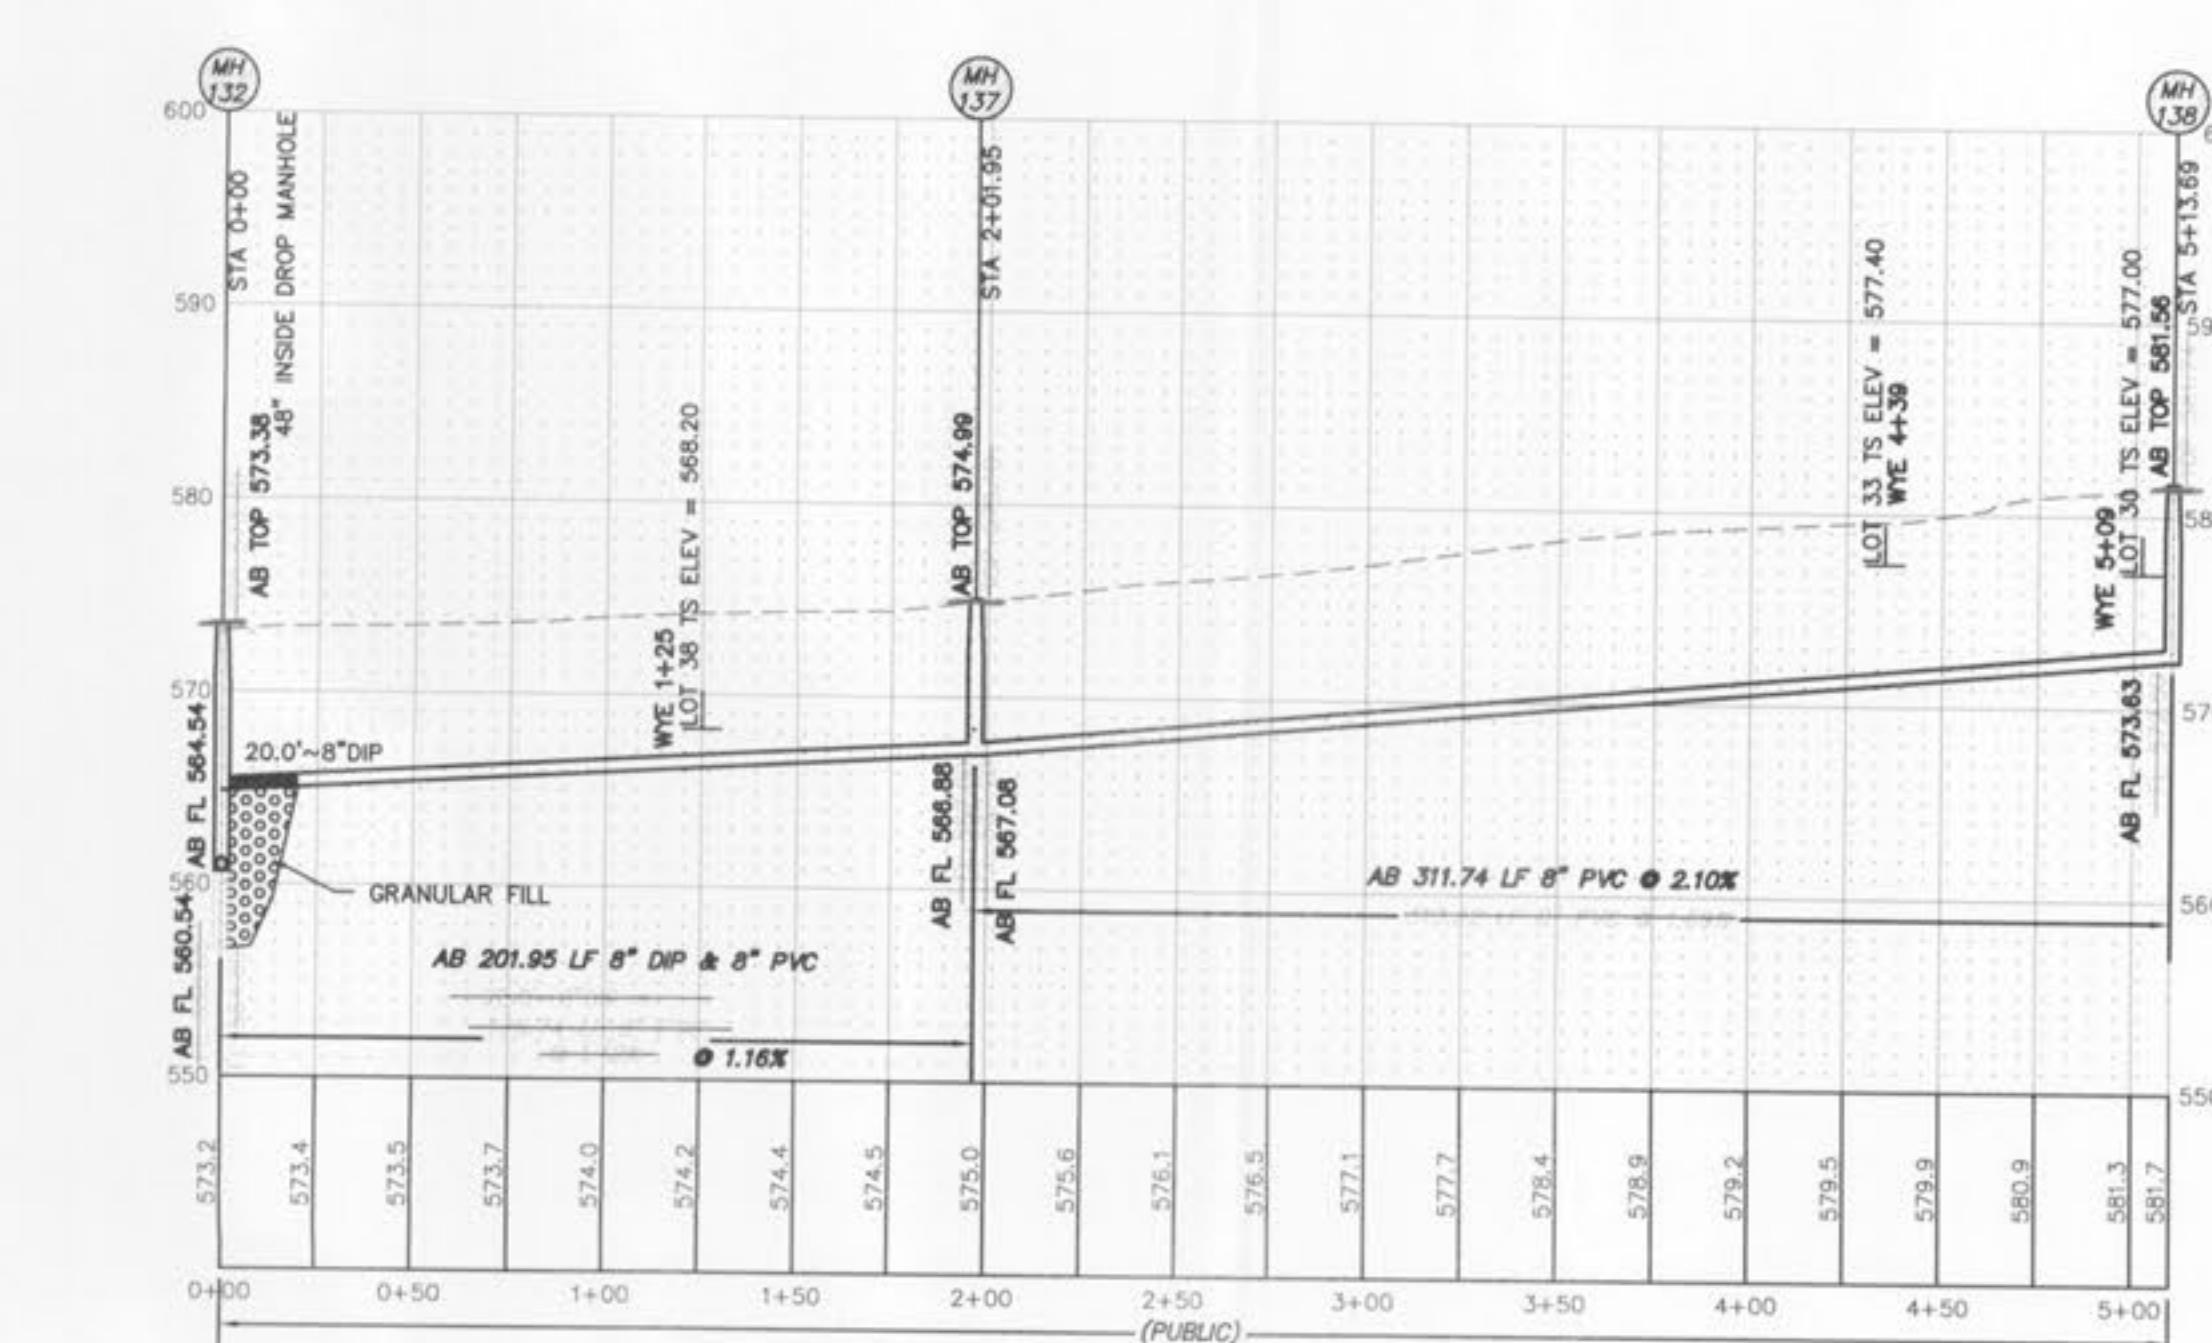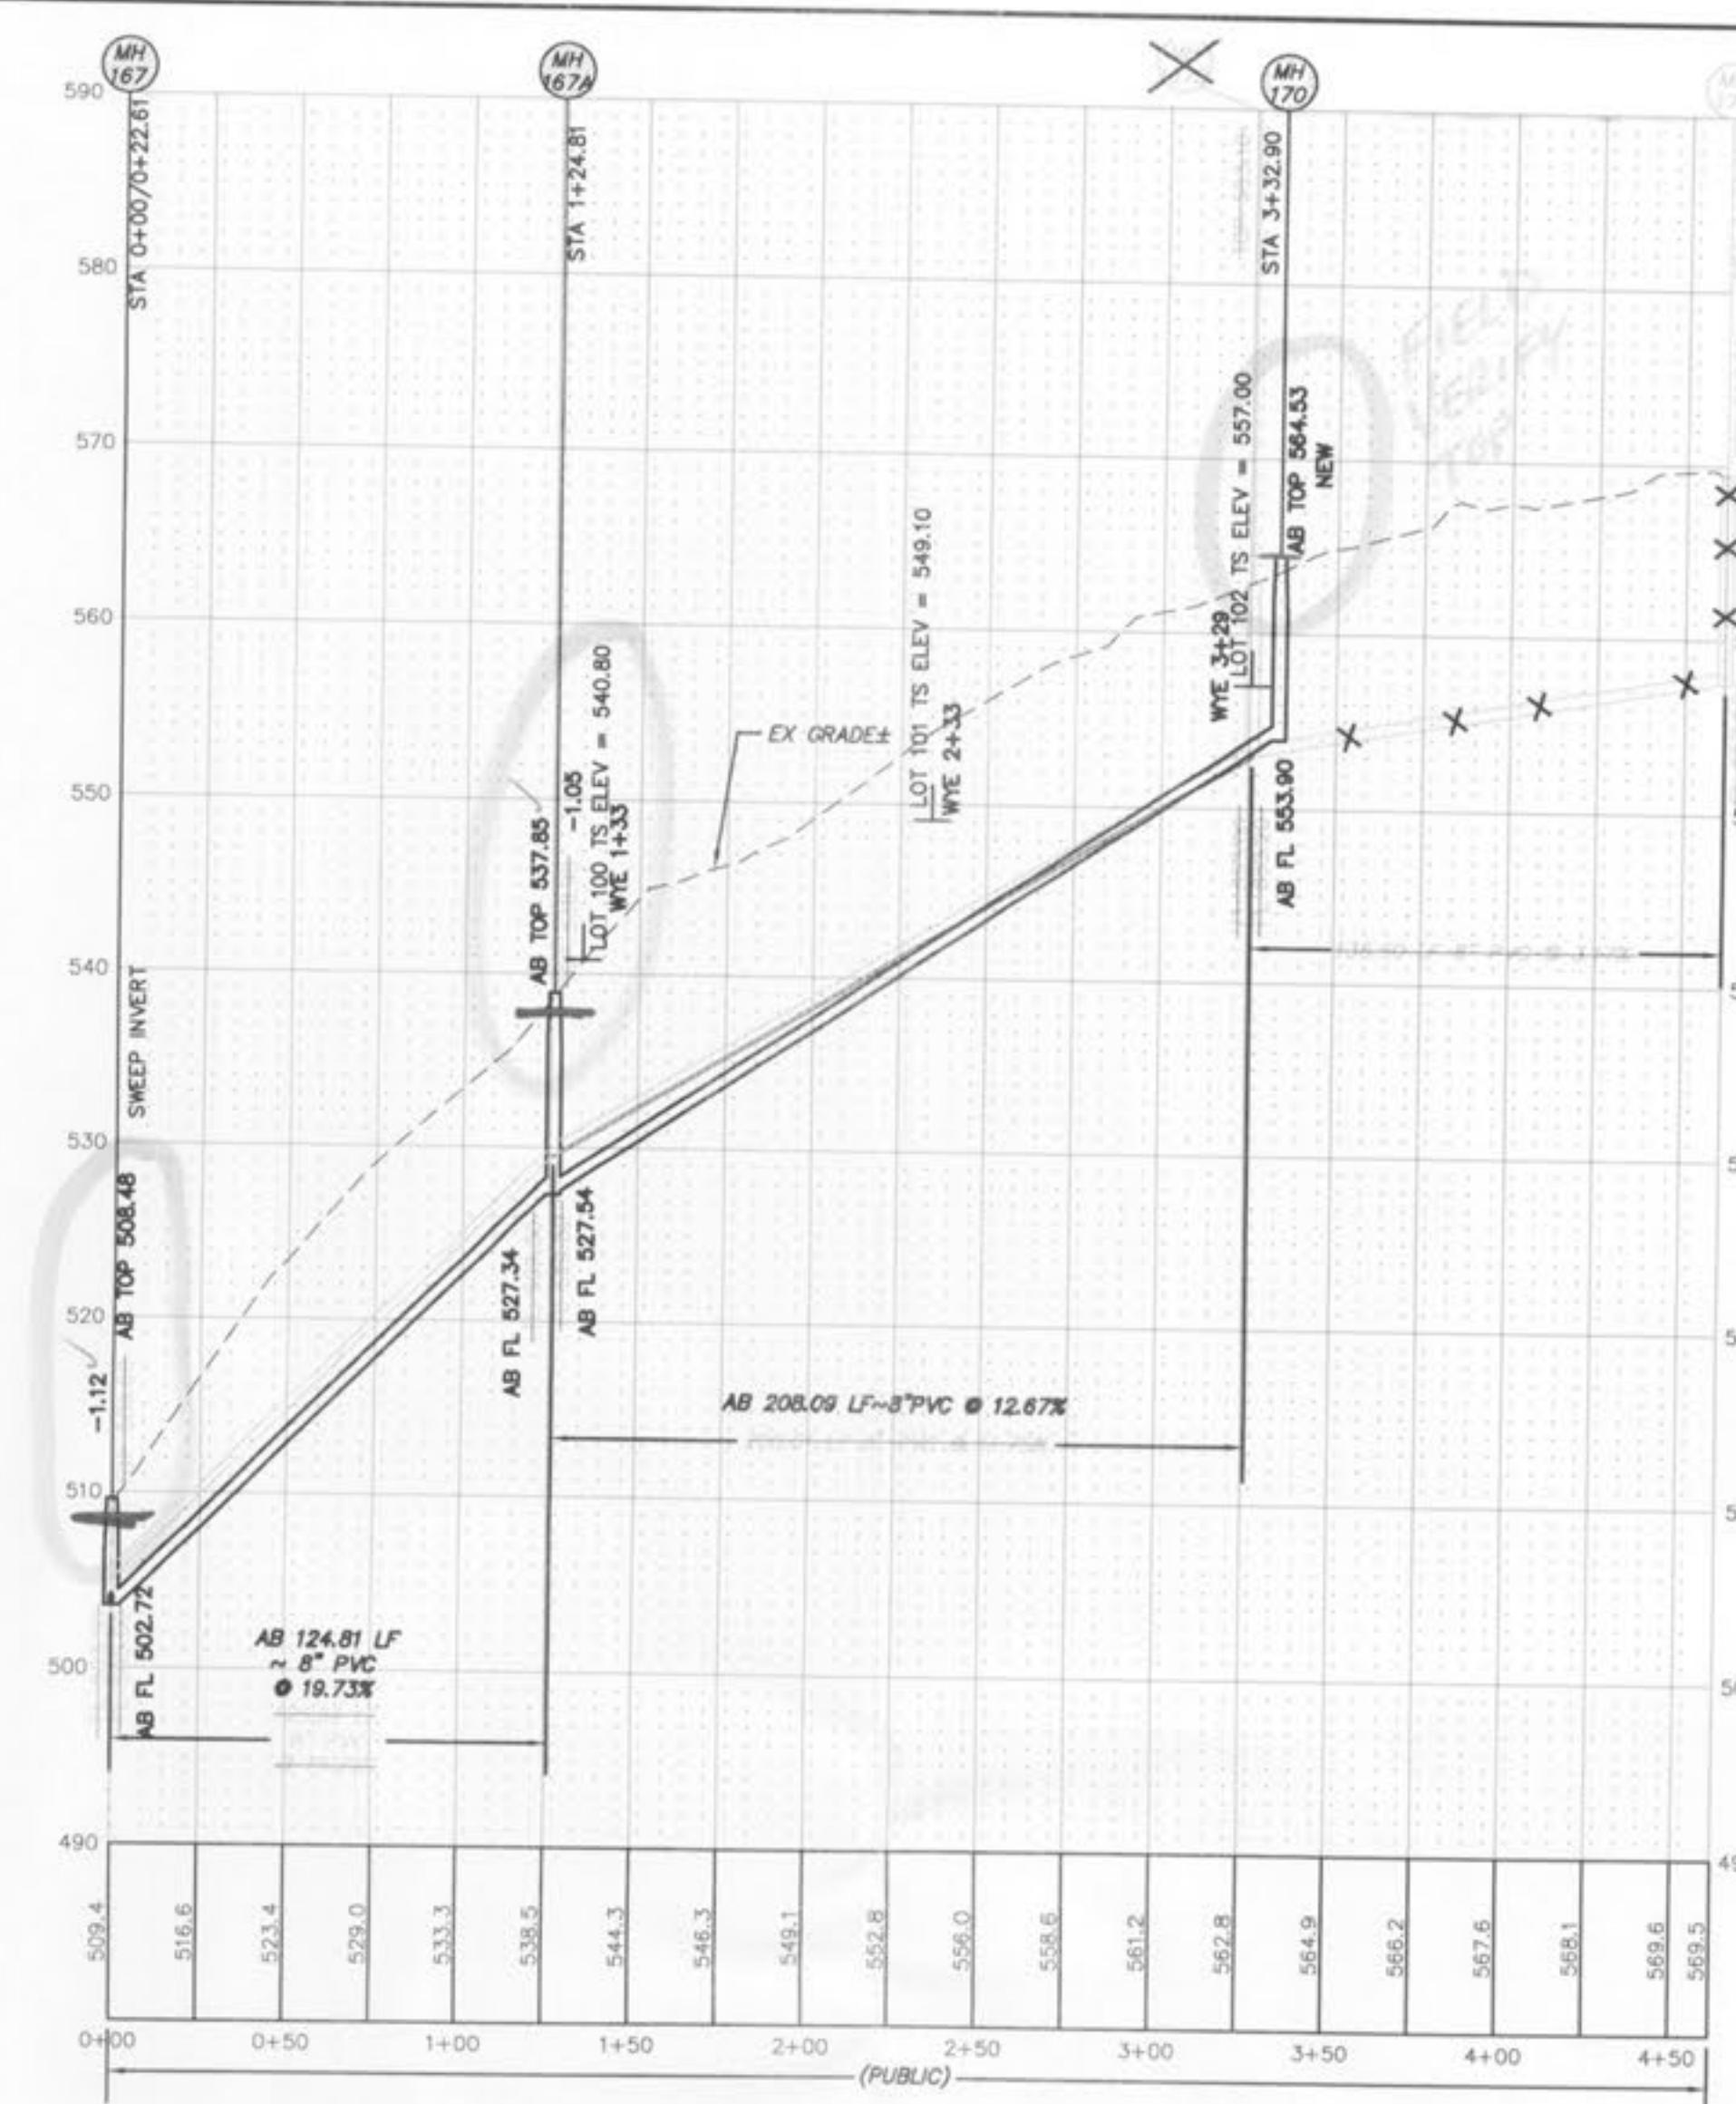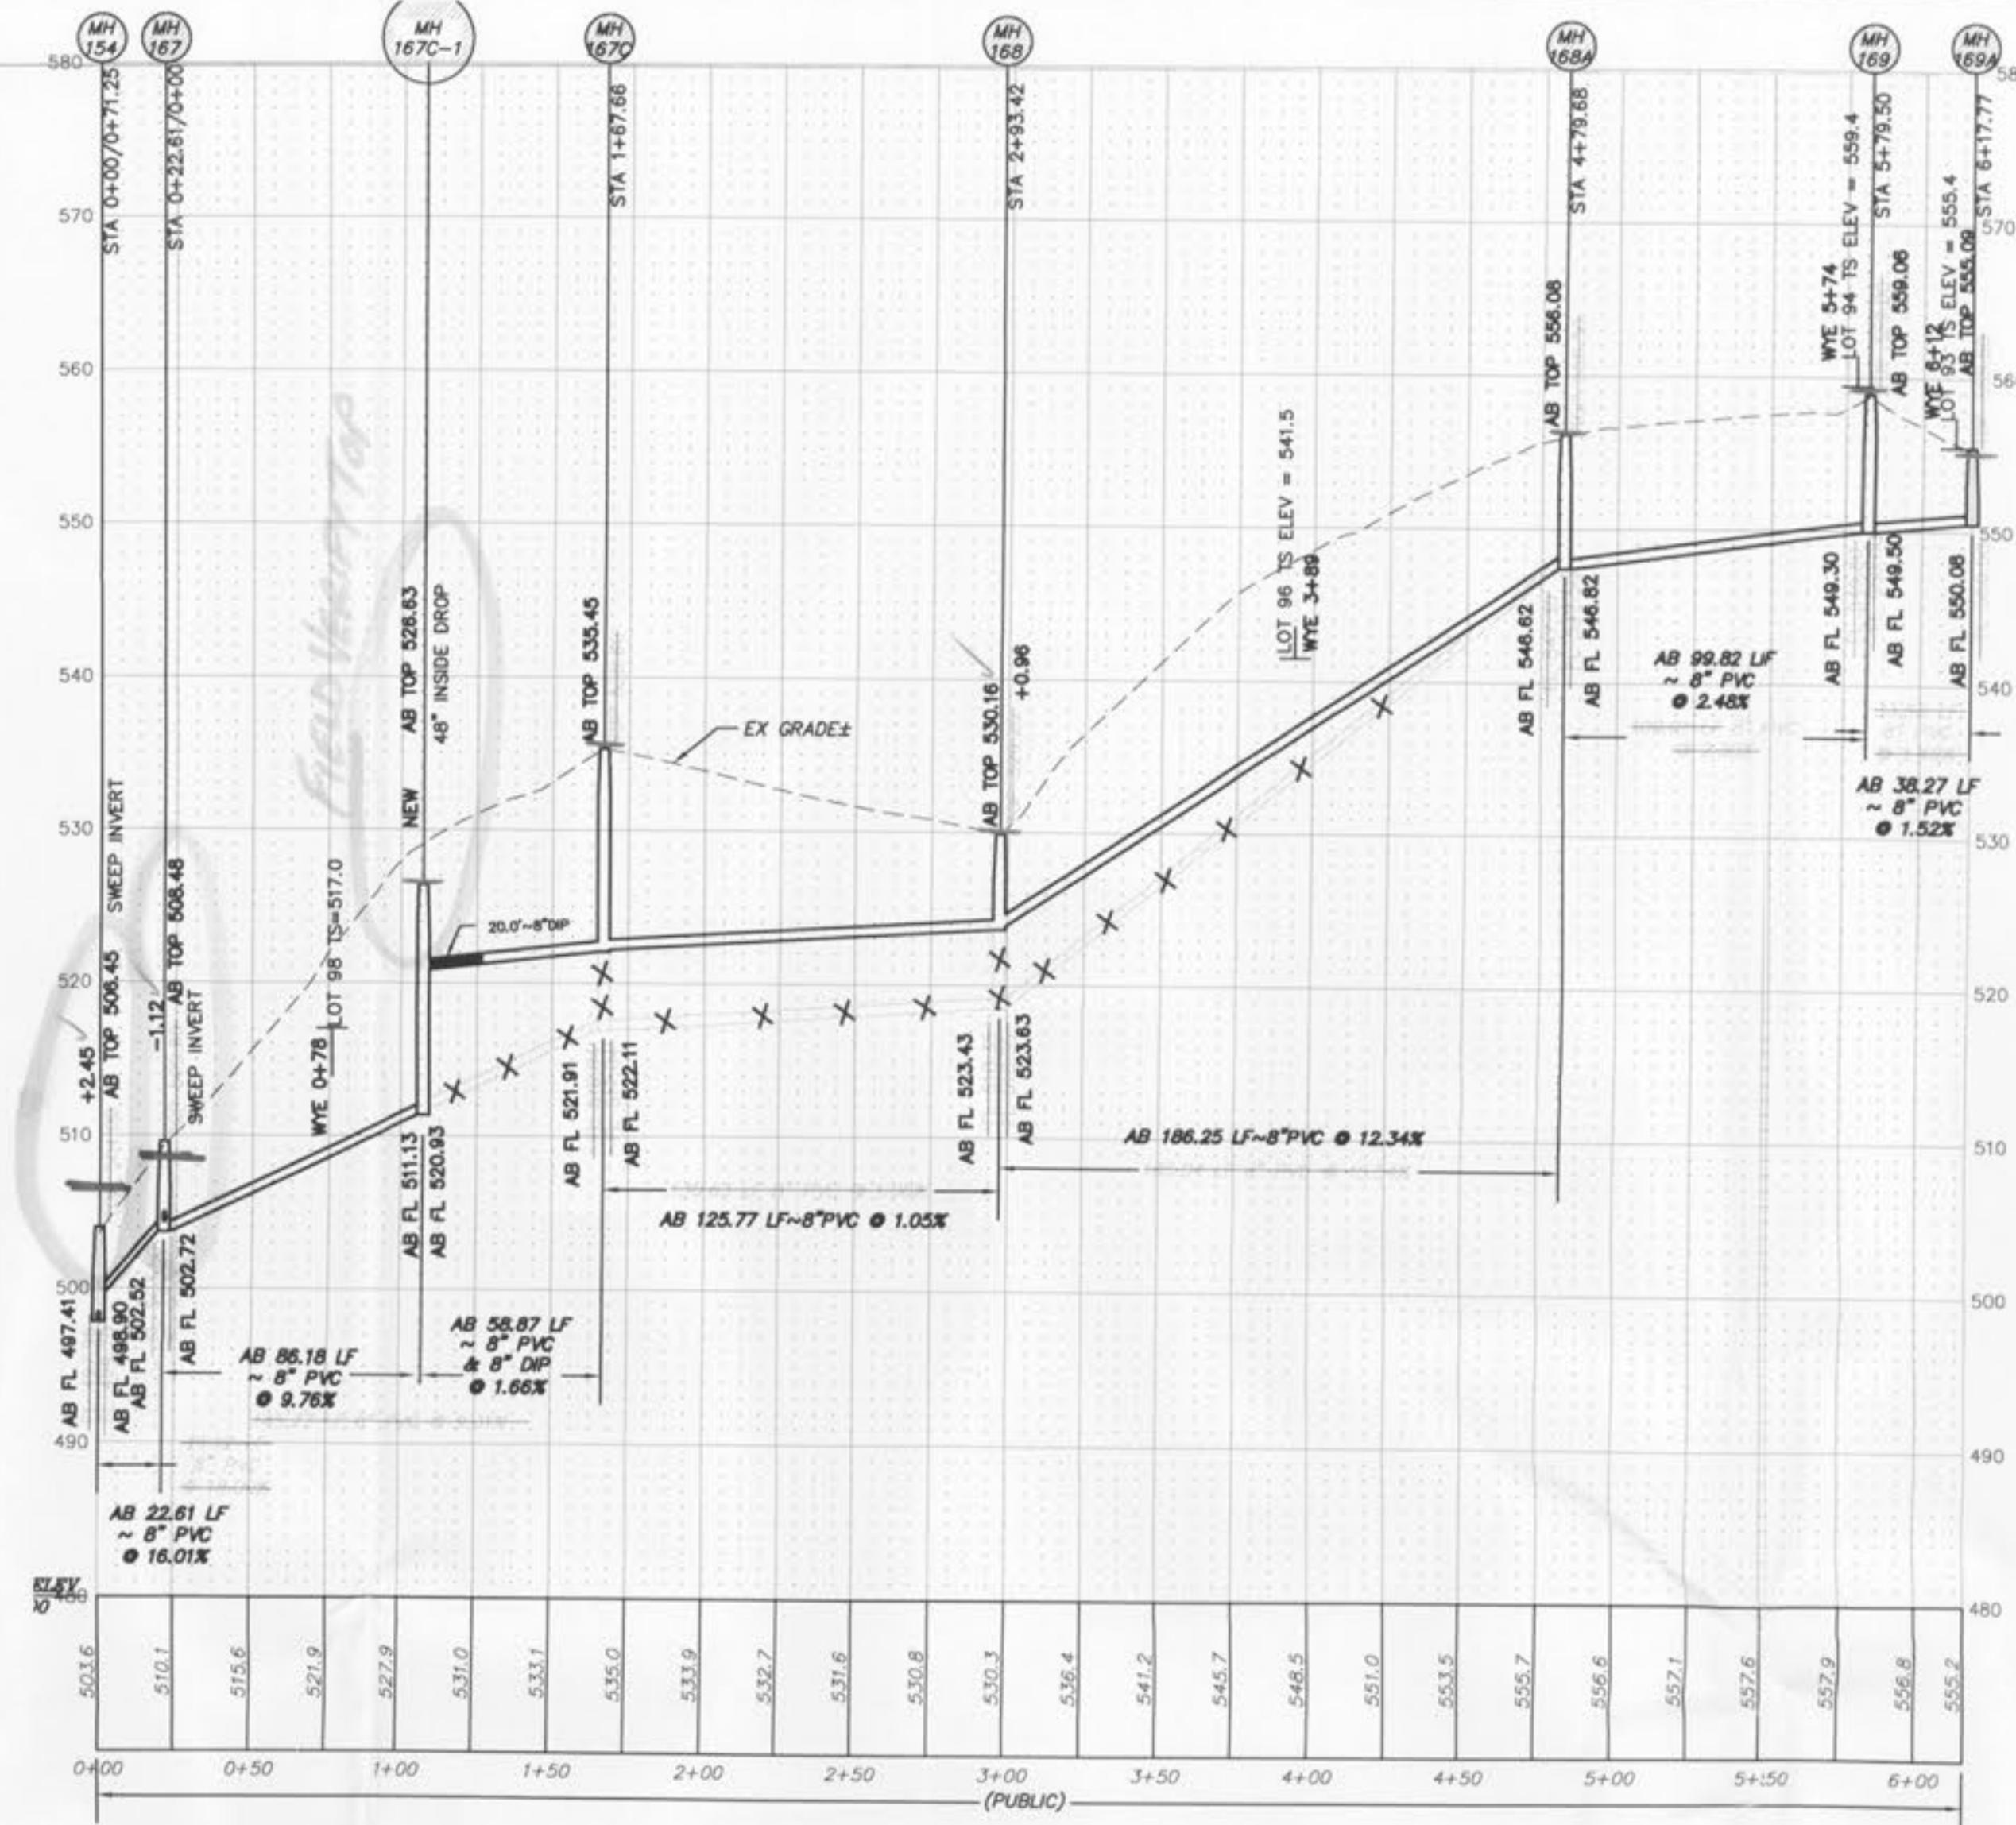

DRAWN MK	DATE
	01/04/04
CHECKED DST	DATE
	01/04/04
PROJECT #	FIELD BOOK
ST. CHARLES COUNTY	1

LAKE CHARLES HILLS N.I.D.
IMPROVEMENT PLANS
SANITARY SEWER PROFILES
SHEET 14 OF 21

PICKETT RAY & SILVER

CIVIL ENGINEERS
PLANNERS
LAND SURVEYORS

333 Mid Rivers Mall Drive
St. Peters, MO 63376
Phone (636) 397-1211
Fax (636) 397-1104

LAKE CHARLES HILLS N.I.D.
IMPROVEMENT PLANS
SANITARY SEWER PROFILES
Prepared For:
ST. CHARLES COUNTY

Mr. Charles Feldman
St. Charles County Gov't
201 N. Second St., Suite 420
St. Charles, MO 63301
Tele: 636-349-7565
Fax: 636-349-7316


REVISIONS	NO.	DATE	PER CITY COMMENTS
	1	7-18-06	PER CITY COMMENTS
	2	8-16-06	PER CITY SHOW 0.2' DROP IN MH'S

ENGINEERS AUTHENTICATION
The responsibility for professional
engineering liability on this project
is hereby limited to the set of plans
authored by the engineer whose
name appears below.
Responsibility is disclaimed for all
other engineering plans involved in
this project and specifically exclude
any plans after this date unless
reauthenticated.

PICKETT, RAY & SILVER, INC.



LAKE CHARLES HILLS N.I.D.
IMPROVEMENT PLANS
SANITARY SEWER PROFILES
SHEET 14 OF 21

© Copyright 2001 by Pickett, Ray & Silver, Inc.

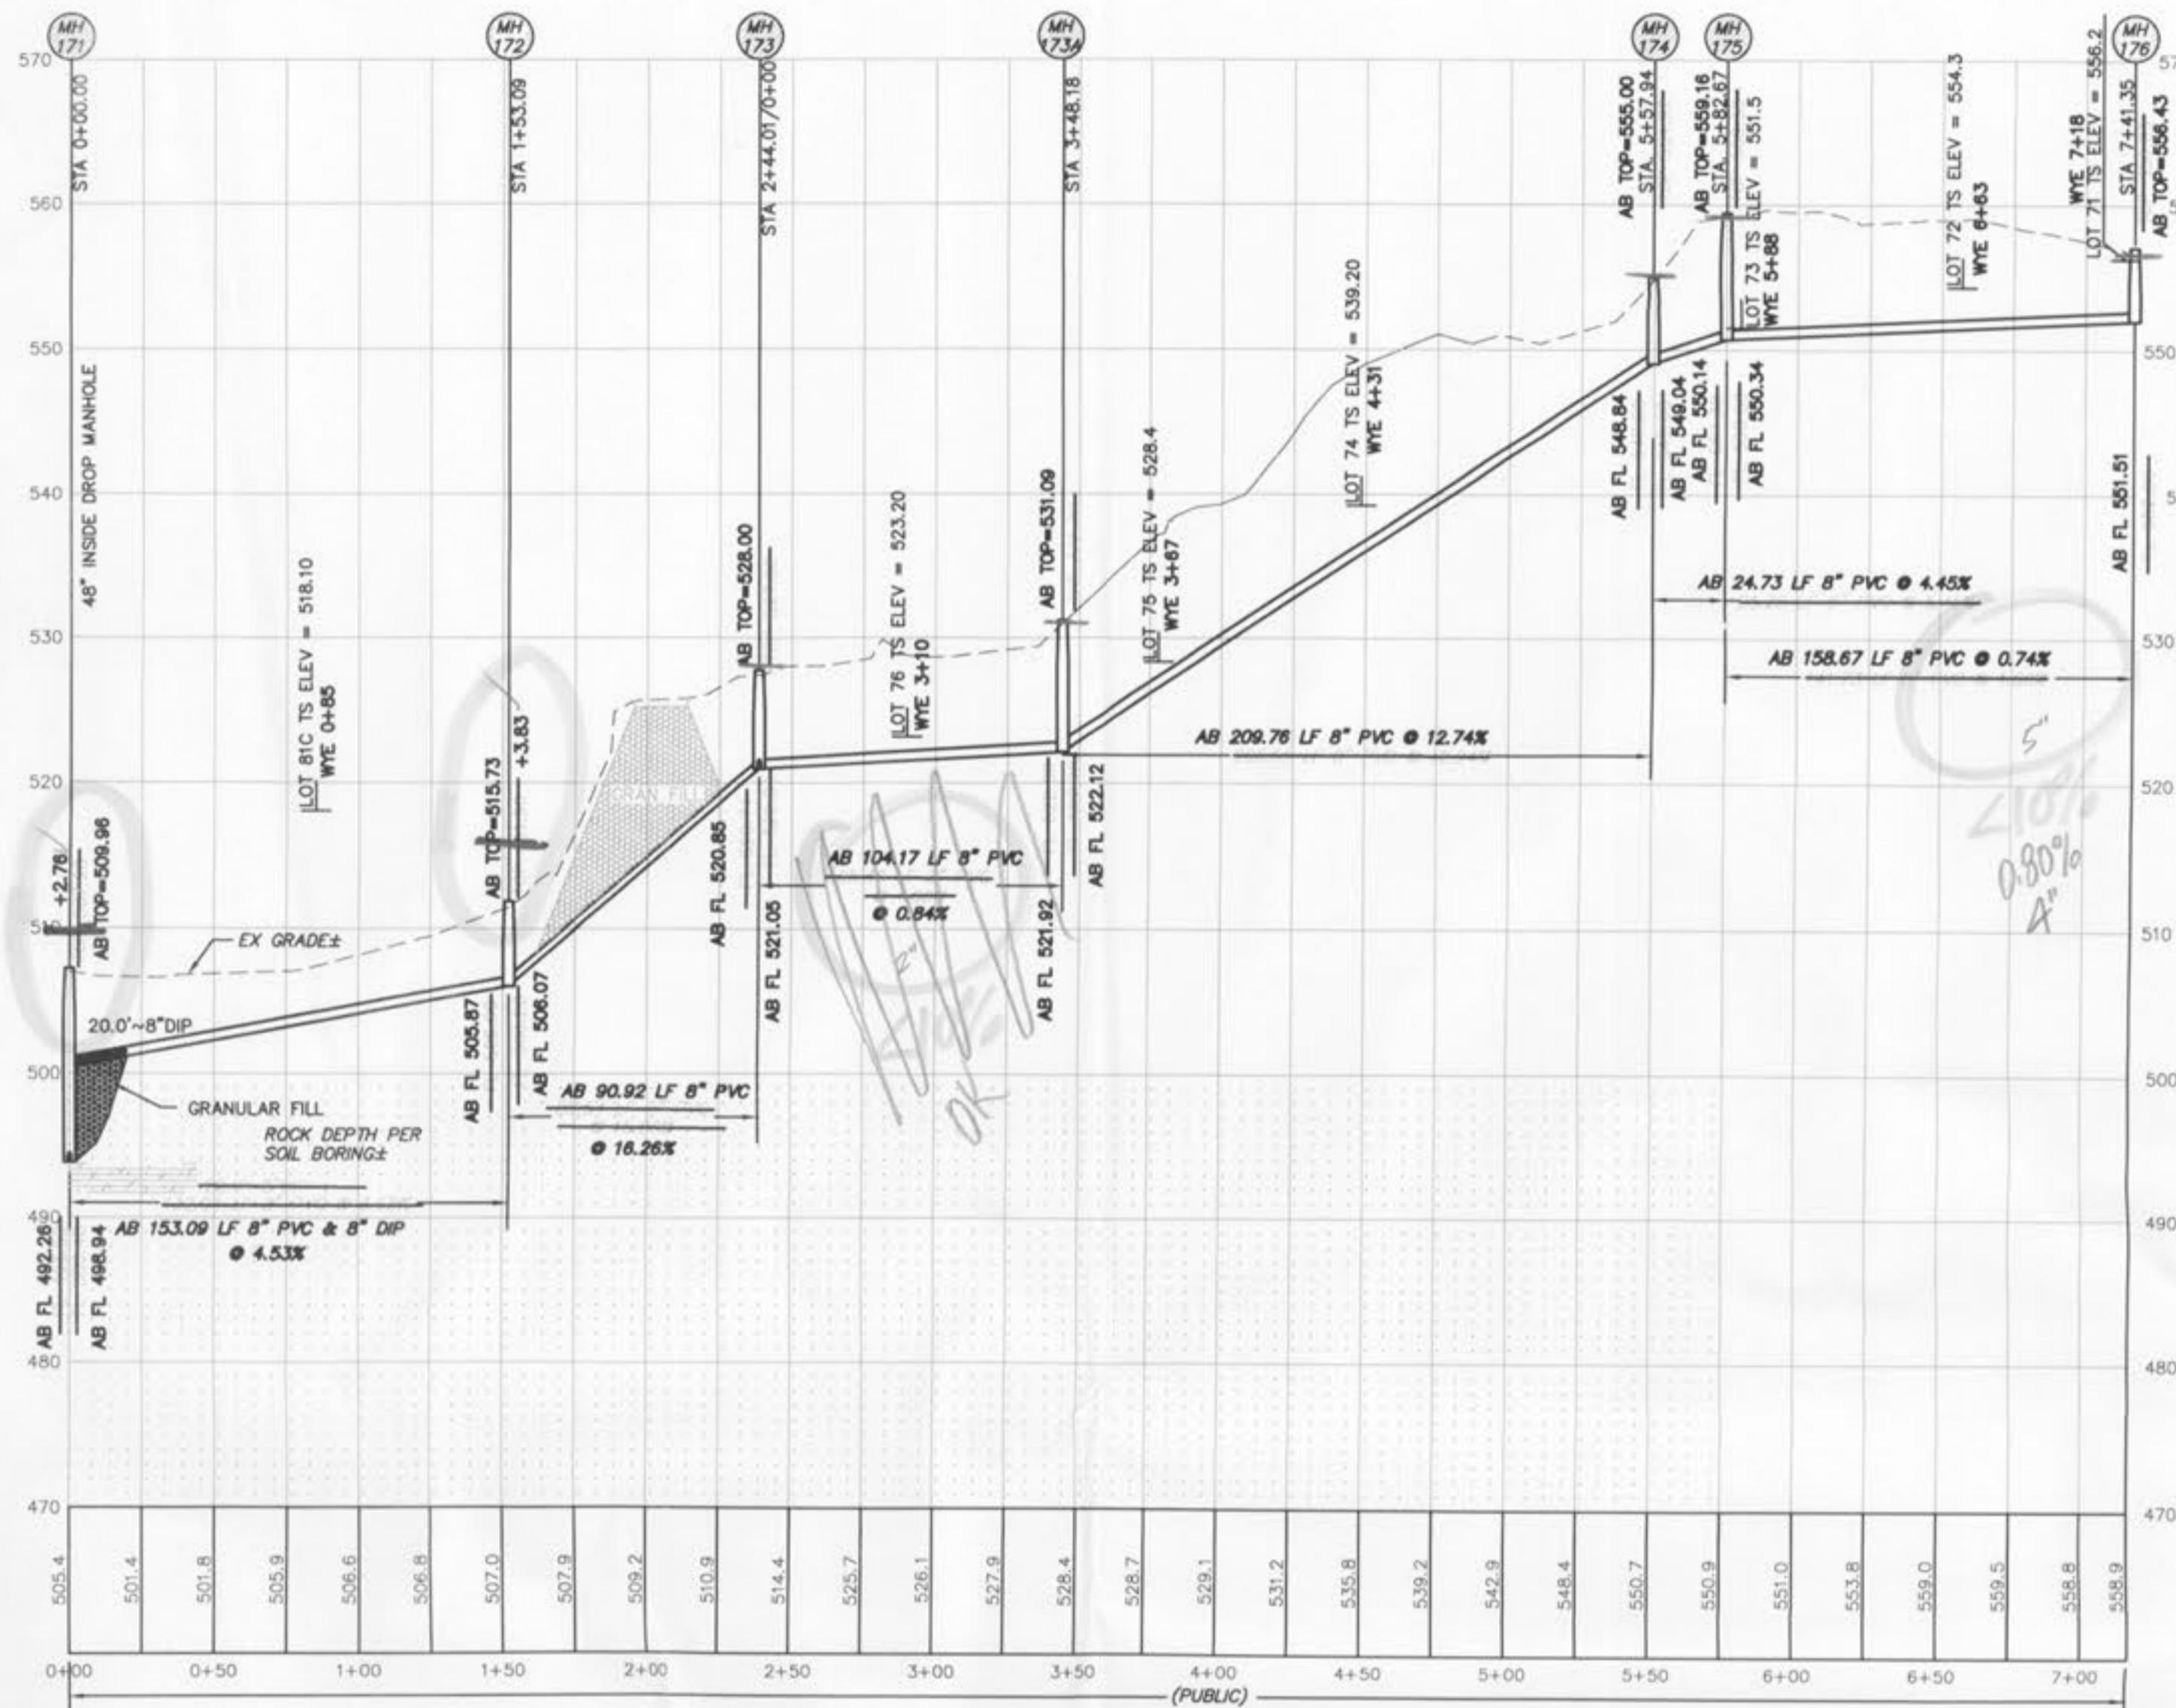

AS-BUILTS

WYE LOCATIONS PROVIDED BY CONTRACTOR

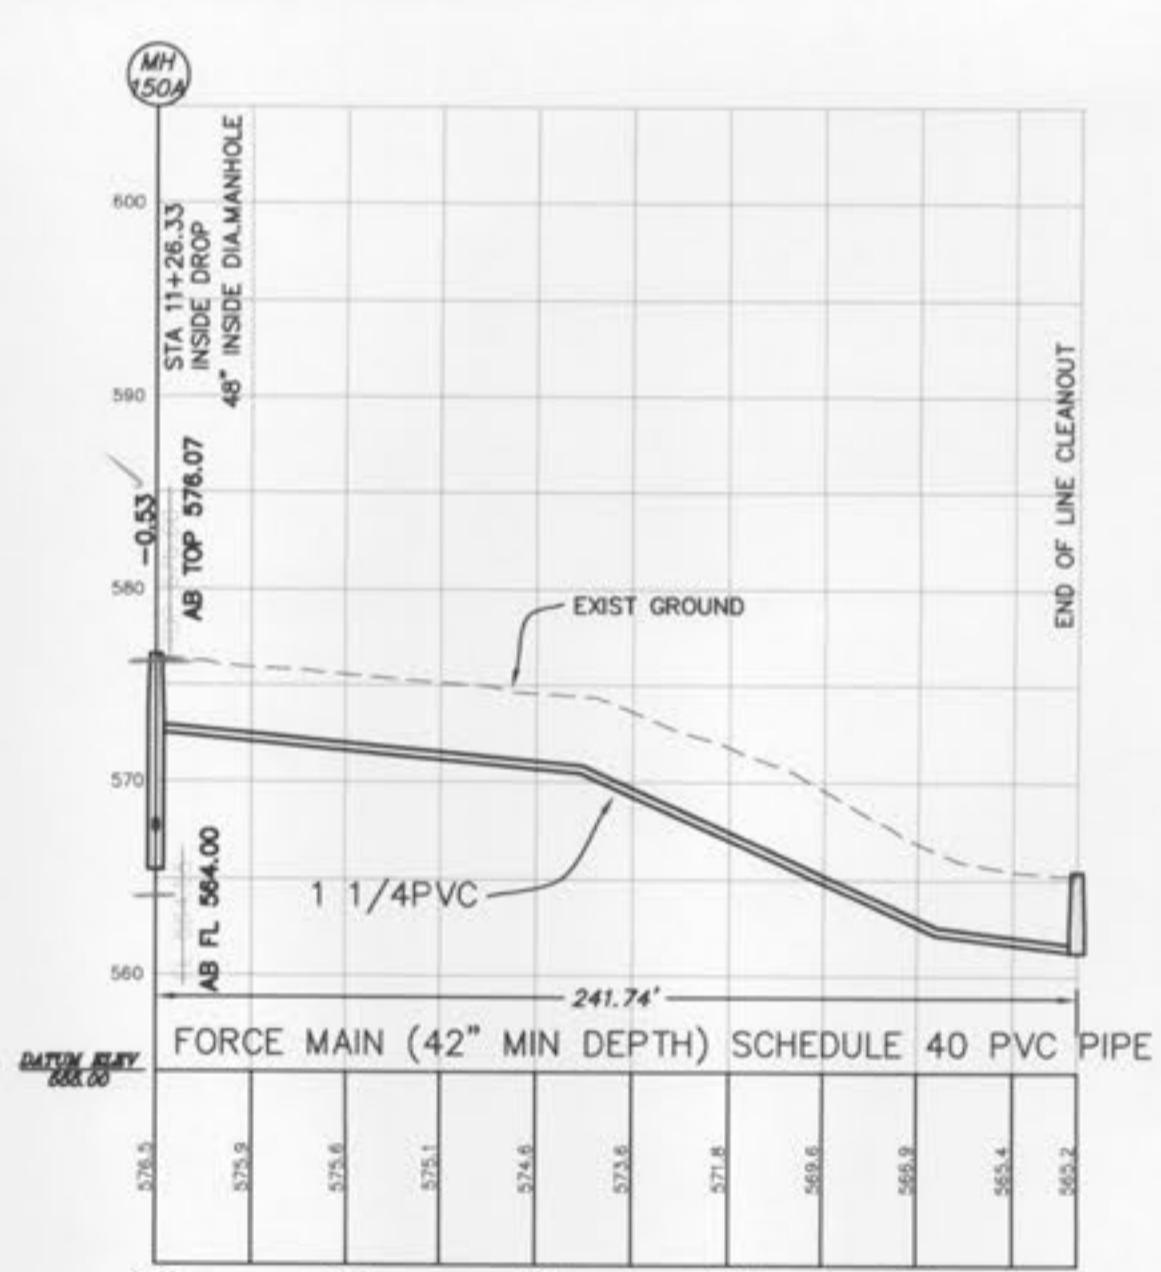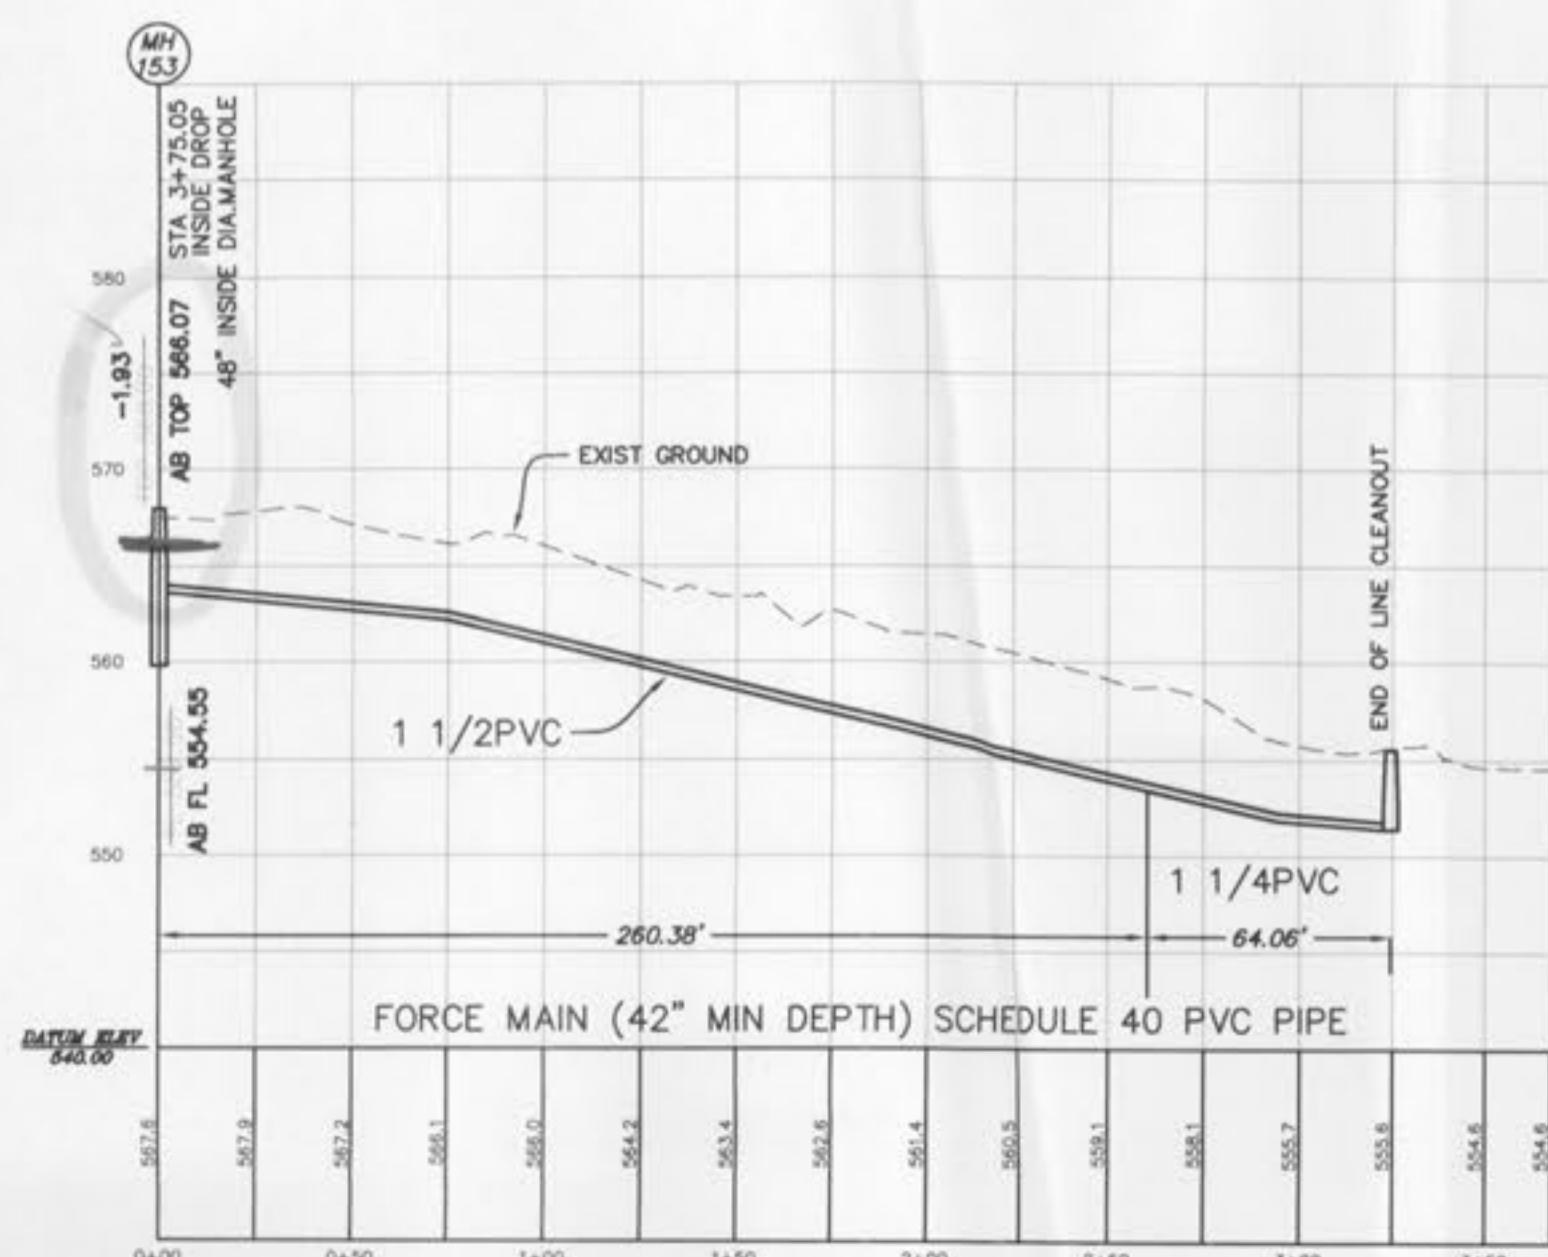

SITE NOTE:
LATERAL LOCATIONS ARE APPROXIMATE. WYE LOCATIONS TO BE DETERMINED IN THE FIELD AT THE TIME OF CONSTRUCTION. ALL LATERALS WILL BE FIELD LOCATED AND SHOWN ON THE AS-BUILT PLANS. CONTRACTOR IS RESPONSIBLE FOR STATIONING WYES.

UTILITY NOTE:
UNDERGROUND FACILITY STRUCTURES AND UTILITIES HAVE BEEN
PLOTTED FROM AVAILABLE SURVEYS AND RECORDED INFORMATION AND,
THEREFORE, THEIR LOCATIONS MUST BE CONSIDERED APPROXIMATE ONLY.
VERIFICATION OF LOCATION OF ALL UNDERGROUND STRUCTURES AND
FACILITIES EITHER SHOWN OR NOT SHOWN ON THESE PLANS, SHALL BE
THE RESPONSIBILITY OF THE CONTRACTOR.

LAKE CHARLES HILLS NEIGHBORHOOD IMPROVEMENT DISTRICT ANALYSIS OF LOW PRESSURE SEWER SYSTEM WITH PIPE SCHEDULE SCHEDULE 40 PVC PIPE														
1 Branch No.	2 No. of Pumps	3 Accum Total	4 Max. On	5 Max. Flow (gpm)	6 Pipe Size (in)	7 Max. Velocity (ft/sec)	8 Length (ft)	9 Friction Loss (ft/100 ft)	10 Friction Loss Total (ft)	11 Accum. Friction Loss (ft)	12 Max. Main Elev. (ft)	13 Minimum Pump Elev. (ft)	14 Elev. Diff. (ft)	15 Max. Total Head (ft)
1	2	2	2	22	1.25	4.72	290.00	6.28	18.212	18.212	574	568	6	24.212

This table based on 200 gallons of usage per dwelling unit.									
1	2	3	4	5	6	7	8	9	10
Branch No.	Accum No. of Pumps	Pipe Size (in)	Gal Per 100 Lineal Feet	Length (ft)	Capacity of Branch	Average Daily Flow	Average Fluid Changes Per Day	Average Retention Time (hr)	Accum. Retention Time (hr)
1	2	1.25	7.8	290.00	32.62	400	17.68	1.26	1.26

LAKE CHARLES HILLS NEIGHBORHOOD IMPROVEMENT DISTRICT ANALYSIS OF LOW PRESSURE SEWER SYSTEM WITH PIPE SCHEDULE SCHEDULE 40 PVC PIPE														
1 Branch No.	2 No. of Pumps	3 Accum Total	4 Max. On	5 Max. Flow (gpm)	6 Pipe Size (in)	7 Max. Velocity (ft/sec)	8 Length (ft)	9 Friction Loss (ft/100 ft)	10 Friction Loss Total (ft)	11 Accum. Friction Loss (ft)	12 Max. Main Elev. (ft)	13 Minimum Pump Elev. (ft)	14 Elev. Diff. (ft)	15 Max. Total Head (ft)
1	1	1	1	11	1.25	2.36	107.00	1.74	1.862	11.006	564	542	22	33.006
2	1	2	2	22	1.50	3.47	102.00	2.97	3.029	9.144	564	548	16	25.144
3	1	3	2	22	1.50	3.47	100.00	2.97	2.970	6.115	564	557	7	13.115
4	1	4	3	33	1.50	5.20	50.00	6.29	3.145	3.145	564	560	4	7.145

This table based on 200 gallons of usage per dwelling unit.									
1	2	3	4	5	6	7	8	9	10
Branch No.	Accum No. of Pumps	Pipe Size (in)	Gal Per 100 Lineal Feet	Length (ft)	Capacity of Branch	Average Daily Flow	Average Fluid Changes Per Day	Average Retention Time (hr)	Accum. Retention Time (hr)
1	1	1.25	7.8	107.00	8.35	200	23.96	1.00	2.23
2	2	1.50	10.6	102.00	10.81	400	37.00	0.65	1.23
3	3	1.50	10.6	100.00	10.60	600	56.60	0.42	0.58
4	4	1.50	10.6	50.00	5.30	800	150.94	0.16	0.16

SCALE: HORIZONTAL 1"=50'
VERTICAL 1"=10'

PICKETT RAY & SILVER

3333 Mid Rivers Mall Drive
St. Peters, MO 63376
Phone (636) 397-1211
Fax (636) 397-1104

St. Peters, MO 63376
Phone (636) 397-1211
Fax (636) 397-1104

SEYVORS

PLANNERS
LAND SUR

Mr. Charles Feldman
St. Charles County Gov't
201 N. Second St. Suite 420
St. Charles, MO 63301
Tele: 636-949-7564
Fax: 636-949-7336

Prepared For:
SST. CHARLES COUNTY