




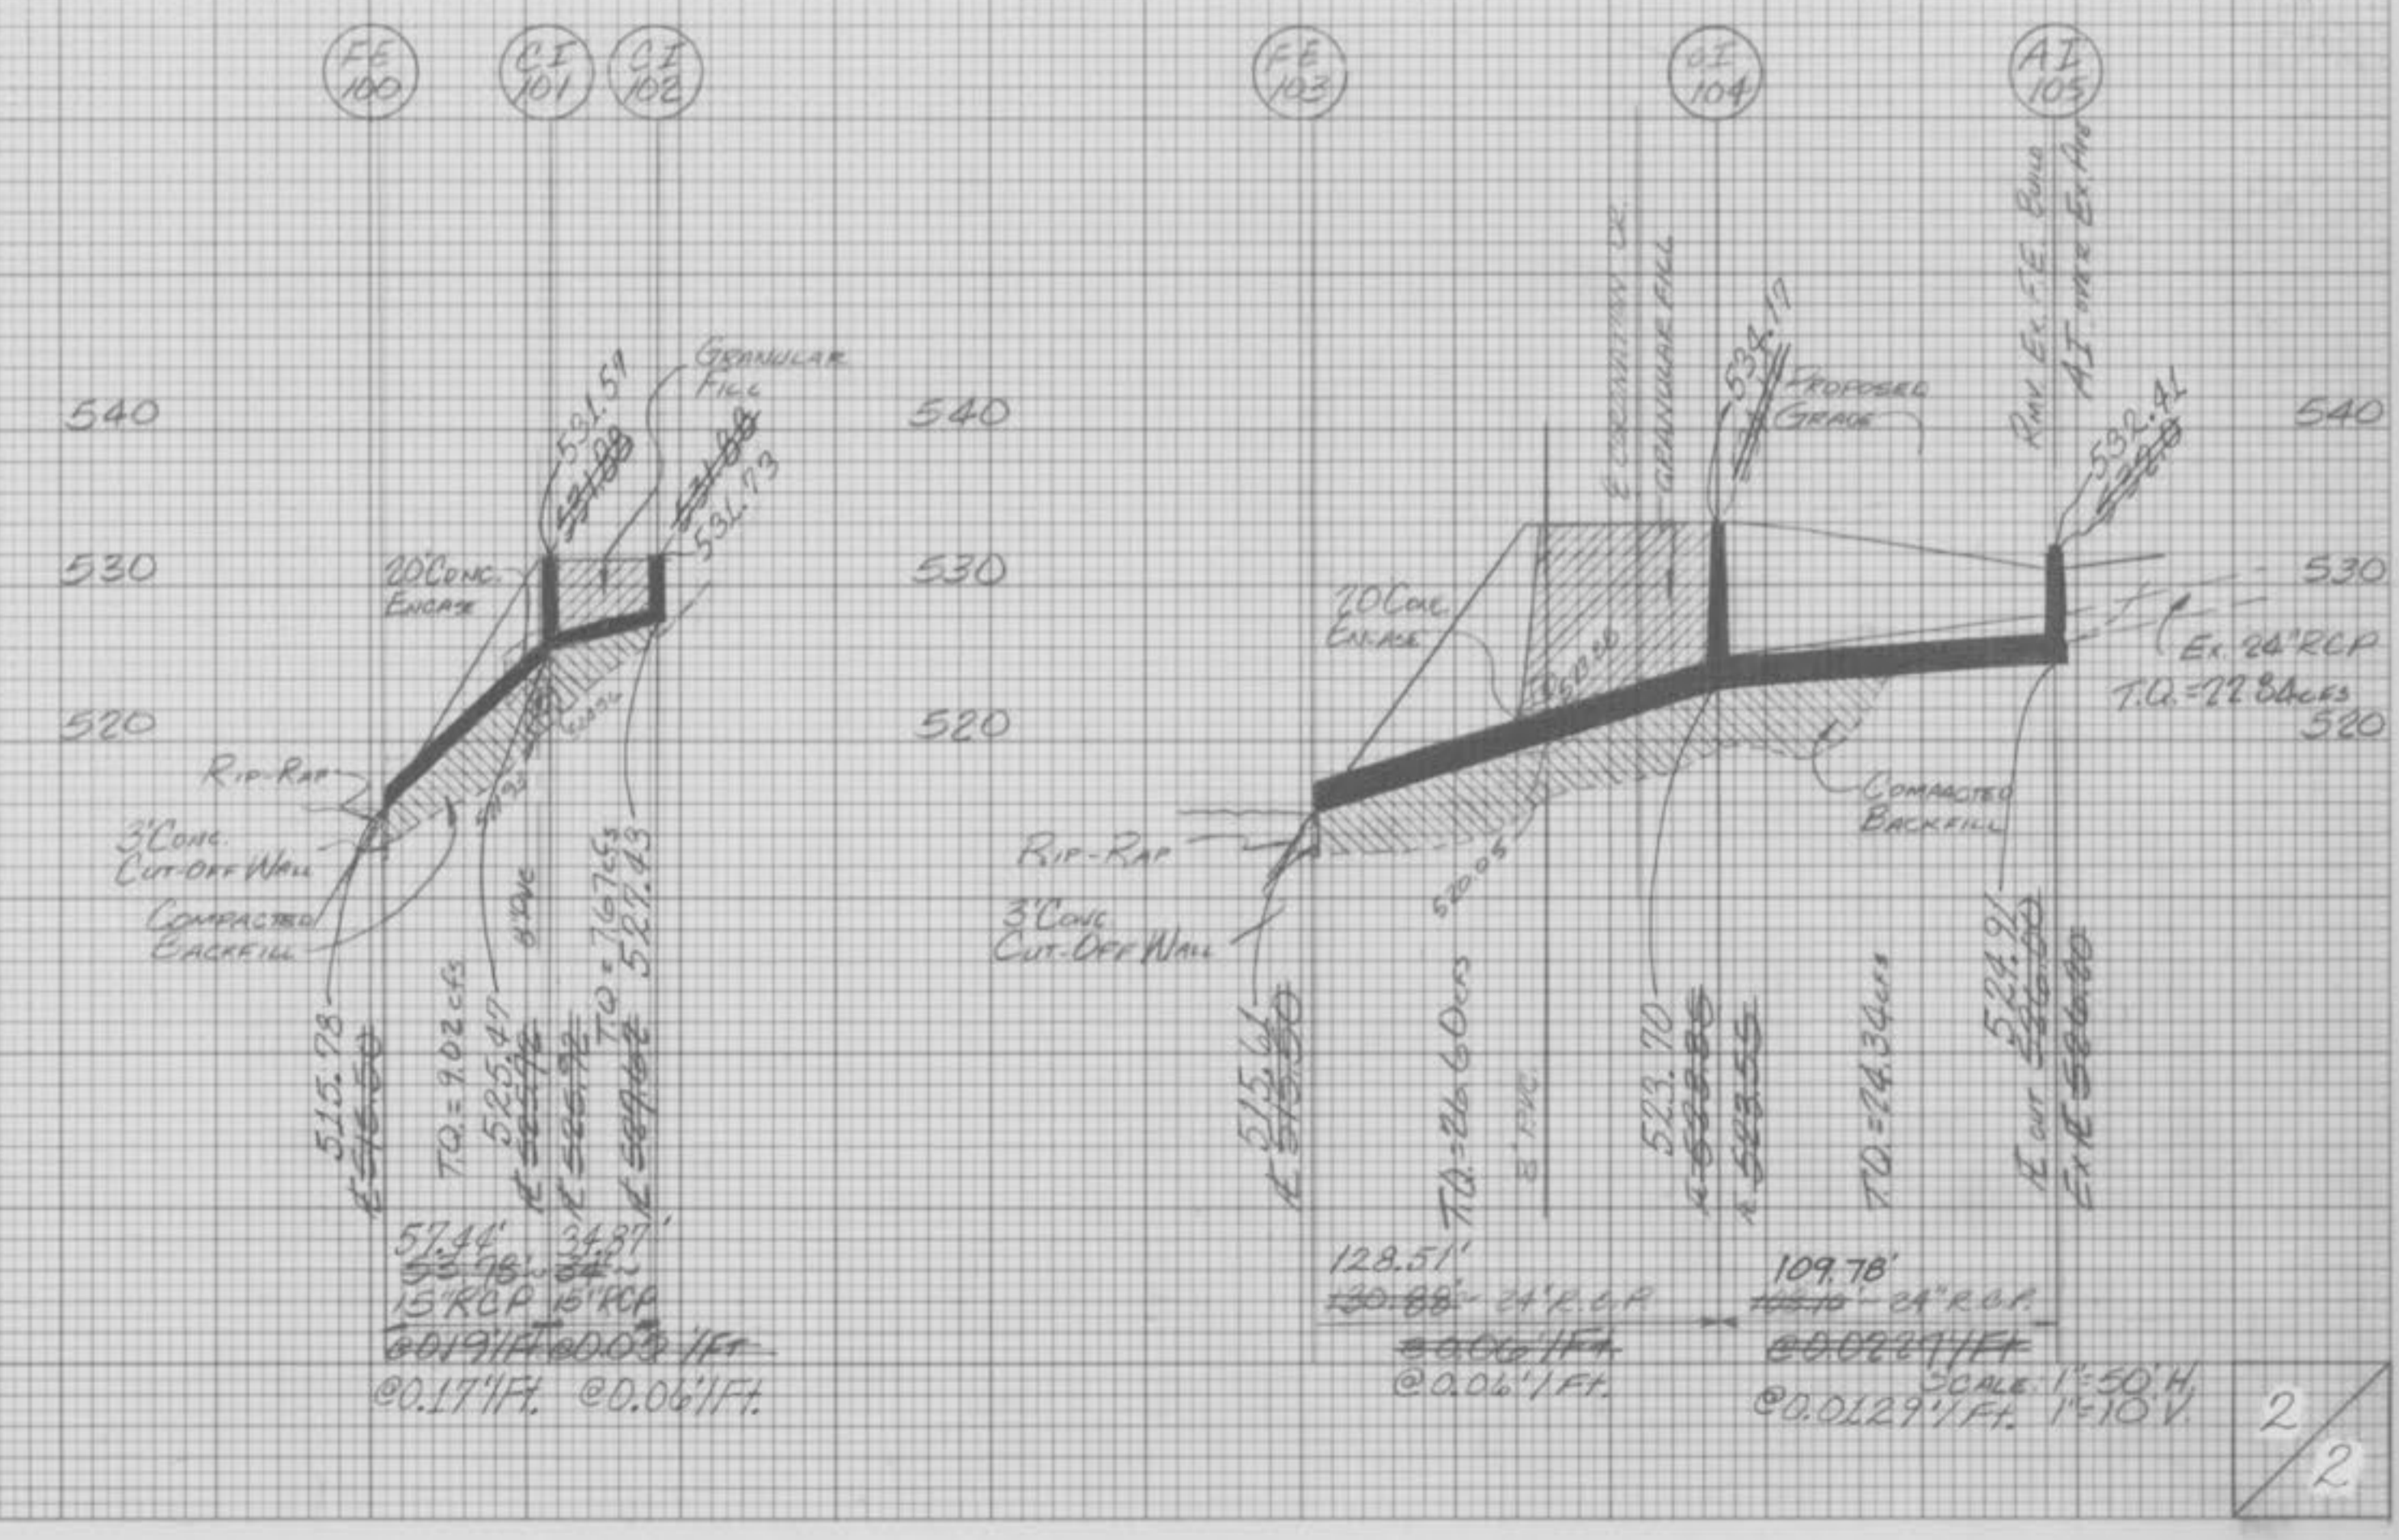

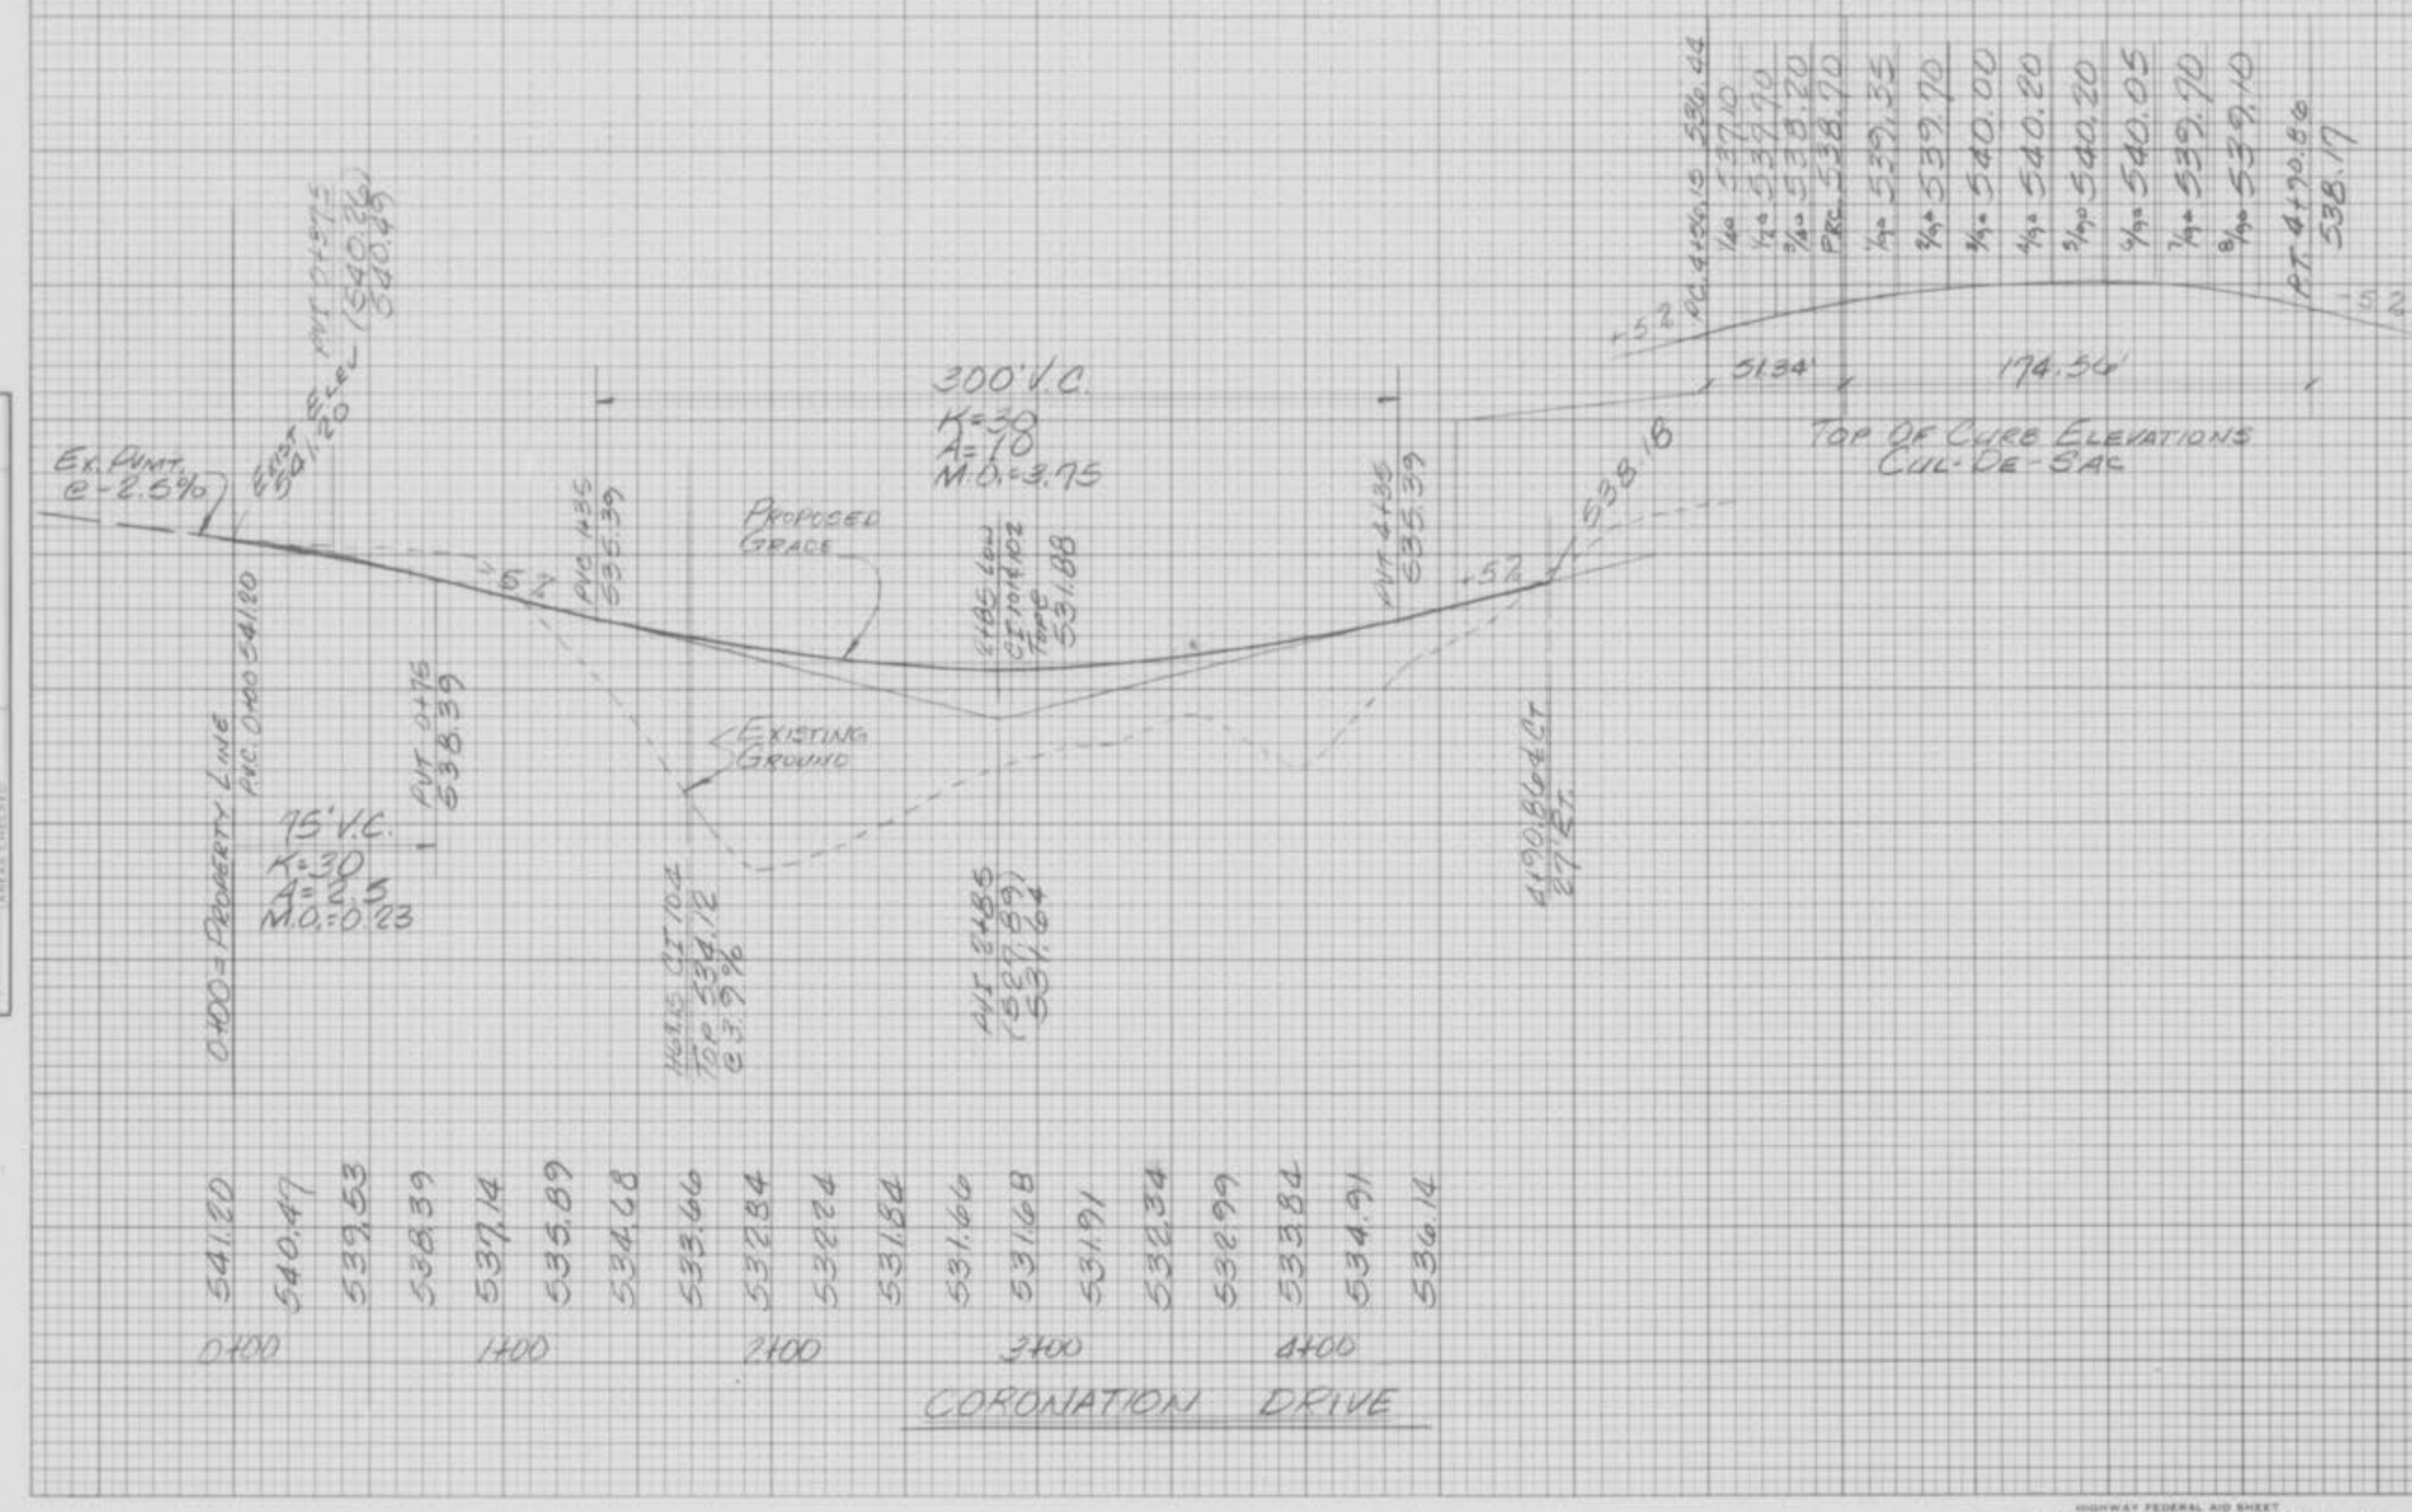

PROFILES  
 LAKE SIDE ESTATES  
 Feb 1995 89-3094C  
 AS-BUILT 10-25-95 LRR

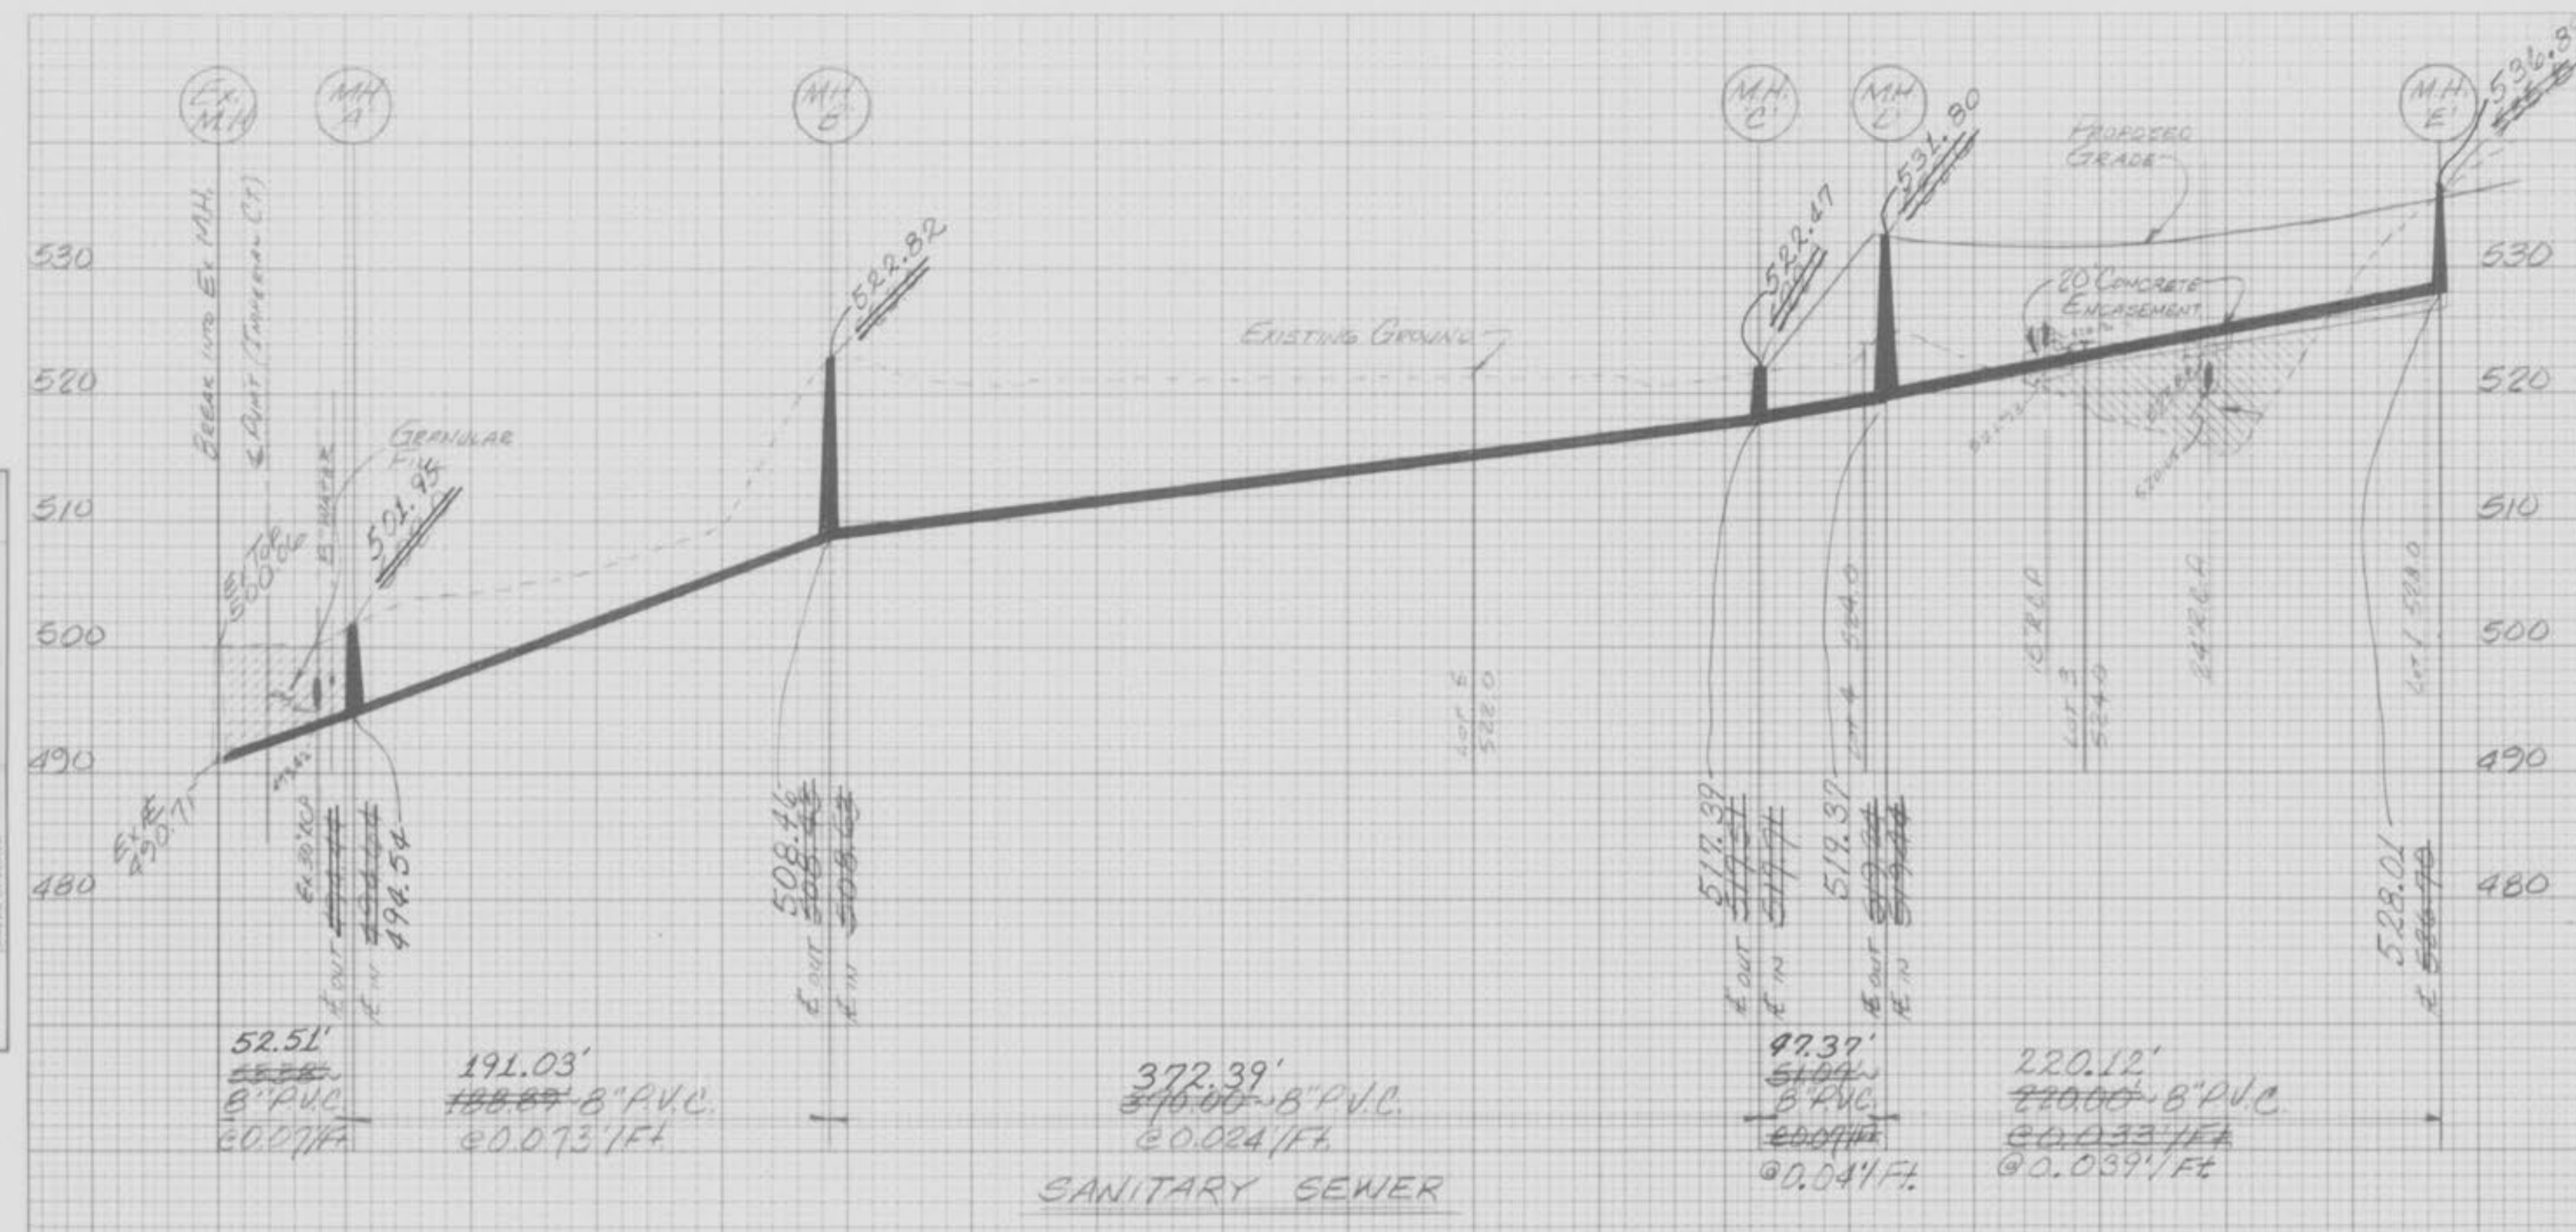

FINAL SURVEY  
 SURVEYED  
 PLOTTED  
 NOTE BOOK  
 DATE

ORIGINAL SURVEY  
 SURVEYED  
 PLOTTED  
 NOTE BOOK  
 DATE

HIGHWAY FEDERAL AID DISTRICT  
 PLATE 3-FULL CROSS SECTION-FULL LINE  
 NATIONAL PORTRAIT  
 PRINTED IN U.S.A.

Lakeside Estates  
 As built