

PROPERTY N/F
ALAN & WANDA FUERST
1638/498

MILAM PARTNERSHIP
1234/672

MATCHLINE SHEET 2



FOREST ACRES
PLAT TWO
P.B.20 PG.53

3


MATCHLINE SHEET 2

MATCHLINE SHEET 3

AS-BUILTS
MANDERLEY PLACE


96-8169 10-31-96

REV. 9-8-97
REV. 6-20-97
REV. 9-29-97

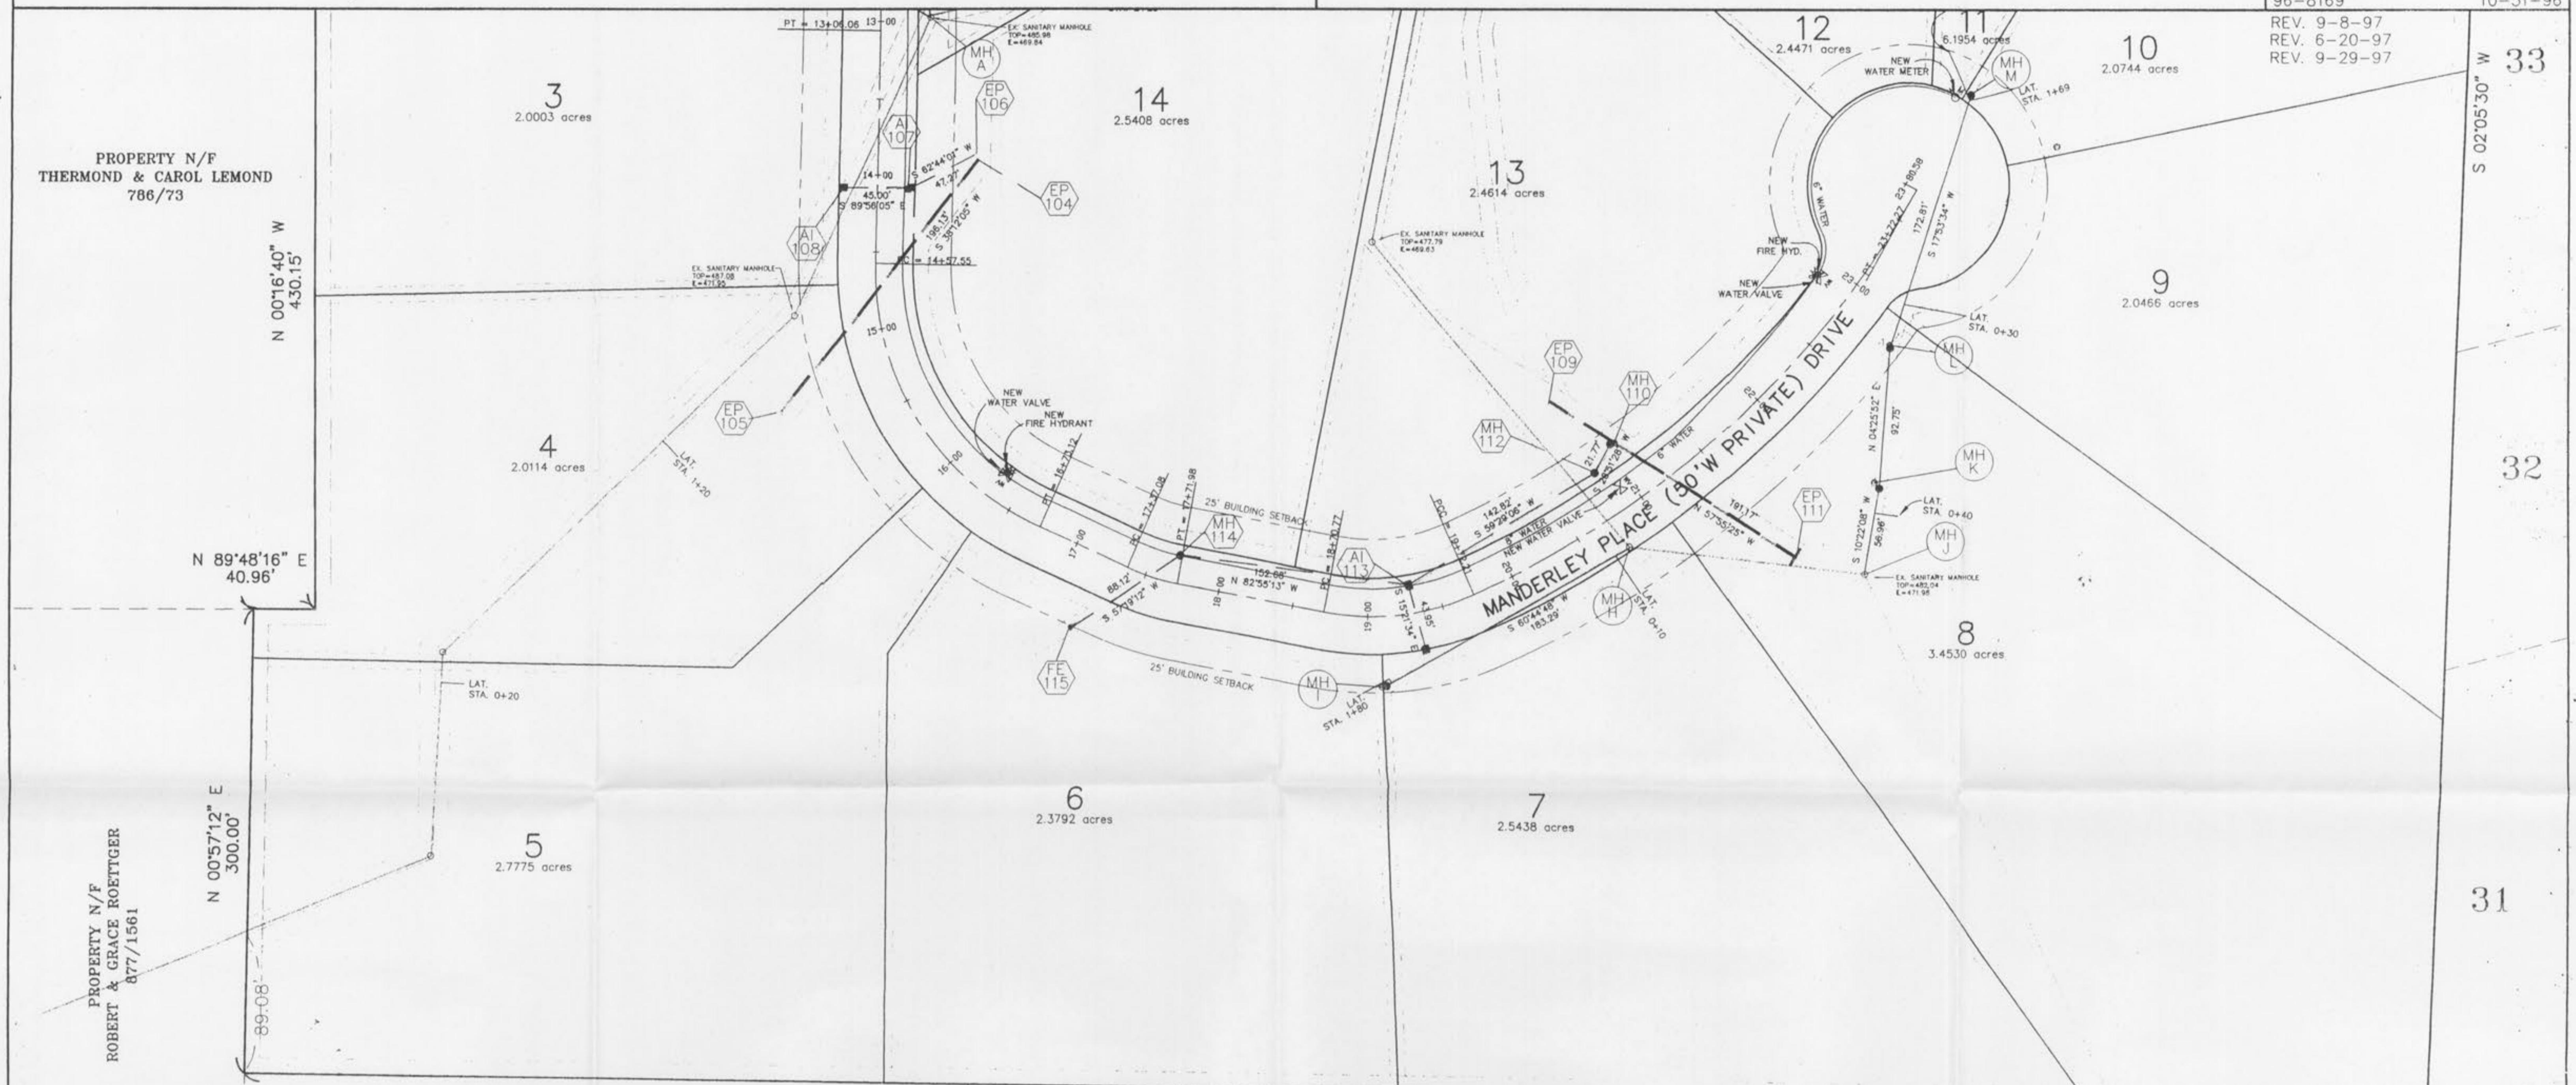



EV. 1-6-97
EV. 1-29-97
EV. 6-20-97
EV. 9-29-97

-8169

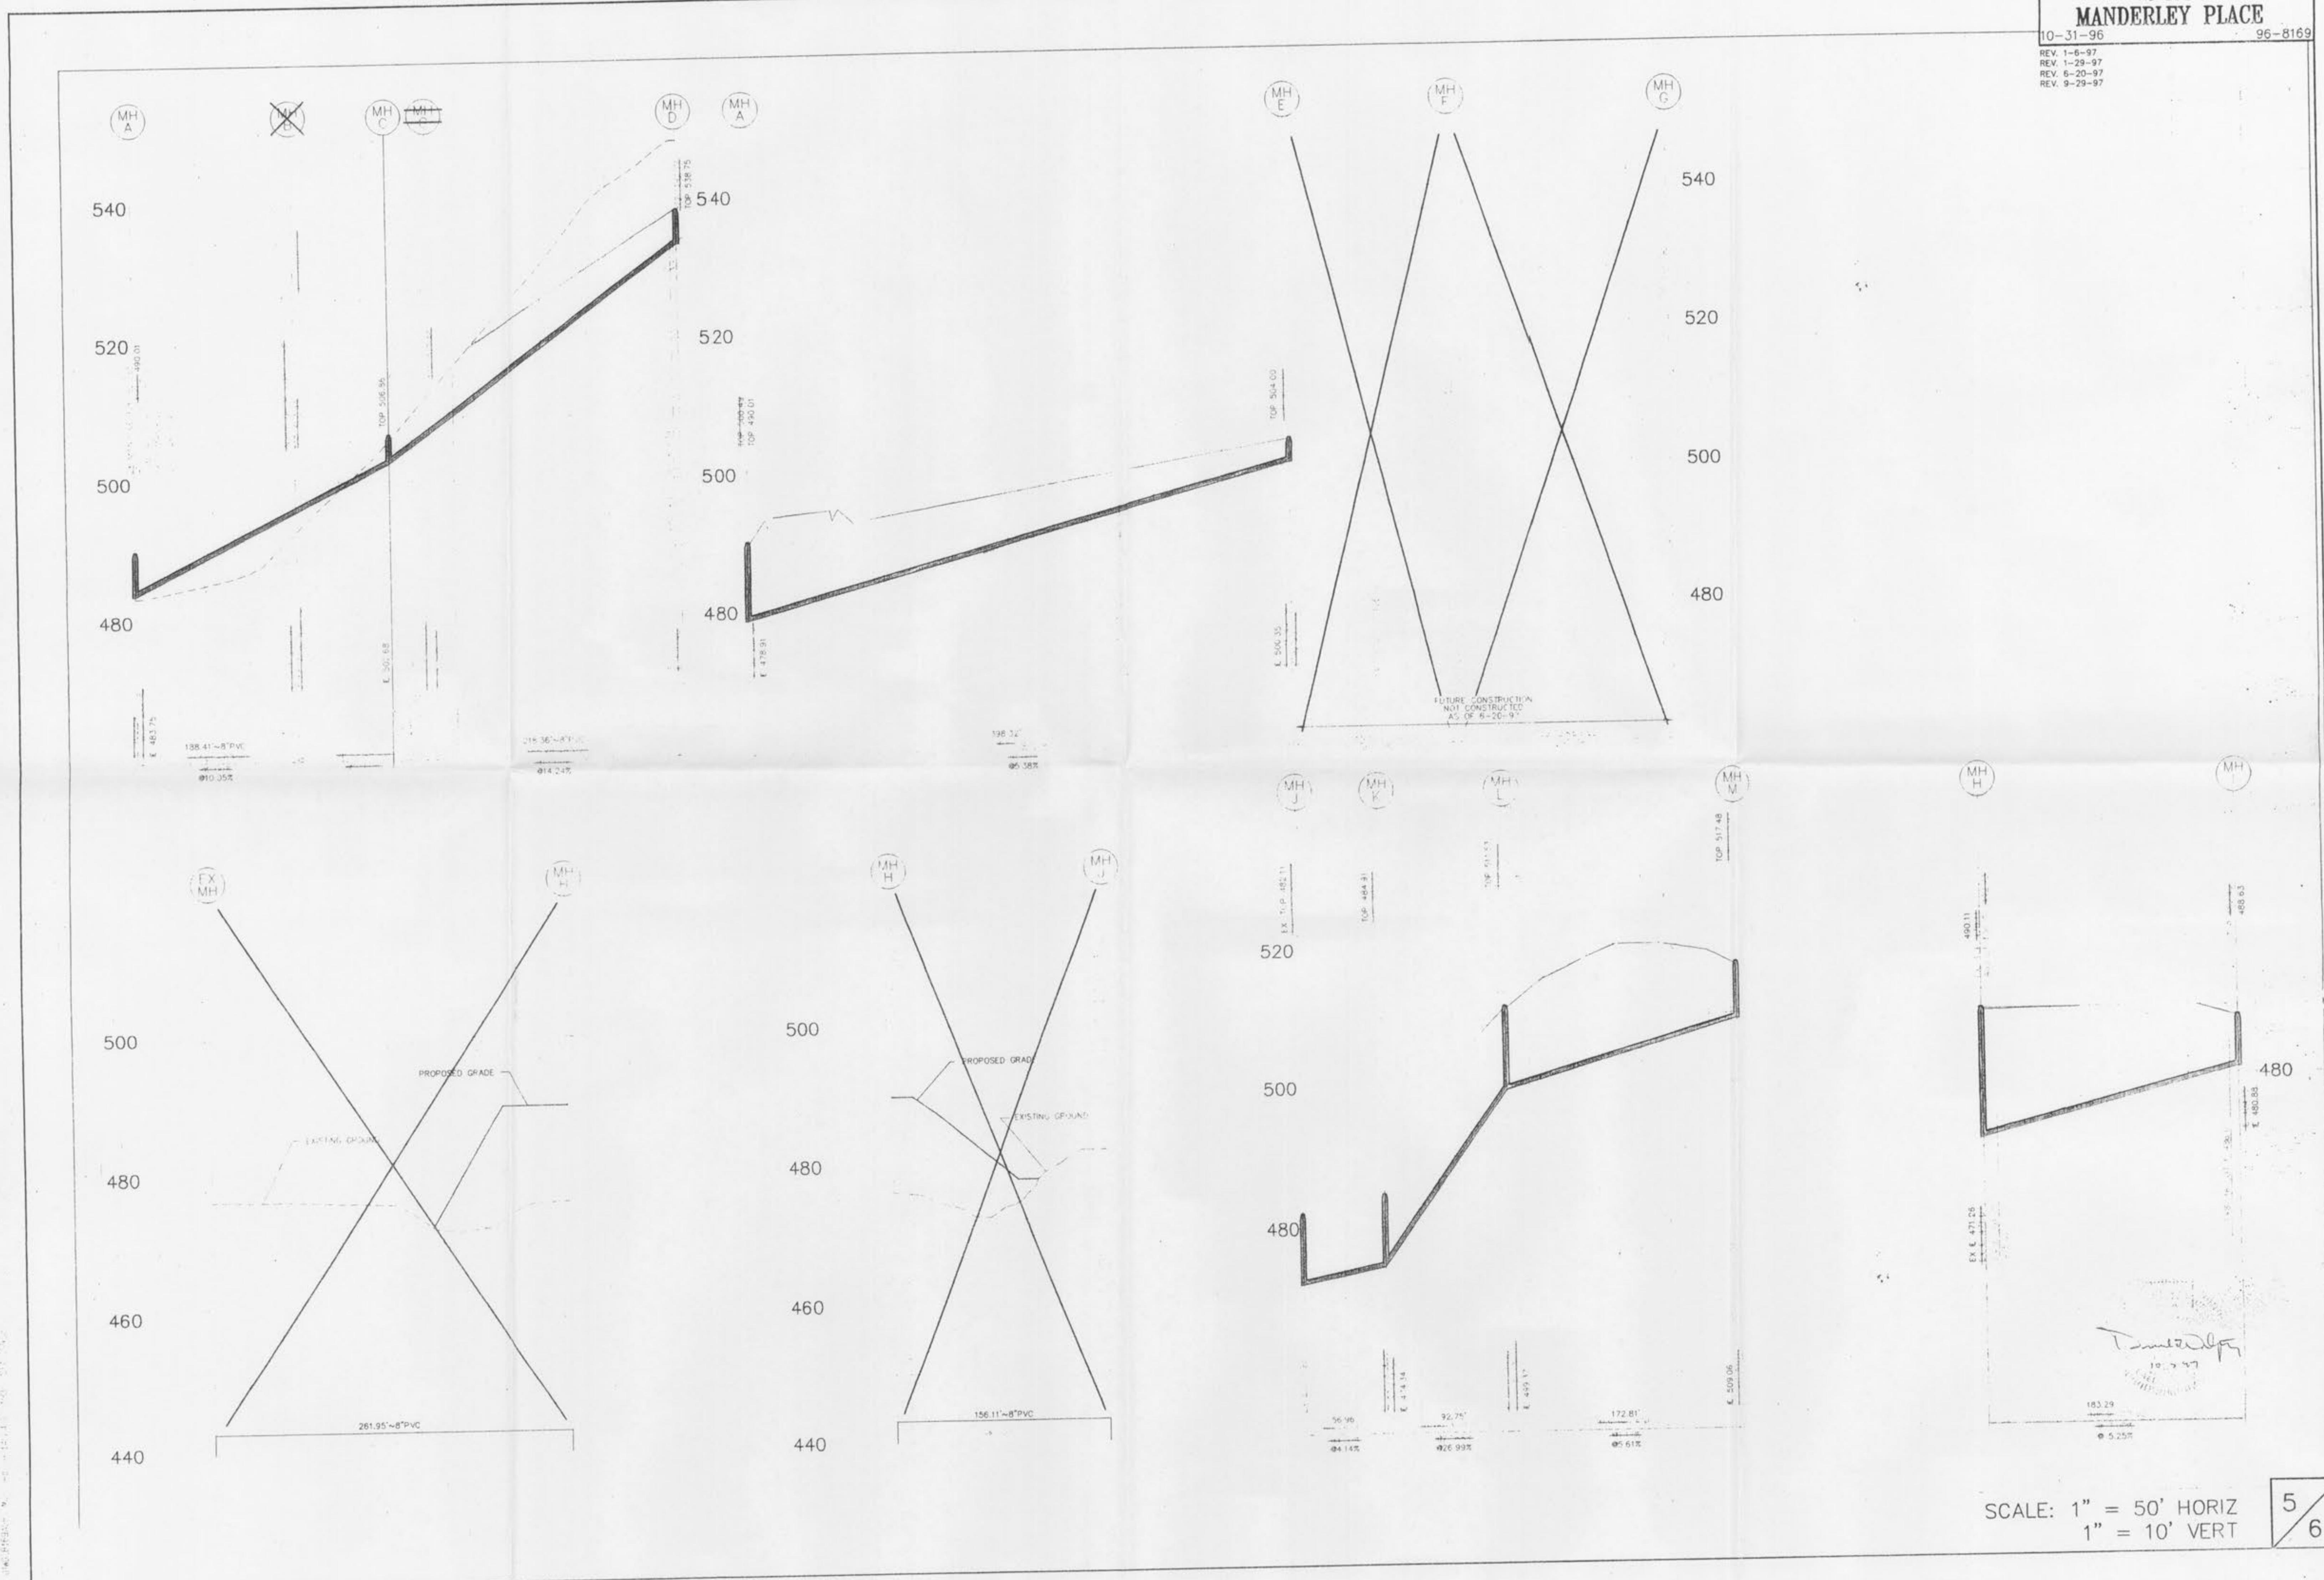


STORM SEWER PROFILS
AS-BUILT
MANDERLEY PLACE
10-31-96 96-8169

REV. 1-6-97
REV. 1-29-97
REV. 2-05-97
REV. 6-20-97
REV. 9-29-97

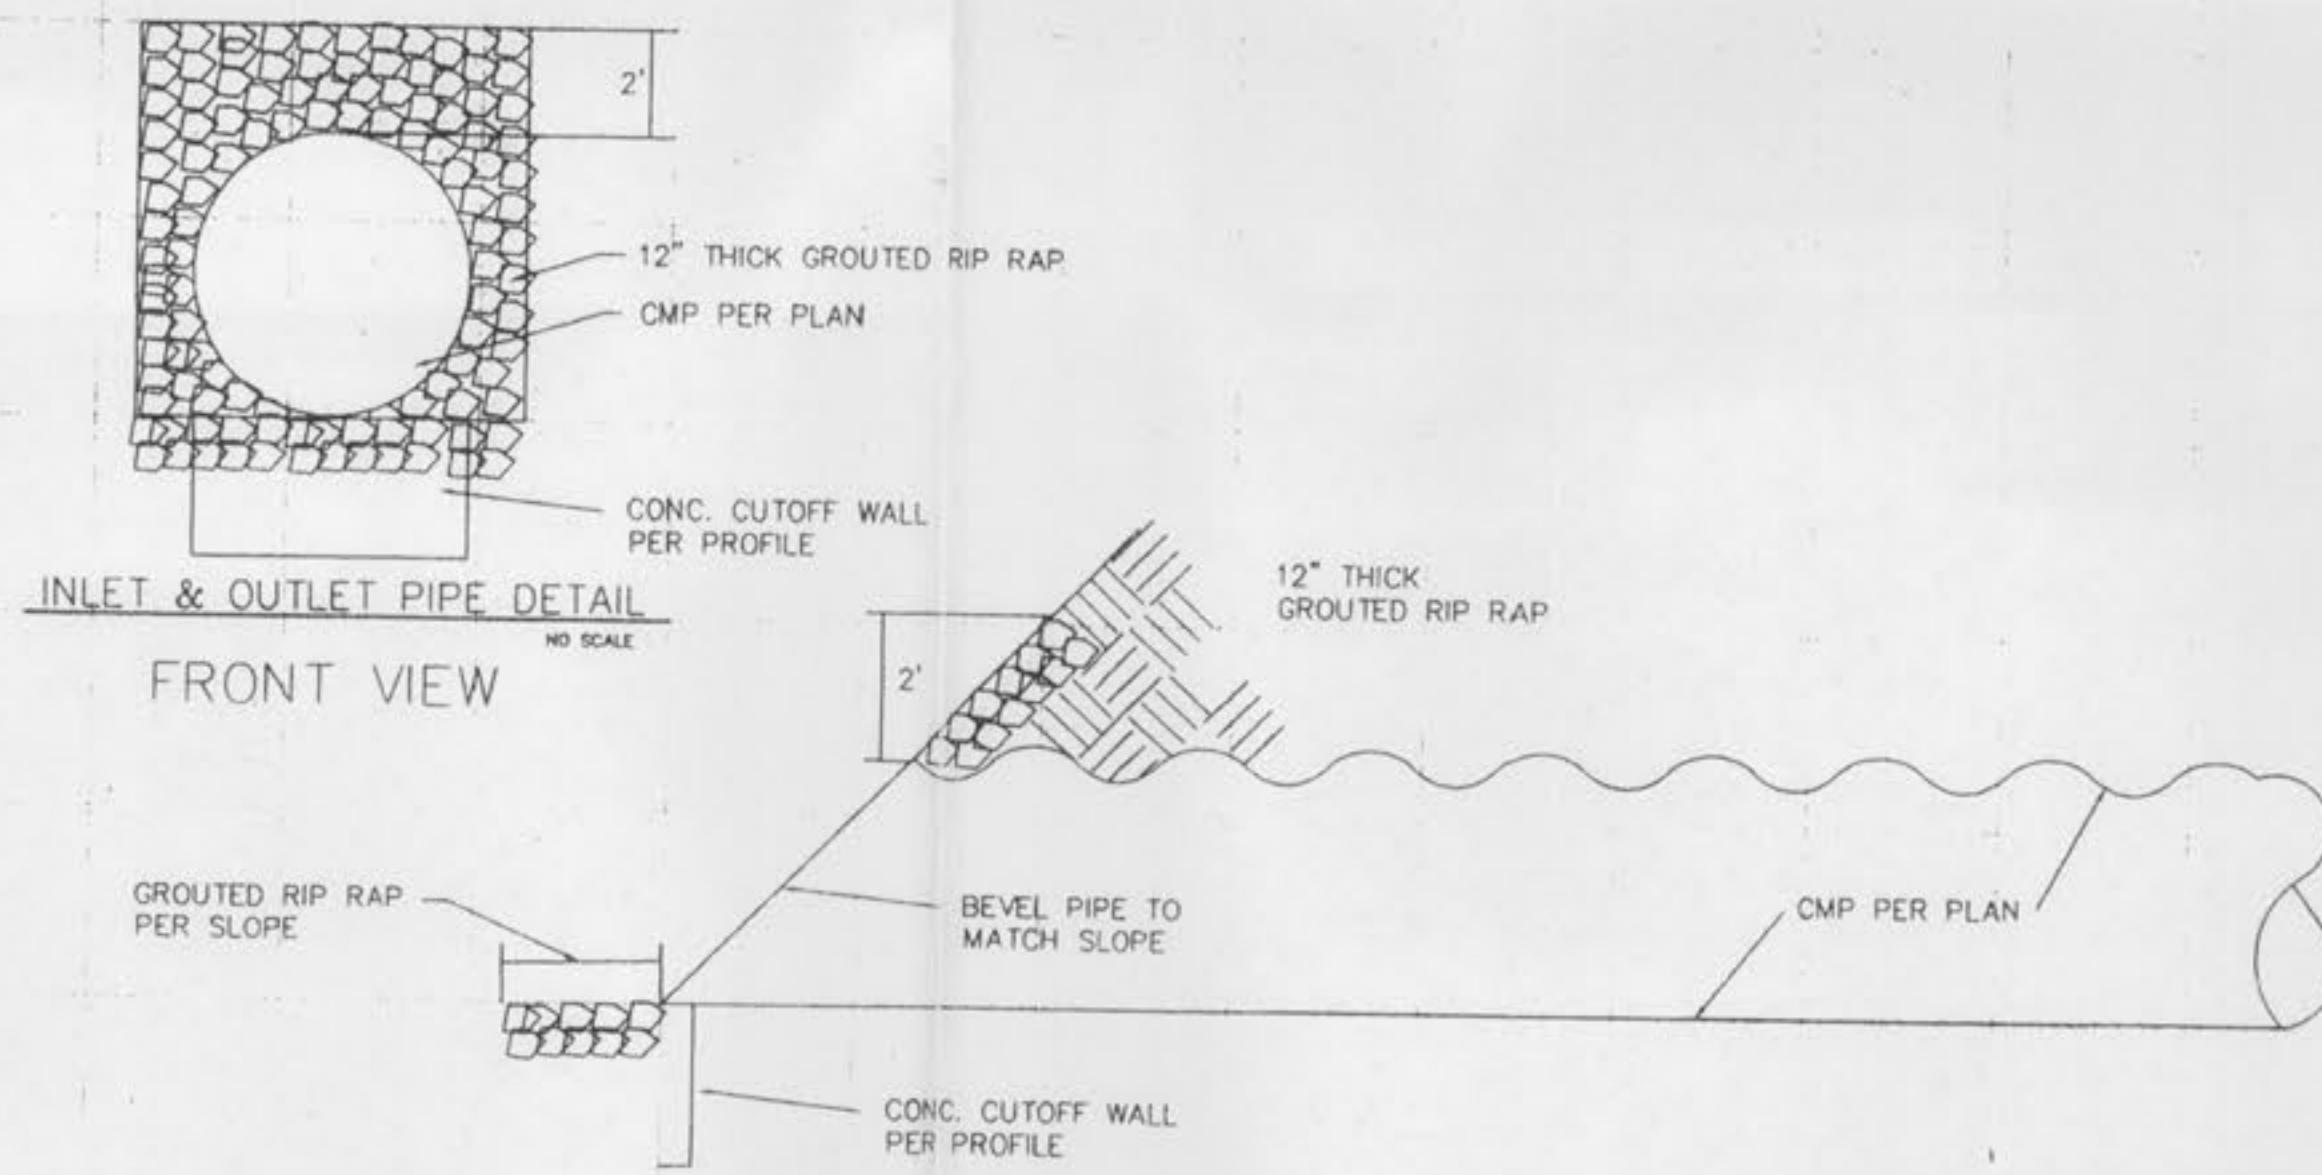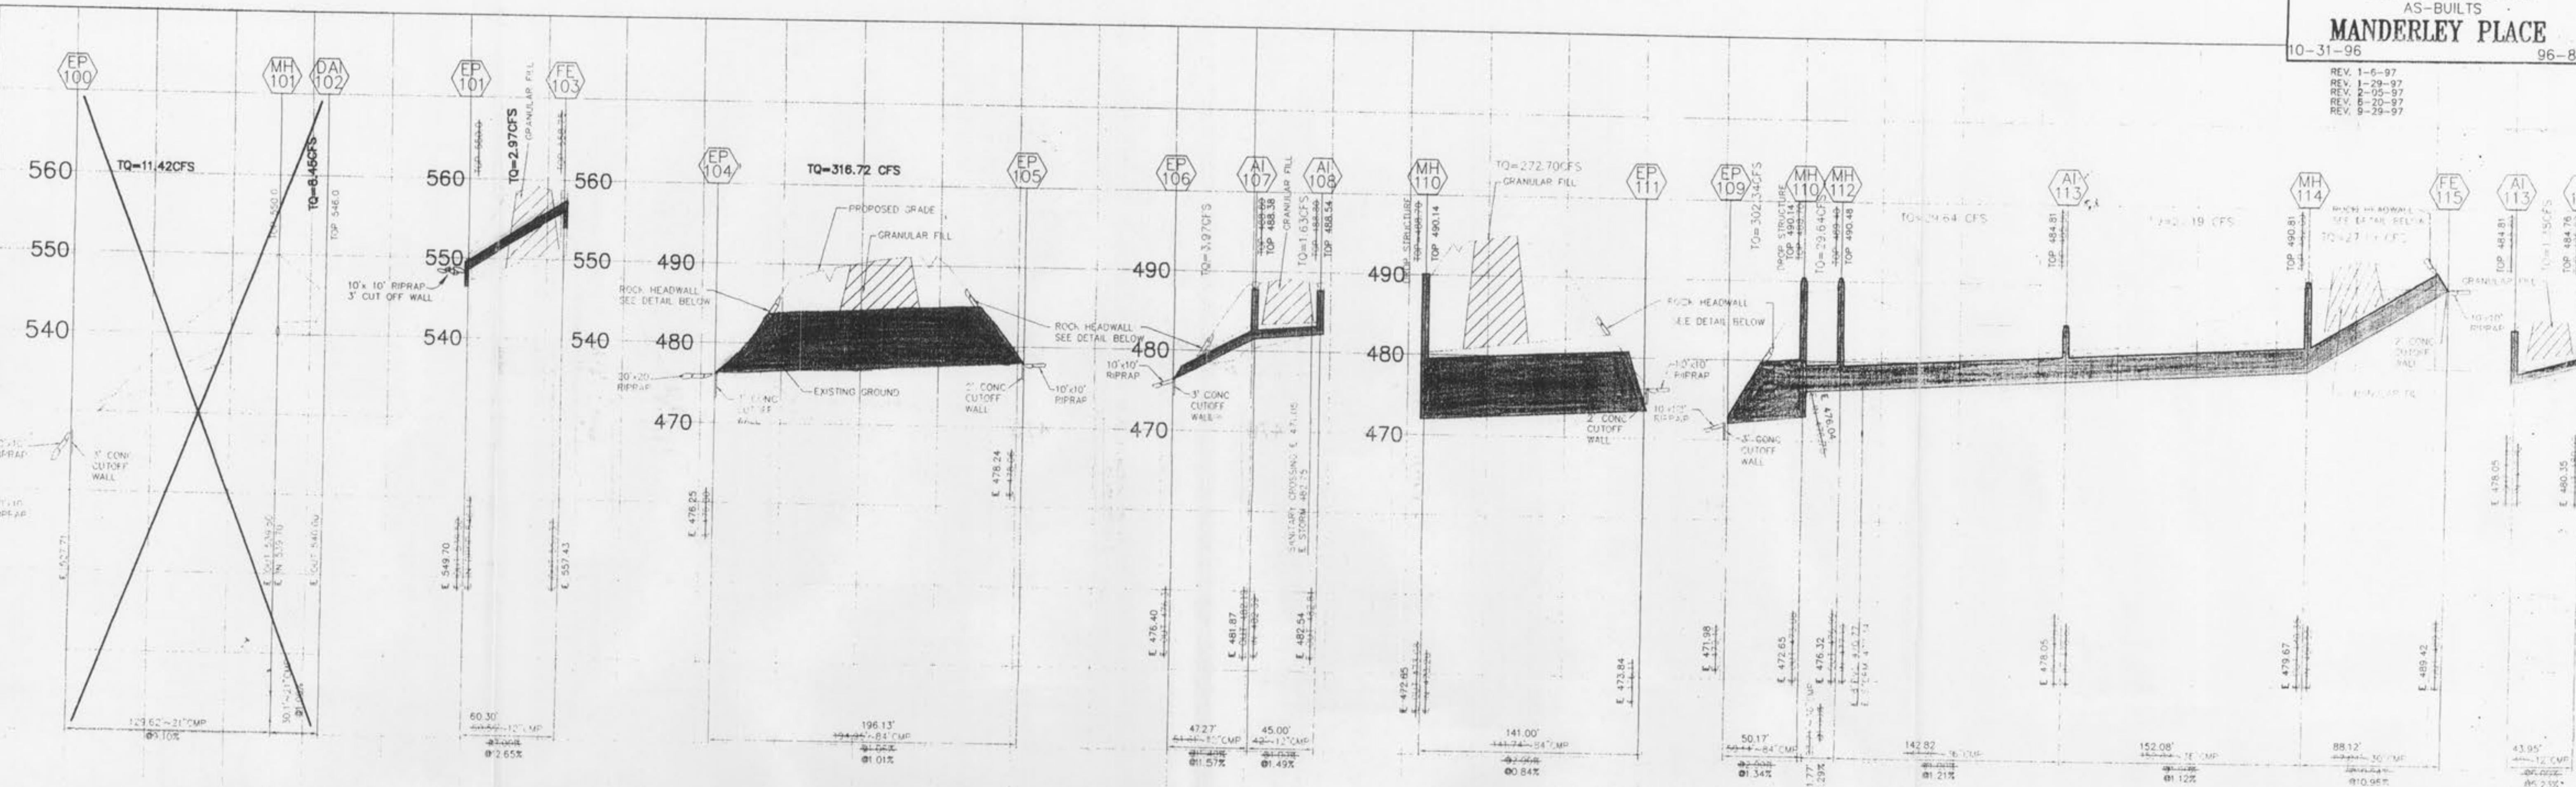

INLET & OUTLET PIPE DETAIL
NO SCALE

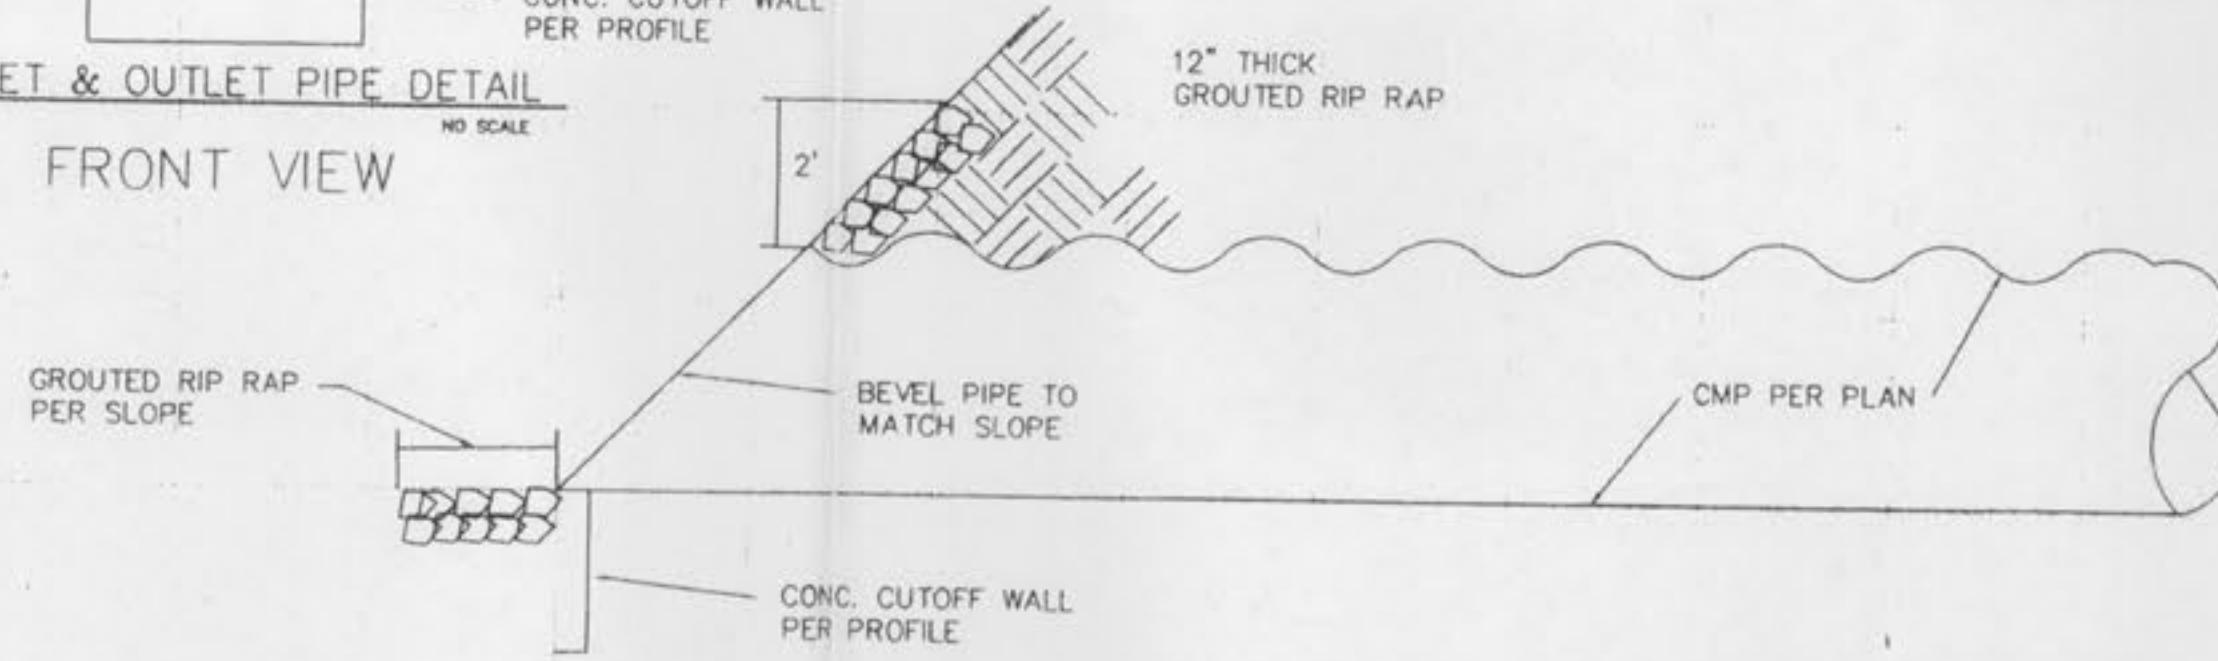

INLET & OUTLET PIPE DETAIL
NO SCALE

SCALE: 1" = 50' HORIZ
1" = 10' VERT

