


GENERAL NOTES

INDEX

1. Gas, water and other underground utilities shall not conflict with the depth or horizontal location of existing and proposed sanitary and storm sewers including house laterals.
 2. Underground utilities have been plotted from available information and therefore their locations must be considered approximate only. The verification of the location of all underground utilities, either shown or not shown on these plans shall be the responsibility of the contractor, and shall be located prior to grading or construction of improvements.
 3. Polyvinyl Chloride (PVC) shall conform to the requirements of ASTM D-3034 Standard Specifications for the PSM Polyvinyl Chloride (PVC) Sewer Pipe and Fittings, SDR 35.
 4. Storm sewers 18" diameter or smaller shall be A.S.T.M. C-14.
 5. Storm sewers 21" diameter or larger shall be A.S.T.M. C-76, Class II.
 6. All storm sewer pipe under pavement, regardless of size, shall be reinforced concrete pipe (A.S.T.M. C-76, Class II) unless noted otherwise on the plans.
 7. Corrugated metal pipe shall conform to the standard specifications for corrugated culvert pipe M 36, A.A.S.H.O.
 8. All filled places under buildings, proposed storm and sanitary sewer lines and/or paved areas including trench backfills shall be compacted to 90% of maximum density as determined by the "Modified A.A.S.H.O. T-180 Compaction Test" (A.S.T.M. D-1557) unless otherwise specified by local governing authority specifications. All tests shall be verified by a Soils Engineer.
 9. All filled places in paved State, County or City roads (Highways) shall be compacted to 90% of maximum density as determined by the "Standard Proctor Test A.A.S.H.O. T-99" (A.S.T.M. D-698) unless otherwise specified by local governing authority specifications. All tests shall be verified by a Soils Engineer.
 10. Trench backfills within the road right-of-way will be water jetted and granular backfill will be used under paved areas.
 11. Easements shall be provided for storm sewers, sanitary sewers and all utilities on the record plat. See record plat for location and size of easements. This does not apply to house laterals.
 12. No area shall be cleared without permission of the developer.
 13. All grade shall be within 0.2 feet more or less of those shown on the grading plan.
 14. No slope shall be greater than 2:1 and shall be either sodded or seeded and mulched.
 15. Barricades will consist of three standard 12"x 36" red and white striped scotchlite hazard markers mounted on two pound "U" channel sign post, with bottom of marker seven feet above pavement surface.
 16. All manhole and catch basin tops built without elevations furnished by the Engineer will be the responsibility of the sewer contractor. At the time of construction stake-out of the sewer lines, all curb and grate inlets will be face staked. If normal face stakes fall in line with sewer construction the Engineer will set these stakes on a double offset. It shall be the responsibility of the sewer contractor to preserve all face stakes from destruction.
 17. All standard street catch basins to have front of inlet 2 feet behind curb.
 18. The minimum vertical distance from the low point of the basement to the flowline of a sanitary sewer at the corresponding house connection shall not be less than the diameter of the sanitary sewer plus a vertical distance not less than two and one half feet (2-1/2').
 19. Water lines, valves, sleeves, meters and etc. shall meet all specifications and installation requirements of the local governing authority.
 20. All cast iron pipe for water mains shall conform to A.W.W.A. specification C-106 and/or C-108. The cast iron fittings shall conform to A.W.W.A. specification C-110. All rubber gasket joints for water cast iron pressure pipe and fittings shall conform to A.W.W.A. specification C-111.
 21. All water hydrants and valves shall be cast iron and installed in accordance with plans and details.
 22. All sanitary and storm sewers shall meet all specifications and installation requirements of the local governing authority.
 23. All P.V.C. water pipe shall have a minimum pressure rating of PR-200 or SDR-21.
 24. All P.V.C. sanitary sewer pipe to be DR-35 or equal with crushed stone bedding uniformly graded between 1" and 1/4" size. This bedding shall extend from 6" below the pipe to 7/10 of the pipe dia. above the bottom of the pipe.
 25. All grading on Missouri State Highway Right-of-Way shall be seeded and mulched and all disturbed Right-of-Way Markers shall be reset at the completion of grading.

MAR-TON ESTATES

PART OF N.E. 1/4 FRAC. SEC. 5, T 46 N,
R 3 E, ST. CHARLES COUNTY, MISSOURI.

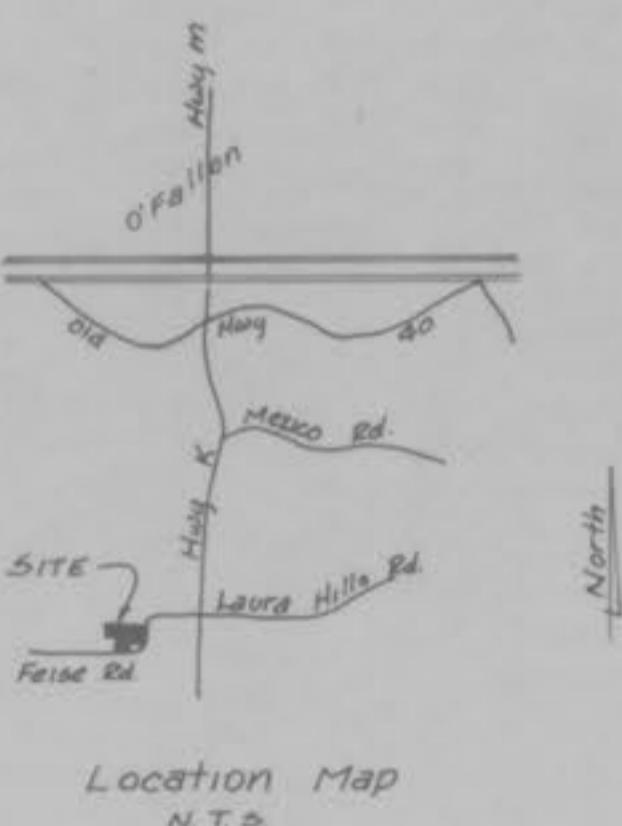


Location Map

Benchmark :
PK nail in power pole
across from Amarillo Village.
Elev : 121.97

LEGEND

<i>C.B.</i>	<i>Catch basin</i>
<i>D.C.B.</i>	<i>Double catch basin</i>
<i>Y.C.B.</i>	<i>Yard catch basin</i>
<i>2G.C.B.</i>	<i>Two grate catch basin</i>
<i>M.H.</i>	<i>Manhole</i>
<i>F.E.</i>	<i>Flared end section</i>
<i>E.P.</i>	<i>End pipe</i>
<i>C.P.</i>	<i>Concrete pipe</i>
<i>R.C.P.</i>	<i>Reinforced concrete pipe</i>
<i>C.M.P.</i>	<i>Corrugated metal pipe</i>
<i>C.I.P.</i>	<i>Cast iron pipe</i>
<i>P.V.C.</i>	<i>Polyvinyl chloride pipe</i>
<i>V.C.P.</i>	<i>Vitrified clay pipe</i>
<i>C.O.</i>	<i>Clean out</i>
<i>V.T.</i>	<i>Vent trap</i>
—■—	<i>Storm sewer</i>
—●—	<i>Sanitary sewer</i>
—-530---	<i>Existing contour</i>
—530—	<i>Proposed contour</i>
#	<i>Street sign</i>
—	<i>End of lateral</i>
↑ —	<i>Lateral</i>
5	<i>Lot or building number</i>
(11.2)	<i>Depth of rock</i>
—x—x—	<i>Existing fence line</i>
<i>wave</i>	<i>Existing tree line</i>

PICKETT, RAY & SILVER		CIVIL ENGINEERS LAND SURVEYORS	GRADE	WATER (SFT. 511)	B.L.
REV	DATE	grading & storm sewer			16
					CHKD
PREPARED FOR -					
Anthony D. Keeven 2896 Highway K O'Fallon, MO. 63366 (314) 272-5111					
DRAWN BY <u>SMITH, JR.</u> DATE <u>Jan. 1984</u>					
CHECKED BY _____ DATE _____					

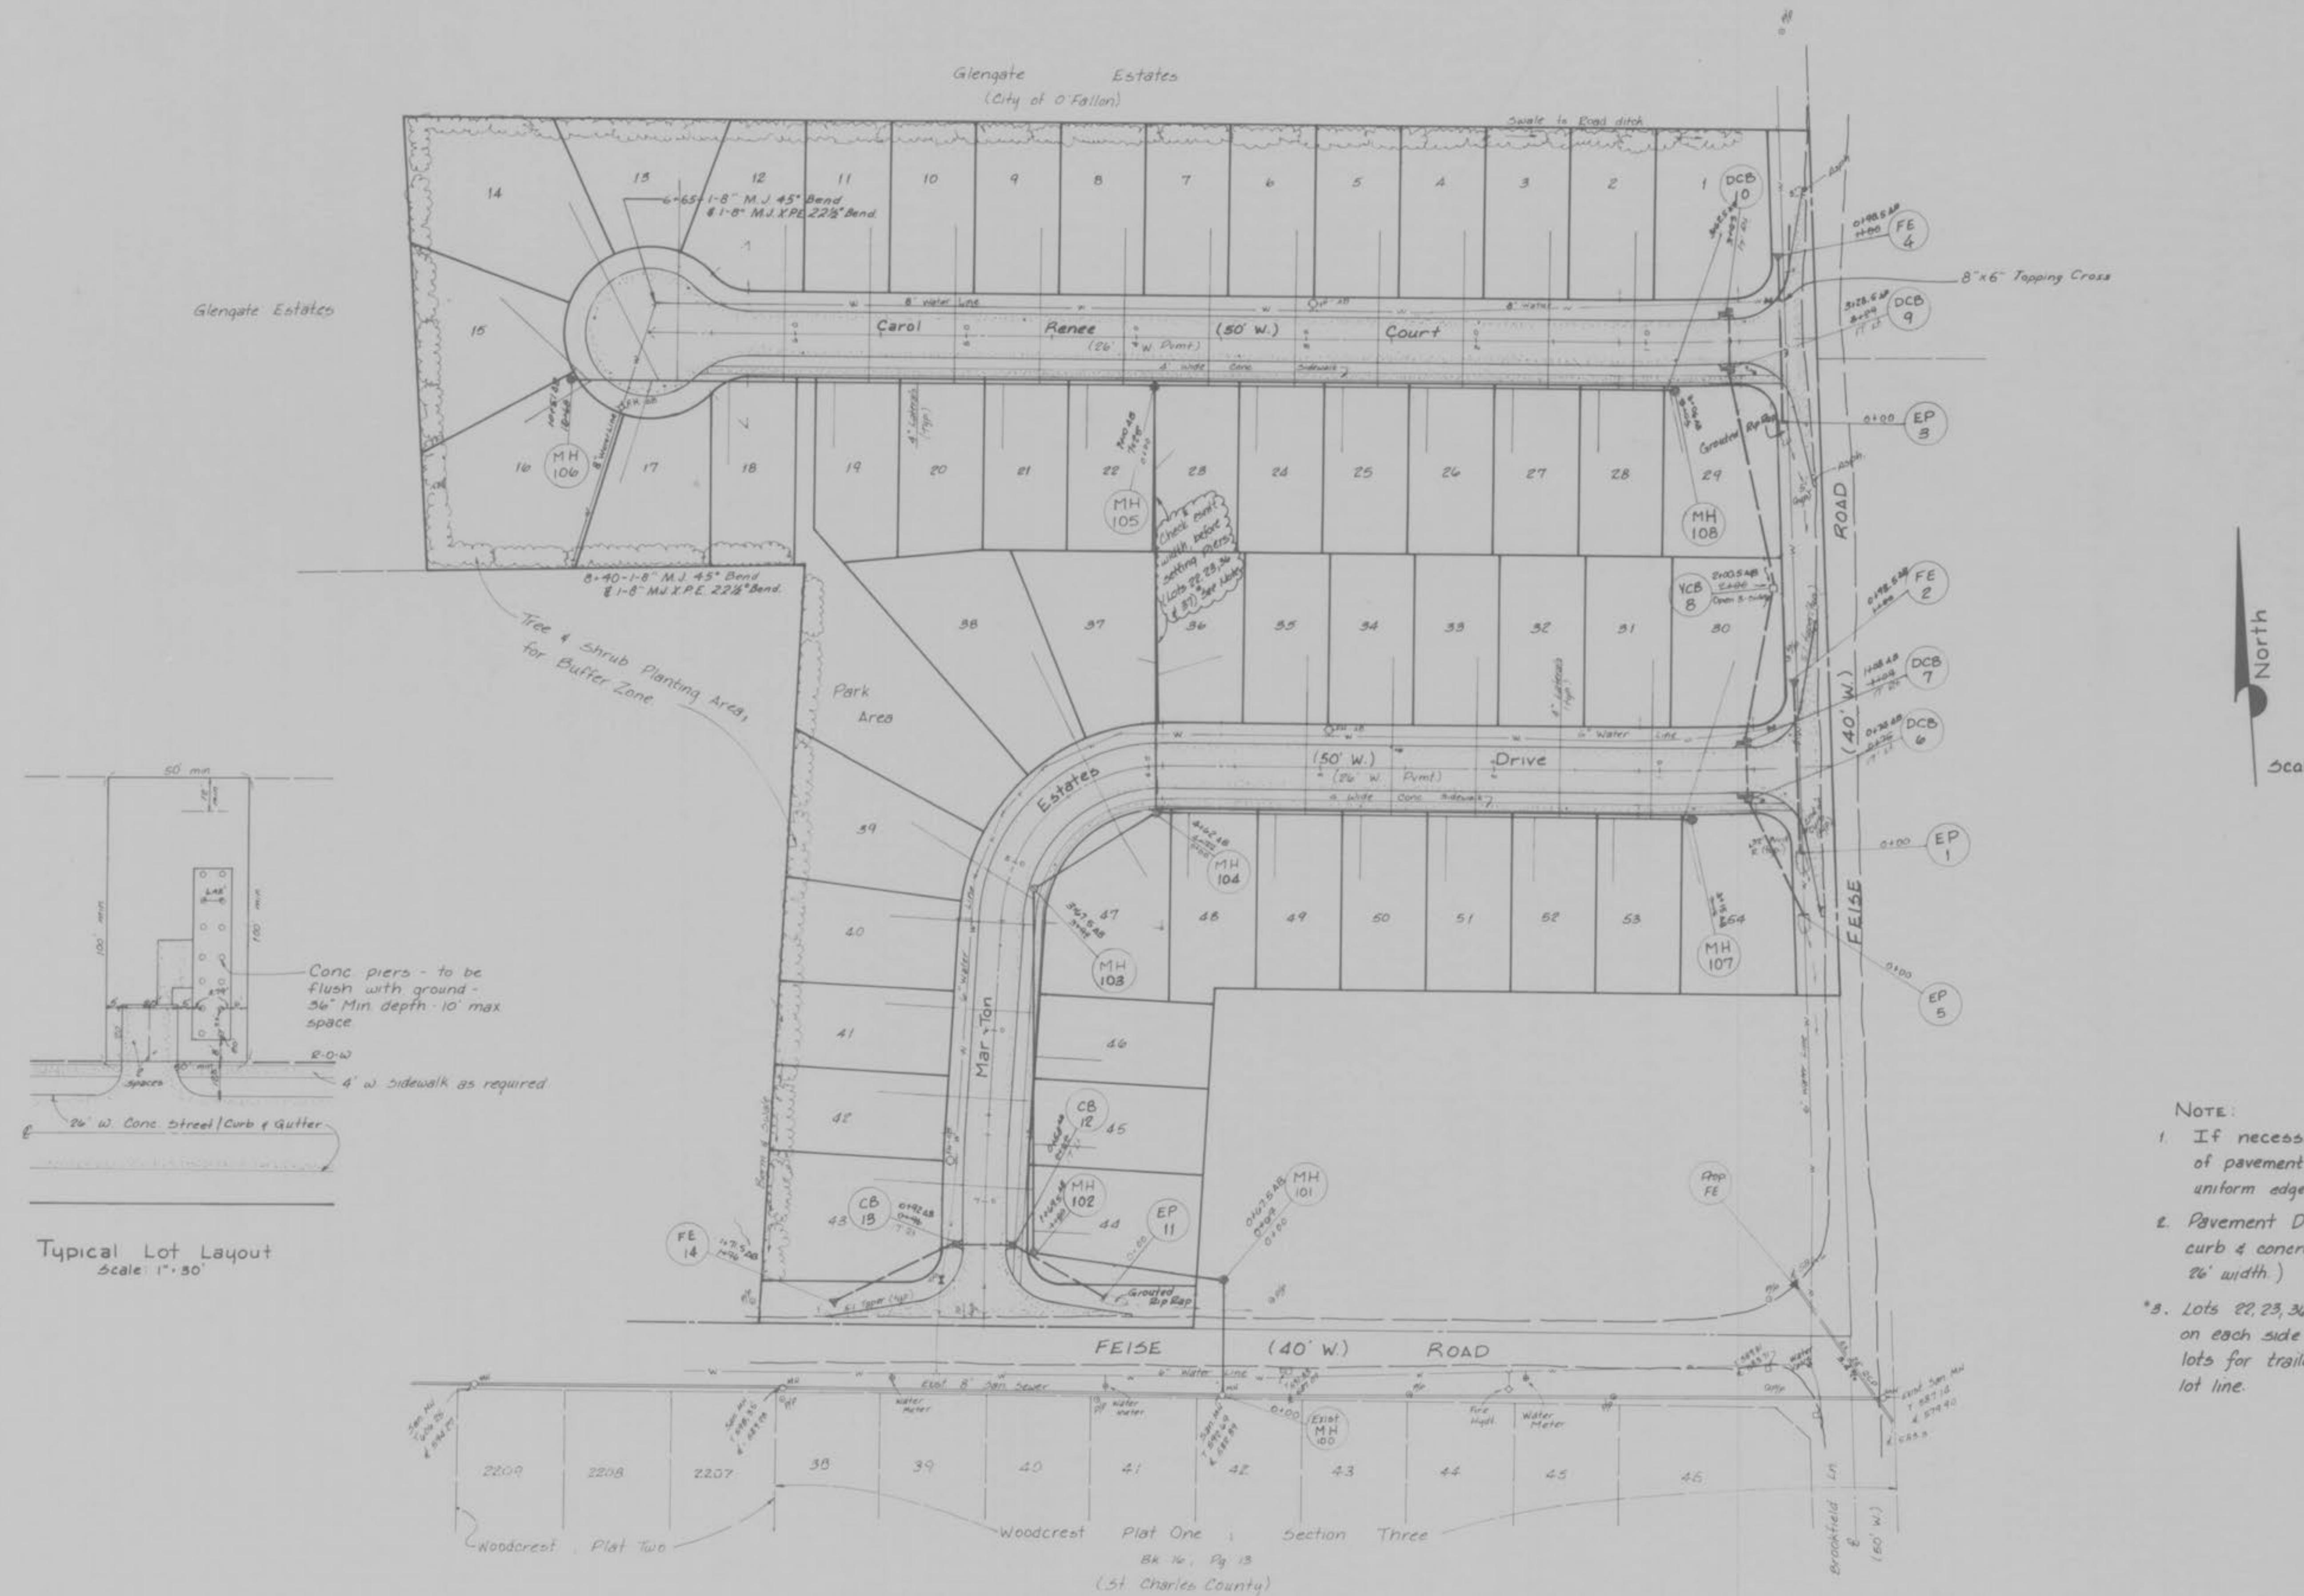


- NOTE:**
1. If necessary saw-cut existing edge of pavement to obtain smooth unbroken uniform edge.
 2. Pavement Detail sheet II of II, Integral curb & concrete pavement. (Section - 26' width.)
 3. Lots 22, 23, 36 & 37 have an easement of 7.5' on each side of the lot line. When preparing lots for trailers, move piers 1.5' further from lot line.

Sanitary sewer Profiles
MAR-TON EST.

Jan. 1984 88-080

As-Built 12-11-84 66

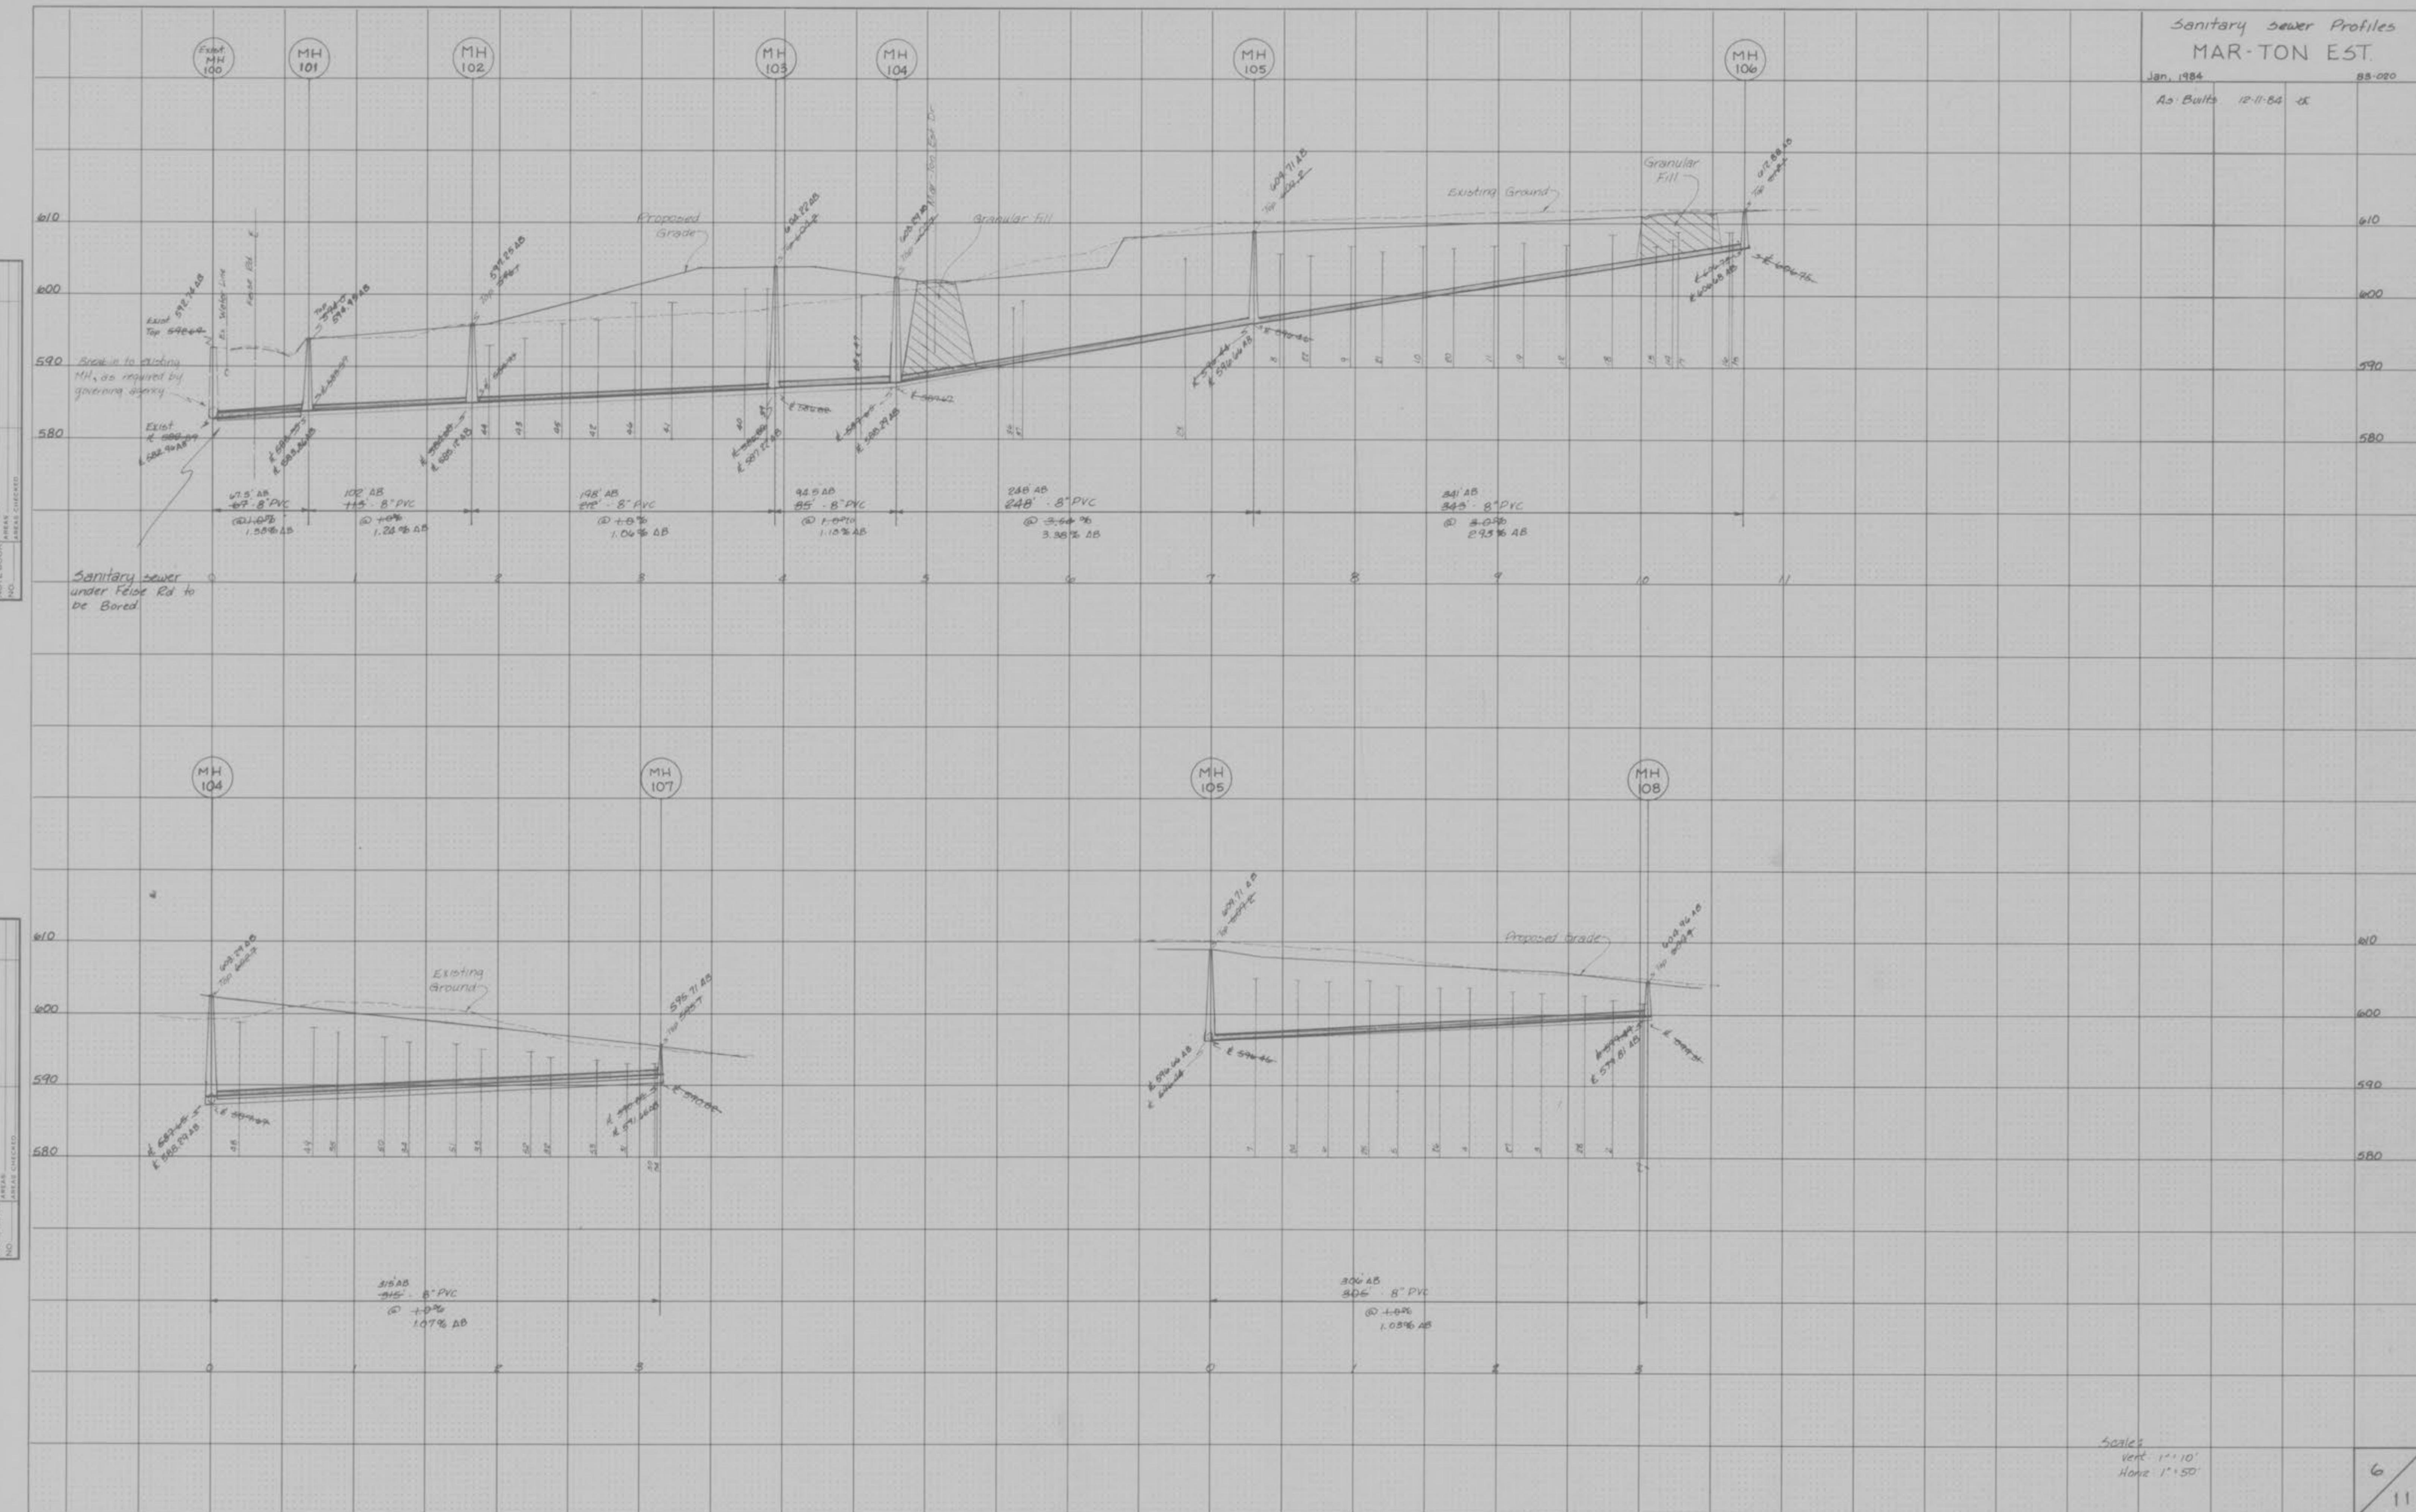

Storm Sewer Profiles

MAR-TON EST

Jan. 1984

83-020

As-built 12-11-84 JK