





Engineering Surveys & Services
DELIVERING YOUR VISION™

1113 Fay Street, Columbia, MO 65201
573-449-2646
802 El Dorado Drive, Jefferson City, MO 65101
573-636-3303
1775 West Main Street, Sedalia, MO 65301
660-826-8618
www.es-inc.com
MO Land Surveying Corp. # 2004004672

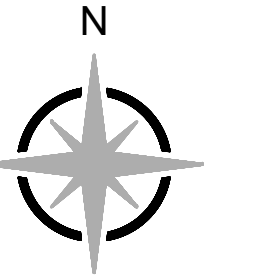

0 1'
SCALE: 1" = 30'

JES DEVELOPMENT CO. INC.
MEADOWOOD ESTATES
O'FALLON, ST. CHARLES COUNTY, MISSOURI

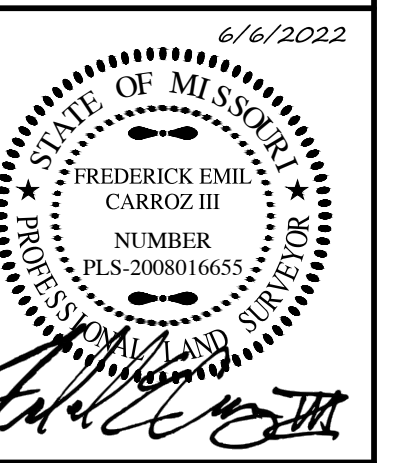

FREDERICK E. CARROZ III
PROFESSIONAL LAND SURVEYOR
PLS - 2008016655

IF ORIGINAL SIGNATURE OR DIGITAL AUTHENTICATION IS NOT PRESENT THIS MEDIA SHOULD NOT BE CONSIDERED A CERTIFIED DOCUMENT.

Date
JUNE 6, 2022

Revised

Surveyed: NTL Drawn: CGH
WATER & LIGHT
STANDARD AS-BUILT

Sheet

V1.02

2 of 12

ES&S PROJECT NO. 15421



P:\GENERAL PROJECTS\15421-ES-MEADOWOOD-POST-CONST-ALTA\CAD\15421-AS-BUILT.DWG 6/6/2022




Engineering Surveys & Services

DELIVERING YOUR VISION™


1113 Fay Street, Columbia, MO 65201
973-449-2646
602 El Dorado Drive, Jefferson City, MO 65101
673-636-3303
1775 West Main Street, Sedalia, MO 65301
660-826-8618
www.ess-inc.com

MO Land Surveying Corp. # 2004004672

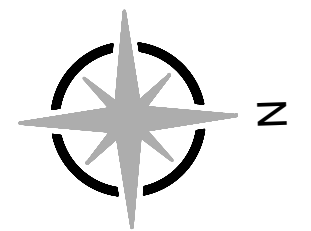

0 1'
SCALE: 1" = 30'

JES DEVELOPMENT CO. INC.
MEADOWOOD ESTATES
O'FALLON, ST. CHARLES COUNTY, MISSOURI

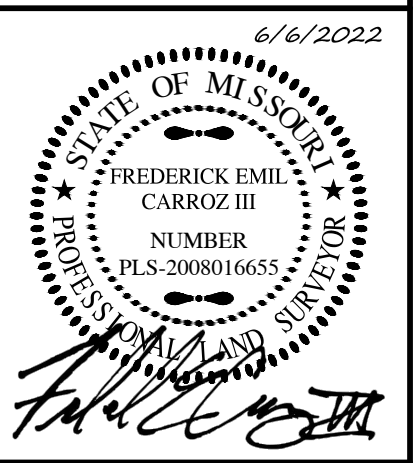

FREDERICK E. CARROZ III
PROFESSIONAL LAND SURVEYOR
PLS - 2008016655

IF ORIGINAL SIGNATURE OR DIGITAL AUTHENTICATION IS NOT PRESENT THIS MEDIA SHOULD NOT BE CONSIDERED A CERTIFIED DOCUMENT.

Date
JUNE 6, 2022

Revised

Surveyed: NTL Drawn: CGH



SANITARY SEWER AS-BUILT

Sheet

V1.04


4 of 12

ESS&S PROJECT NO. 15421

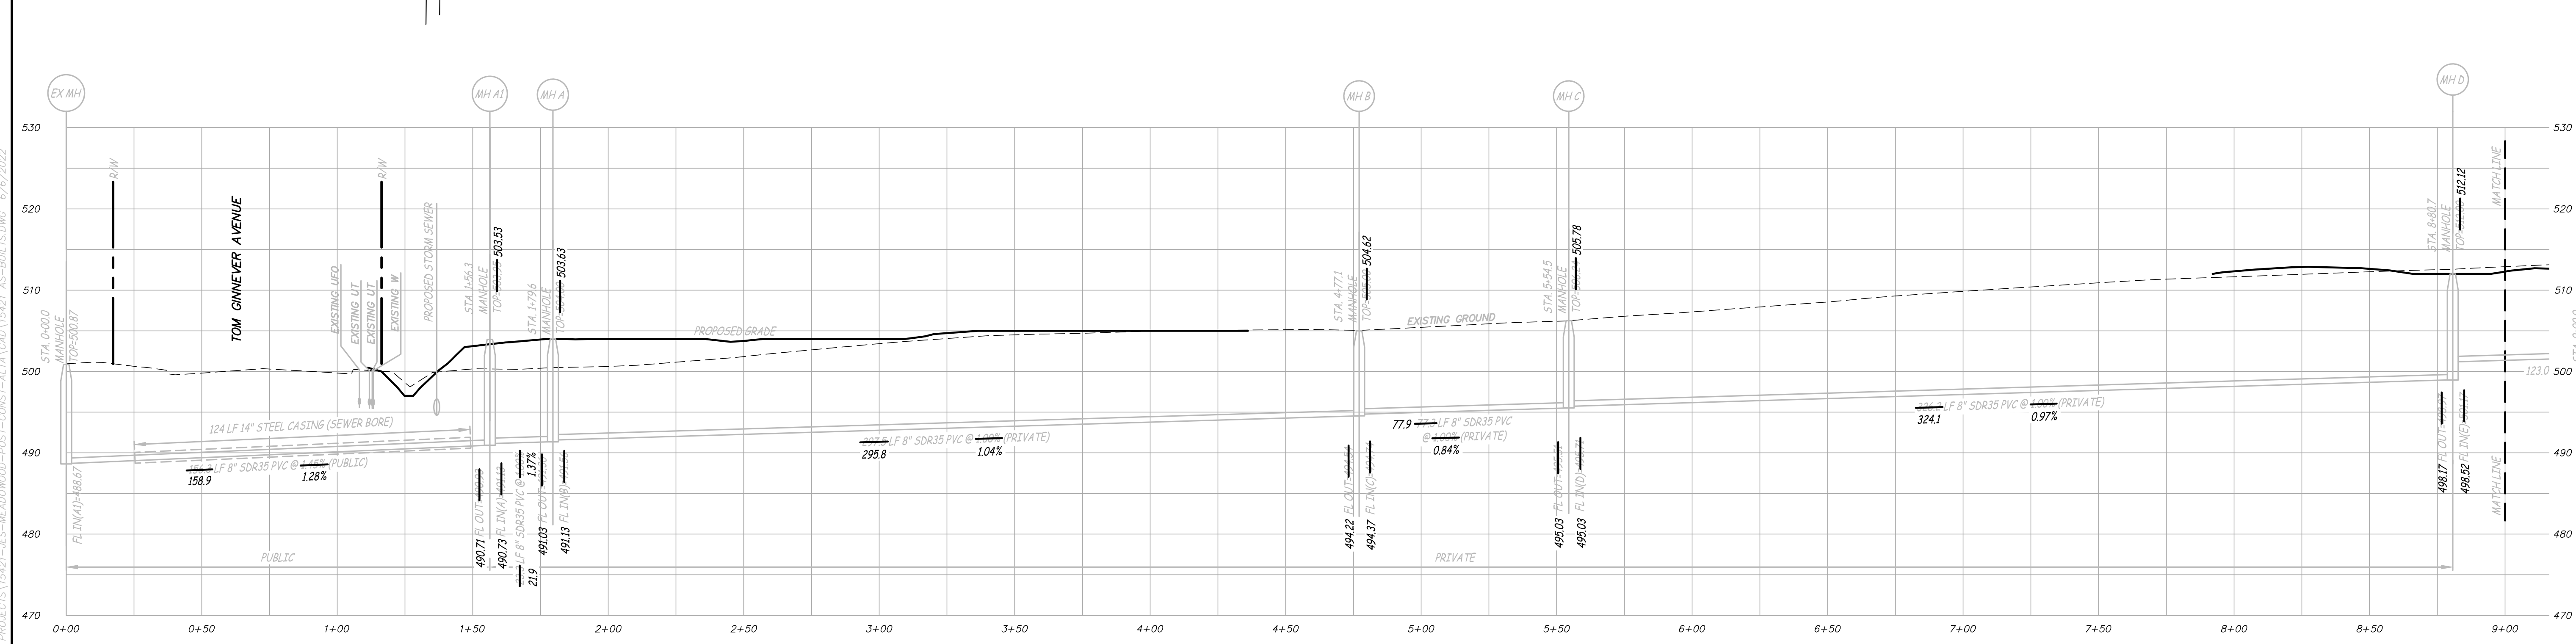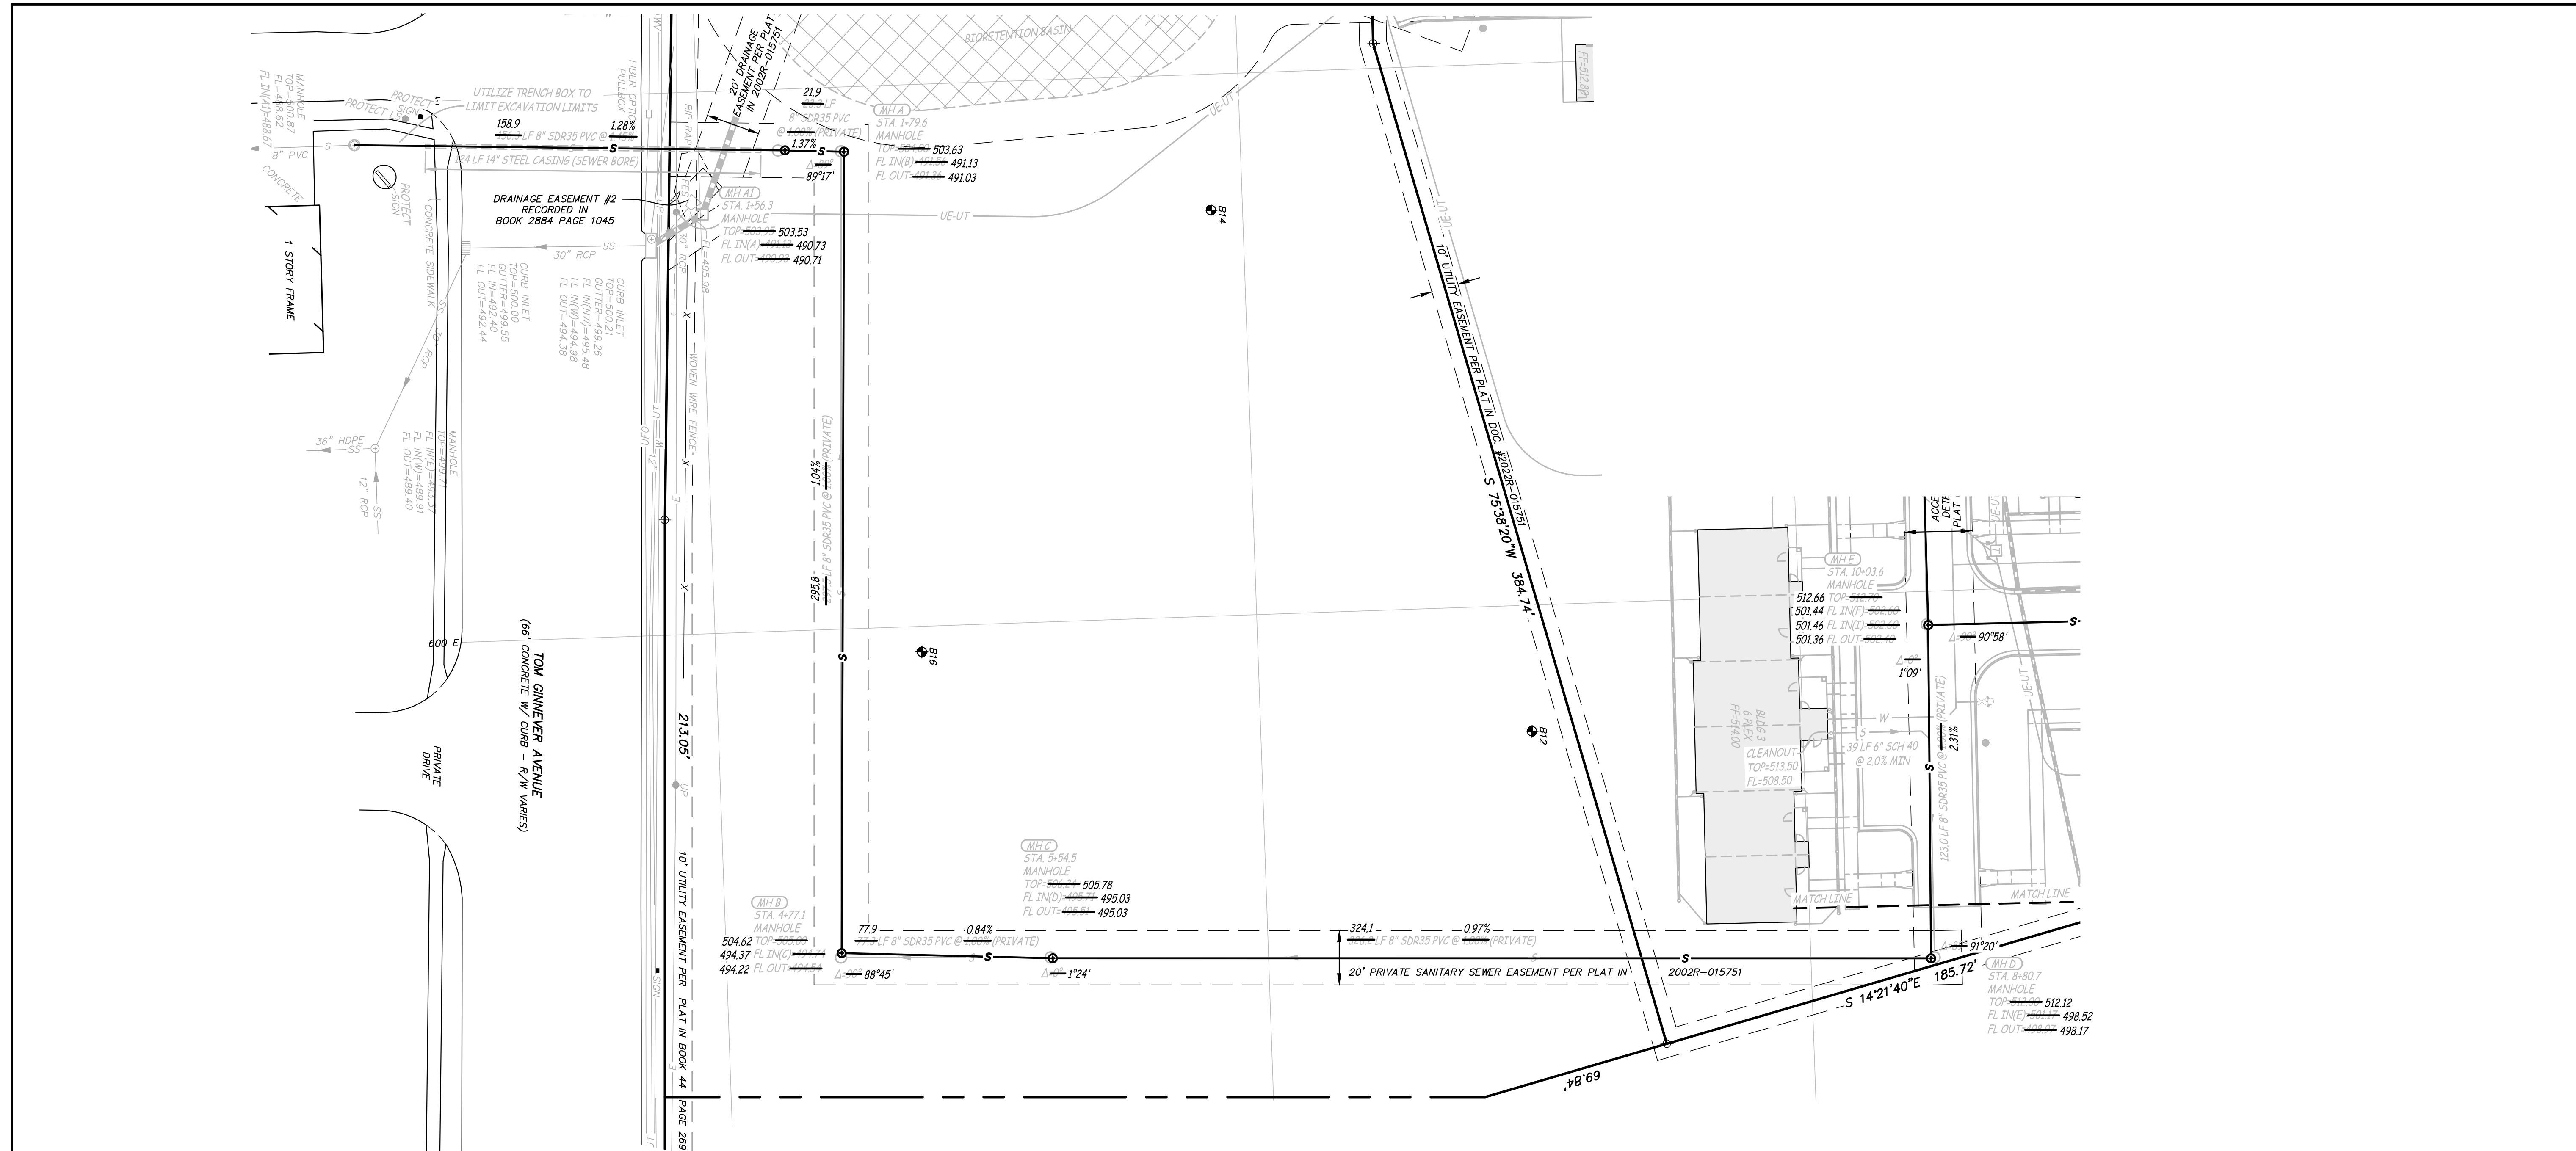


EX MH THRU MH H
SCALE - HORIZ. 1" = 30'
VERT. 1" = 10'

P:\GENERAL PROJECTS\15421-ES-MEADOWOOD-POST-CONST-ALTA\CAD\15421_AS-BUILT.DWG 6/6/2022

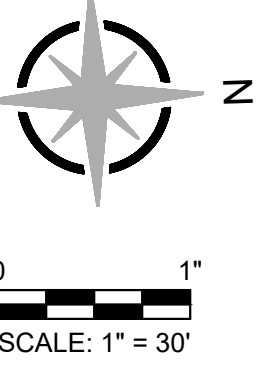

JES DEVELOPMENT CO. INC.
MEADOWOOD ESTATES
 O'FALLON, ST. CHARLES COUNTY, MISSOURI

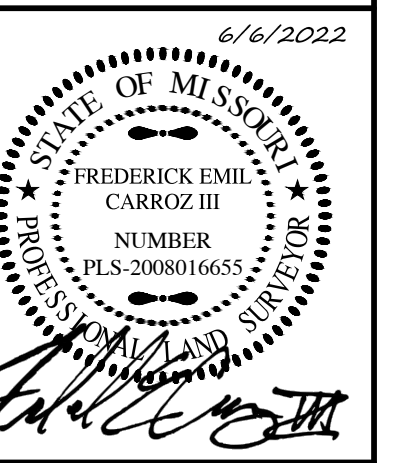

FREDERICK E. CARROZ III
 PROFESSIONAL LAND SURVEYOR
 PLS - 2008016655

Date
JUNE 6, 2022



Revised

Surveyed: NTL Drawn: CGH

SANITARY SEWER AS-BUILT


Sheet
V1.05

5 of 12
 ES&S PROJECT NO. 15421

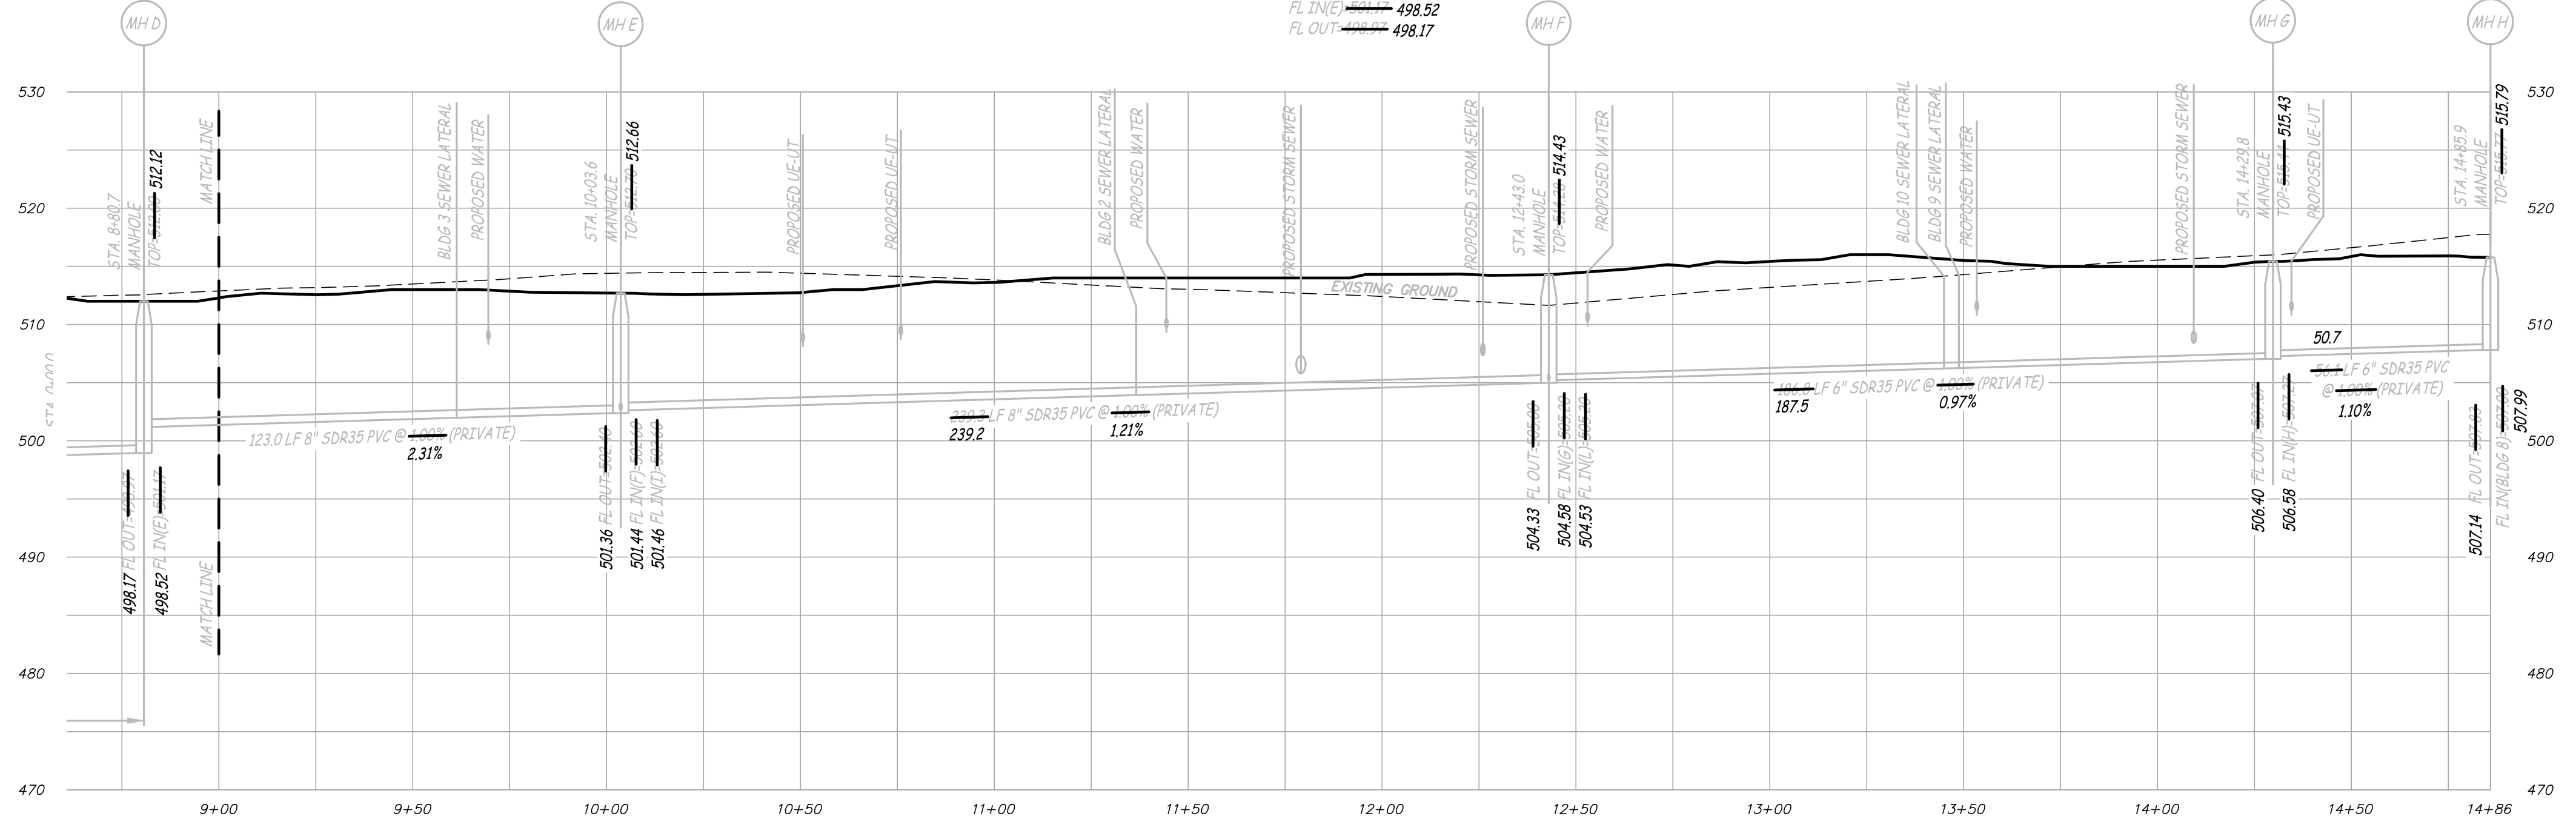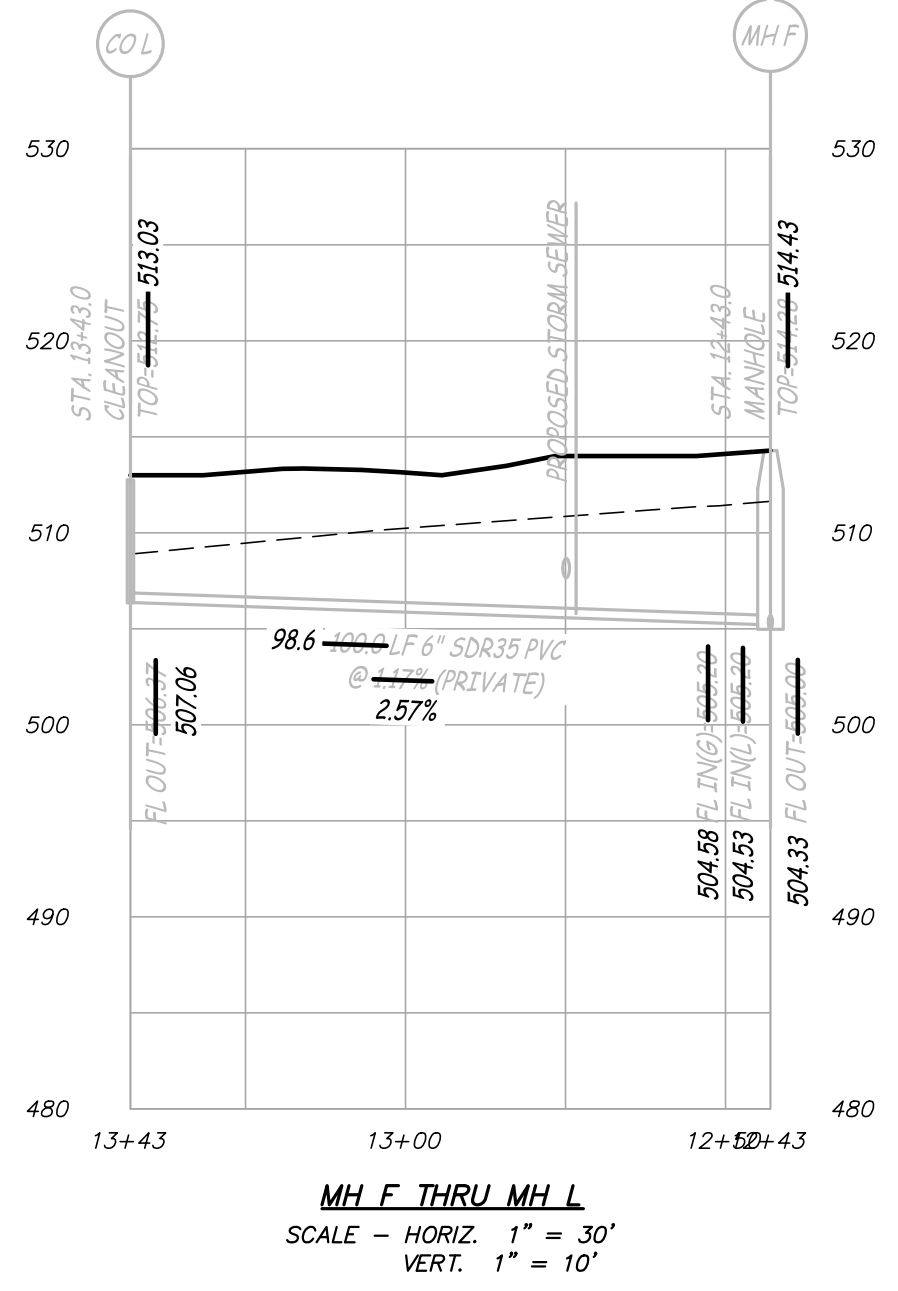


EX MH THRU MH H
 SCALE - HORIZ. 1" = 30'
 VERT. 1" = 10'

P:\GENERAL PROJECTS\15421-JES-MEADOWOOD-POST-CONST-ALTA\CAD\15421 AS-BUILTS.DWG 6/6/2022

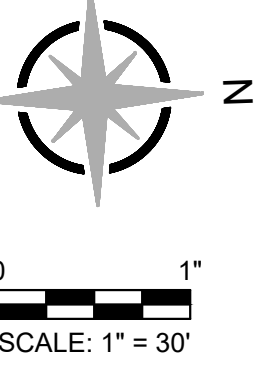

JES DEVELOPMENT CO. INC.
MEADOWOOD ESTATES
 O'FALLON, ST. CHARLES COUNTY, MISSOURI

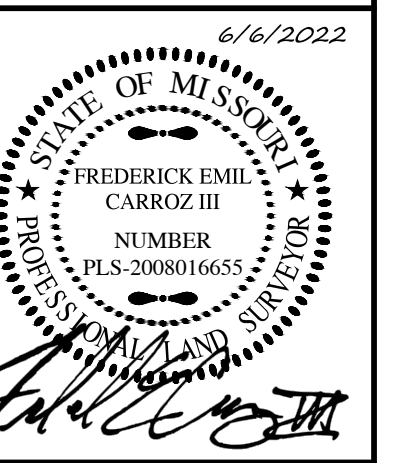

FREDERICK E. CARROZ III
 PROFESSIONAL LAND SURVEYOR
 PLS - 2008016655

IF ORIGINAL SIGNATURE OR DIGITAL AUTHENTICATION IS NOT PRESENT THIS MEDIA SHOULD NOT BE CONSIDERED A CERTIFIED DOCUMENT.

Date
JUNE 6, 2022

Revised


Surveyed: NTL Drawn: CGH

STORM SEWER AS-BUILT


Sheet
V1.07

7 of 12


ES&S PROJECT NO. 15421

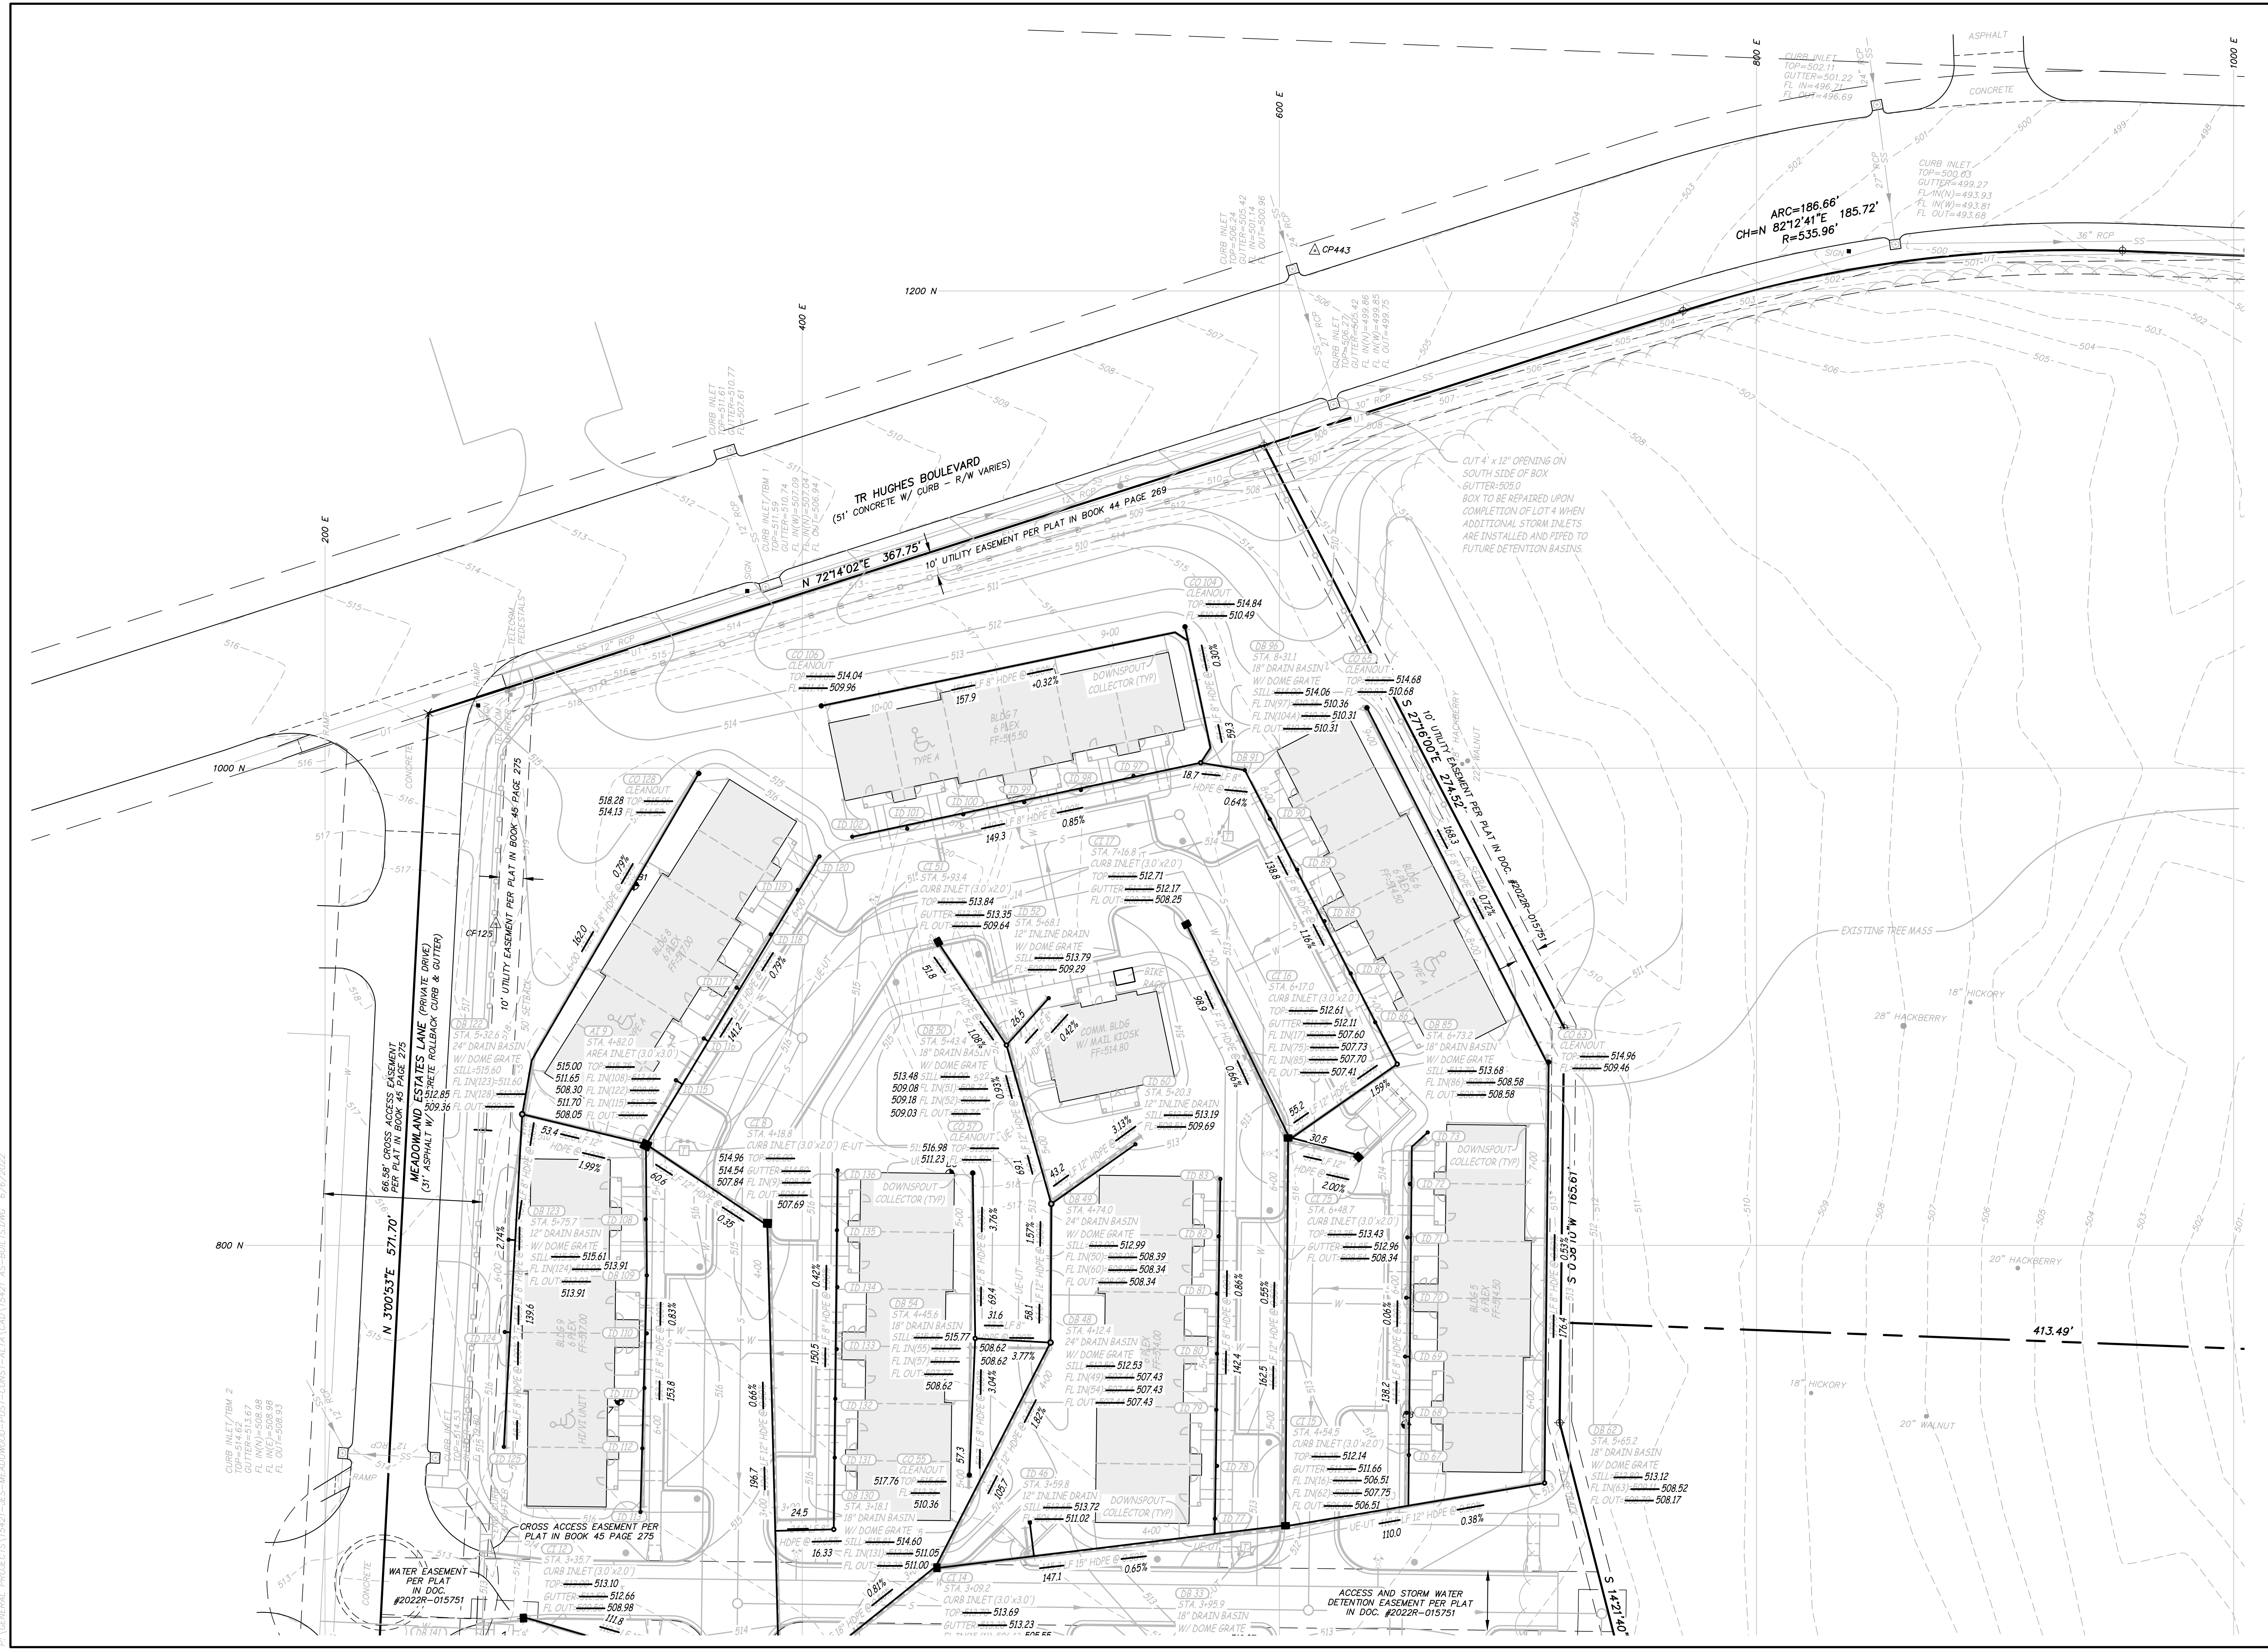

P:\GENERAL PROJECTS\15421-ES-MEADOWOOD-POST-CONV-ALTA\CD\15421_AS-BUILT.DWG 6/6/2022

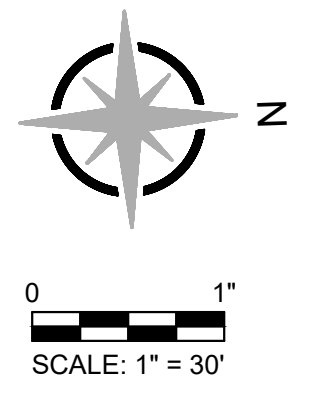

JES DEVELOPMENT CO. INC.
MEADOWWOOD ESTATES
 O'FALLON, ST. CHARLES COUNTY, MISSOURI

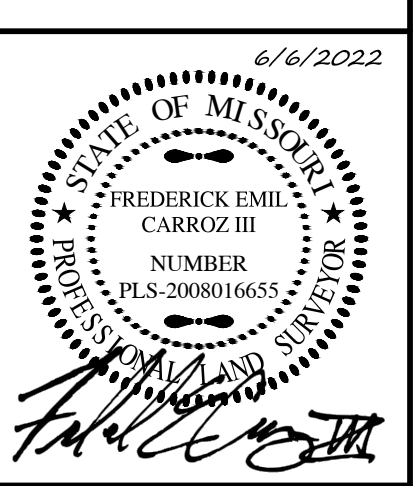

FREDERICK E. CARROZ III
 PROFESSIONAL LAND SURVEYOR
 PLS - 2008016655

IF ORIGINAL SIGNATURE OR DIGITAL AUTHENTICATION IS NOT PRESENT THIS MEDIA SHOULD NOT BE CONSIDERED A CERTIFIED DOCUMENT.

Date
JUNE 6, 2022

Revised

Surveyed: NTL Drawn: CGH


STORM SEWER AS-BUILT

Sheet


V1.08

8 of 12


ES&S PROJECT NO. 15421

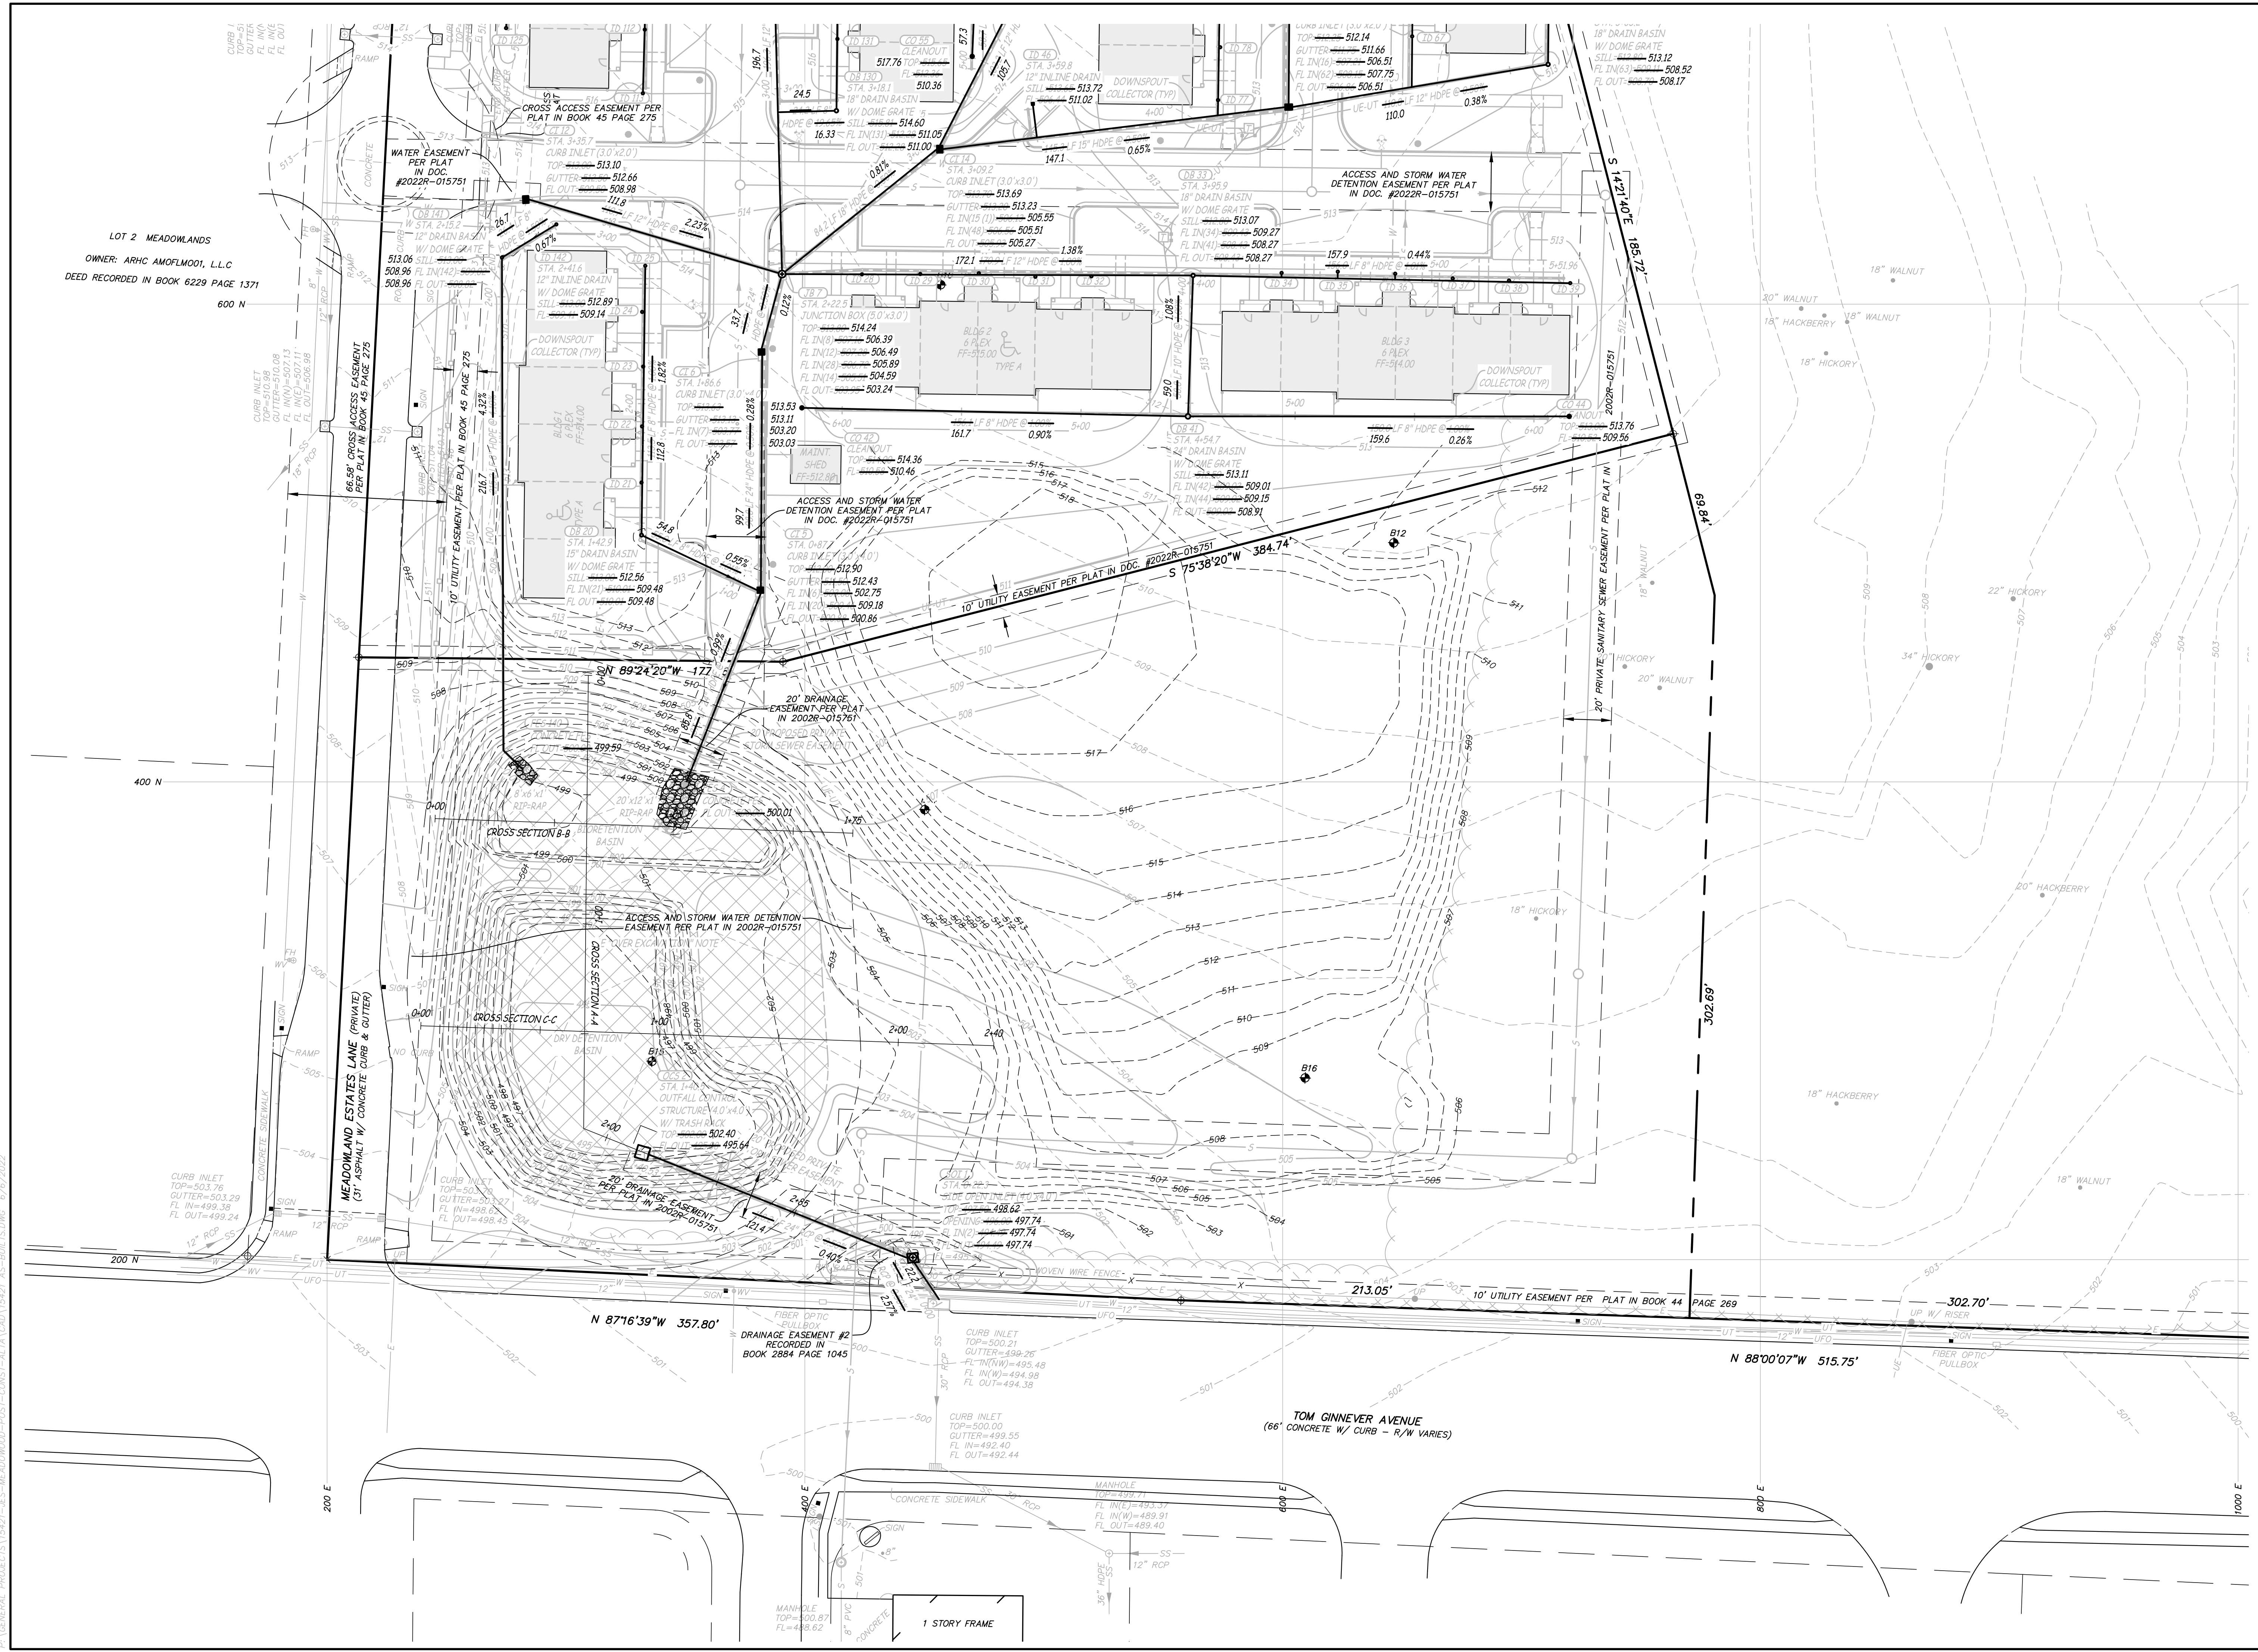


P:\GENERAL PROJECTS\15421-ES-MEADOWWOOD-POST-CONST-ALTA\CAD\15421-AS-BUILT.DWG 6/6/2022

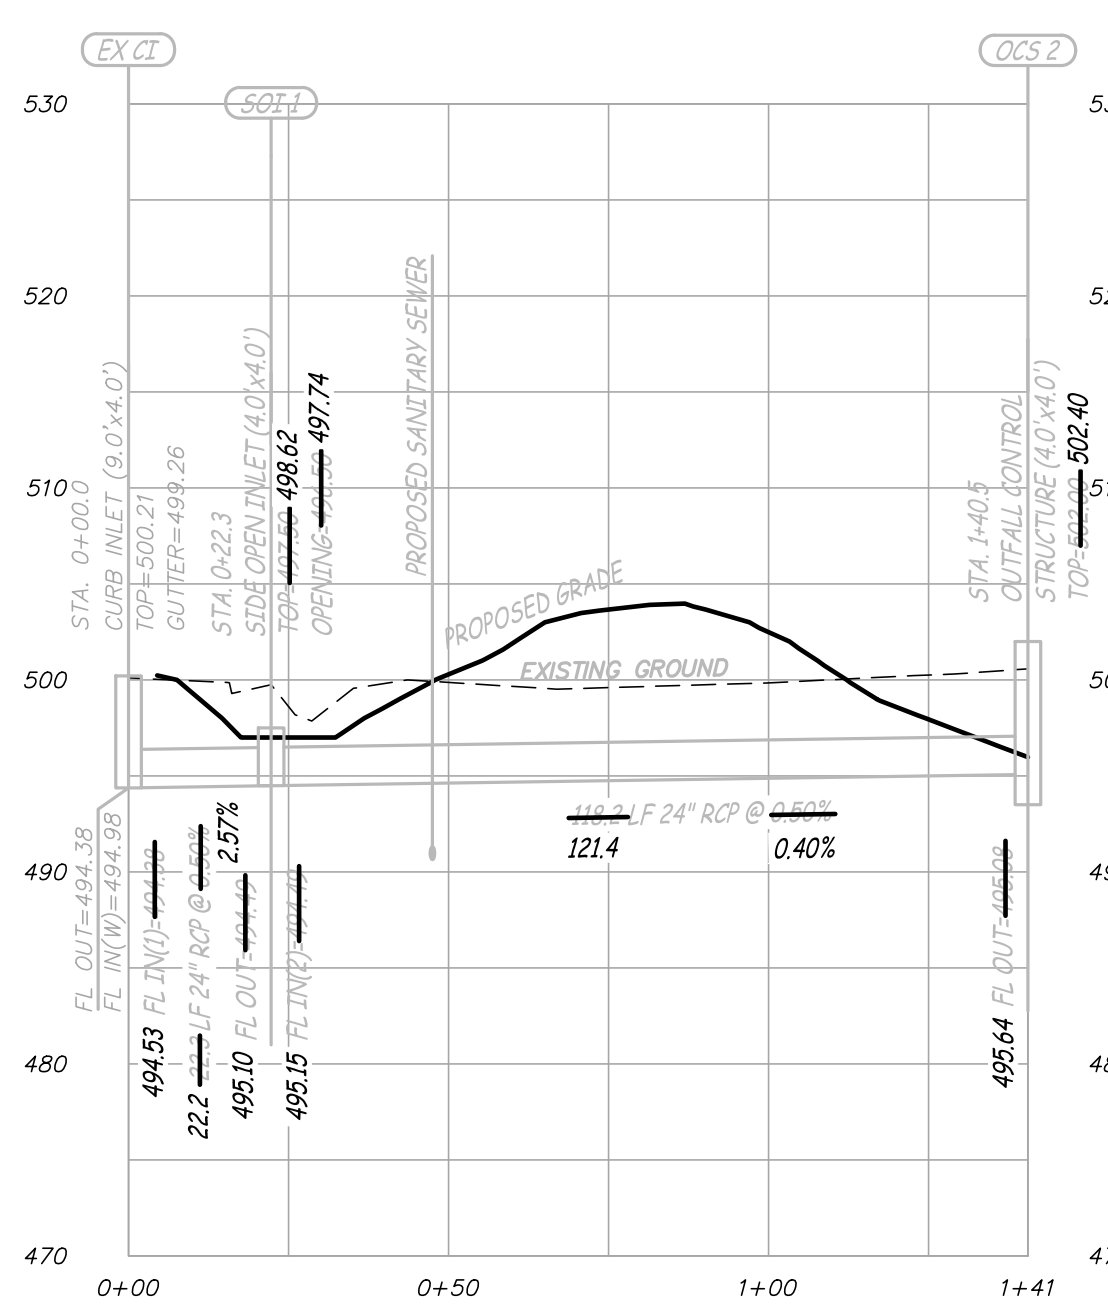


EX CI THRU OCS 2 (PRIVATE)
 SCALE - HORIZ. 1" = 30'
 VERT. 1" = 10'

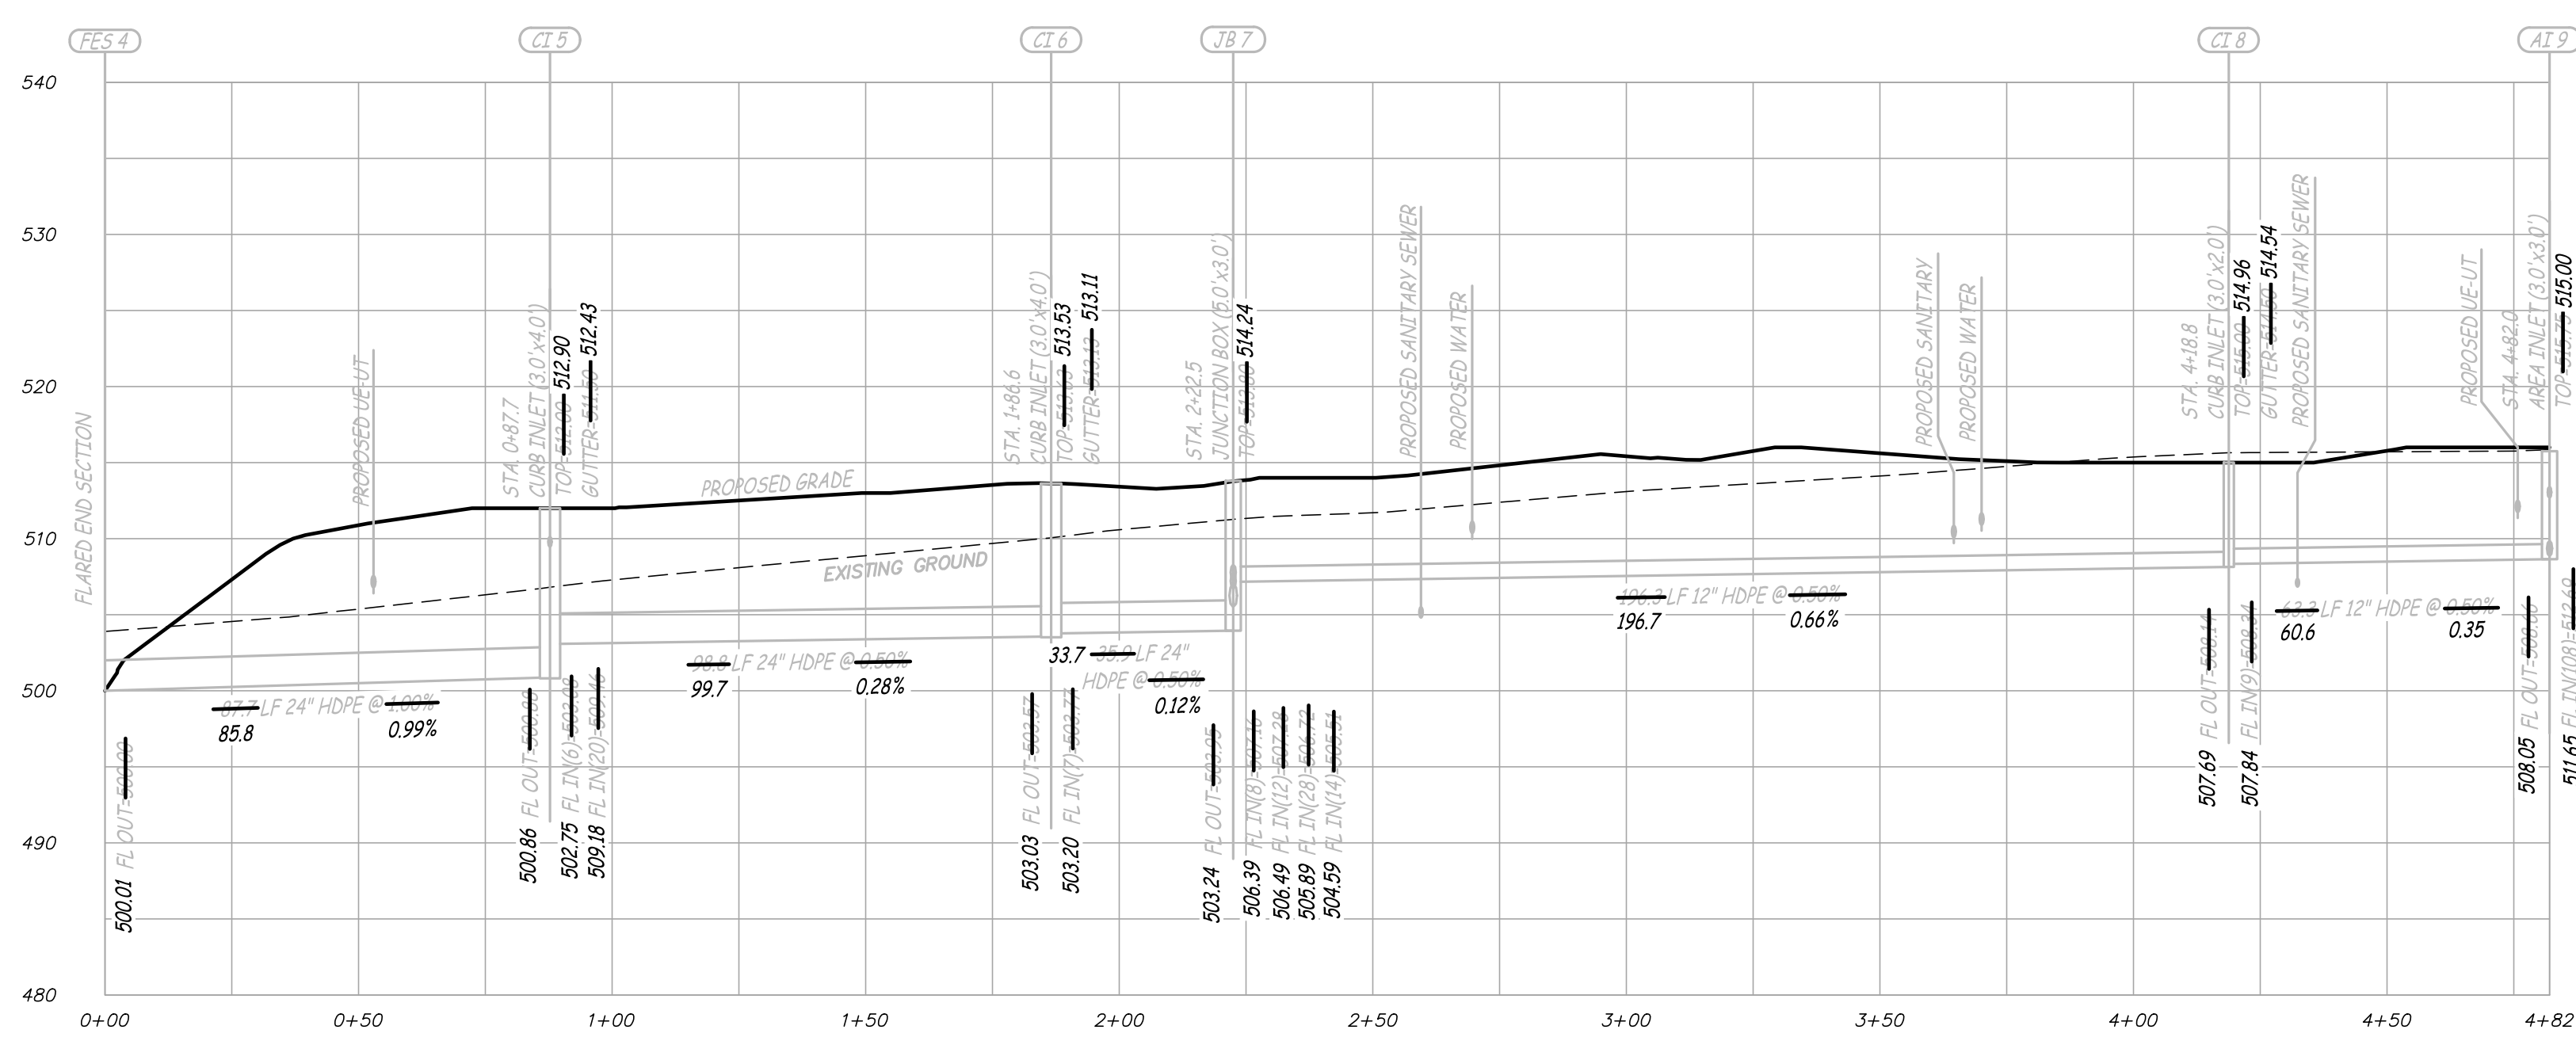


FES 4 THRU AL 9 (PRIVATE)
 SCALE - HORIZ. 1" = 30'
 VERT. 1" = 10'

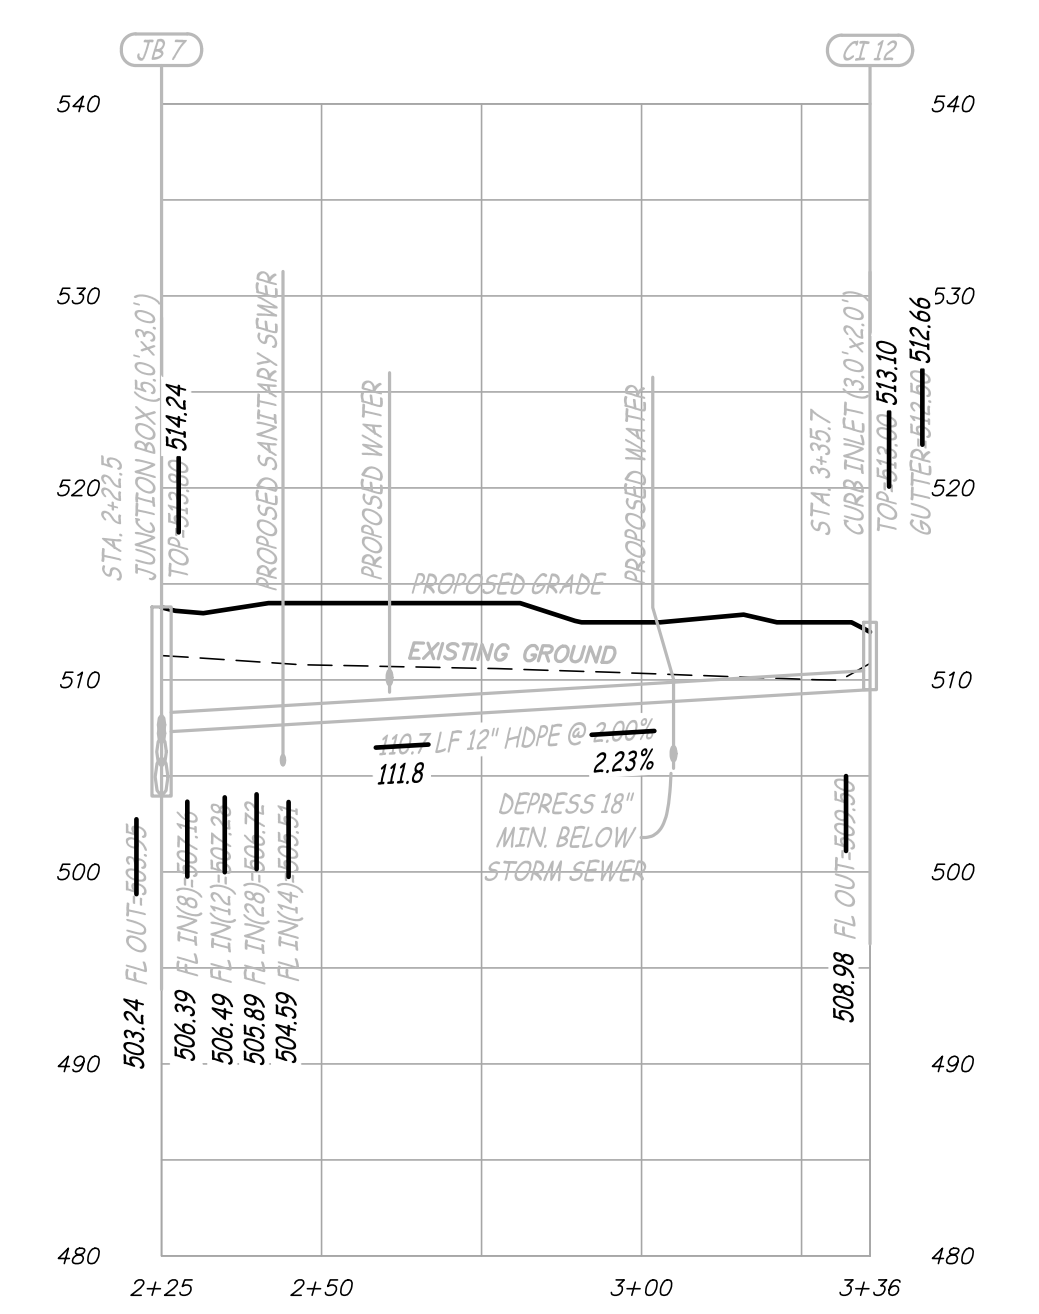


JB 7 THRU CI 12 (PRIVATE)
 SCALE - HORIZ. 1" = 30'
 VERT. 1" = 10'

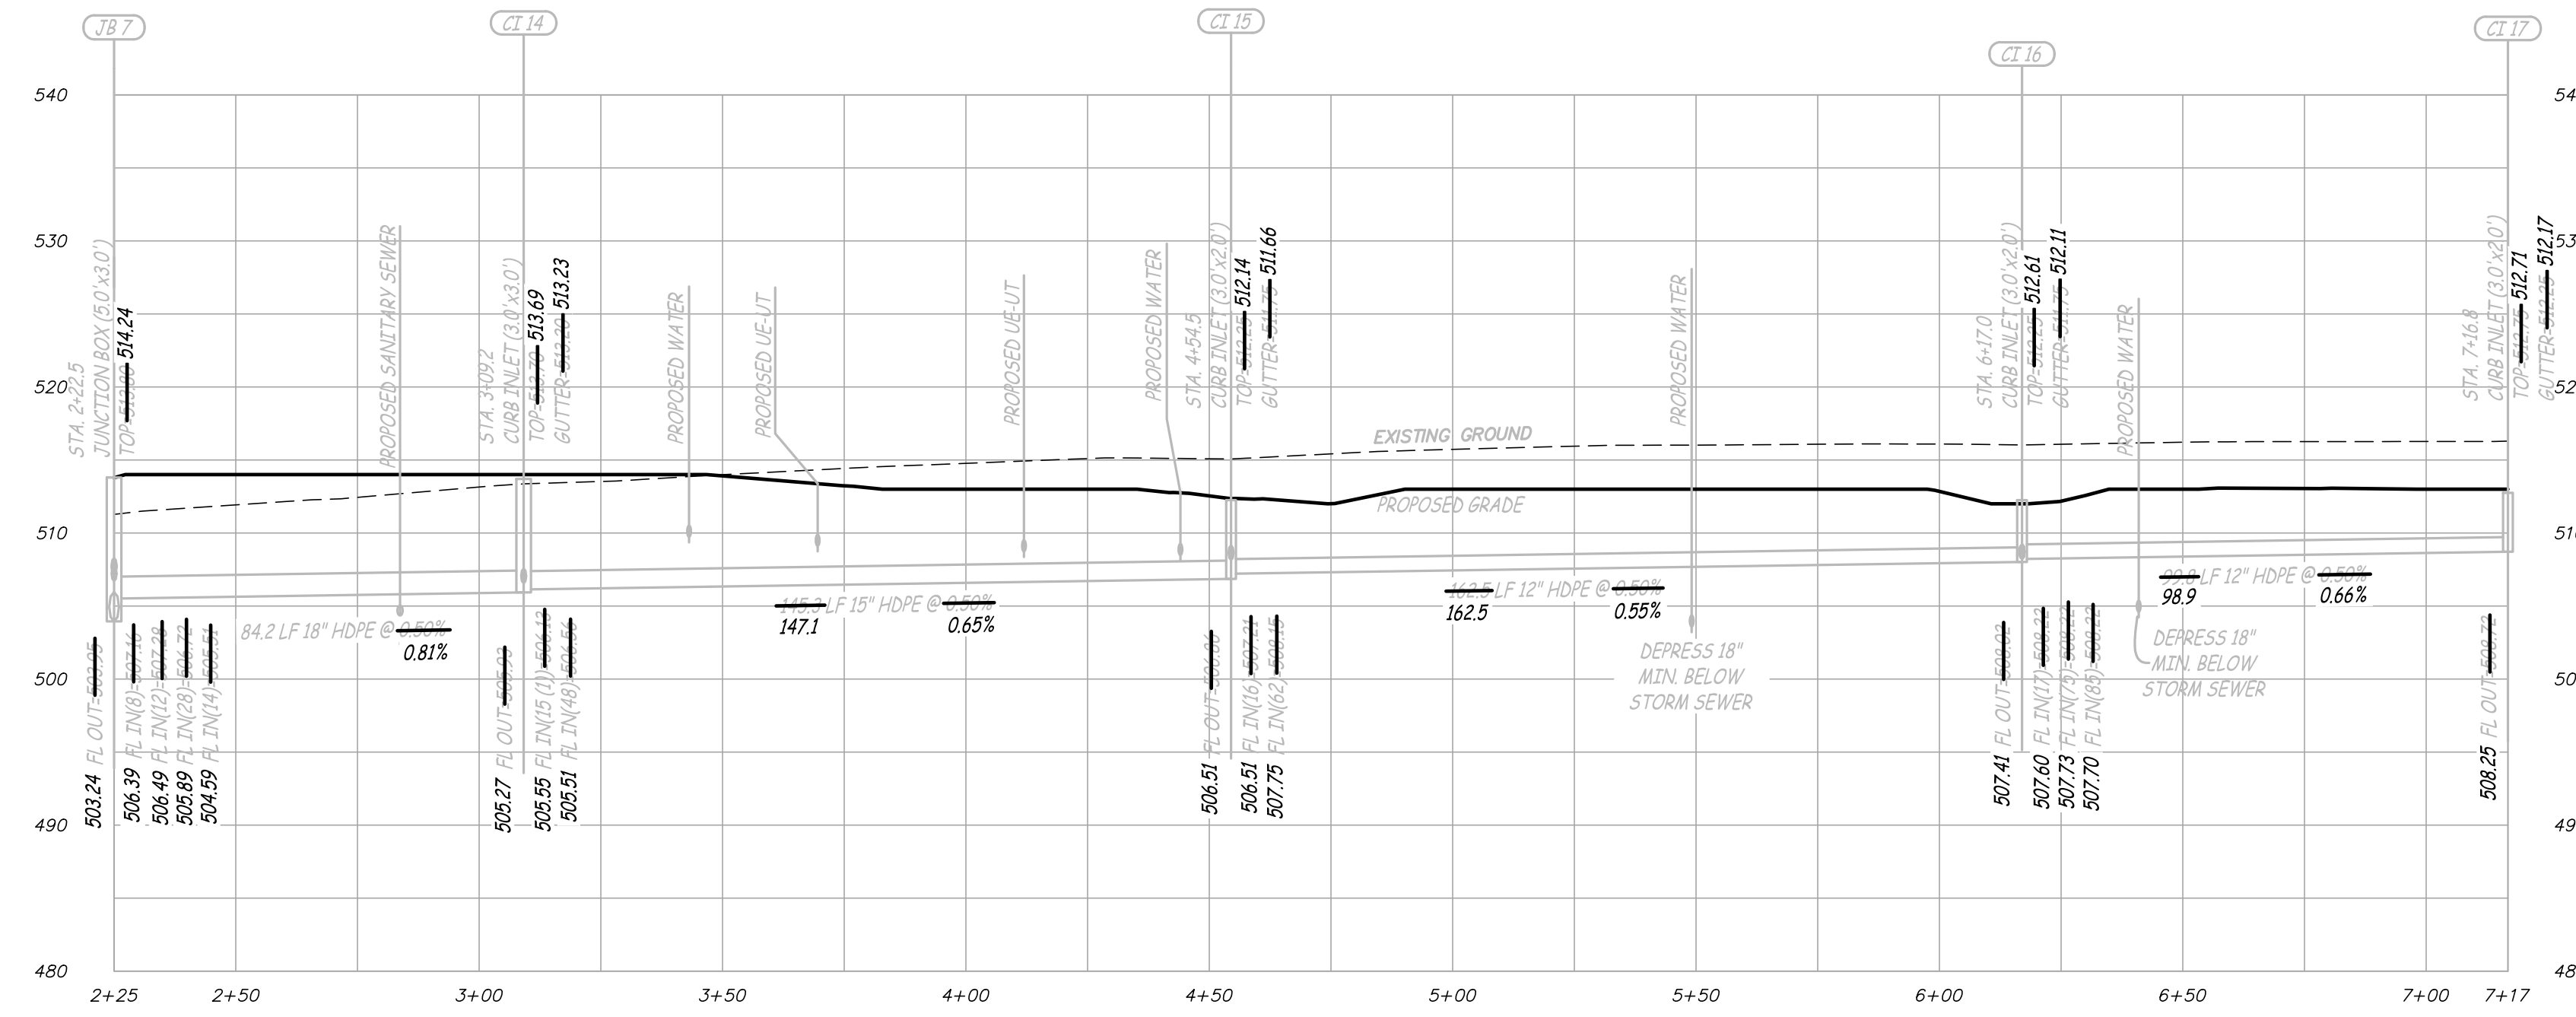


JB 7 THRU CI 17 (PRIVATE)
 SCALE - HORIZ. 1" = 30'
 VERT. 1" = 10'

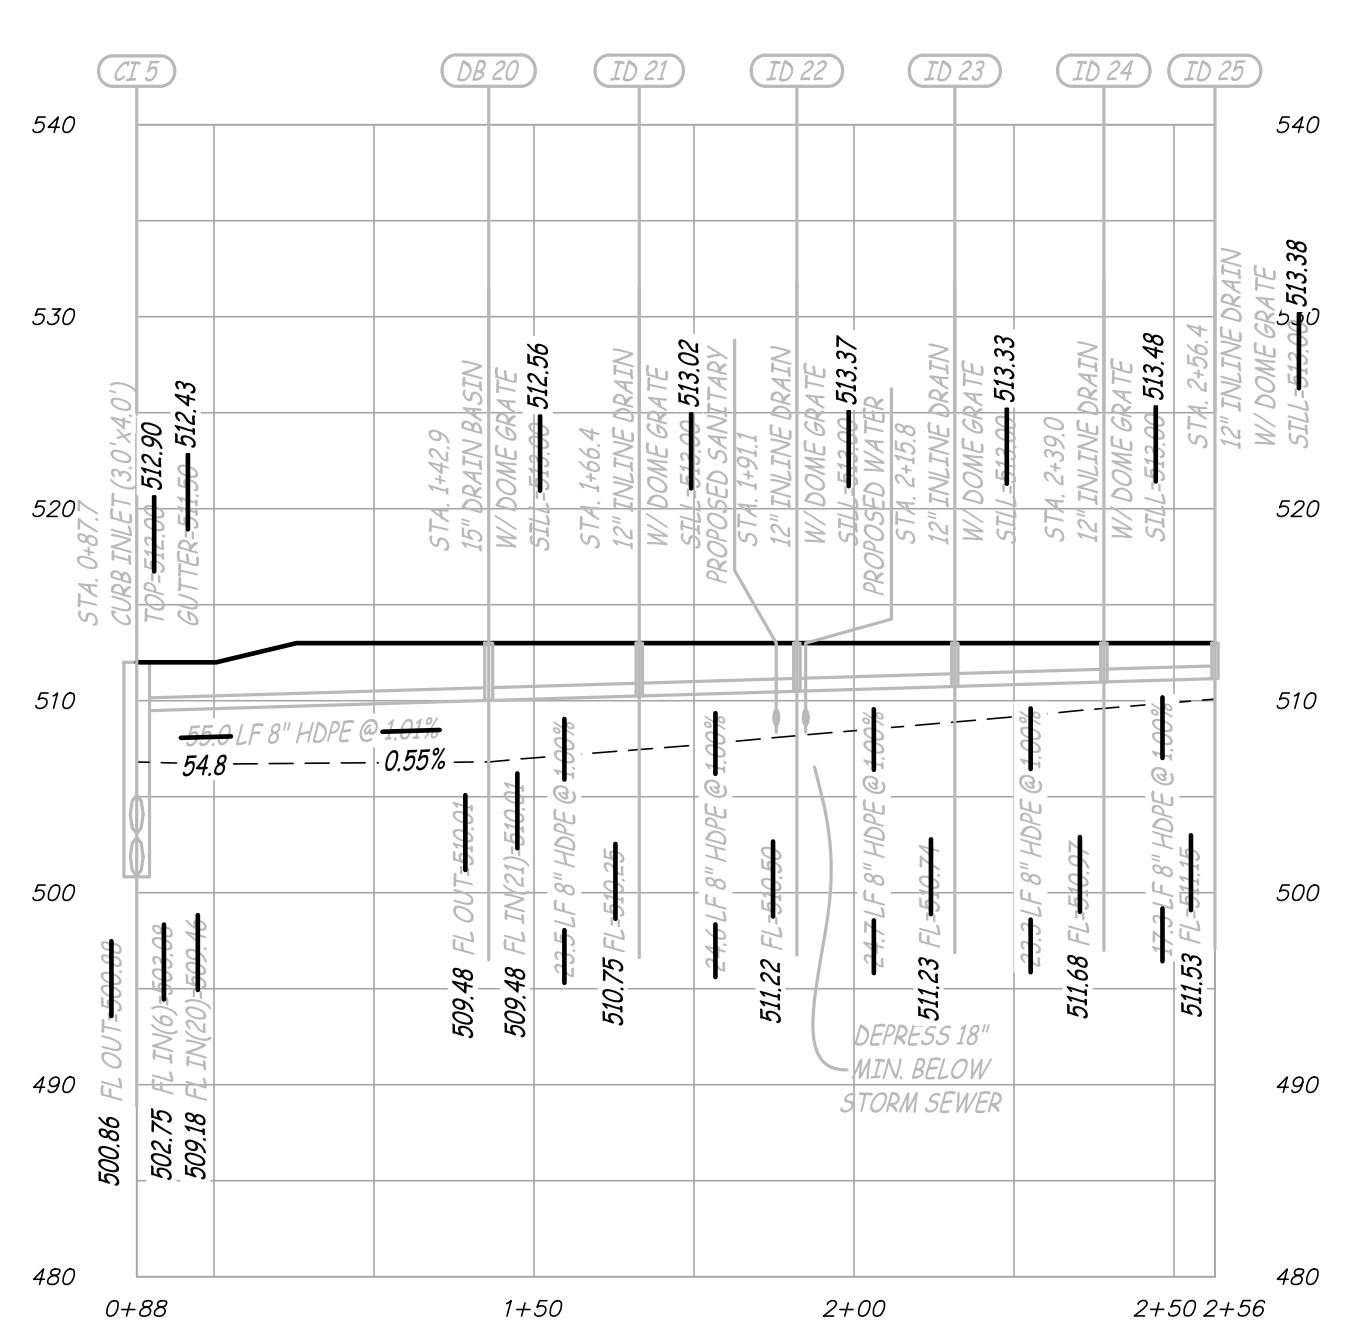


CI 5 THRU ID 25 (PRIVATE)
 SCALE - HORIZ. 1" = 30'
 VERT. 1" = 10'

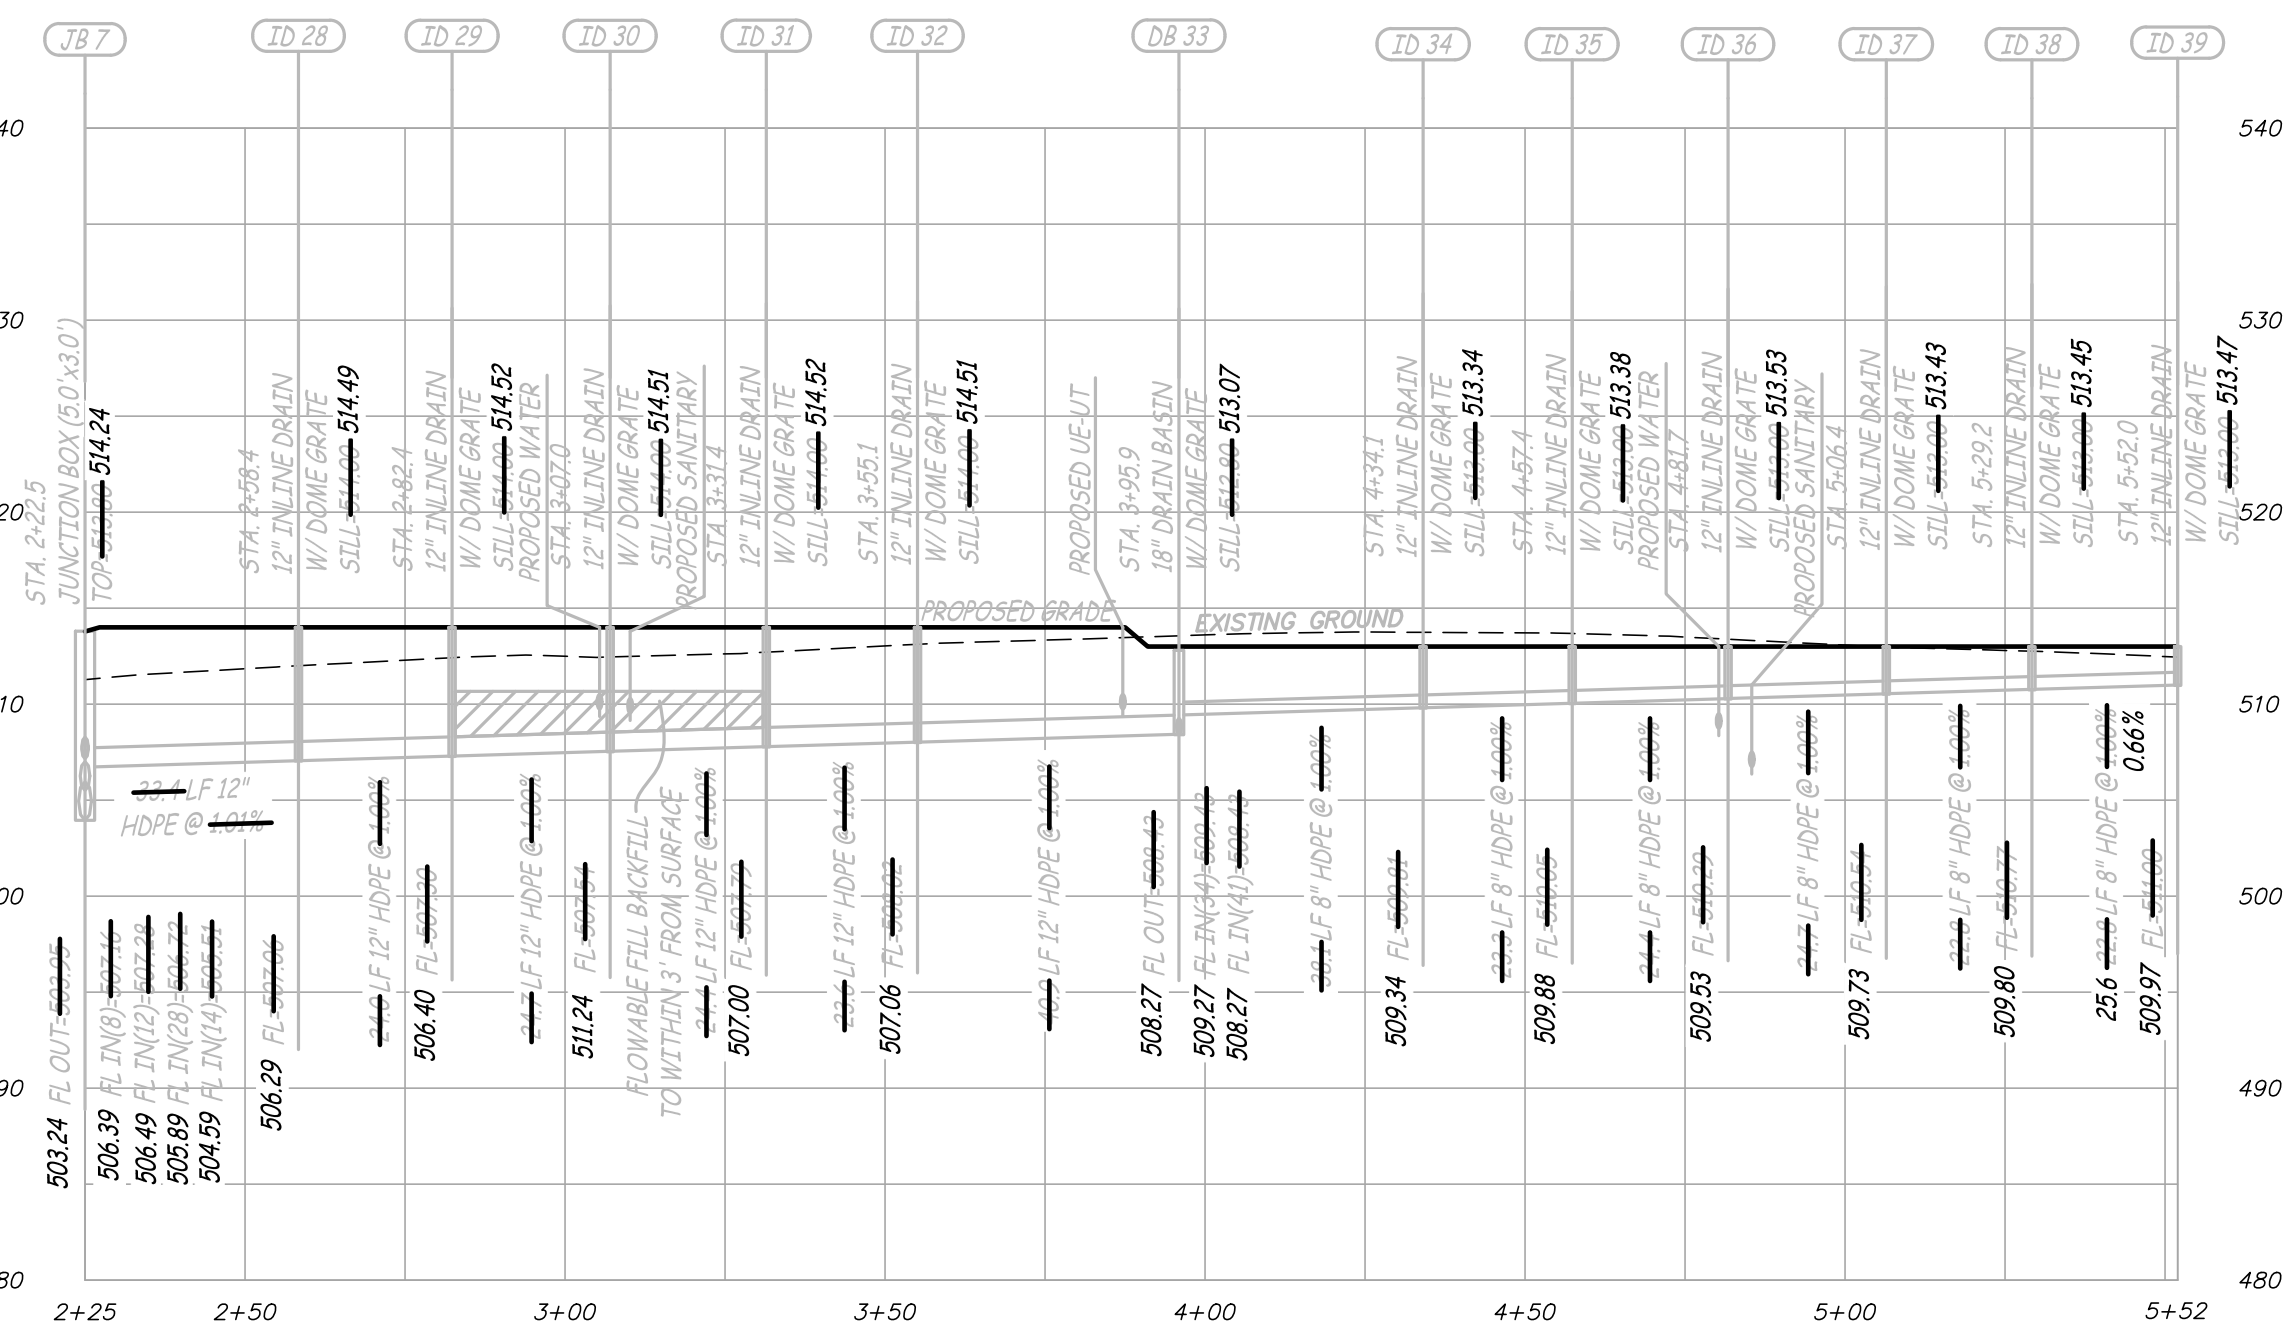

JB 7 THRU ID 39 (PRIVATE)
 SCALE - HORIZ. 1" = 30'
 VERT. 1" = 10'

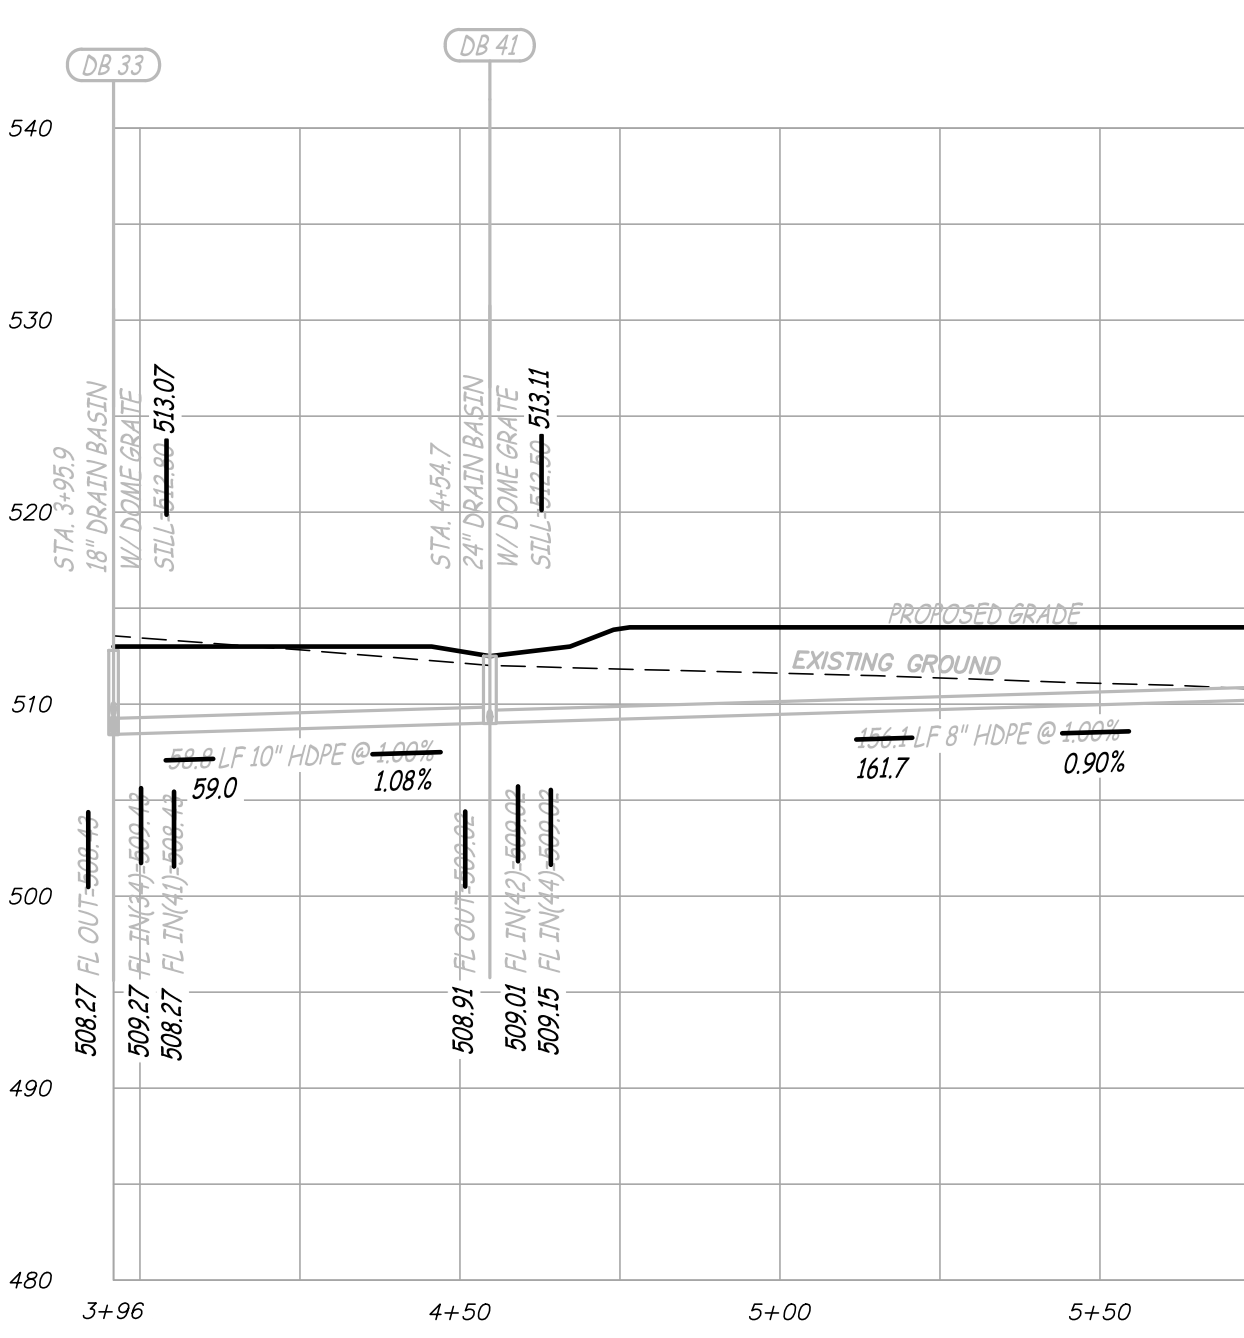


DB 33 THRU CO 42 (PRIVATE)
 SCALE - HORIZ. 1" = 30'
 VERT. 1" = 10'

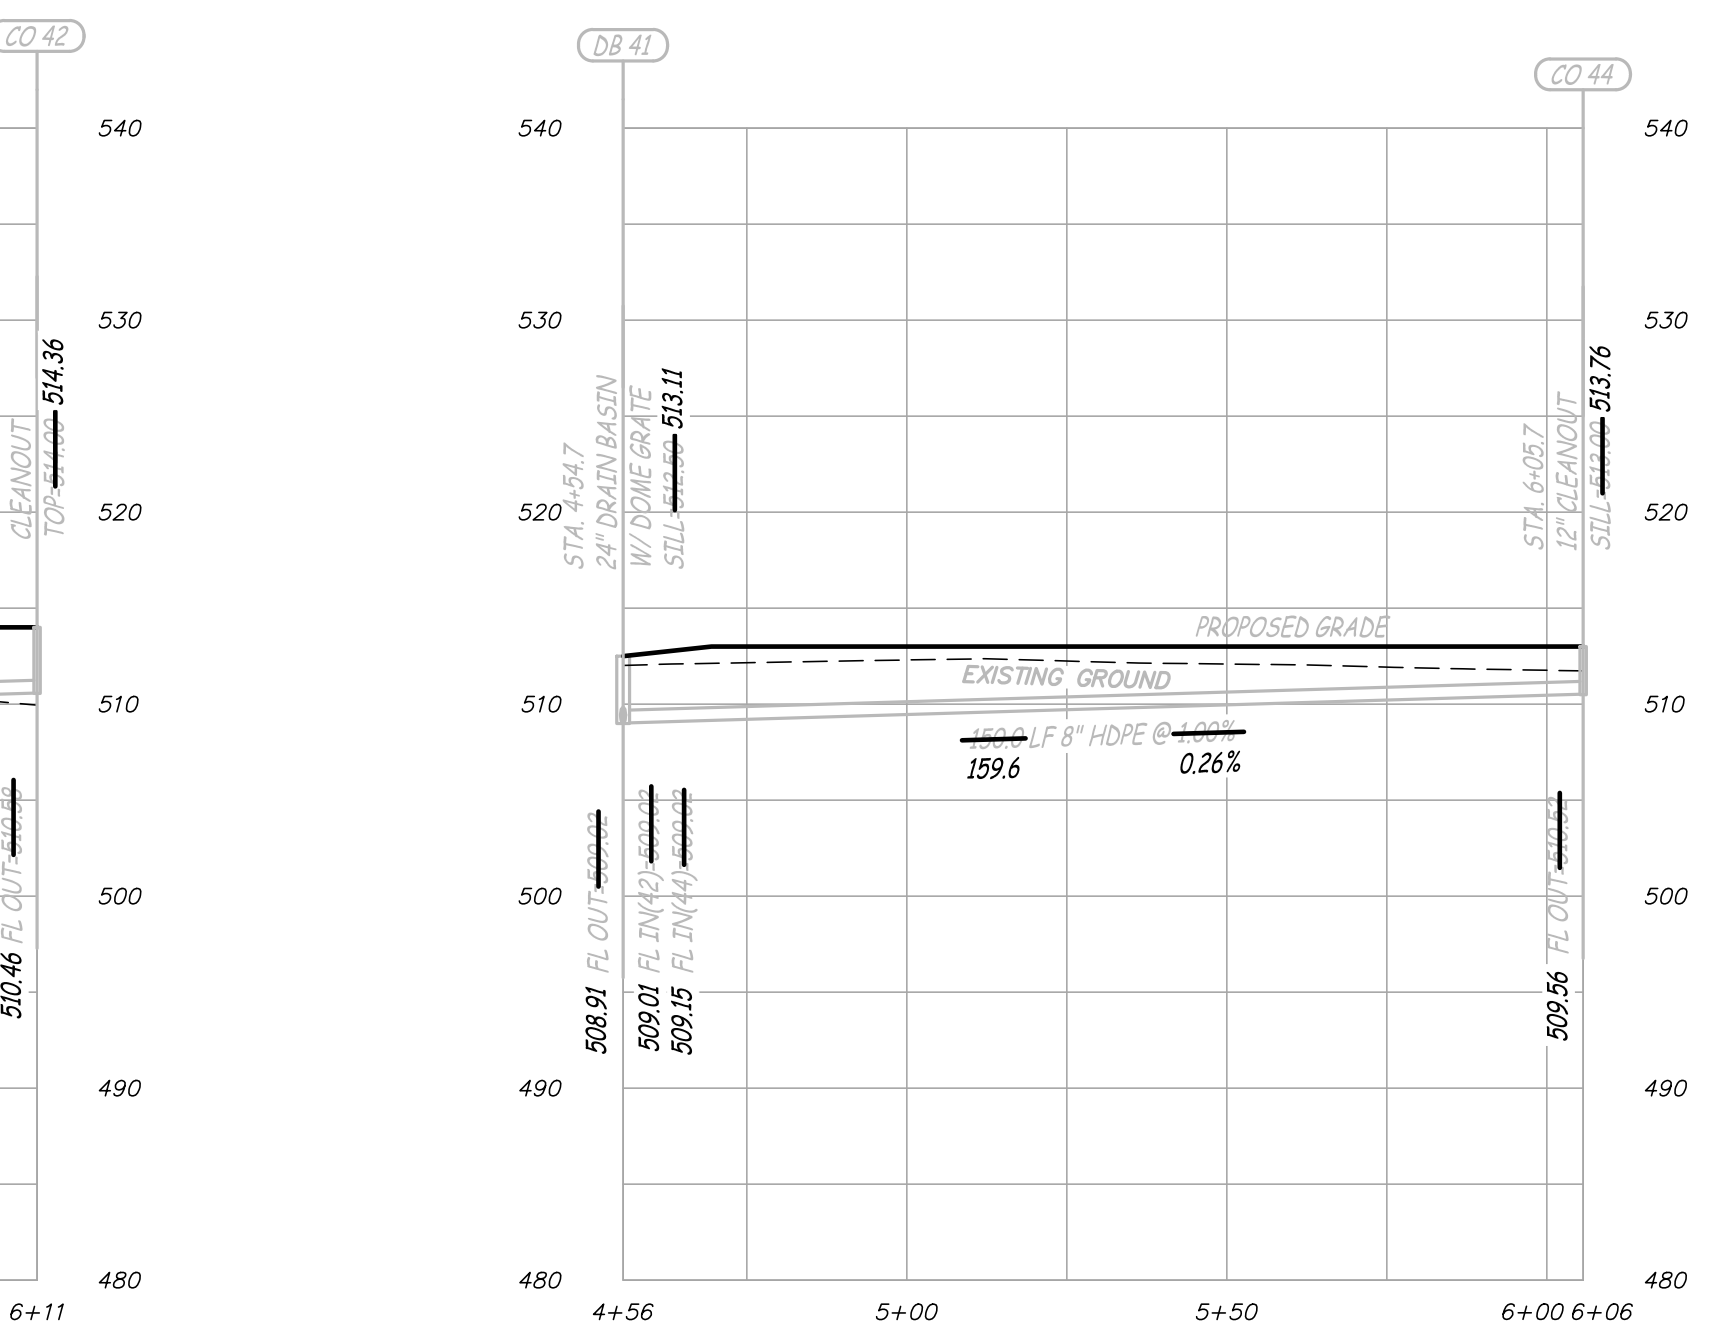

DB 41 THRU CO 44 (PRIVATE)
 SCALE - HORIZ. 1" = 30'
 VERT. 1" = 10'

JES DEVELOPMENT CO. INC.
MEADOWOOD ESTATES
 O'FALLON, ST. CHARLES COUNTY, MISSOURI

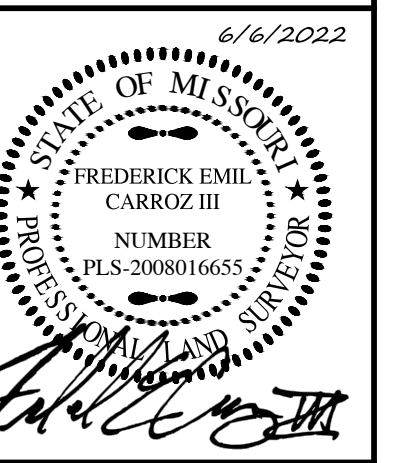

FREDERICK E. CARROZ III
 PROFESSIONAL LAND SURVEYOR
 PLS - 2008016655

Date
JUNE 6, 2022

Revised

Surveyed: NTL Drawn: CGH

STORM SEWER AS-BUILT


Sheet

V1.09

9 of 12
 ES&S PROJECT NO. 15421

P:\GENERAL PROJECTS\15421-ES-MEADOWOOD-POST-CONV-ALTALCAD\15421-AS-BUILT.DWG 6/6/2022

JES DEVELOPMENT CO. INC.
MEADOWOOD ESTATES
 O'FALLON, ST. CHARLES COUNTY, MISSOURI

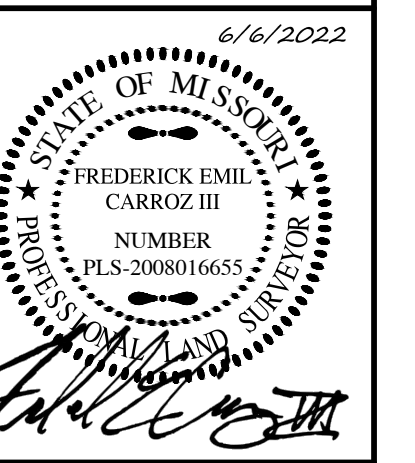

FREDERICK E. CARROZ III
 PROFESSIONAL LAND SURVEYOR
 PLS - 2008016655


Date
JUNE 6, 2022

Revised


Surveyed: NTL Drawn: CGH

STORM SEWER AS-BUILT


Sheet
V1.10
 10 of 12
 ES&S PROJECT NO. 15421

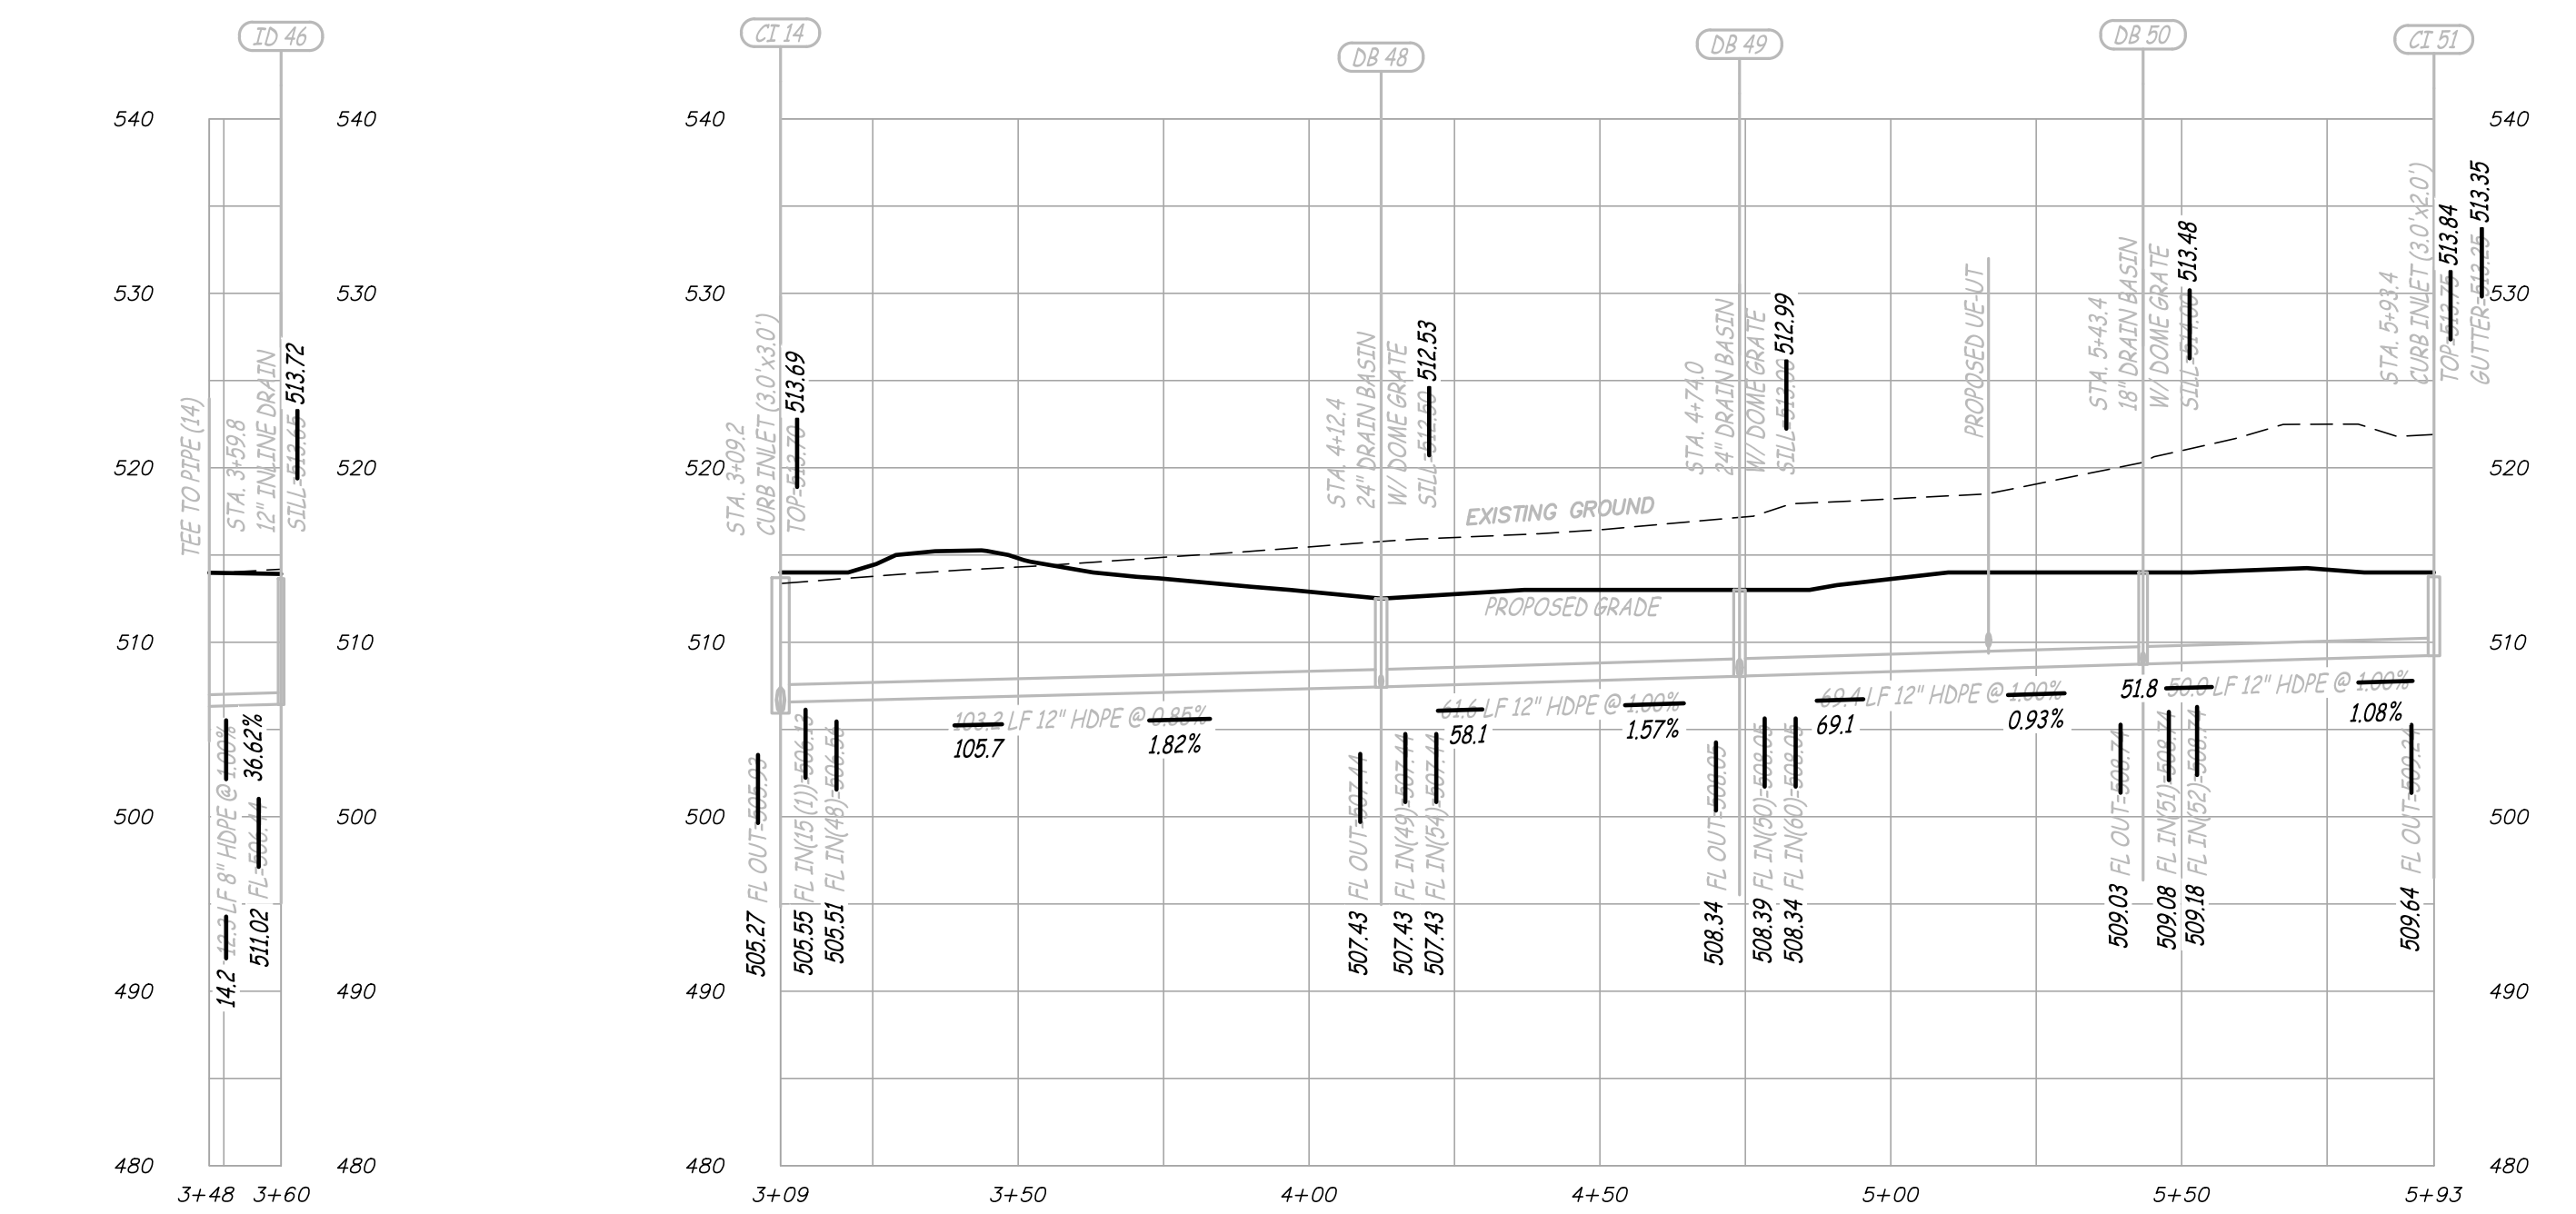


PIPE 14 THRU ID 46 (PRIVATE)
 SCALE - HORIZ. 1" = 30'
 VERT. 1" = 10'

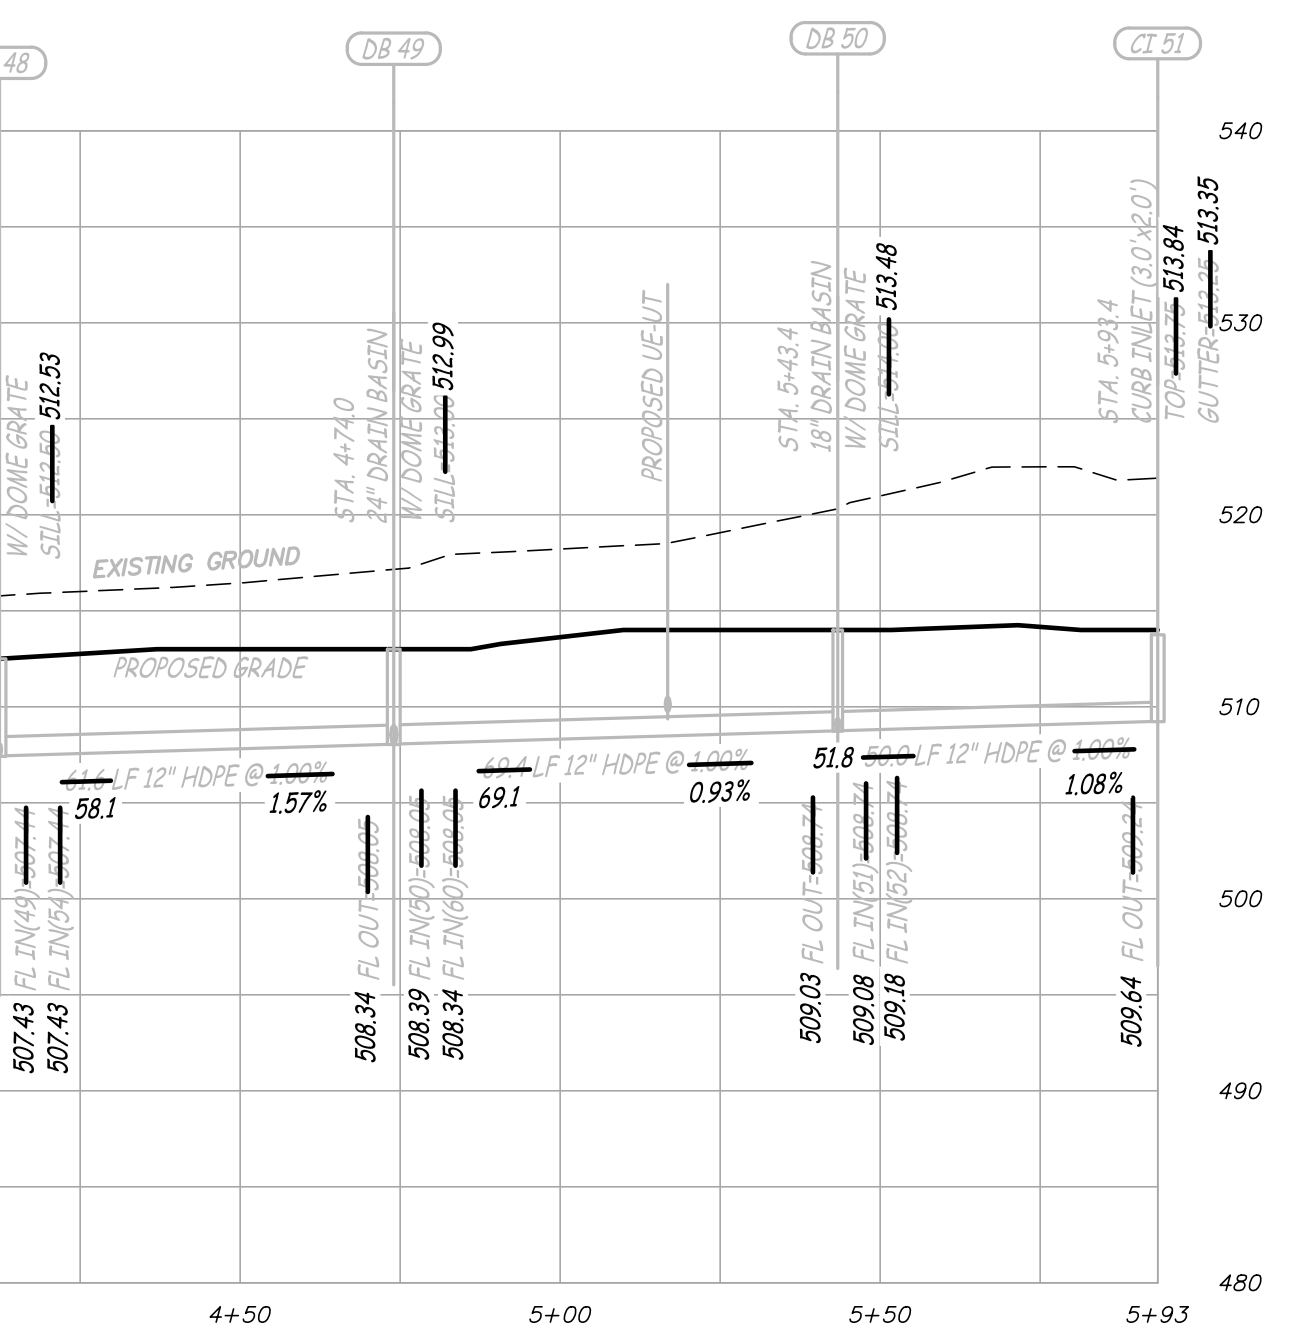


JB 14 THRU CI 51 (PRIVATE)
 SCALE - HORIZ. 1" = 30'
 VERT. 1" = 10'

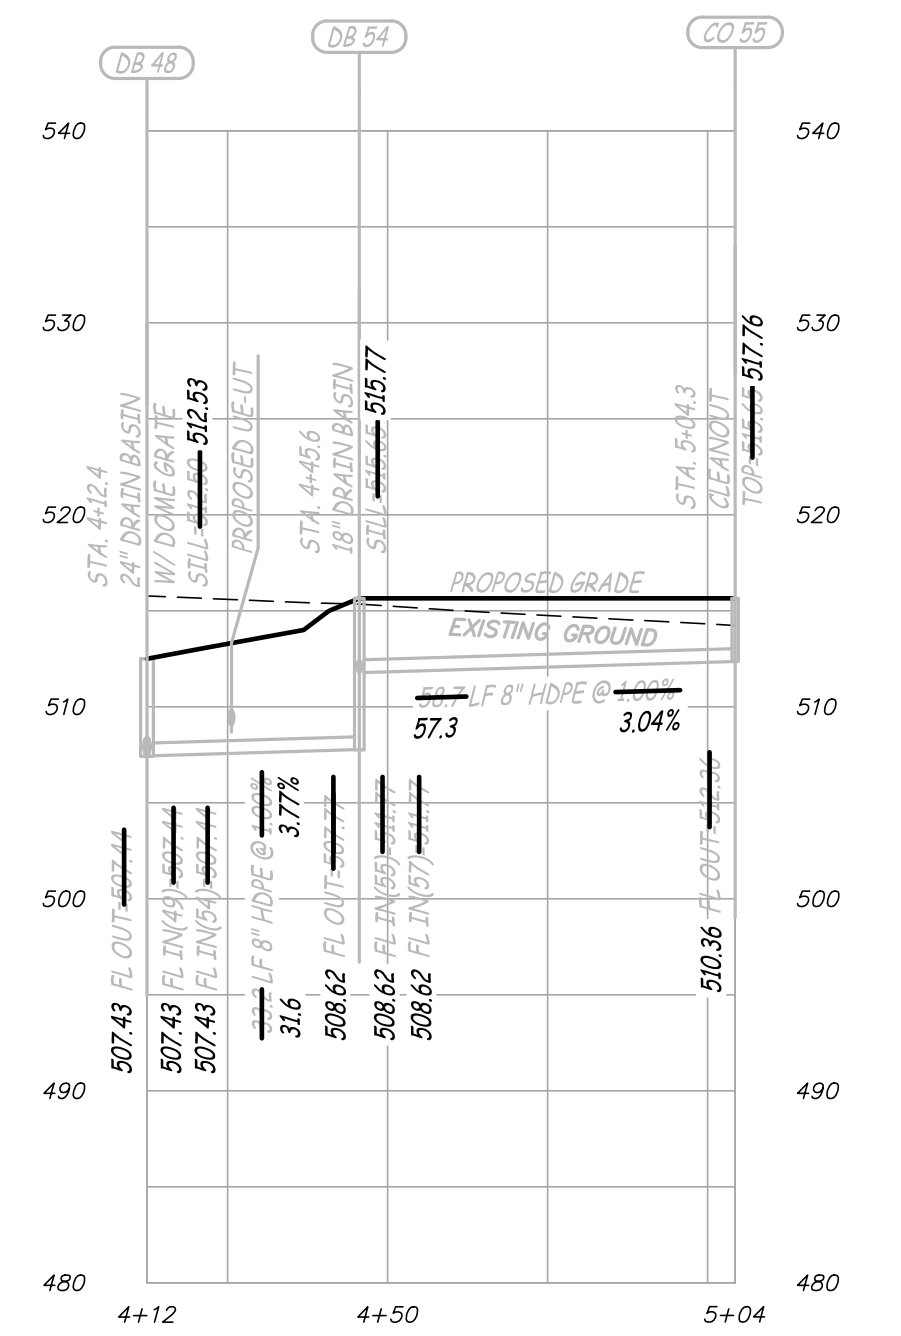


DB 48 THRU CO 55 (PRIVATE)
 SCALE - HORIZ. 1" = 30'
 VERT. 1" = 10'

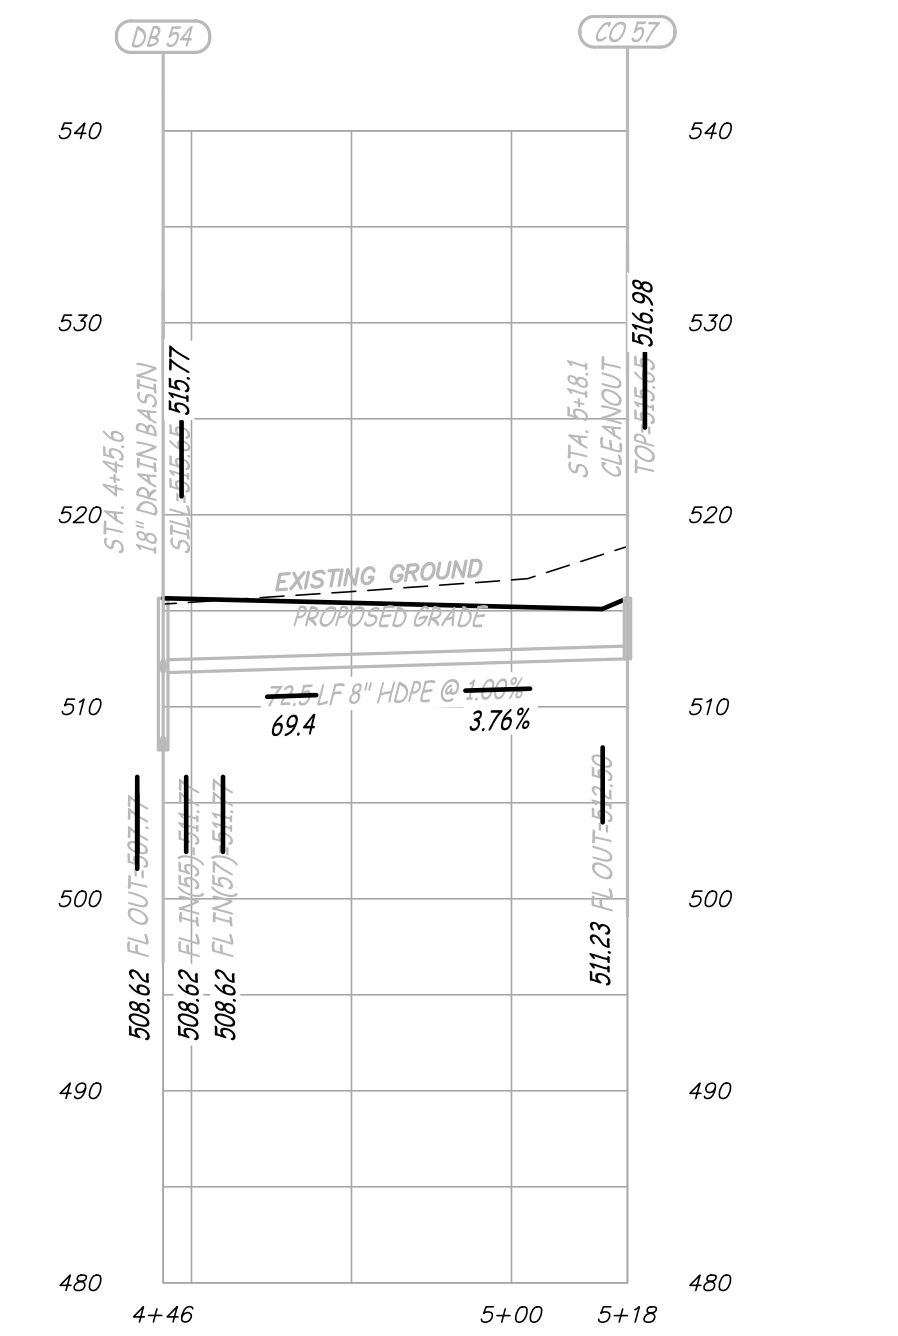


DB 54 THRU CO 57 (PRIVATE)
 SCALE - HORIZ. 1" = 30'
 VERT. 1" = 10'

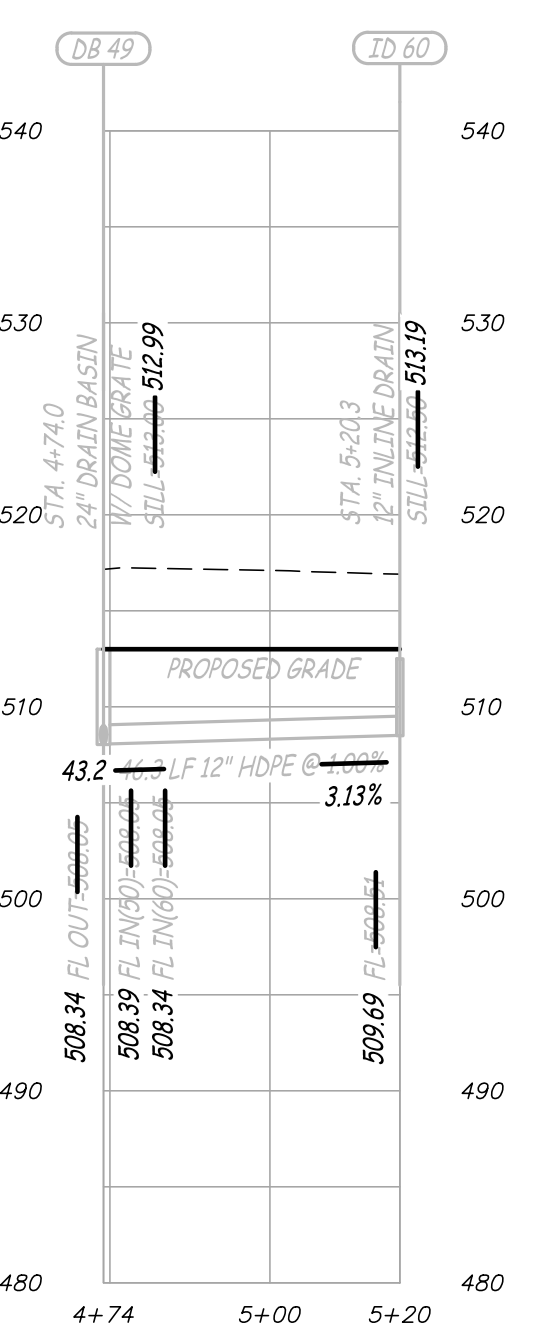


DB 49 THRU ID 60 (PRIVATE)
 SCALE - HORIZ. 1" = 30'
 VERT. 1" = 10'

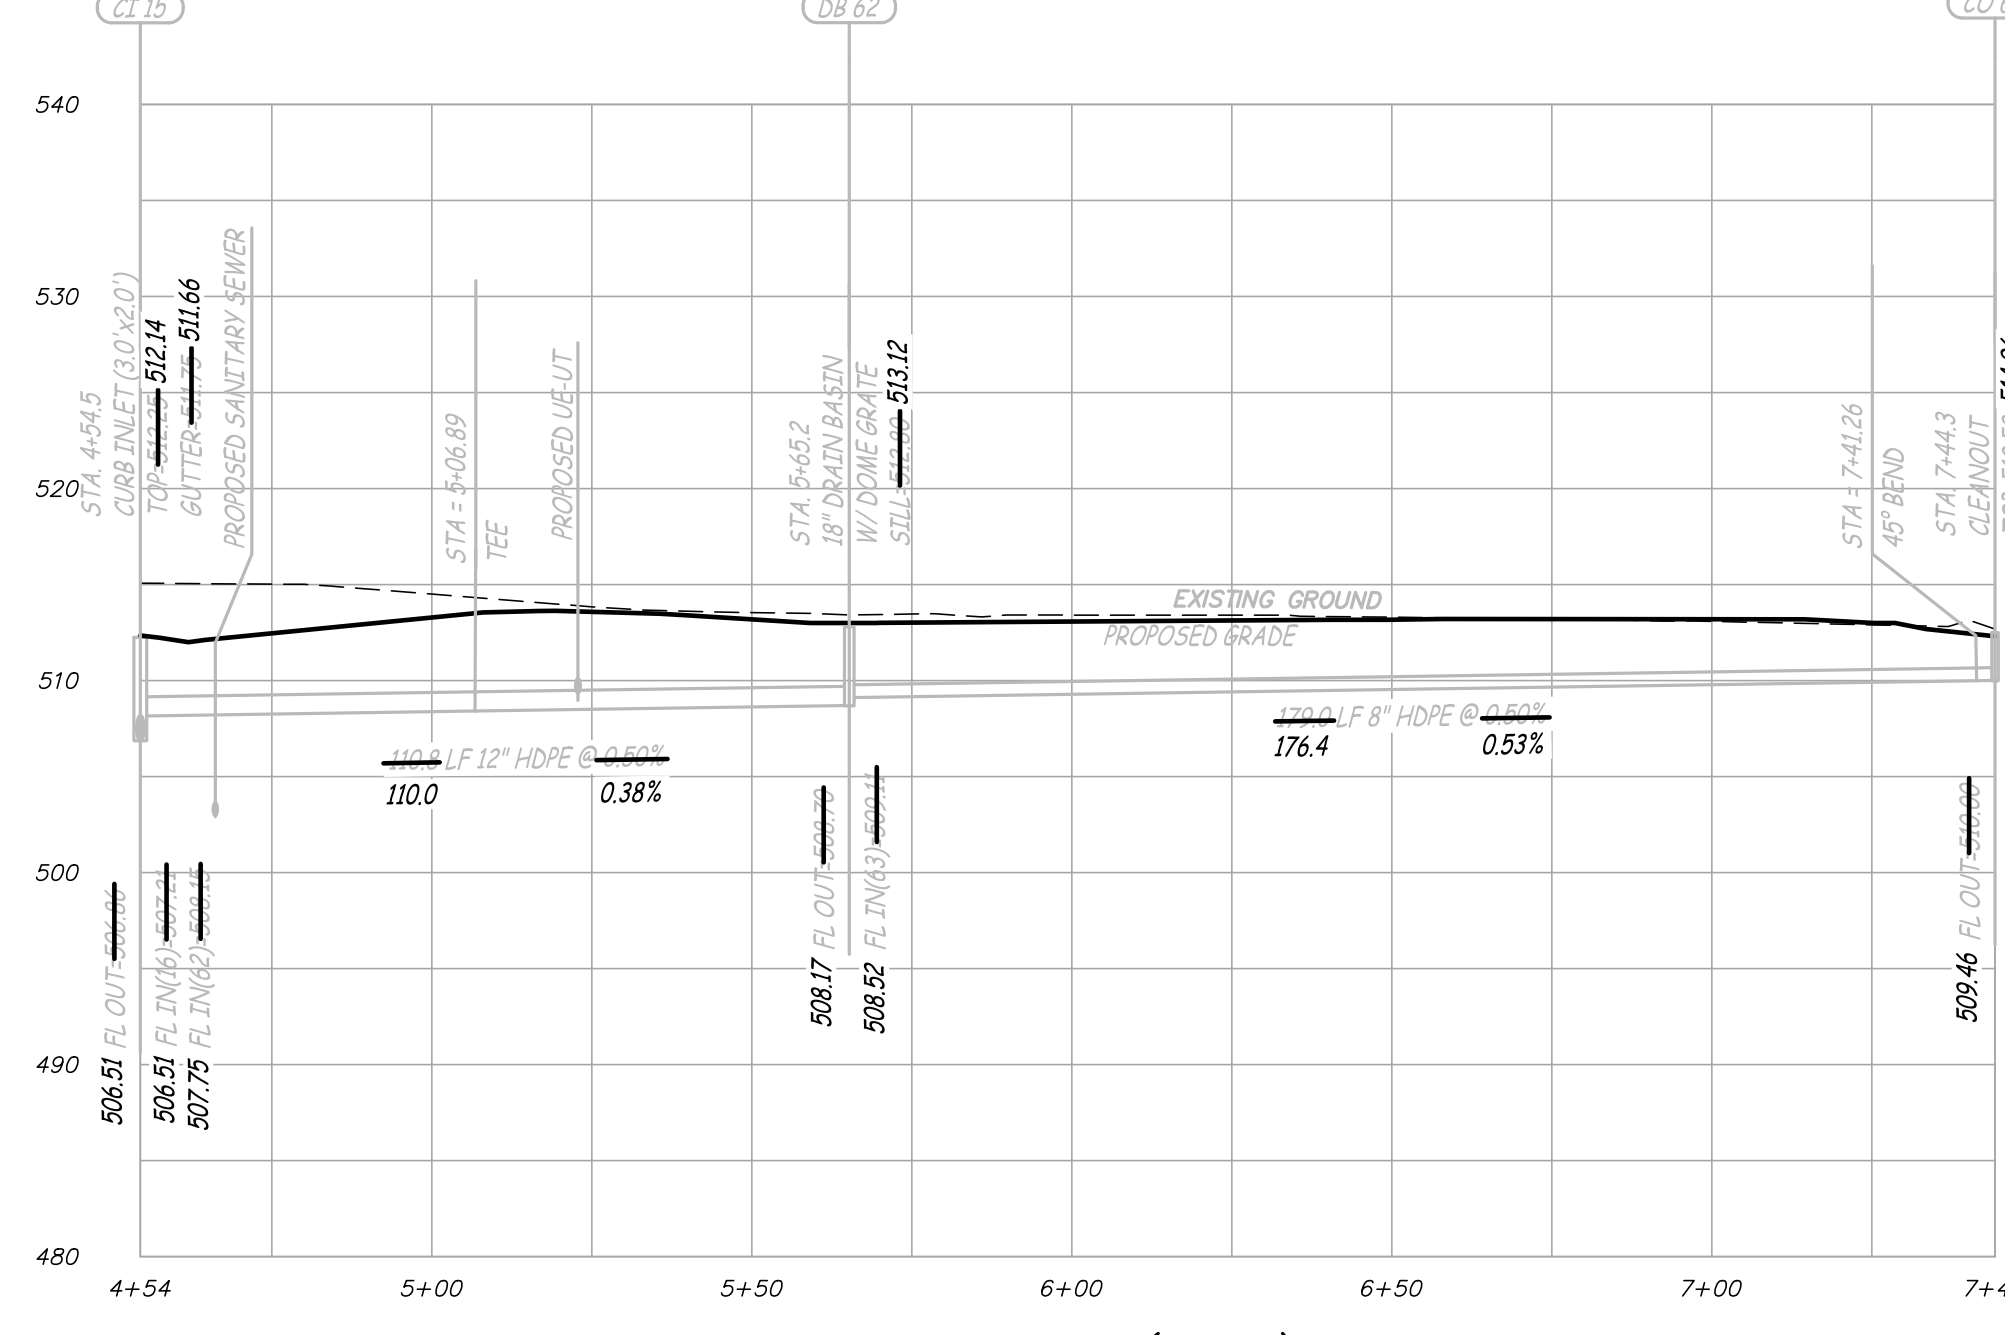


CI 15 THRU CO 63 (PRIVATE)
 SCALE - HORIZ. 1" = 30'
 VERT. 1" = 10'

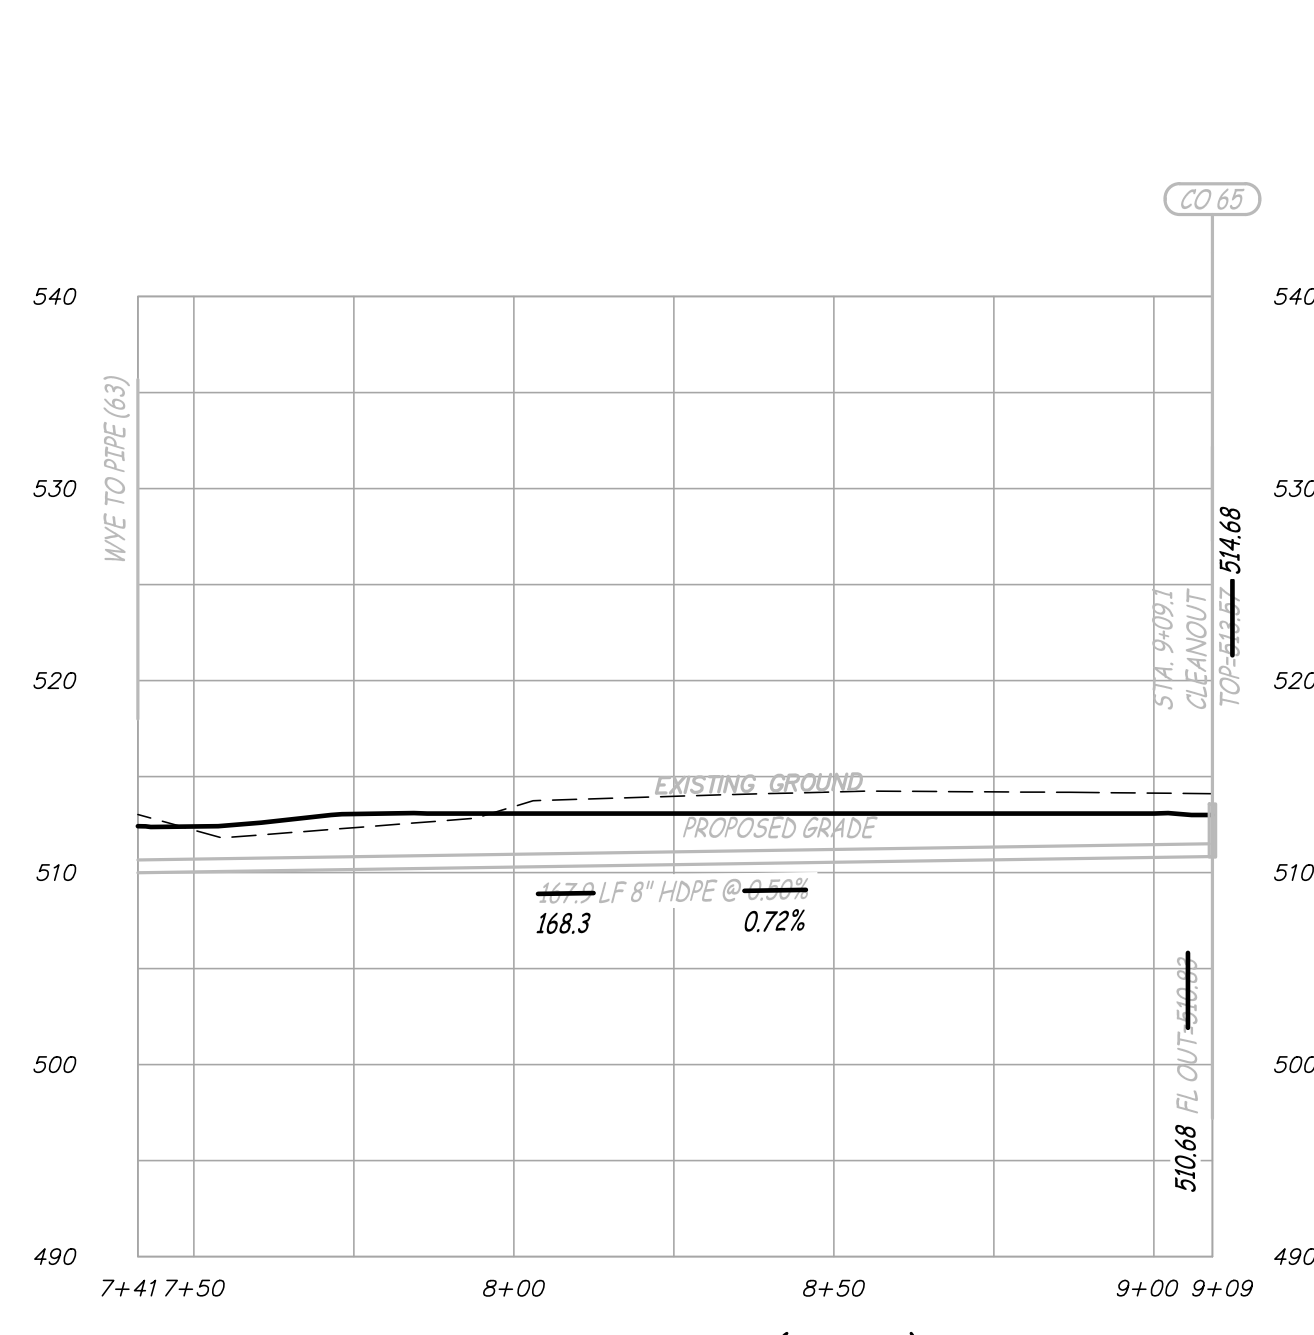


PIPE 63 THRU CO 65 (PRIVATE)
 SCALE - HORIZ. 1" = 30'
 VERT. 1" = 10'

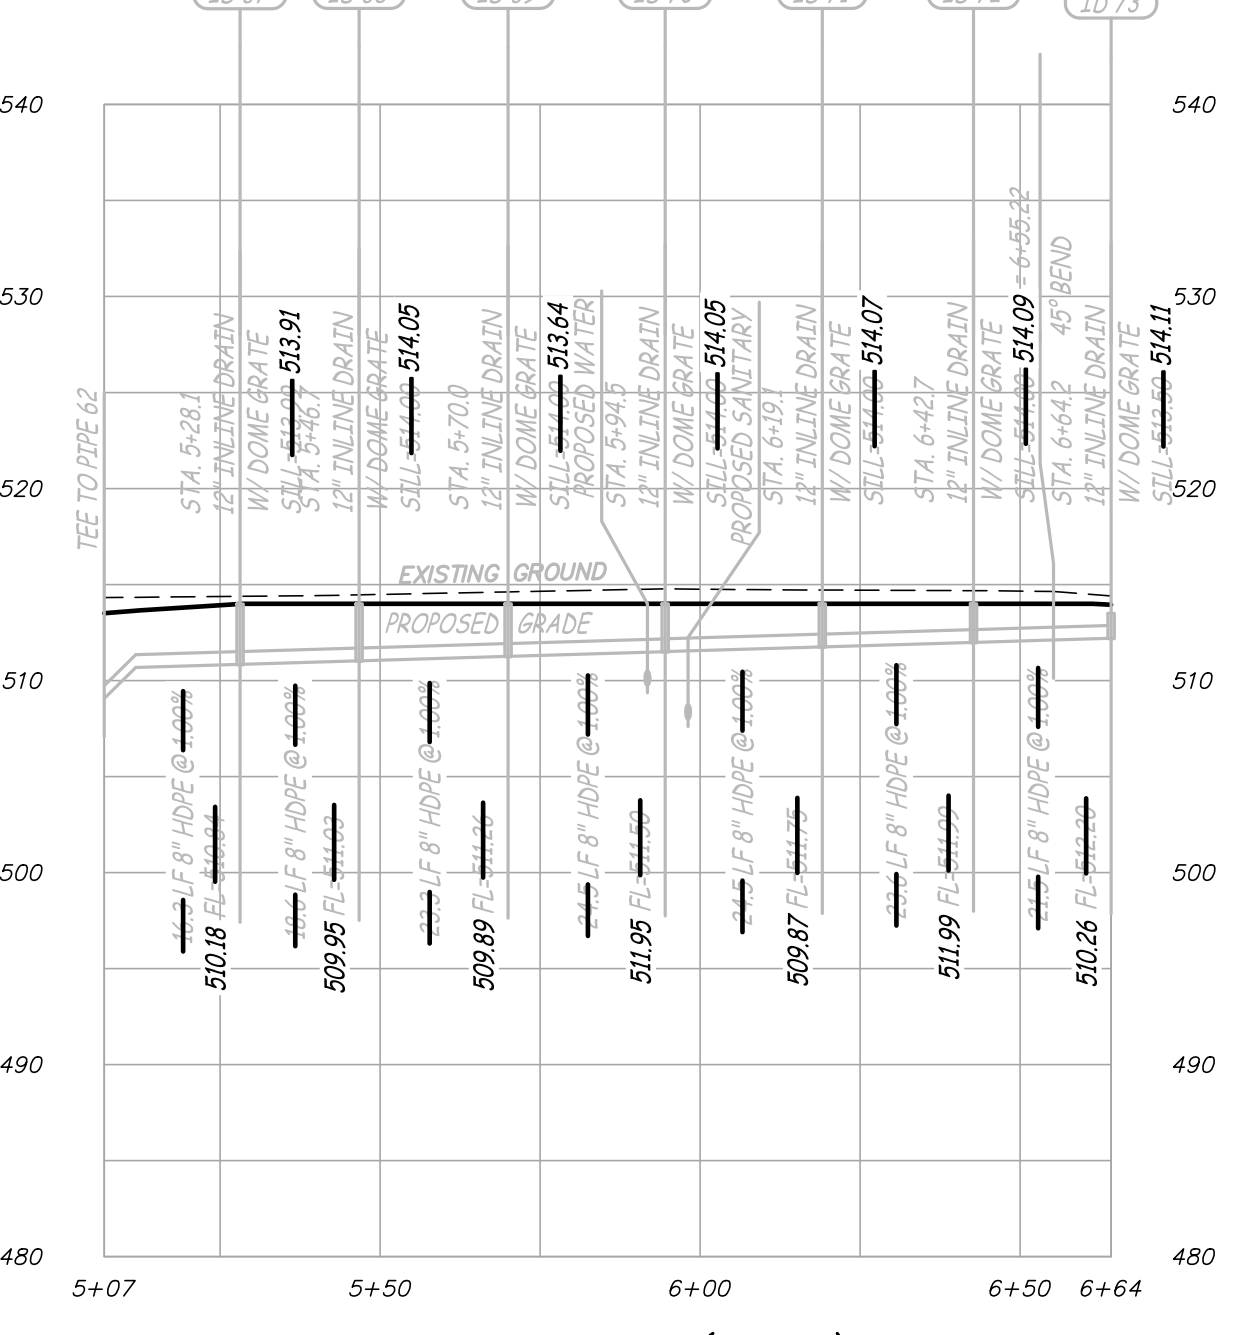


PIPE 62 THRU ID 73 (PRIVATE)
 SCALE - HORIZ. 1" = 30'
 VERT. 1" = 10'

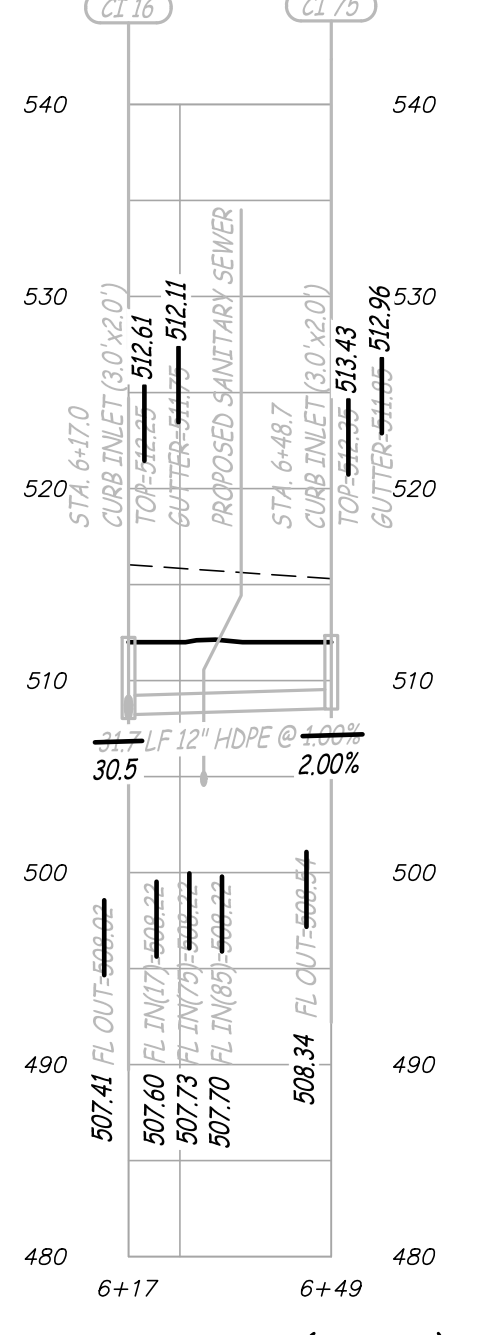


CI 16 THRU CI 75 (PRIVATE)
 SCALE - HORIZ. 1" = 30'
 VERT. 1" = 10'

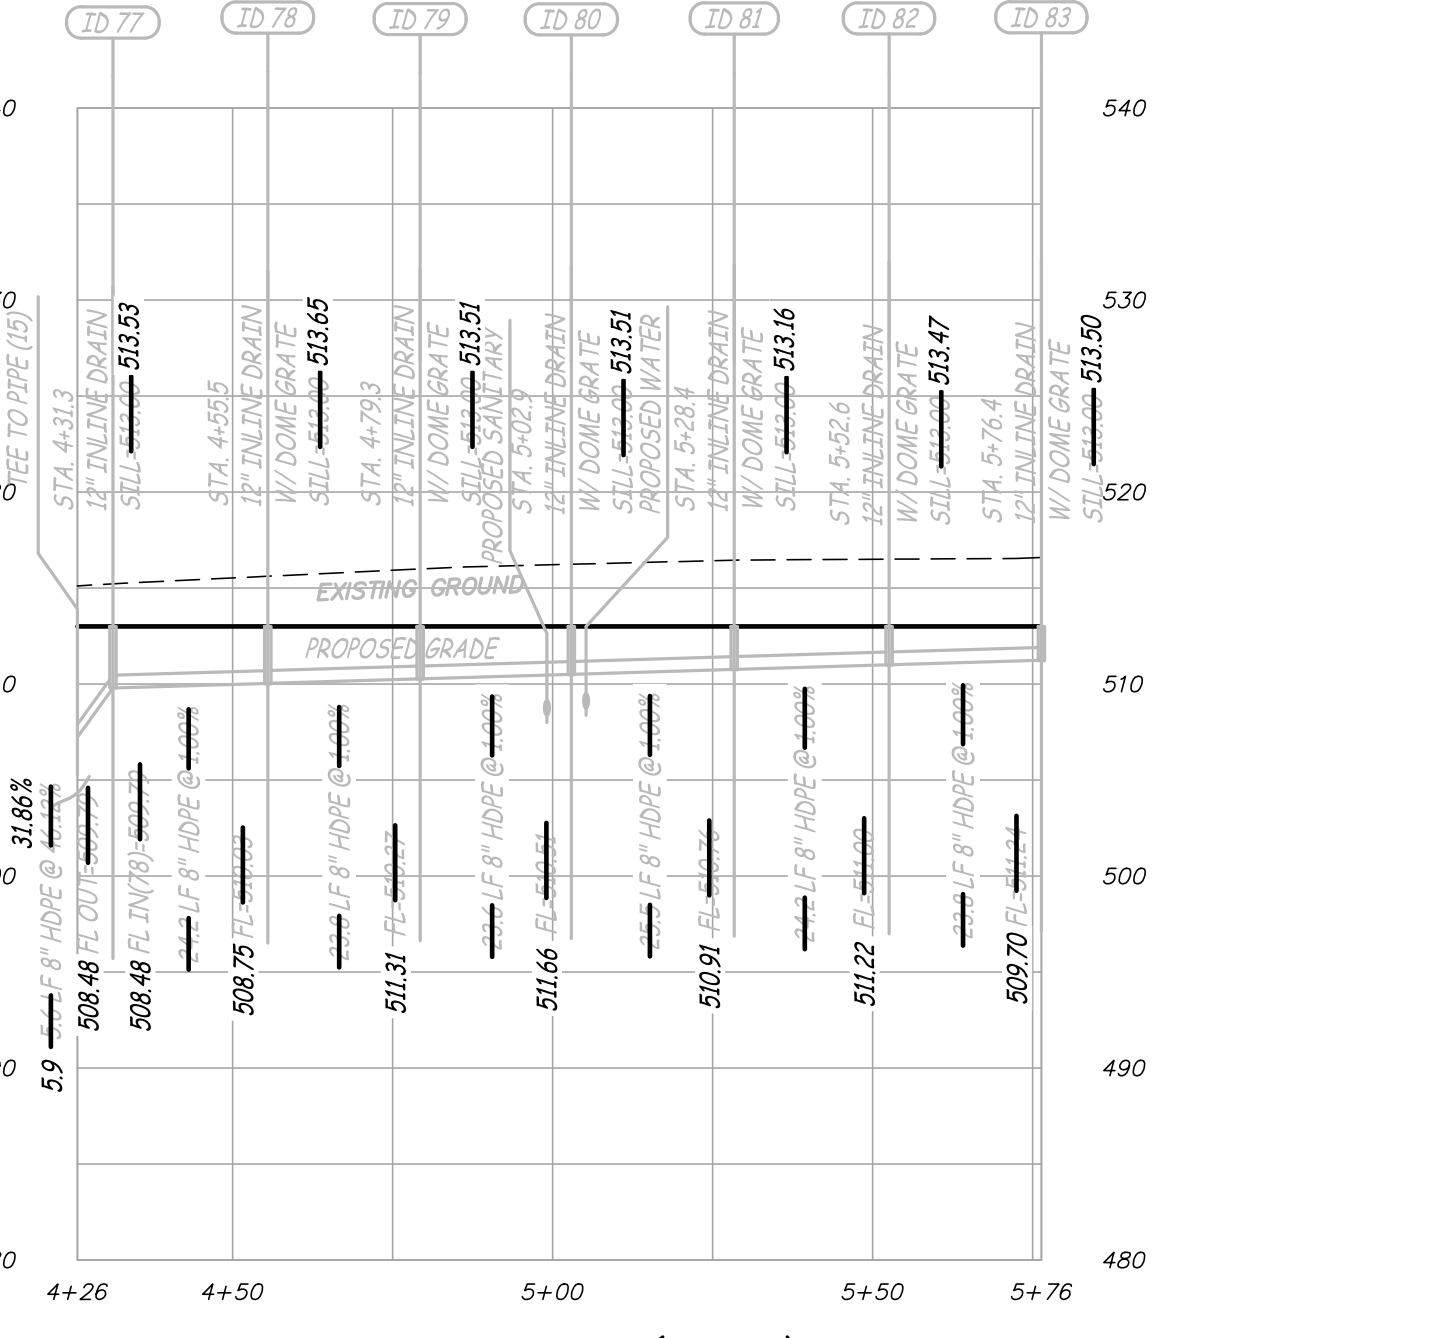


PIPE 15 THRU ID 83 (PRIVATE)
 SCALE - HORIZ. 1" = 30'
 VERT. 1" = 10'

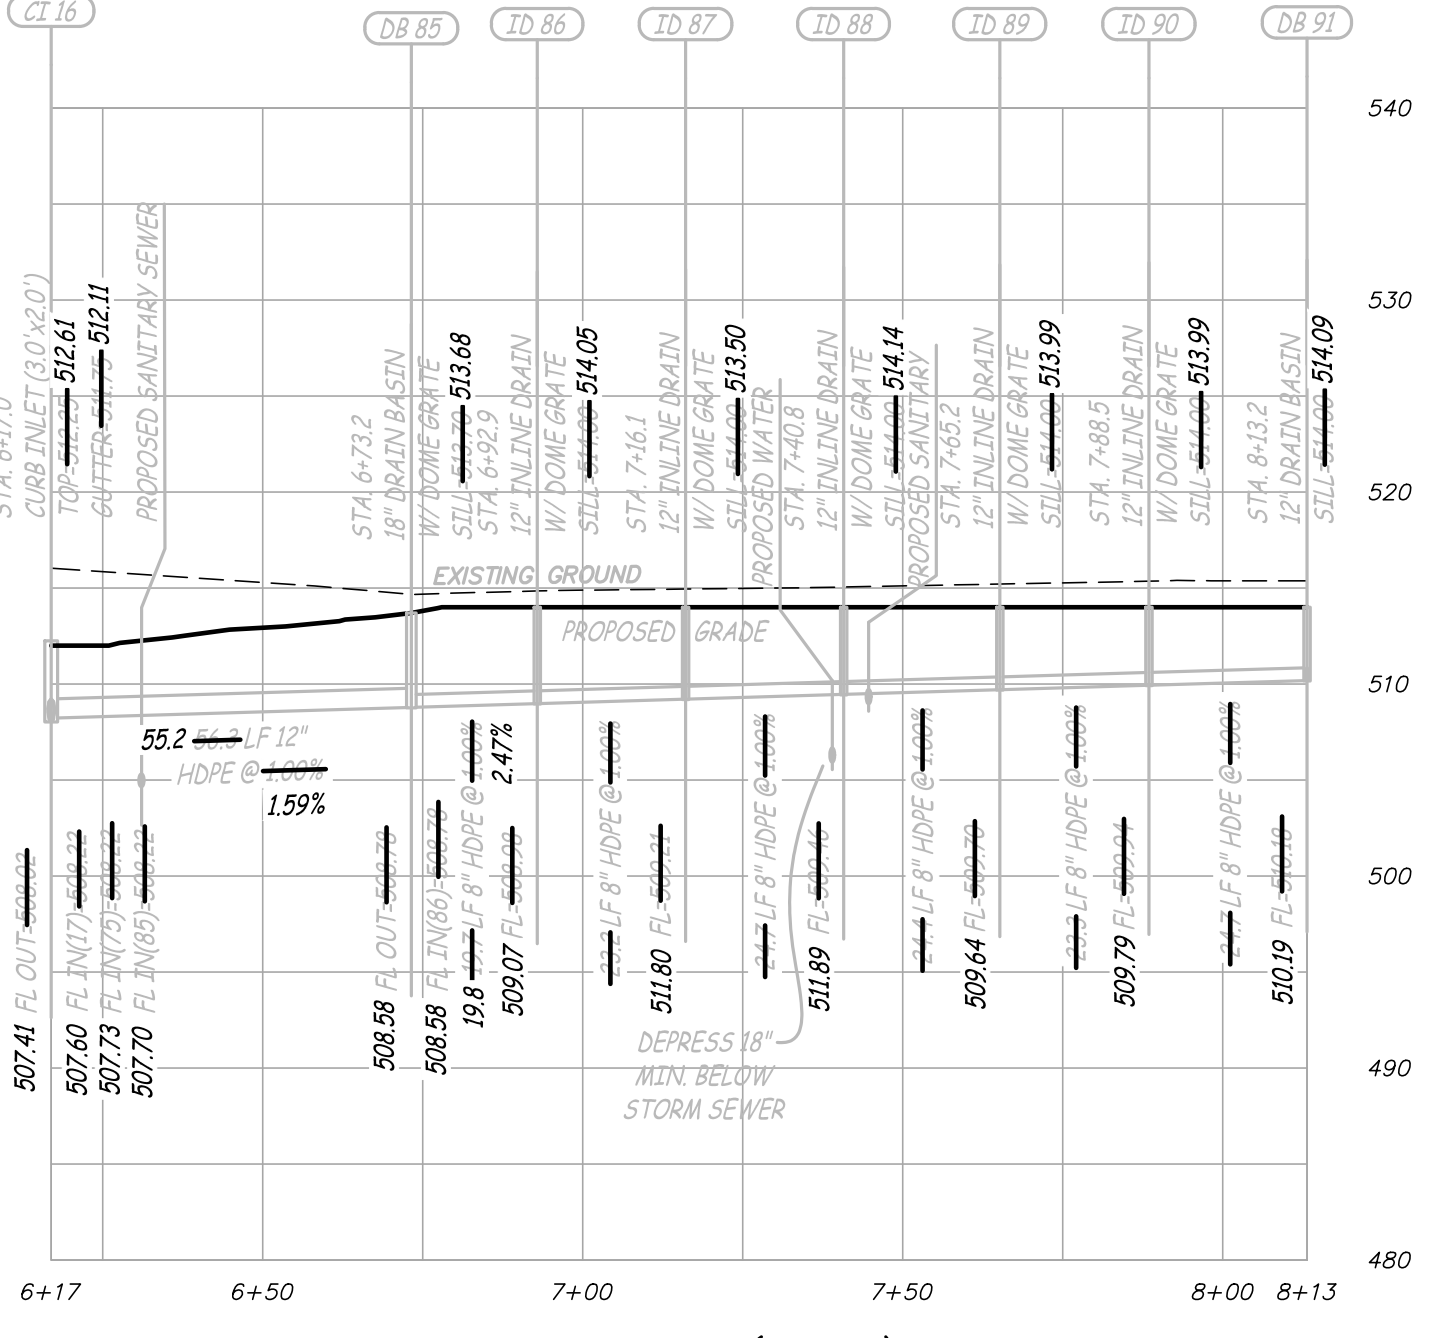

CI 16 THRU ID 91 (PRIVATE)
 SCALE - HORIZ. 1" = 30'
 VERT. 1" = 10'

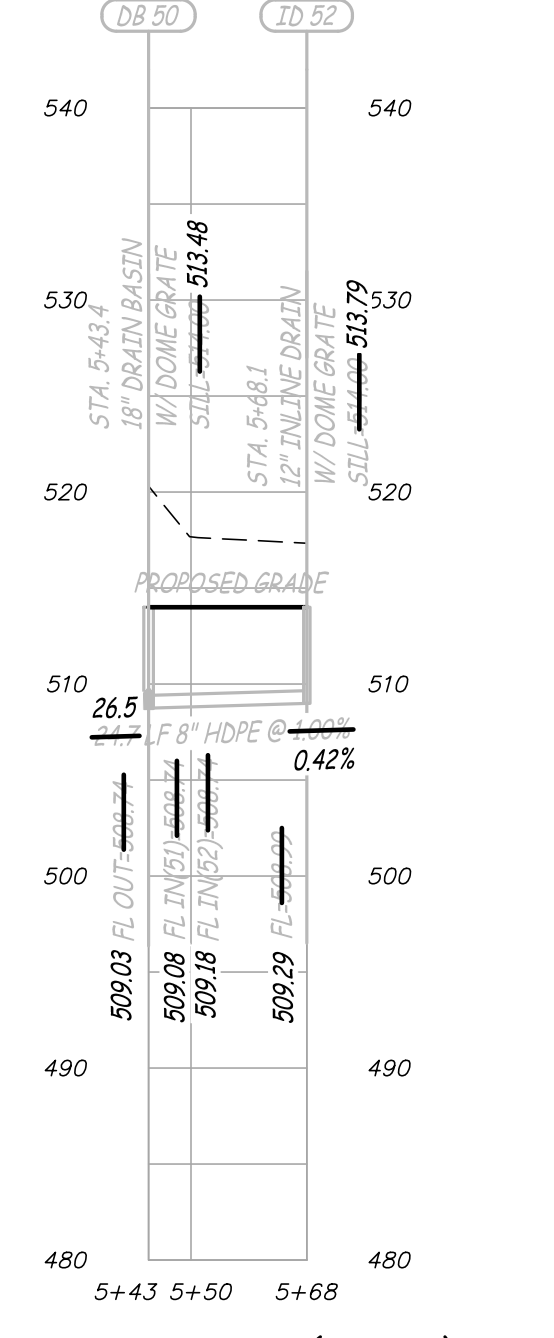


DB 50 THRU ID 52 (PRIVATE)
 SCALE - HORIZ. 1" = 30'
 VERT. 1" = 10'

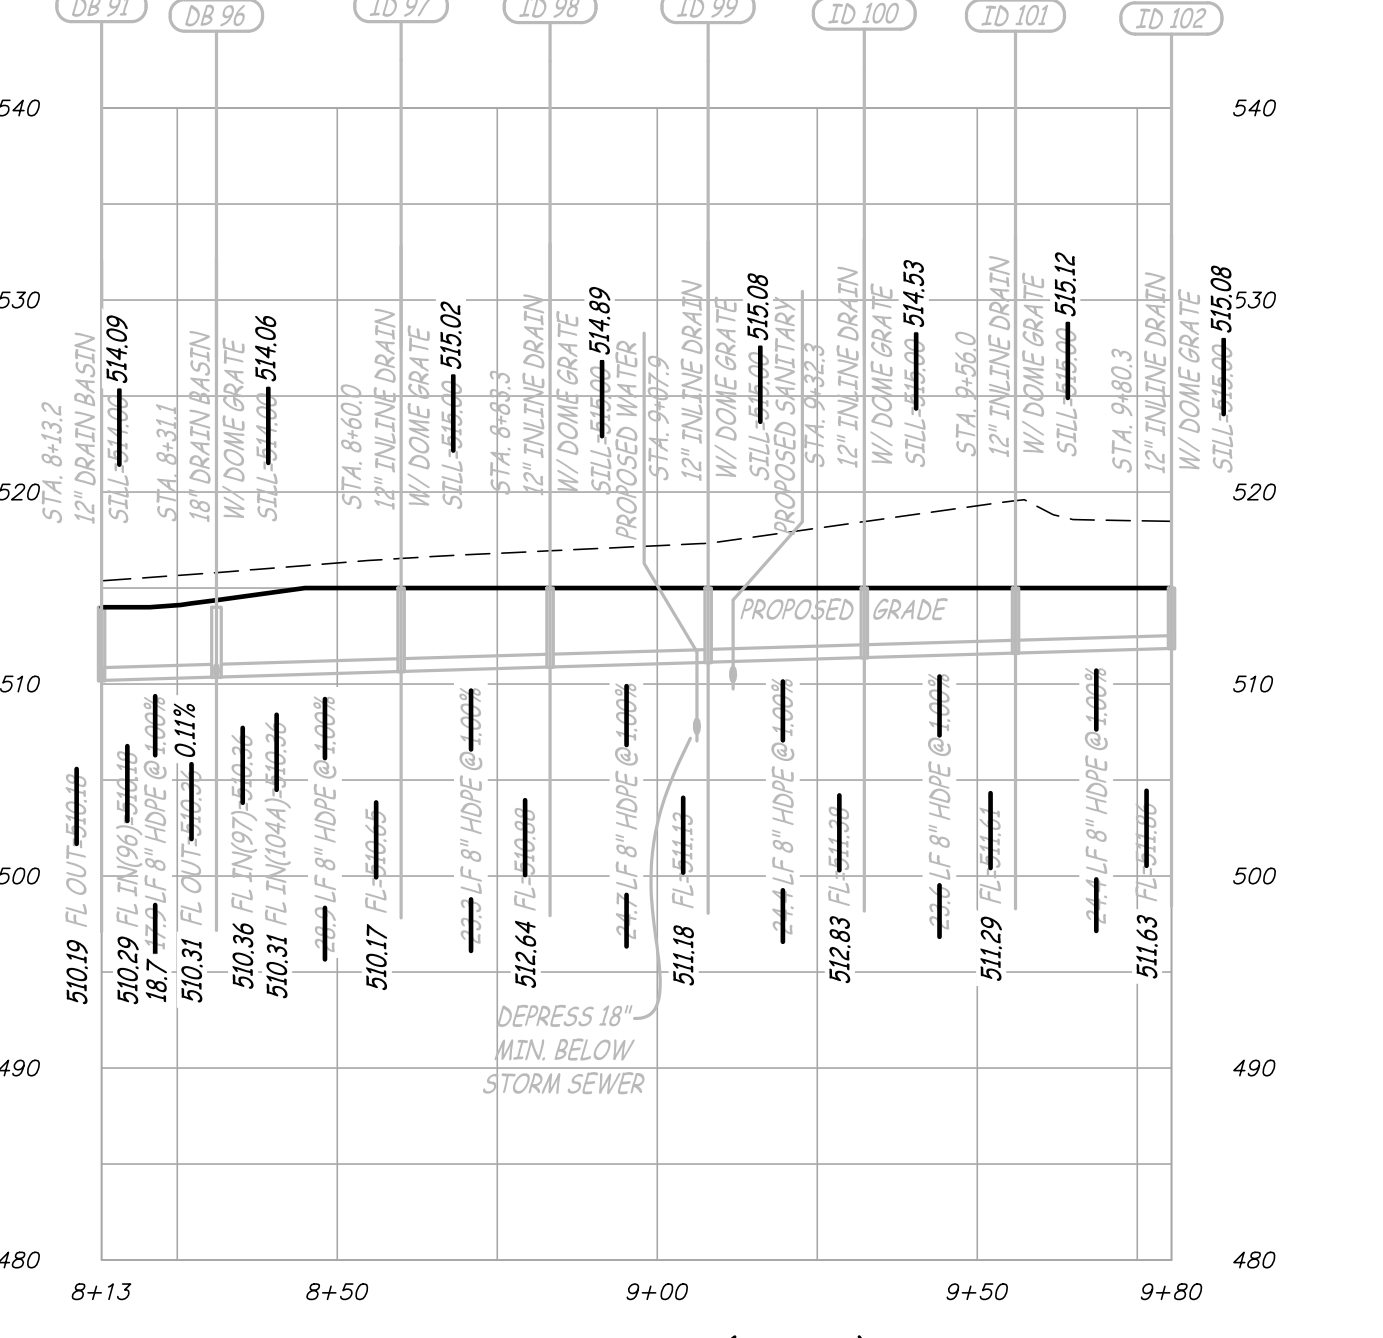

DB 91 THRU ID 102 (PRIVATE)
 SCALE - HORIZ. 1" = 30'
 VERT. 1" = 10'

P:\GENERAL PROJECTS\15421-ES-MEADOWOOD-POST-CONST-ALTA\CAD\15421-AS-BUILT.DWG 6/6/2022

JES DEVELOPMENT CO. INC.
MEADOWOOD ESTATES
 O'FALLON, ST. CHARLES COUNTY, MISSOURI

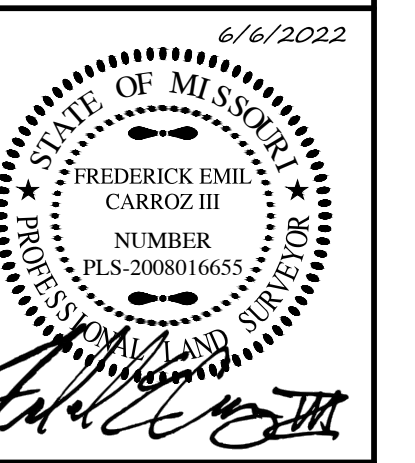

FREDERICK E. CARROZ III
 PROFESSIONAL LAND SURVEYOR
 PLS - 2008016655

IF ORIGINAL SIGNATURE OR DIGITAL AUTHENTICATION IS NOT PRESENT THIS MEDIA SHOULD NOT BE CONSIDERED A CERTIFIED DOCUMENT.

Date
JUNE 6, 2022

Revised

Surveyed: NTL Drawn: CGH


STORM SEWER AS-BUILT

Sheet


V1.11

11 of 12


ES&S PROJECT NO. 15421

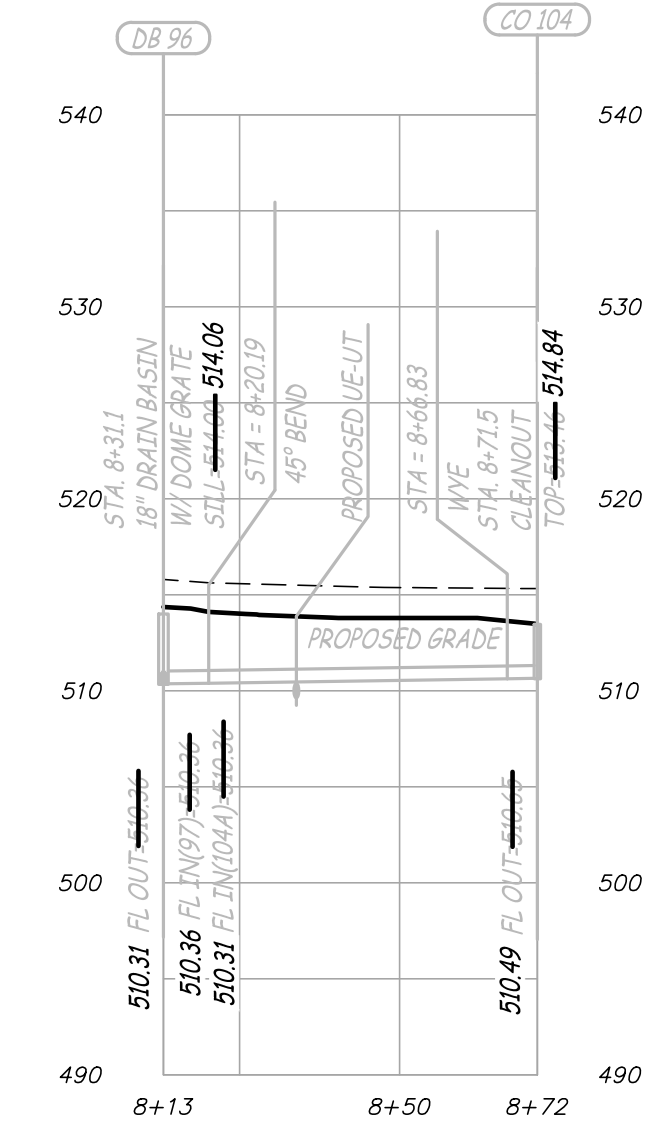


DB 96 THRU CO 104 (PRIVATE)
 SCALE - HORIZ. 1" = 30'
 VERT. 1" = 10'

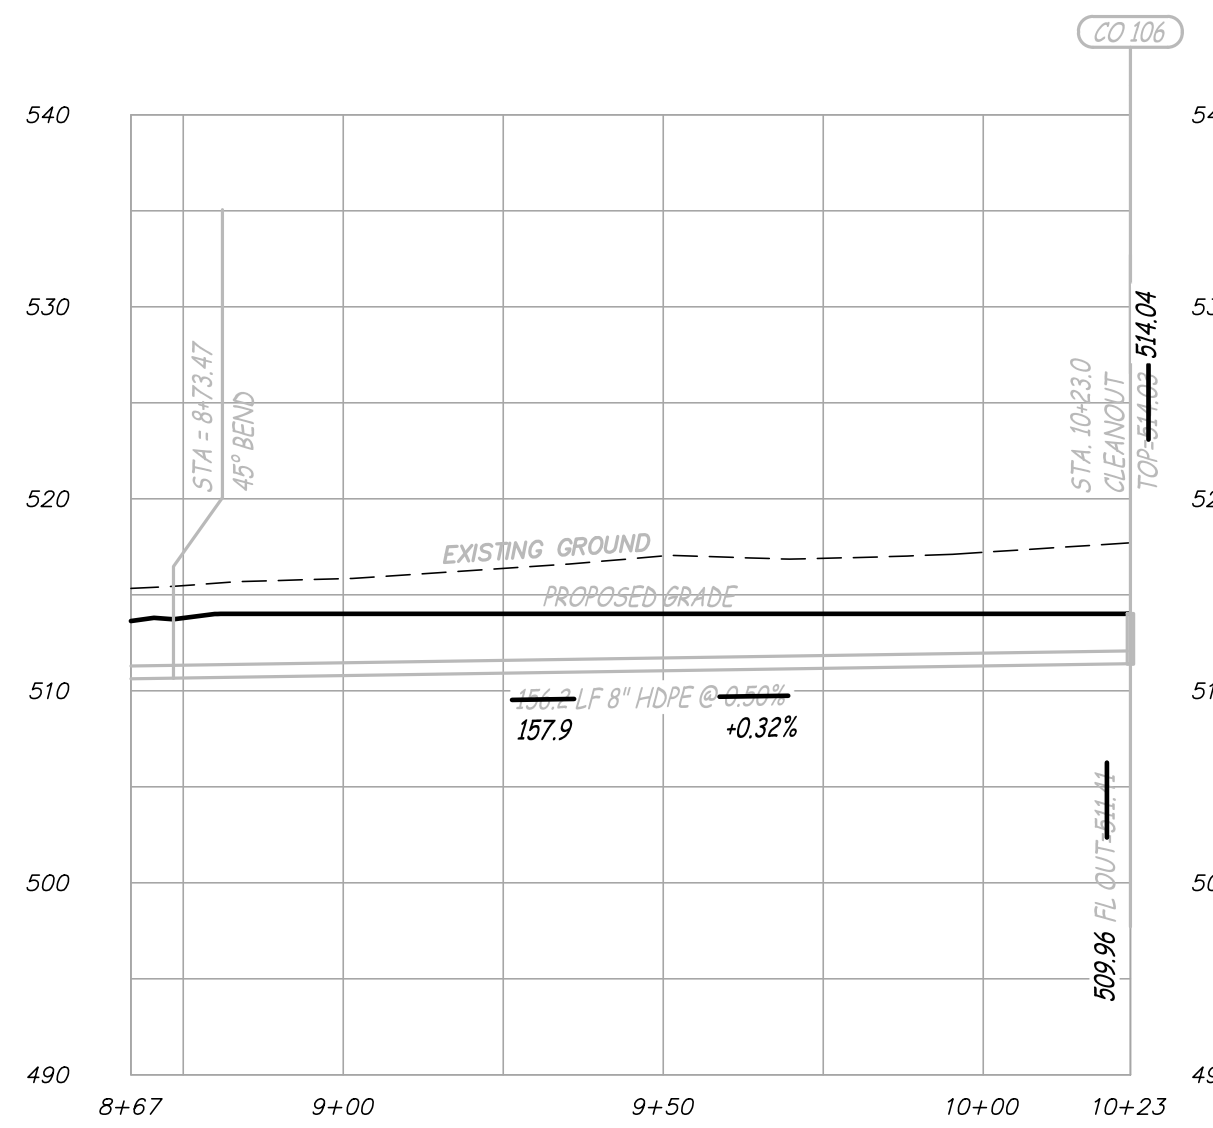


PIPE 104 THRU CO 106 (PRIVATE)
 SCALE - HORIZ. 1" = 30'
 VERT. 1" = 10'

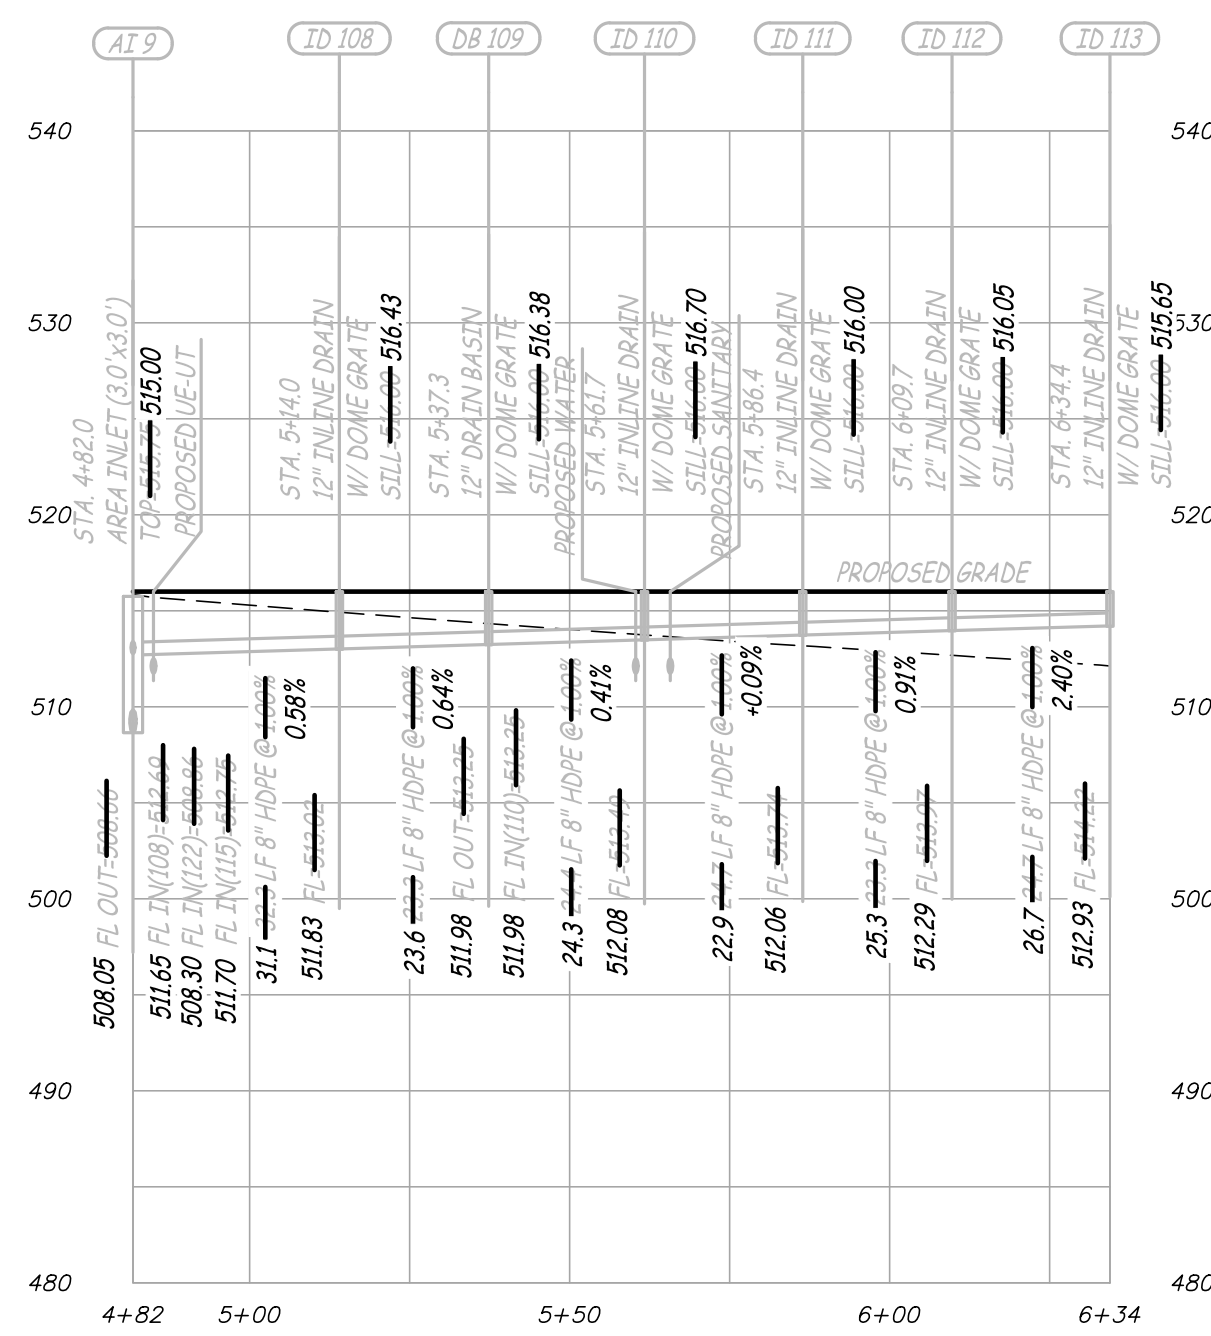


AI 9 THRU ID 113 (PRIVATE)
 SCALE - HORIZ. 1" = 30'
 VERT. 1" = 10'

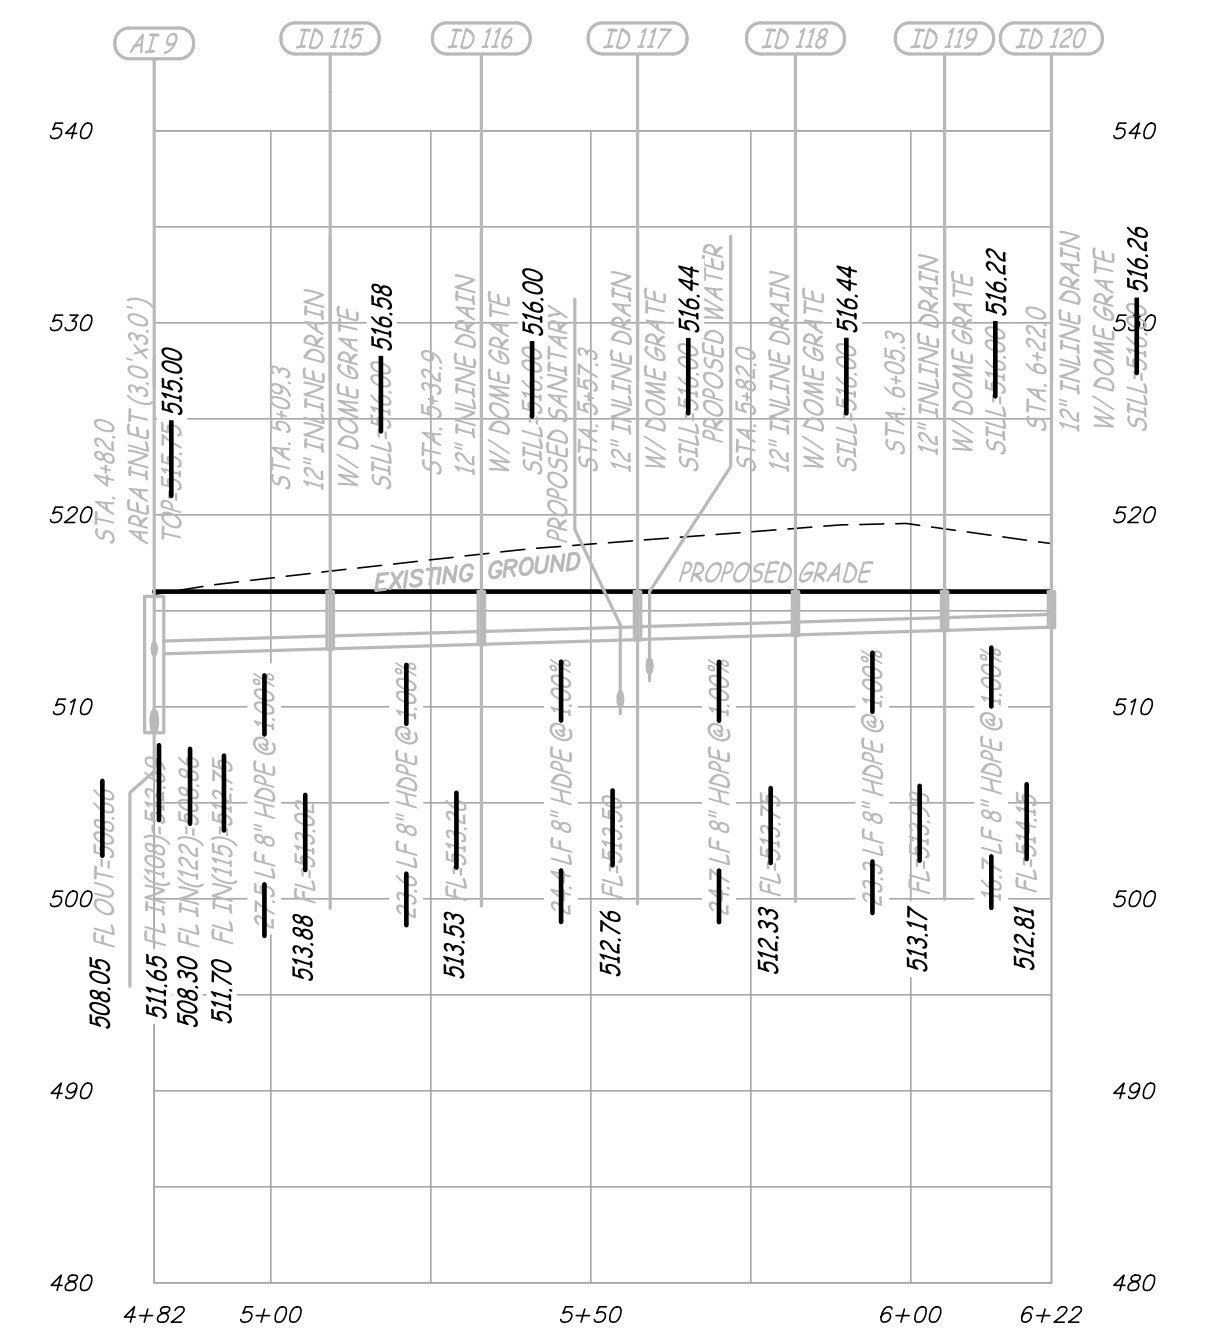


AI 9 THRU ID 120 (PRIVATE)
 SCALE - HORIZ. 1" = 30'
 VERT. 1" = 10'

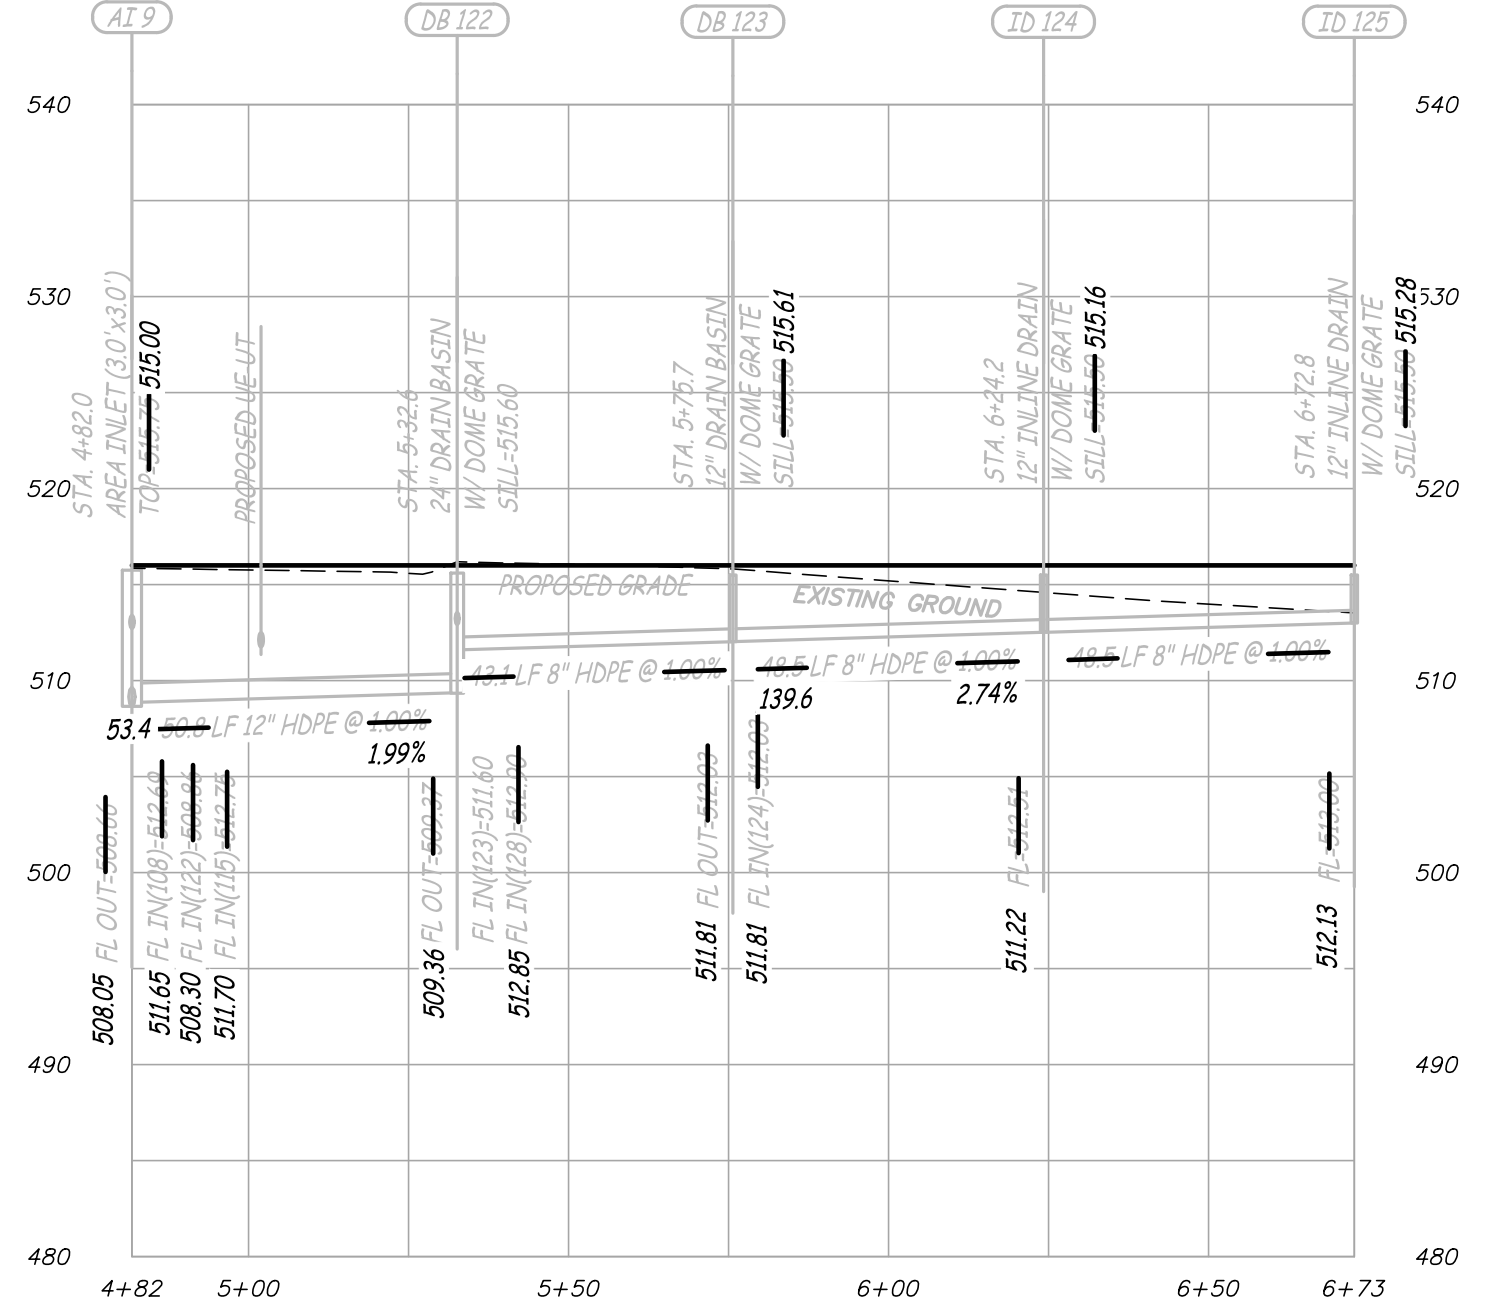


AI 9 THRU ID 125 (PRIVATE)
 SCALE - HORIZ. 1" = 30'
 VERT. 1" = 10'

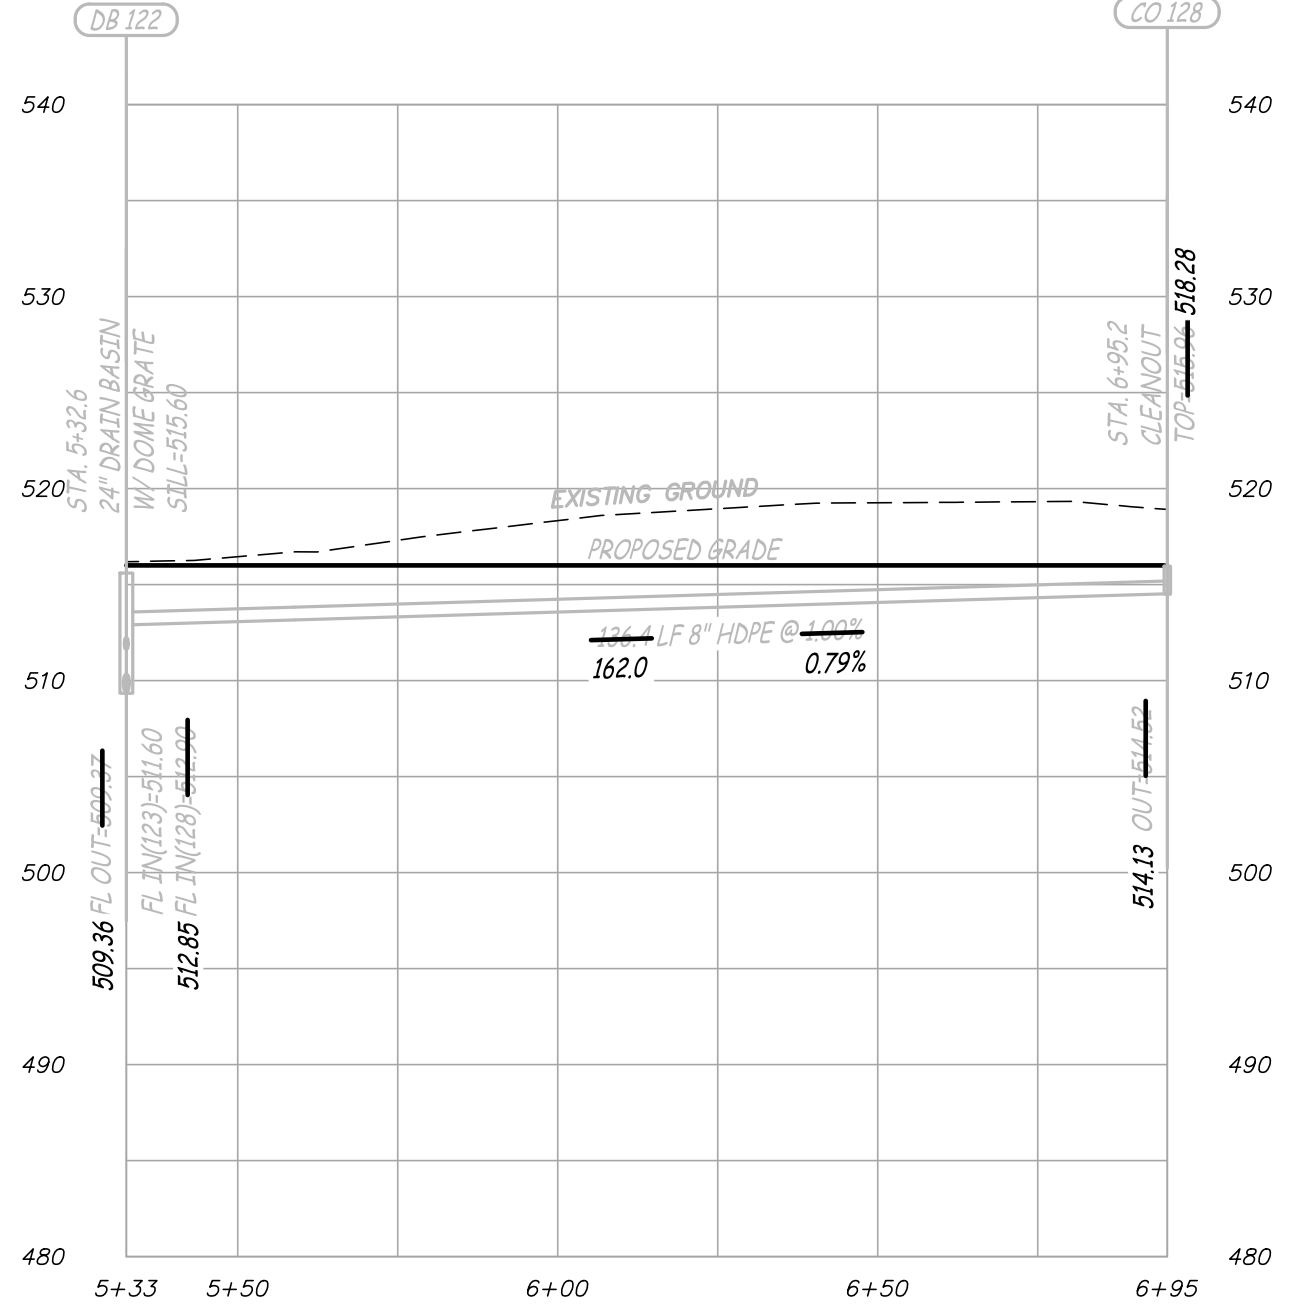

DB 122 THRU CO 128 (PRIVATE)
 SCALE - HORIZ. 1" = 30'
 VERT. 1" = 10'

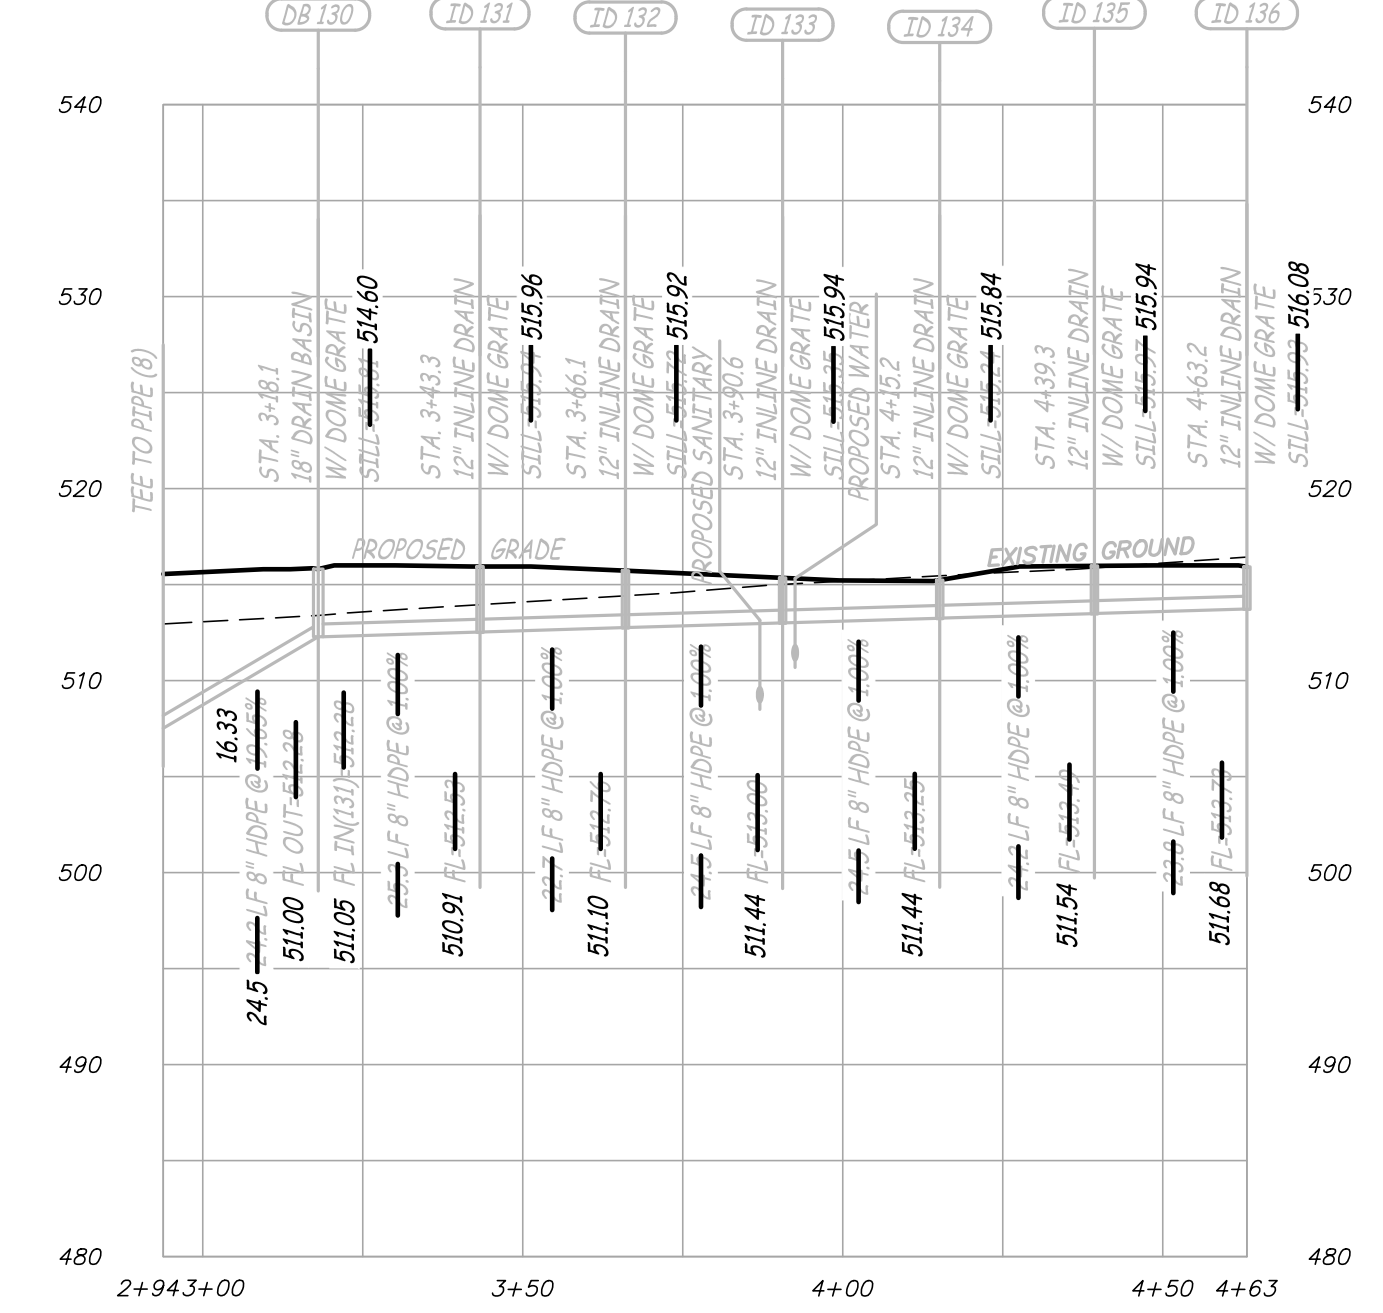

CI 7 THRU ID 136 (PRIVATE)
 SCALE - HORIZ. 1" = 30'
 VERT. 1" = 10'

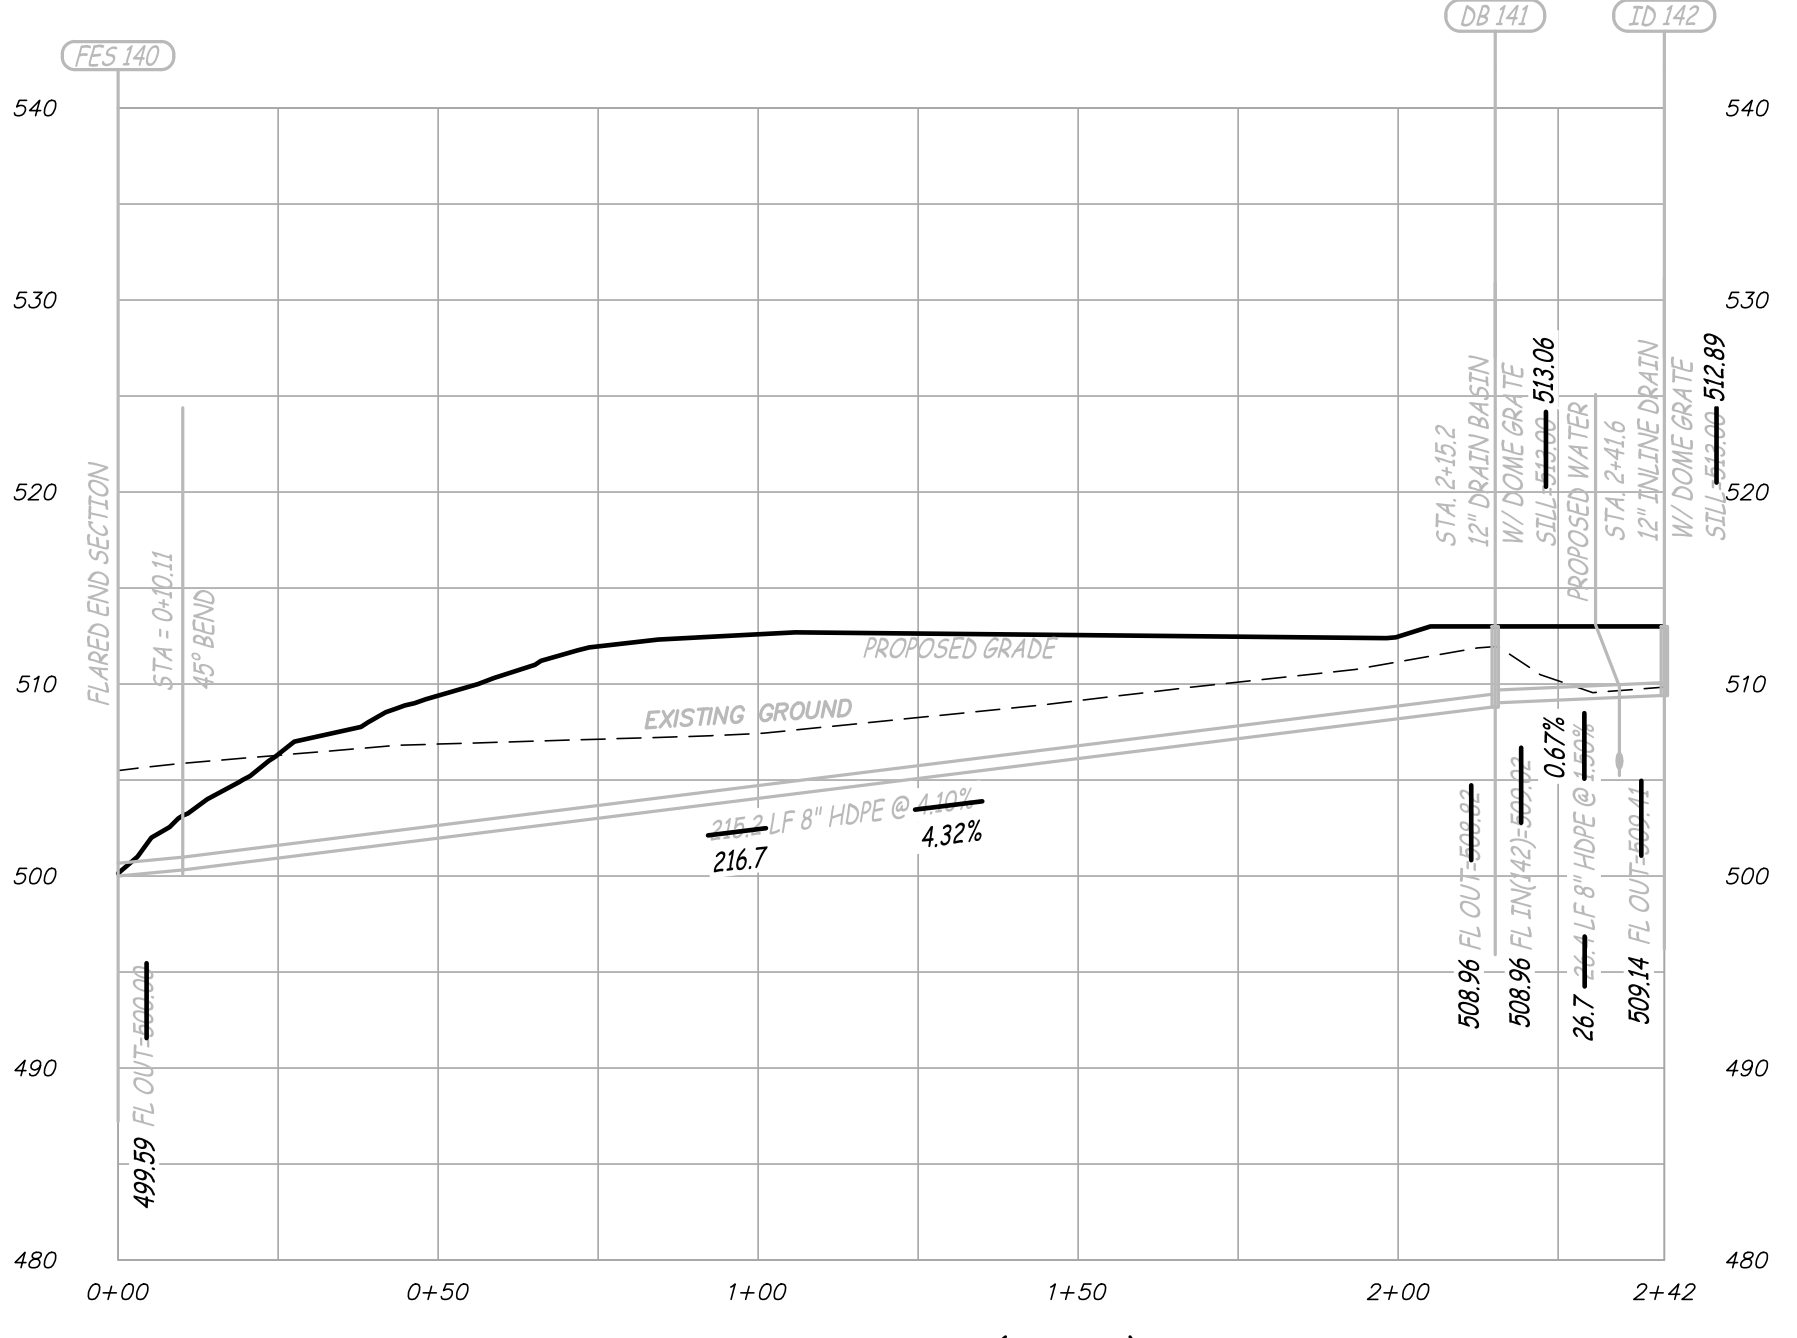

FES 140 THRU ID 142 (PRIVATE)
 SCALE - HORIZ. 1" = 30'
 VERT. 1" = 10'

P:\GENERAL PROJECTS\15421-ES-MEADOWOOD-POST-CONST-ALTA\CAD\15421_AS-BUILTS.DWG 6/6/2022

