
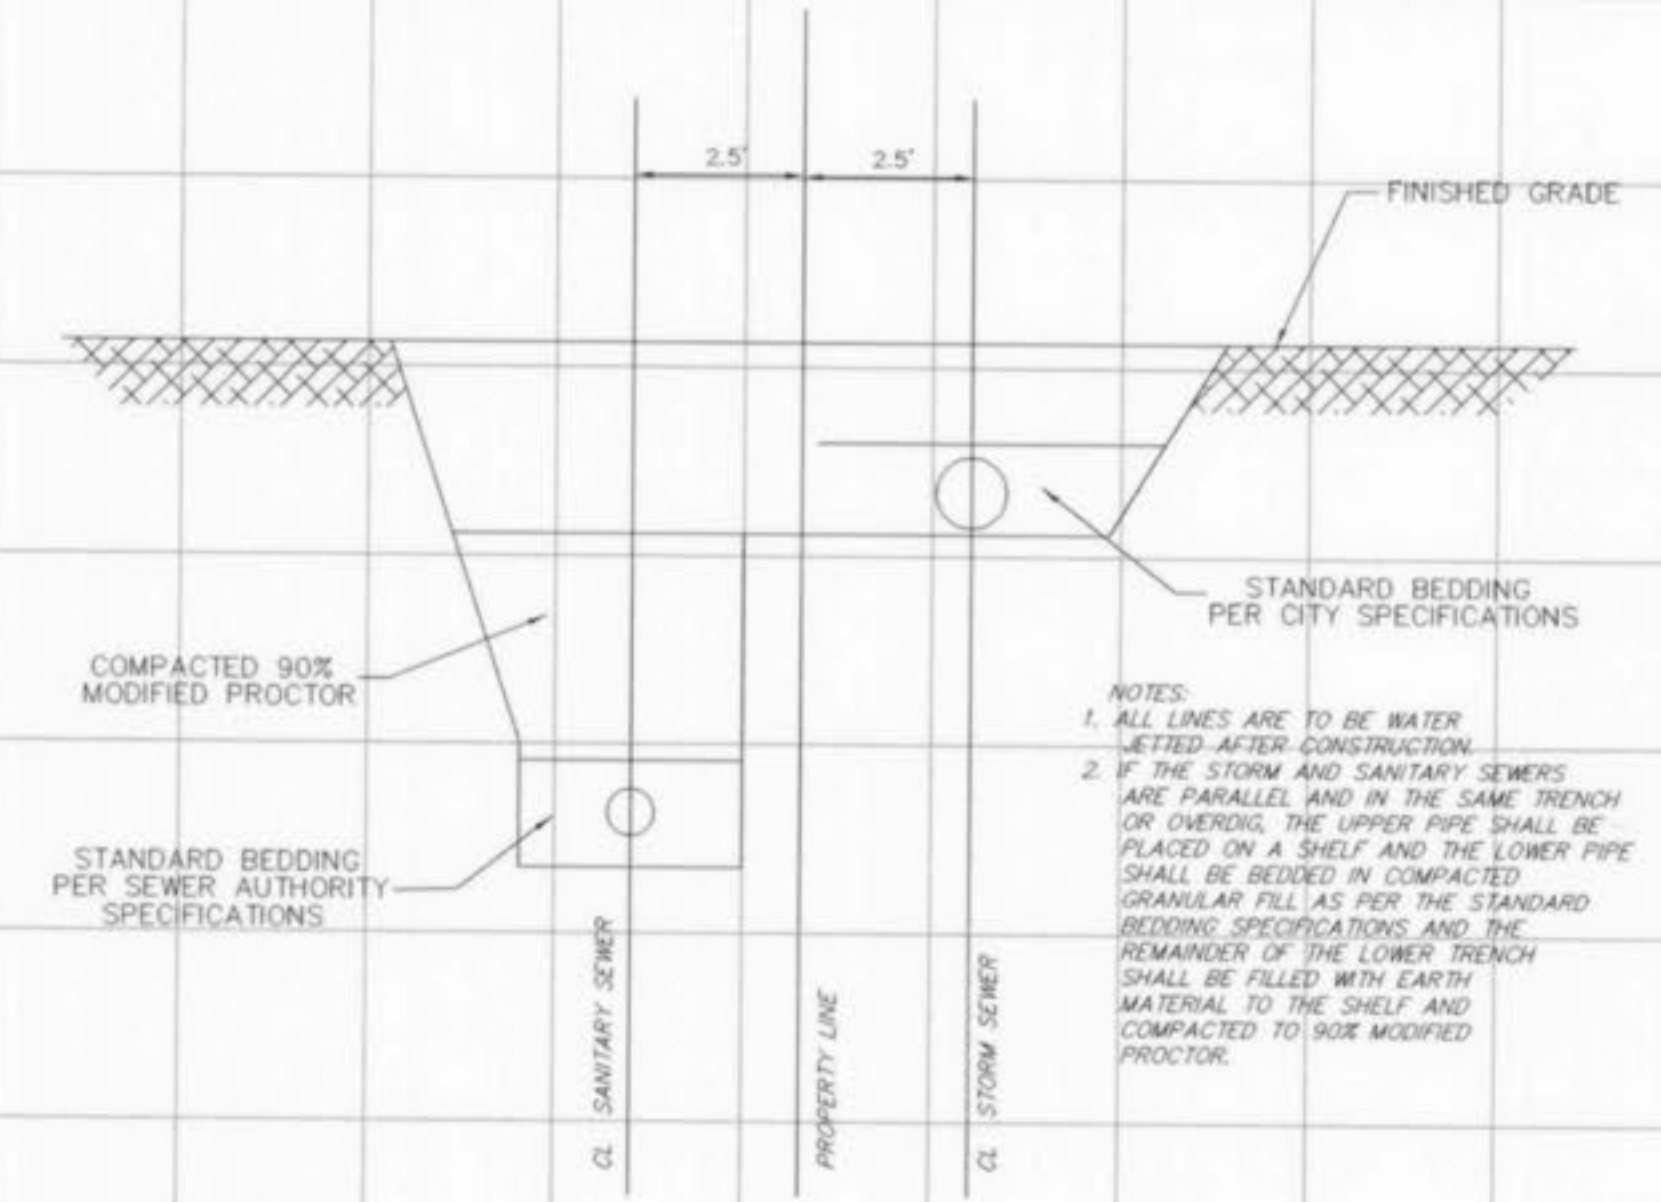


**AS-BUILTS ADDED
 NOVEMBER, 2003**


UNDERGROUND UTILITIES HAVE BEEN PLOTTED FROM AVAILABLE INFORMATION AND THEREFORE THEIR LOCATIONS SHALL BE CONSIDERED APPROXIMATE ONLY. THE VERIFICATION OF THE LOCATION OF ALL UNDERGROUND UTILITIES, EITHER SHOWN OR NOT SHOWN ON THESE PLANS SHALL BE THE RESPONSIBILITY OF THE CONTRACTOR, AND SHALL BE LOCATED PRIOR TO ANY GRADING OR CONSTRUCTION OF THE IMPROVEMENTS.

AS-BUILTS NOTE:
 ALL DISTANCE AND SLOPE CALCULATIONS ARE FROM CENTER OF STRUCTURE TO CENTER OF STRUCTURE.

Meadows @ Parkwood Est. Inc.
 Approved 2/23/04 AAK

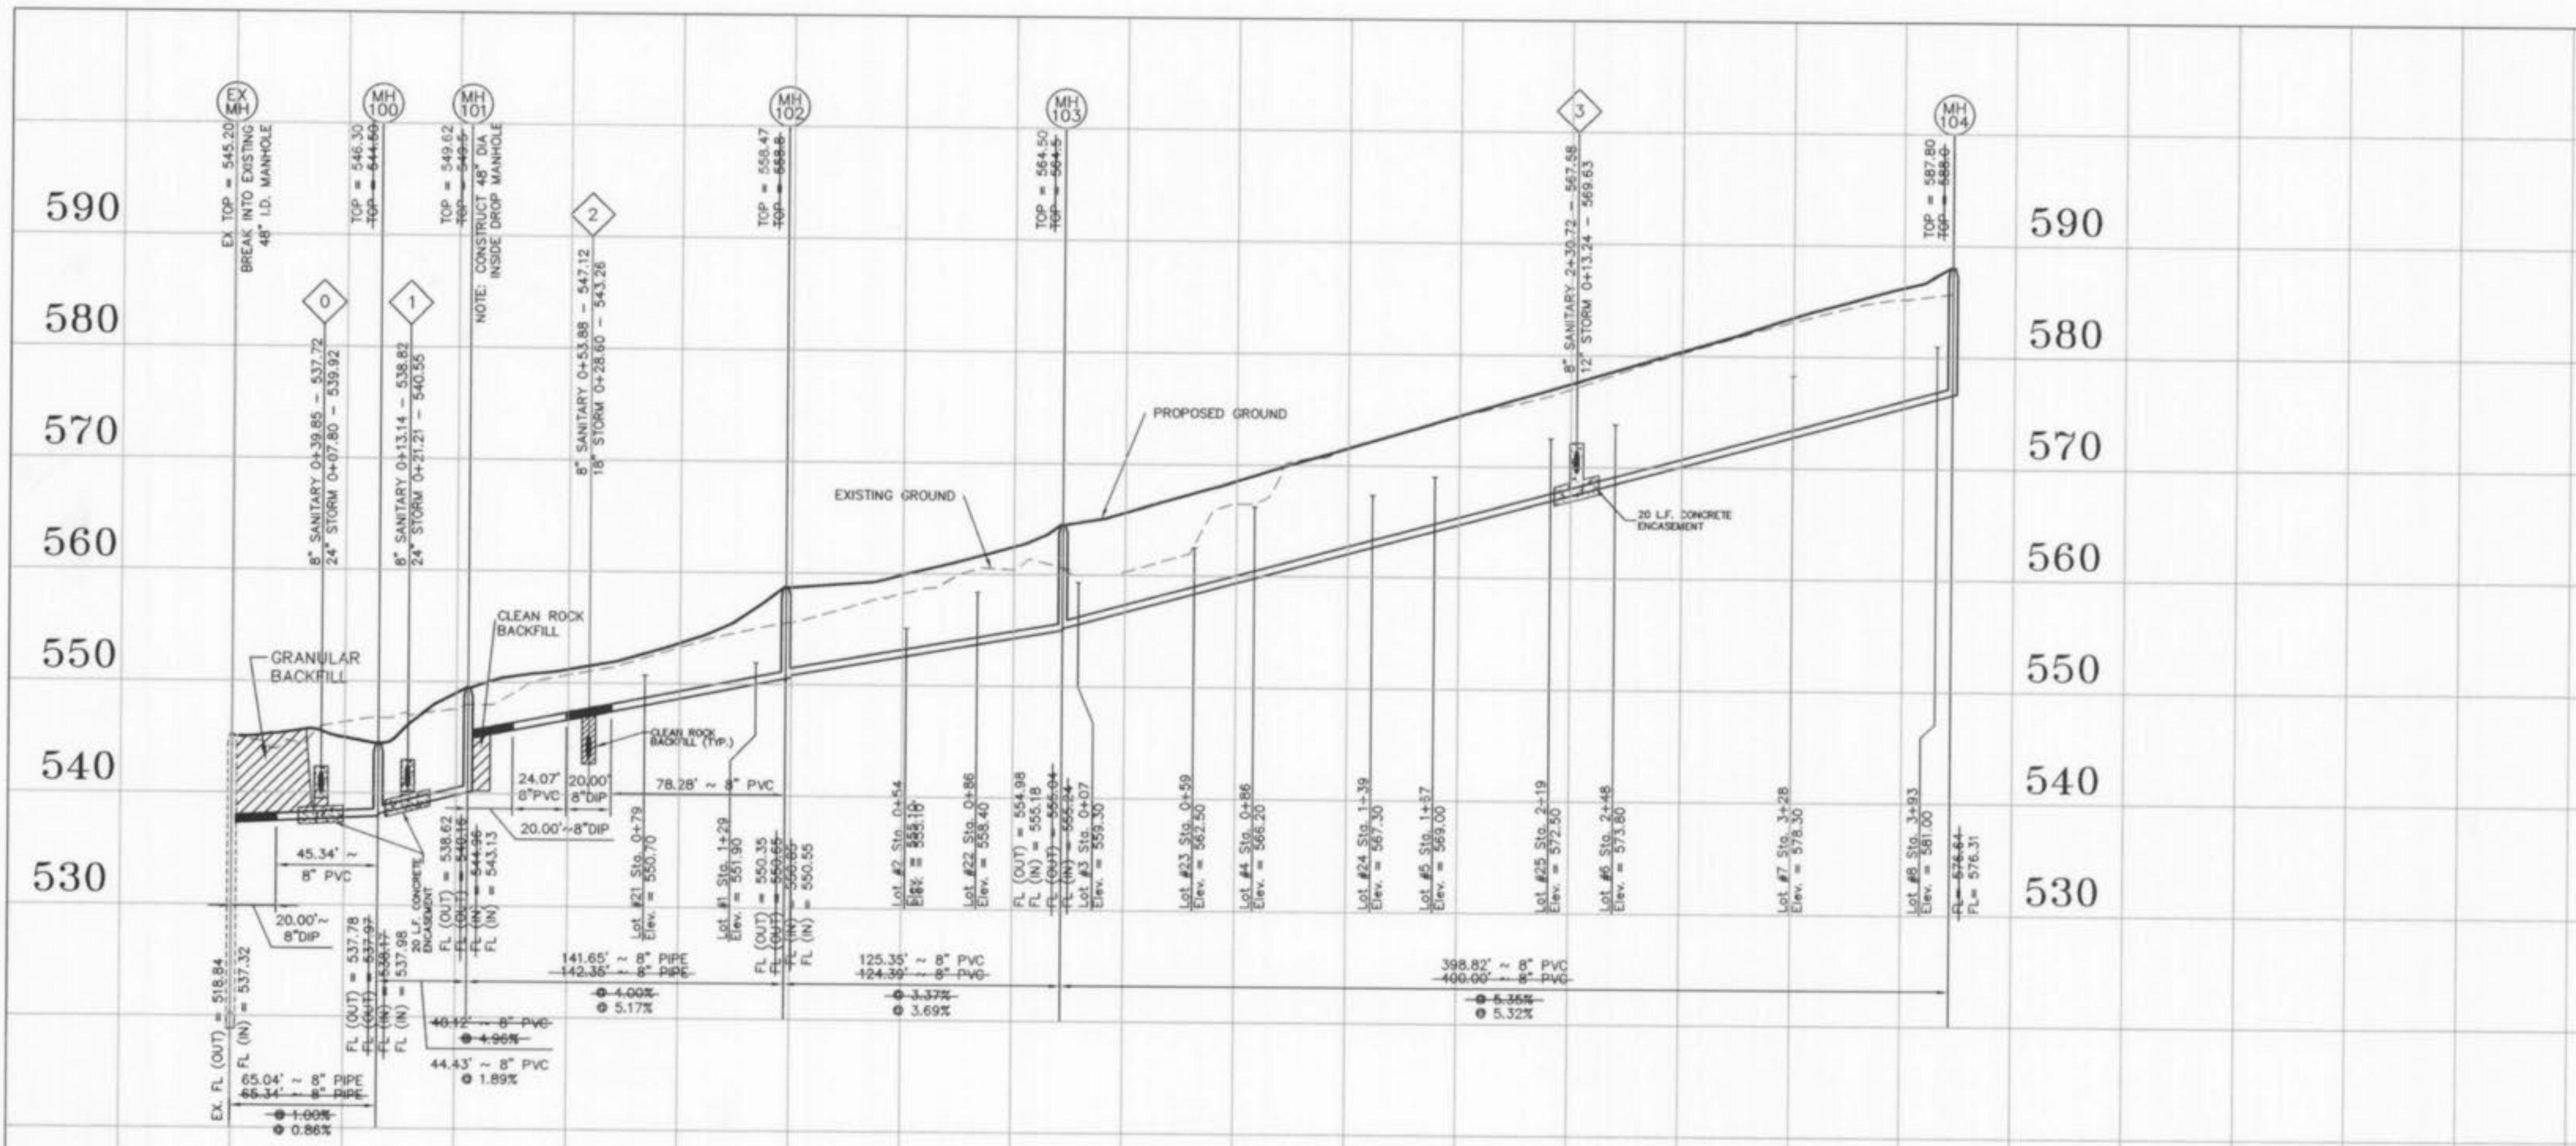

SANITARY AND STORM SEWER TRENCH DETAIL
 (FOR PARALLEL LINES)
 NO SCALE

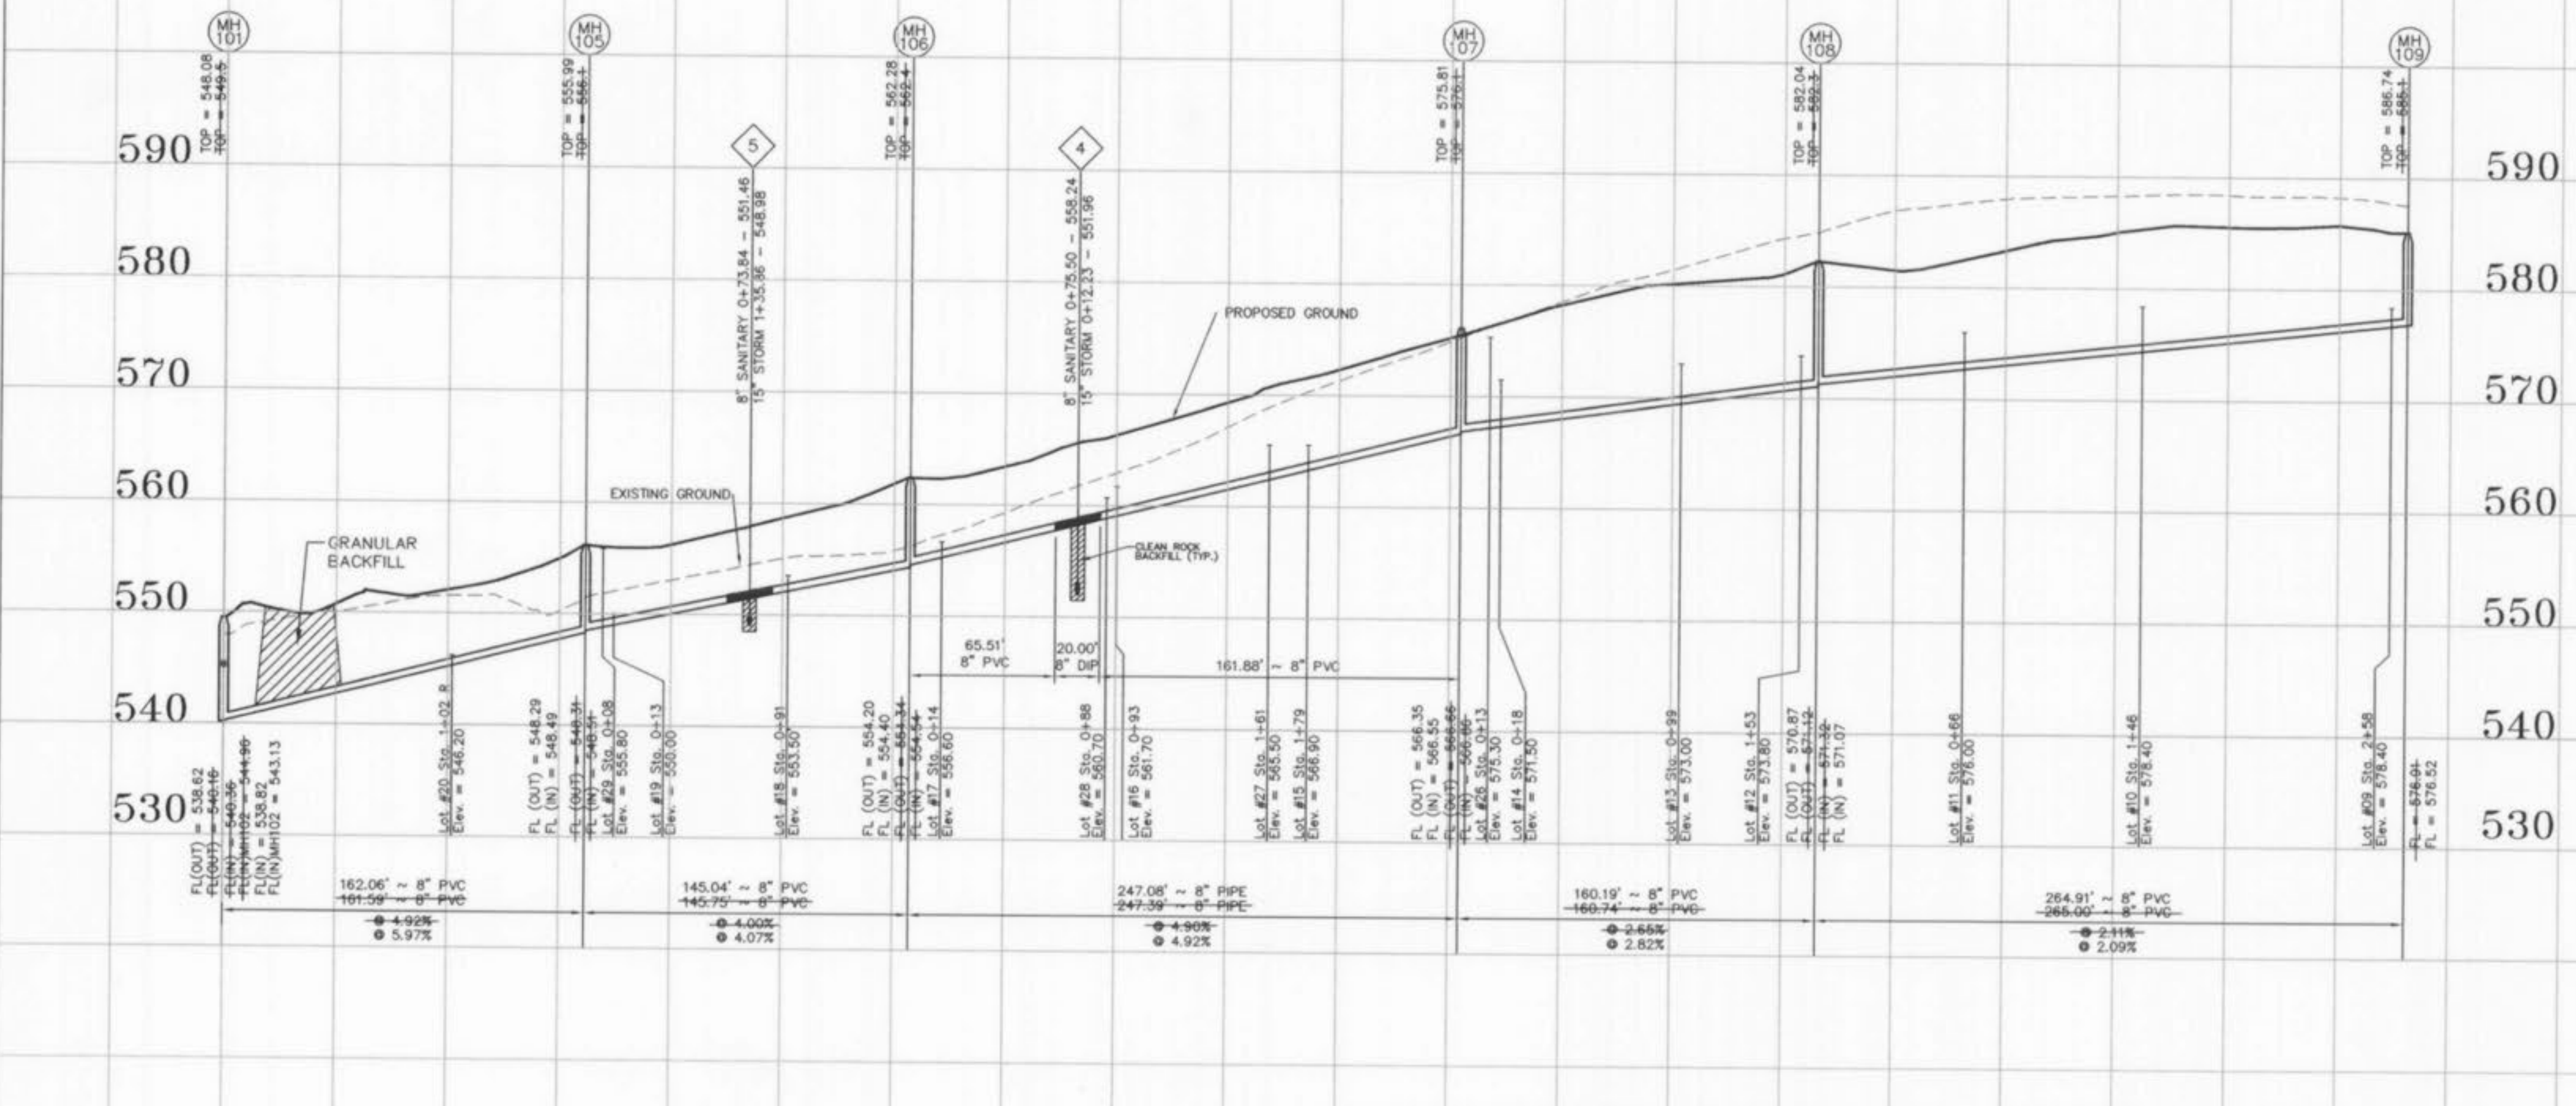

AS-BUILTS ADDED NOVEMBER, 2003.




UNDERGROUND UTILITIES HAVE BEEN PLOTTED FROM AVAILABLE INFORMATION AND THEREFORE THEIR LOCATIONS SHALL BE CONSIDERED APPROXIMATE ONLY. THE VERIFICATION OF THE LOCATION OF ALL UNDERGROUND UTILITIES, EITHER SHOWN OR NOT SHOWN ON THESE PLANS SHALL BE THE RESPONSIBILITY OF THE CONTRACTOR, AND SHALL BE LOCATED PRIOR TO ANY GRADING OR CONSTRUCTION OF THE IMPROVEMENTS.

AS-BUILTS NOTE:
 ALL DISTANCE AND SLOPE CALCULATIONS ARE FROM CENTER OF STRUCTURE TO CENTER OF STRUCTURE.

SCALE: VERTICAL = 1:10
 HORIZONTAL = 1:50

mandate @ Parkwood Estates
 Approved 2/24/04 AAK

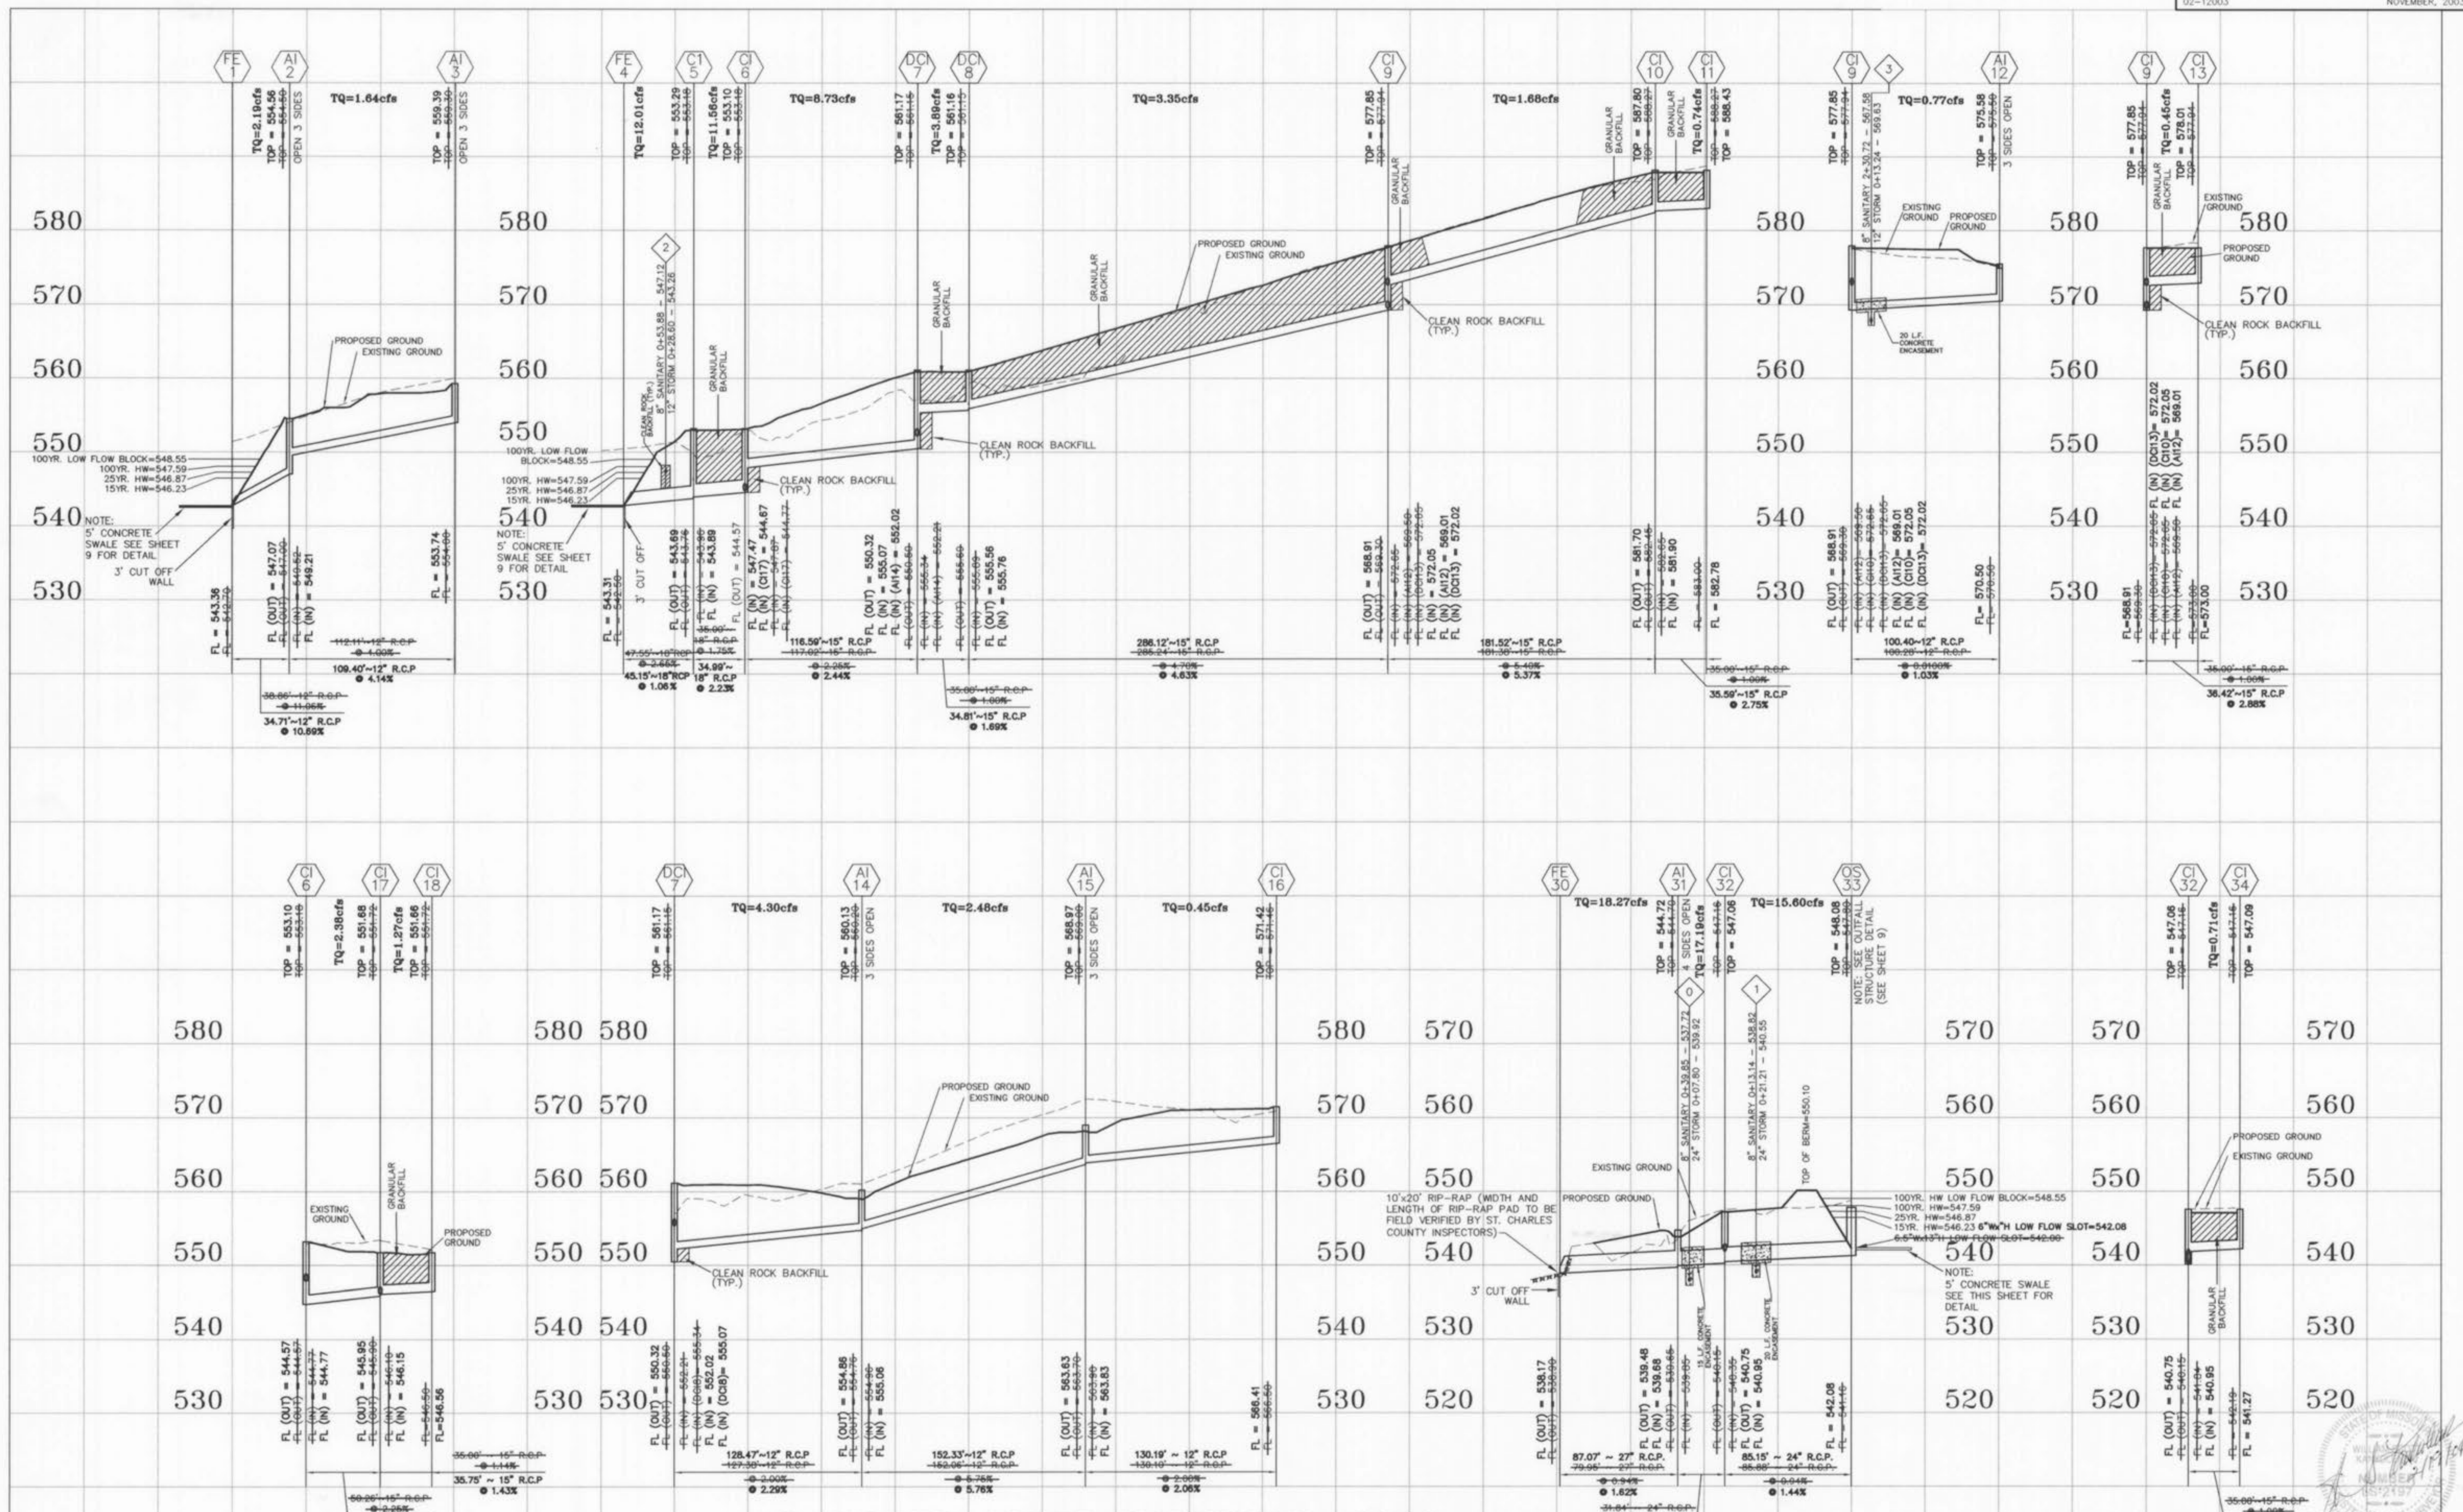

AS-BUILTS ADDED NOVEMBER, 2003.

SCALE: VERTICAL = 1:10
 HORIZONTAL = 1:50



4
 5

UNDERGROUND UTILITIES HAVE BEEN PLOTTED FROM AVAILABLE INFORMATION AND THEREFORE THEIR LOCATIONS SHALL BE CONSIDERED APPROXIMATE ONLY. THE VERIFICATION OF THE LOCATION OF ALL UNDERGROUND UTILITIES, EITHER SHOWN OR NOT SHOWN ON THESE PLANS SHALL BE THE RESPONSIBILITY OF THE CONTRACTOR, AND SHALL BE LOCATED PRIOR TO ANY GRADING OR CONSTRUCTION OF THE IMPROVEMENTS.

AS-BUILTS NOTE:
 ALL DISTANCE AND SLOPE CALCULATIONS ARE FROM CENTER OF STRUCTURE TO CENTER OF STRUCTURE.




Mendow of Parkwood Estates
 Approved 2/23/04 AAK

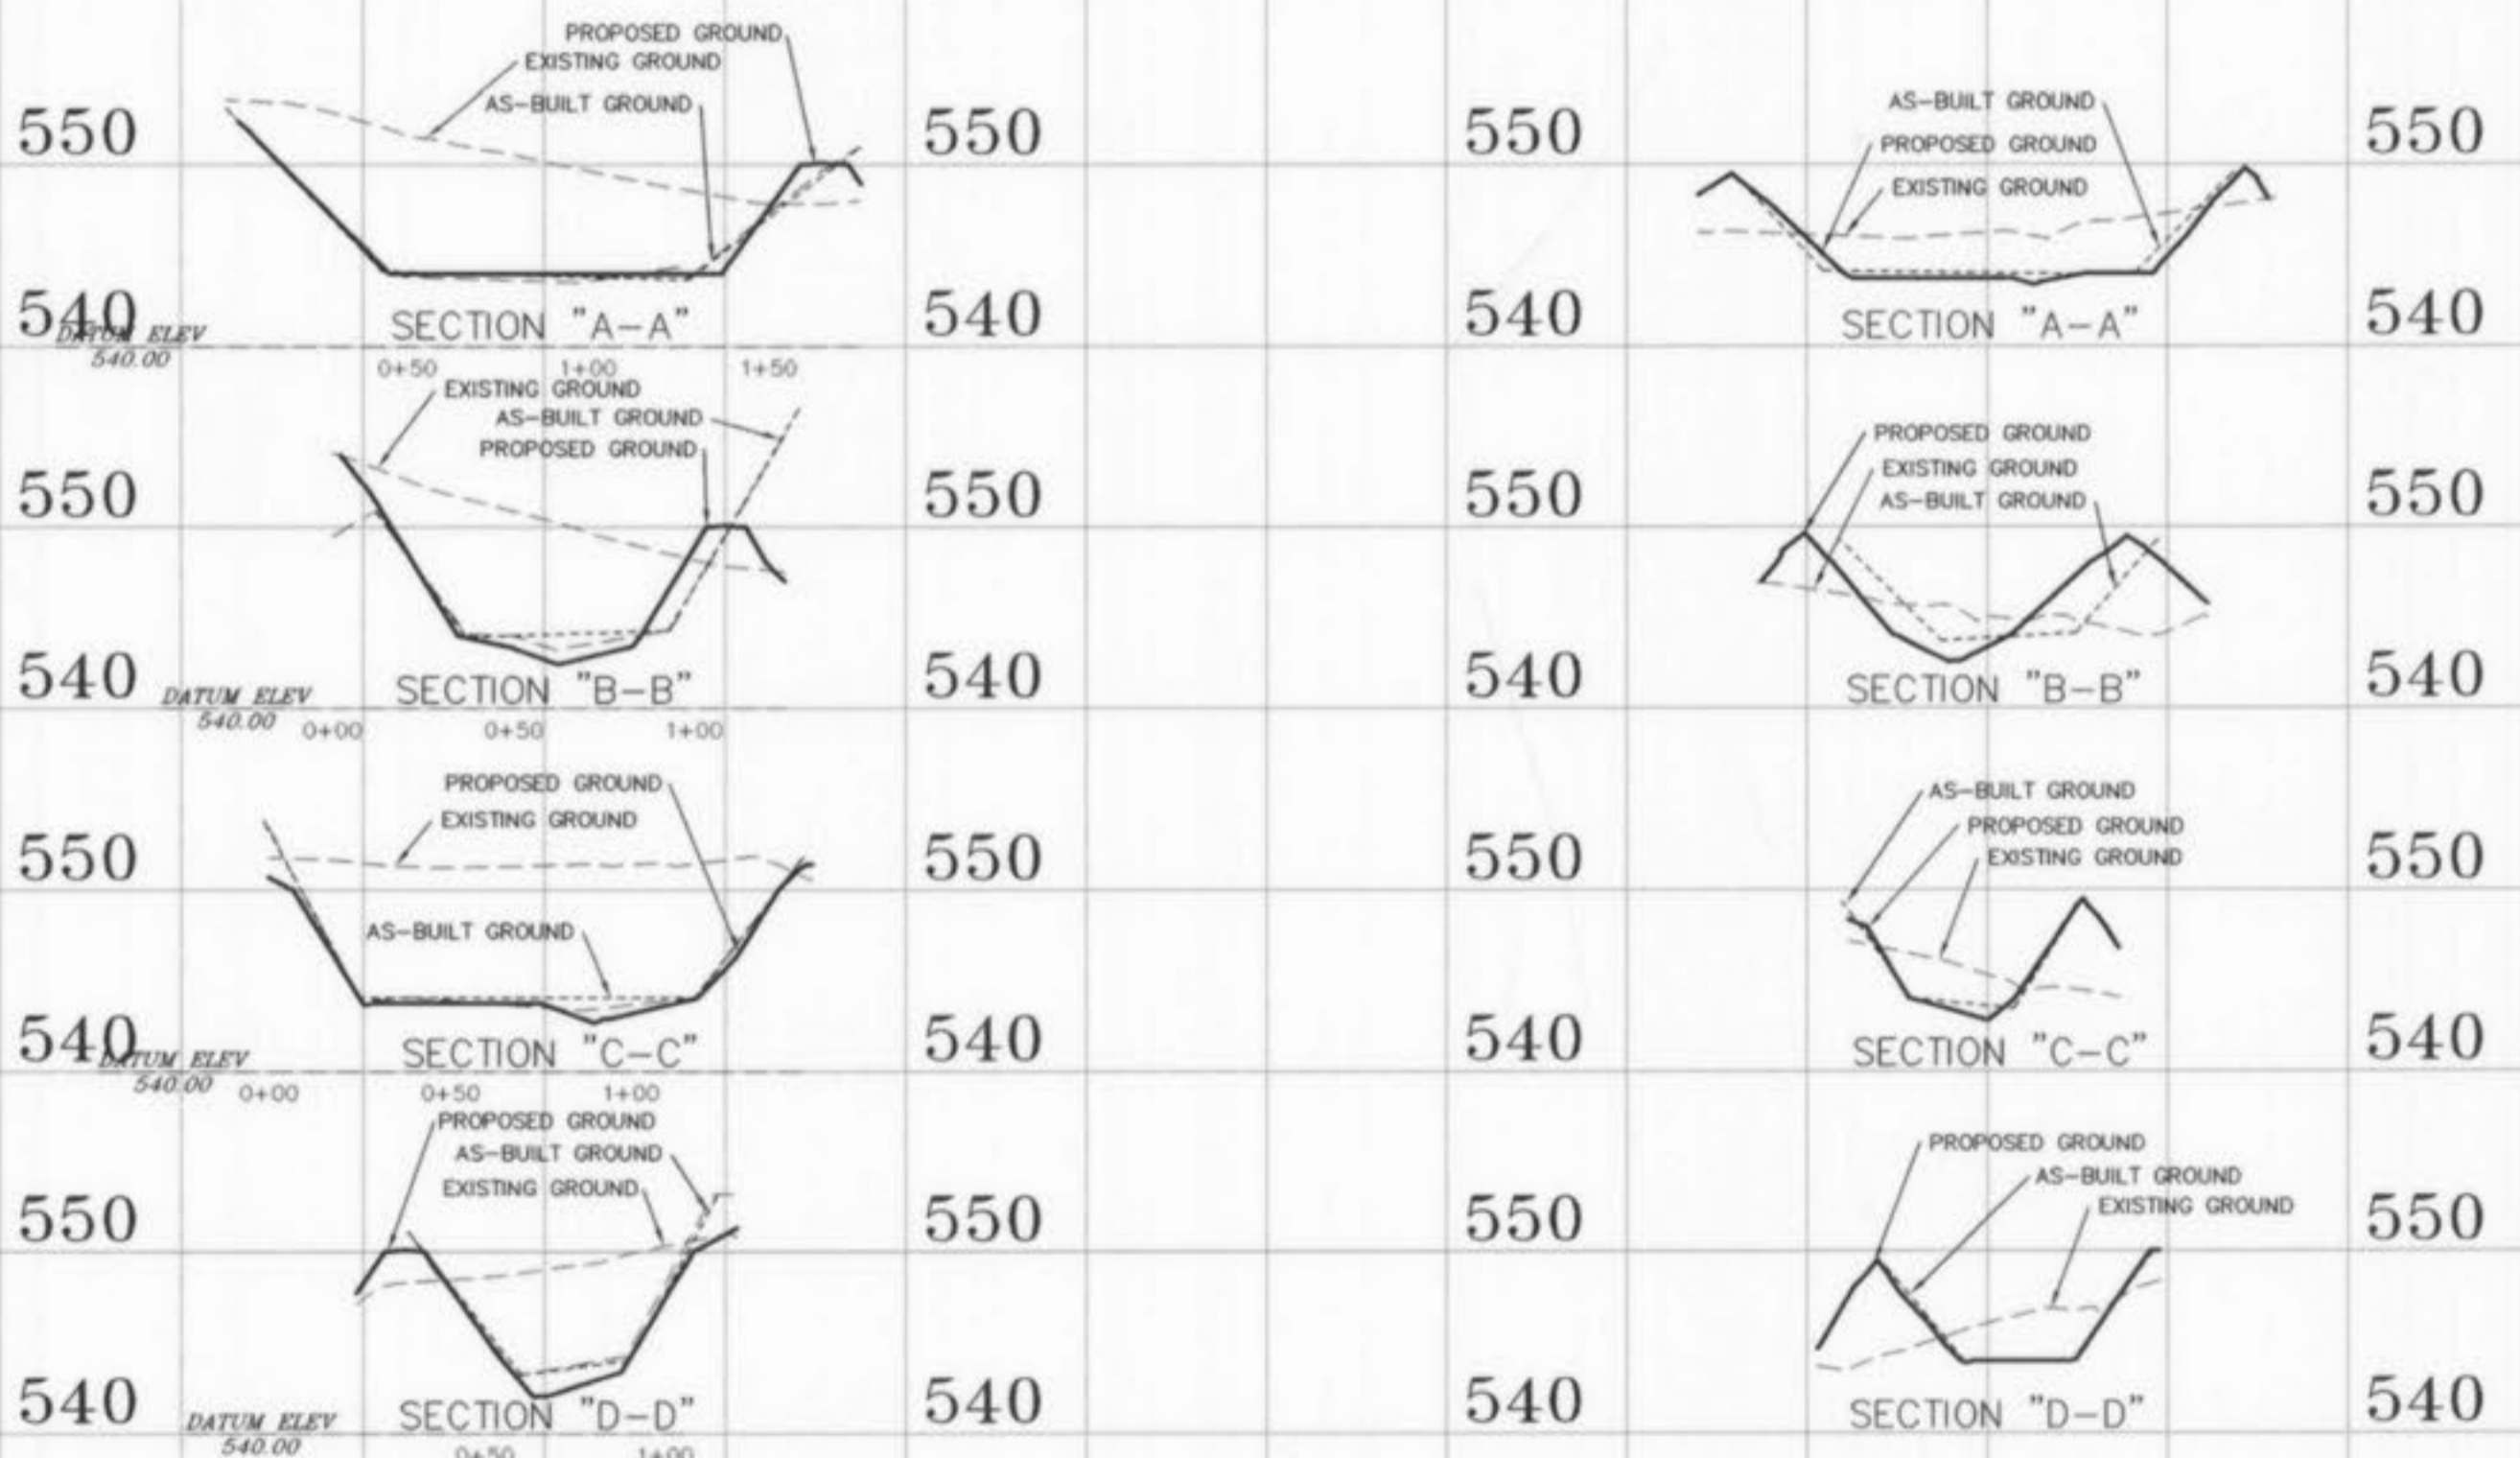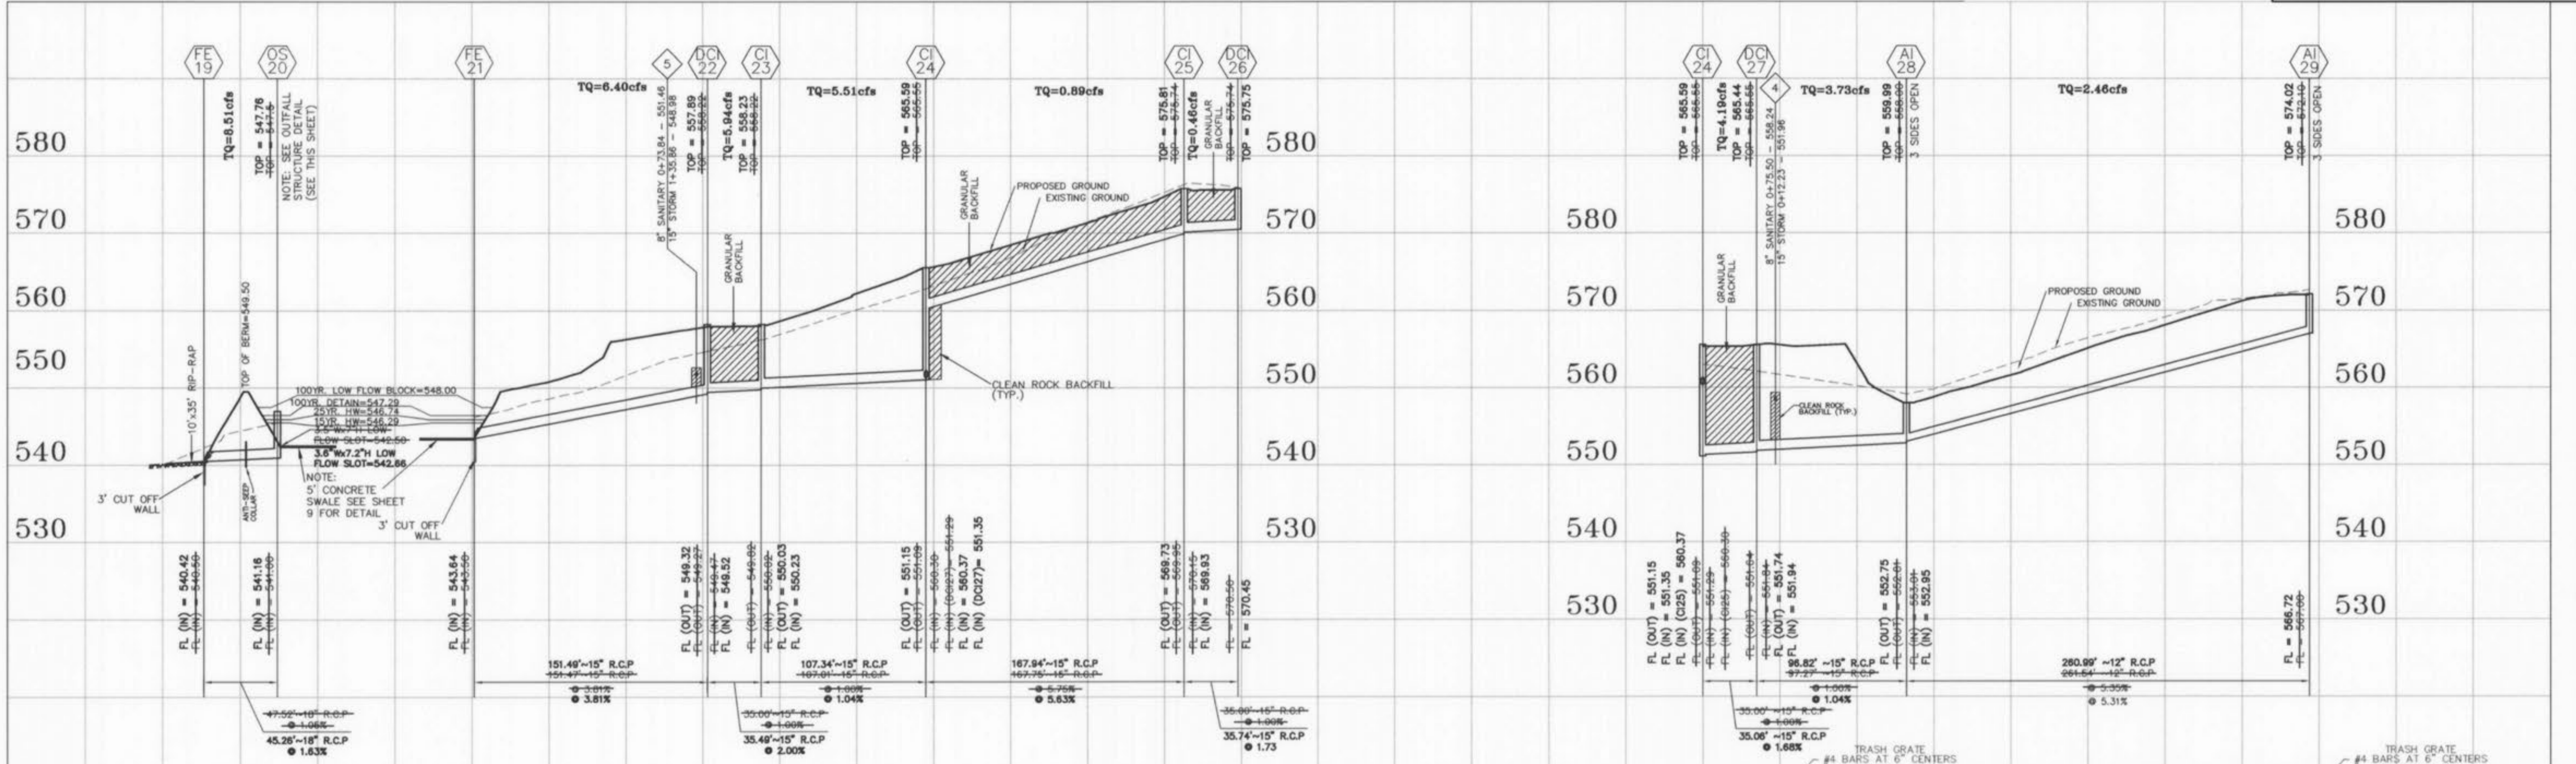


BASIN A


BASIN B

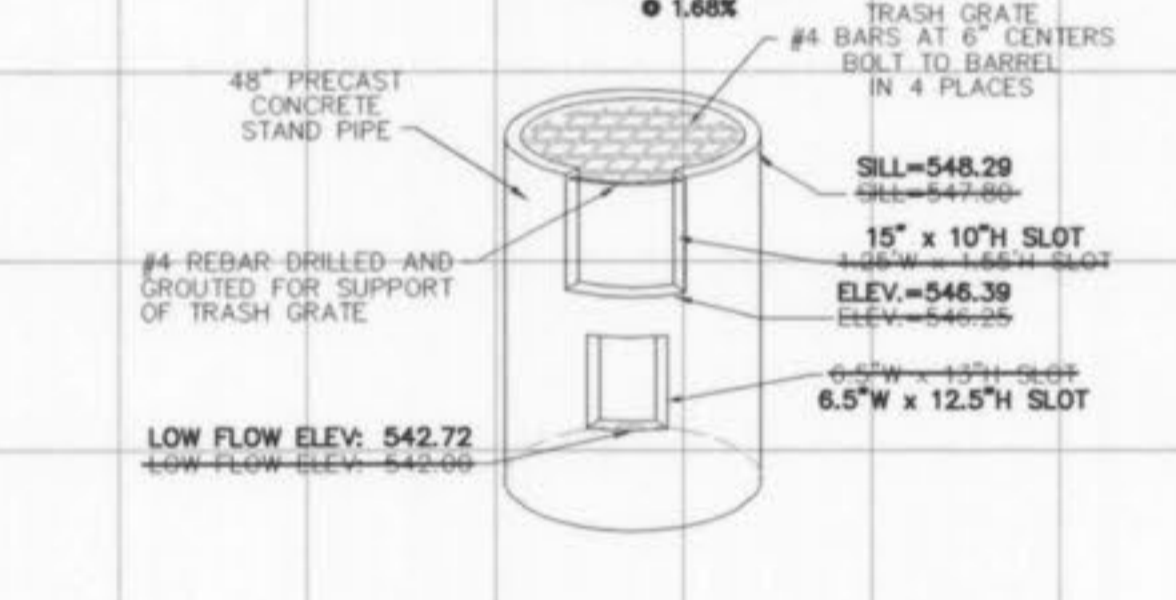


OVERFLOW STRUCTURE 33 BASIN A
 NOT TO SCALE

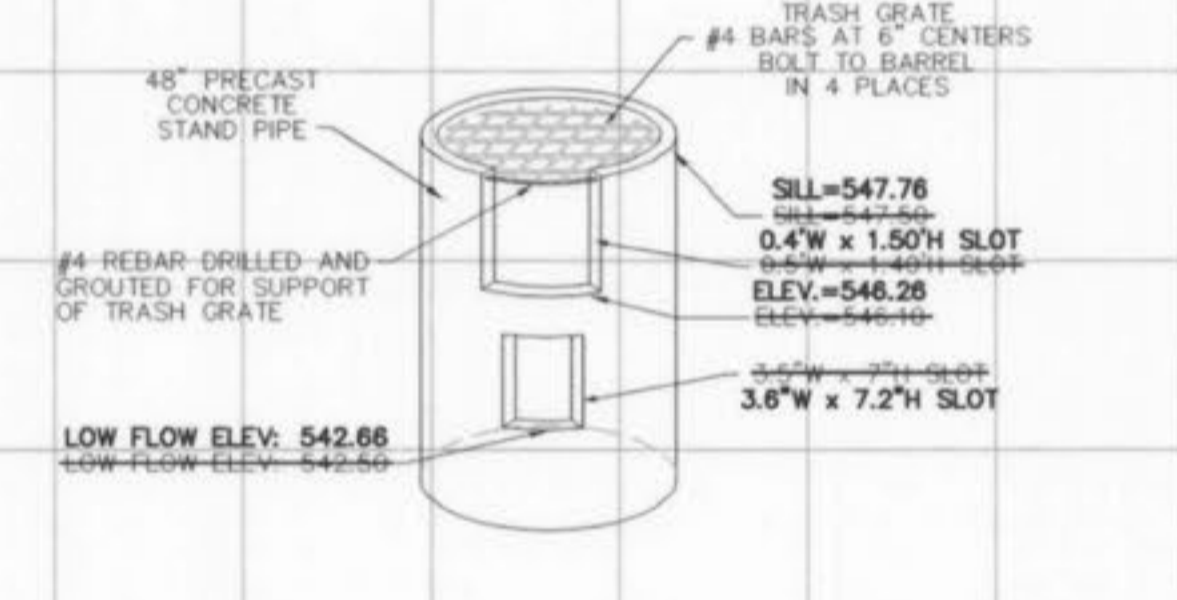


OVERFLOW STRUCTURE 20 BASIN B
 NOT TO SCALE

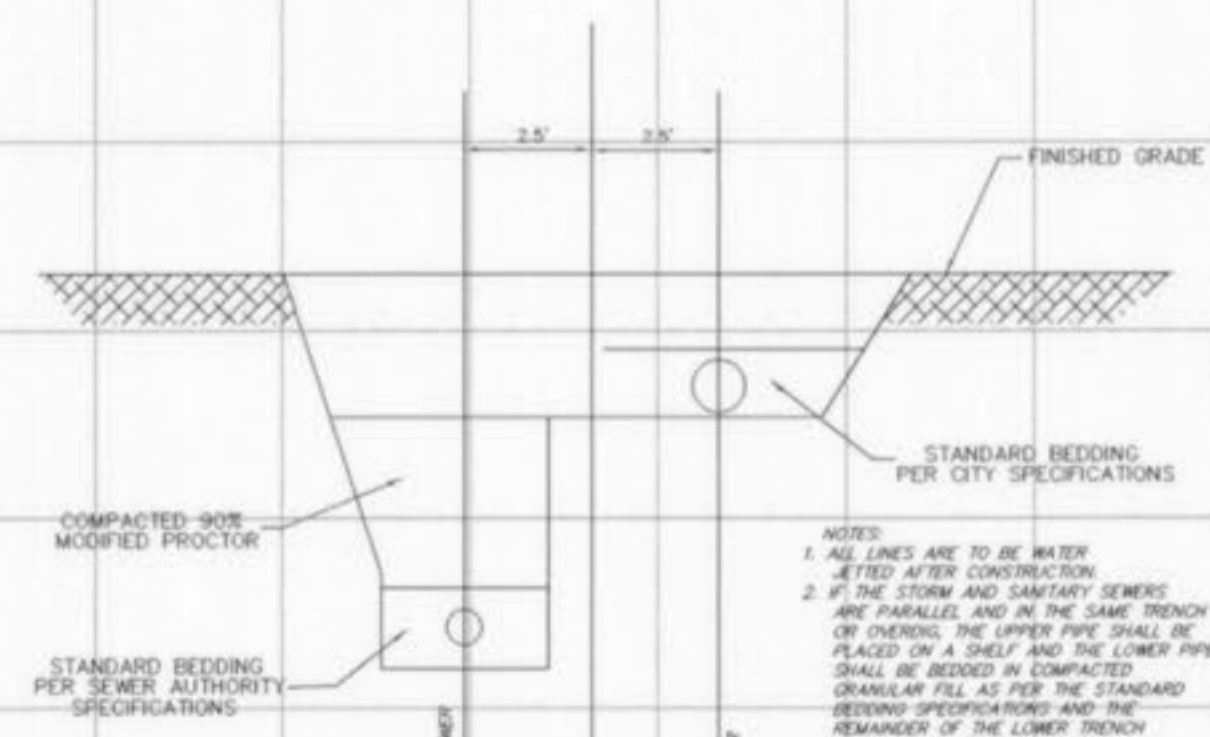

SANITARY AND STORM SEWER TRENCH DETAIL
 (FOR PARALLEL LINES)
 NO SCALE

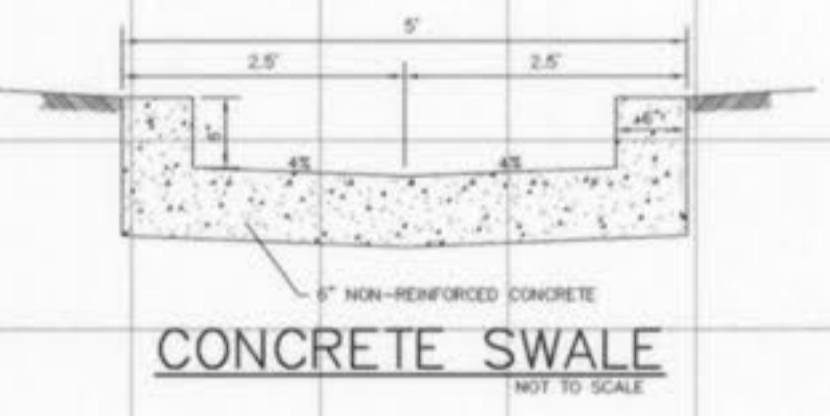

CONCRETE SWALE
 NOT TO SCALE

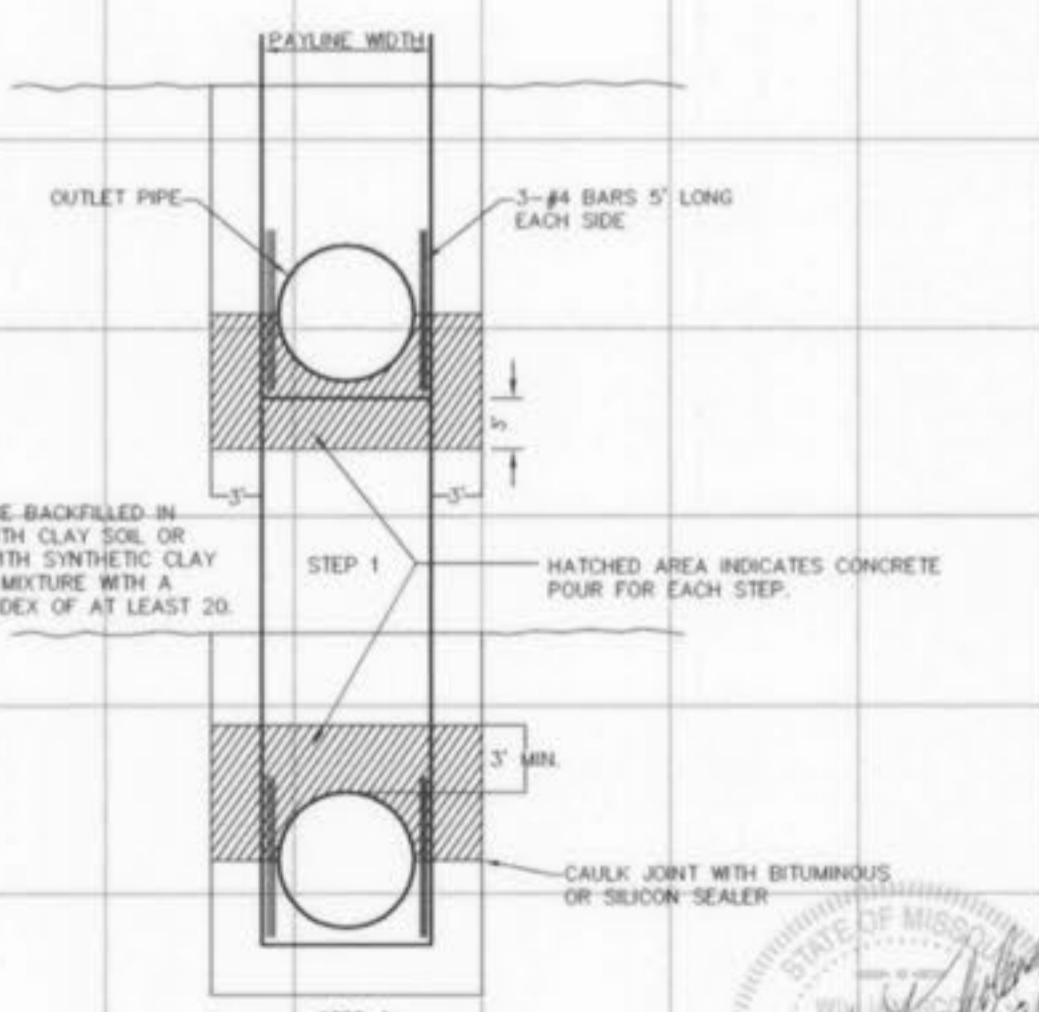

ANTI-SEEPAGE COLLAR
 NOT TO SCALE

AS-BUILTS ADDED NOVEMBER, 2003.

AS-BUILTS NOTE:
 ALL DISTANCE AND SLOPE CALCULATIONS ARE FROM CENTER OF STRUCTURE TO CENTER OF STRUCTURE.

SCALE: VERTICAL = 1:10
 HORIZONTAL = 1:50



5
 5

Meadows of Parkwood Estates
 Approved 2/23/04 AOK

UNDERGROUND UTILITIES HAVE BEEN PLOTTED FROM AVAILABLE INFORMATION AND THEREFORE THEIR LOCATIONS SHALL BE CONSIDERED APPROXIMATE ONLY. THE VERIFICATION OF THE LOCATION OF ALL UNDERGROUND UTILITIES, EITHER SHOWN OR NOT SHOWN ON THESE PLANS SHALL BE THE RESPONSIBILITY OF THE CONTRACTOR, AND SHALL BE LOCATED PRIOR TO ANY GRADING OR CONSTRUCTION OF THE IMPROVEMENTS.