



MONTICELLO ESTATES

FLOOD PLAIN STUDY

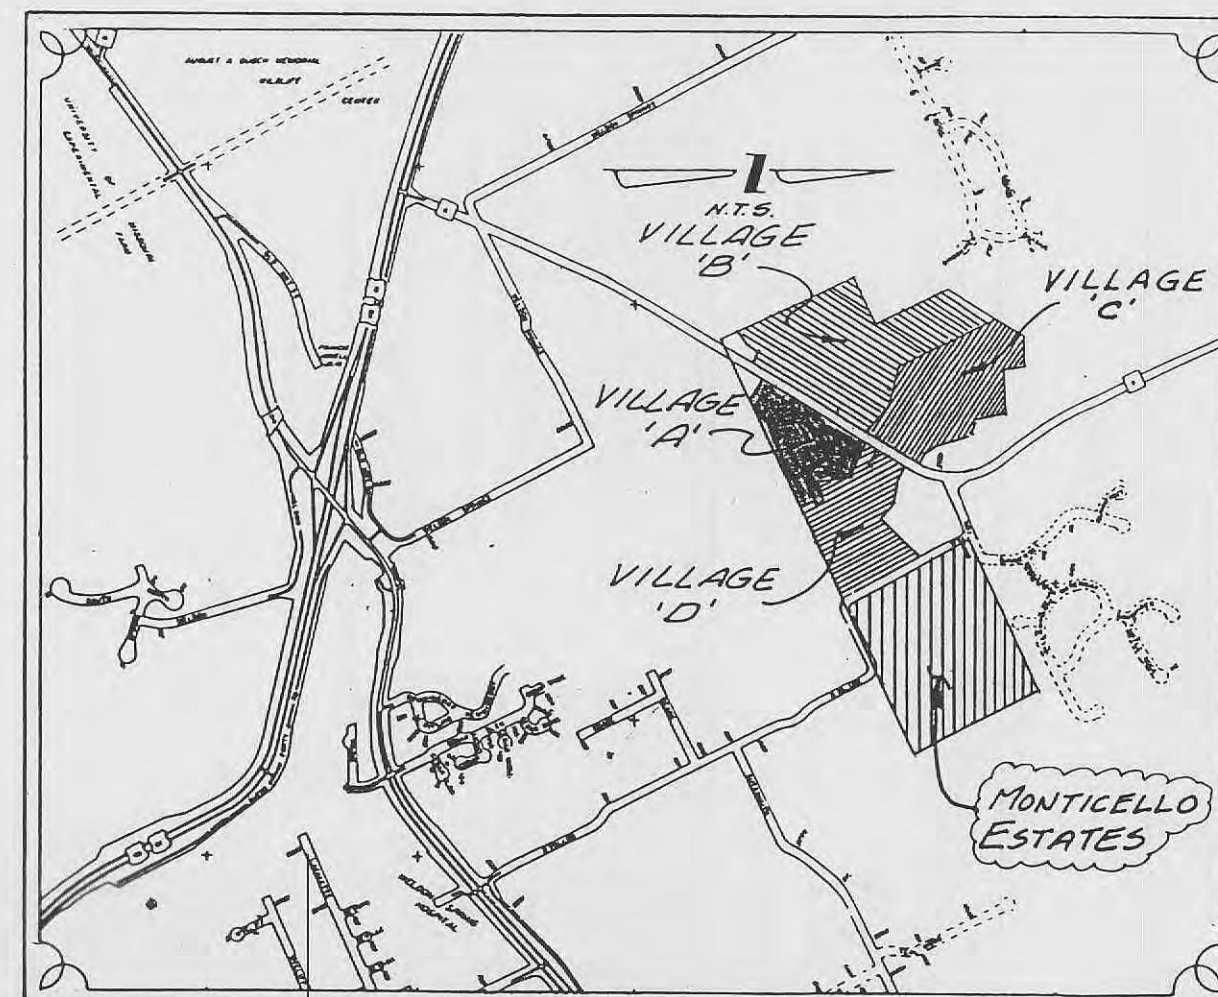

Location Map
1/8" = 300'

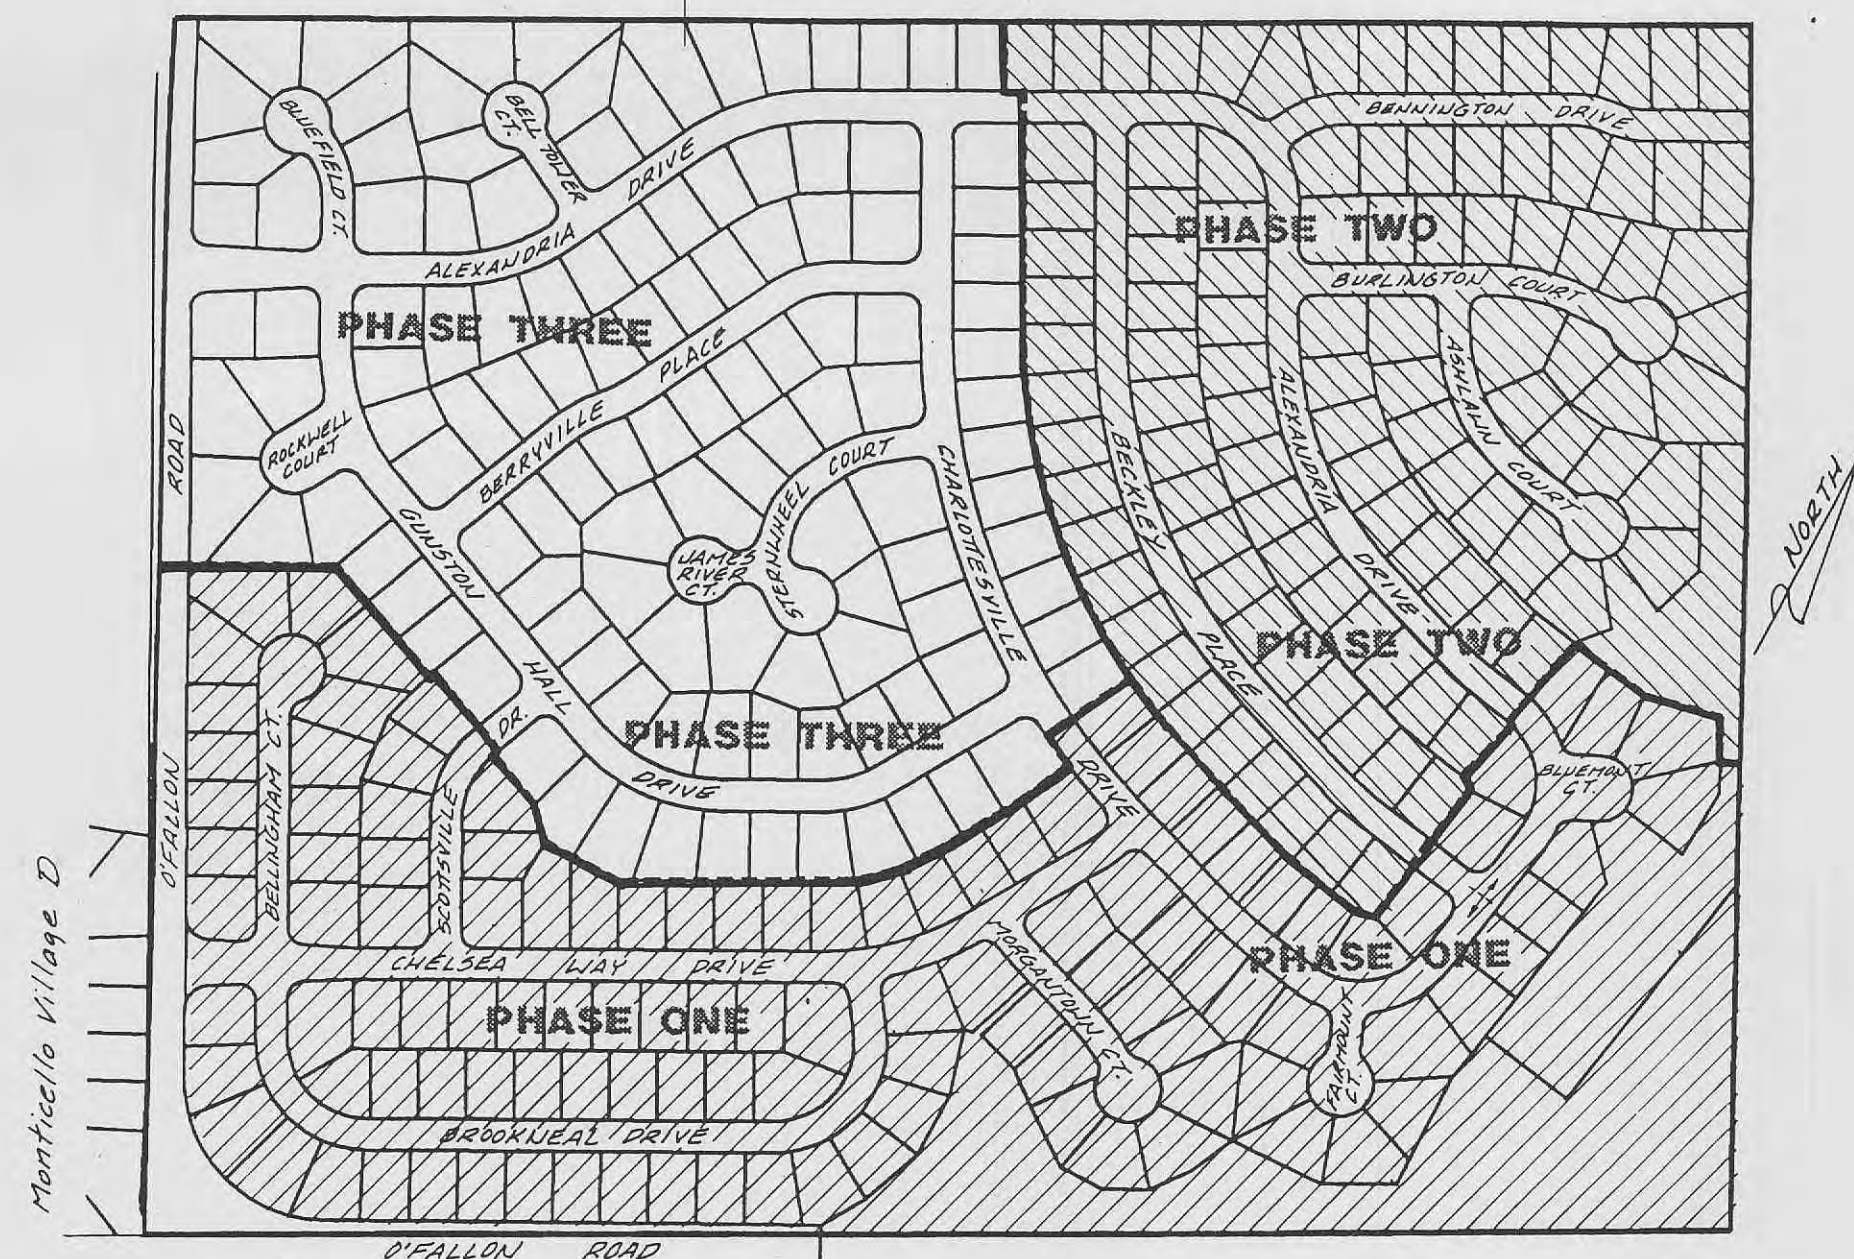

Key Map
1" = 300'

FILE
MONT. EST. PLAT 7

MARKED UP COPY OF
RISE IN FLOOD WAY & PLAIN
PLOTTED FROM HEC-2 ANALYSIS

ENGINEERS AUTHENTICATION <small>The responsibility for professional engineering liability on this project is hereby limited to the set of plans authorized by the seal, signature and date hereunder attached. Responsibility is disclaimed for all other engineering plans involved in the project and specifically excludes revisions after this date unless reauthenticated.</small>		PICKETT RAY & SILVER Civil Engineers Planners Land Surveyors	
333 Mid Rivers Mall Dr. St. Peters, MO 63376 441-1211 278-1211		Phone: (314) 279-1511	
PREPARED FOR: WHITTAKER HOMES 355 Mid Rivers Mall Drive St. Peters, MO 63376		PROJECT # 91-030 JOB ORDER # 29912	
DRAWN CHECKED DATE	DATE DATE	10-22-93 10-22-93	1 3
Signature _____ Date 10-22-93		Pickett, Ray & Silver, Inc.	





N / F
SOKOLIK
BK 1347 PG 1241

