


NOTE:
Underground utilities and structures have been plotted from available information and therefore, their location must be considered approximate only. It is the responsibility of the individual contractors to notify the utility companies before actual construction.

NOTE: SHADeD "BALLOONS"
INDICATE "AS-BUILT" STRUCTURES


FLAT PLAN
MONTICELLO ESTATES
PHASE TWO
Jan. 1993 51-030
Rev. 1/21/93, DWD, Detention Area
Rev. 2/5/93, DWD, Temp Turn-around per D'Alton
AS-BUILTS 10-4-93

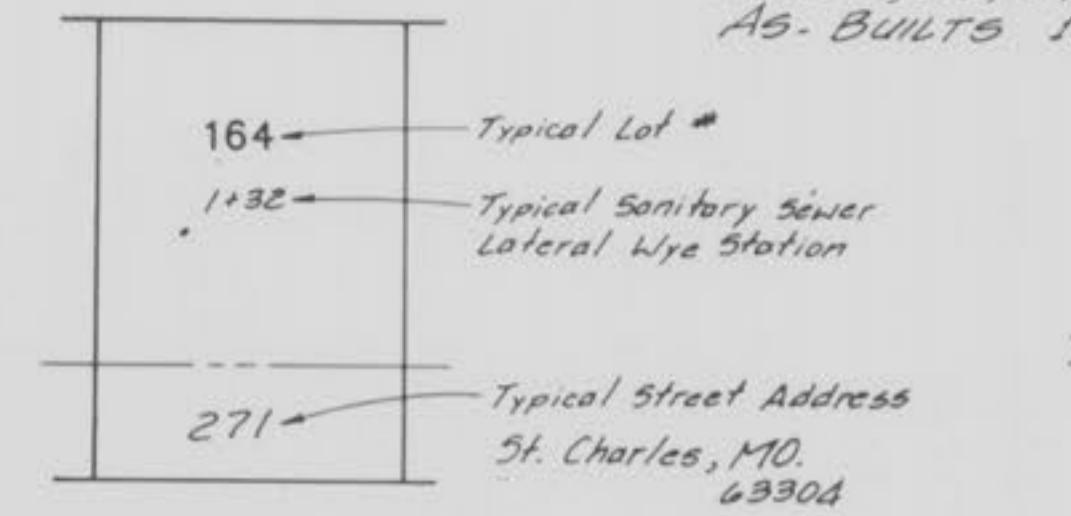



End-of-Pavement Barricade
See Detail on this sheet.

GRAPHIC SCALE
(IN FEET)
1 inch = 50 ft.

Note: At all intersections, rounding radius is 25' for R.O.W. and 37' for pavement.

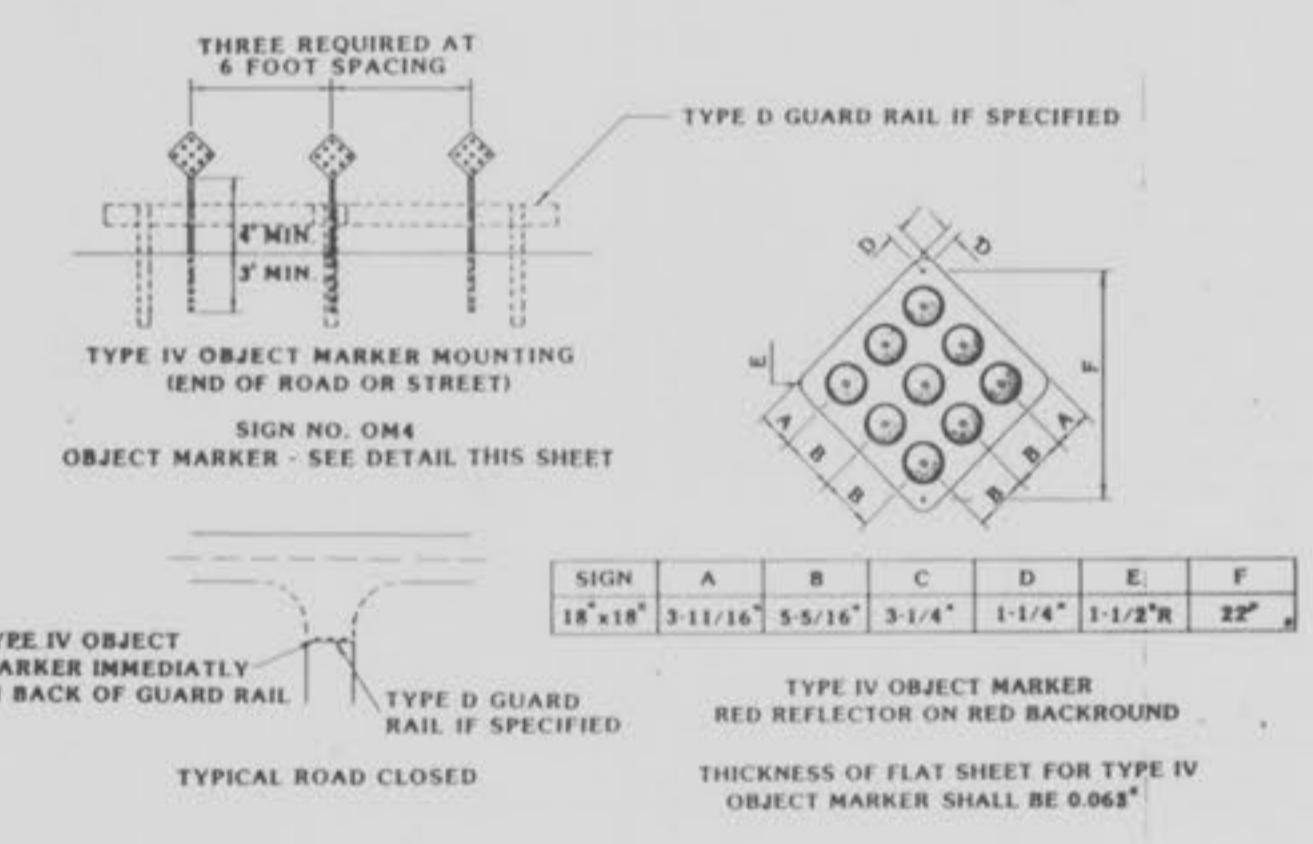

NOTE: SHADeD "BALLOONS"
INDICATE "AS-BUILT" STRUCTURES

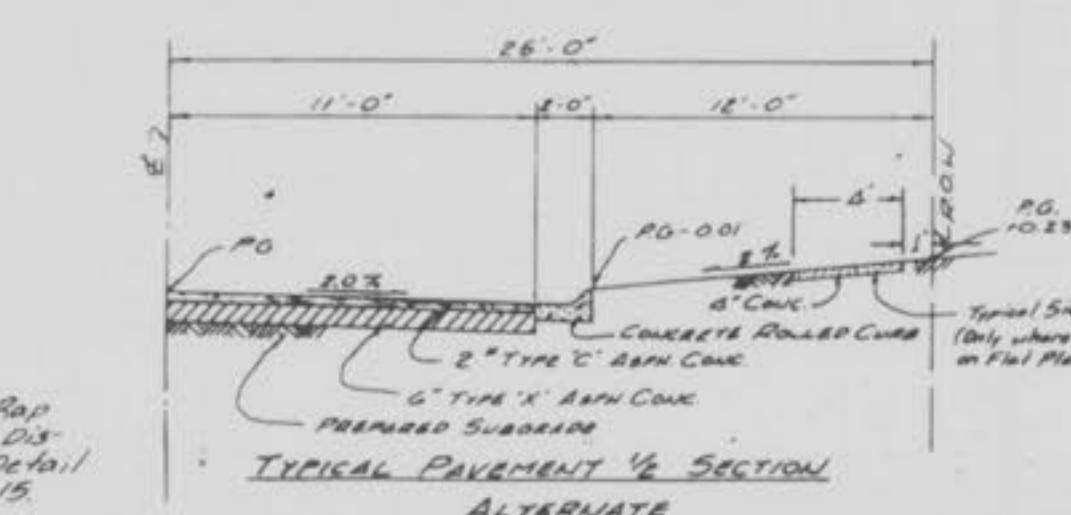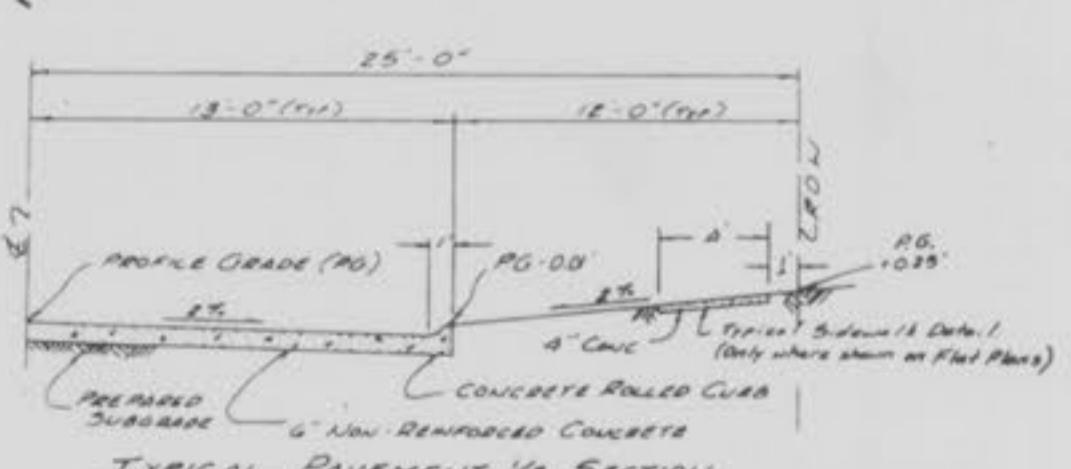

MON EST:
PHASE II
"AS-BUILTS"

2/6
X

SHALE "A"
6'W Flat Bottom
Concrete - See Detail
on Sheet 4 of 15

SHALE "B"
9'W Flat Bottom
Cone - See Detail
on Sheet 4 of 15

SHALE "C"
6'W Flat Bottom
Cone - See Detail
on Sheet 4 of 15

Grooved Rip Rap
with Energy Dis-
sipator - See Detail
on Sheet 3 of 15

FLAT PLAN
MONTICELLO ESTATES
PHASE TWO
Jan. 1993
Rev. 1-21-93, EWD, Detention Area
AS-BUILTS 10-4-93

GRAPHIC SCALE
50 0 50 100
(IN FEET)
1 inch = 50 ft.

NOTE: SHADeD "BALLOONS" INDICATE "AS-BUILT" STRUCTURES.

EXISTING PHASE ONE

EXISTING PHASE ONE


COMMON GROUND & DETENTION AREA

NOTE:
Underground utilities and structures have been plotted from available information and therefore, their location must be considered approximate only. It is the responsibility of the individual contractors to notify the utility companies before actual construction.

Existing Crooked Creek Trunk Line 7


NON EST
PHASE II
"AS-BUILTS"

3/6

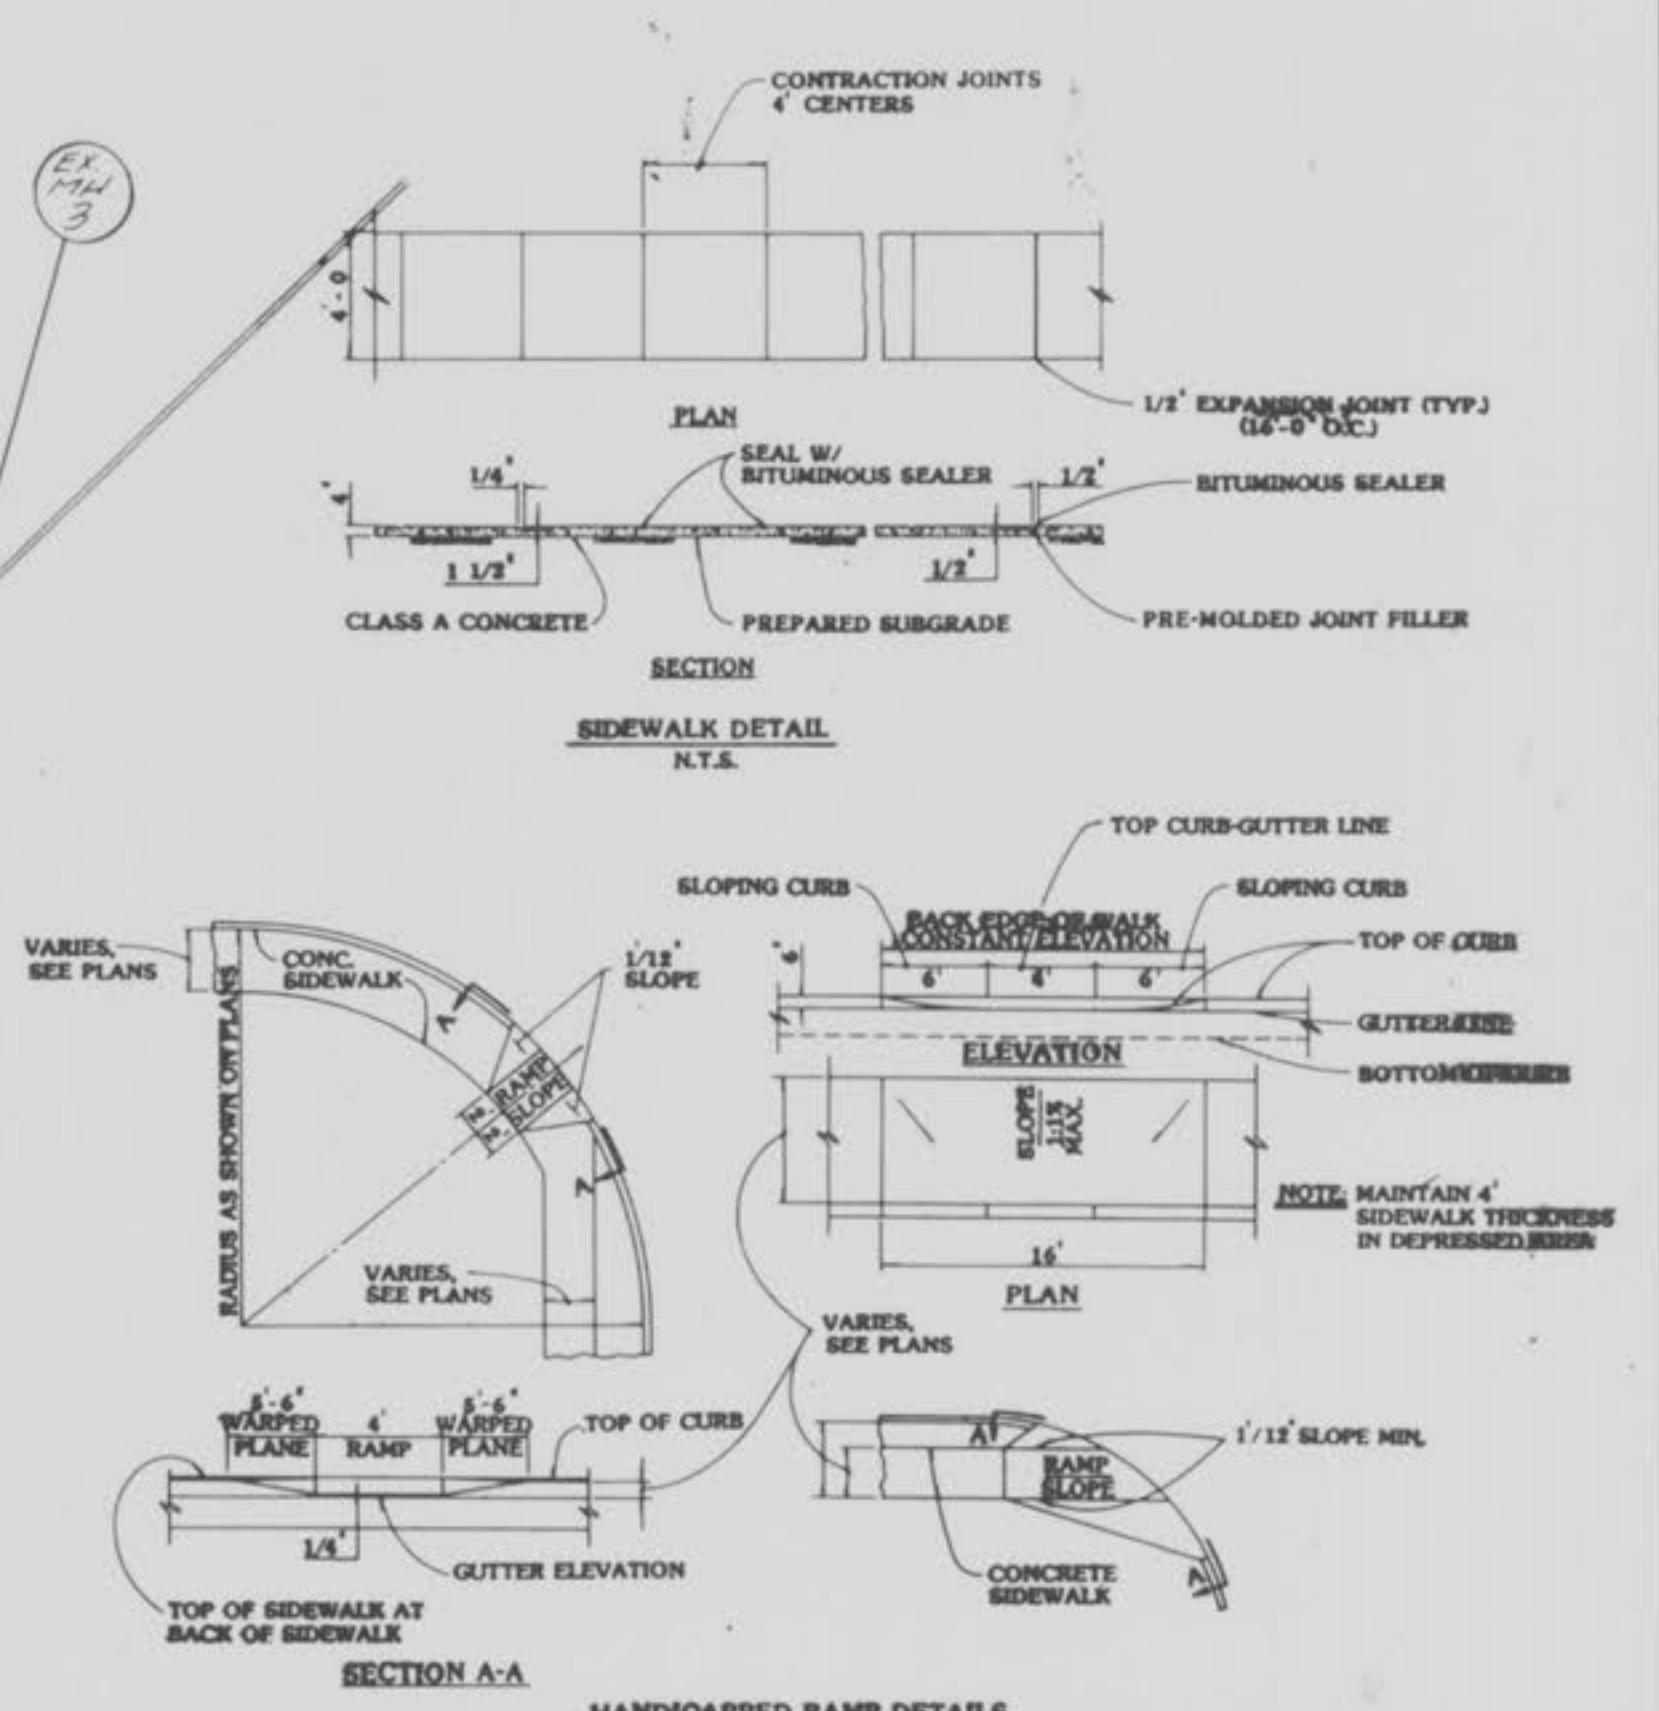

164 - Typical Lot #
1+32 - Typical Sanitary Sewer Lateral Wye Station
271 - Typical Street Address
St. Charles, MO 63304

SEE SHEET 2 15

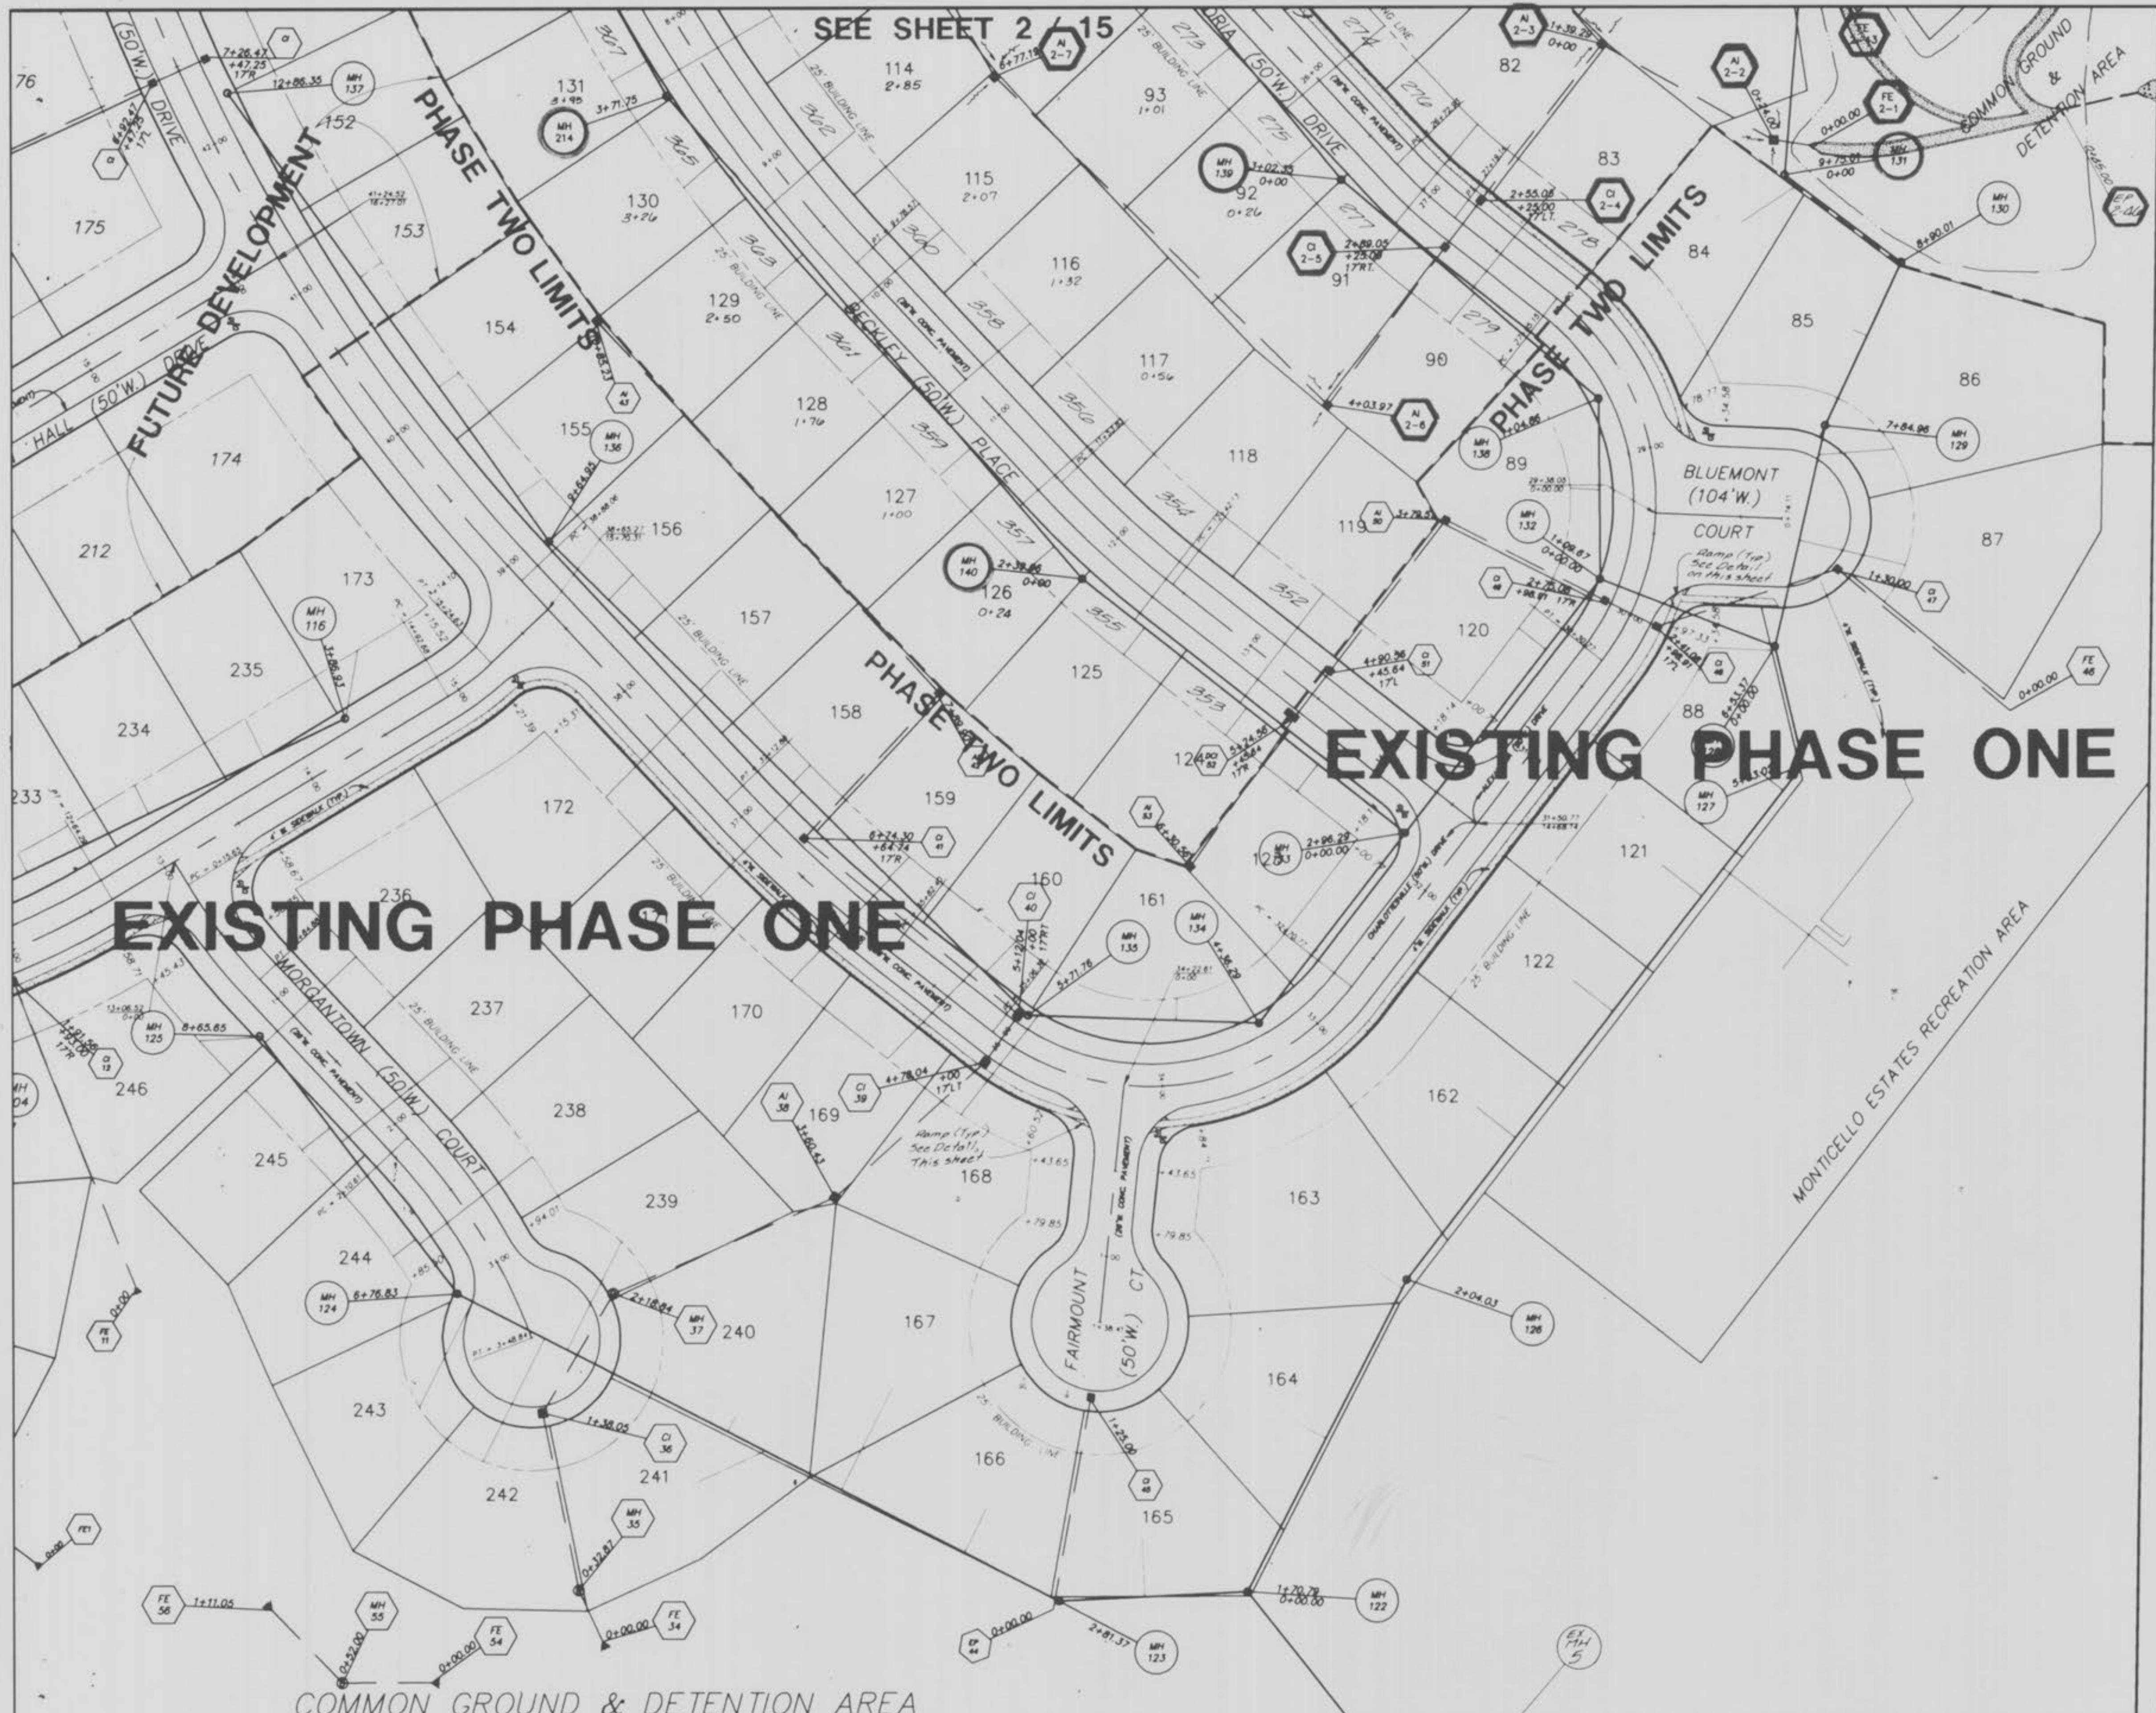


SANITARY SEWER PROFILES
MONTICELLO ESTATES
PHASE TWO
Jan, 1993


91-030

AS-BUILT 10-1-93

FINAL SURVEY
BY DATE
SURVEYED PLOTTED
NOTE BOOK TEMPATE AREA CHECKED

ORIGINAL SURVEY
BY DATE
SURVEYED PLOTTED
NOTE BOOK TEMPATE AREA CHECKED

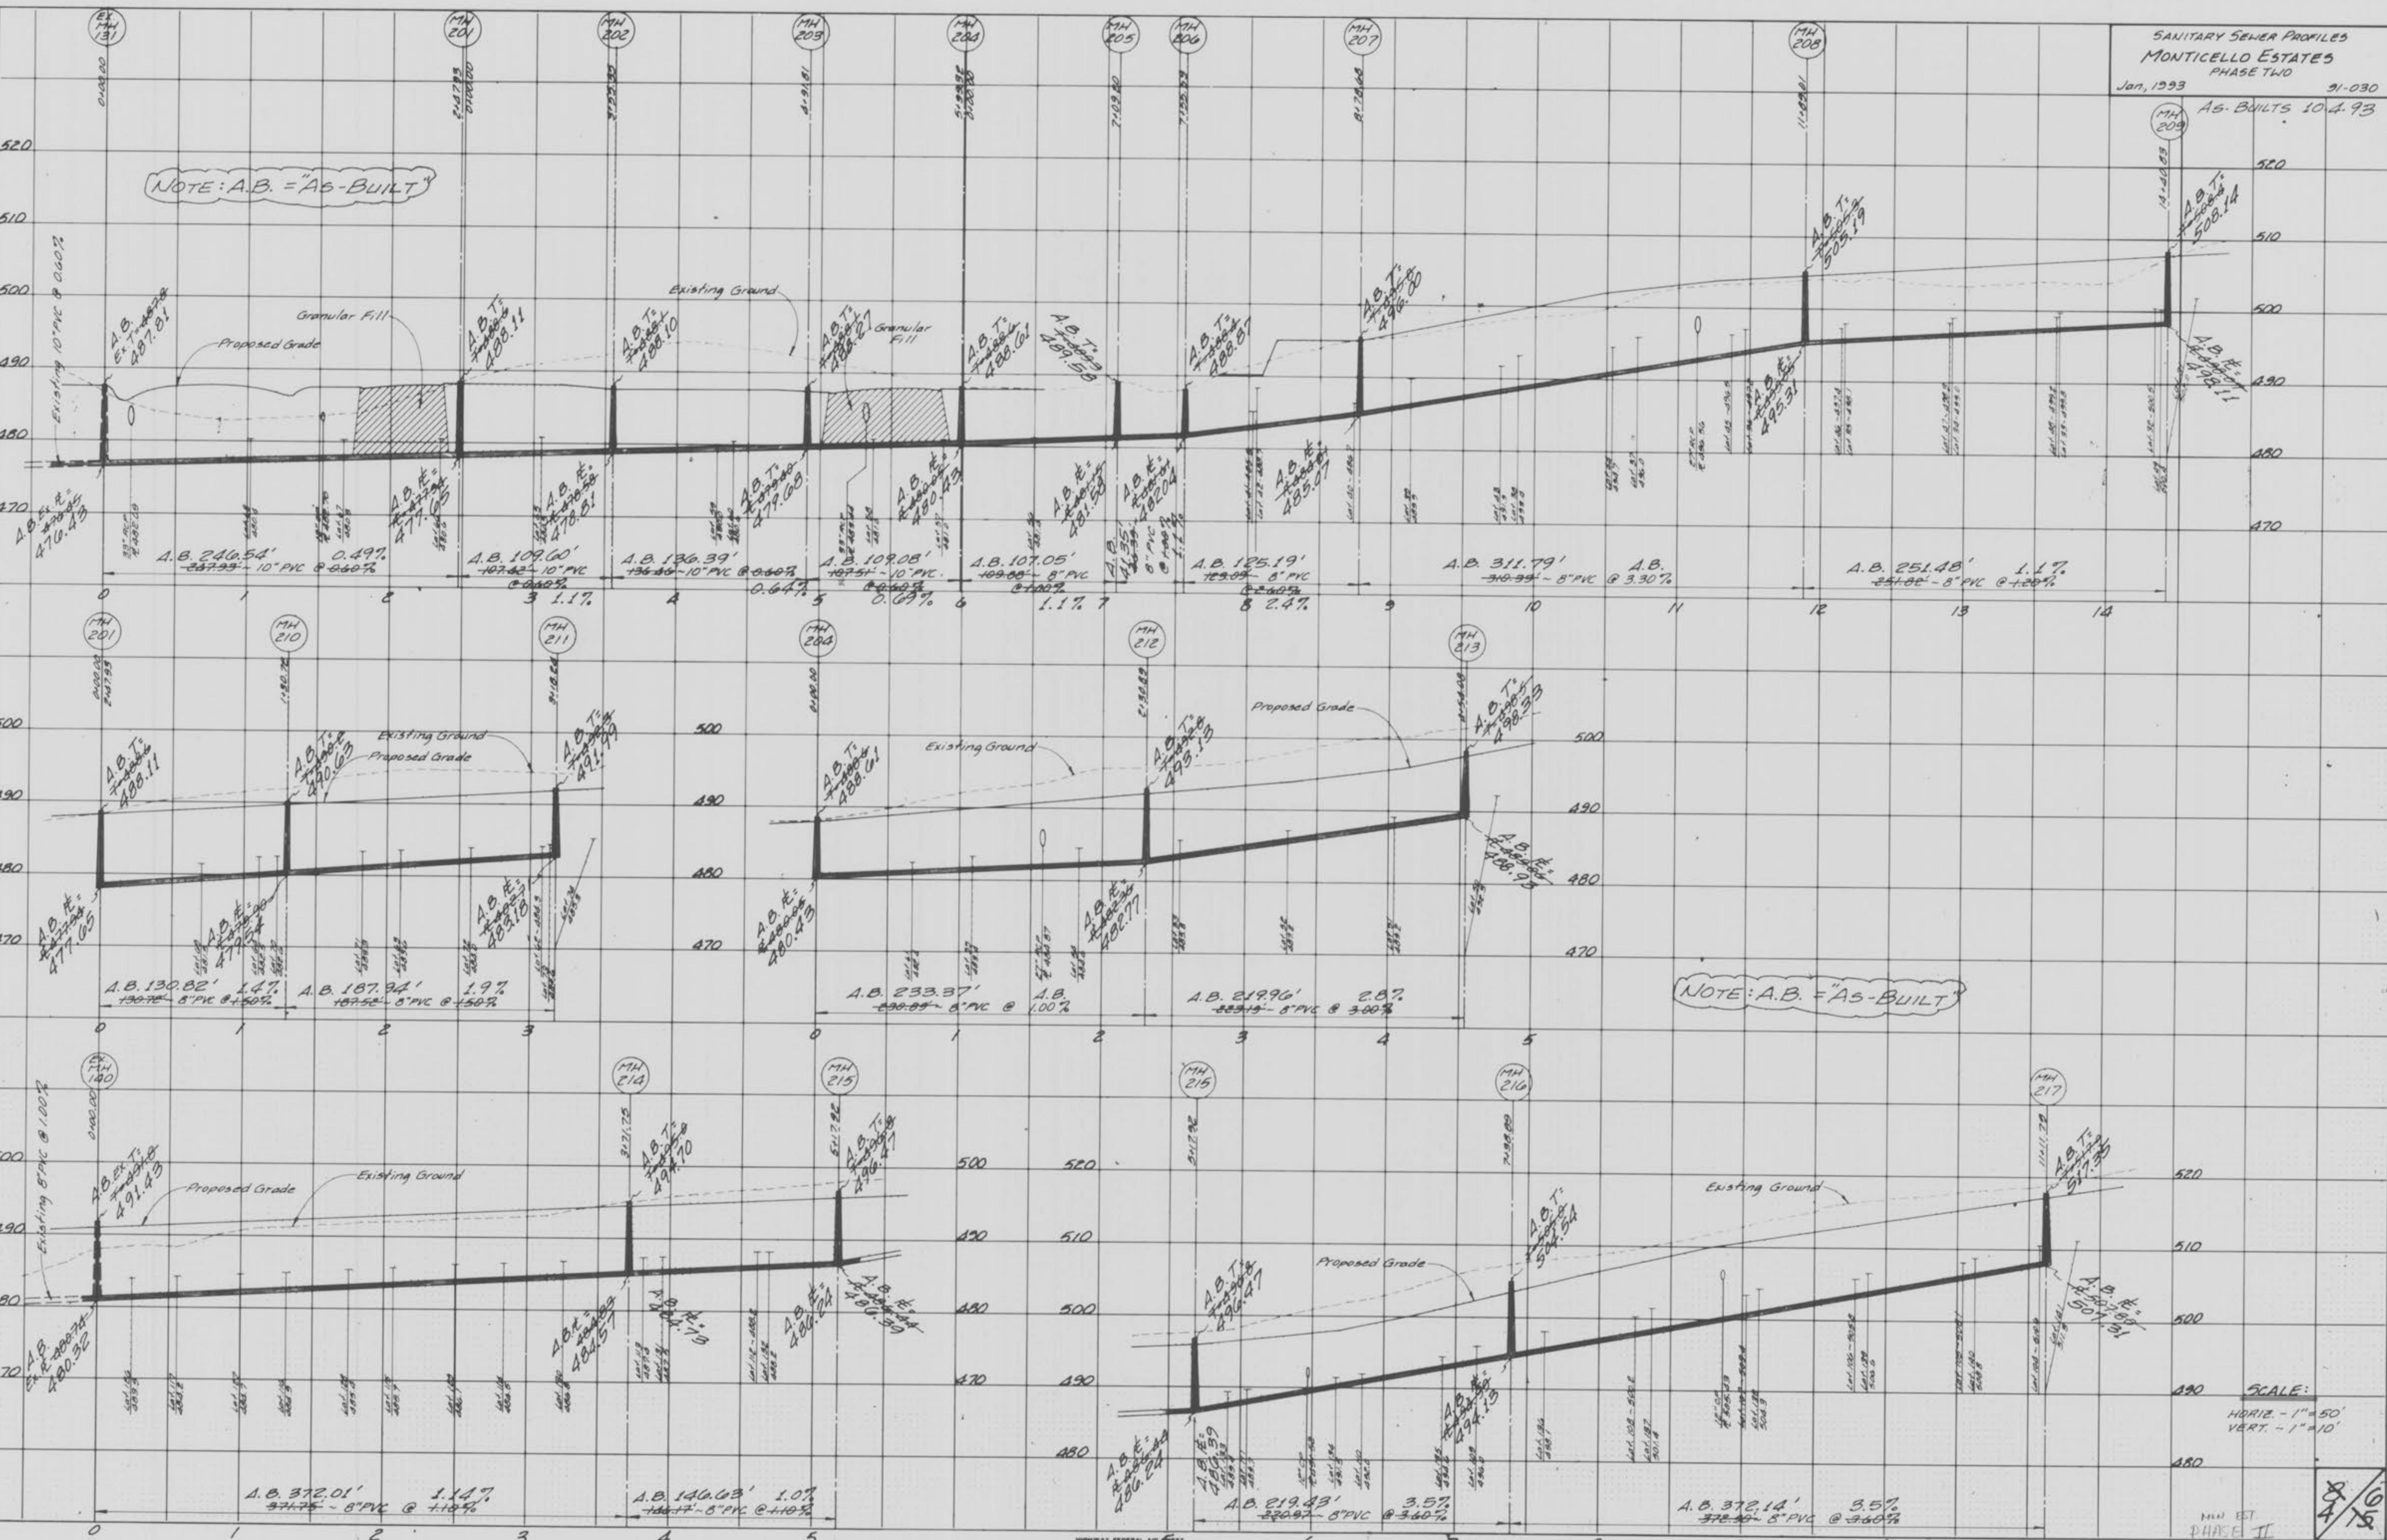

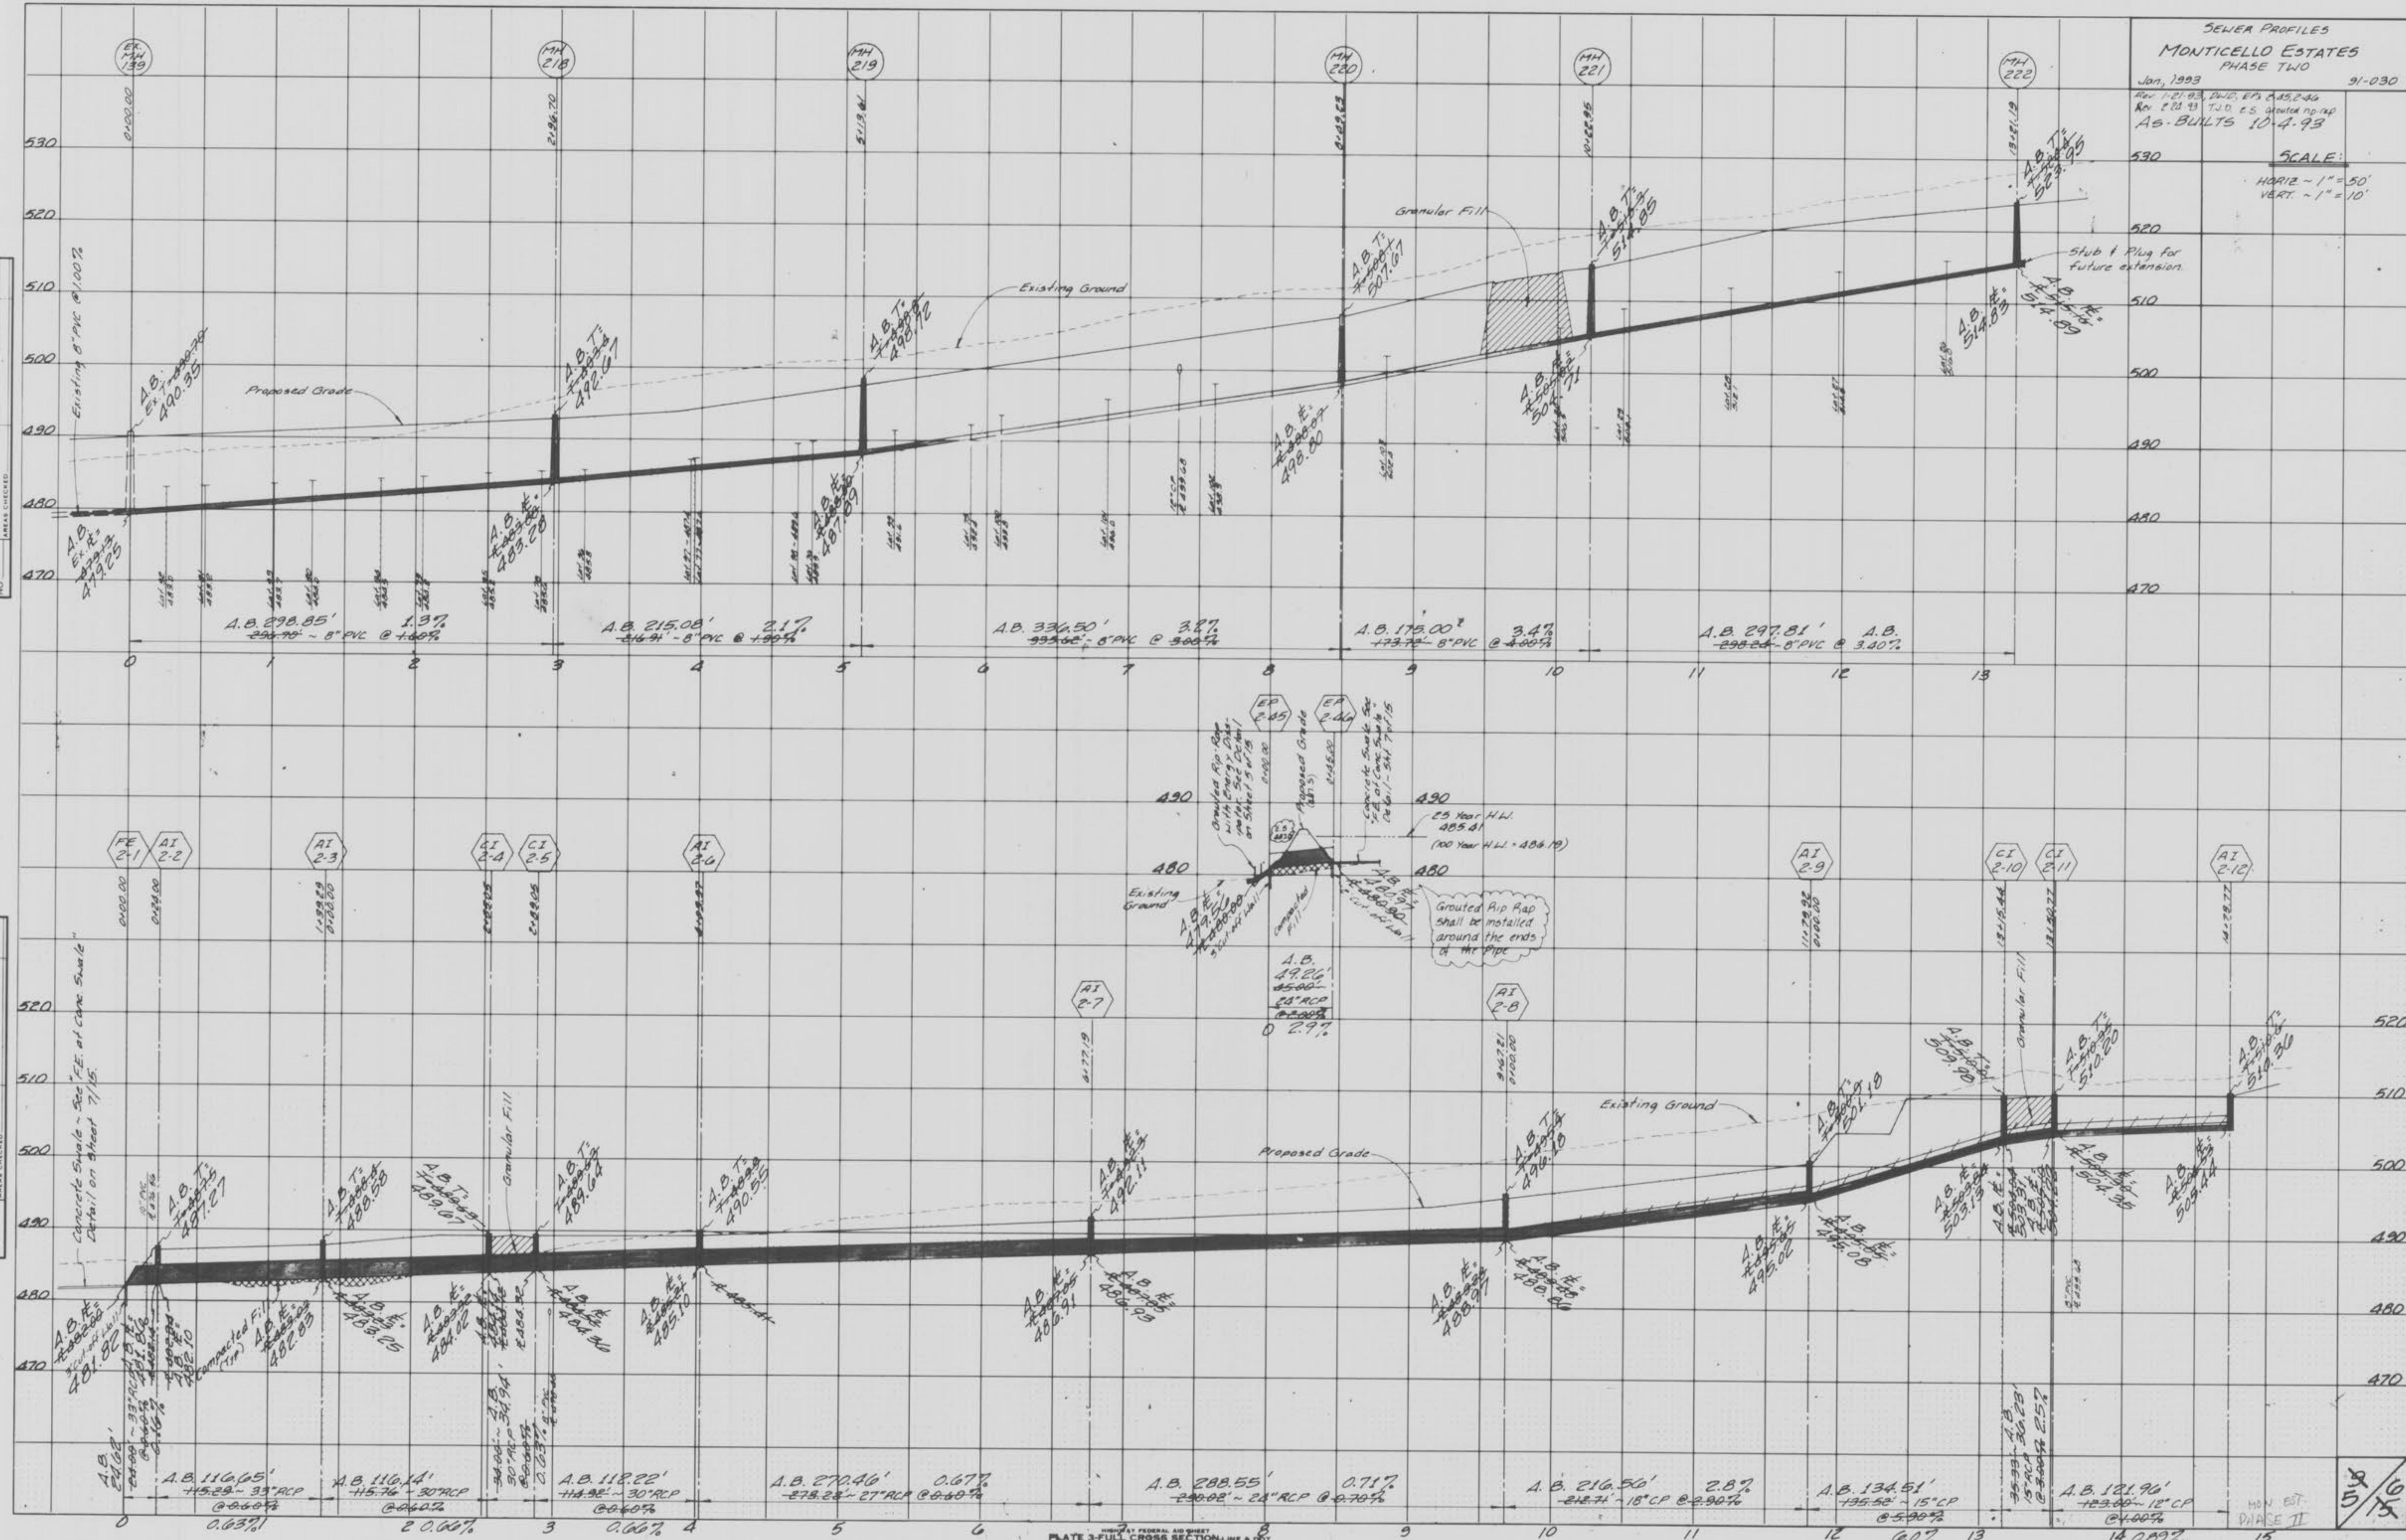

"AS-BUILT¹⁵"

Monticello Estates Ph. II

