









FLAT PLANS  
MONTICELLO ESTATES  
PHASE THREE

Aug. 1993 31-030

Rev. 8-27-93, per Ducket Creek SD, DWD

Rev. 12-13-93, AI 351, DWD

7-8-94 AS-BUILTS

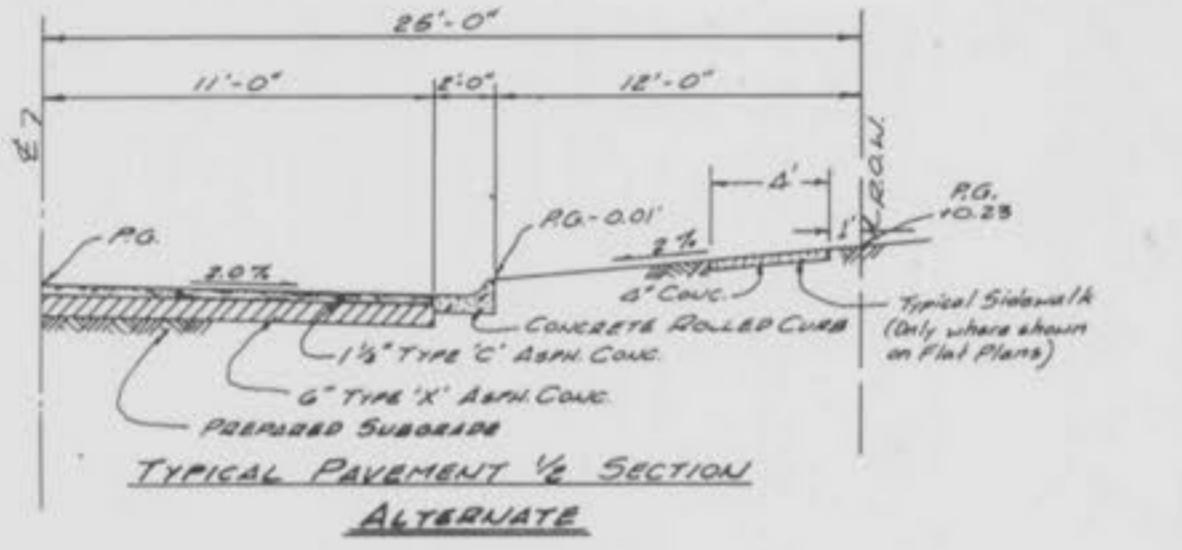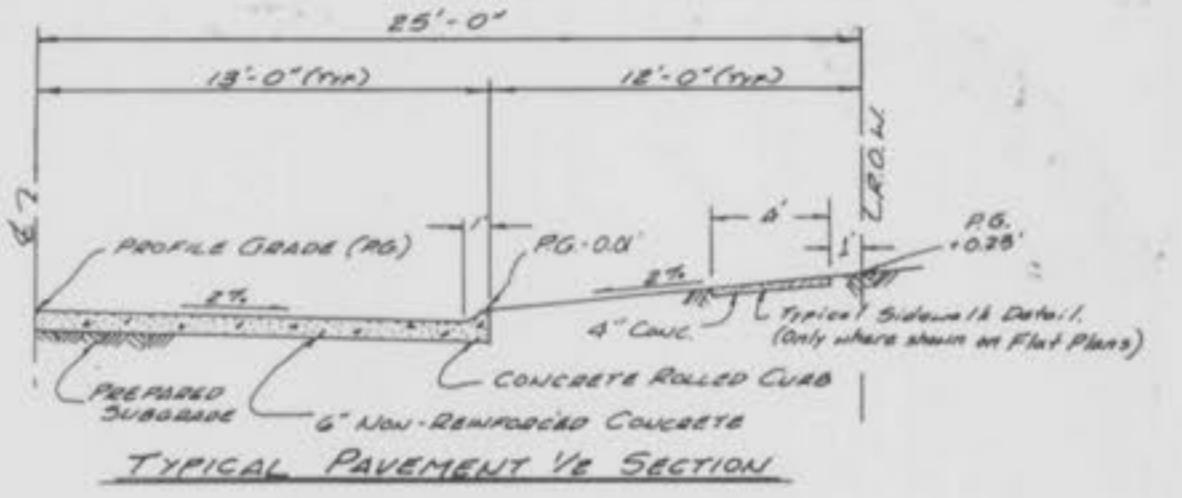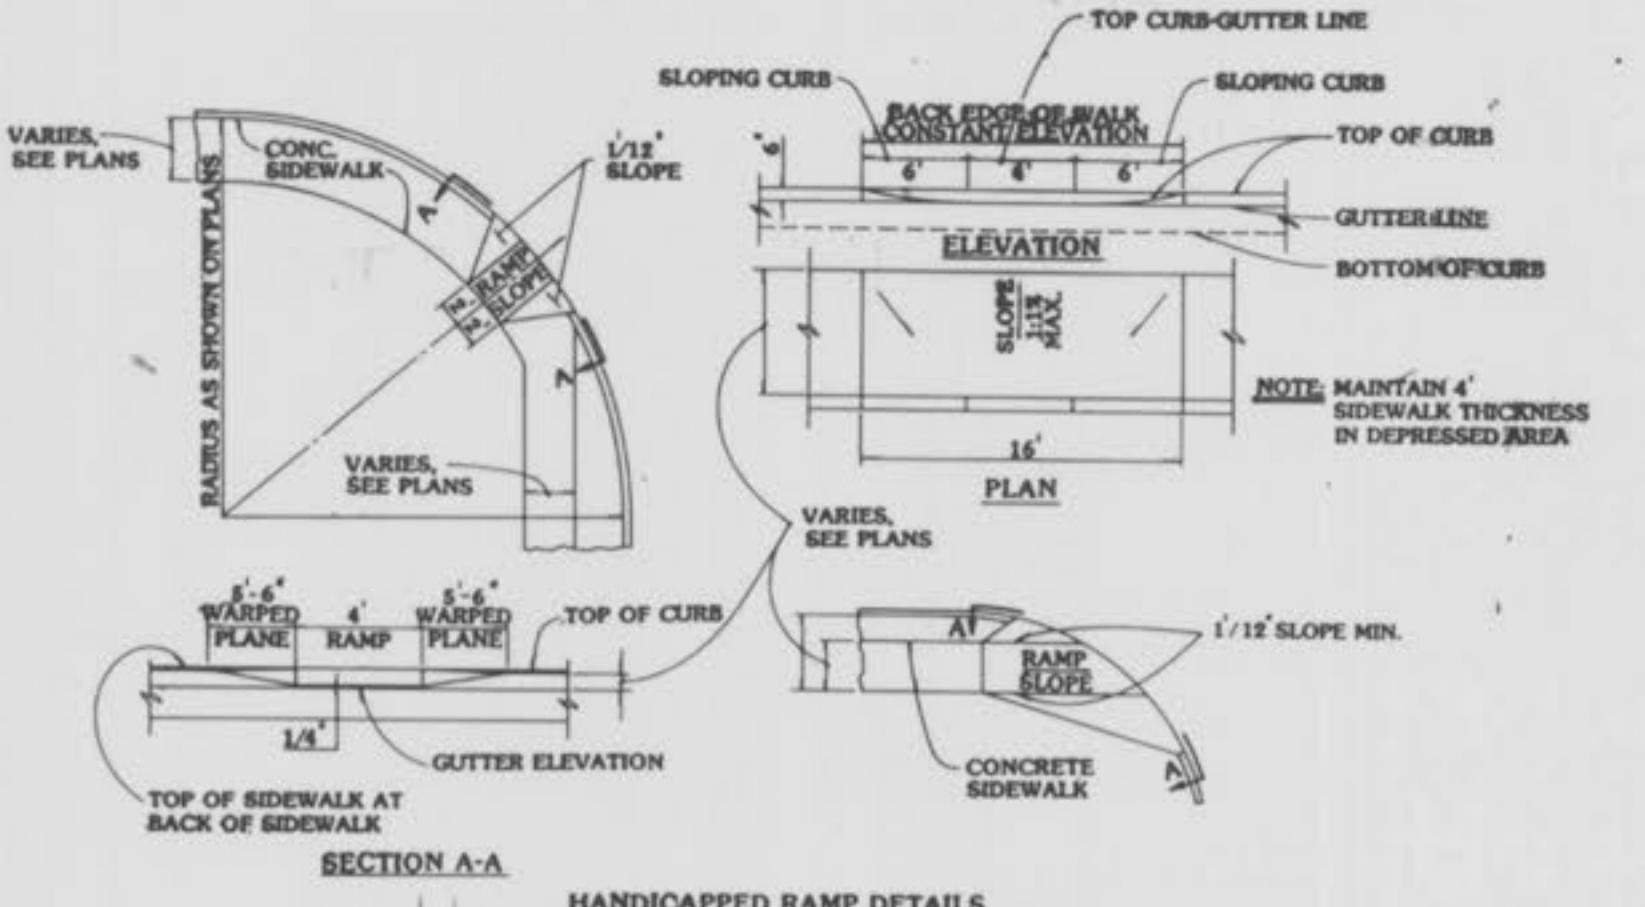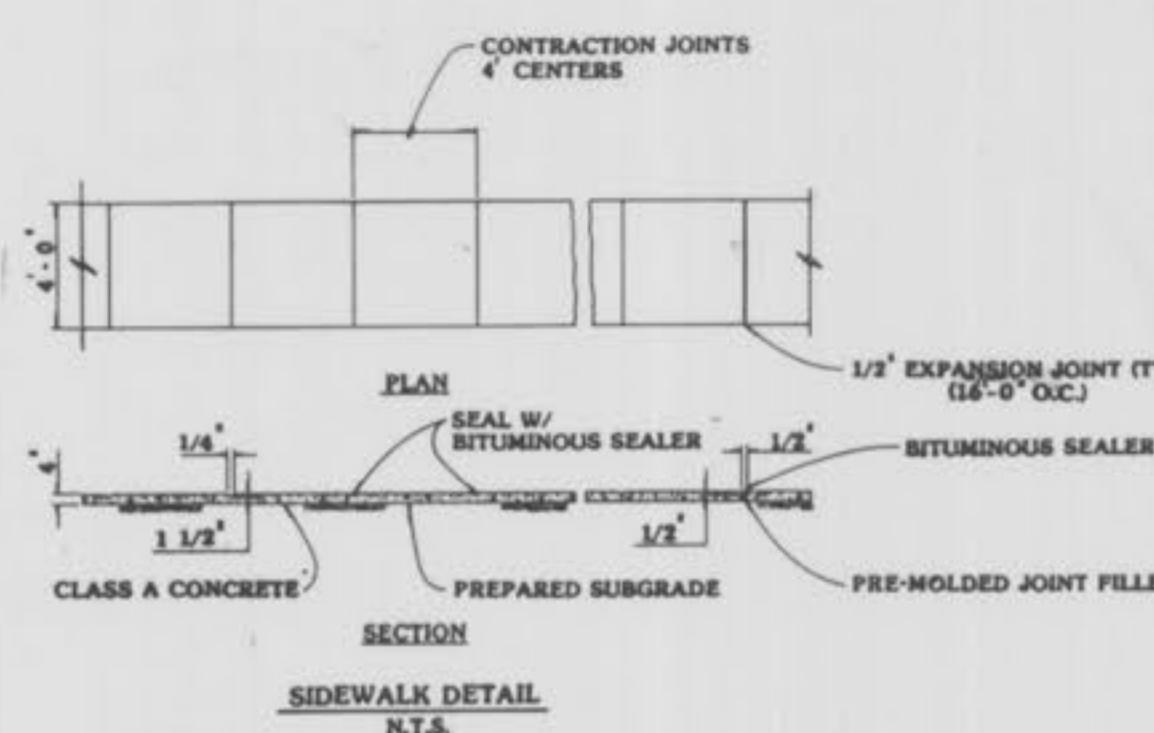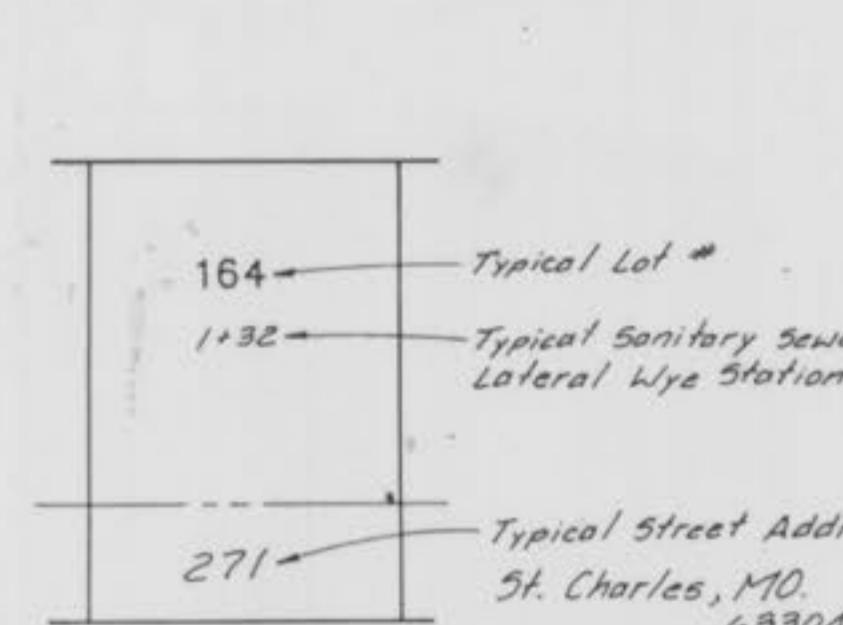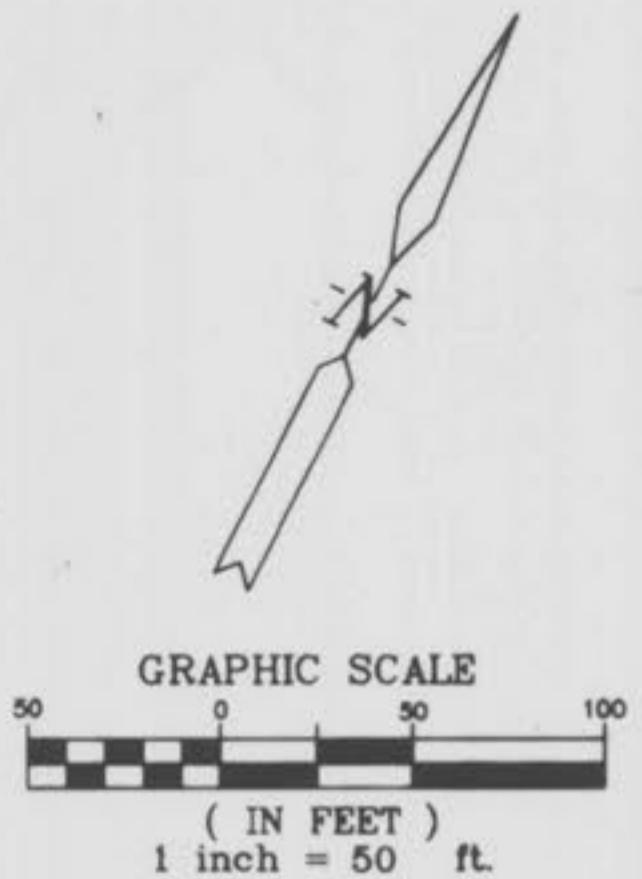



7-8-94 AS-BUILTS

Rev. 8-27-93, Per Lockheed Code, DWD

STORM SEWER PROFILES

MONTICELLO ESTATES

PHASE THREE

AUG, 1993 91-030


FINAL SURVEY BY DATE

ORIGINAL SURVEY BY DATE

SURVEYED PLOTTED

NOTE BOOK AREAS CHECKED

NO.

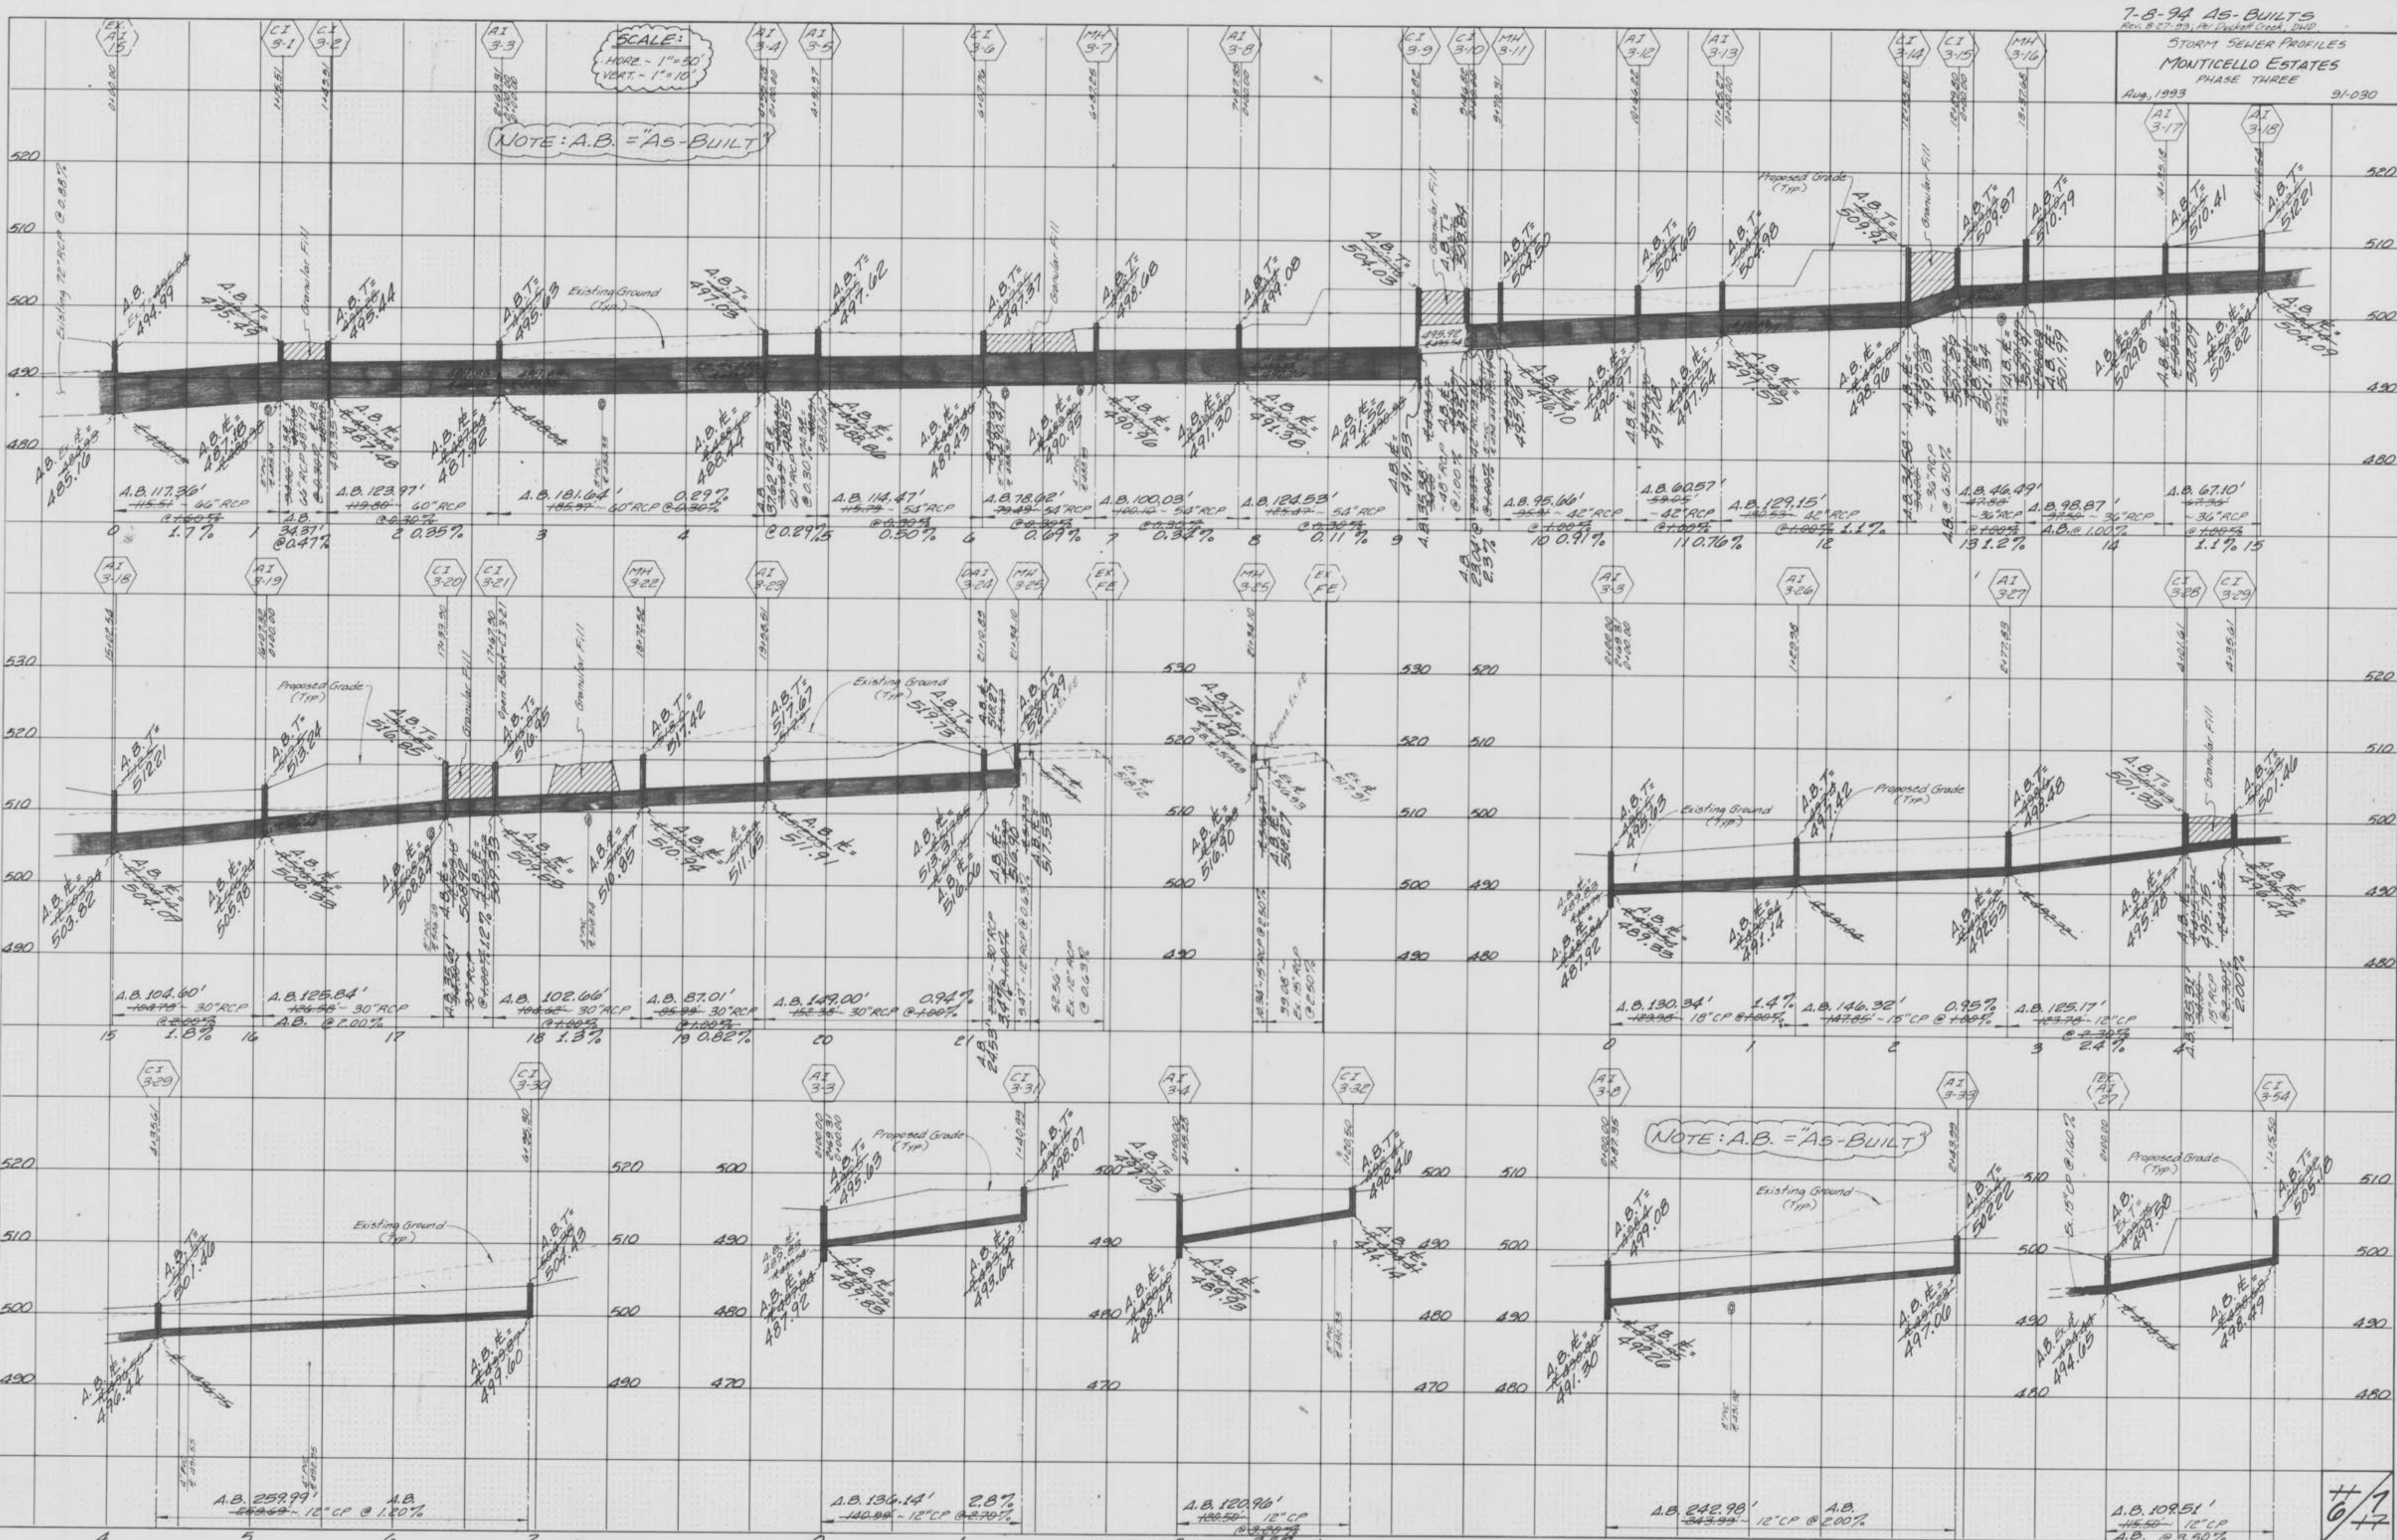

STORM SEWER PROFILES  
MONTICELLO ESTATES  
PHASE THREE  
Aug, 1993

91-030

FINAL SURVEY  
BY DATE  
NOTE BOOK PLOTTED  
AREA CHECKED NO

ORIGINAL SURVEY  
BY DATE  
NOTE BOOK PLOTTED  
AREA CHECKED NO

