

# MONTICELLO MANOR (191 LOTS)

A TRACT OF LAND BEING LOT 14 OF  
JOHN D. COALTER'S HOWELL'S PRAIRIE TRACT  
AS RECORDED IN BOOK H #2  
U.S. SURVEY 1669 T. 46 N., R. 3 E.  
ST. CHARLES COUNTY, MISSOURI

## CITY OF O'FALLON GENERAL NOTES

- Gas, water and other underground utilities shall not conflict with the depth or horizontal locations of existing and proposed sanitary and storm sewers, including house laterals.
- Underground utilities have been plotted from available information and, therefore, their locations must be considered approximate only. The verification of the location of all underground utilities, either shown or not shown on these plans, shall be the responsibility of the contractor and shall be located prior to grading or construction of improvements.
- Polyvinyl Chloride (PVC) shall conform to the requirements of ASTM D-3034 Standard Specifications for the PSM Polyvinyl Chloride (PVC) Sewer Pipe and Fittings, SDR-35.
- Storm sewers 18" in diameter or smaller shall be ASTM C-14.
- Storm sewers 21" in diameter or larger shall be ASTM C-76, Class II.
- All storm sewer pipe under pavement, regardless of size, shall be reinforced concrete pipe (ASTM C-76, Class II) unless noted otherwise in the plans.
- Corrugated metal pipe shall conform to the standard specifications for corrugated culvert pipe M-36, A.A.S.H.O. See plans for gauge.
- All filled places under buildings, proposed sanitary and storm sewer lines, and/or paved areas including trench backfills shall be compacted to 90% of maximum density as determined by the "Modified A.A.S.H.O. T-180 Compaction Test" (ASTM D-1557) unless otherwise specified by the local governing authority specifications. All tests will be verified by a soils engineer.
- All earthen filled places within State, County, or City roads (Highways) shall be compacted to 95% of maximum density as determined by the "Standard Proctor Test A.A.S.H.O. T-99" (ASTM D-698) unless otherwise specified by local governing authority specifications. All tests will be verified by a soils engineer.
- All storm and sanitary trench backfills shall be water jetted. Granular fill will be used under paved areas.
- Easements shall be provided for storm sewers, sanitary sewers, and all utilities on the record plot. This does not apply to house laterals.
- No area shall be cleared without the permission of the developer.
- All grades shall be within 0.2 feet (more or less) of those shown on the grading plan.
- No slope shall be greater than 3:1 and shall be either sodded or seeded and mulched.
- Hazard markers will consist of three (3) standard specification, "Manual on Uniform Traffic Control Devices," and of roadway markers mounted on two (2) pound "U" channel sign post. Each marker shall consist of an eighteen (18) inch diamond reflectorized red panel. The bottom of each panel shall be mounted a minimum of four (4) feet above the elevation of the pavement surface.
- All manhole and curb inlet tops built without elevations furnished by the Engineer will be the responsibility of the sewer contractor. At the time of construction stake-out of the sewer lines, all curb and grate inlets will be face staked. If normal face stakes fall in line with sewer construction, the Engineer will set these stakes on a double offset. It shall be the responsibility of the sewer contractor to preserve all face stakes from destruction.
- All standard street curb inlets to have front of inlet 2 feet behind curb.
- The minimum vertical distance from the low point of the basement to the flowline of a sanitary sewer at the corresponding house connection shall not be less than the diameter of the sanitary sewer plus a vertical distance not less than two and one-half feet (2-1/2').
- Water lines, valves, sleeves, meters and etc., shall meet all specifications and installation requirements of the local governing authority.
- All cast iron pipe for water mains shall conform to A.R.W.A. specification C-106 and/or C-108. The cast iron fittings shall conform to A.R.W.A. specification C-110. All rubber gasket joints for water cast iron pressure pipe and fittings shall conform to A.R.W.A. specification C-111.
- All water hydrants and valves shall be cast iron and installed in accordance with plans and details.
- All sanitary and storm sewers shall meet all specifications and installation requirements of the local governing authority.
- All PVC water pipe shall have a minimum pressure rating of PR-200 or SDR-21.
- All sanitary sewer pipe shall be 6" or equal with 4" sanitary sewer bedding uniformly graded between 4" and 6" above the bedding and 4" below the bedding and 4" above the top of the pipe.
- All grading on Missouri State Highway Right-of-Way shall be seeded and mulched and all disturbed Right-of-Way markers shall be reset at the completion of grading.
- All streets must meet the specifications and installation requirements of the City of O'Fallon.
- All sanitary manholes top shall be set 0.2' higher than the proposed ground except in pavement areas.
- All sanitary manholes shall have 24" vertical separation between all storm sewers and the sludge force main. Contractor shall be responsible for verifying separation prior to storm sewer installation.
- All sanitary service lines shall have a 6" diameter for Multi-family and a 4" diameter for single-family developments.
- Manhole frame and cover shall be Clay and Bailey No. 2008 or Neenah R-1736 or Deeter 1315 or approved equal.
- A slope of 0.3 feet is required through each sanitary manhole.
- The City of O'Fallon shall be notified at least 10 days prior to construction of sanitary sewers for coordination and inspection.
- Brick shall not be used on manholes.
- Sewer contractor shall maintain 24" vertical separation between all storm sewers and the sludge force main. Contractor shall be responsible for verifying separation prior to storm sewer installation.
- Site grading shall be in accordance with the grading plan. The site shall be graded to the elevations shown on the grading plan. The site shall be graded to the elevations shown on the grading plan. The site shall be graded to the elevations shown on the grading plan.
- NOTE: The grading and elevations shown on the grading plans are for construction purposes only. Finished grades and slopes will vary from those shown on the plans depending upon the location, size and type of house built on the lot. However, care should be taken to insure that finished grading conforms to drainage area maps.
- This Tract is Served By Or Located in:  
Union Electric  
Southwestern Bell Telephone  
St. Charles County Water District #2  
St. Charles Gas Company  
Duckett Creek Sanitary District  
Cottleville Fire Protection District  
Francis Howell R-3 School District
- All exterior sewer manholes shall be waterproofed on the exterior in accordance with Missouri Department of Natural Resources specifications. 10 CSR-8.120 (7) (E).
- The City of O'Fallon and the Duckett Creek San. District shall be notified at least 48 hours prior to construction of sanitary sewers for coordination and inspection.
- All PVC sanitary sewer pipe is to be SDR-35 or equal with "clean" 1/2" to 1" granular stone bedding uniformly graded. This bedding shall extend from 8" below the pipe to springline of pipe. Immediate backfill over pipe shall consist of same size "clean" or minus stone from springline of pipe to 6" above the top of pipe.
- All pipes shall have positive drainage through manholes. No flat base structures are allowed.

# "AS-BUILTS"

## DRAWING INDEX

Sheet	Description
1	COVER SHEET
2-4	SITE PLANS
5-7	GRADING PLANS
8-11	STREET PROFILES
5 12	OFF-SITE SEWER PLAN + PROFILE
6-8 13-15*	SANITARY SEWER PROFILES
9-11 17-19**	STORM SEWER PROFILES
20-22	DRAINAGE AREA MAPS
23-25	CONSTRUCTION DETAILS
25A-25B	CULVERT DETAILS

\* (omit sheet 16 of 25)  
\*\* (INCLUDES SANITARY PROFILES ON SHT. 11)

## LOCATION MAP



This is to certify to Duckett Creek Sanitary Dist. that these "As-Built" San. Plans are based on actual field surveys conducted during 11/24/94 and the results are shown here on.

by Pickett Ray & Silver

Delmar F. Vincent  
MO R.L.S. No 1869

Date

## SITE BENCHMARK

BM #  
CROSS @ CENTERLINE/CENTERLINE INTERSECTION OF  
ALEXANDRIA AND DUNMORE DRIVE  
ELEV. 549.34

## REVISIONS

Rev. 4-5-95 L.S.B.  
Rev. 1-25-95 T.R. (4/25)  
Rev. 11-29-94 J.C. (11/29)  
Rev. 3-29-94 L.S.B.  
Rev. 8-10-94 L.S.B.  
As-Built 6-9-95

## DEVELOPER

WHITTAKER CONSTRUCTION, INC.  
355A MID RIVERS MALL DRIVE  
ST. PETERS, MO. 63376  
Phone: (314) 970-1511

## ENGINEERS AUTHENTICATION

The responsibility for professional engineering liability on this project is hereby limited to the set of plans submitted to the local authority and state legislature officials. Responsibility is disclaimed for all other engineering plans involved in the project and specifically includes revisions after the date unless indicated.

PICKETT, RAY & SILVER, INC.



Signature

# PICKETT RAY & SILVER

Civil Engineers  
Planners  
Land Surveyors

333 Mid Rivers Mall Dr.  
St. Peters, MO 63376  
397-1211 FAX 397-1104


Celebrating 25 Years of Service

Copyright 1994 by Pickett, Ray & Silver Inc.





CONFIDENTIAL PROPRIETARY MATERIAL  
The use, reproduction and sales rights of this drawing are reserved by Pickett, Ray & Silver Inc.

DRAWN	DWD/KAW	DATE	6-29-94
CHECKED	JC/TDZ	DATE	6-29-94
FIELD BOOK	4165	PROJECT #	94010
		JOB ORDER #	31749

## "AS-BUILTS"

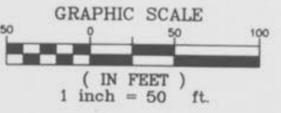


NOTE: Shaded "Balloons" Indicate "As-Built" Structures

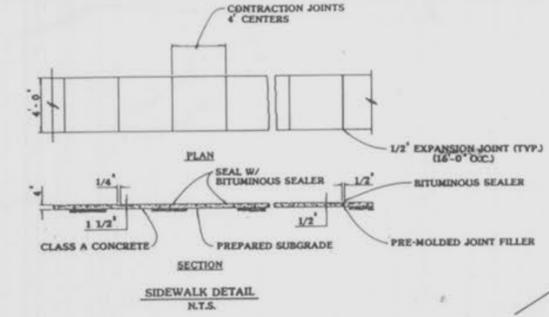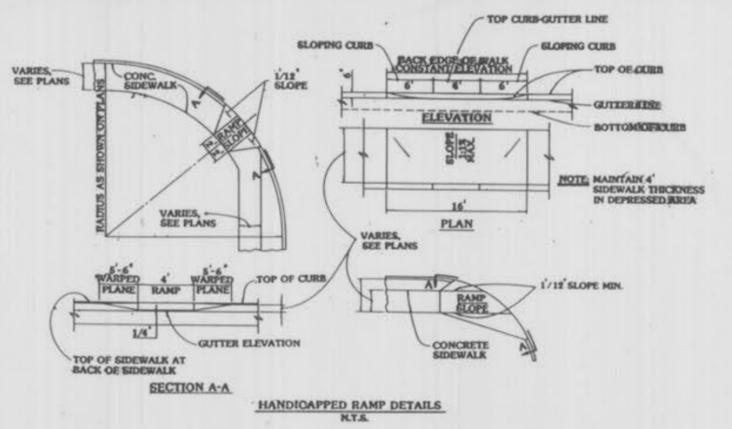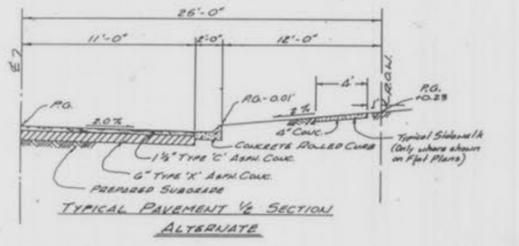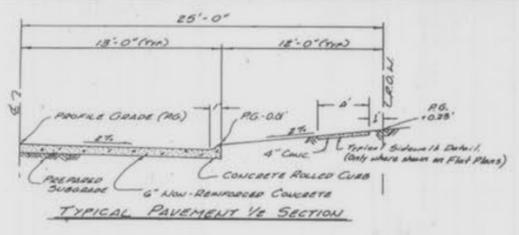

NOTE: SEE SHEET 8 OF 25 FOR ADDITIONAL PAVEMENT DETAILS

SEE MONTICELLO MANOR HIGHWAY ENTRANCE PLANS BY P.R.&S.  
Q & E INTERSECTION 0.9 ± MILES NORTH OF HWY 40-61.  
278+10.86  
0+00

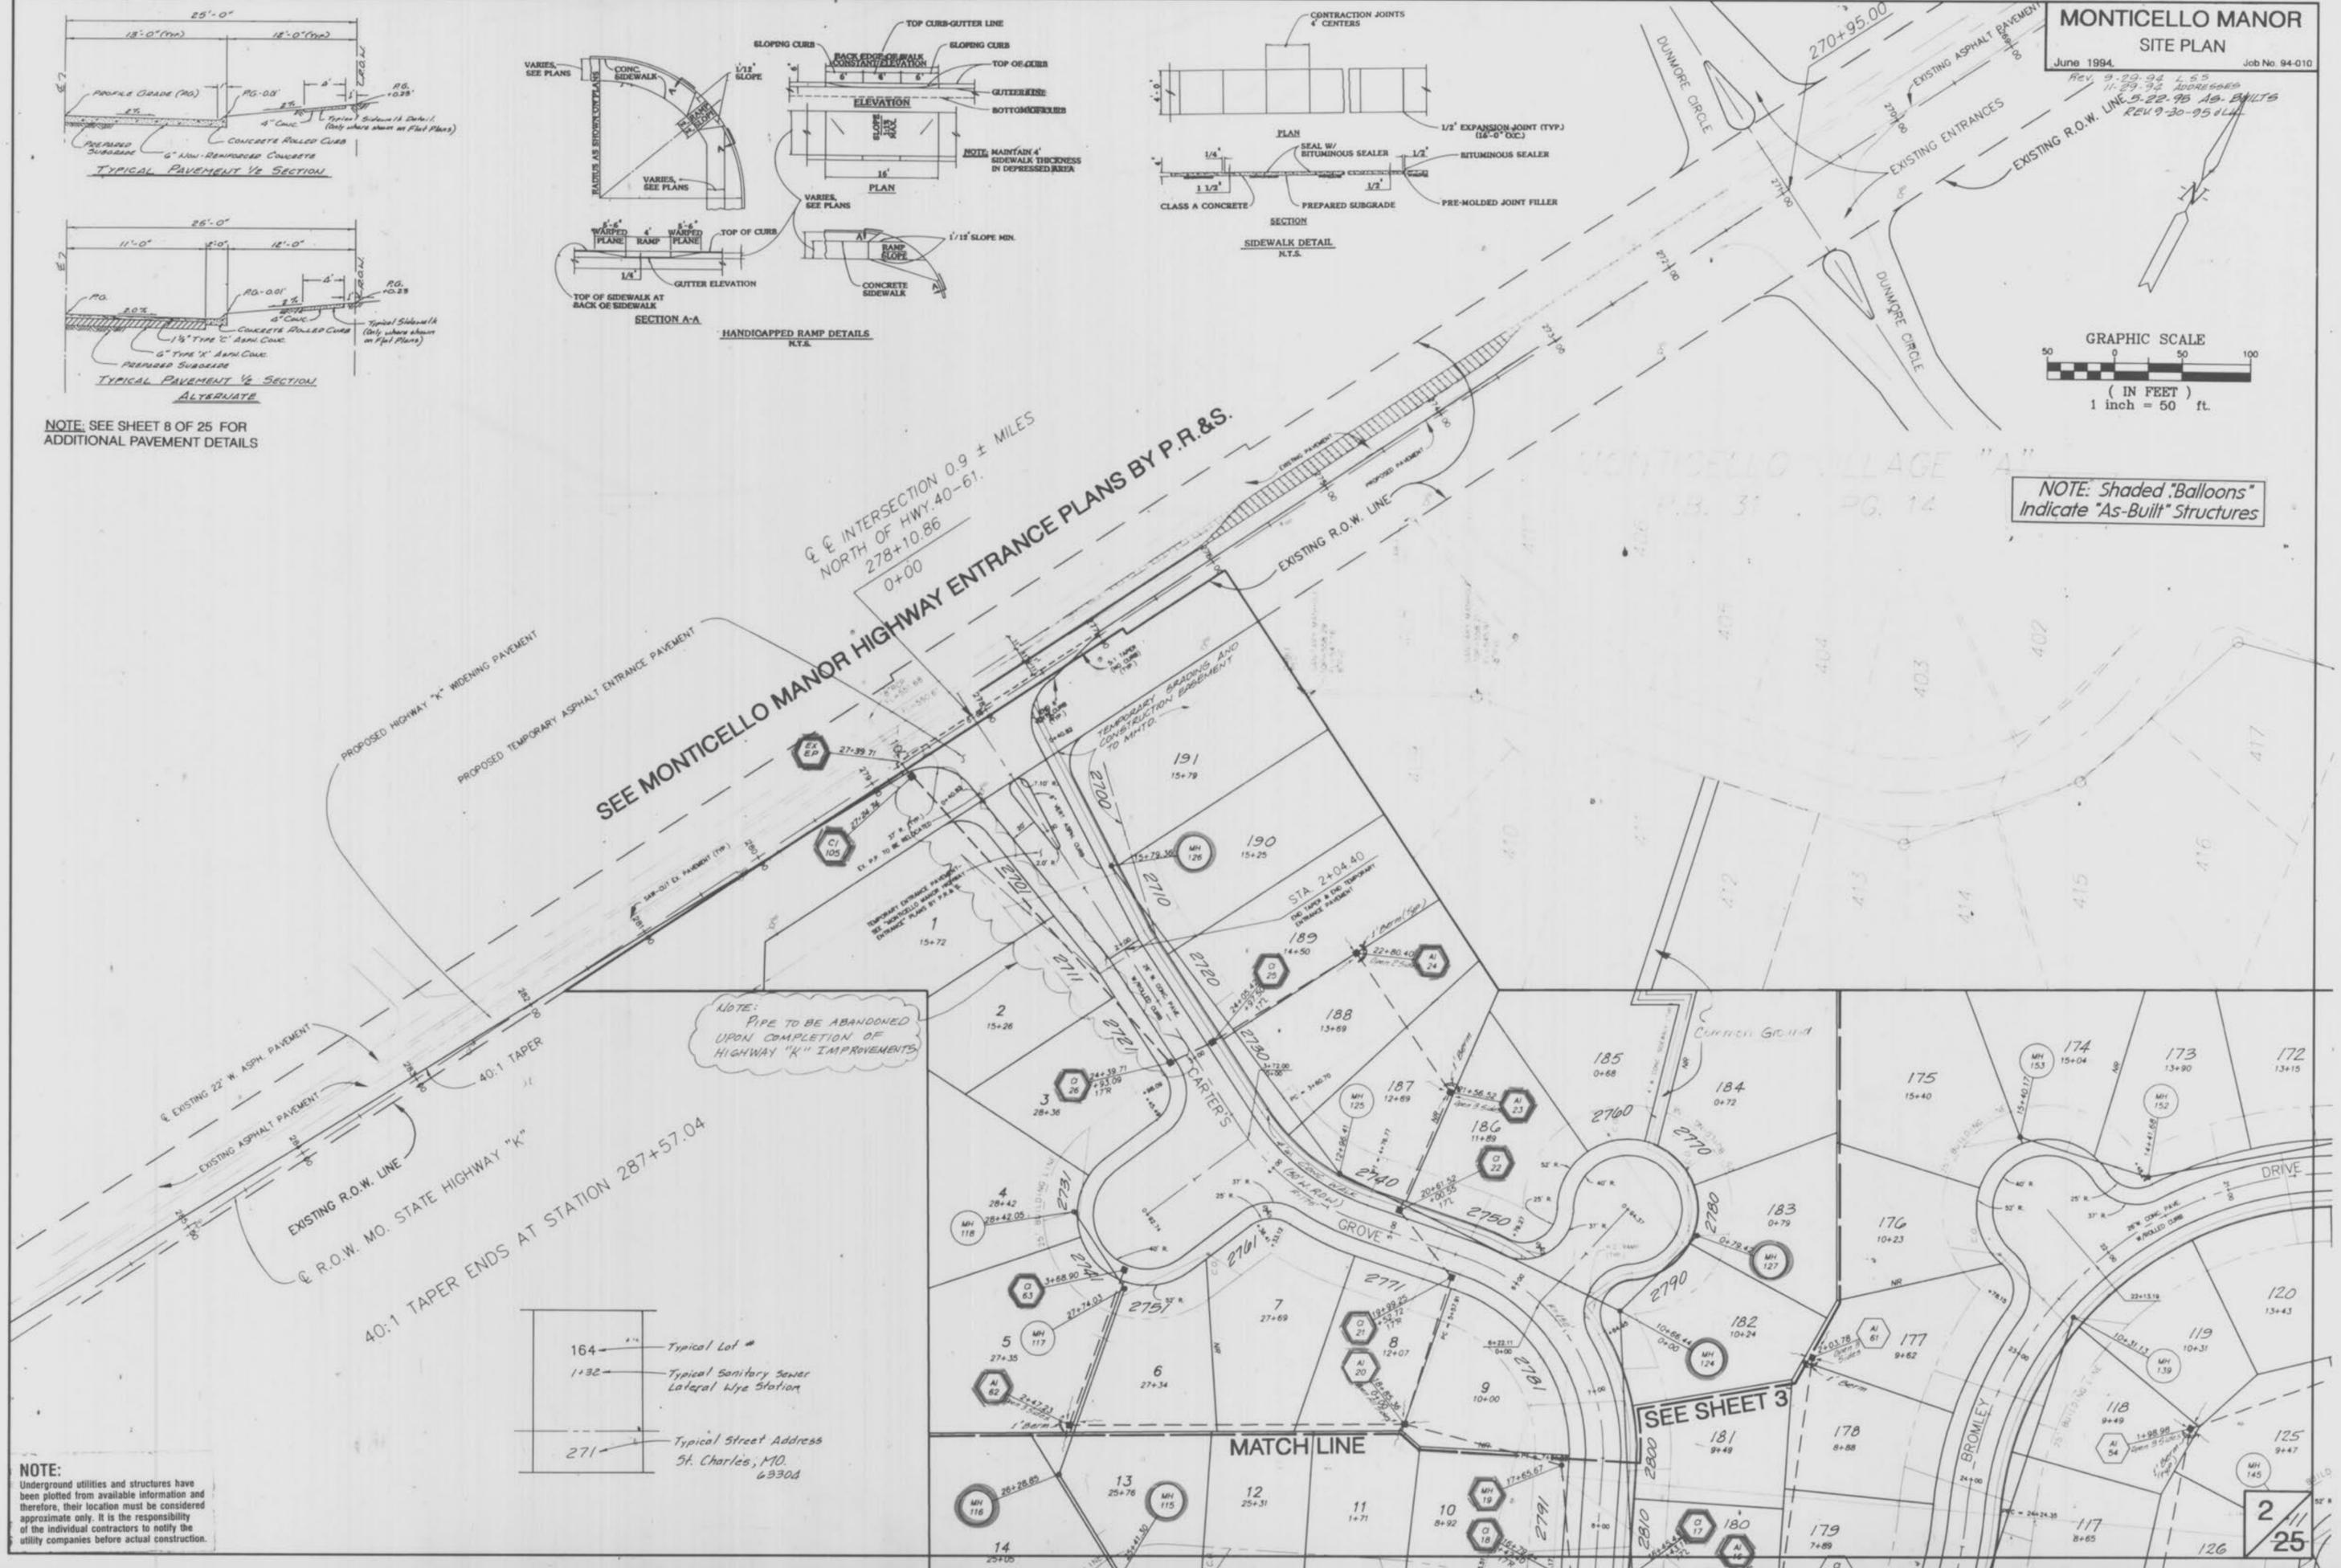

NOTE: Shaded "Balloons" Indicate "As-Built" Structures

**MONTICELLO MANOR**  
SITE PLAN  
June 1994 Job No. 94-010


11-89-94 ADDRESSES  
REV. 8-3-95 C.S. (414 & 107-B)  
COMMON GROUND & DETENTION AREA  
5-22-95 AS-BUILTS  
REV. 9-30-95 J.L.K.



SEE SHEET 2

SEE SHEET 4

MATCH LINE

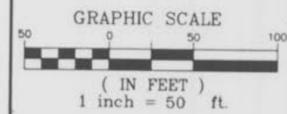


**NOTE:**  
Underground utilities and structures have been plotted from available information and therefore, their location must be considered approximate only. It is the responsibility of the individual contractors to notify the utility companies before actual construction.


**MONTICELLO MANOR  
SITE PLAN**

June 1984 Job No. 94-010

1-24-84 Approves  
1-5-95 1st, Burricade  
1-26-95 1st Temp  
Turnaround  
Rev. 4-5-95 L.S.S.  
San. M.H.'s 108-A,  
108-B, 135-A &  
135-B  
5-22-95 As-Built  
N / F  
HAENSSLER  
BK. 159 PG. 251

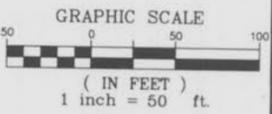

NOTE: Shaded "Balloons" Indicate "As-Built" Structures

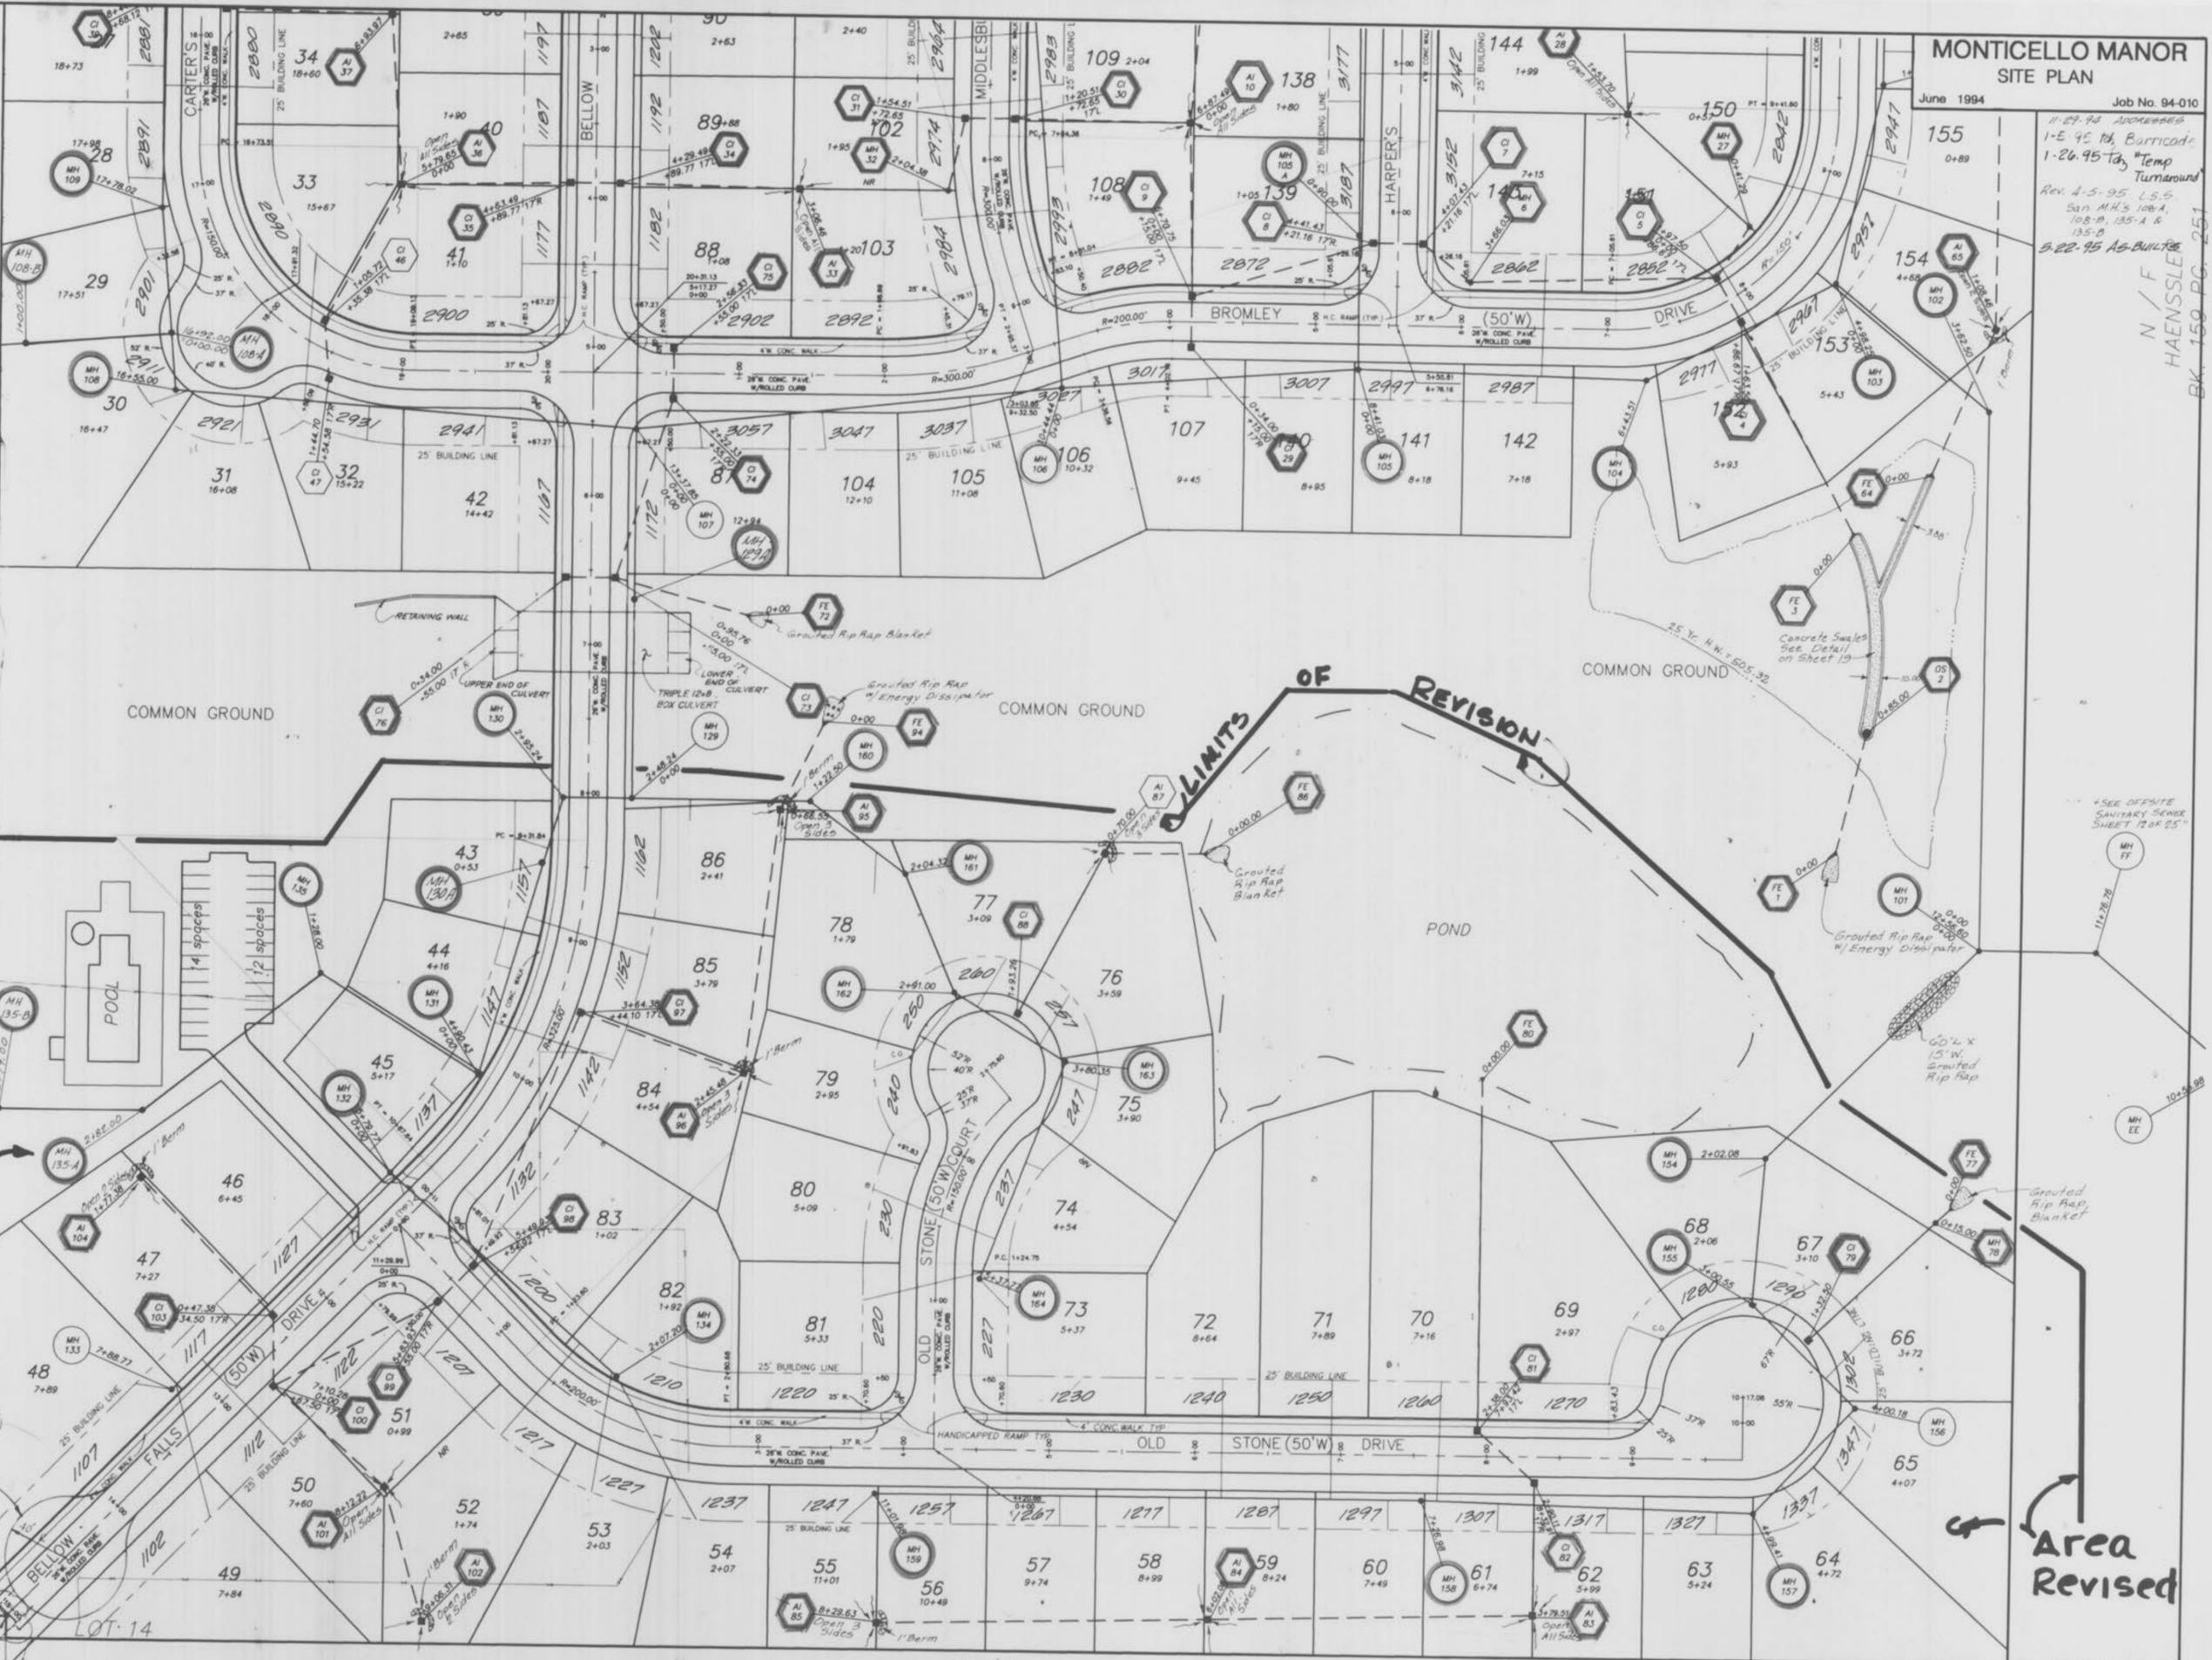


N / F  
GOLDBERG  
BK. 159 PG. 912  
**Area Revised**

**Area Revised**

N / F  
HAENSSLER


**NOTE: Shaded "Balloons" Indicate "As-Built" Structures**

PLAN	SURVEYED	DATE
	PLOTTED	BY
NO. BOOK	ALIGNED	CHECKED
	BY	DATE

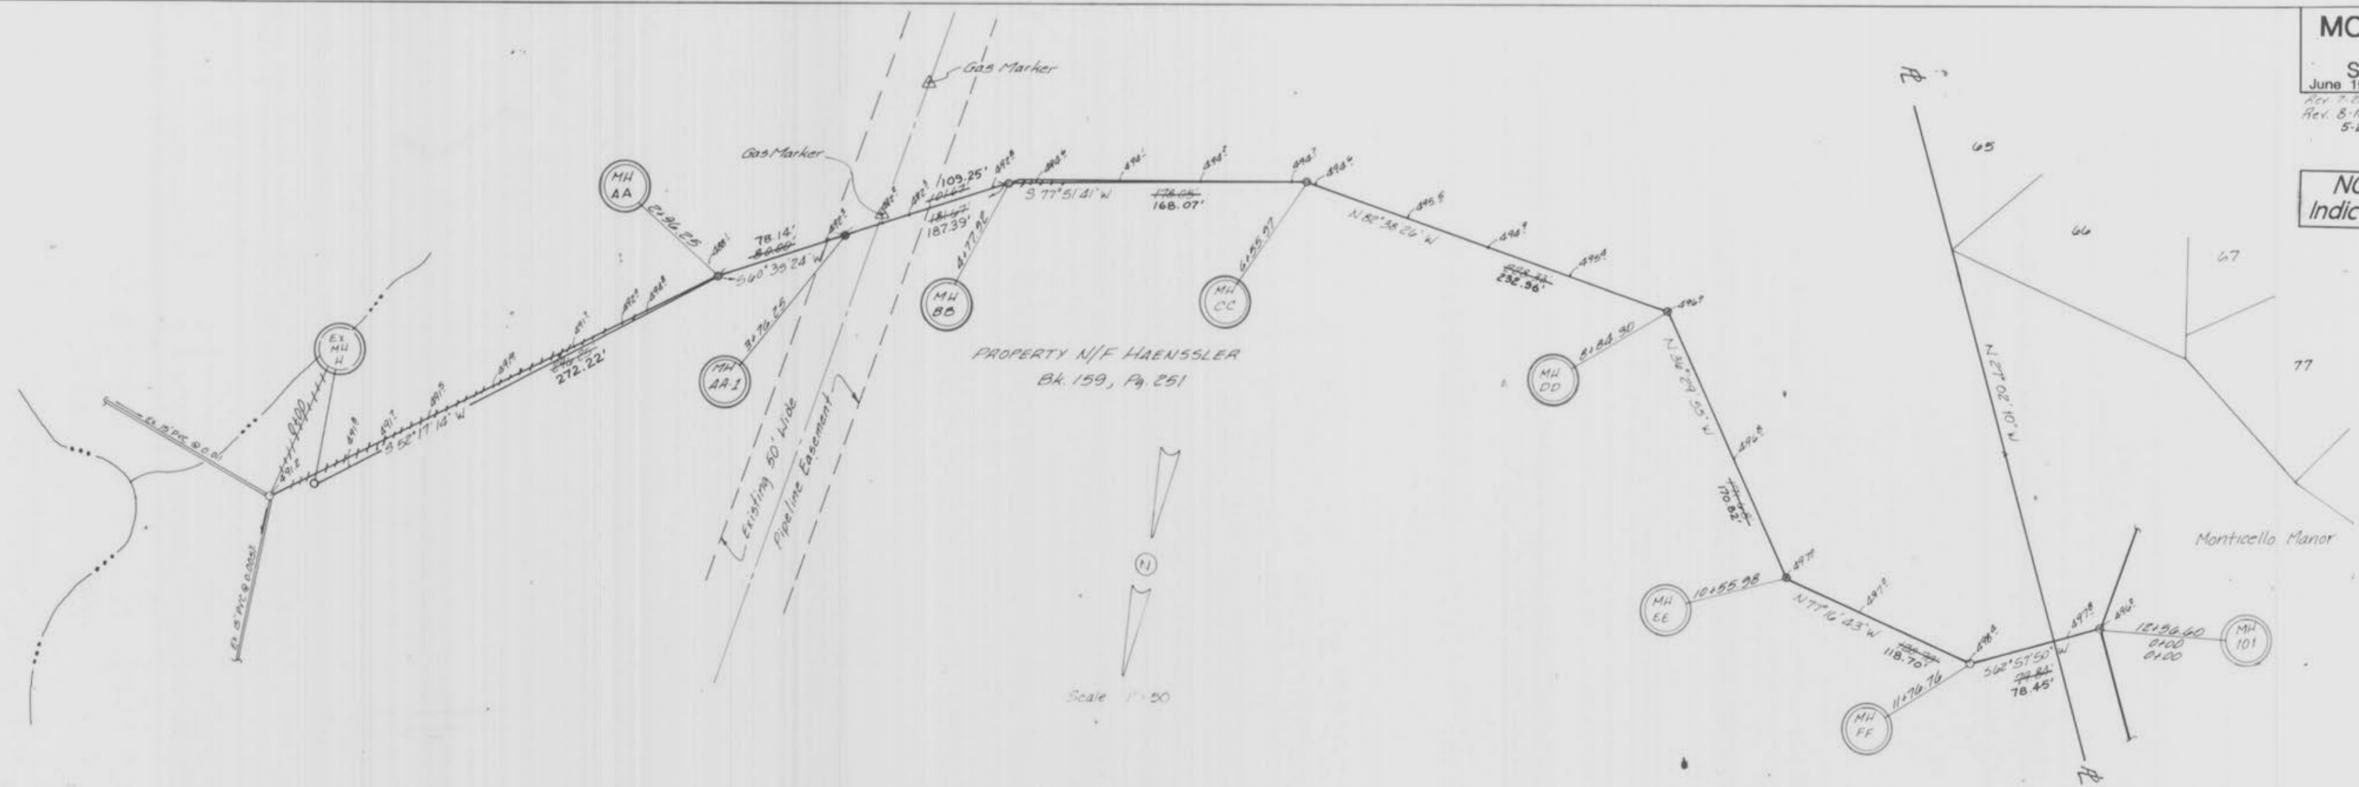

**NOTE:**  
 Underground utilities and structures have been plotted from available information and therefore, their location must be considered approximate only. It is the responsibility of the individual contractors to notify the utility companies before actual construction.

PROFILE	SURVEYED	DATE
	PLOTTED	BY
NO. BOOK	ALIGNED	CHECKED
	BY	DATE

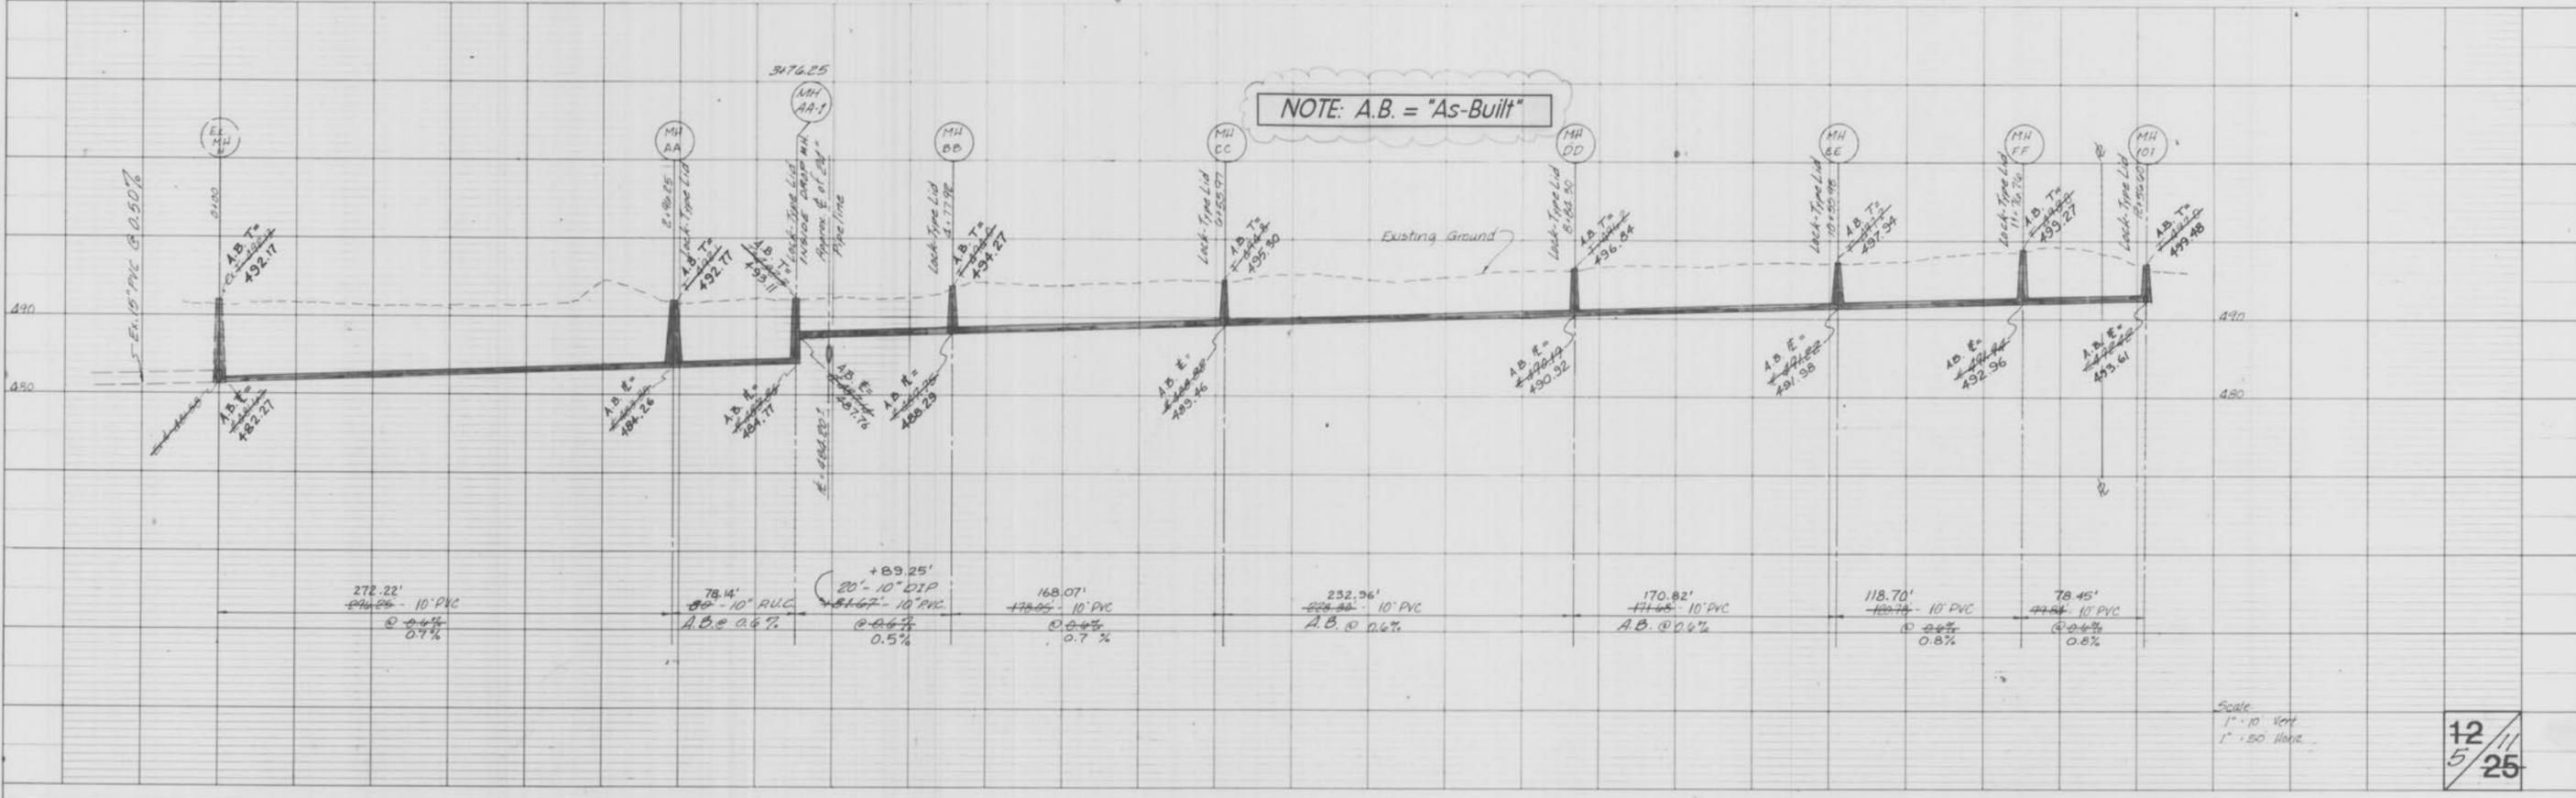

Scale  
 1" = 10 Vert  
 1" = 50 Horiz

**"AS-BUILTS"**

Monticello Manor  
 As-Built

**MONTICELLO MANOR  
SANITARY SEWER PROFILES**


June 1994 Job No. 94-010

REV. 8-10-94 L.S.S. LATERALS  
REV. 11-15-92 106 MH 120,  
REV. 4-25-95 L.S.S. (MH'S 108-A & 109-A)  
5-22-95 J.C.W. (AS BUILTS)

**SCALE**  
HORIZ: 1" = 50'  
VERT: 1" = 10'

DATE: \_\_\_\_\_ BY: \_\_\_\_\_  
ORIGINAL SURVEY PLOTTED: \_\_\_\_\_  
NOTE BOOK NO.: \_\_\_\_\_  
AREAS CHECKED: \_\_\_\_\_

DATE: \_\_\_\_\_ BY: \_\_\_\_\_  
ORIGINAL SURVEY PLOTTED: \_\_\_\_\_  
NOTE BOOK NO.: \_\_\_\_\_  
AREAS CHECKED: \_\_\_\_\_

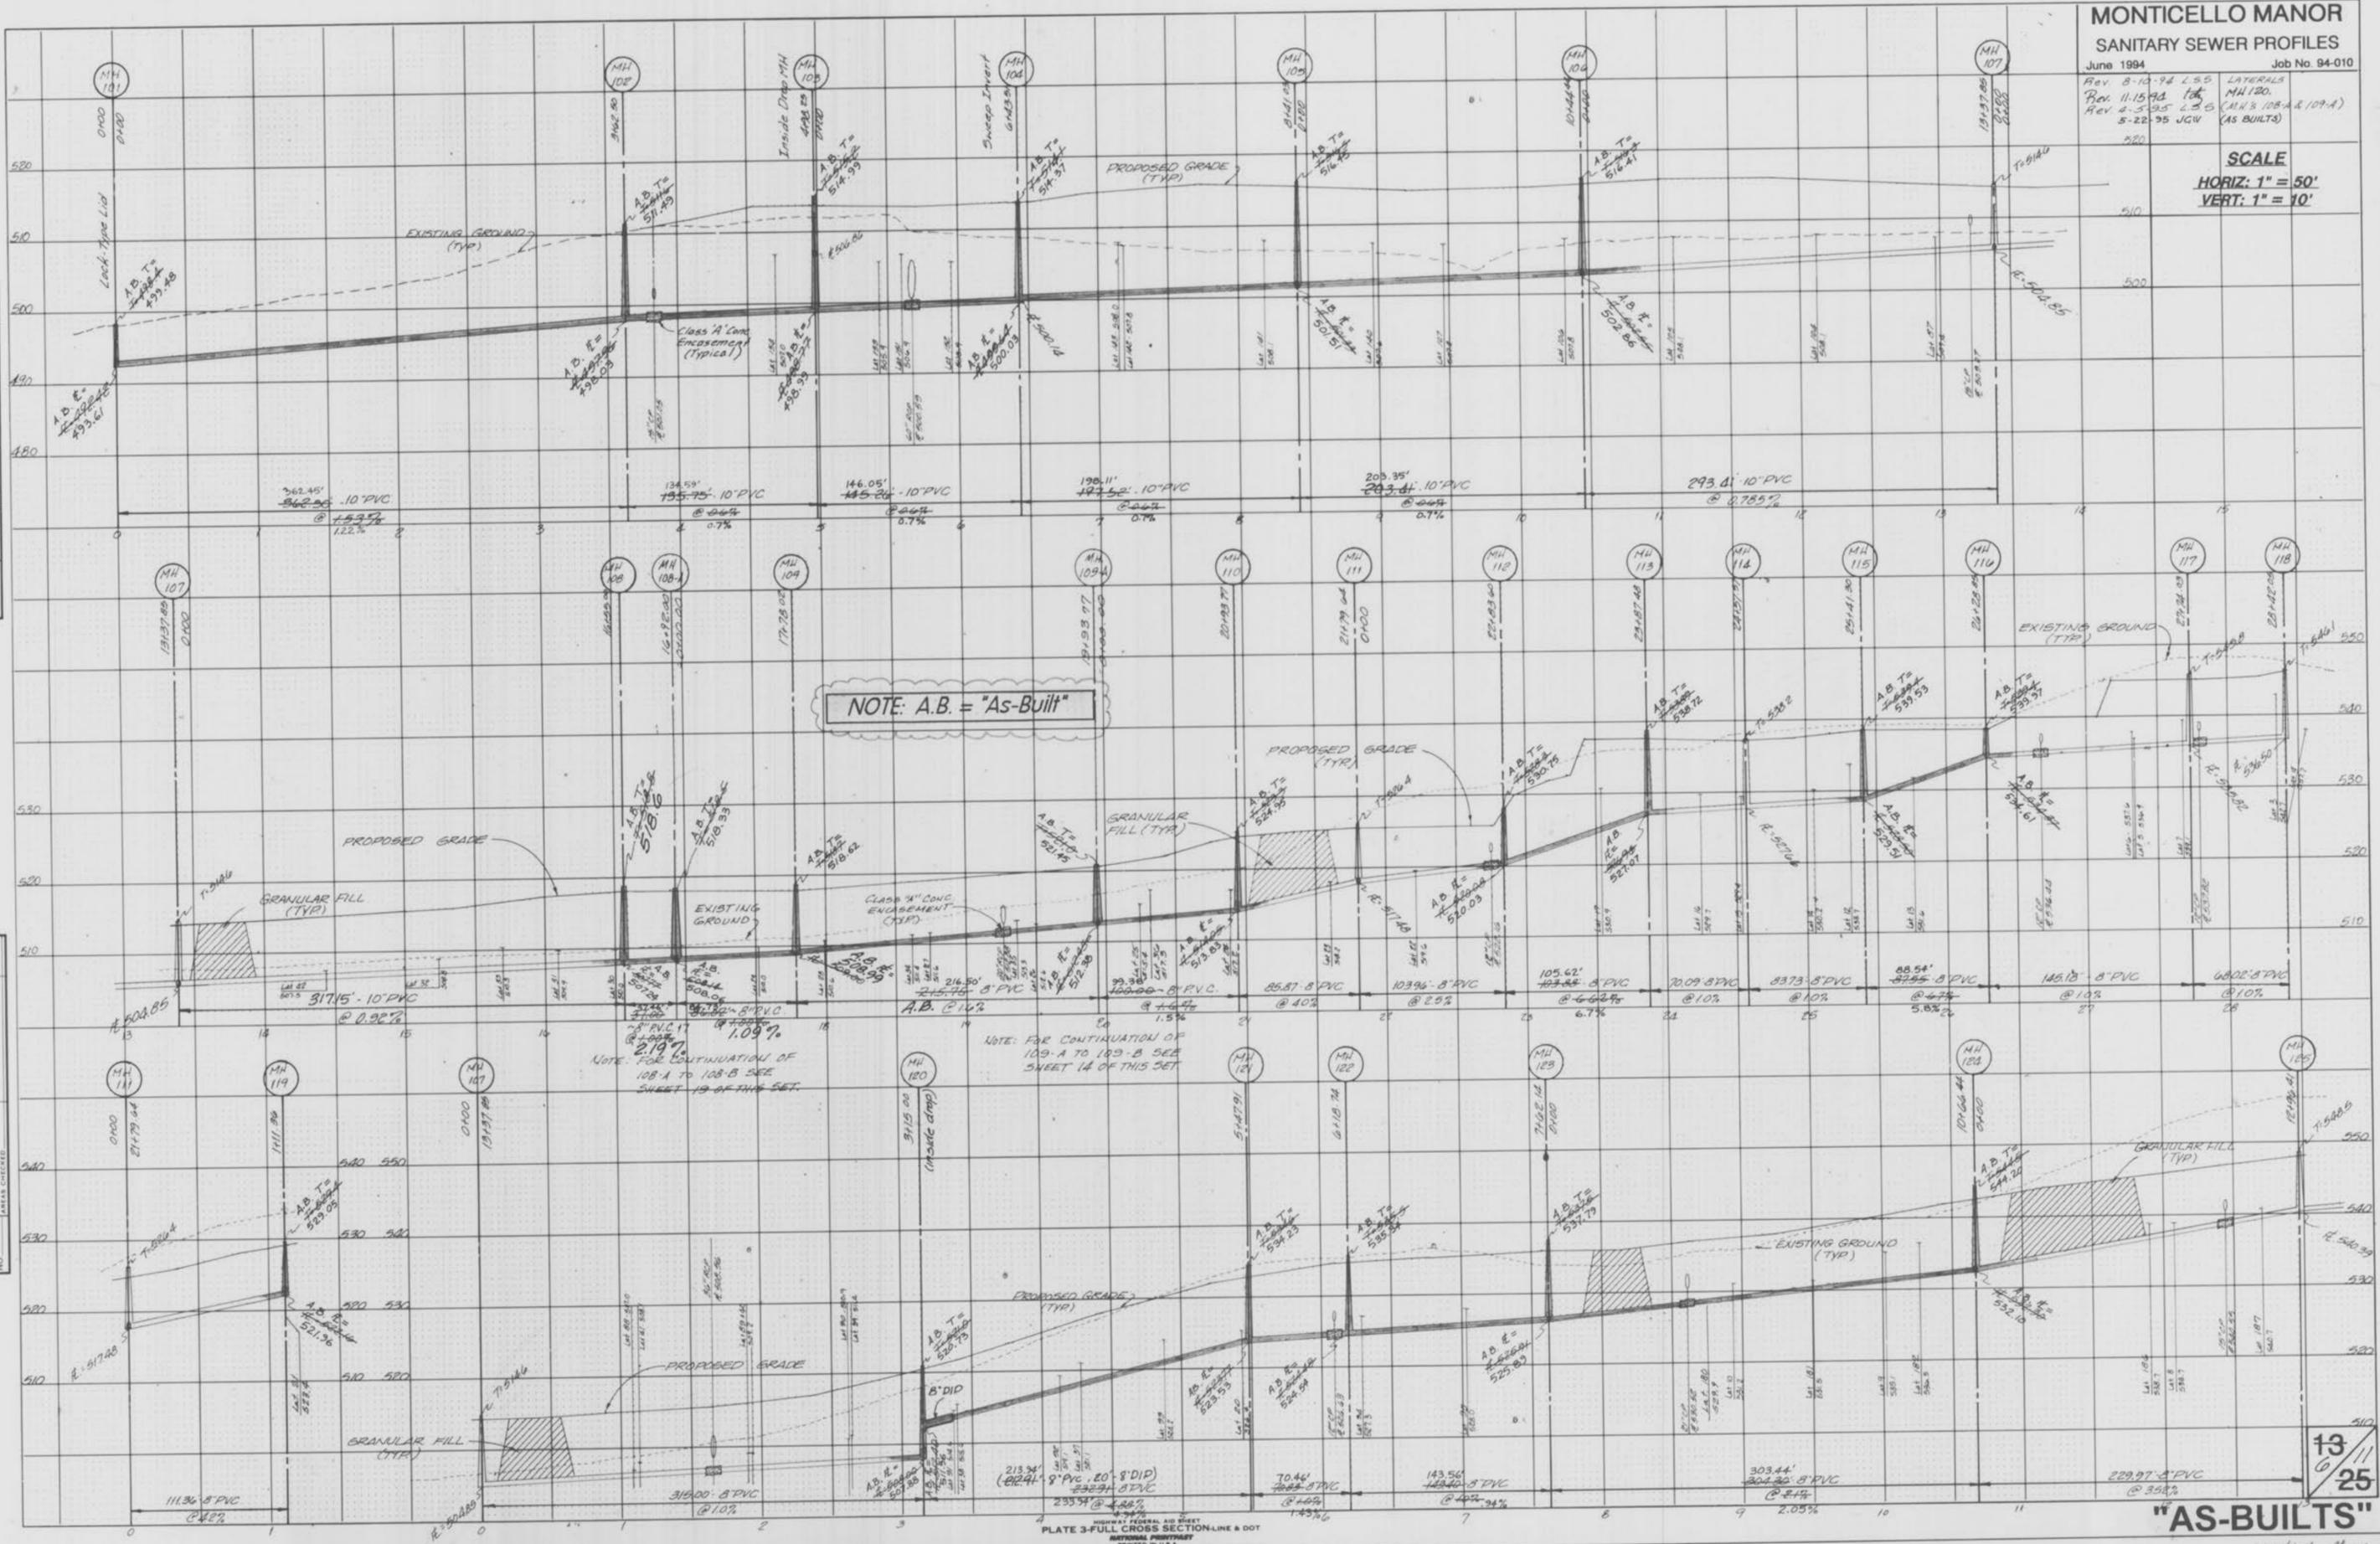

13  
11  
25

**"AS-BUILTS"**

Monticello Manor  
As-Builts


STATE OF ARIZONA  
DEPARTMENT OF TRANSPORTATION  
DESIGN SECTION  
PLATE 3-FULL CROSS SECTION LINE & DOT  
NATIONAL HIGHWAY SYSTEM  
PRINTED IN U.S.A.

NOTE: A.B. = "As-Built"

REV. 8-10-94 L.S.S. LATERALS  
 REV. 10-12-94 L.S.S. LATERALS  
 REV. 4-5-95 L.S.S. M.H.'S  
 (107-A & 107-B)  
 5-22-95 J.G.W. (AS-BUILTS)

DATE: \_\_\_\_\_ BY: \_\_\_\_\_  
 SURVEYED: \_\_\_\_\_ PLOTTED: \_\_\_\_\_  
 ORIGINAL SURVEY: \_\_\_\_\_ NOTE BOOK: \_\_\_\_\_  
 AREA CHECKED: \_\_\_\_\_

DATE: \_\_\_\_\_ BY: \_\_\_\_\_  
 SURVEYED: \_\_\_\_\_ PLOTTED: \_\_\_\_\_  
 ORIGINAL SURVEY: \_\_\_\_\_ NOTE BOOK: \_\_\_\_\_  
 AREA CHECKED: \_\_\_\_\_

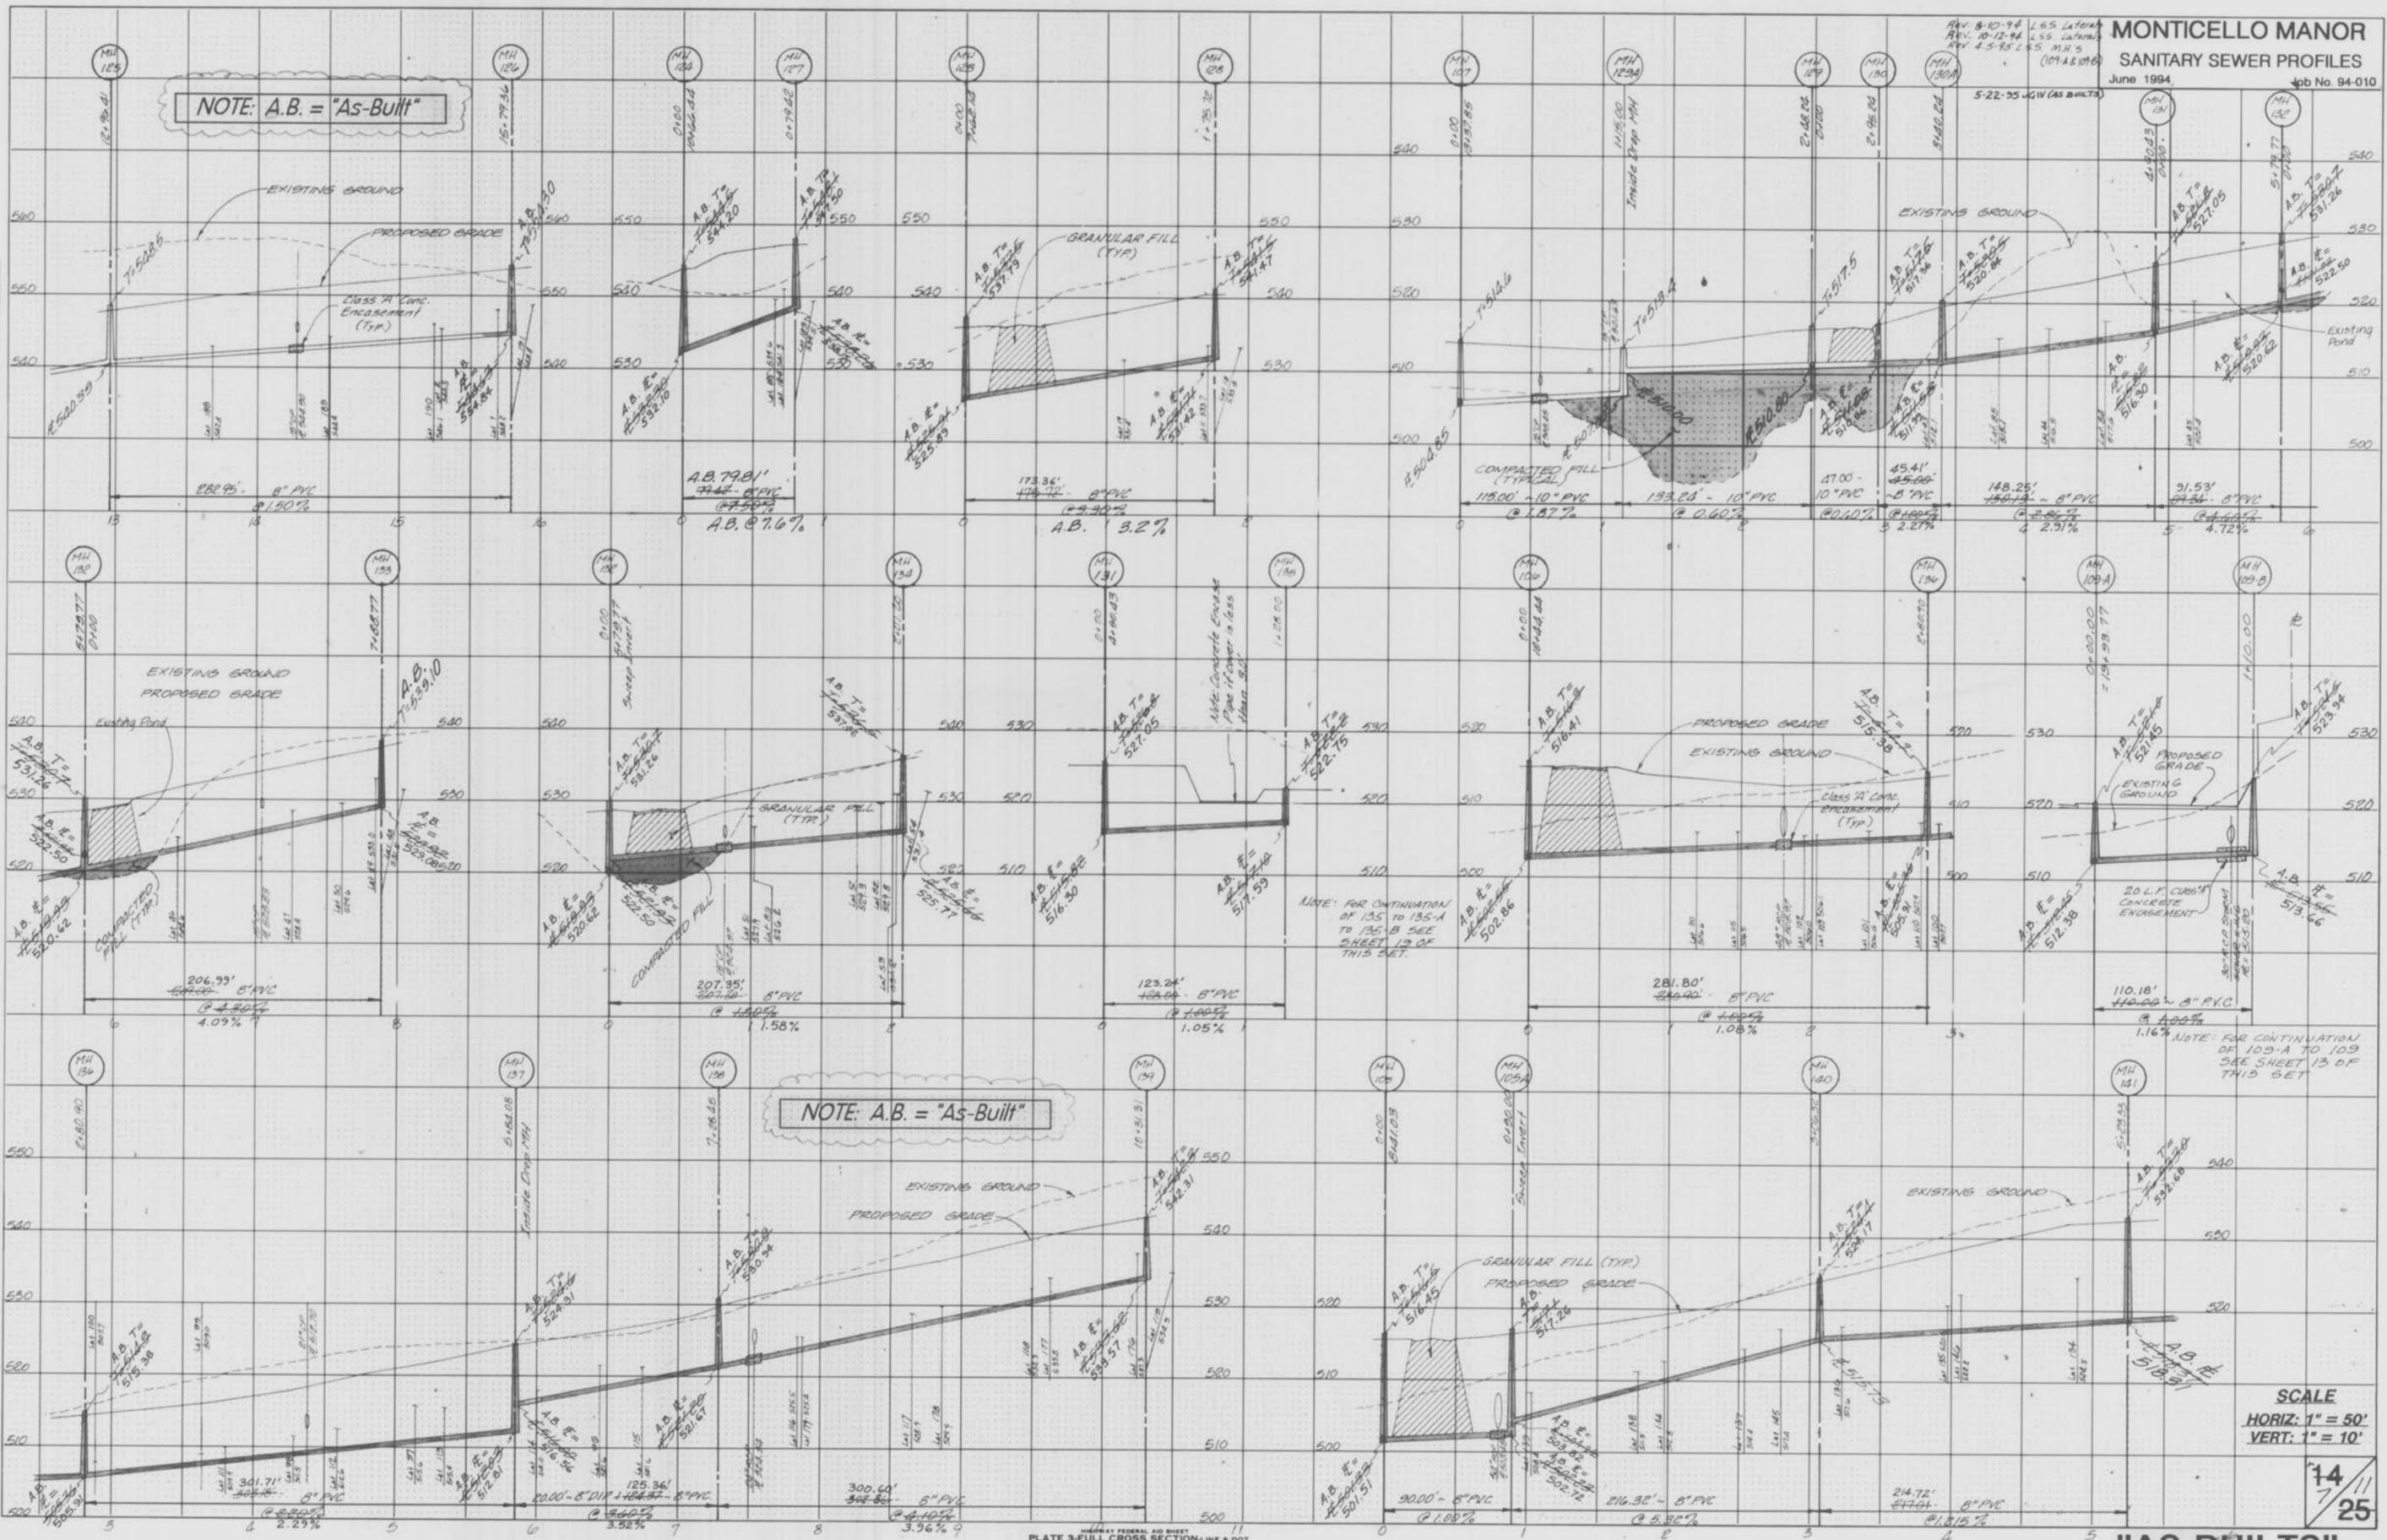

NOTE: A.B. = "As-Built"

SCALE  
 HORIZ: 1" = 50'  
 VERT: 1" = 10'

14/25

"AS-BUILTS"


PLATE 3-FULL CROSS SECTION LINE & DOT  
 NATIONAL INSTRUMENTS  
 PRINTED IN U.S.A.

**MONTICELLO MANOR  
SANITARY SEWER PROFILES**

June 1994 Job No. 94-010  
5-22-95 UGV (AS BUILTS)

DATE: \_\_\_\_\_  
BY: \_\_\_\_\_  
SURVEYED: \_\_\_\_\_  
PLOTTED: \_\_\_\_\_  
FINAL SURVEY: \_\_\_\_\_  
NOTE BOOK: \_\_\_\_\_  
NO. \_\_\_\_\_  
AREA CHECKED: \_\_\_\_\_

DATE: \_\_\_\_\_  
BY: \_\_\_\_\_  
SURVEYED: \_\_\_\_\_  
PLOTTED: \_\_\_\_\_  
ORIGINAL SURVEY: \_\_\_\_\_  
NOTE BOOK: \_\_\_\_\_  
NO. \_\_\_\_\_  
AREA CHECKED: \_\_\_\_\_

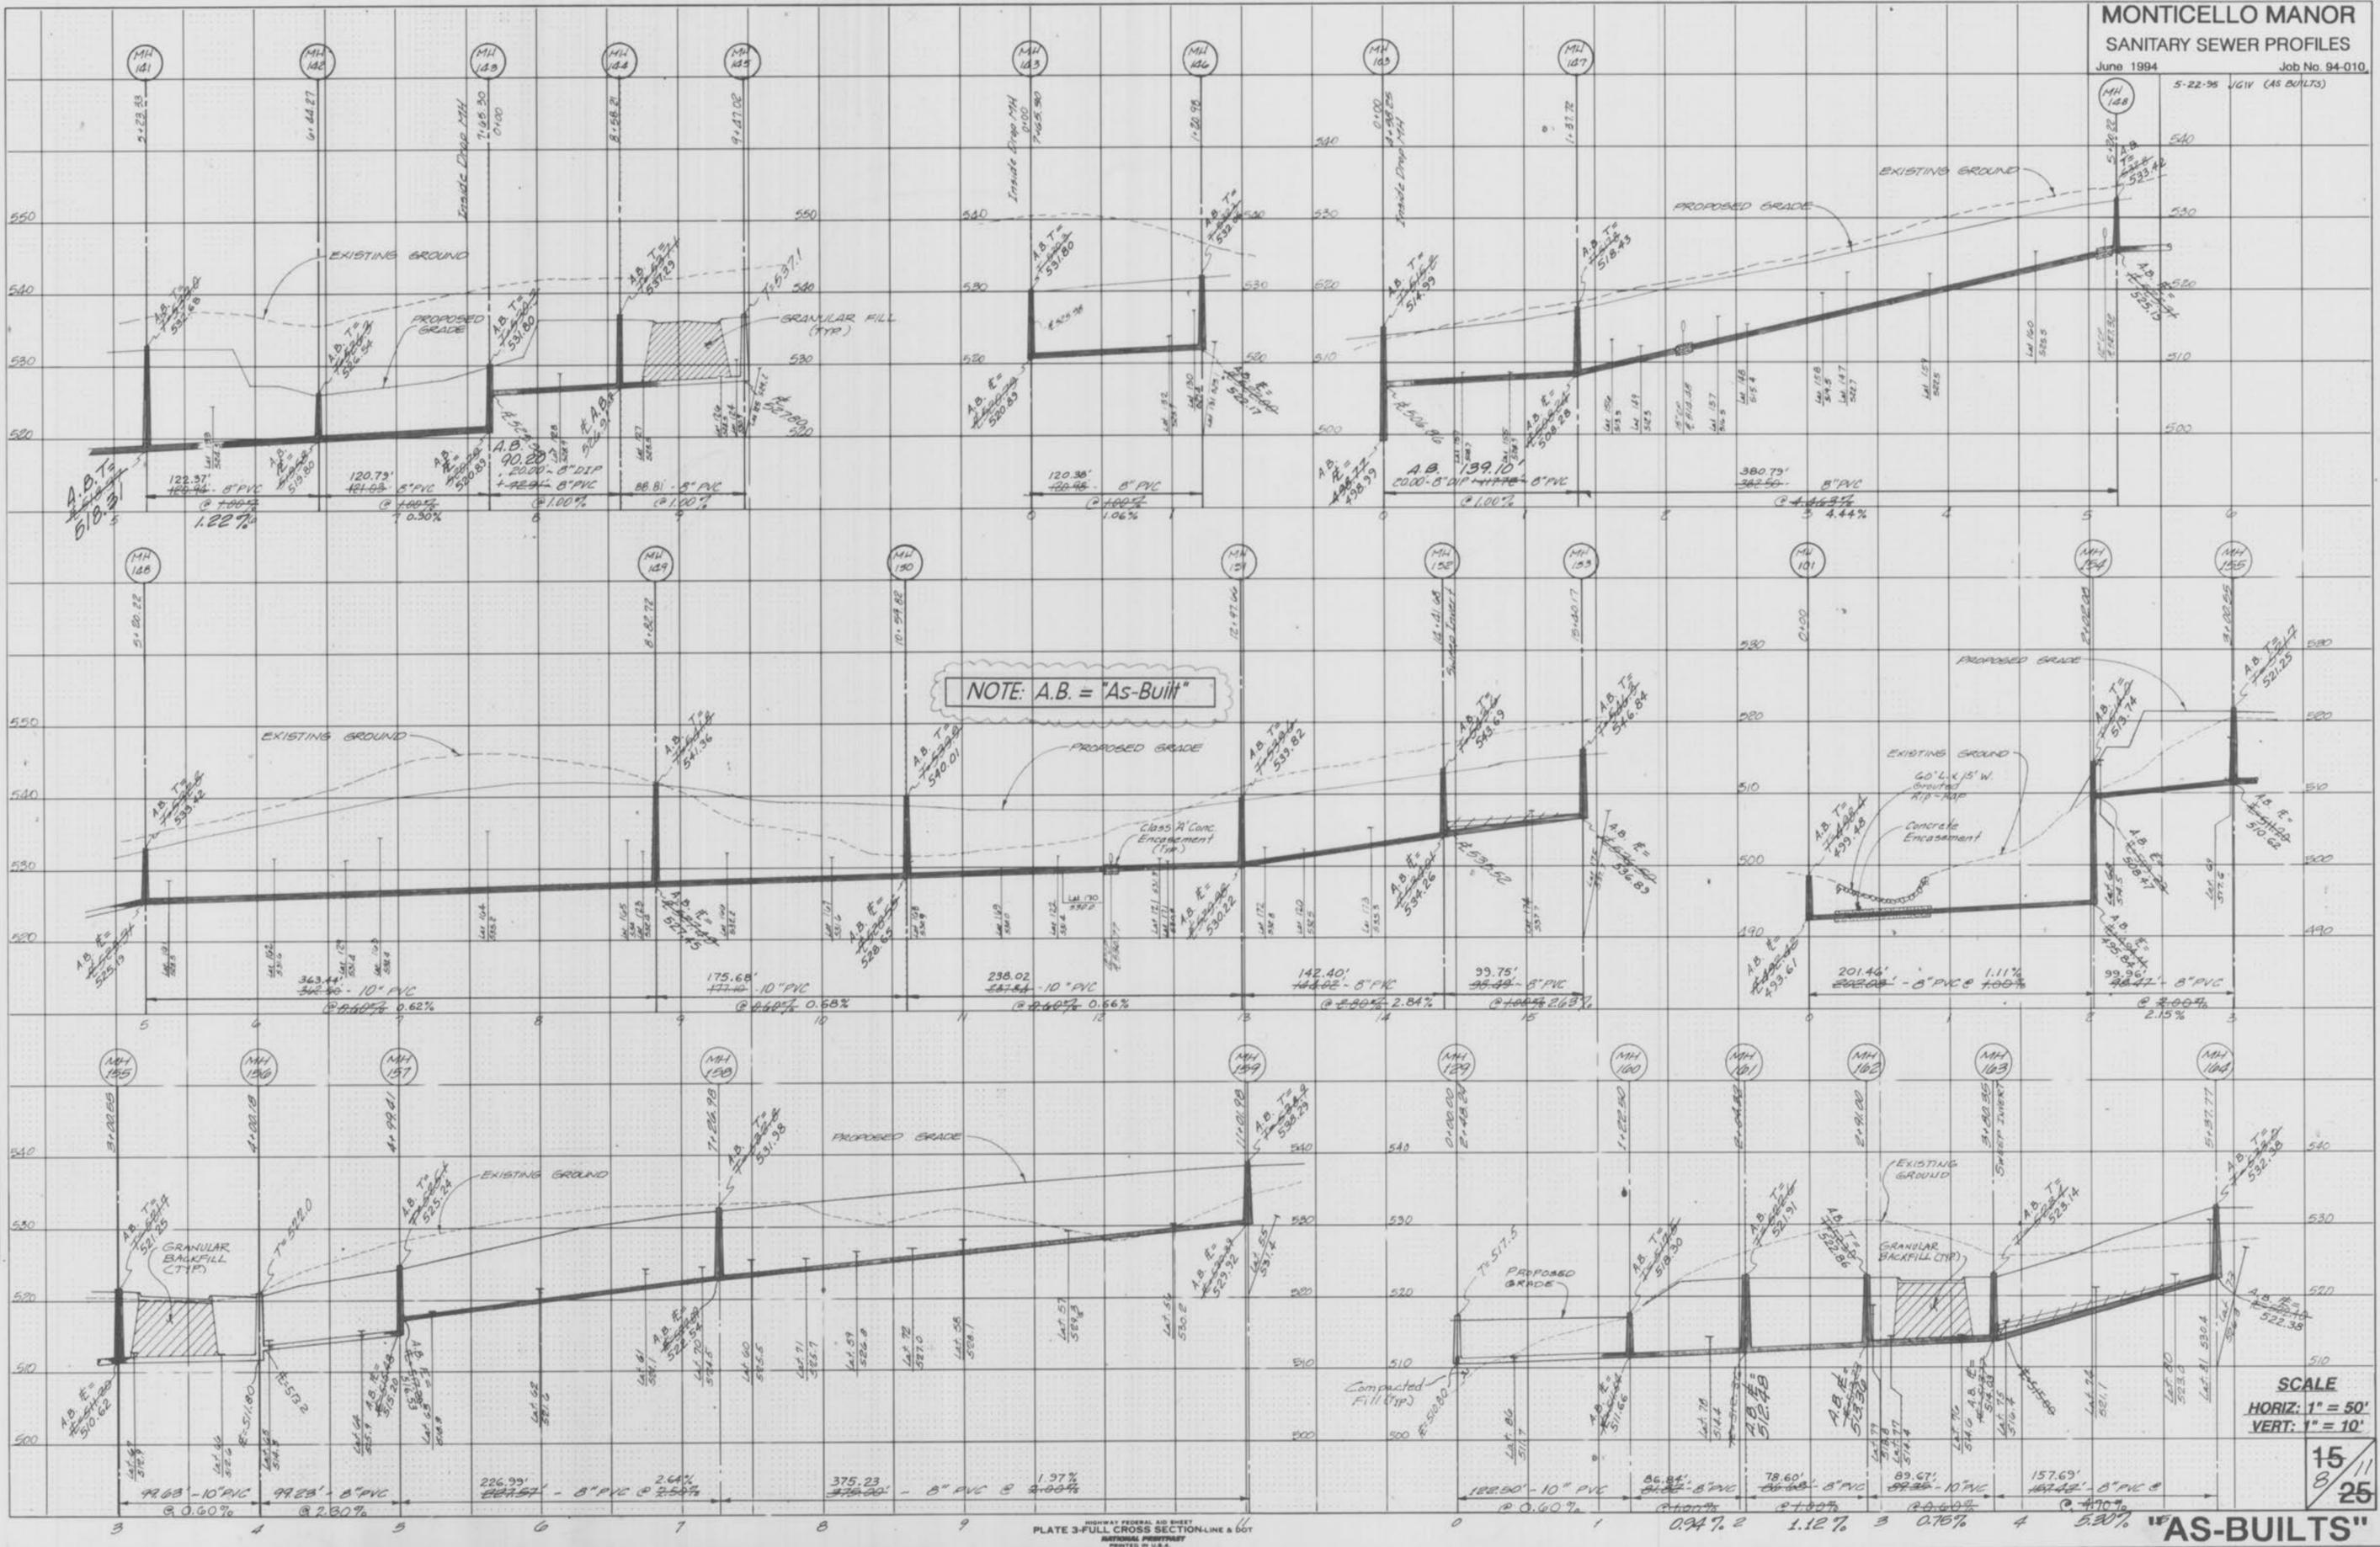


Monticello Manor  
As-Built

**MONTICELLO MANOR  
STORM SEWER PROFILES**

June 1994 Job No. 94-010

**SCALE**  
HORIZ: 1" = 50'  
VERT: 1" = 10'

Rev. 4-5-95 L.S.S.  
(94.0 X 11.0)  
5-22-95 J.G.V.  
(AS BUILTS)  
REV. 9-30-95 J.L.K.  
EXISTING GROUND

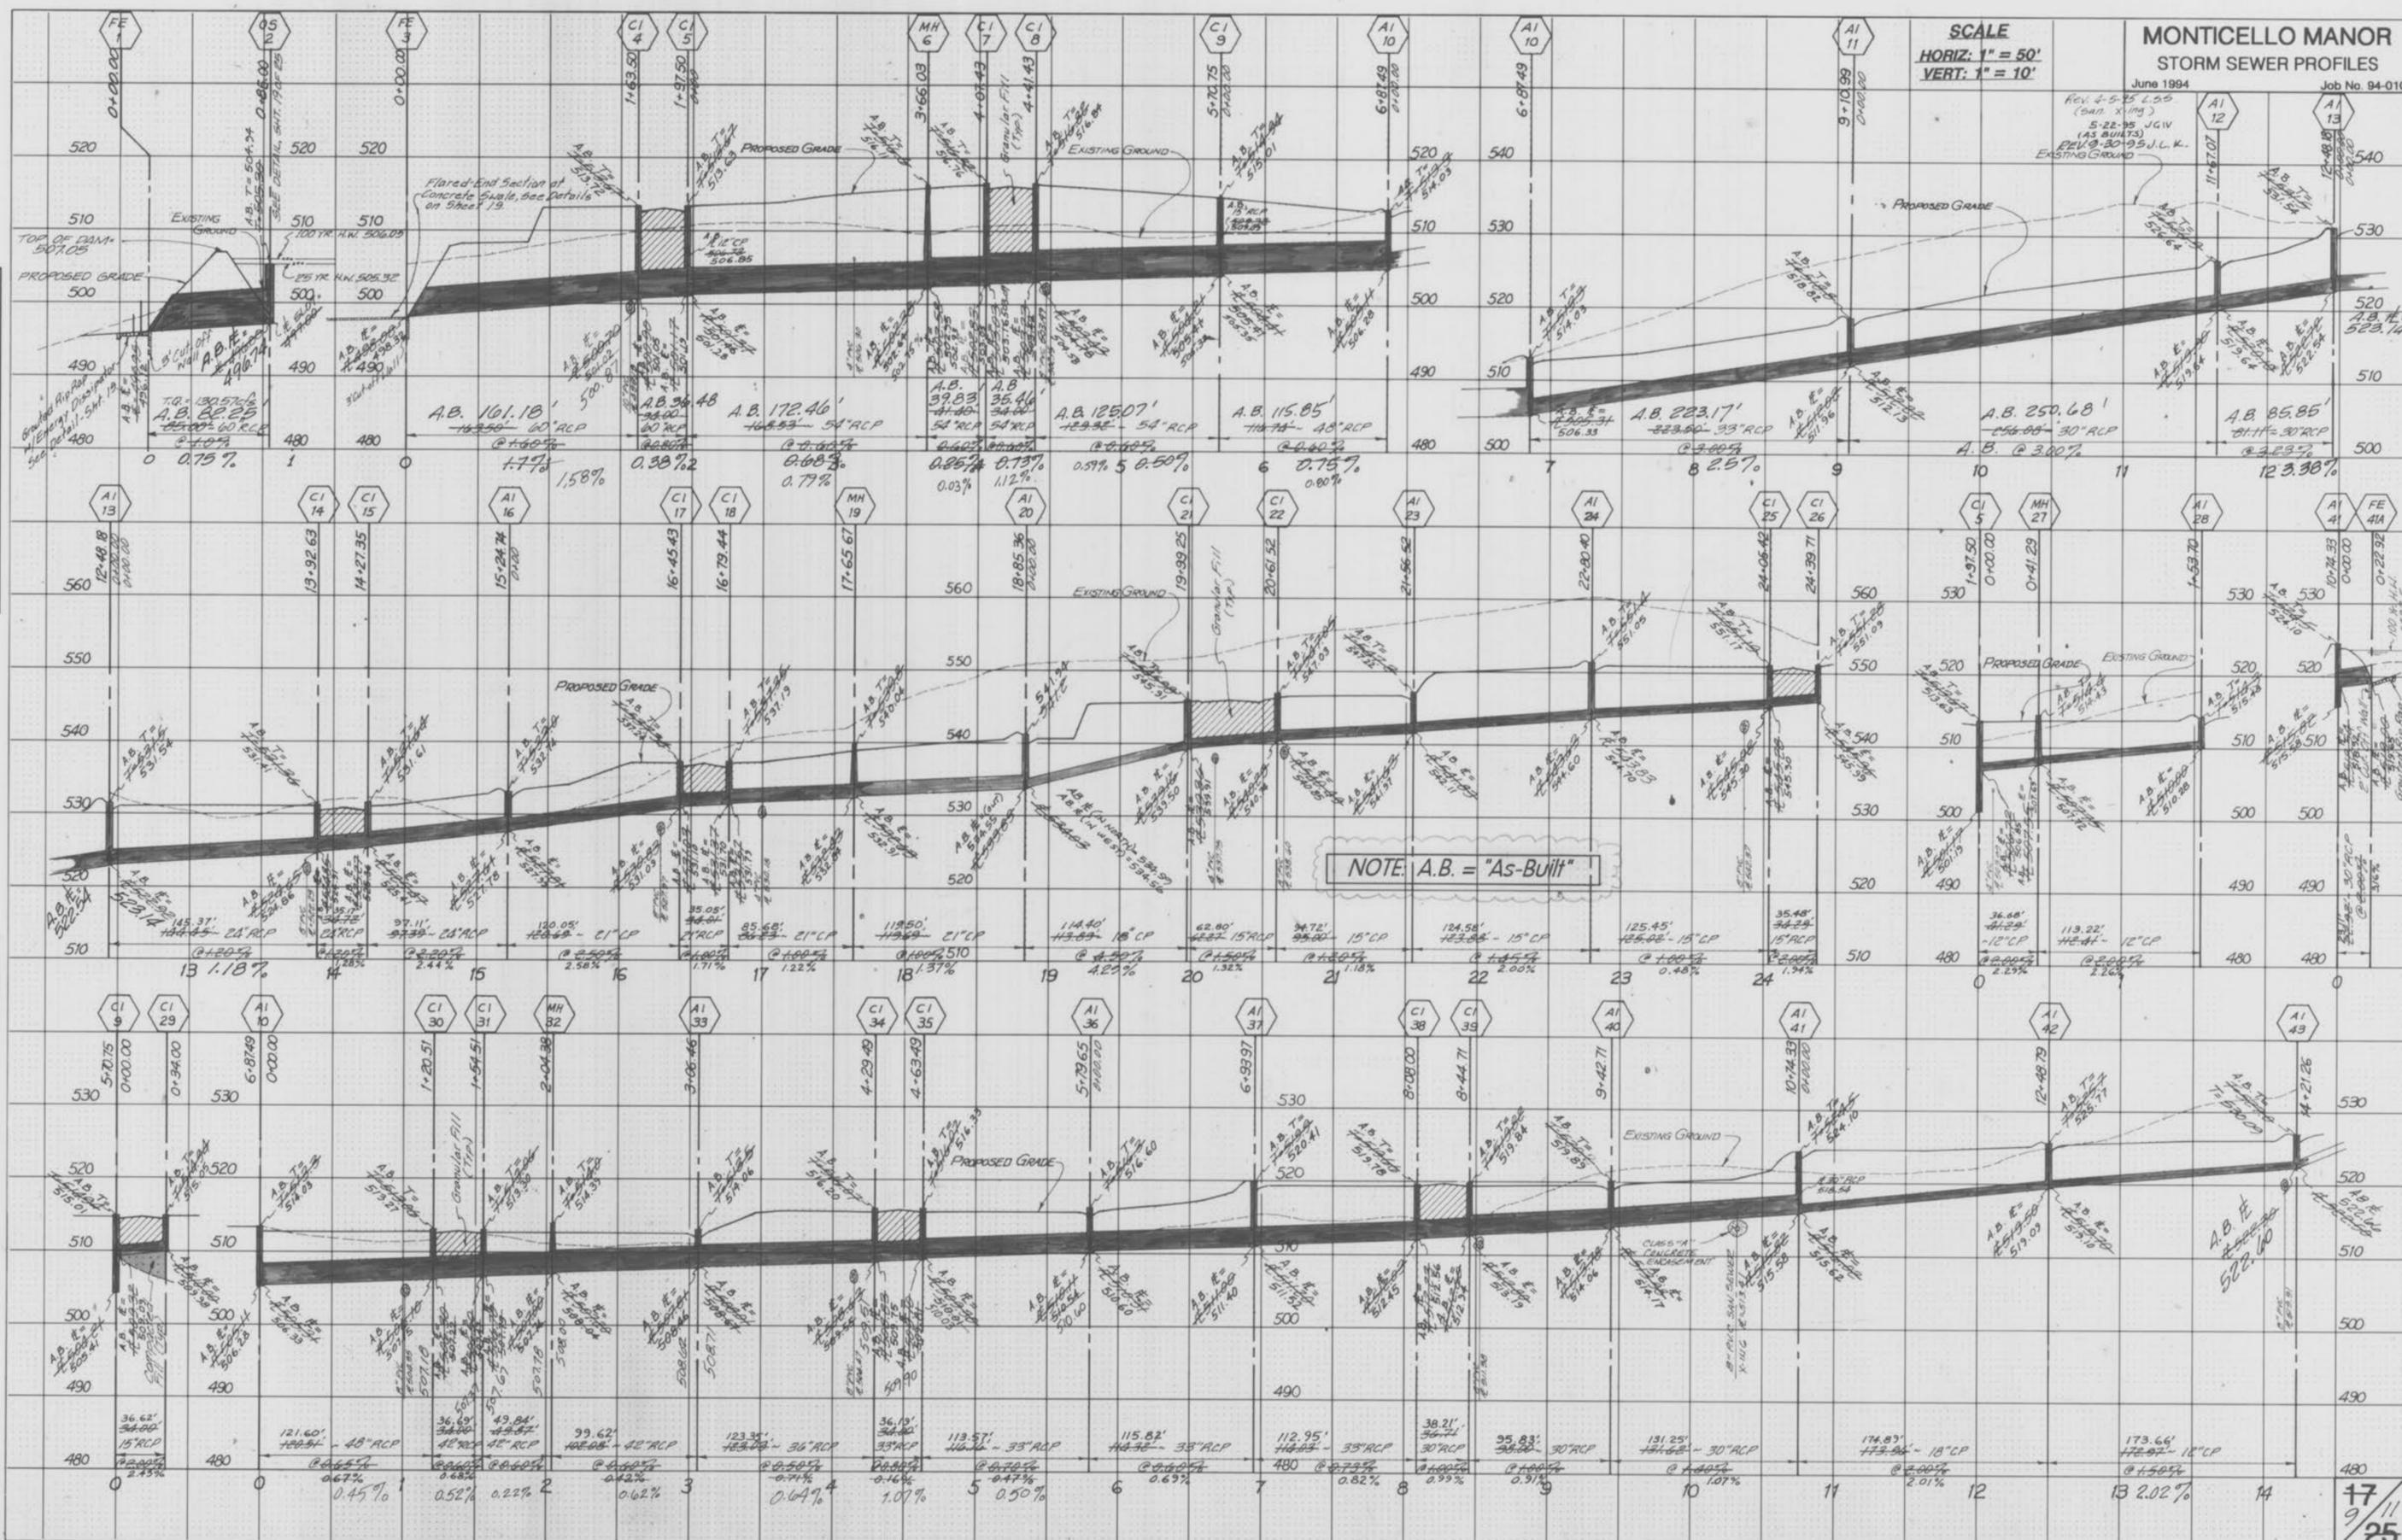

NOTE: A.B. = "As-Built"


FINAL SURVEY PLOTTED  
NOTE BOOK TEMPLATE  
AREAS CHECKED

ORIGINAL SURVEY PLOTTED  
NOTE BOOK TEMPLATE  
AREAS CHECKED

**MONTICELLO MANOR  
STORM SEWER PROFILES\***  
June 1994 Job No. 94-010  
5-22-95 JGV 'AS-BUILTS'  
REV 0-30-95 ULK

DATE: \_\_\_\_\_  
BY: \_\_\_\_\_  
SURVEYED: \_\_\_\_\_  
PLOTTED: \_\_\_\_\_  
TEMPLATE: \_\_\_\_\_  
NOTE BOOK: \_\_\_\_\_  
AREA CHECKED: \_\_\_\_\_  
NO. \_\_\_\_\_

DATE: \_\_\_\_\_  
BY: \_\_\_\_\_  
SURVEYED: \_\_\_\_\_  
PLOTTED: \_\_\_\_\_  
TEMPLATE: \_\_\_\_\_  
NOTE BOOK: \_\_\_\_\_  
AREA CHECKED: \_\_\_\_\_  
NO. \_\_\_\_\_

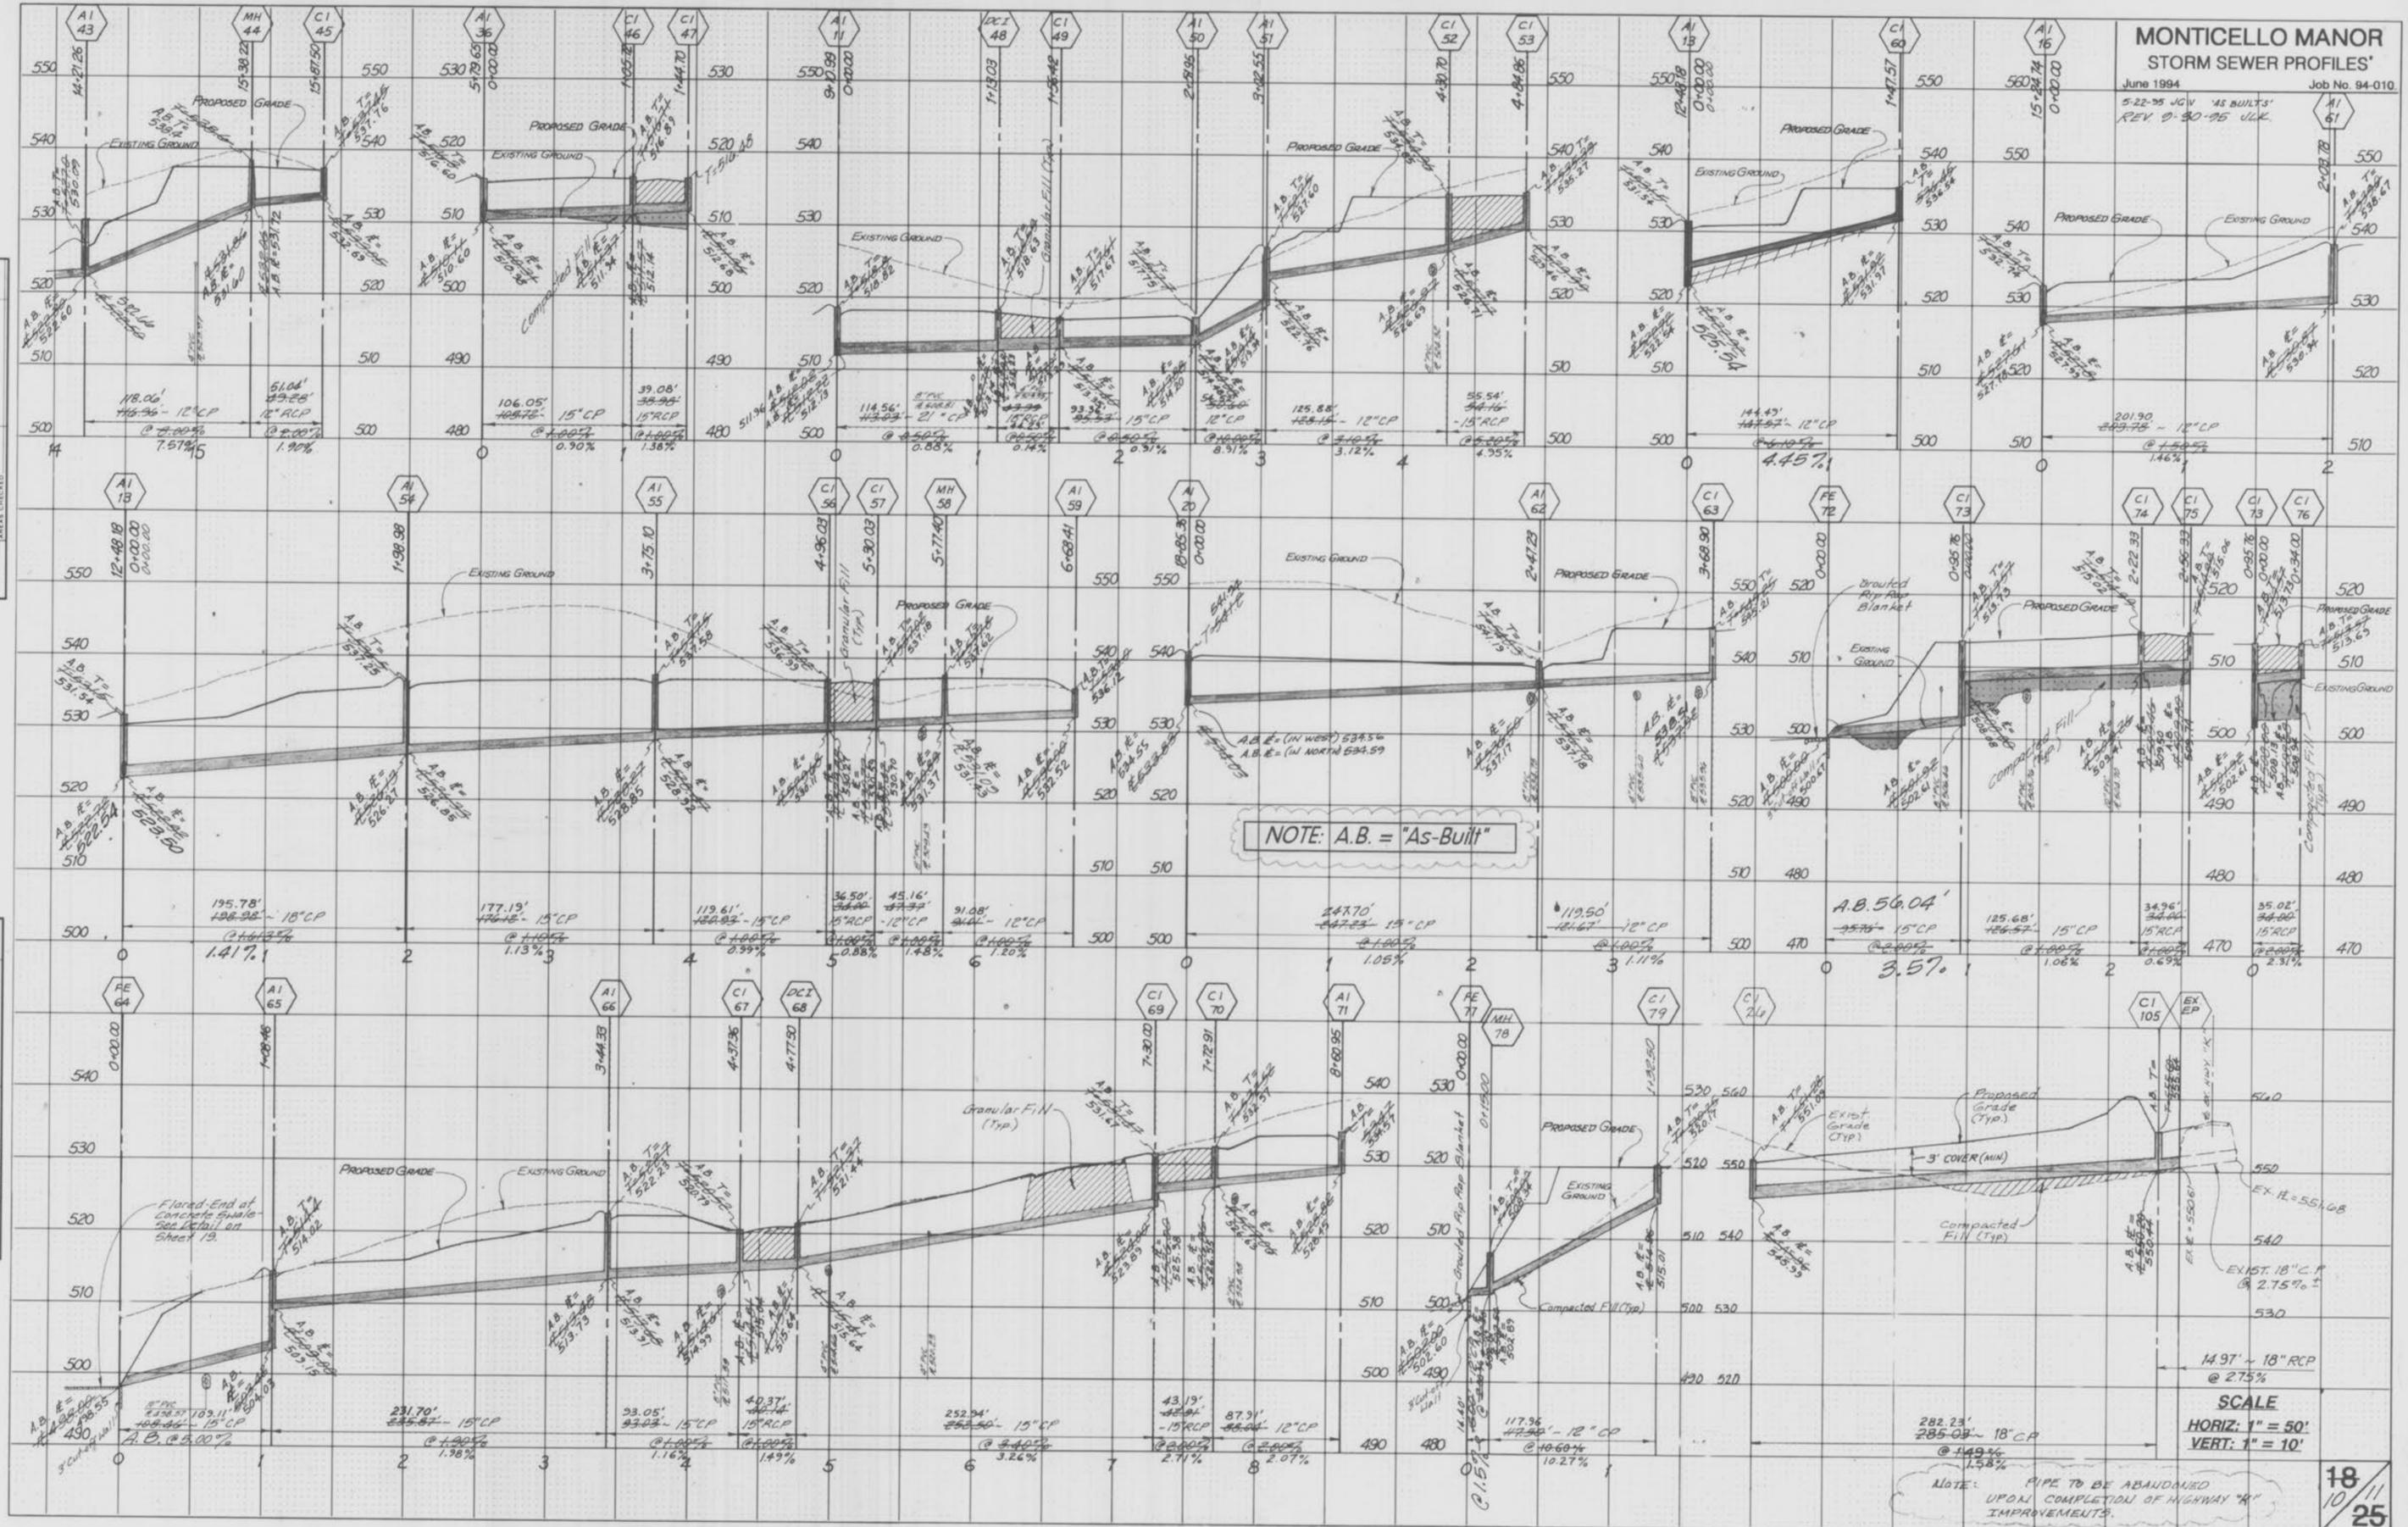

NOTE: A.B. = "As-Built"

SCALE  
HORIZ: 1" = 50'  
VERT: 1" = 10'

NOTE: PIPE TO BE ABANDONED UPON COMPLETION OF HIGHWAY "K" IMPROVEMENTS.

18  
10  
25

"AS-BUILTS"


Monticello Manor  
As-Builts

**MONTICELLO MANOR**  
STORM/SAN. SEWER PROFILES


June 1994 Job No. 94-010

REV. 2-8-95 L.S.S.  
REV. 4-5-95 L.S.S. (SAN. M.N. 5)  
5-22-95 J.G.W. 'AS-BUILT'

SCALE  
HORIZ: 1" = 50'  
VERT: 1" = 10'

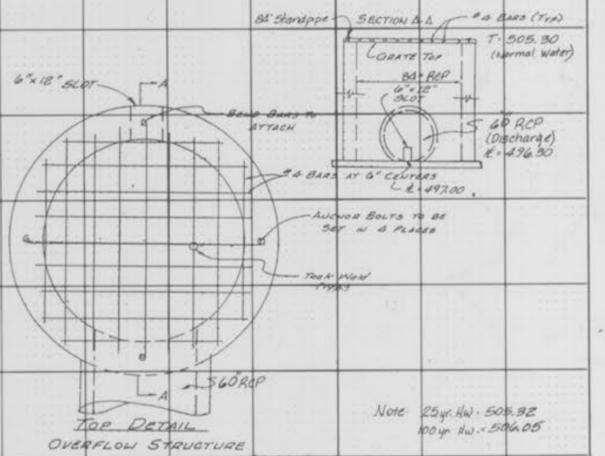


Note: 25 yr. HW - 506.92  
100 yr. HW - 506.05

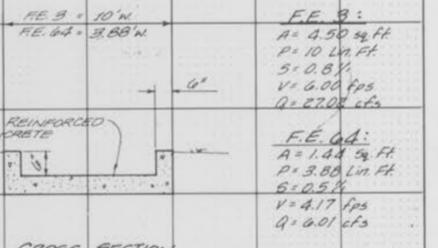

FE 3:  
A = 4.50 sq. ft.  
P = 10 Lin. ft.  
S = 0.8%  
V = 6.00 fps  
Q = 2702 cfs

FE 4:  
A = 1.44 sq. ft.  
P = 3.85 Lin. ft.  
S = 0.5%  
V = 4.17 fps  
Q = 601 cfs

NOTE: A.B. = "As-Built"

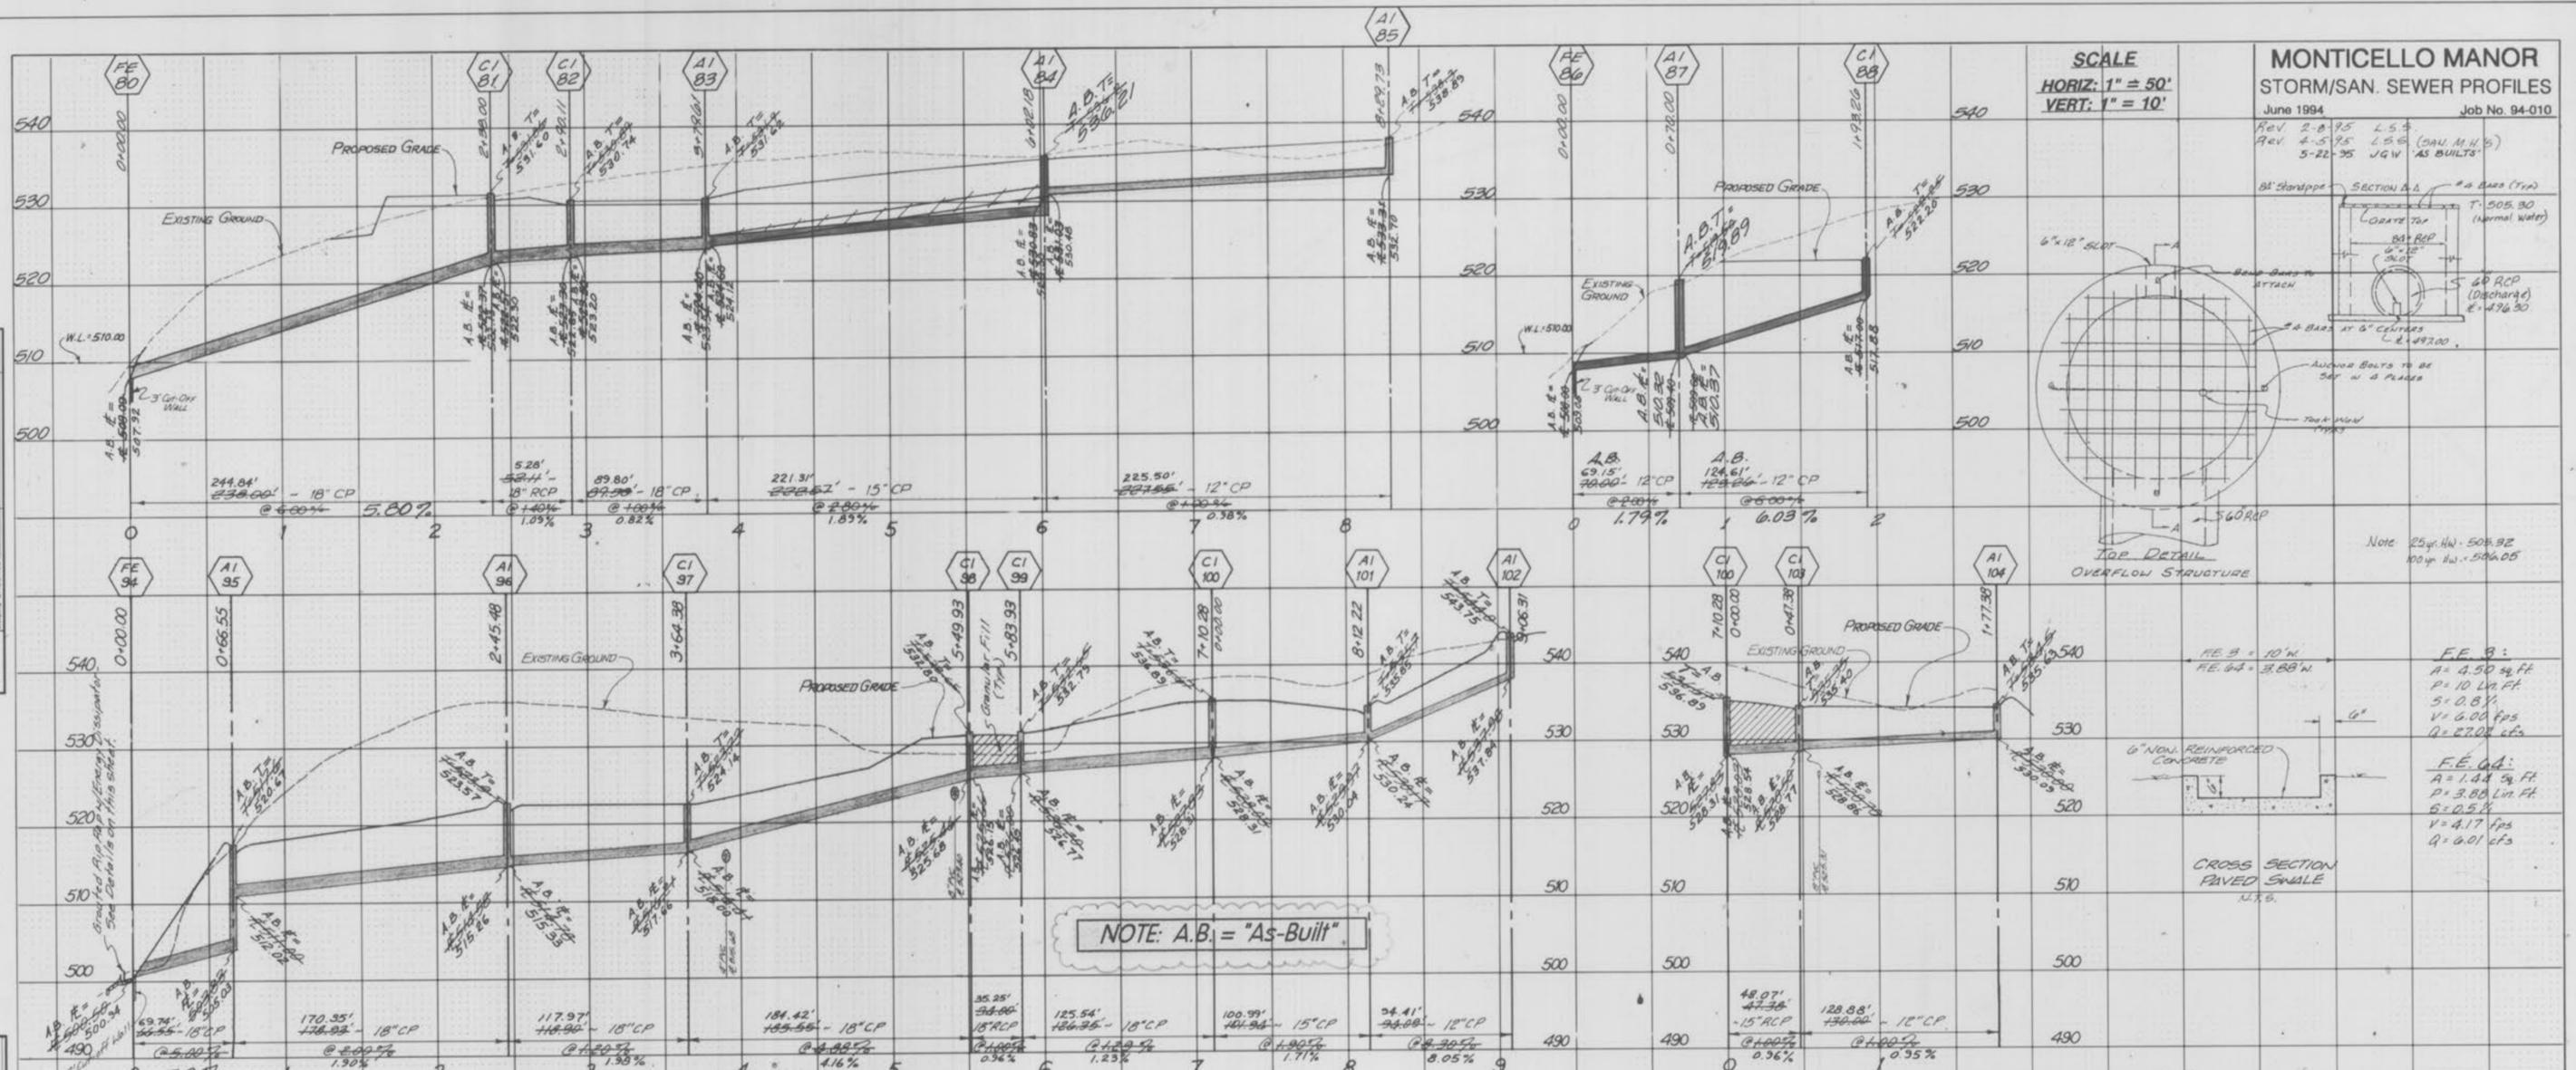

DATE: \_\_\_\_\_ BY: \_\_\_\_\_

FINAL SURVEY PLOTTED \_\_\_\_\_

NOTE BOOK NO. \_\_\_\_\_





AREAS CHECKED \_\_\_\_\_

DATE: \_\_\_\_\_ BY: \_\_\_\_\_

ORIGINAL SURVEY PLOTTED \_\_\_\_\_

NOTE BOOK NO. \_\_\_\_\_

AREAS CHECKED \_\_\_\_\_

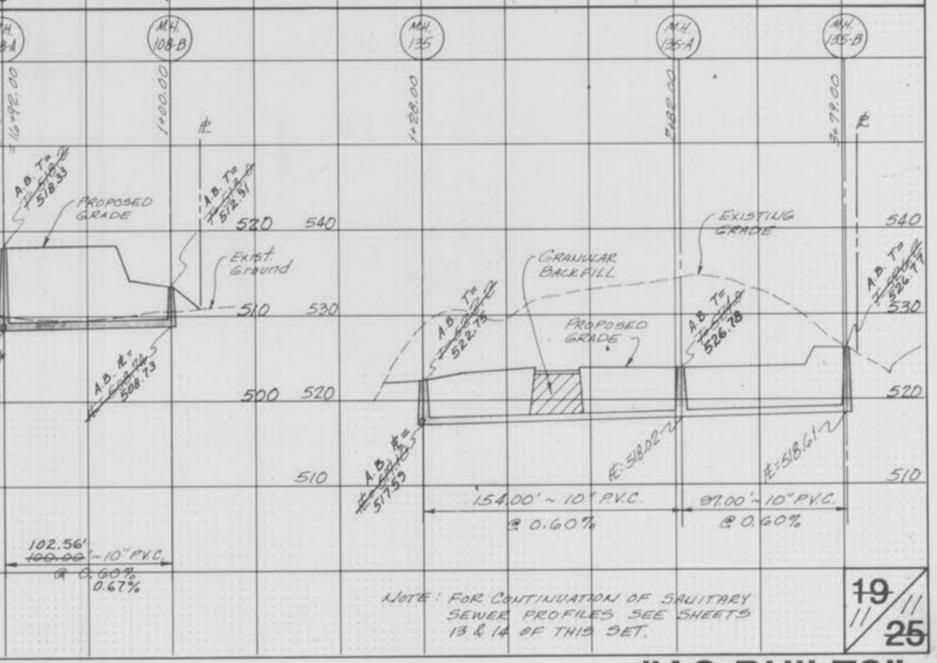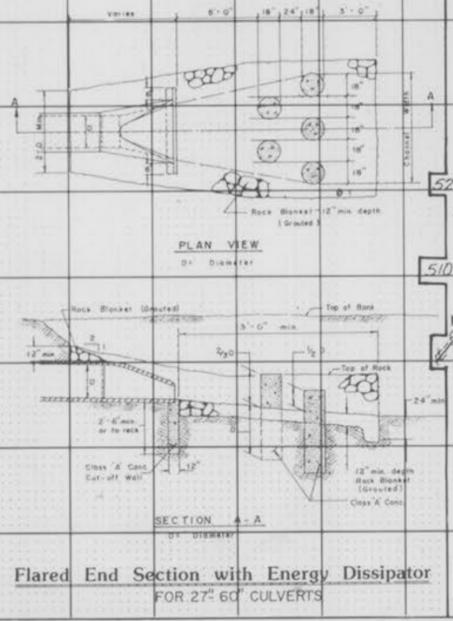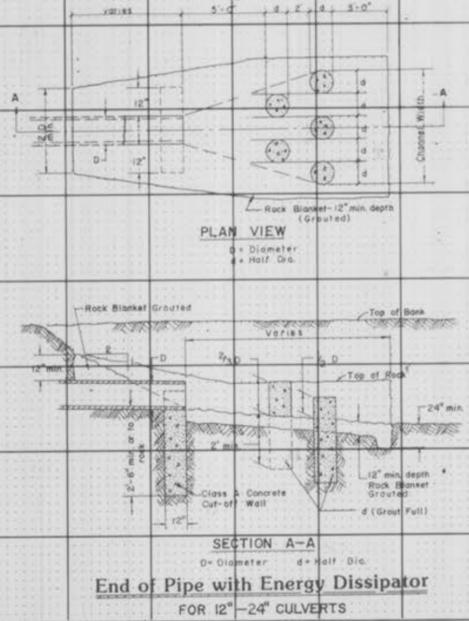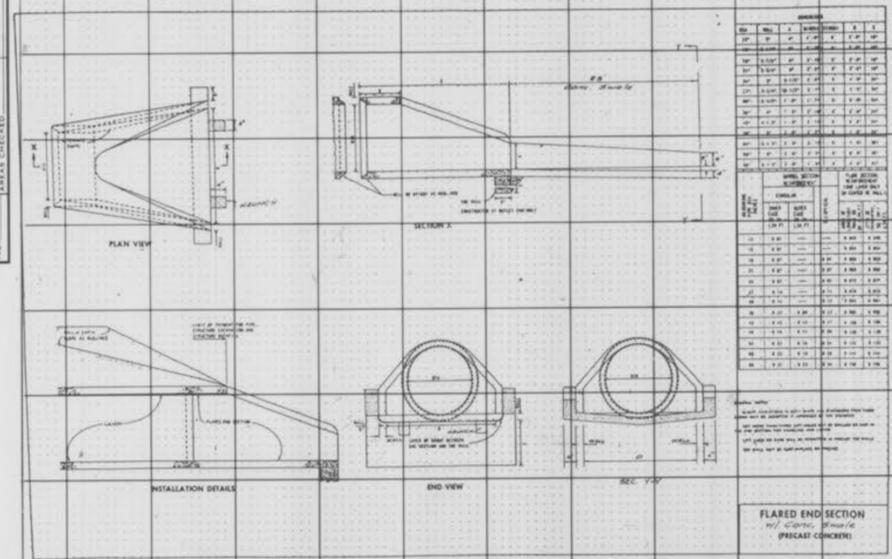

NOTE: FOR CONTINUATION OF SANITARY SEWER PROFILES SEE SHEETS 13 & 14 OF THIS SET.