

City of O'Fallon

## General Notes

1. Gas, water and other underground utilities shall not conflict with the depth or horizontal location of existing and proposed sanitary and storm sewers, including house laterals.
  2. Underground utilities have been plotted from available information and, therefore, their locations must be considered approximate only. The verification of the location of all underground utilities, either shown or not shown on these plans, shall be the responsibility of the contractor, and shall be located prior to grading or construction of improvements.
  3. Polyvinyl Chloride (PVC) shall conform to the requirements of ASTM D-3034 Standard Specifications for the PSM Polyvinyl Chloride (PVC) Sewer Pipe and Fittings, SDR-35.
  4. Storm sewers 18" in diameter or smaller shall be ASTM C-14.
  5. Storm sewers 21" in diameter or larger shall be ASTM C-76, Class II.
  6. All storm sewer pipe under pavement, regardless of size, shall be reinforced concrete pipe (ASTM C-76, Class III) unless noted otherwise on the plans.
  7. Corrugated metal pipe shall conform to the standard specifications for corrugated culvert pipe M-36, A.A.S.H.O. See plans for gauge.
  8. All filled places under buildings, proposed sanitary and storm sewer lines, and/or paved areas including trench backfills shall be compacted to 90% of maximum density as determined by the "Modified A.A.S.H.O. T-180 Compaction Test" (ASTM D-1557) unless otherwise specified by the local governing authority specifications. All tests will be verified by a Soils Engineer.
  9. All earthen filled places within State, County, or City rights (Highways) shall be compacted to 95% of maximum density as determined by the "Standard Proctor Test A.S.T.M. D-693" (ASTM D-693) unless otherwise specified by local governing authority specifications. All tests will be verified by a Soils Engineer.
  10. All storm and sanitary trench backfills shall be water jetted. Granular fill will be used under paved areas.
  11. Easements shall be provided for storm sewers, sanitary sewers, and all utilities on the record plat. See record plat for location and size of easements. This does not apply to house laterals.
  12. No area shall be cleared without the permission of the developer.
  13. All grade shall be within 0.2 feet (more or less) of those shown on the grading plan.
  14. No slope shall be greater than 3:1 and shall be either sodded or seeded and mulched.
  15. Hazard markers will consist of three (3) standard specification, "Manual on Uniform Traffic Control Devices", end of roadway markers mounted on two (2) pound "U" channel sign post. Each marker shall consist of an eighteen (18) inch diamond reflectorized red panel. The bottom of each panel shall be mounted a minimum of four (4) feet above the elevation of the pavement surface.
  16. All manhole and curb inlet tops built without elevations furnished by the Engineer will be the responsibility of the sewer contractor. At the time of construction stake-out of the sewer lines, all curb and grate inlets will be face staked. If normal face stakes fall in line with sewer construction, the Engineer will set these stakes on a double offset. It shall be the responsibility of the sewer contractor to preserve all face stakes from destruction.
  17. All standard street curb inlets to have front of inlet 2 feet behind curb.
  18. The minimum vertical distance from the low point of the basement to the flowline of a sanitary sewer at the corresponding house connection shall not be less than the diameter of the sanitary sewer plus a vertical distance of not less than 2½ feet.
  19. Water lines, valves, sleeves, meters and etc. shall meet all specifications and installation requirements of the local governing authority.
  20. All cast iron pipe for water mains shall conform to A.W.W.A. specification C-106 and/or C-108. The cast iron fittings shall conform to A.W.W.A. specification C-110. All rubber gasket joints for water cast iron pressure pipe and fittings shall conform to A.W.W.A. specification C-111.
  21. All water hydrants and valves shall be cast iron and installed in accordance with plans and details.
  22. All sanitary and storm sewers shall meet all specifications and installation requirements of the local governing authority.
  23. All PVC water pipe shall have a minimum pressure rating of PR-200 or SDR-21.
  24. All PVC sanitary sewer pipe shall be DR-35 or equal with crushed stone bedding uniformly graded between ¼" and ½" size. This bedding shall extend from 6" below the pipe to 8" inches above the top of the pipe.
  25. All grading on Missouri State Highway Right-of-Way shall be seeded and mulched and all disturbed Right-of-Way Markers shall be reset at the completion of grading.
  26. All streets must meet the specifications and installation requirements of the City of O' Fallon.
  27. All sanitary manhole tops shall be set 0.2' higher than the proposed ground except in pavement areas or as otherwise noted.
  28. All sanitary manholes shall have a 31 mil. thick coat of coal-tar pitch waterproofing.
  29. All sanitary service lines shall have a 6" diameter for Multi-family and a 4" diameter for Single-family developments.
  30. Manhole frame and cover shall be Clay and Bailey No. 3008 for Neenah R-1736 or Deeter 1314 or approved equal.
  31. The Duckett Creek Sewer District shall be notified at least 48 hours prior to construction of sanitary sewers for coordination and inspection.
  32. All existing improvements damaged or destroyed during construction shall be replaced or repaired in kind.
  33. Brick shall not be used on manholes.
  34. This tract is served by:

## Benchmark

ORF TRI. STA., 3.5 MI. S.W. OF O'FALLON, 0.5  
MI. N.E. OF DARDENNE CHURCH, IN CONC.  
POST-U.S.C.&G.S. STD. DISK STAMPED "ORF 1931


Elevation  
667.596

85. All sanitary sewer manholes shall be waterproofed on the exterior in accordance with Missouri Department of Natural Resources specification 10-CSR-8.120 (7)(E).



A hand-drawn map showing the locations of four settlements labeled VILLAGE 'A', VILLAGE 'B', VILLAGE 'C', and VILLAGE 'D'. The settlements are represented by shaded areas. A central area is labeled 'SITE'. A river system is depicted with thick lines representing the main channels and smaller lines representing tributaries. The river flows generally from the bottom left towards the top right. Labels include 'RIVER' at the top center, 'WATER' at the top left, and 'LAND' at the top right.

## Location Map

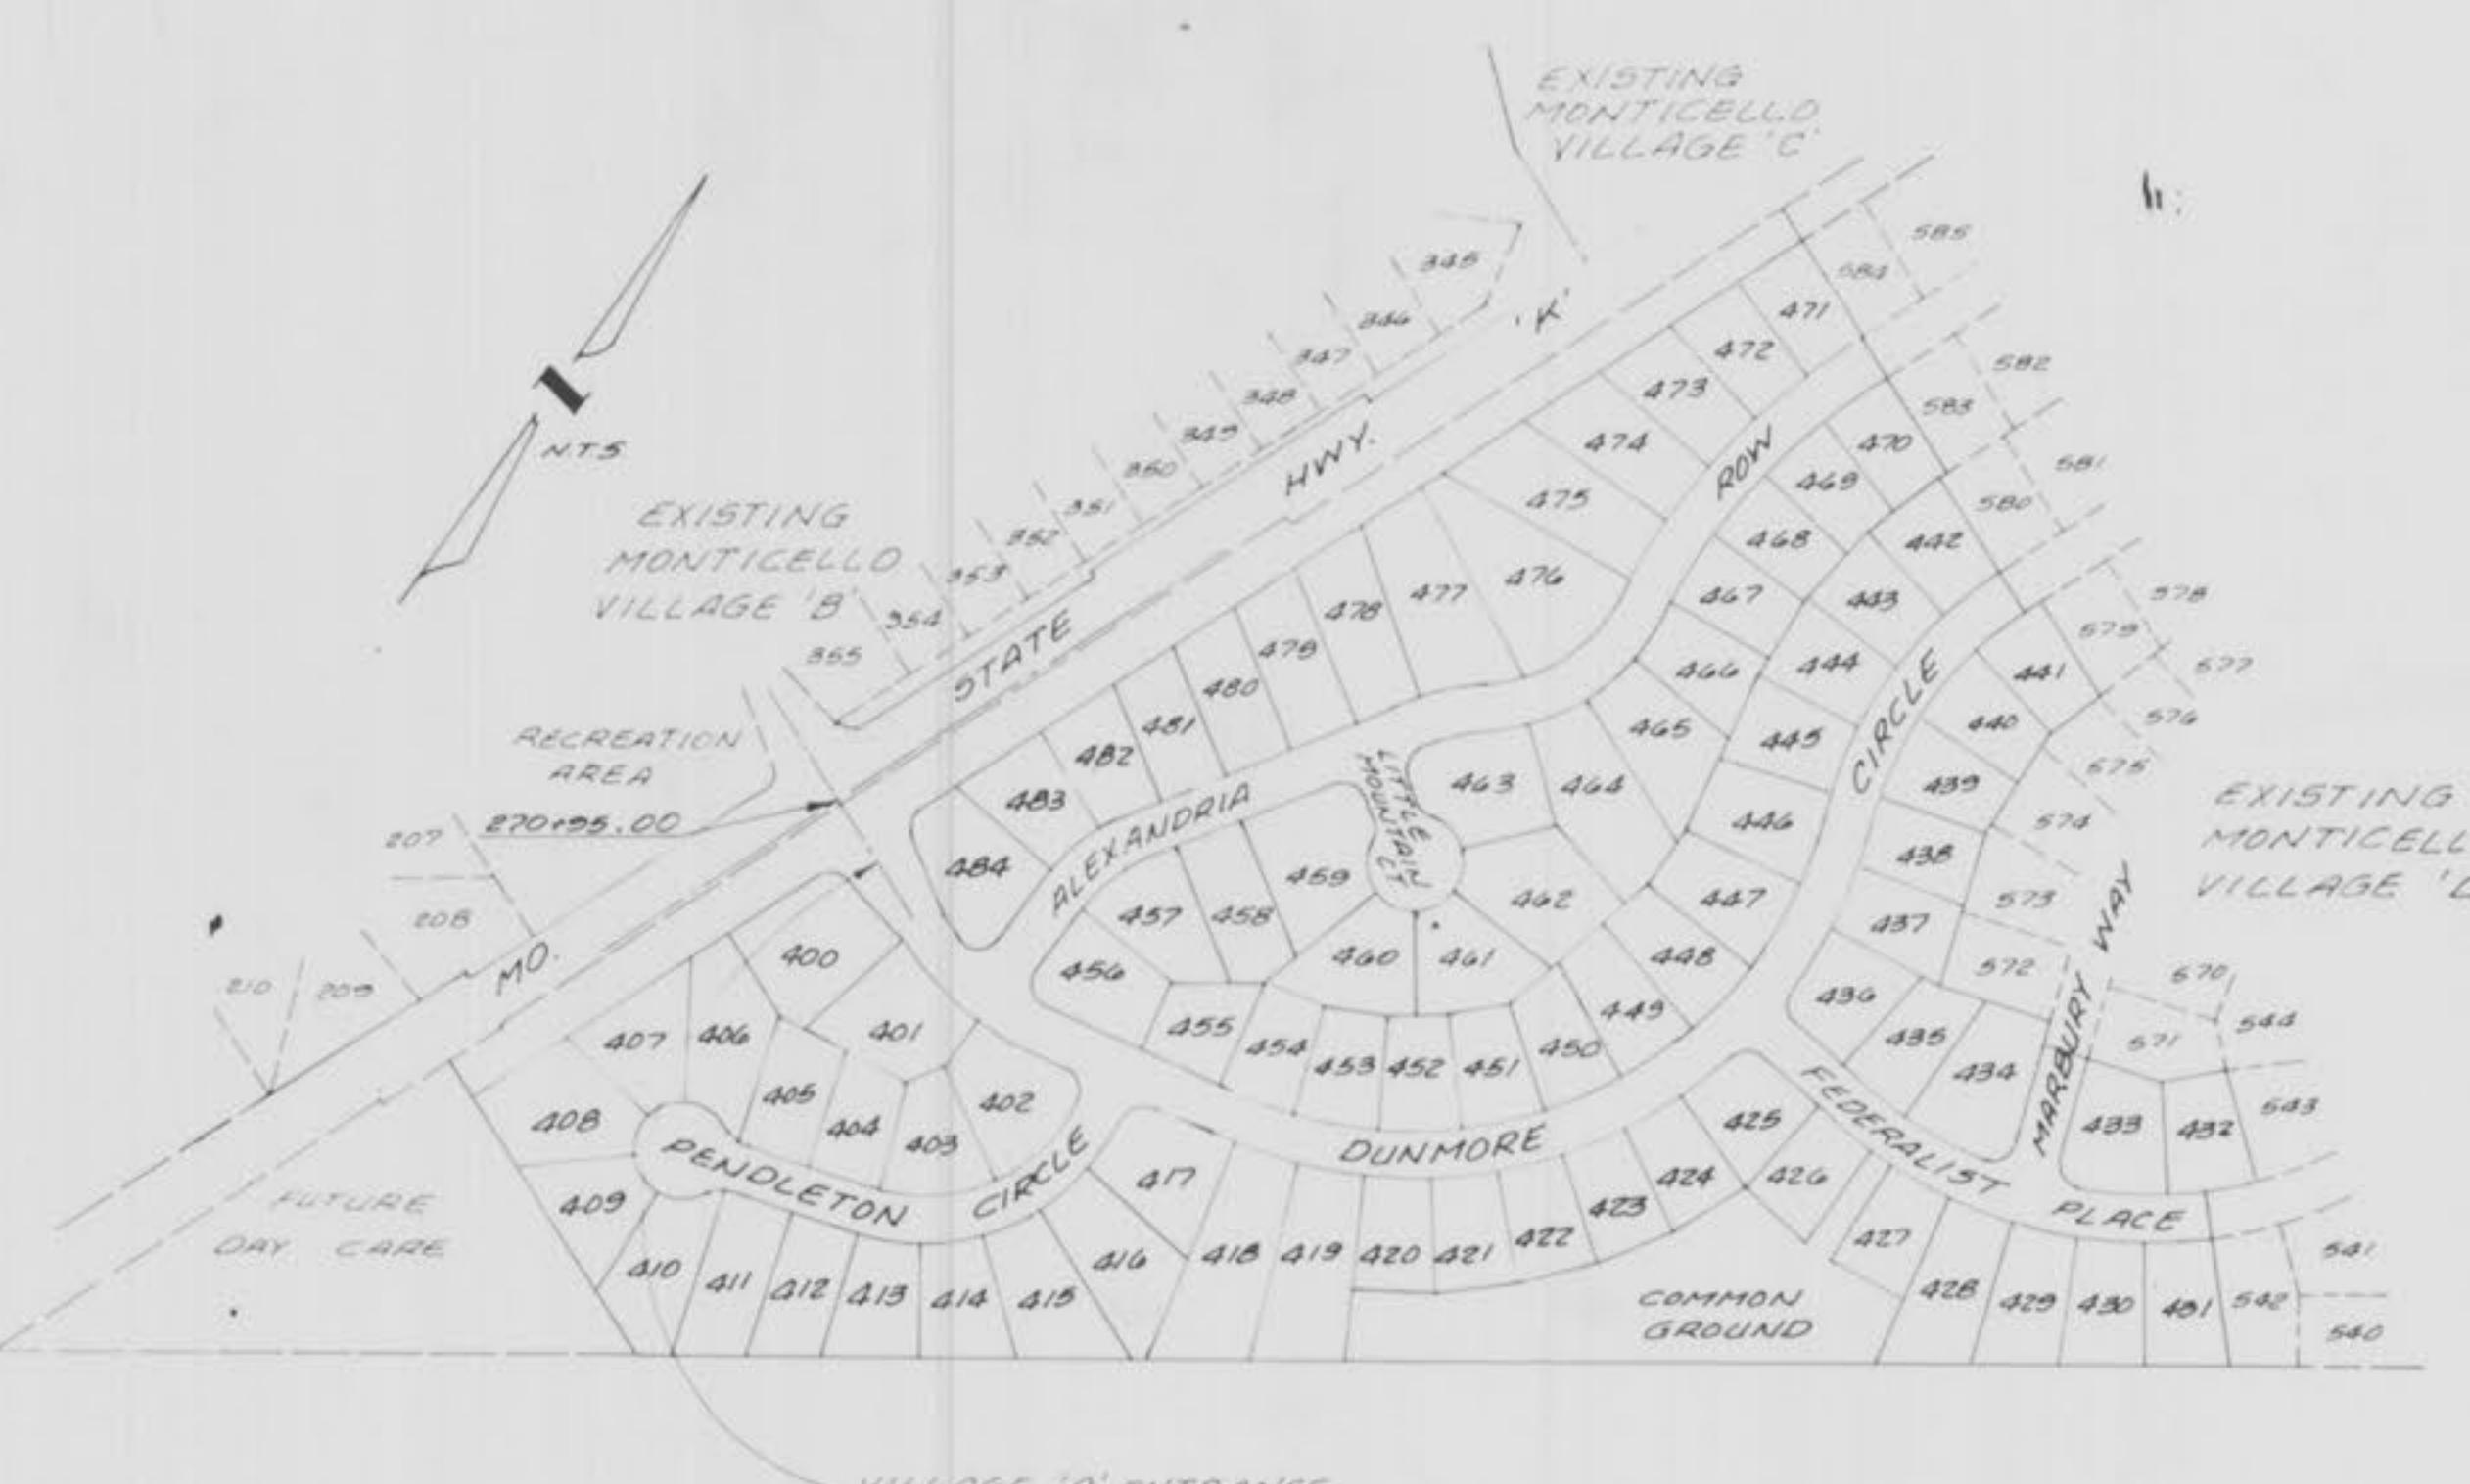

## Key Map

This is to certify to Duckett Creek Sewer Dist.  
that these "As-Built" San. / Storm plans are  
based on actual field surveys conducted  
during June, 1992 and the results are  
shown here on.

by Pickett Ray & Silver

Delmar F. Vincent  
MO R.L.S. No 1869

Date

ENGINEERS AUTHENTICATION		<b>PICKETT RAY &amp; SILVER</b>	
<p>The responsibility for all drawing engineering work in this project is hereby assumed by the set of plans authenticated by the date signature and any subsequent changes. Responsibility is also assumed for all other engineering plans involved in the project and <b>EXCLUSIVELY</b> excludes revisions after this date unless reauthenticated.</p>		<p>Civil Engineers Planners Land Surveyors</p> <p>13 Mid Rivers Mall Dr St. Peters MO 63376 441-1211 279-1211</p>	
 <p>PICKETT, RAY &amp; SILVER INC</p>		<p><b>PREPARED FOR:</b>  <b>WHITTAKER HOMES</b>      <b>Phone:</b>  <b>(314) 279-1511</b>  <b>355 Mid Rivers Mall Drive</b>  <b>St. Peters MO. 63376</b> </p>	
DRAWN CHECKED	DWD JC	DATE DATE	Feb., 1992 Feb., 1992
FIELD BOOK	416K	PROJECT • JOB ORDER •	85-064U 24642
		17 NOV 1992	

PICKETT RAY & SILVER

Civil Engineers  
Planners  
and Surveyors

13 Mid Rivers Mall Dr  
Peters, MO 63376

**REARED FOR:** **Phone:**  
**WHITTAKER HOMES** **(314) 279-1511**  
**355 Mid Rivers Mall Drive**  
**St. Peters MO 63376**

AWN	DWD	DATE	Feb., 1992	17
ECKED	JC	DATE	Feb., 1992	
LD	PROJECT #	85-064 U		
OK	JOB ORDER #	24642		
AIGK				

City of O'Fallon, Mo.

City of O'Fallon, Mo.

## FLAT PLANS

## MONTICELLO - VILLAGE A

February, 1992

85-064U

Rev. 3/5/92 per Duckett Creek, DWD  
Rev. 3/10/92 per City of O'Fallon, DWD  
Rev. 3/12/92 per City of O'Fallon, DWD  
8-17-92 As-Built



FLAT PLANS  
MONTICELLO - VILLAGE A


February, 1992

85-0644

Rev. 3-8-92 per Duckett Creek, DWD  
Rev. 3-12-92 per City of O'Fallon, DWD  
Rev. 3-24-92, Conc Walk added, DWD  
8-17-92 As-Built  
10-29-92 As-Builts (MHs 400-402)




FINAL SURVEY	SURVEYED
DATE	BY
NOTEBOOK NO.	PLOTTED
AREAS CHECKED	BOOK DATE

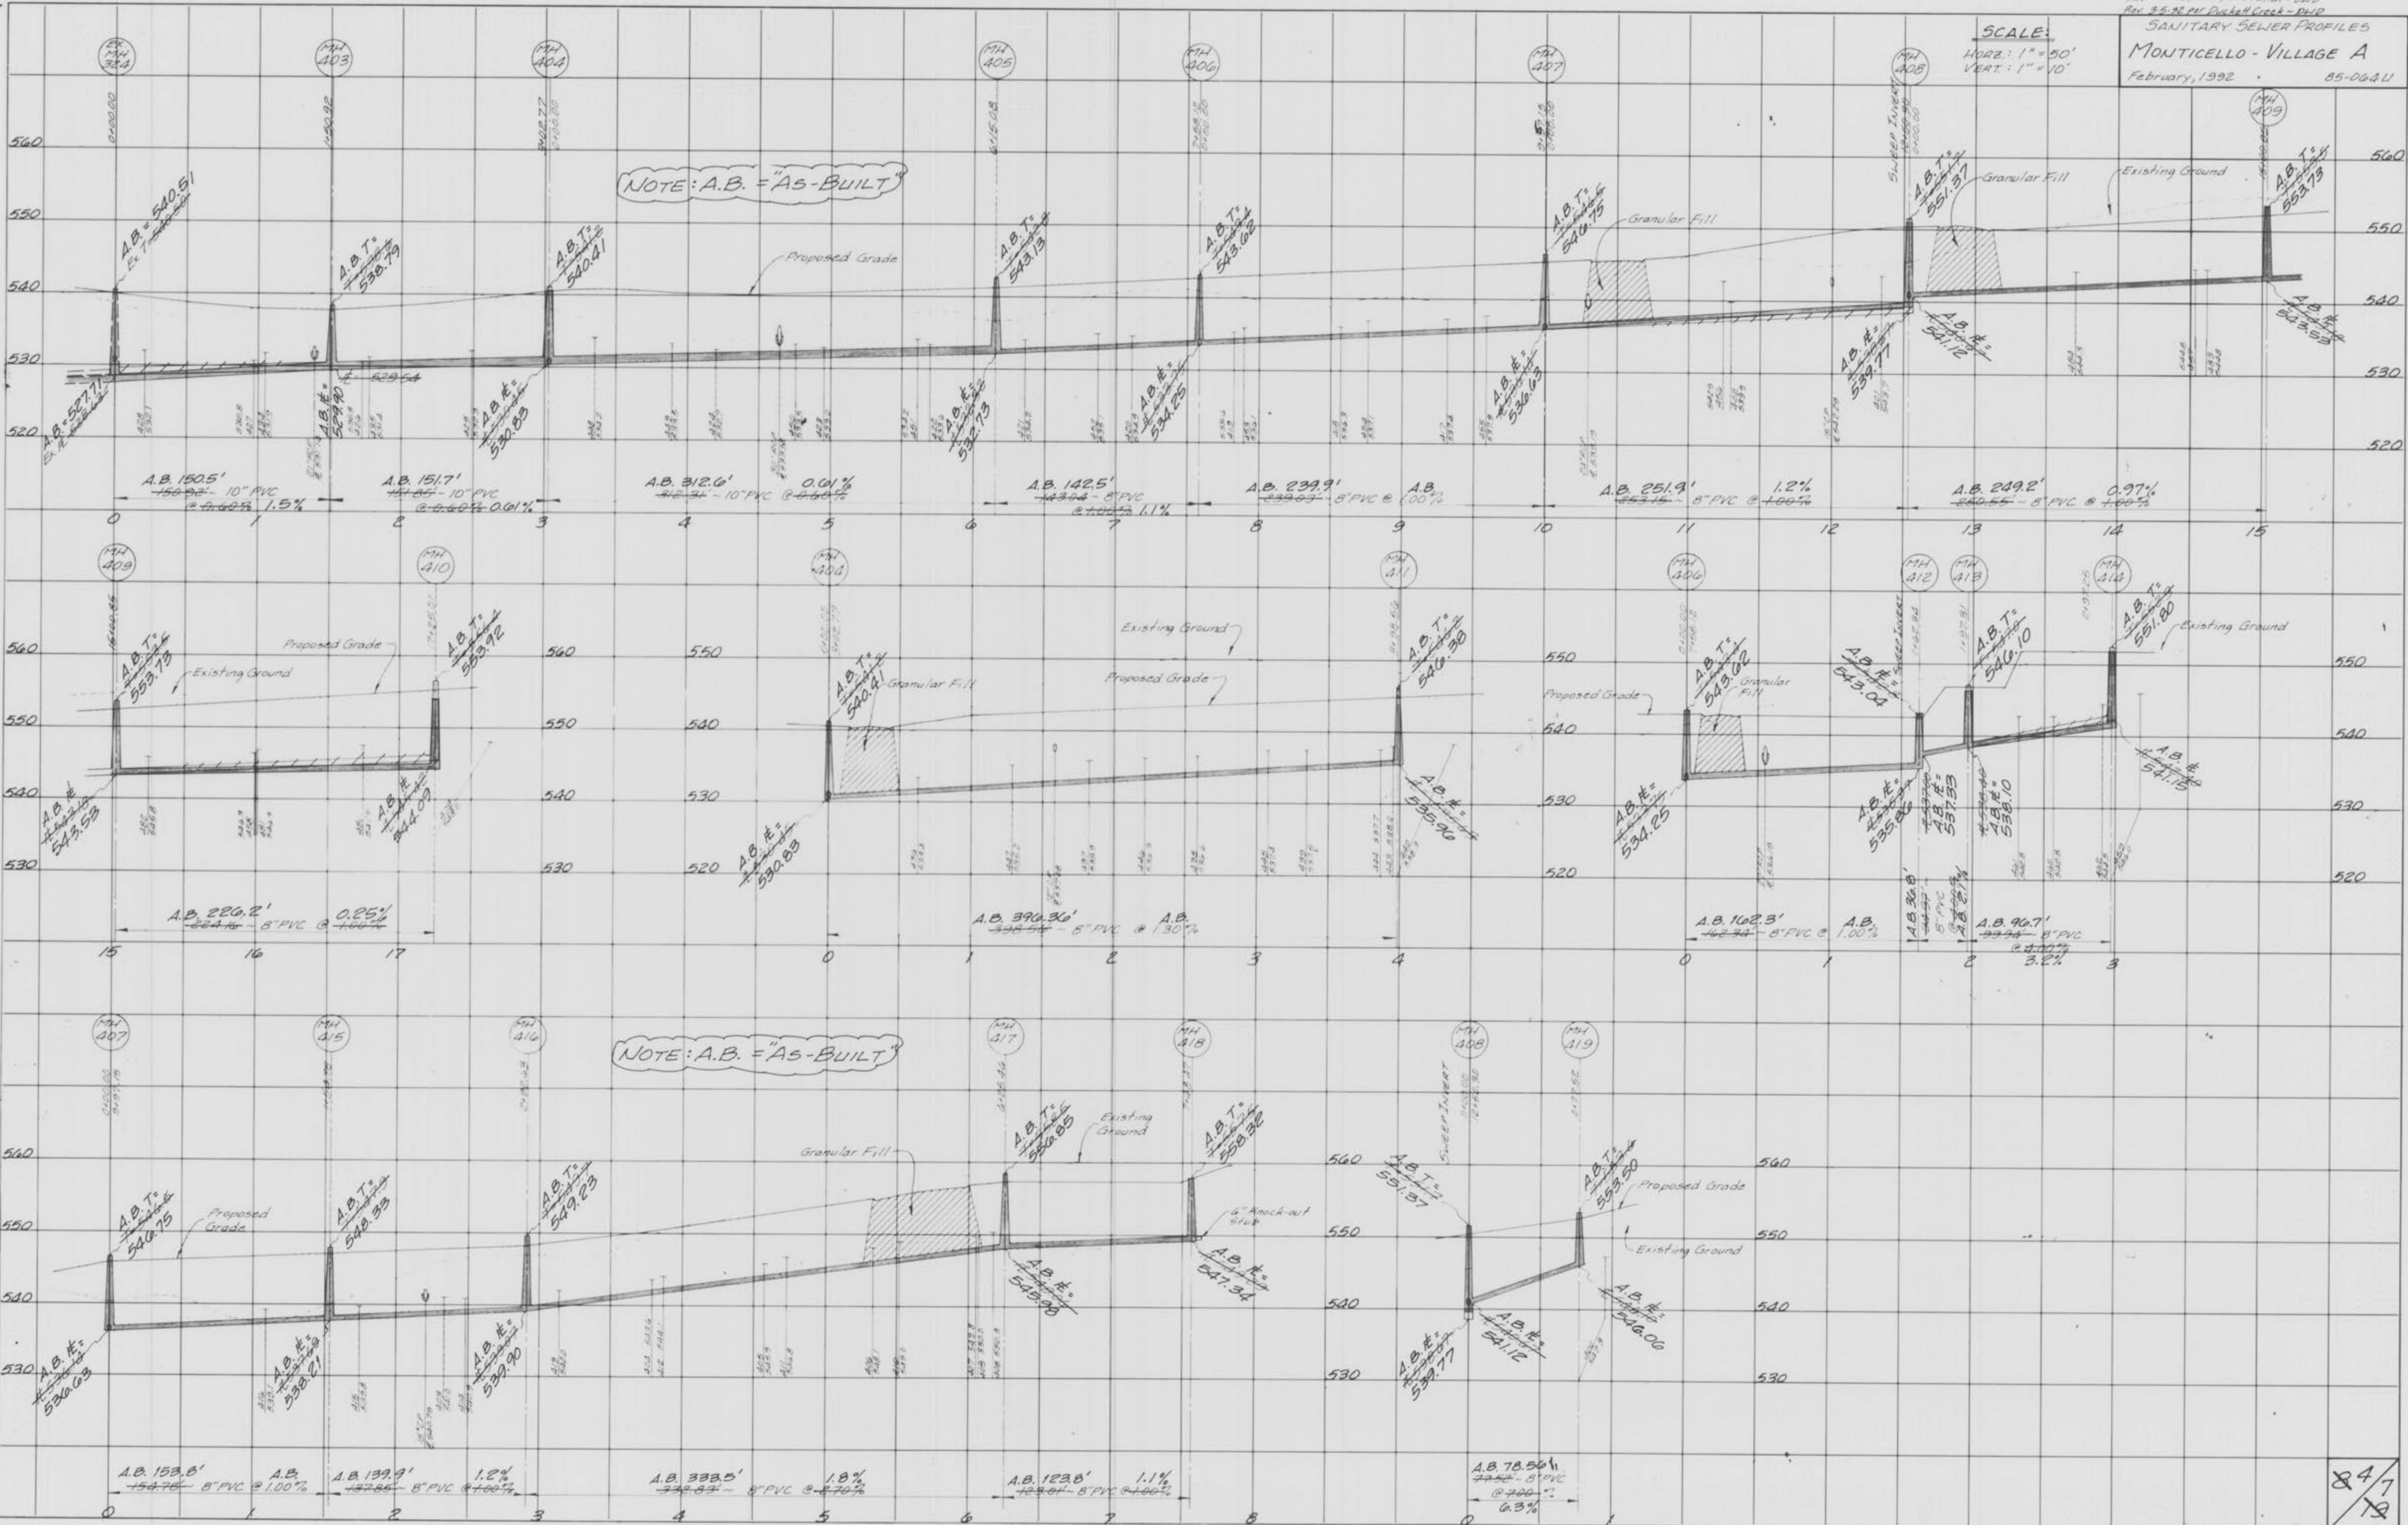





WATER MAIN LAYOUT  
MONTICELLO - VILLAGE A  
February, 1992 85-064U  
Rev. 8/18/92 Per Cottleville Fire Prot. Dist., DWD  
Rev. 8/6/92 per Water Dist. #2, DWD  
8-17-92 As-Built

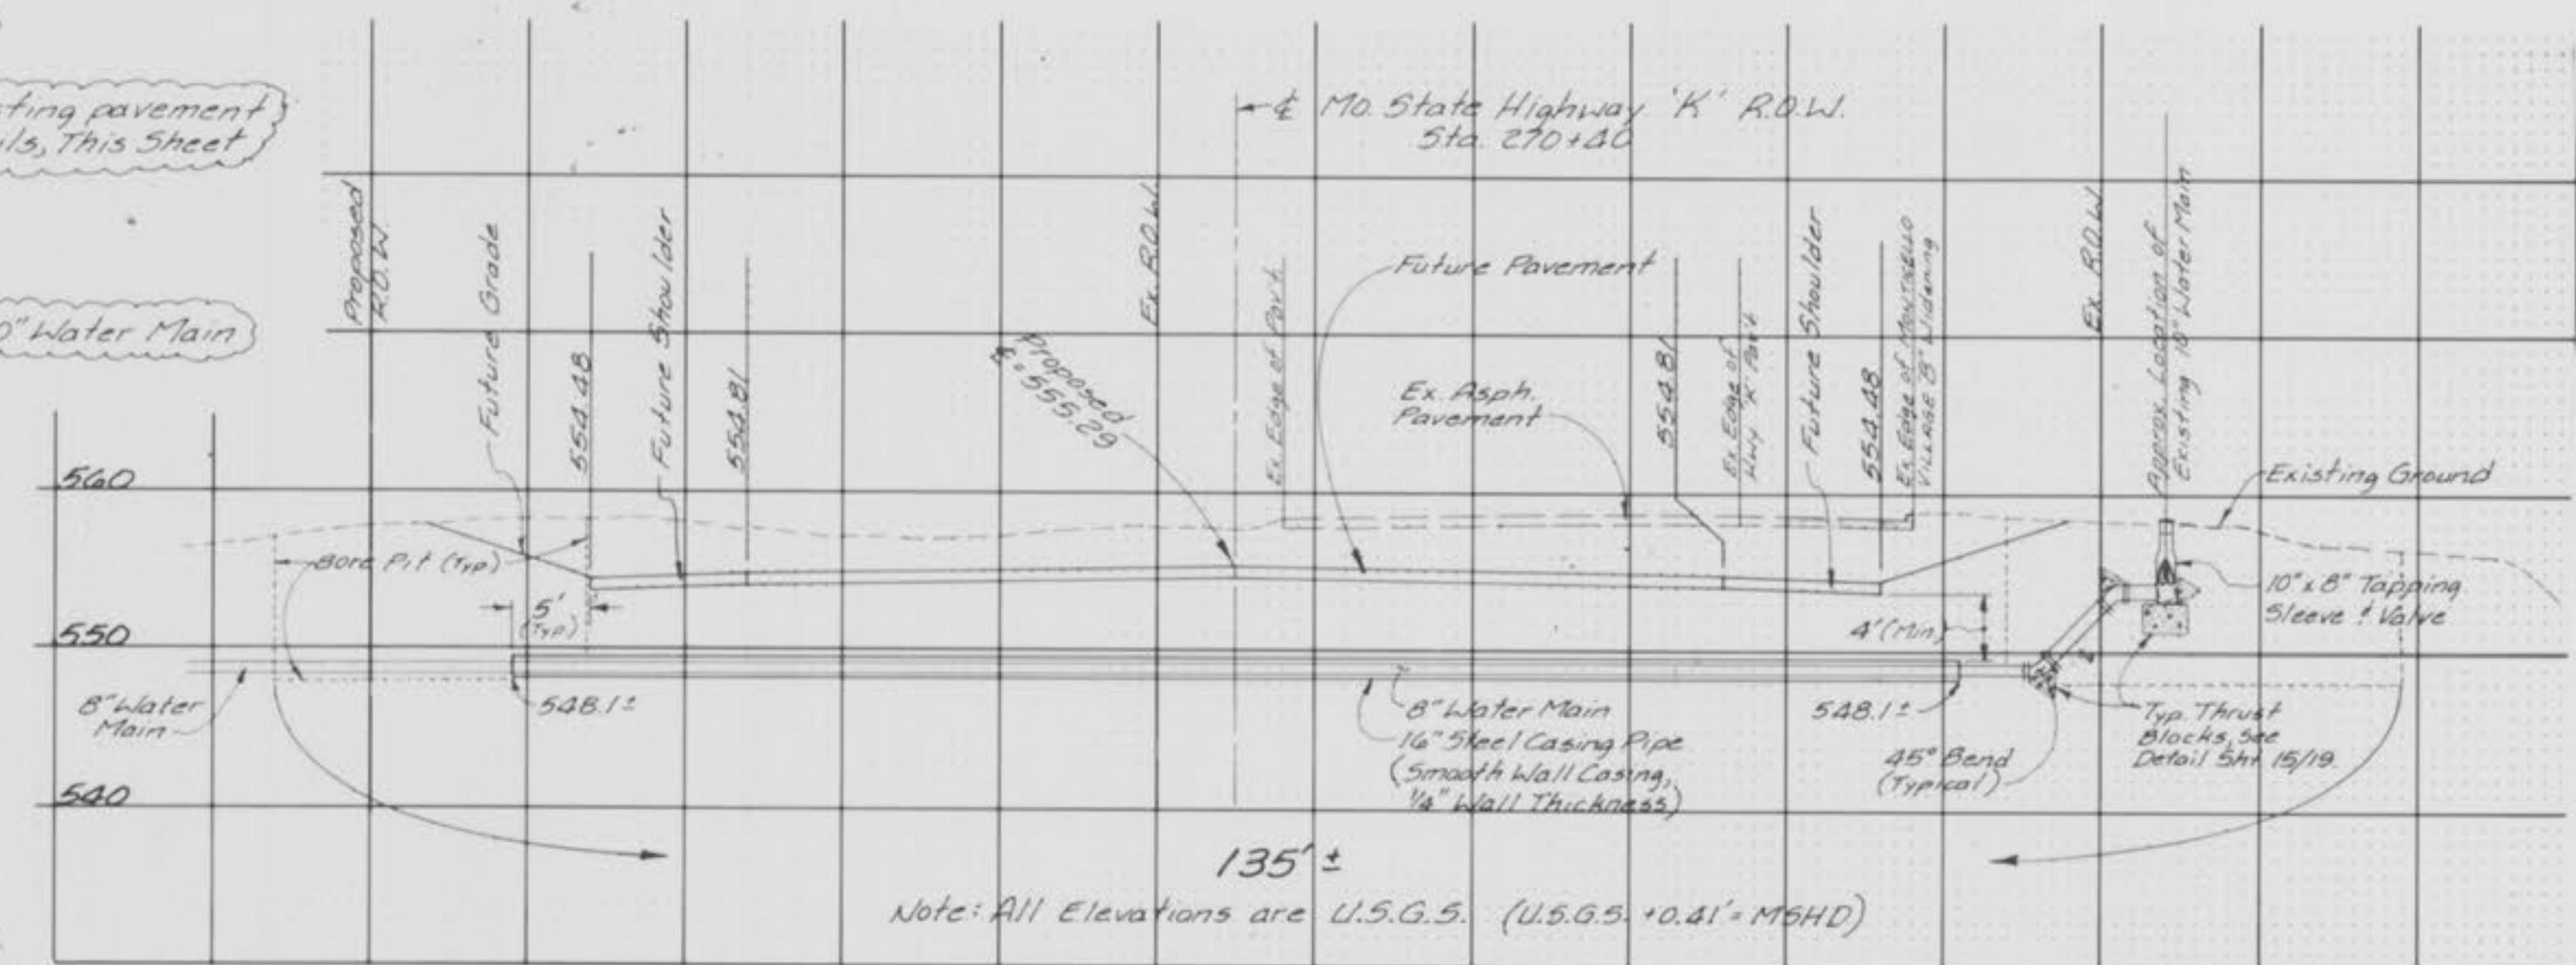

SEE SHEET 14 OF 19

"AS-BUILTS" FOR WATER MAIN CONSTRUCTION ONLY

Monticello Village A  
As-Builts

6/1  
7/1  
8/1

Village A

