

## Index

Sheet	Description
1	COVER SHEET
2	PLAN & PROFILES
3	DETAIL SHEET

## City of O'Fallon

### General Notes

- Gas, water and other underground utilities shall not conflict with the depth or horizontal locations of existing and proposed sanitary and storm sewers, including house laterals.
- Underground utilities have been plotted from available information and, therefore, their locations must be considered approximate only. The verification of the location of all underground utilities, either shown or not shown on these plans, shall be the responsibility of the contractor, and shall be located prior to grading or construction of improvements.
- Polyvinyl Chloride (PVC) shall conform to the requirements of ASTM D-3034 Standard Specifications for the PVC Polyvinyl Chloride (PVC) Sewer Pipe and Fittings, SDR-15.
- Storm sewers 18" in diameter or smaller shall be ASTM C-14.
- Storm sewers 21" in diameter or larger shall be ASTM C-76, Class II.
- All storm sewer pipe under pavement, regardless of size, shall be reinforced concrete pipe (ASTM C-76, Class III) unless noted otherwise on the plans.
- Corrugated metal pipe shall conform to the standard specifications for corrugated culvert pipe M-36, A.A.S.H.O. See plans for gauge.
- All filled places under buildings, proposed sanitary and storm sewer lines, and/or paved areas including trench backfills shall be compacted to 90% of maximum density as determined by the "Modified A.A.S.H.O. T-180 Compaction Test" (ASTM D-1557) unless otherwise specified by the local governing authority specifications. All tests will be verified by a Soils Engineer.
- All earthen filled places within State, County, or City made highways shall be compacted to 90% of maximum density as determined by the "Standard Proctor Test A.A.S.H.O. T-99" (ASTM D-698) unless otherwise specified by local governing authority specifications. All tests will be verified by a Soils Engineer.
- All storm and sanitary trench backfills shall be water-jetted. Granular fill will be used under paved areas.
- Easements shall be provided for storm sewers, sanitary sewers, and all utilities on the record plat. See record plat for location and size of easements. This does not apply to house laterals.
- No area shall be cleared without the permission of the developer.
- All grade shall be within 0.2 feet (more or less) of those shown on the grading plan.
- No slope shall be greater than 3:1 and shall be either sodded or seeded and mulched.
- Hazard markers will consist of three (3) standard specification, "Manual on Uniform Traffic Control Devices", end of roadway markers mounted on two (2) pound 10" channel sign post. Each marker shall consist of an eighteen (18) inch diamond reflectorized red panel. The bottom of each panel shall be mounted a minimum of four (4) feet above the elevation of the pavement surface.
- All manhole and curb inlet tops built without elevations furnished by the Engineer will be the responsibility of the sewer contractor. At the time of construction stake-out of the sewer lines, all curb and grate inlets will be face staked. If normal face stakes fall in line with sewer construction, the Engineer will set these stakes on a double offset. It shall be the responsibility of the sewer contractor to preserve all face stakes from destruction.
- All standard street curb inlets to have front of inlet 2 feet behind curb.
- The minimum vertical distance from the low point of the basement to the flowline of a sanitary sewer at the corresponding house connection shall not be less than the diameter of the sanitary sewer plus a vertical distance of not less than 2-1/2 feet.
- Water lines, valves, sleeves, meters and etc., shall meet all specifications and installation requirements of the local governing authority.
- All cast iron pipe for water mains shall conform to A.W.W.A. specification C-106 and/or C-108. The cast iron fittings shall conform to A.W.W.A. specification C-110. All rubber gasket joints for water cast iron pressure pipe and fittings shall conform to A.W.W.A. specification C-111.
- All water hydrants and valves shall be cast iron and installed in accordance with plans and details.
- All sanitary and storm sewers shall meet all specifications and installation requirements of the local governing authority.
- All PVC water pipe shall have a minimum pressure rating of PR-200 or SDR-21.
- All ~~sewer~~ service lines shall be 6" diameter for multi-family and a 4" diameter for single-family developments.
- All grading on Missouri State Highway Right-of-Way shall be seeded and mulched and all disturbed Right-of-Way markers shall be reset at the completion of grading.
- All streets must meet the specifications and installation requirements of the City of O'Fallon.
- All ~~sewer~~ service lines shall be 6" diameter for multi-family and a 4" diameter for single-family developments.
- All sanitary service lines shall have a 6" diameter for multi-family and a 4" diameter for single-family developments.
- The Duckett Creek Sewer District shall be notified at least 48 hours prior to construction of sanitary sewers for coordination and inspection.
- All existing improvements damaged or destroyed during construction shall be replaced or repaired in kind.
- Brick shall not be used on manholes.
- ~~Contractor shall maintain 30' clear space between utility poles and structures.~~
- This tract is served by:


- Cuivre River Electric Co
- Cottleville Fire Protection District
- Southwestern Bell Telephone
- St. Charles Gas Company
- St. Charles Co. Water District No. 2
- Duckett Creek Sewer District



# MONTICELLO

## VILLAGE C

### OFFSITE SANITARY SEWER "AS-BUILTS"

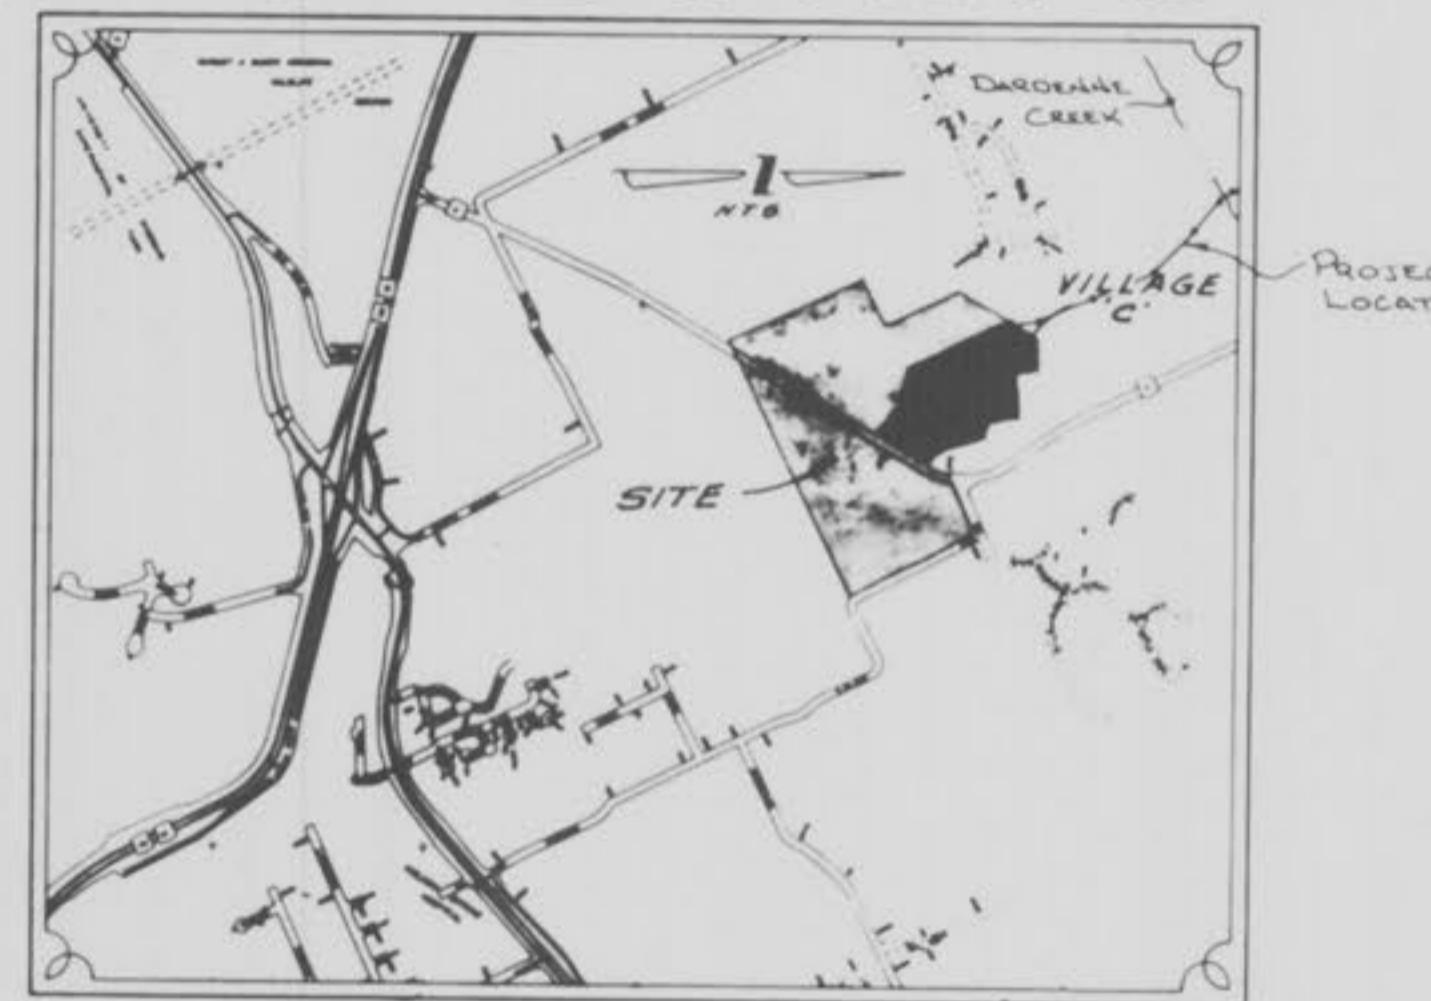

Location Map



Key Map



This is to certify that the as-constructed elevations, locations and distances shown hereon are correct and were taken in the field during December, 1989.

Max Reg. L.S. # 1506

### Legend

1	Sanitary Sewer (Proposed)	C.I.	Curb Inlet
2	Sanitary Sewer (Existing)	D.C.I.	Double Curb Inlet
3	Storm Sewer (Proposed)	G.I.	Grate Inlet
4	Storm Sewer (Existing)	A.I.	Area Inlet
5	Water Line & Size	D.A.I.	Double Area Inlet
6	Tee & Valve	C.C.	Concrete Collar
7	Hydrant	F.E.	Flared End Section
8	Cap	E.P.	End Pipe
9	Lot or Building Number	E.D.	Permeable Dissipator
10	Existing Fence Line	M.H.	Manhole
11	Street Sign	C.P.	Concrete Pipe
12	Direction of Proposed Residence	R.C.P.	Reinforced Concrete Pipe
13	Existing Contour	C.I.P.	Corrugated Metal Pipe
14	Proposed Contour	P.I.C.	Cast Iron Pipe
15	Striped Rip-Rap	V.C.P.	Polyvinyl Chloride
16	End of lateral	V.C.P.	Vitrified Clay Pipe
17	Asphalt Pavement	C.O.	Clean Out
18	Concrete Pavement	V.T.	Vent Trap
19	Storm/Sanitary Structure		
20	Test Hole		
21	Power Pole		
22	Light Standard		

PROPERTY OF  
CITY OF O'FALLON  
BUILDING DEPARTMENT

"AS-BUILTS" 1-26-90, DWG

### PICKETT RAY & SILVER

Civil Engineers  
Planners  
Land Surveyors

33 Mid Rivers Mall Dr.  
St. Peters, MO 63376  
441-1211 278-1211

PREPARED FOR:  
WHITTAKER HOMES (314) 279-1511  
355 Mid Rivers Mall Drive  
St. Peters, MO, 63376

DRAWN JWE-00 DATE 12-1988  
CHECKED \_\_\_\_\_ DATE \_\_\_\_\_  
FIELD BOOK 416A PROJECT # 65-064P  
JOB ORDER # 2732

1/2

SANITARY  
MONTICELLO OFF-SITE  
City of O'Fallon, Mo.

"AS-BUILTS" 1-26-89 PWD

