




Locator Map

O'FALLON SPORTS PARK STREAM STABILIZATION TOPOGRAPHIC AS-BUILT SURVEY

A TRACT OF LAND IN
FRACTIONAL SECTION 16,
TOWNSHIP 46 NORTH, RANGE 3 EAST
OF THE FIFTH PRINCIPAL MERIDIAN,
CITY OF O'FALLON
ST. CHARLES COUNTY, MISSOURI

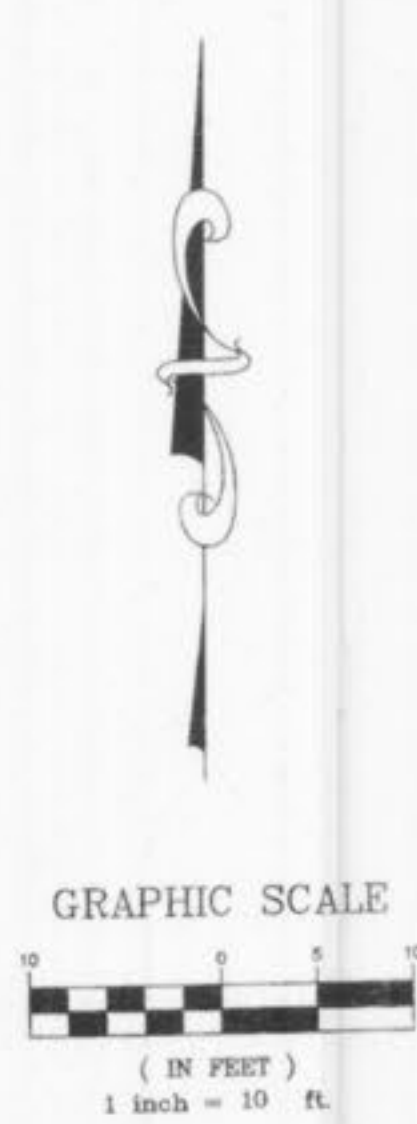

PREPARED FOR:
SCI ENGINEERING, INC.
130 POINT WEST BOULEVARD
ST. CHARLES, MISSOURI 63303

DISCLAIMER OF RESPONSIBILITY
I hereby disclaim any
responsibility for all other
drawings, specifications, estimates,
reports or other documents or
instruments relating to or
intended to be used for any part
or parts of the architectural or
engineering project or survey
other than those authenticated by
my seal.

REVISIONS



ENGINEERING
PLANNING
SURVEYING
221 Point West Blvd.
St. Charles, MO 63301
636-928-5552
FAX 928-1718

SEWER MEASUREMENTS

THE EXISTING SEWER LENGTHS, SIZES, FLOWLINES, DEPTHS OF STRUCTURES AND SEWERS AND LOCATIONS HAVE BEEN MEASURED. THE RESULTS OF THESE MEASUREMENTS ARE SHOWN ON THIS SET OF FINAL MEASUREMENT PLANS.



10-29-2010
DATE
10-14980
PROJECT NUMBER
1 of 1
SHEET OF
14980TOPQ-101026
FILE NAME
JBS DRO
DRAWN CHECKED
KF 10/2010
SURVEY BY DATE