


FILE #9831.51

Dan Almy
12/10/04

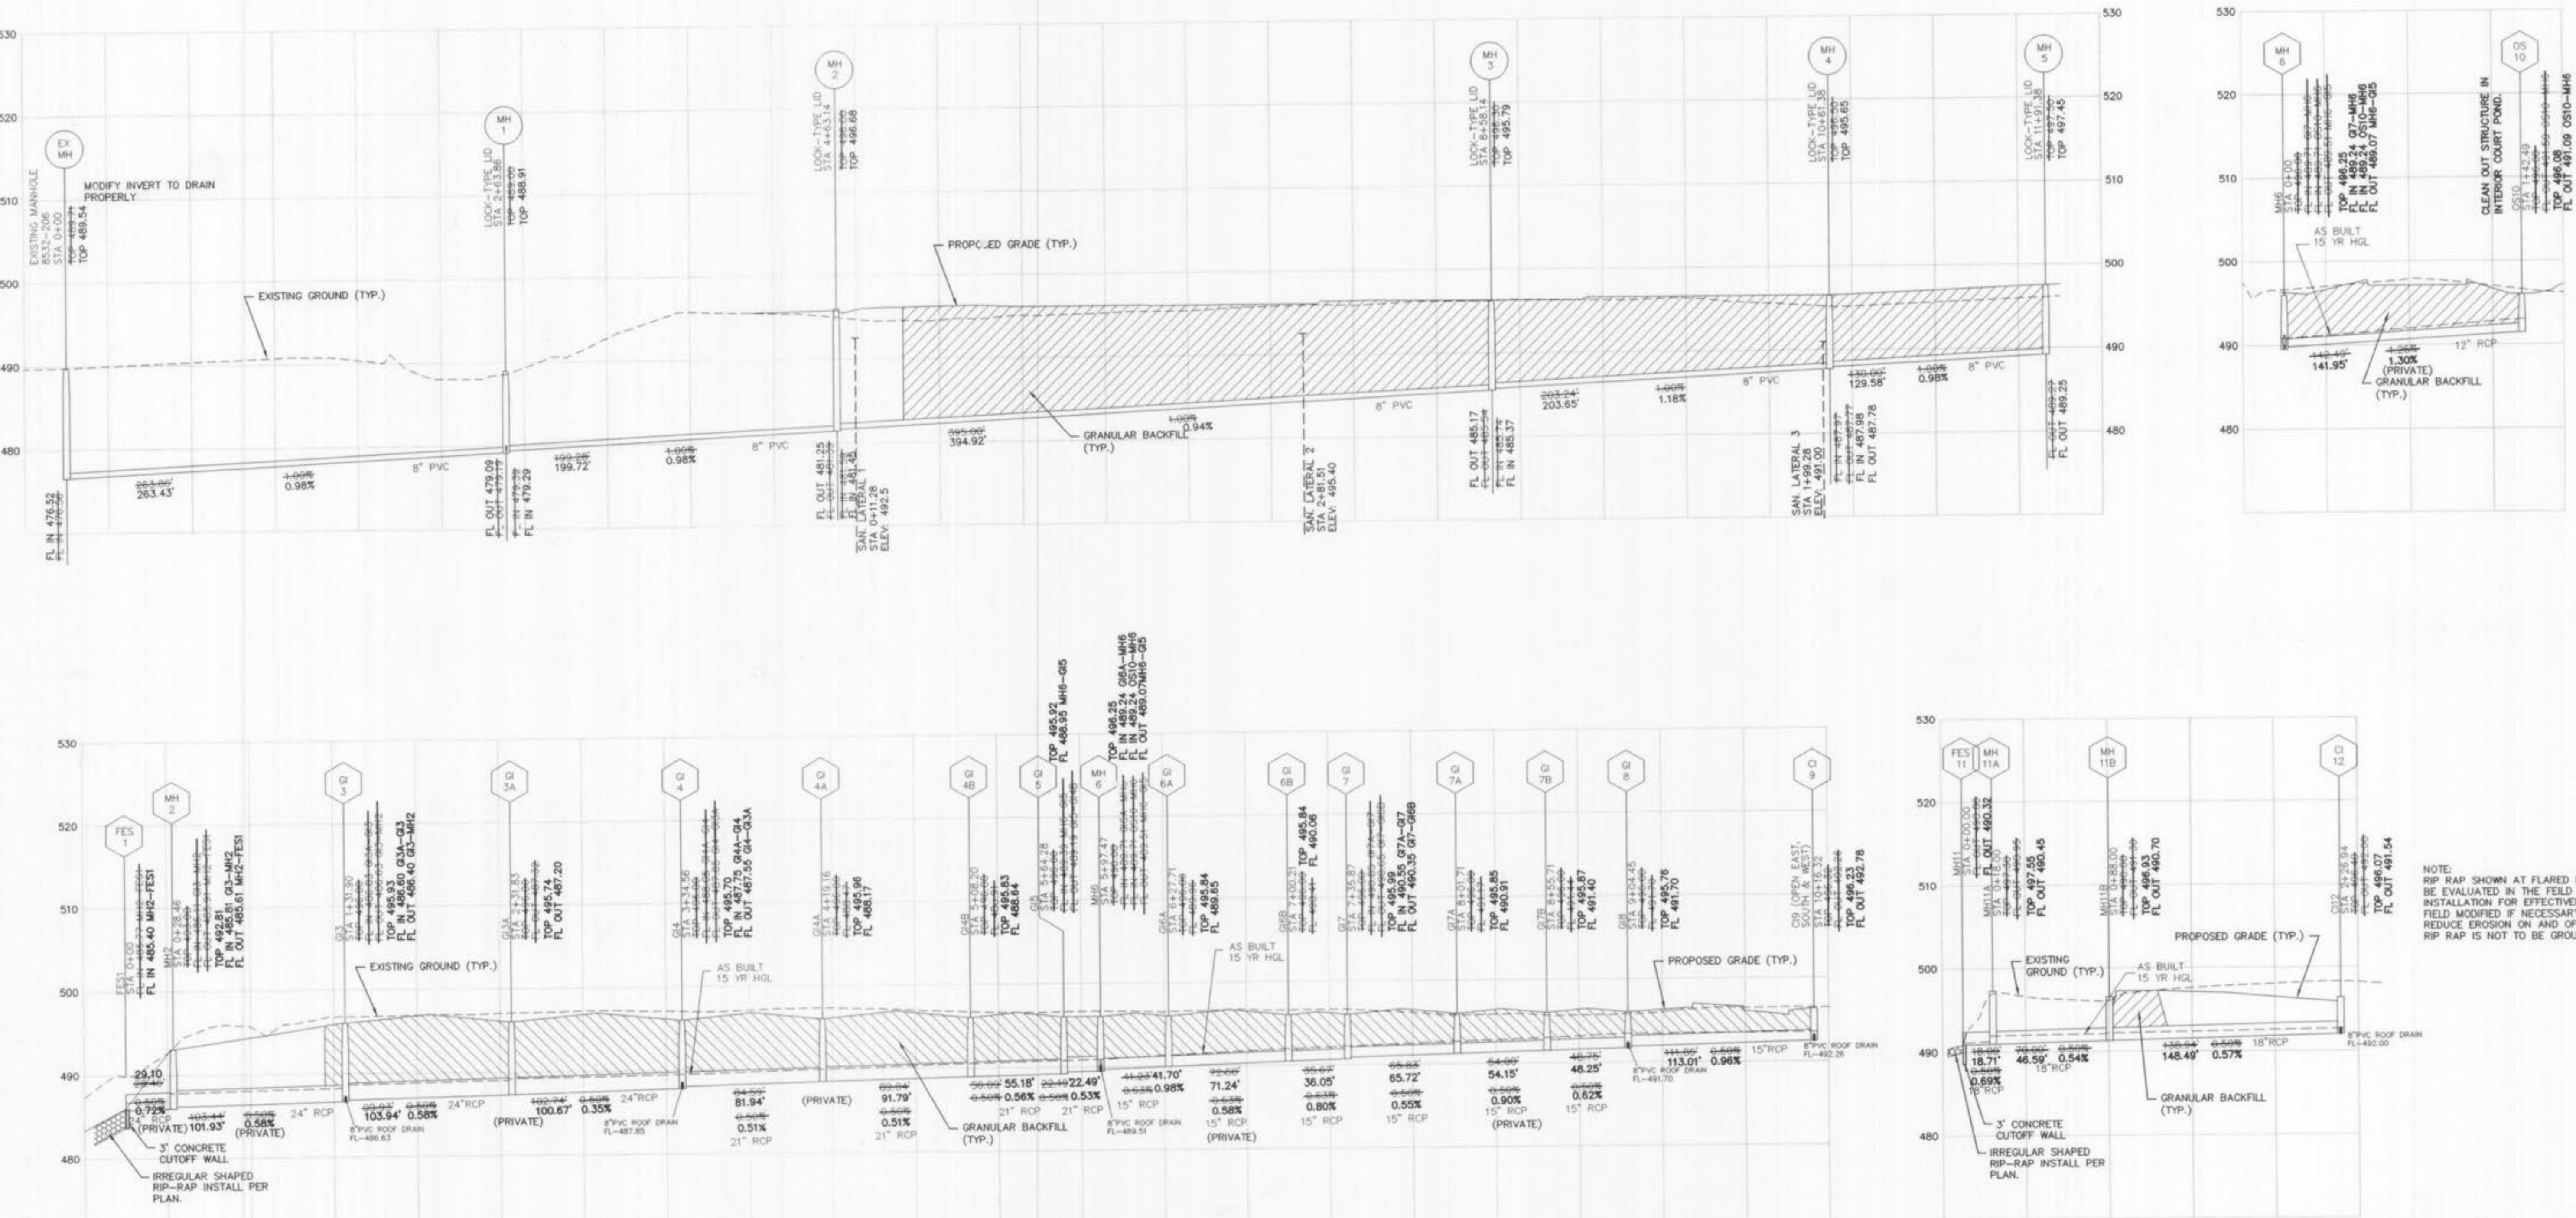

NOTE:
RIP RAP SHOWN AT FLARED ENDS WILL
BE EVALUATED IN THE FIELD AFTER
INSTALLATION FOR EFFECTIVENESS AND
FIELD MODIFIED IF NECESSARY TO
REDUCE EROSION ON AND OFF SITE.
RIP RAP IS NOT TO BE GROUTED.

AS-BUILTS ADDED AUGUST 2006

ALL SANITARY SEWER LATERAL TAILSTAKE ELEVATIONS HAVE BEEN DESIGNED FOR AN
BASEMENT POUR IN HOMES WITH THE TOP OF FOUNDATION ELEVATION BEING SET A MINIMUM OF
ABOVE THE TOP OF CURB ELEVATION AT THE DRIVEWAY.

UNDERGROUND UTILITIES HAVE BEEN PLOTTED FROM AVAILABLE INFORMATION AND THEREFORE THEIR LOCATIONS SHALL BE CONSIDERED APPROXIMATE ONLY. THE VERIFICATION OF THE LOCATION OF ALL UNDERGROUND UTILITIES, EITHER SHOWN OR NOT SHOWN ON THESE PLANS SHALL BE THE RESPONSIBILITY OF THE CONTRACTOR, AND SHALL BE LOCATED PRIOR TO ANY GRADING OR CONSTRUCTION OF THE IMPROVEMENTS.

SCALE: VERTICAL = 10
HORIZONTAL = 50

Park Place 3/3
As b w t s